

CITY OF HAMILTON
BUILDING DIVISION
Planning & Development Department

OCT 06 2020

REC BY _____ DATE _____
REF'D TO _____ DATE _____

FROM PLAN DATED: JAN 2020
BUILDER: GREENPARK HOMES
SITE: RUSSELL GARDENS PH 3
MODEL: VALLEYCREEK 4
ELEVATION: 1, 3


LOT:
CITY: WATERDOWN
SALESMAN: MARIO DICIANO
DESIGNER: AJ
REVISION:

NOTES:
REFER TO THE NORDIC INSTALLATION GUIDE FOR PROPER STORAGE AND INSTALLATION.
SQUASH BLOCKS OF 2x4, 2x6, 2x8 #2 S.P.F REQ'D UNDER INTERIOR UNIFORM LOAD BEARING WALLS. MULTIPLE SQUASH BLOCKS REQ'D UNDER CONCENTRATED LOADS. SEE FIGURE 1. CANTILEVERED JOISTS INCLUDING CANT' OVER BRICK REQ. I-JOIST BLOCKING ALONG BEARING AND RIMBOARD CLOSURE AT ENDS. SEE FIGURES 4 & 5 FOR REINFORCEMENT REQUIREMENTS. FOR HOLES INCLUDING DUCT CHASE AND FIELD CUT OPENINGS SEE FIGURE 7, TABLES 1 & 2. CERAMIC TILE APPLICATION AS PER O.B.C 9.30.6.

LOADING:
DESIGN LOADS: L/480.000
LIVE LOAD: 40.0 lb/ft²
DEAD LOAD: 20.0 lb/ft²
SUBFLOOR: 3/4" GLUED AND NAILED

DATE: 2020-02-19

1st FLOOR

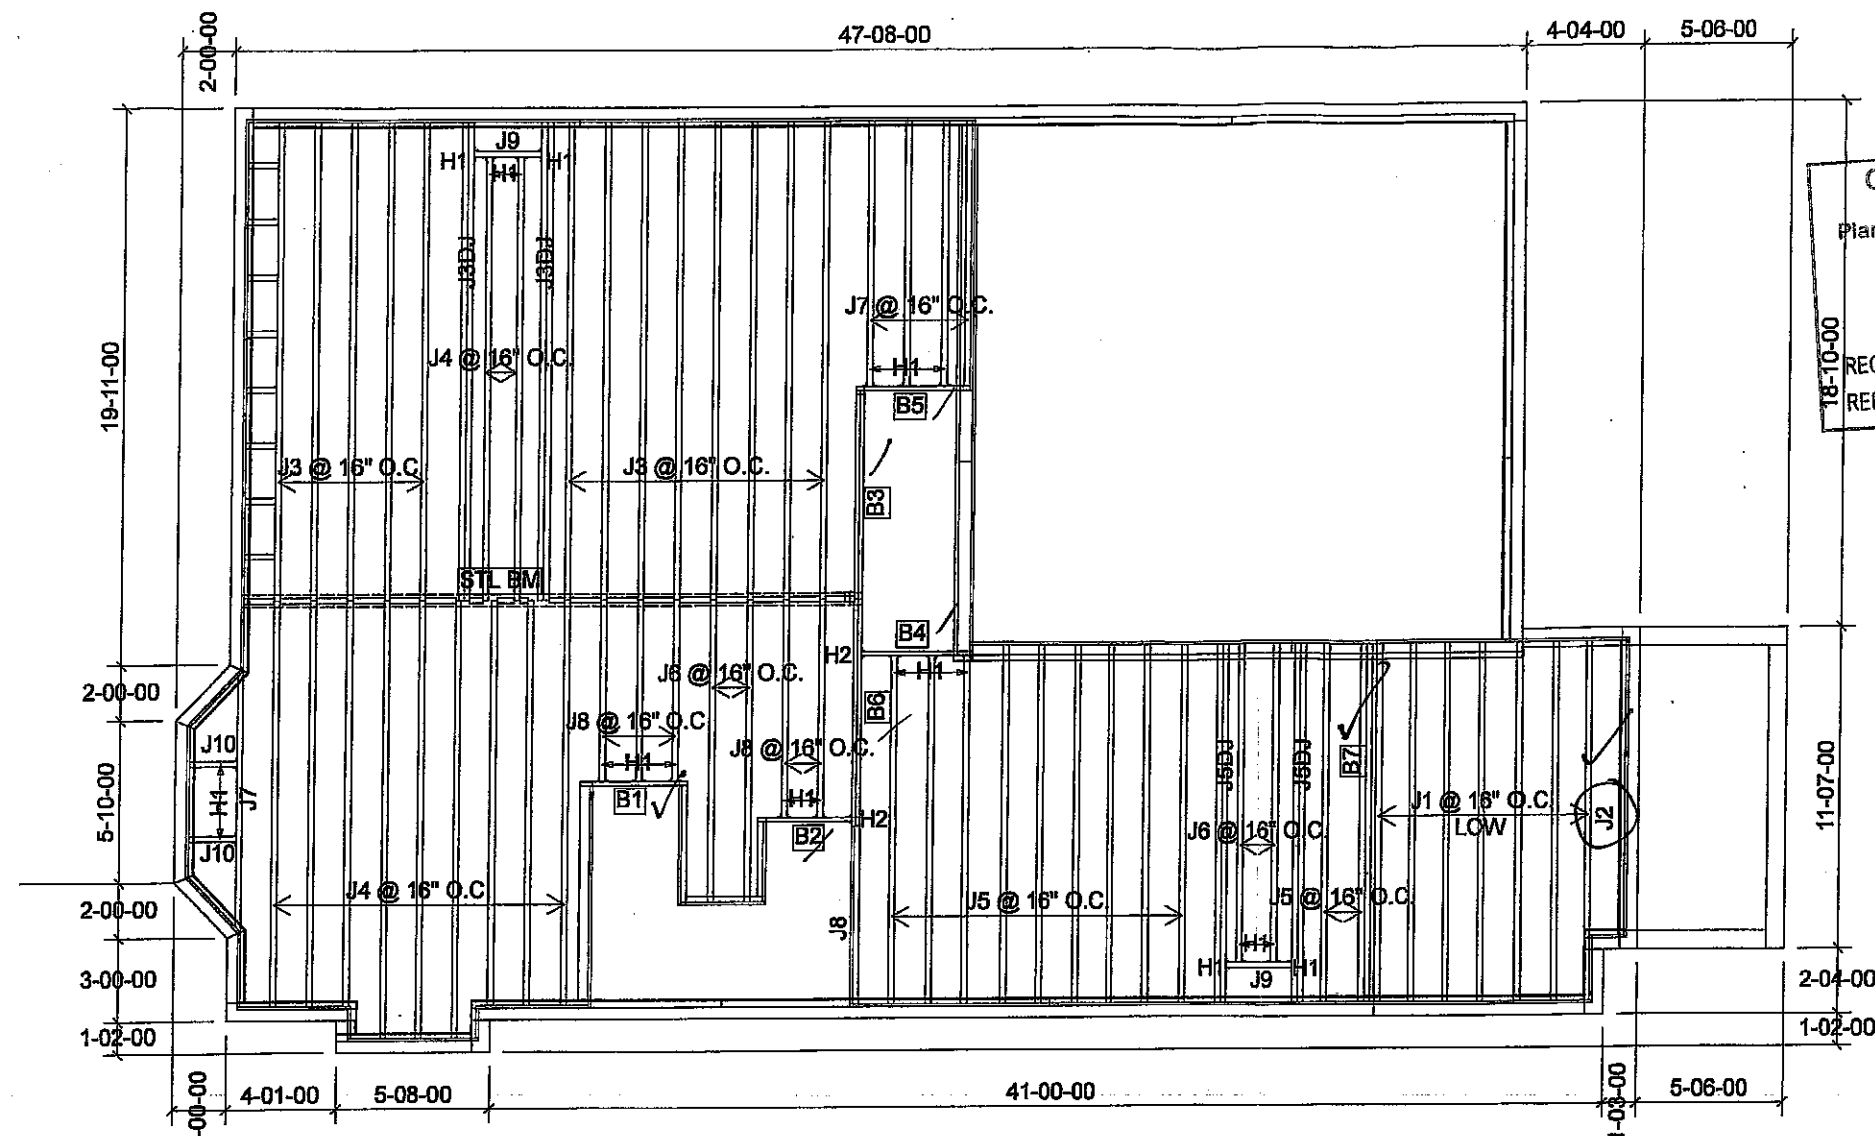

Products					
PlotID	Length	Product	Plies	Net Qty	Fab Type
J1	14-00-00	9 1/2" NI-40x	1	7	MFD
J2	12-00-00	9 1/2" NI-40x	1	1	MFD
J3	18-00-00	11 7/8" NI-40x	1	13	MFD
J3DJ	18-00-00	11 7/8" NI-40x	2	4	MFD
J4	16-00-00	11 7/8" NI-40x	1	11	MFD
J5	14-00-00	11 7/8" NI-40x	1	11	MFD
J5DJ	14-00-00	11 7/8" NI-40x	2	4	MFD
J6	12-00-00	11 7/8" NI-40x	1	4	MFD
J7	10-00-00	11 7/8" NI-40x	1	5	MFD
J8	8-00-00	11 7/8" NI-40x	1	6	MFD
J9	4-00-00	11 7/8" NI-40x	1	2	MFD
J10	2-00-00	11 7/8" NI-40x	1	2	MFD
B7	14-00-00	1-3/4" x 11-7/8" VERSA-LAM® 2.0 3100 SP	1	1	MFD
B6	10-00-00	1-3/4" x 11-7/8" VERSA-LAM® 2.0 3100 SP	2	2	MFD
B3	8-00-00	1-3/4" x 11-7/8" VERSA-LAM® 2.0 3100 SP	2	2	MFD
B5	6-00-00	1-3/4" x 11-7/8" VERSA-LAM® 2.0 3100 SP	1	1	MFD
B1	4-00-00	1-3/4" x 11-7/8" VERSA-LAM® 2.0 3100 SP	1	1	MFD
B2	4-00-00	1-3/4" x 11-7/8" VERSA-LAM® 2.0 3100 SP	1	1	MFD
B4	4-00-00	1-3/4" x 11-7/8" VERSA-LAM® 2.0 3100 SP	1	1	MFD

Connector Summary		
Qty	Manuf	Product
11	H1	IUS2.56/11.88
4	H1	IUS2.56/11.88
6	H1	IUS2.56/11.88
2	H2	HUS1.81/10

CITY OF HAMILTON
Building Division

Permit No. 187682

THESE STAMPED DRAWINGS SHALL BE AVAILABLE ON SITE

THE OWNER AND/OR CONTRACTOR SHALL COMPLY WITH THE ONTARIO BUILDING CODE AND ALL OTHER APPLICABLE LAW

These drawings and/or specifications have been reviewed by

JDC Nov 6/2020
FOR CHIEF BUILDING OFFICIAL DATE

FROM PLAN DATED: JAN 2020

BUILDER: GREENPARK HOMES

SITE: RUSSELL GARDENS PH 3

MODEL: VALLEYCREEK 4

ELEVATION: 2

LOT:

CITY: WATERDOWN

SALESMAN: MARIO DICIANO

DESIGNER: AJ

REVISION:

NOTES:

REFER TO THE **NORDIC INSTALLATION** GUIDE FOR PROPER STORAGE AND INSTALLATION.

SQUASH BLOCKS OF 2x4, 2x6, 2x8 #2 S.P.F REQ'D UNDER INTERIOR UNIFORM LOAD BEARING WALLS. **MULTIPLE SQUASH BLOCKS** REQ'D UNDER CONCENTRATED LOADS. SEE FIGURE 1. **CANTILEVERED JOISTS** INCLUDING **CANT' OVER BRICK** REQ. **JOIST BLOCKING** ALONG BEARING AND **RIMBOARD CLOSURE** AT ENDS. SEE FIGURES 4 & 5 FOR REINFORCEMENT REQUIREMENTS. FOR **HOLES** INCLUDING **DUCT CHASE** AND **FIELD CUT OPENINGS** SEE FIGURE 7, TABLES 1 & 2. **CERAMIC TILE** APPLICATION AS PER O.B.C 9.30.6.

LOADING:

DESIGN LOADS: L/480.000


LIVE LOAD: 40.0 lb/ft²

DEAD LOAD: 20.0 lb/ft²

SUBFLOOR: 3/4" GLUED AND NAILED

DATE: 2020-02-19

1st FLOOR

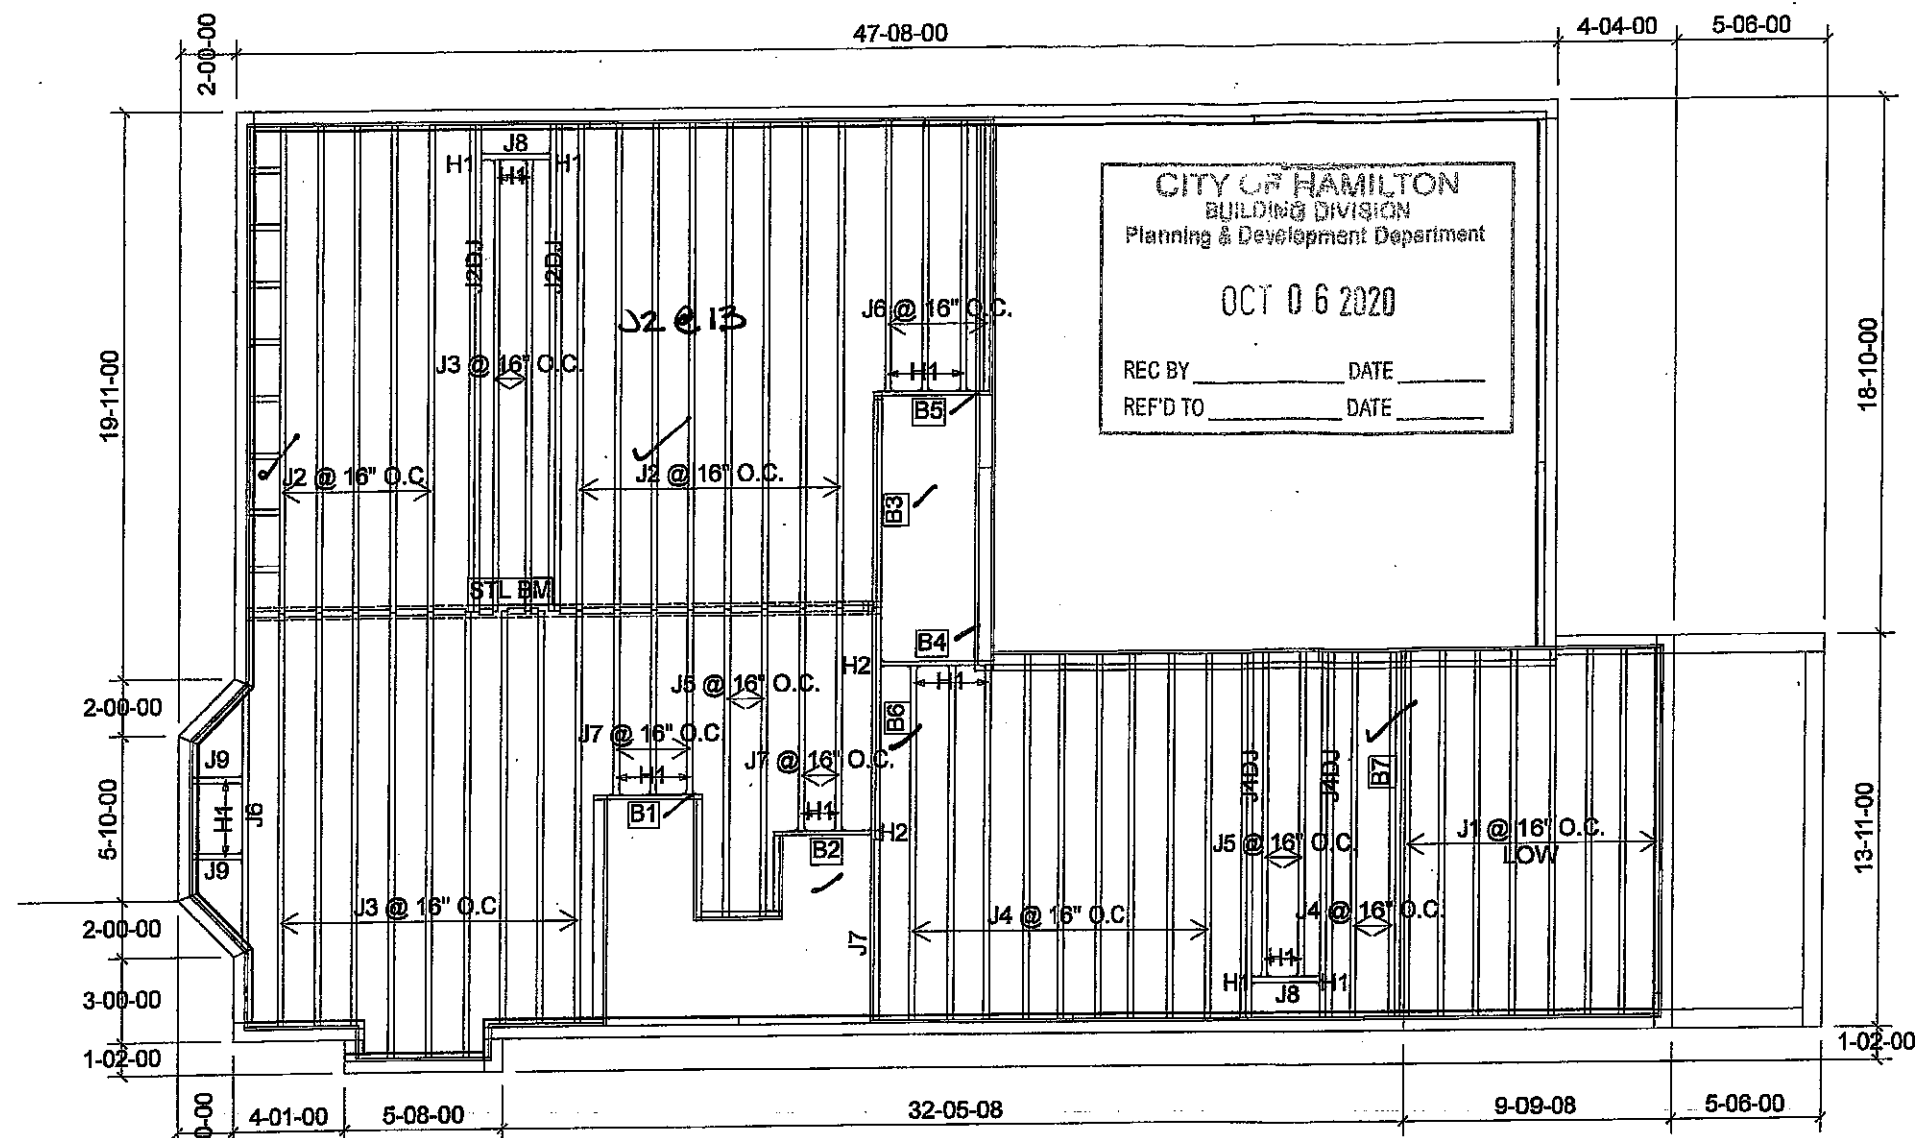

Products					
PlotID	Length	Product	Plies	Net Qty	Fab Type
J1	14-00-00	9 1/2" NI-40x	1	8	MFD
J2	18-00-00	11 7/8" NI-40x	1	13	MFD
J2DJ	18-00-00	11 7/8" NI-40x	2	4	MFD
J3	16-00-00	11 7/8" NI-40x	1	11	MFD
J4	14-00-00	11 7/8" NI-40x	1	11	MFD
J4DJ	14-00-00	11 7/8" NI-40x	2	4	MFD
J5	12-00-00	11 7/8" NI-40x	1	4	MFD
J6	10-00-00	11 7/8" NI-40x	1	5	MFD
J7	8-00-00	11 7/8" NI-40x	1	6	MFD
J8	4-00-00	11 7/8" NI-40x	1	2	MFD
J9	2-00-00	11 7/8" NI-40x	1	2	MFD
B7	14-00-00	1-3/4" x 11-7/8" VERSA-LAM® 2.0 3100 SP	1	1	MFD
B6	10-00-00	1-3/4" x 11-7/8" VERSA-LAM® 2.0 3100 SP	2	2	MFD
B3	8-00-00	1-3/4" x 11-7/8" VERSA-LAM® 2.0 3100 SP	2	2	MFD
B5	6-00-00	1-3/4" x 11-7/8" VERSA-LAM® 2.0 3100 SP	1	1	MFD
B1	4-00-00	1-3/4" x 11-7/8" VERSA-LAM® 2.0 3100 SP	1	1	MFD
B2	4-00-00	1-3/4" x 11-7/8" VERSA-LAM® 2.0 3100 SP	1	1	MFD
B4	4-00-00	1-3/4" x 11-7/8" VERSA-LAM® 2.0 3100 SP	1	1	MFD

Connector Summary		
Qty	Manuf	Product
11	H1	IUS2.56/11.88
4	H1	IUS2.56/11.88
6	H1	IUS2.56/11.88
2	H2	HUS1.81/10

CITY OF HAMILTON
Building Division

Permit No. **187682**

THESE STAMPED DRAWINGS SHALL BE AVAILABLE ON SITE

THE OWNER AND/OR CONTRACTOR SHALL COMPLY WITH THE ONTARIO BUILDING CODE AND ALL OTHER APPLICABLE LAW

These drawings and/or specifications have been reviewed by

JDC *Nov 6/2020*
FOR CHIEF BUILDING OFFICIAL DATE

FROM PLAN DATED: JAN 2020

BUILDER: GREENPARK HOMES

SITE: RUSSELL GARDENS PH 3

MODEL: VALLEYCREEK 4

ELEVATION: 1, 3

LOT:

CITY: WATERDOWN

SALESMAN: MARIO DICIANO

DESIGNER: AJ

REVISION:

NOTES:

REFER TO THE **NORDIC INSTALLATION GUIDE** FOR PROPER STORAGE AND INSTALLATION.

SQUASH BLOCKS OF 2x4, 2x6, 2x8 #2 S.P.F REQ'D UNDER INTERIOR UNIFORM LOAD BEARING WALLS. **MULTIPLE SQUASH BLOCKS** REQ'D UNDER CONCENTRATED LOADS. SEE FIGURE 1. **CANTILEVERED JOISTS** INCLUDING **CANT' OVER BRICK** REQ. I-JOIST BLOCKING ALONG BEARING AND RIMBOARD CLOSURE AT ENDS. SEE FIGURES 4 & 5 FOR REINFORCEMENT REQUIREMENTS. FOR HOLES INCLUDING **DUCT CHASE** AND **FIELD CUT OPENINGS** SEE FIGURE 7, TABLES 1 & 2. **CERAMIC TILE** APPLICATION AS PER O.B.C 9.30.6.

LOADING:

DESIGN LOADS: L/480.000

LIVE LOAD: 40.0 lb/ft²


DEAD LOAD: 20.0 lb/ft²

SUBFLOOR: 3/4" GLUED AND NAILED

DATE: 2020-03-24

1st FLOOR

DECK CONDITION

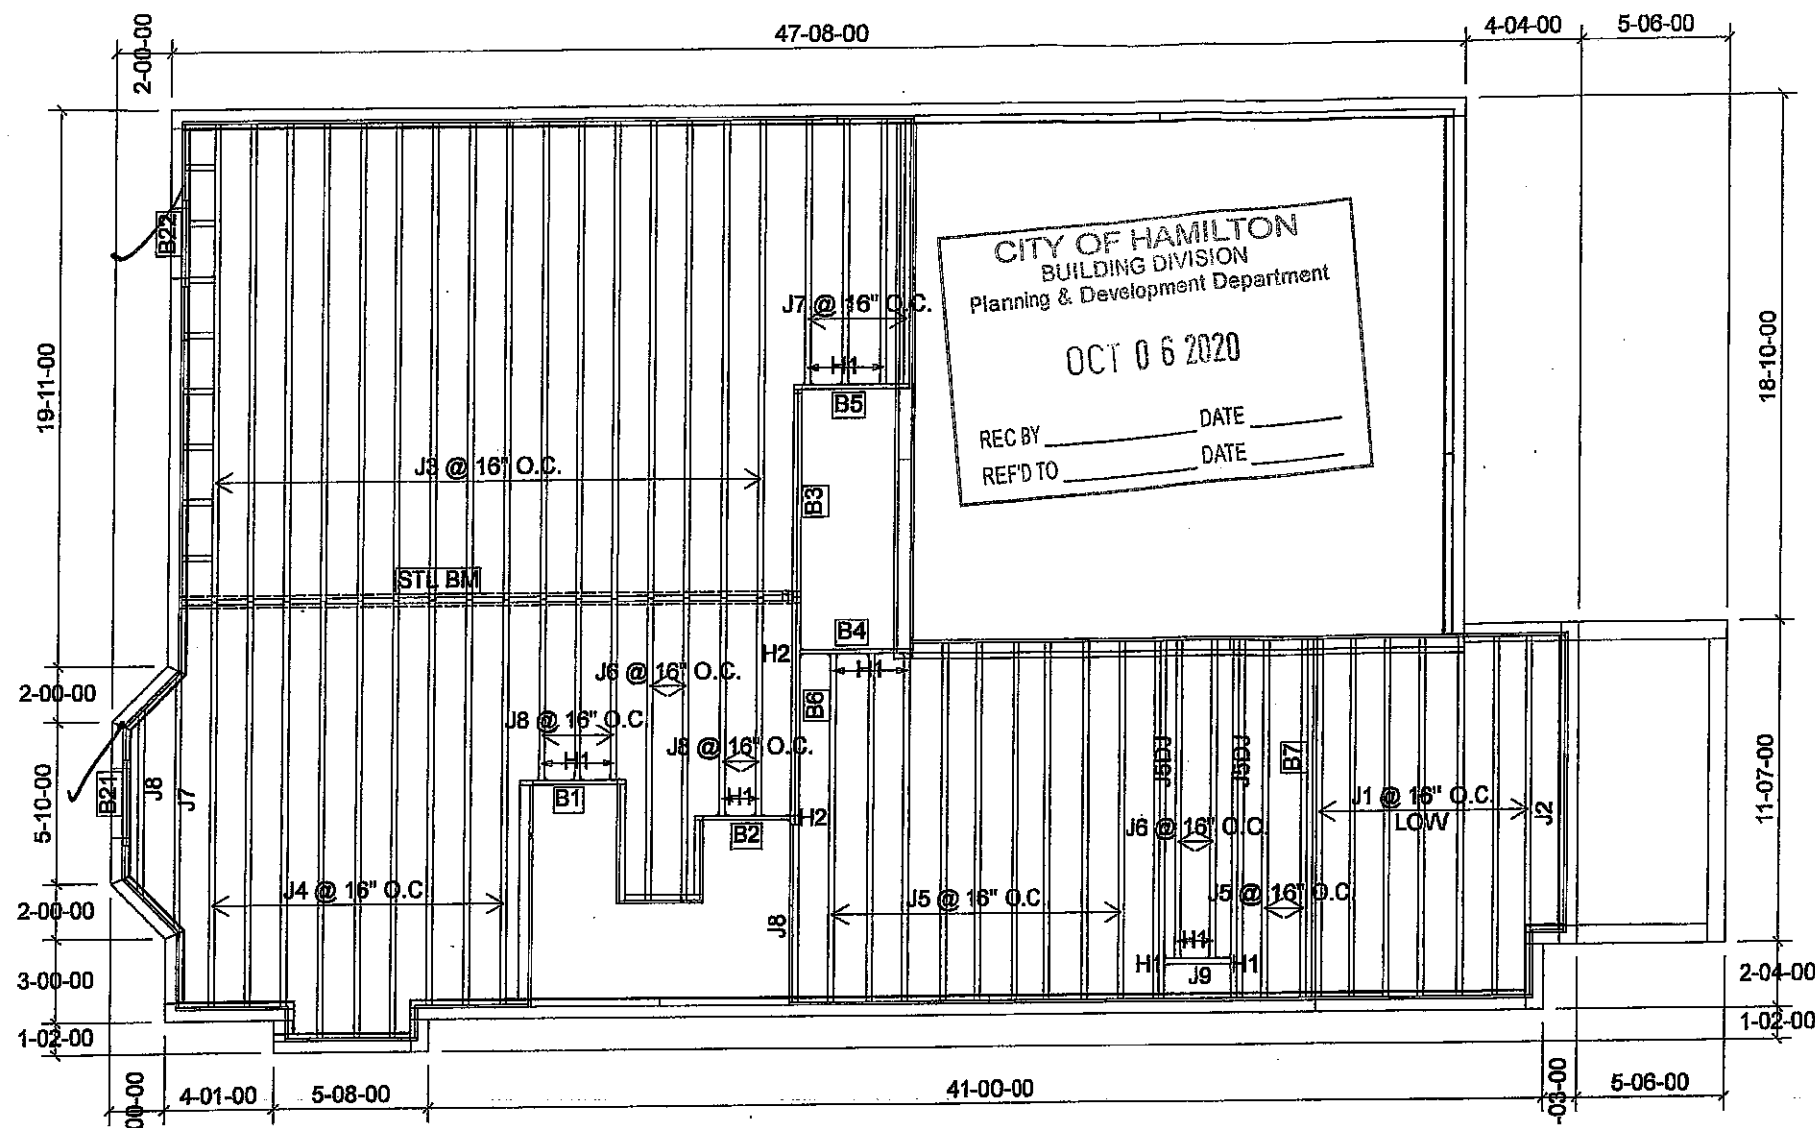

Products					
PlotID	Length	Product	Plies	Net Qty	Fab Type
J1	14-00-00	9 1/2" NI-40x	1	7	MFD
J2	12-00-00	9 1/2" NI-40x	1	1	MFD
J3	18-00-00	11 7/8" NI-40x	1	16	MFD
J4	16-00-00	11 7/8" NI-40x	1	9	MFD
J5	14-00-00	11 7/8" NI-40x	1	11	MFD
J5DJ	14-00-00	11 7/8" NI-40x	2	4	MFD
J6	12-00-00	11 7/8" NI-40x	1	4	MFD
J7	10-00-00	11 7/8" NI-40x	1	5	MFD
J8	8-00-00	11 7/8" NI-40x	1	7	MFD
J9	4-00-00	11 7/8" NI-40x	1	1	MFD
B7	14-00-00	1-3/4" x 11-7/8" VERSA-LAM® 2.0 3100 SP	1	1	MFD
B6	10-00-00	1-3/4" x 11-7/8" VERSA-LAM® 2.0 3100 SP	2	2	MFD
B3	8-00-00	1-3/4" x 11-7/8" VERSA-LAM® 2.0 3100 SP	2	2	MFD
B5	6-00-00	1-3/4" x 11-7/8" VERSA-LAM® 2.0 3100 SP	1	1	MFD
B1	4-00-00	1-3/4" x 11-7/8" VERSA-LAM® 2.0 3100 SP	1	1	MFD
B2	4-00-00	1-3/4" x 11-7/8" VERSA-LAM® 2.0 3100 SP	1	1	MFD
B4	4-00-00	1-3/4" x 11-7/8" VERSA-LAM® 2.0 3100 SP	1	1	MFD
B21	4-00-00	1-3/4" x 11-7/8" VERSA-LAM® 2.0 3100 SP	2	2	MFD
B22	4-00-00	1-3/4" x 11-7/8" VERSA-LAM® 2.0 3100 SP	2	2	MFD

Connector Summary		
Qty	Manuf	Product
11	H1	IUS2.56/11.88
2	H1	IUS2.56/11.88
2	H1	IUS2.56/11.88
2	H2	HUS1.81/10

CITY OF HAMILTON
Building Division
Permit No. **187682**
THESE STAMPED DRAWINGS SHALL BE AVAILABLE ON SITE
THE OWNER AND/OR CONTRACTOR SHALL COMPLY WITH
THE ONTARIO BUILDING CODE AND ALL OTHER APPLICABLE LAW
These drawings and/or specifications have been reviewed by
JDL **Nov 6/2020**
FOR CHIEF BUILDING OFFICIAL DATE

FROM PLAN DATED: JAN 2020

BUILDER: GREENPARK HOMES

SITE: RUSSELL GARDENS PH 3

MODEL: VALLEYCREEK 4

ELEVATION: 2

LOT:

CITY: WATERDOWN

SALESMAN: MARIO DICIANO

DESIGNER: AJ

REVISION:

NOTES:

REFER TO THE **NORDIC INSTALLATION GUIDE** FOR PROPER STORAGE AND INSTALLATION.

SQUASH BLOCKS OF 2x4, 2x6, 2x8 #2 S.P.F. REQ'D UNDER INTERIOR UNIFORM LOAD BEARING WALLS. **MULTIPLE SQUASH BLOCKS** REQ'D UNDER CONCENTRATED LOADS. SEE FIGURE 1. **CANTILEVERED JOISTS** INCLUDING **CANT' OVER BRICK** REQ. JOIST BLOCKING ALONG BEARING AND RIMBOARD CLOSURE AT ENDS. SEE FIGURES 4 & 5 FOR REINFORCEMENT REQUIREMENTS. FOR **HOLES** INCLUDING **DUCT CHASE** AND **FIELD CUT OPENINGS** SEE FIGURE 7, TABLES 1 & 2. **CERAMIC TILE** APPLICATION AS PER O.B.C 9.30.6.

LOADING:

DESIGN LOADS: L/480.000

LIVE LOAD: 40.0 lb/ft²


DEAD LOAD: 20.0 lb/ft²

SUBFLOOR: 3/4" GLUED AND NAILED

DATE: 2020-03-24

1st FLOOR

DECK CONDITION

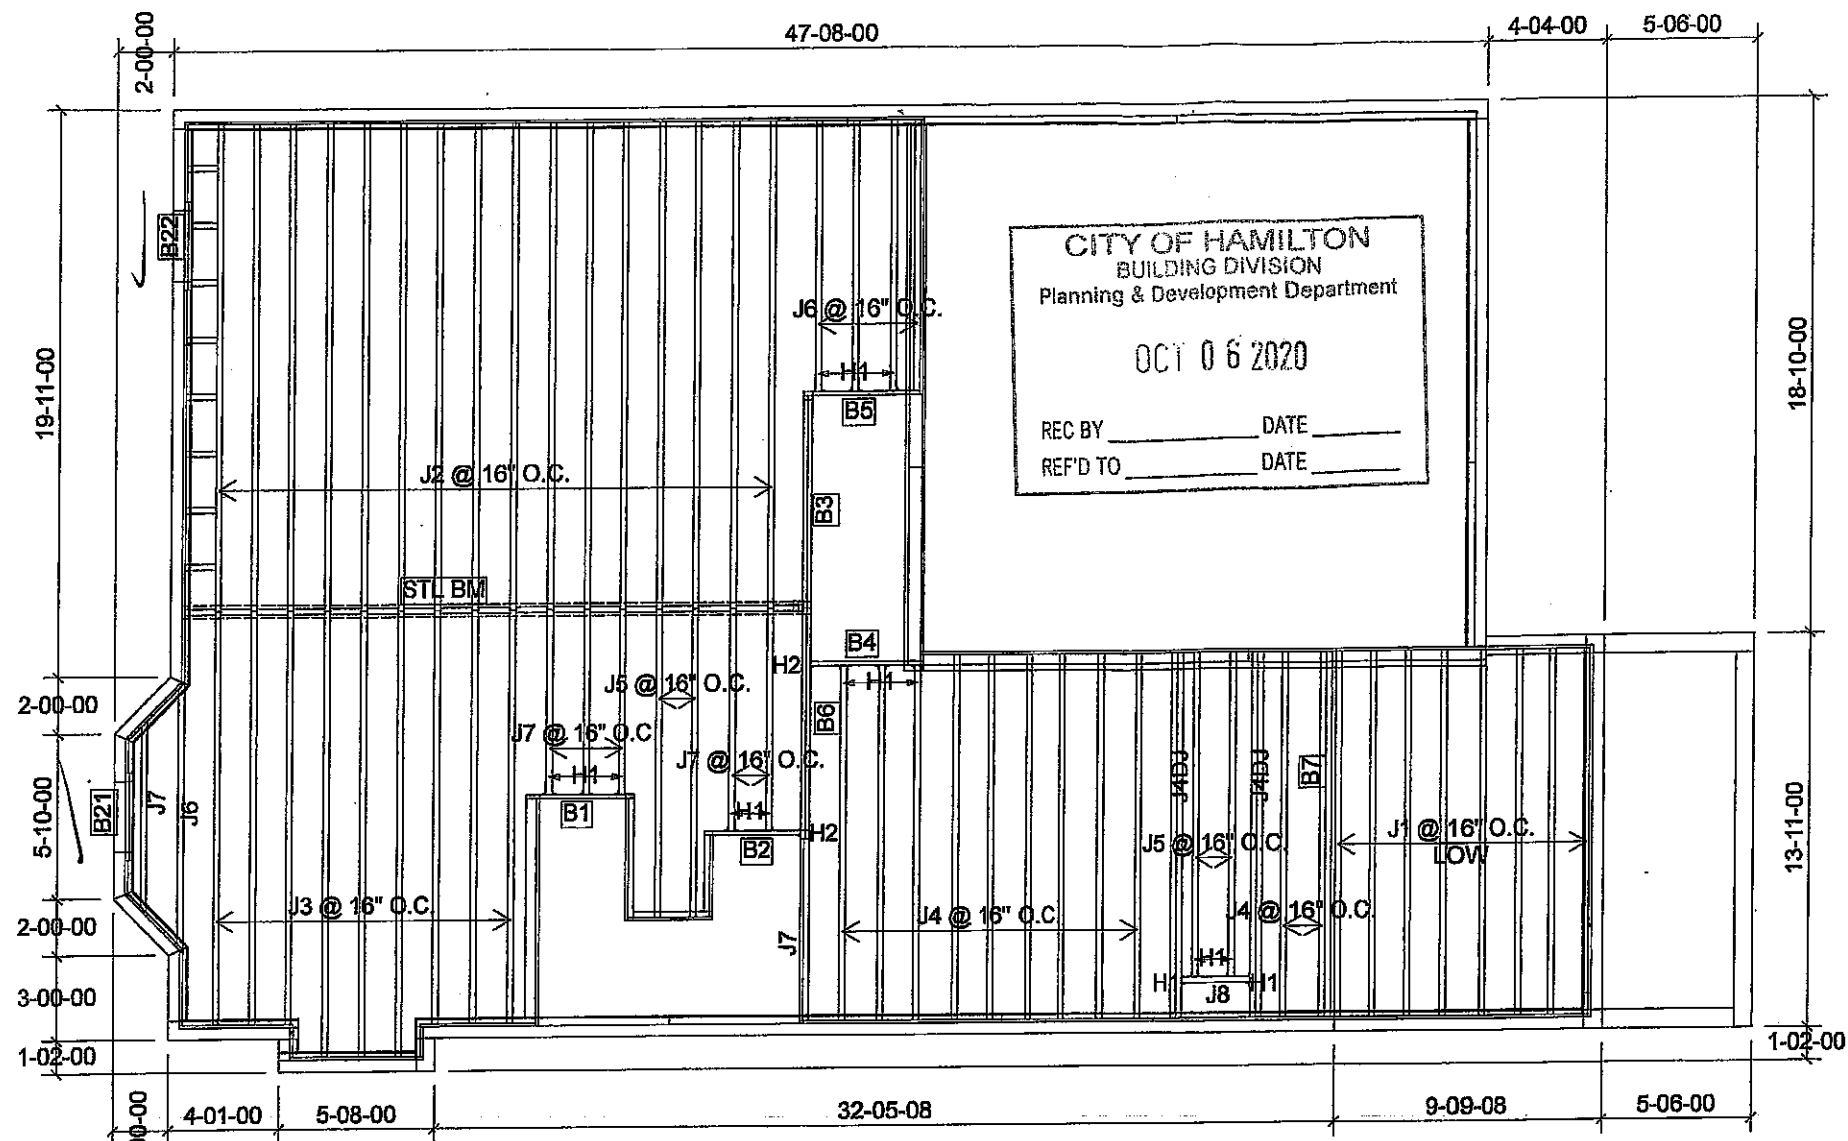

Products					
PlotID	Length	Product	Plies	Net Qty	Fab Type
J1	14-00-00	9 1/2" NI-40x	1	8	MFD
J2	18-00-00	11 7/8" NI-40x	1	16	MFD
J3	16-00-00	11 7/8" NI-40x	1	9	MFD
J4	14-00-00	11 7/8" NI-40x	1	11	MFD
J4DJ	14-00-00	11 7/8" NI-40x	2	4	MFD
J5	12-00-00	11 7/8" NI-40x	1	4	MFD
J6	10-00-00	11 7/8" NI-40x	1	5	MFD
J7	8-00-00	11 7/8" NI-40x	1	7	MFD
J8	4-00-00	11 7/8" NI-40x	1	1	MFD
B7	14-00-00	1-3/4" x 11-7/8" VERSA-LAM® 2.0 3100 SP	1	1	MFD
B6	10-00-00	1-3/4" x 11-7/8" VERSA-LAM® 2.0 3100 SP	2	2	MFD
B3	8-00-00	1-3/4" x 11-7/8" VERSA-LAM® 2.0 3100 SP	2	2	MFD
B5	6-00-00	1-3/4" x 11-7/8" VERSA-LAM® 2.0 3100 SP	1	1	MFD
B1	4-00-00	1-3/4" x 11-7/8" VERSA-LAM® 2.0 3100 SP	1	1	MFD
B2	4-00-00	1-3/4" x 11-7/8" VERSA-LAM® 2.0 3100 SP	1	1	MFD
B4	4-00-00	1-3/4" x 11-7/8" VERSA-LAM® 2.0 3100 SP	1	1	MFD
B21	4-00-00	1-3/4" x 11-7/8" VERSA-LAM® 2.0 3100 SP	2	2	MFD
B22	4-00-00	1-3/4" x 11-7/8" VERSA-LAM® 2.0 3100 SP	2	2	MFD

Connector Summary		
Qty	Manuf	Product
11	H1	IUS2.56/11.88
2	H1	IUS2.56/11.88
2	H1	IUS2.56/11.88
2	H2	HUS1.81/10

CITY OF HAMILTON
Building Division

Permit No. **187682**

THESE STAMPED DRAWINGS SHALL BE AVAILABLE ON SITE

THE OWNER AND/OR CONTRACTOR SHALL COMPLY WITH
THE ONTARIO BUILDING CODE AND ALL OTHER APPLICABLE LAW

These drawings and/or specifications have been reviewed by

[Signature] **Nov 6/2020**
FOR CHIEF BUILDING OFFICIAL DATE

CITY OF HAMILTON
BUILDING DIVISION
Planning & Development Department

OCT 06 2020

REC BY _____ DATE _____
REF'D TO _____ DATE _____

TAMARACK
LUMBER INC
ALPA LUMBER GROUP

FROM PLAN DATED: JAN 2020

BUILDER: GREENPARK HOMES

SITE: RUSSELL GARDENS PH 3

MODEL: VALLEYCREEK 4

ELEVATION: 1

LOT:

CITY: WATERDOWN

SALESMAN: MARIO DICIANO

DESIGNER: AJ

REVISION:


NOTES:
REFER TO THE NORDIC **INSTALLATION GUIDE** FOR PROPER STORAGE AND INSTALLATION. **SQUASH BLOCKS** OF 2x4, 2x6, 2x8 #2 S.P.F. REQ'D UNDER INTERIOR UNIFORM LOAD BEARING WALLS. **MULTIPLE SQUASH BLOCKS** REQ'D UNDER CONCENTRATED LOADS. SEE FIGURE 1. **CANTILEVERED JOISTS** INCLUDING **CANT' OVER BRICK** REQ. I-JOIST BLOCKING ALONG BEARING AND RIMBOARD CLOSURE AT ENDS. SEE FIGURE 7 TABLES 4 & 5 FOR REINFORCEMENT REQUIREMENTS. FOR **HOLES** INCLUDING **DUCT CHASE** AND **FIELD CUT OPENINGS** SEE FIGURE 7 TABLES 1 & 2 OF THE INSTALLATION GUIDE. **CERAMIC TILE** APPLICATION AS PER O.B.C. 9.30.6

LOADING:
DESIGN LOADS: L/480.000
LIVE LOAD: 40.0 lb/ft²
DEAD LOAD: 20.0 lb/ft²

SUBFLOOR: 5/8" GLUED AND NAILED

DATE: 2020-03-24

2nd FLOOR

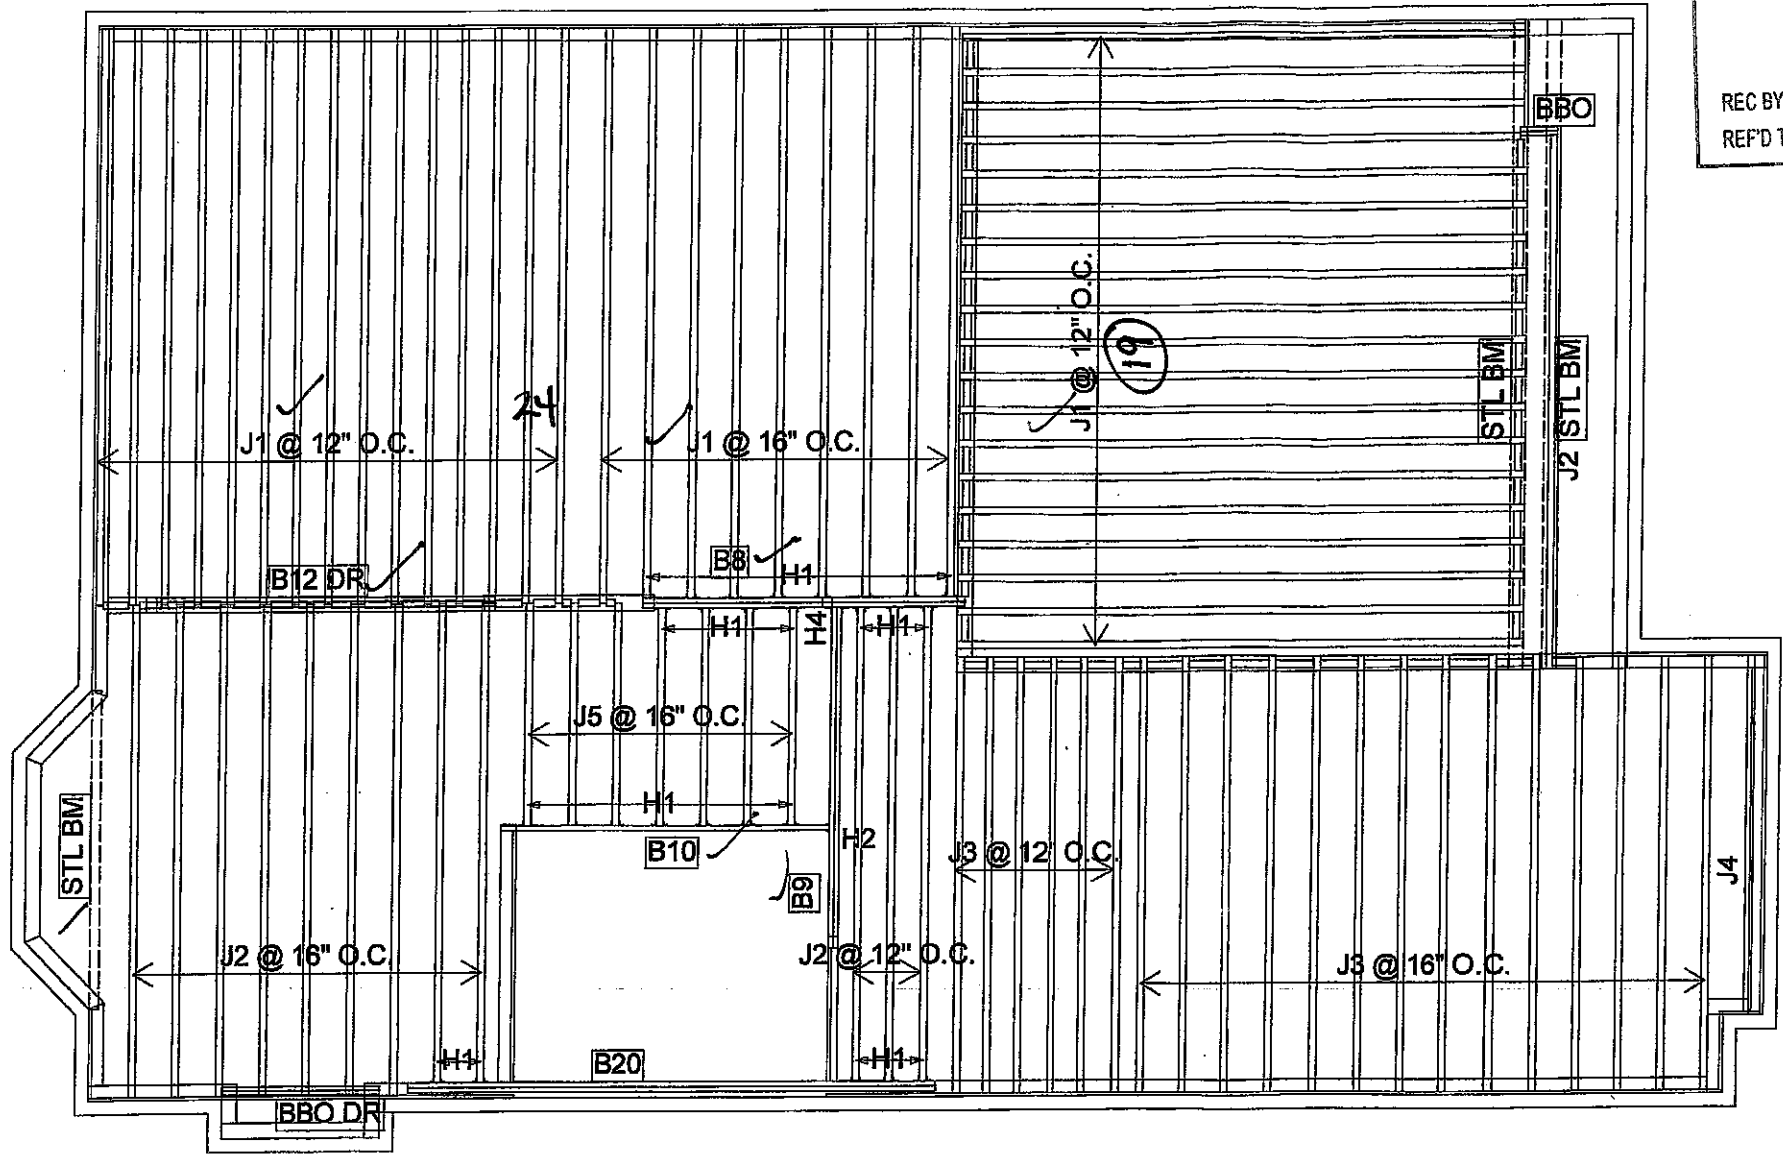

Products					
PlotID	Length	Product	Plies	Net Qty	Fab Type
J1	18-00-00	11 7/8" NI-40x	1	✓ 43	MFD
J2	16-00-00	11 7/8" NI-40x	1	13	MFD
J3	14-00-00	11 7/8" NI-40x	1	20	MFD
J4	12-00-00	11 7/8" NI-40x	1	1	MFD
J5	8-00-00	11 7/8" NI-40x	1	7	MFD
B12 DR	12-00-00	1-3/4" x 9-1/2" VERSA-LAM® 2.0 3100 SP	3	3	MFD
B20	16-00-00	1-3/4" x 11-7/8" VERSA-LAM® 2.0 3100 SP	2	2	MFD
B9	12-00-00	1-3/4" x 11-7/8" VERSA-LAM® 2.0 3100 SP	2	2	MFD
B10	10-00-00	1-3/4" x 11-7/8" VERSA-LAM® 2.0 3100 SP	1	1	MFD
B8	10-00-00	1-3/4" x 11-7/8" VERSA-LAM® 2.0 3100 SP	2	2	MFD

Connector Summary		
Qty	Manuf	Product
7	H1	IUS2.56/11.88
20	H1	IUS2.56/11.88
1	H2	HUS1.81/10
1	H4	HGUS410

CITY OF HAMILTON
Building Division

Permit No. 187682

THESE STAMPED DRAWINGS SHALL BE AVAILABLE ON SITE

THE OWNER AND/OR CONTRACTOR SHALL COMPLY WITH
THE ONTARIO BUILDING CODE AND ALL OTHER APPLICABLE LAW

These drawings and/or specifications have been reviewed by

JDC Nov 6/2020
FOR CHIEF BUILDING OFFICIAL DATE

FROM PLAN DATED: JAN 2020

BUILDER: GREENPARK HOMES

SITE: RUSSELL GARDENS PH 3

MODEL: VALLEYCREEK 4

ELEVATION: 2

LOT:

CITY: WATERDOWN

SALESMAN: MARIO DICIANO

DESIGNER: AJ

REVISION:

NOTES:

REFER TO THE NORDIC INSTALLATION GUIDE FOR PROPER STORAGE AND INSTALLATION. **SQUASH BLOCKS** OF 2x4, 2x6, 2x8 #2 S.P.F. REQ'D UNDER INTERIOR UNIFORM LOAD BEARING WALLS. **MULTIPLE SQUASH BLOCKS** REQ'D UNDER CONCENTRATED LOADS. SEE FIGURE 1. **CANTILEVERED JOISTS** INCLUDING **CANT' OVER BRICK** REQ. I-JOIST BLOCKING ALONG BEARING AND RIMBOARD CLOSURE AT ENDS. SEE FIGURE 7 TABLES 4 & 5 FOR REINFORCEMENT REQUIREMENTS. FOR **HOLES** INCLUDING **DUCT CHASE** AND **FIELD CUT OPENINGS** SEE FIGURE 7 TABLES 1 & 2 OF THE INSTALLATION GUIDE. **CERAMIC TILE** APPLICATION AS PER O.B.C. 9.30.6

LOADING:

DESIGN LOADS: L/480.000


LIVE LOAD: 40.0 lb/ft²

DEAD LOAD: 20.0 lb/ft²

SUBFLOOR: 5/8" GLUED AND NAILED

DATE: 2020-03-24

2nd FLOOR

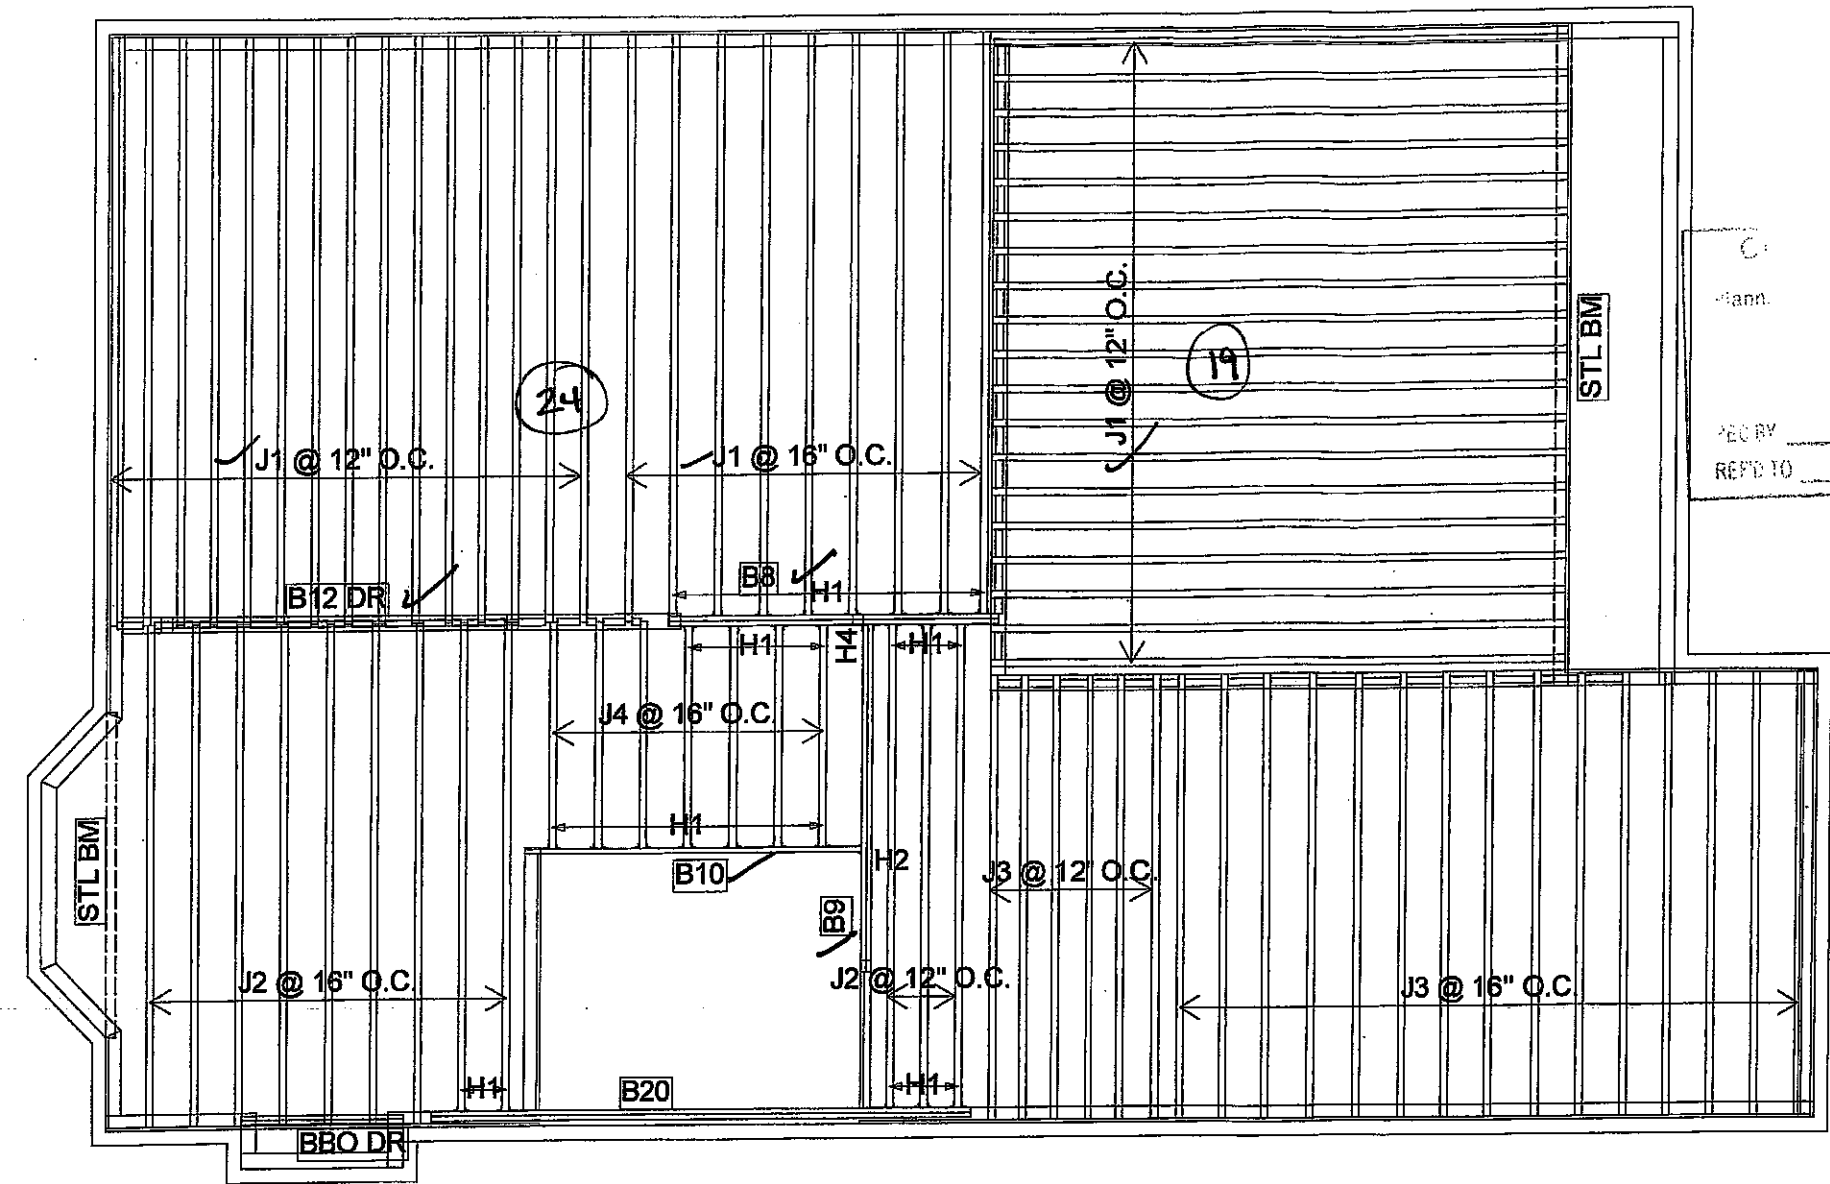

Plan. _____

Department _____

10/10/20

REC'D BY _____ DATE _____

REP'D TO _____ DATE _____

Products					
PlotID	Length	Product	Plies	Net Qty	Fab Type
J1	18-00-00	11 7/8" NI-40x	1	43	MFD
J2	16-00-00	11 7/8" NI-40x	1	12	MFD
J3	14-00-00	11 7/8" NI-40x	1	21	MFD
J4	8-00-00	11 7/8" NI-40x	1	7	MFD
B12 DR	12-00-00	1-3/4" x 9-1/2" VERSA-LAM® 2.0 3100 SP	3	3	MFD
B20	16-00-00	1-3/4" x 11-7/8" VERSA-LAM® 2.0 3100 SP	2	2	MFD
B9	12-00-00	1-3/4" x 11-7/8" VERSA-LAM® 2.0 3100 SP	2	2	MFD
B10	10-00-00	1-3/4" x 11-7/8" VERSA-LAM® 2.0 3100 SP	1	1	MFD
B8	10-00-00	1-3/4" x 11-7/8" VERSA-LAM® 2.0 3100 SP	2	2	MFD

Connector Summary		
Qty	Manuf	Product
7	H1	IUS2.56/11.88
15	H1	IUS2.56/11.88
5		IUS2.56/11.88
1	H2	HUS1.81/10
1	H4	HGUS410

CITY OF HAMILTON
Building Division

Permit No. 107682

THESE STAMPED DRAWINGS SHALL BE AVAILABLE ON SITE

THE OWNER AND/OR CONTRACTOR SHALL COMPLY WITH THE ONTARIO BUILDING CODE AND ALL OTHER APPLICABLE LAW

These drawings and/or specifications have been reviewed by

JDC Nov 6/2020

FOR CHIEF BUILDING OFFICIAL DATE

FROM PLAN DATED: JAN 2020

BUILDER: GREENPARK HOMES

SITE: RUSSELL GARDENS PH 3

MODEL: VALLEYCREEK 4

ELEVATION: 3

LOT:

CITY: WATERDOWN

SALESMAN: MARIO DICIANO

DESIGNER: AJ

REVISION:

NOTES:
REFER TO THE NORDIC INSTALLATION GUIDE FOR PROPER STORAGE AND INSTALLATION. **SQUASH BLOCKS** OF 2x4, 2x6, 2x8 #2 S.P.F. REQ'D UNDER INTERIOR UNIFORM LOAD BEARING WALLS. **MULTIPLE SQUASH BLOCKS** REQ'D UNDER CONCENTRATED LOADS. SEE FIGURE 1. **CANTILEVERED JOISTS** INCLUDING **CANT' OVER BRICK** REQ. 1-JOIST BLOCKING ALONG BEARING AND RIMBOARD CLOSURE AT ENDS. SEE FIGURE 7 TABLES 4 & 5 FOR REINFORCEMENT REQUIREMENTS. FOR **HOLES** INCLUDING **DUCT CHASE** AND **FIELD CUT OPENINGS** SEE FIGURE 7 TABLES 1 & 2 OF THE INSTALLATION GUIDE. **CERAMIC TILE** APPLICATION AS PER O.B.C. 9.30.6

LOADING:

DESIGN LOADS: L/480.000



LIVE LOAD: 40.0 lb/ft²

DEAD LOAD: 20.0 lb/ft²

SUBFLOOR: 5/8" GLUED AND NAILED

DATE: 2020-03-24

2nd FLOOR

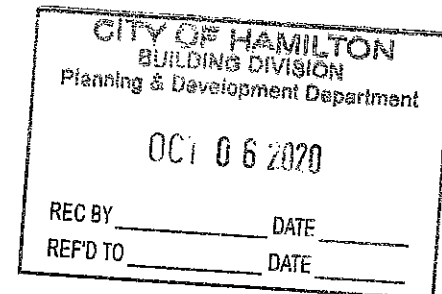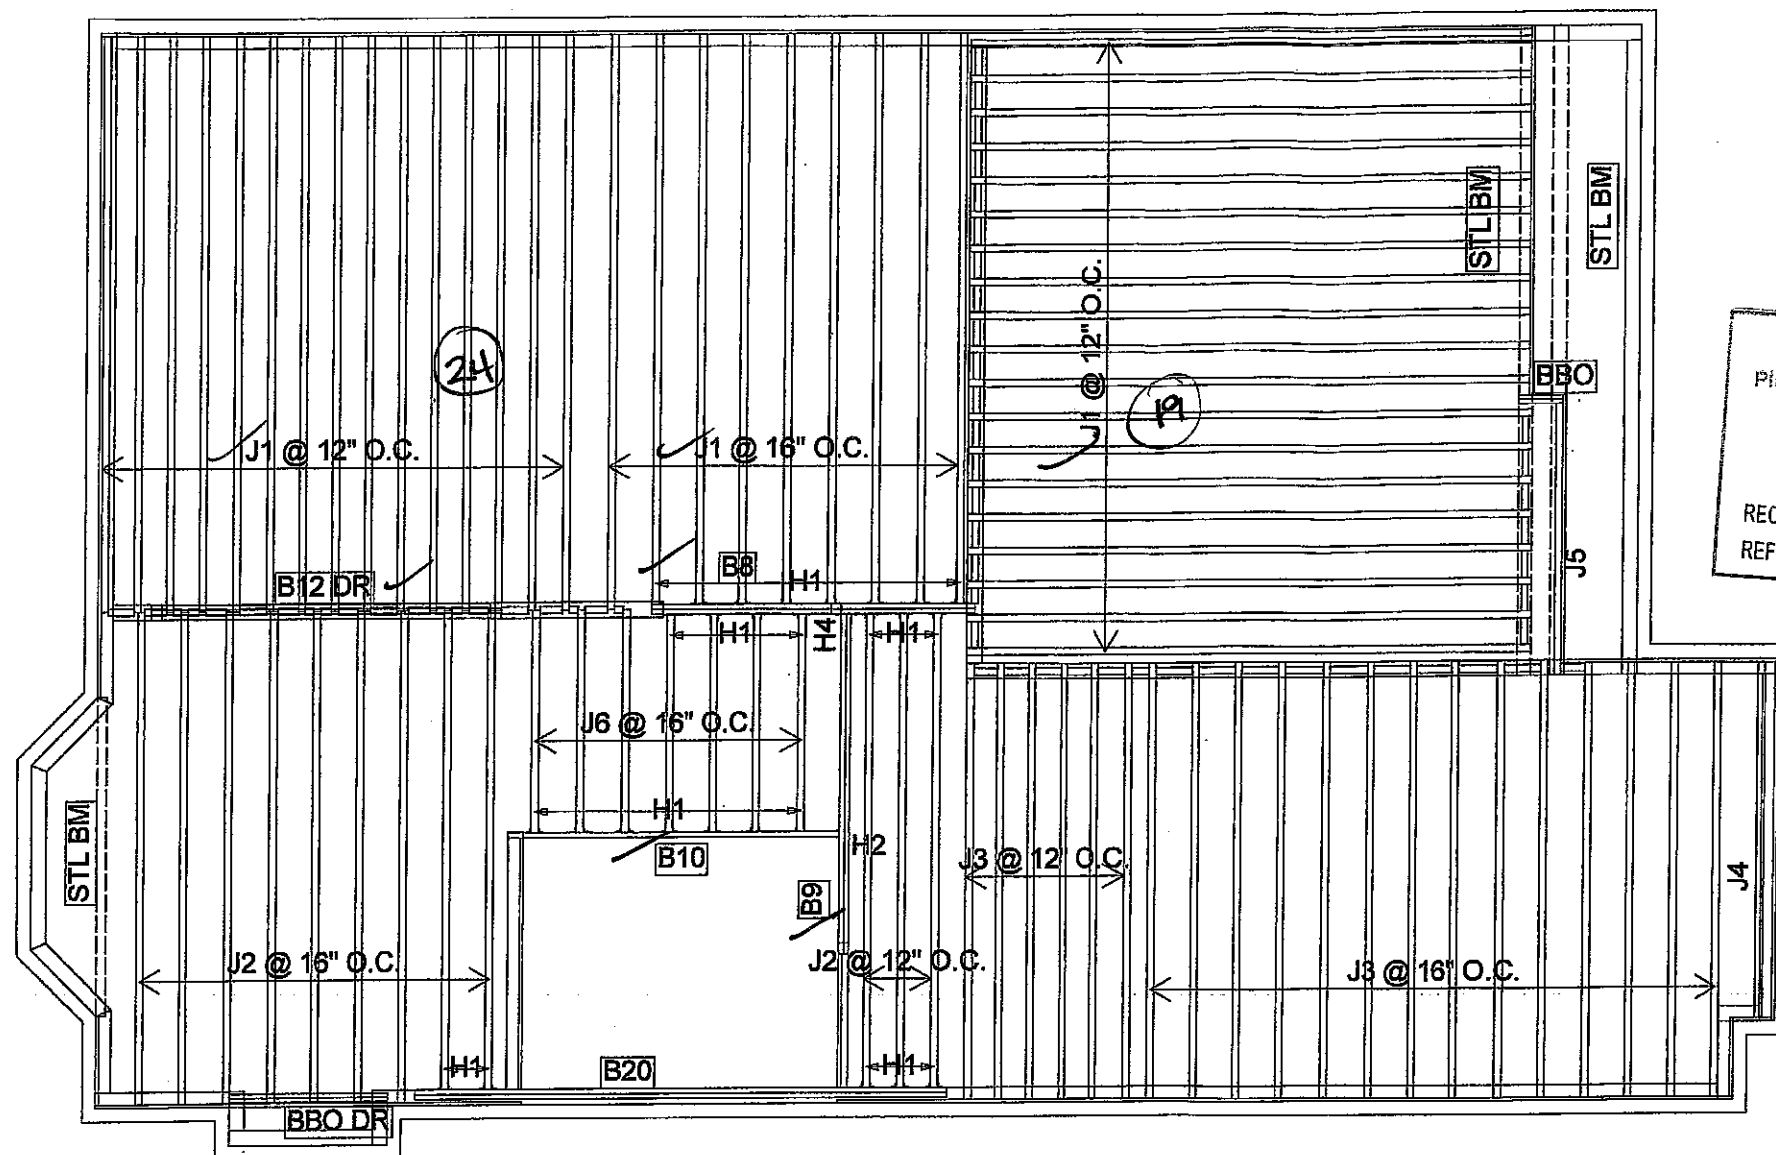


Products					
PlotID	Length	Product	Plies	Net Qty	Fab Type
J1	18-00-00	11 7/8" NI-40x	1	43	MFD
J2	16-00-00	11 7/8" NI-40x	1	12	MFD
J3	14-00-00	11 7/8" NI-40x	1	20	MFD
J4	12-00-00	11 7/8" NI-40x	1	1	MFD
J5	10-00-00	11 7/8" NI-40x	1	1	MFD
J6	8-00-00	11 7/8" NI-40x	1	7	MFD
B12 DR	12-00-00	1-3/4" x 9-1/2" VERSA-LAM@ 2.0 3100 SP	3	3	MFD
B20	16-00-00	1-3/4" x 11-7/8" VERSA-LAM@ 2.0 3100 SP	2	2	MFD
B9	12-00-00	1-3/4" x 11-7/8" VERSA-LAM@ 2.0 3100 SP	2	2	MFD
B10	10-00-00	1-3/4" x 11-7/8" VERSA-LAM@ 2.0 3100 SP	1	1	MFD
B8	10-00-00	1-3/4" x 11-7/8" VERSA-LAM@ 2.0 3100 SP	2	2	MFD

Connector Summary		
Qty	Manuf	Product
7	H1	IUS2.56/11.88
20	H1	IUS2.56/11.88
1	H2	HUS1.81/10
1	H4	HGUS410

DATE: Nov 6/2020
FOR CHIEF BUILDING OFFICIAL
These drawings and/or specifications have been reviewed by
THE OWNER AND/OR CONTRACTOR SHALL COMPLY WITH
THE ONTARIO BUILDING CODE AND ALL OTHER APPLICABLE LAW
THESE STAMPED DRAWINGS SHALL BE AVAILABLE ON SITE
Permit No. 187682

CITY OF HAMILTON
Building Division

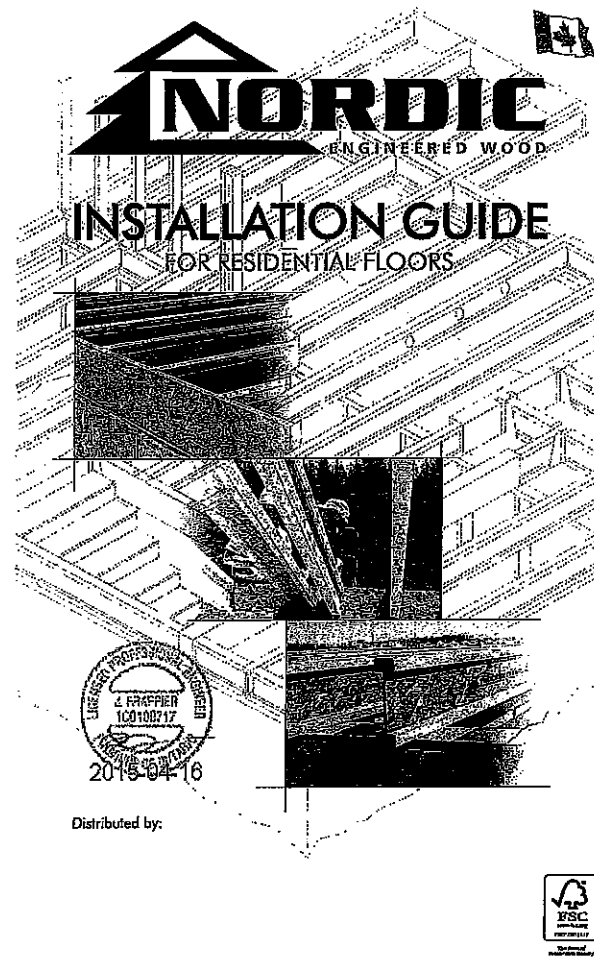

SAFETY AND CONSTRUCTION PRECAUTIONS



Do not walk on I-joists until fully fastened and braced, or serious injuries can result.



Never stack building materials over unfastened I-joists. Once sheathed, do not over-stress I-joist with concentrated loads from building materials.

Improper storage or installation, failure to follow applicable building codes, failure to follow span ratings for Nordic I-joists, failure to follow allowable hole sizes and locations, or failure to use web stiffeners when required can result in serious accidents. Follow these installation guidelines carefully.

WARNING


I-joists are not stable until completely installed, and will not carry any load until fully braced and sheathed.

Avoid Accidents by Following these Important Guidelines:

1. Brace and nail each I-joist as it is installed, using hangers, blocking panels, rim board, and/or cross-briding of joist ends. When I-joists are applied continuously over interior supports and a load-bearing wall is planned at that location, blocking will be required at the interior support.
2. When the building is completed, the floor sheathing will provide lateral support for the top flanges of the I-joists. Until this sheathing is applied, temporary bracing, often called *struts*, or temporary sheathing must be applied to prevent I-joist rollover or buckling.
 - Temporary bracing or struts must be 1x4 inch minimum, at least 8 feet long and spaced no more than 8 feet on center, and must be secured with a minimum of two 2-1/2" nails fastened to the top surface of each I-joist. Nail the bracing to a lateral restraint at the end of each bay. Lap ends of adjoining bracing over at least two I-joists.
 - Or, sheathing (temporary or permanent) can be nailed to the top flange of the first 4 feet of I-joists at the end of the bay.
3. For cantilevered I-joists, brace top and bottom flanges, and brace ends with diaphragm panels, rim board, or cross-briding.
4. Install and fully nail permanent sheathing to each I-joist before placing loads on the floor system. Then, stack building materials over beams or walls only.
5. Never install a damaged I-joist.

STORAGE AND HANDLING GUIDELINES

1. Bundle wrap can be slippery when wet. Avoid walking on wrapped bundles.
2. Store, stock, and handle I-joists vertically and level only.
3. Always stack and handle I-joists in the upright position only.
4. Do not store I-joists in direct contact with the ground and/or flatwise.
5. Protect I-joists from weather, and use spacers to separate bundles.
6. Bundled units should be kept intact until time of installation.
7. When handling I-joists with a crane on the job site, take a few simple precautions to prevent damage to the I-joists and injury to your work crew.
 - Pick I-joists in bundles as shipped by the supplier.
 - Orient the bundles so that the webs of the I-joists are vertical.
 - Pick the bundles at the 5th points, using a spreader bar if necessary.
8. Do not handle I-joists in a horizontal orientation.
9. NEVER USE OR TRY TO REPAIR A DAMAGED I-JOIST

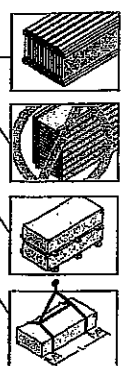

MAXIMUM FLOOR SPANS


1. Maximum clear spans applicable to single-span or multiple-span residential floor construction with a design live load of 40 psf and dead load of 15 psf. The ultimate limit states are based on the factored loads of 1.50L + 1.25D. The serviceability limit states include the consideration for floor vibration and a live load deflection limit of L/460. For multiple-span applications, the end spans shall be 40% or more of the adjacent span.
2. Spans are based on a composite floor with glued-nailed oriented strand board (OSB) sheathing with a minimum thickness of 5/8 inch for a joist spacing of 19.2 inches or less, or 3/4 inch for joist spacing of 24 inches. Adhesive shall meet the requirements given in CGS-71.26 Standard. No concrete topping or bridging element was assumed. Increased spans may be achieved with the use of gypsum and/or a row of blocking at mid-span.
3. Minimum bearing length shall be 1-3/4 inches for the end bearings, and 3-1/2 inches for the intermediate bearings.
4. Bearing stiffeners are not required when I-joists are used with the spans and spacings given in this table, except as required for hangers.
5. This span chart is based on uniform loads. For applications with other than uniform loads, an engineering analysis may be required based on the use of the design properties.
6. Tables are based on Limit States Design per CAN/CSA C308-09 Standard, and NRC 2010.
7. SI units conversion: 1 inch = 25.4 mm
1 foot = 0.305 m

MAXIMUM FLOOR SPANS FOR NORDIC I-JOISTS


Joist Depth	Joist Series	Simple spans				Multiple spans			
		On centre spacing				On centre spacing			
		12"	16"	18"	24"	12"	16"	18"	24"

CANTILEVER DETAILS FOR BALCONIES (NO WALL LOAD)

3a I-JOIST CANTILEVER DETAIL FOR BALCONIES (No Wall Load)

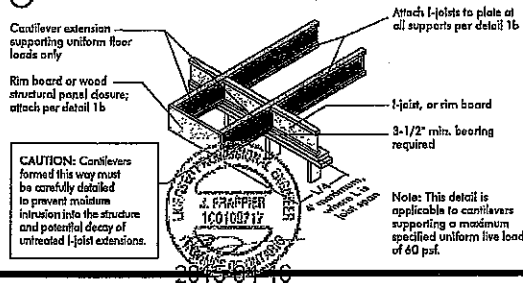


3b LUMBER CANTILEVER DETAIL FOR BALCONIES (No Wall Load)

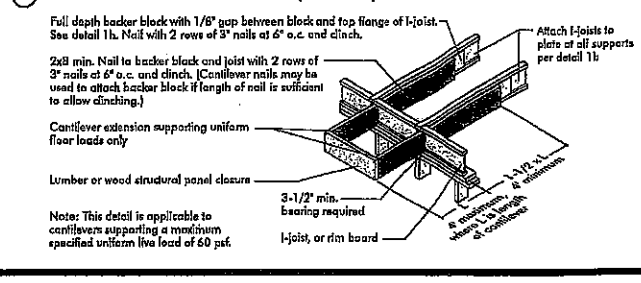

CANTILEVER DETAILS FOR VERTICAL BUILDING OFFSET (CONCENTRATED WALL LOAD)

4a Method 1—SHEATHING REINFORCEMENT ONE SIDE

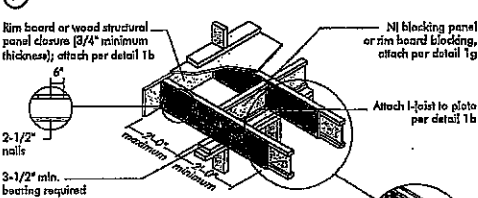

Method 2—SHEATHING REINFORCEMENT TWO SIDES

- Use same installation as Method 1 but reinforce both sides of I-joist with sheathing.
- Use nailing pattern shown for Method 1 with opposite face nailing offset by 3".

Note: Canadian softwood plywood sheathing or equivalent (minimum thickness 3/4") required on sides of joist. Depth shall match the full height of the joist. Nail with 2-1/2" nails at 6" o.c., top and bottom flange. Install with face grain horizontal. Attach I-joist to plate at all supports per detail 1b. Verify reinforced I-joist capacity.

4b Alternative Method 2—DOUBLE I-JOIST


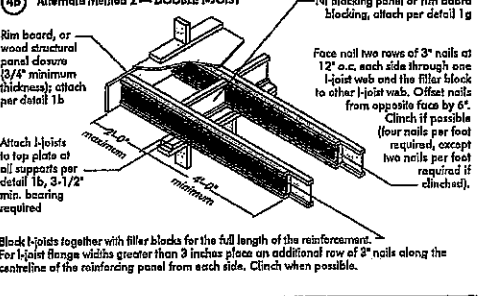


FIGURE 4 (continued)

See table below for NI reinforcement requirements of cantilever.

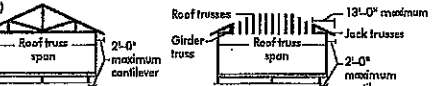

For hip roofs with the jack trusses running parallel to the cantilevered floor joists, the I-joist reinforcement requirements for a span of 26 ft. shall be permitted to be used.


CANTILEVER REINFORCEMENT METHODS ALLOWED

JOIST DEPTH (in.)	ROOF TRUSS SPAN (ft)	ROOF LOADING (UNFACTORED)							
		LL = 30 psf, DL = 15 psf				LL = 50 psf, DL = 15 psf			
		12	16	20	24	12	16	20	24
12	N	N	N	1	2	N	N	1	2
14	N	N	N	1	2	N	N	1	2
1. N = No reinforcement required.
- 1 = NI reinforced with 3/4" wood structural panel on one side only.
- 2 = NI reinforced with 3/4" wood structural panel on both sides, or double I-joist.
- X = Try a deeper joist or closer spacing.
2. Maximum design load shall be: 15 psf roof dead load, 55 psf floor total load, and 80 psf wall load. Wall load is based on 9'-0" maximum width window or door opening.
3. For larger openings, or multiple 3'-0" wide openings spaced less than 6'-0" o.c., additional joints beneath the opening's eave studs may be required.
4. For conventional roof construction using a ridge beam, the Roof Truss Span column above is equivalent to the distance between the supporting wall and the ridge beam. When the roof is framed using a ridge beam, the Roof Truss Span is equivalent to the distance between the supporting walls as if a truss is used.
5. Cantilevered joists supporting girder trusses or roof beams may require additional reinforcing.

BRICK CANTILEVER DETAILS FOR VERTICAL BUILDING OFFSET (CONCENTRATED WALL LOAD)

5a SHEATHING REINFORCEMENT

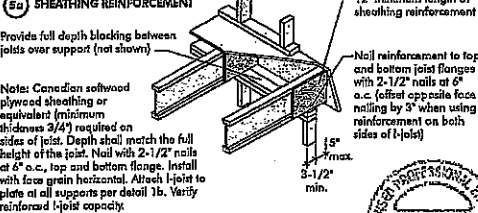

5b SET-BACK DETAIL

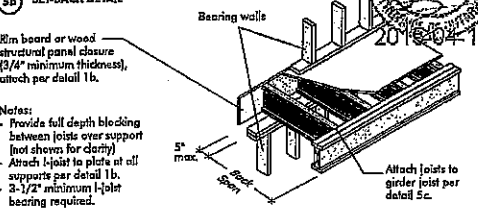

5c SET-BACK CONNECTION


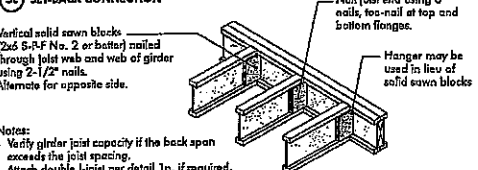


FIGURE 5 (continued)

See table below for NI reinforcement requirements of cantilever.

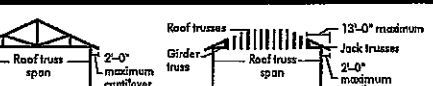

For hip roofs with the jack trusses running parallel to the cantilevered floor joists, the I-joist reinforcement requirements for a span of 26 ft. shall be permitted to be used.

BRICK CANTILEVER REINFORCEMENT METHODS ALLOWED

JOIST DEPTH (in.)	ROOF TRUSS SPAN (ft)	ROOF LOADING (UNFACTORED)							
		LL = 30 psf, DL = 15 psf				LL = 50 psf, DL = 15 psf			
		12	16	20	24	12	16	20	24
12	N	N	N	1	2	N	N	1	2
14	N	N	N	1	2	N	N	1	2
1. N = No reinforcement required.
- 1 = NI reinforced with 3/4" wood structural panel on one side only.
- 2 = NI reinforced with 3/4" wood structural panel on both sides, or double I-joist.
- X = Try a deeper joist or closer spacing.
2. Maximum design load shall be: 15 psf roof dead load, 55 psf floor total load, and 80 psf wall load. Wall load is based on 9'-0" maximum width window or door opening.
3. For larger openings, or multiple 3'-0" wide openings spaced less than 6'-0" o.c., additional joints beneath the opening's eave studs may be required.
4. For conventional roof construction using a ridge beam, the Roof Truss Span column above is equivalent to the distance between the supporting wall and the ridge beam. When the roof is framed using a ridge beam, the Roof Truss Span is equivalent to the distance between the supporting walls as if a truss is used.
5. Cantilevered joists supporting girder trusses or roof beams may require additional reinforcing.

WEB HOLES

RULES FOR CUTTING HOLES AND DUCT CHASE OPENINGS:

1. The distance between the inside edge of the support and the centerline of any hole or duct chase opening shall be in compliance with the requirements of Table 1 or 2, respectively.
2. I-joist top and bottom flanges must NEVER be cut, notched, or otherwise modified.
3. Whenever possible, field-cut holes should be centered on the middle of the web.
4. The maximum size hole or the maximum depth of a duct chase opening that can be cut into an I-joist web shall equal the clear distance between the flanges of the I-joist minus 1/4 inch. A minimum of 1/8 inch should always be maintained between the top or bottom of the hole or opening and the adjacent I-joist flange.
5. The sides of square holes or longest sides of rectangular holes should not exceed 3/4 of the diameter of the maximum round hole permitted at the location.
6. Where more than one hole is necessary, this distance between adjacent hole edges shall exceed twice the diameter of the largest round hole or twice the size of the largest square hole (or twice the length of the longest side of the longest rectangular hole or duct chase opening) and each hole and duct chase opening shall be sized and located in compliance with the requirements of Tables 1 and 2, respectively.
7. A knockout is not considered a hole, may be utilized anywhere it occurs, and may be ignored for purposes of calculating minimum distances between holes and/or duct chase openings.
8. Holes measuring 1-1/2 inches or smaller shall be permitted anywhere in a cantilevered section of a joist. Holes of greater size may be permitted subject to verification.
9. A 1-1/2 inch hole or smaller can be placed anywhere in the web provided that it meets the requirements of rule number 6 above.
10. All holes and duct chase openings shall be cut in a workman-like manner in accordance with the restrictions listed above and as illustrated in Figure 7.
11. Limit three maximum size holes per span, of which one may be a duct chase opening.
12. A group of round holes at approximately the same location shall be permitted if they meet the requirements for a single round hole circumscribed around them.

FIGURE 7 FIELD-CUT HOLE LOCATOR

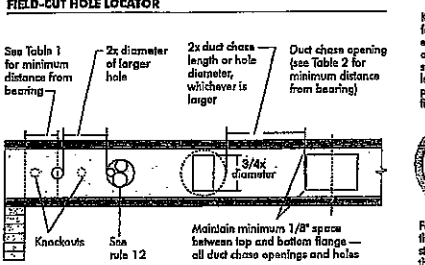

A knockout is NOT considered a hole, may be utilized wherever it occurs and may be ignored for purposes of calculating minimum distances between holes.

TABLE 1 LOCATION OF CIRCULAR HOLES IN JOIST WEBS Simple or Multiple Span for Dead Loads up to 15 psf and Live Loads up to 40 psf


1. Above table may be used for I-joist spacing of 24 inches on center or less.
2. Hole location distance is measured from inside face of supports to center of hole.
3. Distances in this chart are based on uniformly loaded joists.

OPTIONAL:

The above table is based on the I-joists used at their maximum span, if the I-joists are placed at less than their full maximum span (see Maximum Span table), the minimum distance from the centerline of the hole to the face of any support (D) as given above may be reduced as follows:

D reduced = $\frac{\text{Actual span}}{\text{Maximum span}} \times D$

Where: D reduced = Distance from the inside face of any support to center of hole, reduced for less-than-maximum span application (D is the minimum distance from the centerline of the hole to the face of any support as given above may be reduced as follows).

Actual = The actual measured span between the inside faces of supports (S).

SAF = Span Adjustment Factor given in this table.

D = The minimum distance from the inside face of any support to center of hole from this table.

If D reduced is greater than 1, use 1 in the above calculation for D reduced.

TABLE 2 DUCT CHASE OPENING SIZES AND LOCATIONS—Simple Span Only


1. Above table may be used for I-joist spacing of 24 inches on center or less.
2. Duct chase opening location distance is measured from inside face of supports to center of opening.
3. The above table is based on simple span joists only. For other applications, consult your local distributor.
4. Distances are based on uniformly loaded joists that meet the span requirements for design live load of 40 psf and dead load of 15 psf, and a live load deflection limit of L/480. For other applications, consult your local distributor.

INSTALLING THE GLUED FLOOR SYSTEM

1. Wipe any mud, dirt, water, or ice from I-joist flanges before gluing.
2. Snap a chalk line across the I-joists four feet in from the wall for panel edge alignment and as a boundary for spreading glue.
3. Spread only enough glue to lay one or two panels at a time, or follow specific recommendations from the glue manufacturer.
4. Lay the first panel with tongue side to the wall, and nail in place. This protects the tongue of the next panel from damage when lapped into place with a block and sledgehammer.
5. Apply a continuous line of glue (about 1/4-inch diameter) to the top flange of a single I-joist. Apply glue in a winding pattern on wide areas, such as with double I-joists.
6. Apply two lines of glue on I-joists where panel ends butt to assure proper gluing of each end.
7. After the first row of panels is in place, spread glue in the groove of one or two panels at a time before laying the next row. Glue may be continuous or spread, but avoid squeeze-out by applying a thinner line (1/8 inch) than used on I-joist flanges.
8. Tap the second row of panels into place, using a block to protect groove edges.
9. Stagger and joints in each succeeding row of panels. A 1/8-inch space between all end joints and 1/8-inch of all edges, including T&G edges, is recommended. Use a spacer tool or an 2-1/2" common nail to assure accurate and consistent spacing.
10. Complete all nailing of each panel before glue sets. Check the manufacturer's recommendations for cure time. (Warm weather accelerates glue setting.) Use 2" ring- or screw-shank nails for panels 3/4-inch thick or less, and 2-1/2" ring- or screw-shank nails for thicker panels. Space nails per the table below. Clear nail spacing may be required by some codes, or for displacement construction. The finished deck can be walked on right away and will carry construction loads without damage to the glue bond.

FASTENERS FOR SHEATHING AND SUBFLOORING(1)

Joist Spacing (in.)	Minimum Panel Thickness (in.)	Nail Size and Type				Maximum Spacing of Fastener (in.)
		Common Wn or Spiral Nails	Ring Threads	Nails or Screws	Staples	
16	5/8	2"	1-3/4"	2"	6"	12"
20	5/8	2"	1-3/4"	2"	6"	12"
24	3/4	2"	1-3/4"	2"	6"	12"


1. Fasteners of sheathing and subflooring shall conform to the above table.
2. Staples shall not be less than 1/16-inch in diameter or thickness, with not less than a 3/8-inch crown with the crown parallel to framing.
3. Flooring screws shall not be less than 1/8-inch in diameter.
4. Special conditions may impose heavy traffic and concentrated loads that require construction in excess of the minimums shown.
5. Use only adhesives conforming to CAN/CSA-71.26 Standard, Adhesives for Field-Gluing Plywood to Lumber Framing for Floor Systems, applied in accordance with the manufacturer's recommendations. If OSB panels with sealed surfaces and edges are to be used, use only solvent-based glues; check with panel manufacturer.

Ref.: NRC-CNRC, National Building Code of Canada 2010, Table 9.23.3.5.


IMPORTANT NOTE: Floor sheathing must be field glued to the I-joist flanges in order to achieve the maximum spans shown in this document. If sheathing is nailed only, I-joist spans must be verified with your local distributor.

RIM BOARD INSTALLATION DETAILS

8a ATTACHMENT DETAILS WHERE RIM BOARDS ABUT

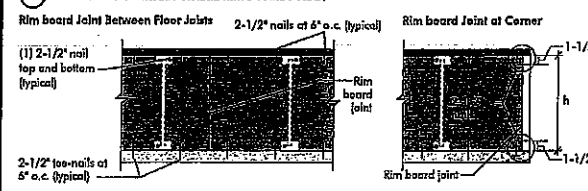

8b TOE-NAIL CONNECTION AT RIM BOARD

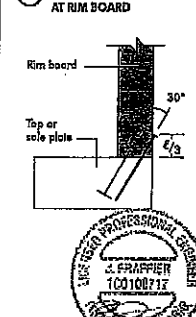

Refer to the Installation Guide for Residential Floors for additional information.
CCMC EVALUATION REPORT 13032-R

WEB HOLE SPECIFICATIONS

RULES FOR CUTTING HOLES AND DUCT CHASE OPENINGS:

- The distance between the inside edge of the support and the centerline of any hole or duct chase opening shall be in compliance with the requirements of Table 1 and 2, respectively.
- I-joist top and bottom flanges must NEVER be cut, notched, or otherwise modified.
- Whenever possible, field-cut holes should be centered on the middle of the web.
- The maximum size hole or the maximum depth of a duct chase opening that can be cut into an I-joist web shall equal the clear distance between the flanges of the I-joist minus 1/4 inch. A minimum of 1/8 inch should always be maintained between the top or bottom of the hole or opening and the adjacent I-joist flange.

- The sides of square holes or longest sides of rectangular holes shall not exceed 3/4 of the diameter of the maximum round hole permitted at that location.
- Where more than one hole is necessary, the distance between adjacent hole edges shall exceed twice the diameter of the largest round hole or twice the size of the largest square hole (or twice the length of the longest side of the largest rectangular hole or duct chase opening) and each hole and duct chase opening shall be sized and located in compliance with the requirements of Tables 1 and 2, respectively.
- A knockout is not considered a hole, may be utilized anywhere it occurs, and may be ignored for purposes of calculating minimum distances between holes and/or duct chase openings.
- Holes measuring 1-1/2 inches or smaller are permitted anywhere in a cantilevered section of a joist. Holes of greater size may be permitted subject to verification.

- A 1-1/2 inch hole or smaller can be placed anywhere in the web provided that it meets the requirements of rule number 6 above.
- All holes and duct chase openings shall be cut in a workman-like manner in accordance with the restrictions listed above and as illustrated in Figure 7.
- Limit three maximum size holes per span, of which one may be a duct chase opening.
- A group of round holes of approximately the same location shall be permitted if they meet the requirements for a single round hole circumscribed around them.

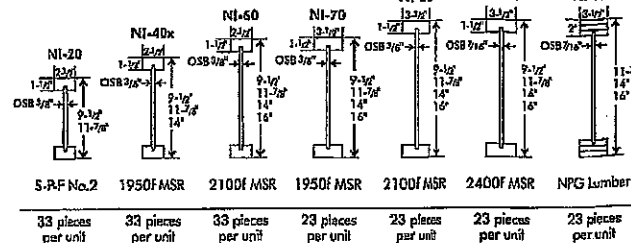


TABLE 1
LOCATION OF CIRCULAR HOLES IN JOIST WEBS
Simple or Multiple Span for Dead Loads up to 15 psf and Live Loads up to 40 psf

Joist Depth	Joist Series	Minimum Distance from Inside Face of Any Support to Centre of Hole (ft - in.)												
		Round Hole Diameter (in.)												
		2	3	4	5	6	8	10	12	14	16	18	20	22
9-1/2"	NI-20	0-7"	1-6"	2-10"	3-8"	4-3"	5-8"	6-0"	---	---	---	---	---	---
	NI-40x	0-7"	1-6"	2-10"	3-8"	4-3"	5-8"	6-0"	---	---	---	---	---	---
	NI-60	1-3"	2-6"	3-4"	4-4"	5-4"	7-0"	7-5"	---	---	---	---	---	---
	NI-70	2-0"	3-4"	4-4"	5-4"	6-3"	8-0"	8-4"	---	---	---	---	---	---
	NI-80	2-3"	3-6"	4-6"	5-6"	6-6"	8-2"	8-8"	---	---	---	---	---	---
11-7/8"	NI-20	0-7"	0-8"	1-0"	2-4"	3-8"	4-0"	5-0"	6-4"	7-5"	---	---	---	---
	NI-40x	0-7"	0-8"	1-0"	2-4"	3-8"	4-0"	5-0"	6-4"	7-5"	---	---	---	---
	NI-60	0-7"	1-6"	2-6"	3-6"	4-6"	6-0"	7-0"	8-10"	10-0"	---	---	---	---
	NI-70	1-3"	2-6"	3-6"	4-6"	5-6"	7-0"	8-0"	9-10"	11-2"	---	---	---	---
	NI-80	1-6"	2-10"	3-10"	4-10"	5-10"	7-5"	8-5"	10-5"	12-5"	---	---	---	---
14"	NI-20	0-7"	0-8"	1-0"	2-4"	3-8"	4-0"	5-0"	6-4"	7-5"	---	---	---	---
	NI-40x	0-7"	0-8"	1-0"	2-4"	3-8"	4-0"	5-0"	6-4"	7-5"	---	---	---	---
	NI-60	0-7"	1-6"	2-6"	3-6"	4-6"	6-0"	7-0"	8-10"	10-0"	---	---	---	---
	NI-70	1-3"	2-6"	3-6"	4-6"	5-6"	7-0"	8-0"	9-10"	11-2"	---	---	---	---
	NI-80	1-6"	2-10"	3-10"	4-10"	5-10"	7-5"	8-5"	10-5"	12-5"	---	---	---	---
16"	NI-20	0-7"	0-8"	1-0"	2-4"	3-8"	4-0"	5-0"	6-4"	7-5"	---	---	---	---
	NI-40x	0-7"	0-8"	1-0"	2-4"	3-8"	4-0"	5-0"	6-4"	7-5"	---	---	---	---
	NI-60	0-7"	1-6"	2-6"	3-6"	4-6"	6-0"	7-0"	8-10"	10-0"	---	---	---	---
	NI-70	1-3"	2-6"	3-6"	4-6"	5-6"	7-0"	8-0"	9-10"	11-2"	---	---	---	---
	NI-80	1-6"	2-10"	3-10"	4-10"	5-10"	7-5"	8-5"	10-5"	12-5"	---	---	---	---



- Above table may be used for I-joist spacing of 24 inches on center or less.
- Hole location distance is measured from inside face of supports to center of opening.
- Distances in this chart are based on uniformly loaded joists.
- The above table is based on the I-joists being used at their maximum spans. The minimum distance as given above may be reduced for shorter spans; contact your local distributor.

TABLE 2
DUCT CHASE OPENING SIZES AND LOCATIONS
Simple Span Only

Joist Depth	Joist Series	Minimum distance from inside face of supports to centre of opening (ft - in.)												
		Duct Chase Length (in.)												
		8	10	12	14	16	18	20	22	24				
9-1/2"	NI-20	4-1"	4-6"	4-10"	5-4"	5-8"	6-1"	6-6"	7-1"	7-5"				
	NI-40x	5-3"	5-8"	6-0"	6-5"	7-1"	7-3"	7-8"	8-2"	8-6"				
	NI-60	5-4"	5-9"	6-2"	6-7"	7-1"	7-5"	8-0"	8-3"	8-9"				
	NI-70	5-1"	5-5"	5-10"	6-3"	6-7"	7-1"	7-6"	8-1"	8-4"				
	NI-80	5-5"	5-9"	6-0"	6-5"	7-0"	7-3"	7-8"	8-2"	8-6"				
11-7/8"	NI-20	5-0"	5-2"	6-4"	7-1"	7-5"	7-9"	8-3"	8-9"	9-4"				
	NI-40x	6-8"	7-2"	7-4"	8-1"	8-4"	9-1"	9-6"	10-1"	10-9"				
	NI-60	7-3"	7-8"	8-0"	8-6"	9-0"	9-3"	9-9"	10-3"	11-0"				
	NI-70	7-1"	7-4"	7-9"	8-3"	8-7"	9-1"	9-6"	10-1"	10-9"				
	NI-80	7-2"	7-7"	8-0"	8-5"	8-10"	9-3"	9-8"	10-2"	10-8"				
14"	NI-20	7-6"	7-11"	8-4"	8-9"	9-2"	9-7"	10-1"	10-7"	11-1"				
	NI-40x	8-1"	8-7"	9-0"	9-6"	10-1"	10-7"	11-2"	11-8"	12-3"				
	NI-60	8-9"	9-3"	9-8"	10-1"	10-6"	11-1"	11-6"	12-1"	12-6"				
	NI-70	9-7"	9-1"	9-5"	9-9"	10-4"	10-8"	11-2"	11-7"	12-3"				
	NI-80	9-0"	9-3"	9-9"	10-1"	10-7"	11-1"	11-6"	12-1"	12-6"				
16"	NI-20	9-2"	9-6"	10-0"	10-6"	10-11"	11-5"	11-9"	12-4"	12-11"				
	NI-40x	9-4"	9-8"	10-3"	10-7"	11-1"	11-7"	12-1"	12-7"	13-2"				
	NI-60	10-3"	10-8"	11-2"	11-6"	12-1"	12-6"	13-0"	13-5"	14-1"				
	NI-70	10-1"	10-5"	11-0"	11-4"	11-10"	12-3"	12-8"	13-3"	14-0"				
	NI-80	10-4"	10-9"	11-3"	11-8"	12-1"	12-7"	13-1"	13-6"	14-2"				

- Above table may be used for I-joist spacing of 24 inches on center or less.
- Duct chase opening location distance is measured from inside face of supports to center of opening.
- The above table is based on simple-span joists only. For other applications, contact your local distributor.
- Distances are based on uniformly loaded floor joists that meet the span requirements for a design live load of 40 psf and dead load of 15 psf and a live load deflection limit of L/480.
- The above table is based on the I-joists being used at their maximum spans. The minimum distance as given above may be reduced for shorter spans; contact your local distributor.

FIGURE 7
FIELD-CUT HOLE LOCATOR

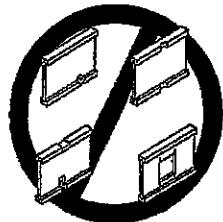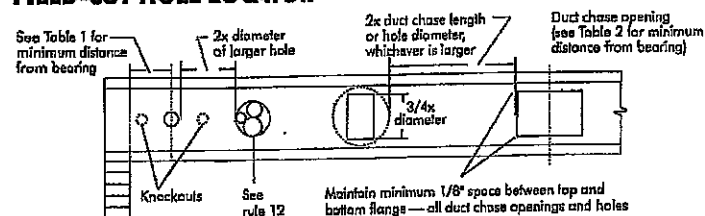

Knockouts are predrilled holes provided for the contractor's convenience to install electrical or small plumbing lines. They are 1-1/2 inches in diameter, and are spaced 15 inches on center along the length of the I-joist. Where possible, it is preferable to use knockouts instead of field-cut holes.

Never drill, cut or notch the flange, or over-cut the web.

Holes in webs should be cut with a sharp saw.

For rectangular holes, avoid over-cutting the corners, as this can cause unnecessary stress concentrations. Slightly rounding the corners is recommended. Starting the rectangular hole by drilling a 1-inch diameter hole in each of the four corners and then making the cuts between the holes is another good method to minimize damage to the I-joist.

SAFETY AND CONSTRUCTION PRECAUTIONS



Do not walk on I-joists until fully fastened and braced, or serious injuries can result.



Never stack building materials over unheated I-joists. Once sheathed, do not over-stress I-joists with concentrated loads from building materials.

WARNING: I-joists are not stable until completely installed, and will not carry any load until fully braced and sheathed.

AVOID ACCIDENTS BY FOLLOWING THESE IMPORTANT GUIDELINES:

- Brace and nail each I-joist as it is installed, using hangers, blocking panels, rim board, and/or cross-briding at joist ends. When I-joists are applied continuously over interior supports and a load-bearing wall is planned at that location, blocking will be required at the interior support.
- When the building is completed, the floor sheathing will provide lateral support for the top flanges of the I-joist. Until this sheathing is applied, temporary bracing, often called snits, or temporary sheathing must be applied to prevent I-joist rollover or buckling.
- Temporary bracing or snits must be 1x4 inch minimum, at least 8 feet long and spaced no more than 8 feet on center, and must be secured with a minimum of two 2-1/2" nails fastened to the top surface of each I-joist. Nail the bracing to a lateral restraint at the end of each bay. Top ends of adjoining bracing over at least two I-joists.
- Or, sheathing (temporary or permanent) can be nailed to the top flange of the first 4 feet of I-joists at the end of the bay.
- For cantilevered I-joists, brace top and bottom flanges, and brace ends with closure panels, rim board, or cross-briding.
- Install and fully nail permanent sheathing to each I-joist before placing loads on the floor system. Then, stack building materials over beams or walls only.
- Never install a damaged I-joist.




Improper storage or installation, failure to follow applicable building codes, failure to follow span ratings for Nordic I-joists, failure to follow allowable hole sizes and locations, or failure to use web stiffeners when required can result in serious accidents. Follow these installation guidelines carefully.








PRODUCT WARRANTY





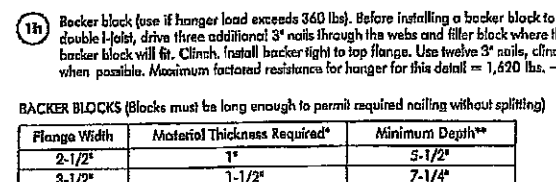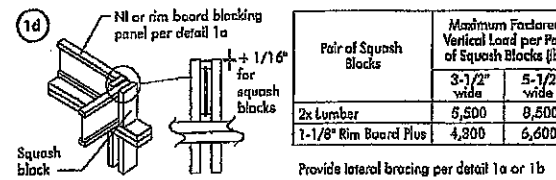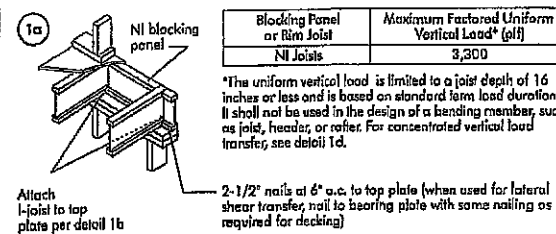

* Minimum grade for backer block material shall be S-P-F No. 2 or better for solid sawn lumber and wood structural panels conforming to CAN/CSA-C325 or CAN/CSA-C437 Standard.
** For face-mount hangers use net joist depth minus 3-1/4" for joists with 1-1/2" thick flanges. For 2" thick flanges use net depth minus 4-1/4".

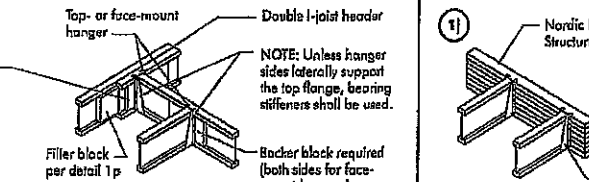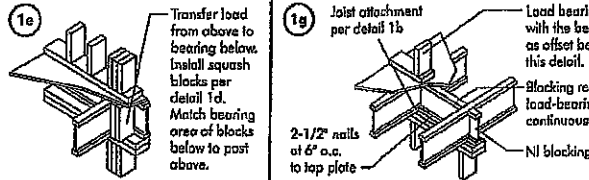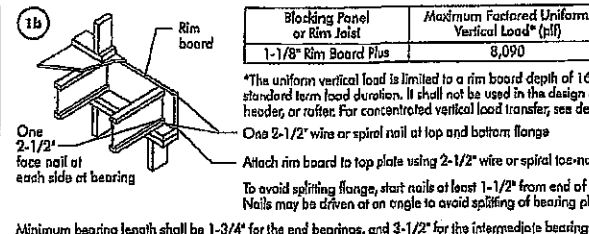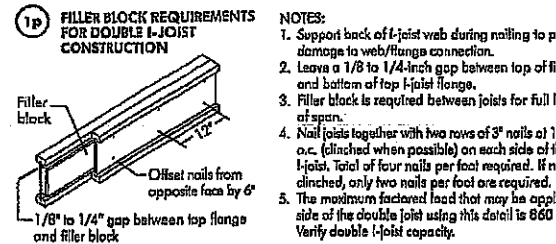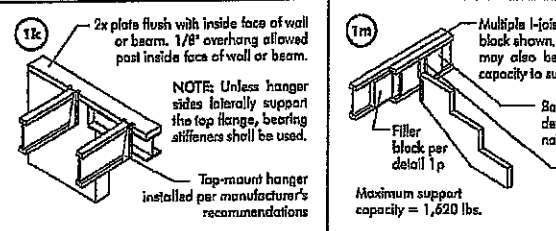

* Minimum grade for backer block material shall be S-P-F No. 2 or better for solid sawn lumber and wood structural panels conforming to CAN/CSA-C325 or CAN/CSA-C437 Standard.
** For face-mount hangers use net joist depth minus 3-1/4" for joists with 1-1/2" thick flanges. For 2" thick flanges use net depth minus 4-1/4".

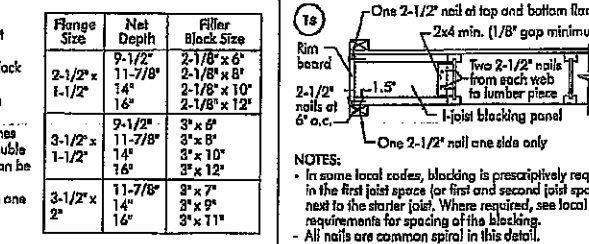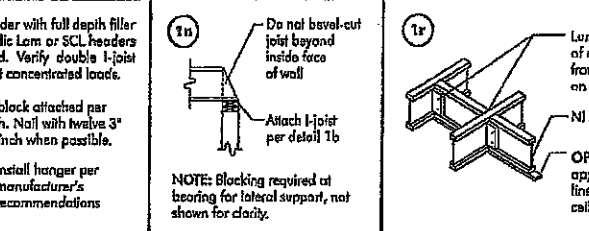


WEB STIFFENERS


RECOMMENDATIONS:

- A bearing stiffener is required in all engineered applications with factored reactions greater than shown in the I-joist properties table found in the I-joist Construction Guide (C101). The gap between the stiffener and the flange is at the top.
- A bearing stiffener is required when the I-joist is supported in a hanger and the sides of the hanger do not extend up to, and support, the top flange. The gap between the stiffener and flange is at the top.
- A load stiffener is required at locations where a factored concentrated load greater than 2,370 lbs is applied to the top flange between supports, or in the case of a cantilever, anywhere between the cantilever tip and the support. These values are for standard term load duration, and may be adjusted for other load durations as permitted by the code. The gap between the stiffener and the flange is at the bottom.


FIGURE 2
WEB STIFFENER INSTALLATION DETAILS

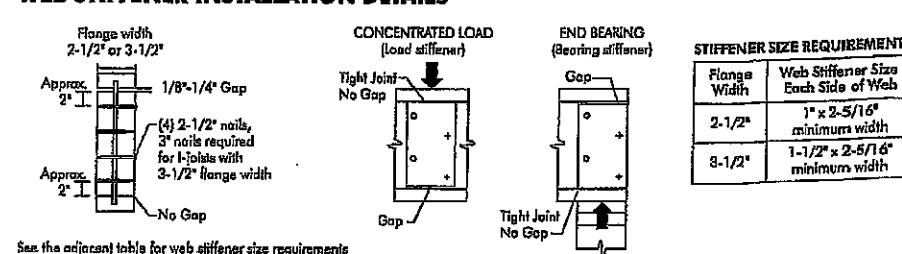

CANTILEVER DETAILS FOR VERTICAL BUILDING OFFSET

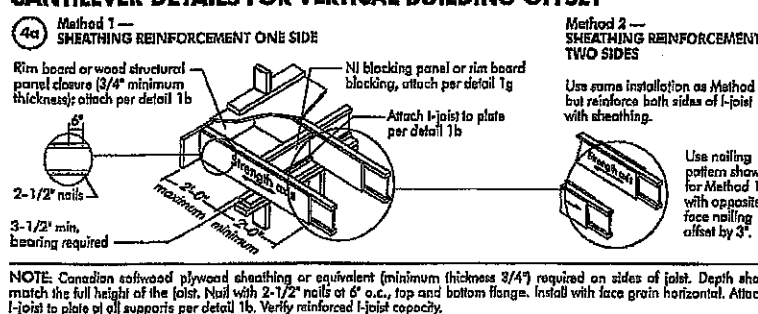

RIM BOARD INSTALLATION DETAILS

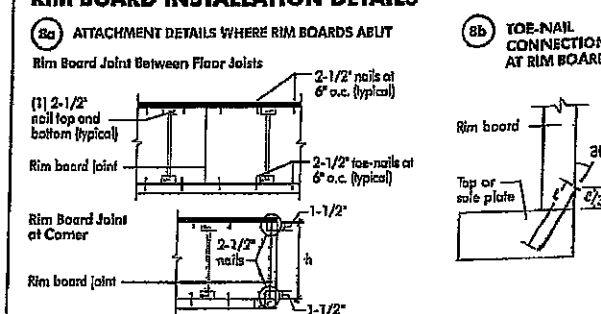



Boise Cascade



Double 1-3/4" x 11-7/8" VERSA-LAM® 2.0 3100 SP

PASSED

1ST FLR FRAMING\Flush Beams\B6(i2804) (Flush Beam)

Dry | 1 span | No cant.

February 19, 2020 10:08:06

BC CALC® Member Report

Build 7239

Job name:

Address:

City, Province, Postal Code: WATERDOWN

Customer:

Code reports: CCMC 12472-R


File name: VALLEYCREEK 4 EL 1.mmdl

Description: 1ST FLR FRAMING\Flush Beams\B6(i2804)

Specifier:

Designer: AJ

Company:

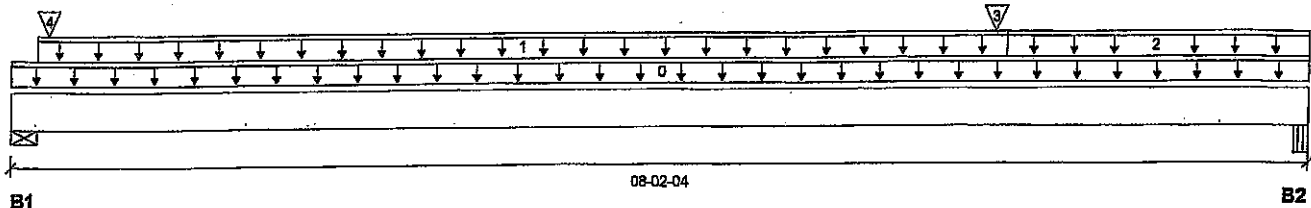

Total Horizontal Product Length = 08-02-04

Reaction Summary (Down / Uplift) (lbs)

Bearing	Live	Dead	Snow	Wind
B1, 3-3/4"	712 / 0	418 / 0		
B2, 2-5/8"	584 / 0	348 / 0		

Load Summary

Tag	Description	Load Type	Ref.	Start	End	Loc.	Live	Dead	Snow	Wind	Tributary
0	Self-Weight	Unf. Lin. (lb/ft)	L	00-00-00	08-02-04	Top	1.00	0.65	1.00	1.15	00-00-00
1	FC2 Floor Material	Unf. Lin. (lb/ft)	L	00-02-00	06-03-08	Top	53	27			n/a
2	FC2 Floor Material	Unf. Lin. (lb/ft)	L	06-03-08	08-02-04	Top	29	15			n/a
3	B4(i2757)	Conc. Pt. (lbs)	L	06-02-10	06-02-10	Top	534	277			n/a
4	B2(i2070)	Conc. Pt. (lbs)	L	00-02-14	00-02-14	Top	380	200			n/a

Controls Summary

	Factored Demand	Factored Resistance	Demand/Resistance	Case	Location
Pos. Moment	2231 ft-lbs	35392 ft-lbs	6.3%	1	06-02-10
End Shear	1219 lbs	14464 lbs	8.4%	1	06-11-12
Total Load Deflection	L/999 (0.017")	n/a	n/a	4	04-04-08
Live Load Deflection	L/999 (0.01")	n/a	n/a	5	04-04-08
Max Defl.	0.017"	n/a	n/a	4	04-04-08
Span / Depth	7.9				

Bearing Supports

	Dim. (LxW)	Demand	Demand/Resistance Support	Demand/Resistance Member	Material
B1	Wall/Plate 3-3/4" x 3-1/2"	1590 lbs	19.7%	9.9%	Spruce-Pine-Fir
B2	Beam 2-5/8" x 3-1/2"	1312 lbs	26.7%	11.7%	Unspecified

Notes

Design meets Code minimum (L/240) Total load deflection criteria.

Design meets Code minimum (L/360) Live load deflection criteria.

Calculations assume member is fully braced.

Resistance Factor phi has been applied to all presented results per CSA O86.

BC CALC® analysis is based on Canadian Limit States Design, as per NBCC 2015 and CSA O86.

Design based on Dry Service Condition.


Importance Factor : Normal Part code : Part 9

DWB NO. TAM 5463-20

STRUCTURAL**COMPONENT ONLY****Disclosure**

Use of the Boise Cascade Software is subject to the terms of the End User License Agreement (EULA). Completeness and accuracy of input must be reviewed and verified by a qualified engineer or other appropriate expert to assure its adequacy, prior to anyone relying on such output as evidence of suitability for a particular application. The output here is based on building code-accepted design properties and analysis methods. Installation of Boise Cascade engineered wood products must be in accordance with current Installation Guide and applicable building codes. To obtain Installation Guide or ask questions, please call (800)232-0788 before installation.

CONFORMS TO NBC 2012
 AMENDED 2020
 PROVIDE 3 ROWS OF 3/4" ARDOX SPIRAL NAILS @ 8" O/C FOR MULTI-PLY NAILING. MAINTAIN A MIN. 2" LUMBER EDGE/END DISTANCE. DO NOT USE AIR NAILS

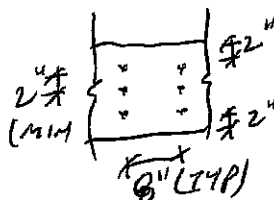

BC CALC®, BC FRAMER®, AJS™, ALLJOIST®, BC RIM BOARD™, BCI®, BOISE GLULAM™, BC FloorValue®, VERSA-LAM®, VERSA-RIM PLUS®.



Single 1-3/4" x 11-7/8" VERSA-LAM® 2.0 3100 SP

PASSED

1ST FLR FRAMING\Flush Beams\B7\I2754) (Flush Beam)

Dry | 1 span | No cant.

February 19, 2020 10:08:06

BC CALC® Member Report

Build 7239

Job name:

Address:

City, Province, Postal Code: WATERDOWN

Customer:

Code reports: CCMC 12472-R


File name: VALLEYCREEK 4 EL 1.mmdl

Description: 1ST FLR FRAMING\Flush Beams\B7\I2754)

Specifier:

Designer: AJ

Company:

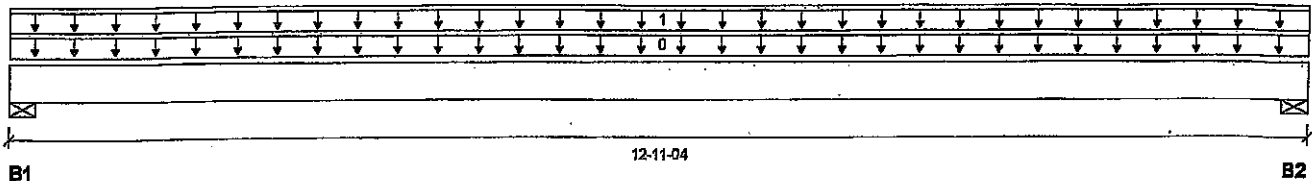

Total Horizontal Product Length = 12-11-04

Reaction Summary (Down / Uplift) (lbs)

Bearing	Live	Dead	Snow	Wind
B1, 1-7/8"	58 / 0	67 / 0		
B2, 4-3/8"	60 / 0	70 / 0		

Load Summary

Tag	Description	Load Type	Ref.	Start	End	Loc.	Live	Dead	Snow	Wind	Tributary
0	Self-Weight	Unf. Lin. (lb/ft)	L	00-00-00	12-11-04	Top	1.00	0.65	1.00	1.15	00-00-00
1	FC2 Floor Material	Unf. Lin. (lb/ft)	L	00-00-00	12-11-04	Top	9	5			n/a

Controls Summary

	Factored Demand	Factored Resistance	Demand/Resistance	Case	Location
Pos. Moment	531 ft-lbs	17696 ft-lbs	3.0%	1	06-04-06
End Shear	141 lbs	7232 lbs	1.9%	1	01-01-12
Total Load Deflection	L/999 (0.023")	n/a	n/a	4	06-04-06
Live Load Deflection	L/999 (0.01")	n/a	n/a	5	06-04-06
Max Defl.	0.023"	n/a	n/a	4	06-04-06
Span / Depth	12.7				

Bearing Supports

	Dim. (LxW)	Demand	Demand/Resistance Support	Demand/Resistance Member	Material
B1	Wall/Plate 1-7/8" x 1-3/4"	172 lbs	8.5%	4.3%	Spruce-Pine-Fir
B2	Wall/Plate 4-3/8" x 1-3/4"	177 lbs	3.8%	1.9%	Spruce-Pine-Fir



DWG NO. TAM 5404-20
STRUCTURAL
COMPONENT ONLY

Notes

Design meets Code minimum (L/240) Total load deflection criteria.

Design meets Code minimum (L/360) Live load deflection criteria.

Calculations assume member is fully braced.

Resistance Factor phi has been applied to all presented results per CSA O86.

BC CALC® analysis is based on Canadian Limit States Design, as per NBCC 2015 and CSA O86.

Design based on Dry Service Condition.

Importance Factor : Normal Part code : Part 9

CONFORMS TO OBC 2012

AMENDED 2020

Disclosure

Use of the Boise Cascade Software is subject to the terms of the End User License Agreement (EULA). Completeness and accuracy of input must be reviewed and verified by a qualified engineer or other appropriate expert to assure its adequacy, prior to anyone relying on such output as evidence of suitability for a particular application. The output here is based on building code-accepted design properties and analysis methods. Installation of Boise Cascade engineered wood products must be in accordance with current Installation Guide and applicable building codes. To obtain Installation Guide or ask questions, please call (800)232-0788 before installation.

BC CALC®, BC FRAMER®, AJS™, ALLJOIST®, BC RIM BOARD™, BCI®, BOISE GLULAM™, BC FloorValue®, VERSA-LAM®, VERSA-RIM PLUS®,

NORDIC STRUCTURES

COMPANY
Feb. 19, 2020 10:27


PROJECT
J2 1ST FLOOR.wwb ✓

Design Check Calculation Sheet Nordic Sizer – Canada 7.2

Loads:

Load	Type	Distribution	Pat- tern	Location [ft] Start End	Magnitude Start End	Unit
Load1	Dead	Full Area			20.00	psf
Load2	Live	Full Area			40.00	psf

Maximum Reactions (lbs) and Support Bearing (in):

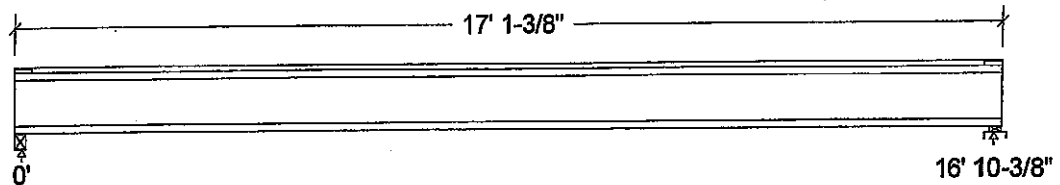


Unfactored:			
Dead	225		225
Live	450		450
Factored:			
Total	956		956
Bearing:			
Capacity			
Joist	2102		2101
Support	-		3971
Des ratio			
Joist	0.45		0.45
Support	-		0.24
Load case	#2		#2
Length	2-3/8		2-3/8
Min req'd	1-3/4		1-3/4
Stiffener	No		No
KD	1.00		1.00
KB support	-		1.00
fcp sup	-		769
Kzcp sup	-		1.09

Nordic Joist 11-7/8" NI-40x Floor joist @ 16" o.c.

Supports: 1 - Steel Beam, W; 2 - Lumber Sill plate, No.1/No.2;
Total length: 17' 1-3/8"; Clear span: 16' 8-5/8"; 3/4" nailed and glued OSB sheathing
This section **PASSES** the design code check.

Limit States Design using CSA-O86-09 and Vibration Criterion:

Criterion	Analysis Value	Design Value	Unit	Analysis/Design
Shear	Vf = 956	Vr = 2336	lbs	Vf/Vr = 0.41
Moment (+)	Mf = 4029	Mr = 6255	lbs-ft	Mf/Mr = 0.64
Perm. Defl'n	0.12 = < L/999	0.56 = L/360	in	0.21
Live Defl'n	0.24 = L/841	0.42 = L/480	in	0.57
Total Defl'n	0.36 = L/560	0.84 = L/240	in	0.43
Bare Defl'n	0.29 = L/695	0.56 = L/360	in	0.52
Vibration	Lmax = 16'-10.4	Lv = 18'-1.3	ft	0.93
Defl'n	= 0.030	= 0.038	in	0.80

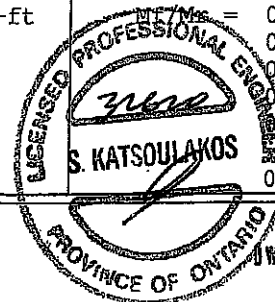

10/1/22
DWG NO. YAM577 -20
STRUCTURAL
COMPONENT ONLY

Additional Data:

FACTORS:	f/E	KD	KH	KZ	KL	KT	KS	KN	LC#
Vr	2336	1.00	1.00	-	-	-	-	-	#2
Mr+	6255	1.00	1.00	-	1.000	-	-	-	#2
EI	371.1 million	-	-	-	-	-	-	-	#2

CRITICAL LOAD COMBINATIONS:

Shear : LC #2 = 1.25D + 1.5L

Moment(+) : LC #2 = 1.25D + 1.5L

Deflection: LC #1 = 1.0D (permanent)

LC #2 = 1.0D + 1.0L (live)

LC #2 = 1.0D + 1.0L (total)

LC #2 = 1.0D + 1.0L (bare joist)

Bearing : Support 1 - LC #2 = 1.25D + 1.5L

Support 2 - LC #2 = 1.25D + 1.5L

Load Types: D=dead W=wind S=snow H=earth,groundwater E=earthquake

L=live(use,occupancy) Ls=live(storage,equipment) f=fire

Load Patterns: s=S/2 L=L+Ls _=no pattern load in this span

All Load Combinations (LCs) are listed in the Analysis output

CALCULATIONS:E_Ieff = 459.76 lb-in² K= 6.18e06 lbs


"Live" deflection is due to all non-dead loads (live, wind, snow...)

CONFORMS TO OBC 2012

AMENDED 2020

Design Notes:

1. WoodWorks analysis and design are in accordance with the 2010 National Building Code of Canada (NBC), Division B, Part 4, and the CSA O86-09 Engineering Design in Wood standard, which includes Update No.1
2. Please verify that the default deflection limits are appropriate for your application.
3. Refer to Nordic Structures technical documentation for installation guidelines and construction details.
4. Nordic I-joists are listed in CCMC evaluation report 13032-R.
5. Joists shall be laterally supported at supports and continuously along the compression edge.
6. The design assumptions and specifications have been provided by the client. Any damages resulting from faulty or incorrect information, specifications, and/or designs furnished, and the correctness or accuracy of this information is their responsibility. This analysis does not constitute a record of the structural integrity of the building nor suitability of the design assumptions made. Nordic Structures is responsible only for the structural adequacy of this component based on the design criteria and loadings shown.

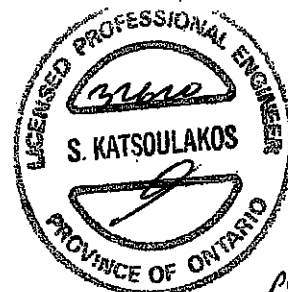

1624
 DWG NO. TAM 5477 -20
 STRUCTURAL
 COMPONENT ONLY



Single 1-3/4" x 11-7/8" VERSA-LAM® 2.0 3100 SP

PASSED

1ST FLR FRAMING\Flush Beams\B1(i2775) (Flush Beam)

Dry | 1 span | No cant.

February 19, 2020 10:08:06

BC CALC® Member Report

Build 7239

Job name:

Address:

City, Province, Postal Code: WATERDOWN

Customer:

Code reports: CCMC 12472-R


File name: VALLEYCREEK 4 EL 1.mmdl

Description: 1ST FLR FRAMING\Flush Beams\B1(i2775)

Specifier:

Designer: AJ

Company:

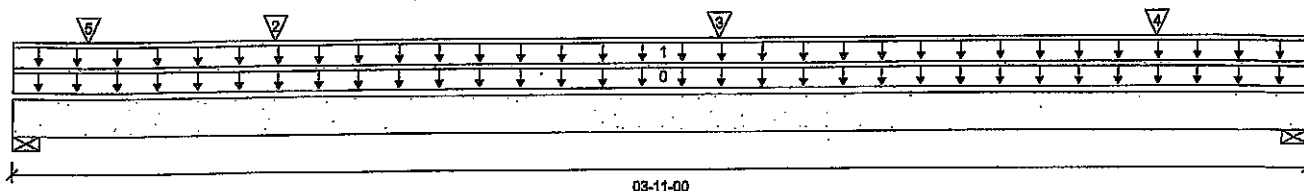

B1

03-11-00

B2

Total Horizontal Product Length = 03-11-00

Reaction Summary (Down / Uplift) (lbs)

Bearing	Live	Dead	Snow	Wind
B1, 5-1/2"	688 / 0	374 / 0		
B2, 3-1/2"	507 / 0	264 / 0		

Load Summary

Tag	Description	Load Type	Ref.	Start	End	Loc.	Live	Dead	Snow	Wind	Tributary
0	Self-Weight	Unf. Lin. (lb/ft)	L	00-00-00	03-11-00	Top	1.00	0.65	1.00	1.15	00-00-00
1	STAIR	Unf. Lin. (lb/ft)	L	00-00-00	03-11-00	Top	120	60			n/a
2	J8(i2787)	Conc. Pt. (lbs)	L	00-09-08	00-09-08	Top	177	88			n/a
3	J8(i2785)	Conc. Pt. (lbs)	L	02-01-08	02-01-08	Top	179	89			n/a
4	J8(i2790)	Conc. Pt. (lbs)	L	03-05-08	03-05-08	Top	177	88			n/a
5	12(i854)	Conc. Pt. (lbs)	L	00-02-12	00-02-12	Top	188	112			n/a

Controls Summary

	Factored Demand	Factored Resistance	Demand/Resistance	Case	Location
Pos. Moment	783 ft-lbs	17696 ft-lbs	4.4%	1	02-01-08
End Shear	446 lbs	7232 lbs	6.2%	1	01-05-06
Total Load Deflection	L/999 (0.002")	n/a	n/a	4	02-00-08
Live Load Deflection	L/999 (0.001")	n/a	n/a	5	02-00-08
Max Defl.	0.002"	n/a	n/a	4	02-00-08
Span / Depth	3.3				

Bearing Supports

	Dim. (LxW)	Demand	Demand/Resistance Support	Demand/Resistance Member	Material
B1	Wall/Plate 5-1/2" x 1-3/4"	1499 lbs	25.3%	12.8%	Spruce-Pine-Fir
B2	Wall/Plate 3-1/2" x 1-3/4"	1090 lbs	28.9%	14.6%	Spruce-Pine-Fir

Notes

Design meets Code minimum (L/240) Total load deflection criteria.

Design meets Code minimum (L/360) Live load deflection criteria.

Calculations assume member is fully braced.

Resistance Factor phi has been applied to all presented results per CSA O86.

BC CALC® analysis is based on Canadian Limit States Design, as per NBCC 2015 and CSA O86.

Design based on Dry Service Condition.

Importance Factor : Normal Part code : Part 9

CONFORMS TO OBC 2012

AMENDED 2020



SWG NO. TAM5478-20
STRUCTURAL
COMPONENT ONLY

Disclosure

Use of the Boise Cascade Software is subject to the terms of the End User License Agreement (EULA). Completeness and accuracy of input must be reviewed and verified by a qualified engineer or other appropriate expert to assure its adequacy, prior to anyone relying on such output as evidence of suitability for a particular application. The output here is based on building code-accepted design properties and analysis methods. Installation of Boise Cascade engineered wood products must be in accordance with current Installation Guide and applicable building codes. To obtain Installation Guide or ask questions, please call (800)232-0788 before installation.

BC CALC®, BC FRAMER®, AJST™, ALLJOIST®, BC RIM BOARD™, BCI®, BOISE GLULAM™, BC FloorValue®, VERSA-LAM®, VERSA-RIM PLUS®,



Single 1-3/4" x 11-7/8" VERSA-LAM® 2.0 3100 SP

PASSED

1ST FLR FRAMING\Flush Beams\B2(i2070) (Flush Beam)

Dry | 1 span | No cant.

February 19, 2020 10:08:06

BC CALC® Member Report

Build 7239

Job name:

Address:

City, Province, Postal Code: WATERDOWN

Customer:

Code reports: CCMC 12472-R


File name: VALLEYCREEK 4 EL 1.mmdl

Description: 1ST FLR FRAMING\Flush Beams\B2(i2070)

Specifier:

Designer: AJ

Company:

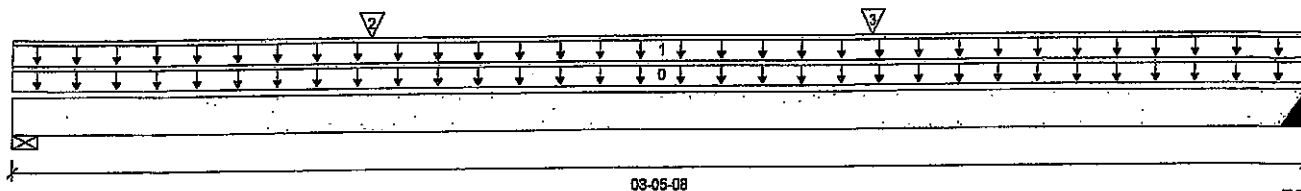

B1

Total Horizontal Product Length = 03-05-08

B2

Reaction Summary (Down / Uplift) (lbs)

Bearing	Live	Dead	Snow	Wind
B1, 3-1/2"	451 / 0	237 / 0		
B2, 2"	391 / 0	206 / 0		

Load Summary

Tag	Description	Load Type	Ref.	Start	End	Loc.	Live	Dead	Snow	Wind	Tributary
0	Self-Weight	Unf. Lin. (lb/ft)	L	00-00-00	03-05-08	Top	1.00	0.65	1.00	1.15	00-00-00
1	STAIR	Unf. Lin. (lb/ft)	L	00-00-00	03-05-08	Top	120	60			n/a
2	J8()	Conc. Pt. (lbs)	L	00-11-08	00-11-08	Top	214	107			n/a
3	J8()	Conc. Pt. (lbs)	L	02-03-08	02-03-08	Top	213	107			n/a

Controls Summary

	Factored Demand	Factored Resistance	Demand/Resistance	Case	Location
Pos. Moment	731 ft-lbs	17696 ft-lbs	4.1%	1	01-11-11
End Shear	539 lbs	7232 lbs	7.5%	1	02-03-10
Total Load Deflection	L/999 (0.002")	n/a	n/a	4	01-09-07
Live Load Deflection	L/999 (0.001")	n/a	n/a	5	01-09-07
Max Defl.	0.002"	n/a	n/a	4	01-09-07
Span / Depth	3.2				

Bearing Supports

	Dim. (LxW)	Demand	Demand/Resistance Support	Demand/Resistance Member	Material
B1	Wall/Plate 3-1/2" x 1-3/4"	973 lbs	25.8%	13.0%	Spruce-Pine-Fir
B2	Hanger 2" x 1-3/4"	843 lbs	n/a	19.7%	HUS1.81/10

Cautions

Header for the hanger HUS1.81/10 at B2 is a Double 1-3/4" x 11-7/8" VERSA-LAM® 1.7 2400 DF. Hanger model HUS1.81/10 and seat length were input by the user. Hanger has not been analyzed for adequate capacity.

Notes

Design meets Code minimum (L/240) Total load deflection criteria.

Design meets Code minimum (L/360) Live load deflection criteria.

Calculations assume member is fully braced.

Hanger Manufacturer: Unassigned

Resistance Factor phi has been applied to all presented results per CSA O86.

BC CALC® analysis is based on Canadian Limit States Design, as per NBCC 2015 and CSA O86.

Design based on Dry Service Condition.

Importance Factor: Normal Part code: Part 9

CONFORMS TO OBC 2012

AMENDED 2020



HWB NO. YAM 5479 -20

STRUCTURAL

COMPONENT ONLY

Disclosure

Use of the Boise Cascade Software is subject to the terms of the End User License Agreement (EULA). Completeness and accuracy of input must be reviewed and verified by a qualified engineer or other appropriate expert to assure its adequacy, prior to anyone relying on such output as evidence of suitability for a particular application. The output here is based on building code-accepted design properties and analysis methods. Installation of Boise Cascade engineered wood products must be in accordance with current Installation Guide and applicable building codes. To obtain Installation Guide or ask questions, please call (800)232-0788 before installation.

BC CALC®, BC FRAMER®, AJS™, ALLJOIST®, BC RIM BOARD™, BCI®, BOISE GLULAM™, BC FloorValue®, VERSA-LAM®, VERSA-RIM PLUS®.



Boise Cascade

**Double 1-3/4" x 11-7/8" VERSA-LAM® 2.0 3100 SP****PASSED****1ST FLR FRAMING\Flush Beams\B3\j2318) (Flush Beam)**

BC CALC® Member Report

Dry | 1 span | No cant.

February 19, 2020 10:08:06

Build 7239

Job name:

File name: VALLEYCREEK 4 EL 1.mmdl

Address:

Description: 1ST FLR FRAMING\Flush Beams\B3\j2318)

City, Province, Postal Code: WATERDOWN

Specifier:


Customer:

Designer: AJ

Code reports:

CCMC 12472-R

Company:

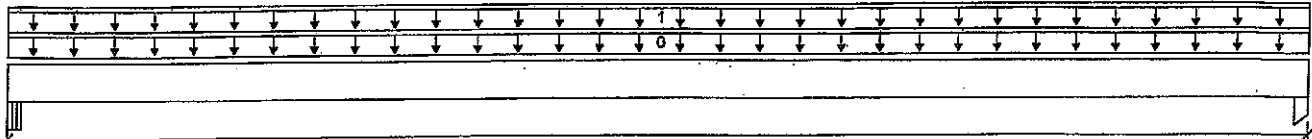

B1

07-05-12

B2

Total Horizontal Product Length = 07-05-12

Reaction Summary (Down / Uplift) (lbs)

Bearing	Live	Dead	Snow	Wind
B1, 2-5/8"	110 / 0	101 / 0		
B2, 1-3/4"	108 / 0	99 / 0		

Load Summary

Tag	Description	Load Type	Ref.	Start	End	Loc.	Live	Dead	Snow	Wind	Tributary
0	Self-Weight	Unf. Lin. (lb/ft)	L	00-00-00	07-05-12	Top	1.00	0.65	1.00	1.15	00-00-00
1	FC2 Floor Material	Unf. Lin. (lb/ft)	L	00-00-00	07-05-12	Top	29	15			n/a

Controls Summary

	Factored Demand	Factored Resistance	Demand/Resistance	Case	Location
Pos. Moment	505 ft-lbs	35392 ft-lbs	1.4%	1	03-09-05
End Shear	198 lbs	14464 lbs	1.4%	1	01-02-08
Total Load Deflection	L/999 (0.004")	n/a	n/a	4	03-09-05
Live Load Deflection	L/999 (0.002")	n/a	n/a	5	03-09-05
Max Defl.	0.004"	n/a	n/a	4	03-09-05
Span / Depth	7.3				

Bearing Supports

	Dim. (LxW)	Demand	Demand/Resistance Support	Demand/Resistance Member	Material
B1	Beam 2-5/8" x 3-1/2"	291 lbs	5.9%	2.6%	Unspecified
B2	Column 1-3/4" x 3-1/2"	285 lbs	5.7%	3.8%	Unspecified

Notes

Design meets Code minimum (L/240) Total load deflection criteria.

Design meets Code minimum (L/360) Live load deflection criteria.

Calculations assume member is fully braced.

Resistance Factor phi has been applied to all presented results per CSA O86.

BC CALC® analysis is based on Canadian Limit States Design, as per NBCC 2015 and CSA O86.

Design based on Dry Service Condition.

Importance Factor : Normal Part code : Part 9


CONFORMS TO OBC 2012

AMENDED 2020

DWG NO. YAM 5480-20
STRUCTURALCOMPONENT ONLY
Disclosure

Use of the Boise Cascade Software is subject to the terms of the End User License Agreement (EULA). Completeness and accuracy of input must be reviewed and verified by a qualified engineer or other appropriate expert to assure its adequacy, prior to anyone relying on such output as evidence of suitability for a particular application. The output here is based on building code-accepted design properties and analysis methods. Installation of Boise Cascade engineered wood products must be in accordance with current Installation Guide and applicable building codes. To obtain Installation Guide or ask questions, please call (800)232-0788 before installation.

BC CALC®, BC FRAMER®, AJS™, ALLJOIST®, BC RIM BOARD™, BC®, BOISE GLULAM™, BC FloorValue®, VERSA-LAM®, VERSA-RIM PLUS®.

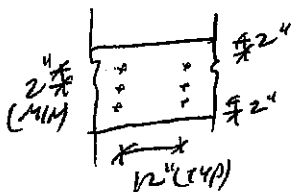

PROVIDE 2 ROWS OF 3/4" ARDOX SPIRAL NAILS @ 12" O/C FOR MULTI-PLY NAILING. MAINTAIN A MIN. 2" LUMBER EDGE/END DISTANCE. DO NOT USE AIR NAILS



Boise Cascade

**Single 1-3/4" x 11-7/8" VERSA-LAM® 2.0 3100 SP****PASSED****1ST FLR FRAMING\Flush Beams\B4(I2757) (Flush Beam)**

Dry | 1 span | No cant.

February 19, 2020 10:08:06

BC CALC® Member Report

Build 7239

Job name:

Address:

City, Province, Postal Code: WATERDOWN

Customer:

Code reports: CCMC 12472-R


File name: VALLEYCREEK 4 EL 1.mmdl

Description: 1ST FLR FRAMING\Flush Beams\B4(I2757)

Specifier:

Designer: AJ

Company:

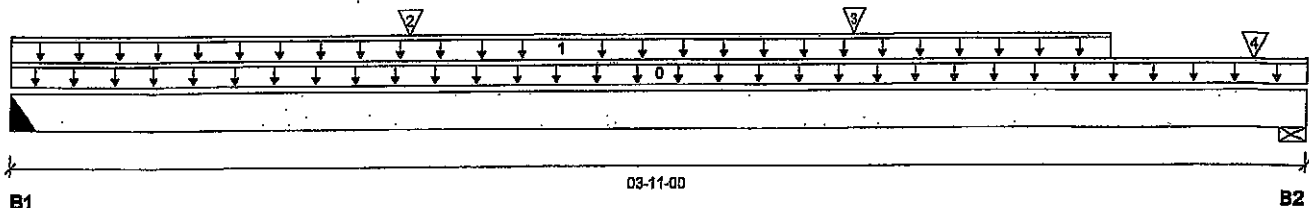

Total Horizontal Product Length = 03-11-00

Reaction Summary (Down / Uplift) (lbs)

Bearing	Live	Dead	Snow	Wind
B1, 2"	549 / 0	286 / 0		
B2, 5-1/2"	1077 / 0	589 / 0		

Load Summary

Tag	Description	Load Type	Ref.	Start	End	Loc.	Live	Dead	Snow	Wind	Tributary
0	Self-Weight	Unf. Lin. (lb/ft)	L	00-00-00	03-11-00	Top	1.00	0.65	1.00	1.15	00-00-00
1	STAIR	Unf. Lin. (lb/ft)	L	00-00-00	03-04-00	Top	120	60			n/a
2	J5(I2769)	Conc. Pt. (lbs)	L	01-02-08	01-02-08	Top	350	175			n/a
3	J5(I2755)	Conc. Pt. (lbs)	L	02-06-08	02-06-08	Top	333	167			n/a
4	-	Conc. Pt. (lbs)	L	03-09-02	03-09-02	Top	543	309			n/a

Controls Summary

	Factored Demand	Factored Resistance	Demand/Resistance	Case	Location
Pos. Moment	1142 ft-lbs	17696 ft-lbs	6.5%	1	01-08-03
End Shear	1088 lbs	7232 lbs	15.0%	1	02-05-10
Total Load Deflection	L/999 (0.004")	n/a	n/a	4	01-09-09
Live Load Deflection	L/999 (0.002")	n/a	n/a	5	01-09-09
Max Defl.	0.004"	n/a	n/a	4	01-09-09
Span / Depth	3.5				

Bearing Supports	Dim. (LxW)	Demand	Demand/Resistance Support	Demand/Resistance Member	Material
B1	Hanger 2" x 1-3/4"	1181 lbs	n/a	27.6%	HUS1.81/10
B2	Wall/Plate 5-1/2" x 1-3/4"	2352 lbs	39.7%	20.0%	Spruce-Pine-Fir

Cautions

Header for the hanger HUS1.81/10 at B1 is a Double 1-3/4" x 11-7/8" VERSA-LAM® 1.7 2400 DF. Hanger model HUS1.81/10 and seat length were input by the user. Hanger has not been analyzed for adequate capacity.

Notes

Design meets Code minimum (L/240) Total load deflection criteria.

Design meets Code minimum (L/360) Live load deflection criteria.

Calculations assume member is fully braced.

Hanger Manufacturer: Unassigned

Resistance Factor phi has been applied to all presented results per CSA O86. **AMENDED 2020**

BC CALC® analysis is based on Canadian Limit States Design, as per NBCC 2015 and CSA O86.

Design based on Dry Service Condition.

Importance Factor : Normal Part code : Part 9

CONFORMS TO OBC 2012

DWG NO. TAM 5481 -20

STRUCTURAL**COMPONENT ONLY****Disclosure**

Use of the Boise Cascade Software is subject to the terms of the End User License Agreement (EULA). Completeness and accuracy of input must be reviewed and verified by a qualified engineer or other appropriate expert to assure its adequacy, prior to anyone relying on such output as evidence of suitability for a particular application. The output here is based on building code-accepted design properties and analysis methods. Installation of Boise Cascade engineered wood products must be in accordance with current Installation Guide and applicable building codes. To obtain Installation Guide or ask questions, please call (800)232-0788 before installation.

BC CALC®, BC FRAMER®, AJS™, ALLJOIST®, BC RIM BOARD™, BC®, BOISE GLULAM™, BC FloorValue®, VERSA-LAM®, VERSA-RIM PLUS®,



Boise Cascade



Single 1-3/4" x 11-7/8" VERSA-LAM® 2.0 3100 SP

PASSED

1ST FLR FRAMING\Flush Beams\B5(i2778) (Flush Beam)

Dry | 1 span | No cant.

February 19, 2020 10:08:06

BC CALC® Member Report

Build 7239

Job name:

Address:

City, Province, Postal Code: WATERDOWN

Customer:

Code reports: CCMC 12472-R


File name: VALLEYCREEK 4 EL 1.mmdl

Description: 1ST FLR FRAMING\Flush Beams\B5(i2778)

Specifier:

Designer: AJ

Company:

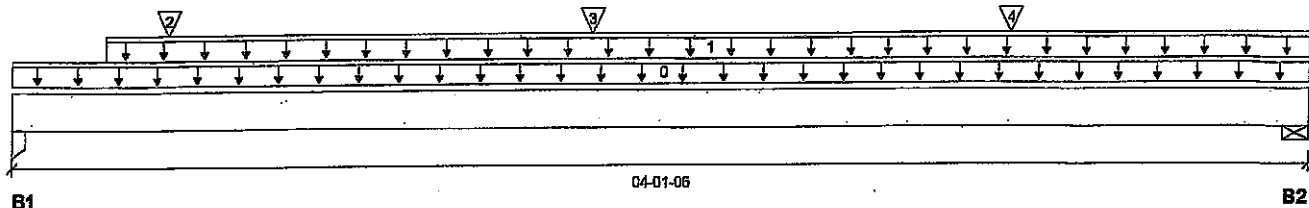

Total Horizontal Product Length = 04-01-06

Reaction Summary (Down / Uplift) (lbs)

Bearing	Live	Dead	Snow	Wind
B1, 3-1/2"	451 / 0	237 / 0		
B2, 4-3/8"	313 / 0	169 / 0		

Load Summary

Tag	Description	Load Type	Ref.	Start	End	Loc.	Live	Dead	Snow	Wind	Tributary
0	Self-Weight	Unf. Lin. (lb/ft)	L	00-00-00	04-01-06	Top	1.00	0.65	1.00	1.15	00-00-00
1	FC2 Floor Material	Unf. Lin. (lb/ft)	L	00-03-08	04-01-06	Top	3	1			n/a
2	J7(i2880)	Conc. Pt. (lbs)	L	00-06-00	00-06-00	Top	287	143			n/a
3	J7(i2828)	Conc. Pt. (lbs)	L	01-10-00	01-10-00	Top	255	128			n/a
4	J7(i2834)	Conc. Pt. (lbs)	L	03-02-00	03-02-00	Top	208	104			n/a

Controls Summary

	Factored Demand	Factored Resistance	Demand/Resistance	Case	Location
Pos. Moment	722 ft-lbs	17696 ft-lbs	4.1%	1	01-10-00
End Shear	480 lbs	7232 lbs	6.6%	1	02-09-02
Total Load Deflection	L/999 (0.002")	n/a	n/a	4	02-00-01
Live Load Deflection	L/999 (0.001")	n/a	n/a	5	02-00-01
Max Defl.	0.002"	n/a	n/a	4	02-00-01
Span / Depth	3.6				

Bearing Supports

	Dim. (LxW)	Demand	Demand/Resistance Support	Demand/Resistance Member	Material
B1	Column 3-1/2" x 1-3/4"	973 lbs	19.6%	13.0%	Unspecified
B2	Wall/Plate 4-3/8" x 1-3/4"	680 lbs	14.4%	7.3%	Spruce-Pine-Fir

Notes

Design meets Code minimum (L/240) Total load deflection criteria.

Design meets Code minimum (L/360) Live load deflection criteria.

Calculations assume member is fully braced.

Resistance Factor phi has been applied to all presented results per CSA O86.


BC CALC® analysis is based on Canadian Limit States Design, as per NBCC 2015 and CSA O86.

Design based on Dry Service Condition.

Importance Factor : Normal Part code : Part 9

CONFORMS TO OBC 2012

AMENDED 2020

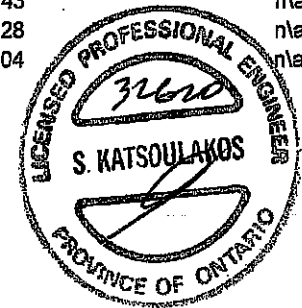DWG NO. TAM5482-20
STRUCTURAL
COMPONENT ONLY

Disclosure

Use of the Boise Cascade Software is subject to the terms of the End User License Agreement (EULA). Completeness and accuracy of Input must be reviewed and verified by a qualified engineer or other appropriate expert to assure its adequacy, prior to anyone relying on such output as evidence of suitability for a particular application. The output here is based on building code-accepted design properties and analysis methods. Installation of Boise Cascade engineered wood products must be in accordance with current Installation Guide and applicable building codes. To obtain Installation Guide or ask questions, please call (800)232-0788 before installation.

BC CALC®, BC FRAMER®, AJS™, ALLJOIST®, BC RIM BOARD™, BCi®, BOISE GLULAM™, BC FloorValue®, VERSA-LAM®, VERSA-RIM PLUS®,



Double 1-3/4" x 11-7/8" VERSA-LAM® 2.0 3100 SP

PASSED

BC CALC® Member Report

Dry | 1 span | No cant.

March 24, 2020 16:05:37

Build 7239

Job name:

File name: VALLEYCREEK 4 EL 1 DECK CONDITION.mmdl

Address:

Description: 1ST FLR FRAMING\Flush Beams\B21(i3058) (Flush Beam)

City, Province, Postal Code: WATERDOWN


Specifier:

Customer:

Designer: AJ

Code reports: CCMC 12472-R

Company:

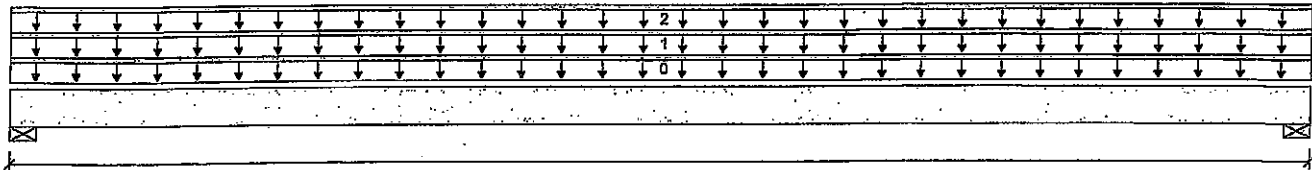

B1

Total Horizontal Product Length = 03-01-00

B2

Reaction Summary (Down / Uplift) (lbs)

Bearing	Live	Dead	Snow	Wind
B1, 3"	21 / 0	154 / 0		
B2, 3"	21 / 0	154 / 0		

Load Summary

Tag	Description	Load Type	Ref.	Start	End	Loc.	Live	Dead	Snow	Wind	Tributary
0	Self-Weight	Unf. Lin. (lb/ft)	L	00-00-00	03-01-00	Top	1.00	0.65	1.00	1.15	00-00-00
1	E3(i753)	Unf. Lin. (lb/ft)	L	00-00-00	03-01-00	Top		81			n/a
2	FC2 Floor Material	Unf. Lin. (lb/ft)	L	00-00-00	03-01-00	Top	13	7			n/a

Controls Summary

	Factored Demand	Factored Resistance	Demand/Resistance	Case	Location
Pos. Moment	128 ft-lbs	23005 ft-lbs	0.6%	0	01-06-08
End Shear	42 lbs	9401 lbs	0.4%	0	01-02-14
Total Load Deflection	L/999 (0")	n/a	n/a	4	01-06-08
Max Defl.	0"	n/a	n/a	4	01-06-08
Span / Depth	2.7				

Bearing Supports	Dim. (LxW)	Demand	Demand/Resistance Support	Demand/Resistance Member	Material
B1	Wall/Plate 3" x 3-1/2"	215 lbs	5.1%	2.6%	Spruce-Pine-Fir
B2	Wall/Plate 3" x 3-1/2"	215 lbs	5.1%	2.6%	Spruce-Pine-Fir

Notes

Design meets Code minimum (L/240) Total load deflection criteria.

Calculations assume member is fully braced.

Resistance Factor phi has been applied to all presented results per CSA O86.


BC CALC® analysis is based on Canadian Limit States Design, as per NBCC 2015 and CSA O86.

Design based on Dry Service Condition.

Importance Factor : Normal Part code : Part 9

CONFORMS TO CBC 2012

AMENDED 2020

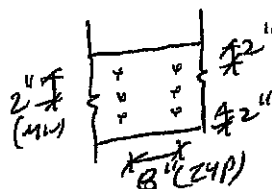

PROVIDE 3 ROWS OF 3/4" ARDOX SPIRAL NAILS @ 8" O/C FOR MULTI-PLY NAILING. MAINTAIN A MIN. 2" LUMBER EDGE/END DISTANCE. DO NOT USE AIR NAILS



DWG NO. YAM 5489-20
STRUCTURAL
COMPONENT ONLY

Disclosure

Use of the Boise Cascade Software is subject to the terms of the End User License Agreement (EULA). Completeness and accuracy of input must be reviewed and verified by a qualified engineer or other appropriate expert to assure its adequacy, prior to anyone relying on such output as evidence of suitability for a particular application. The output here is based on building code-accepted design properties and analysis methods. Installation of Boise Cascade engineered wood products must be in accordance with current Installation Guide and applicable building codes. To obtain Installation Guide or ask questions, please call (800)232-0788 before installation.

BC CALC®, BC FRAMER®, AJS™, ALLJOIST®, BC RIM BOARD™, BCI®, BOISE GLULAM™, BC FloorValue®, VERSA-LAM®, VERSA-RIM PLUS®,



Double 1-3/4" x 11-7/8" VERSA-LAM® 2.0 3100 SP

PASSED

1ST FLR FRAMING\Flush Beams\B22(I3082) (Flush Beam)

BC CALC® Member Report

Dry | 1 span | No cant.

March 24, 2020 16:05:37

Build 7239

Job name:

File name: VALLEYCREEK 4 EL 1 DECK CONDITION.mmdl

Address:

Description: 1ST FLR FRAMING\Flush Beams\B22(I3082)

City, Province, Postal Code: WATERDOWN

Specifier:


Customer:

Designer: AJ

Code reports:

CCMC 12472-R

Company:

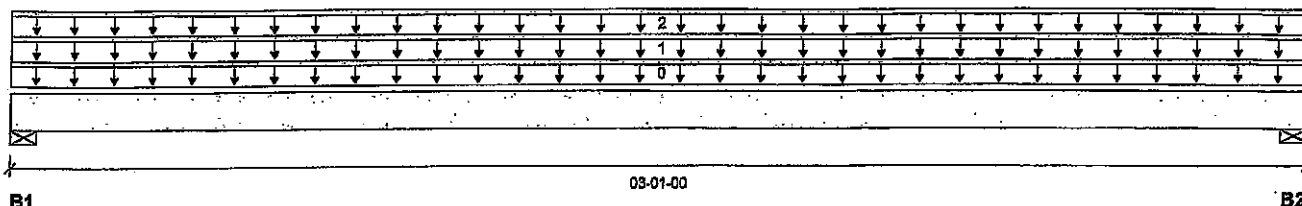

Total Horizontal Product Length = 03-01-00

Reaction Summary (Down / Uplift) (lbs)

Bearing	Live	Dead	Snow	Wind
B1, 3"	84 / 0	194 / 0		
B2, 3"	84 / 0	194 / 0		

Load Summary

Tag	Description	Load Type	Ref.	Start	End	Loc.	Live	Dead	Snow	Wind	Tributary
0	Self-Weight	Unf. Lin. (lb/ft)	L	00-00-00	03-01-00	Top	12	12			00-00-00
1	E5(I757)	Unf. Lin. (lb/ft)	L	00-00-00	03-01-00	Top	28	101			n/a
2	FC2 Floor Material	Unf. Lin. (lb/ft)	L	00-00-00	03-01-00	Top	27	13			n/a

Controls Summary

	Factored Demand	Factored Resistance	Demand/Resistance	Case	Location
Pos. Moment	162 ft-lbs	23005 ft-lbs	0.7%	0	01-06-08
End Shear	53 lbs	9401 lbs	0.6%	0	01-02-14
Total Load Deflection	L/999 (0")	n/a	n/a	4	01-06-08
Live Load Deflection	L/999 (0")	n/a	n/a	5	01-06-08
Max Defl.	0"	n/a	n/a	4	01-06-08
Span / Depth	2.7				

Bearing Supports

	Dim. (LxW)	Demand	Demand/Resistance Support	Demand/Resistance Member	Material
B1	Wall/Plate 3" x 3-1/2"	272 lbs	6.5%	3.3%	Spruce-Pine-Fir
B2	Wall/Plate 3" x 3-1/2"	272 lbs	6.5%	3.3%	Spruce-Pine-Fir

Notes

Design meets Code minimum (L/240) Total load deflection criteria.

Design meets Code minimum (L/360) Live load deflection criteria.

Calculations assume member is fully braced.

Resistance Factor phi has been applied to all presented results per CSA O86.


BC CALC® analysis is based on Canadian Limit States Design, as per NBCC 2015 and CSA O86.

Design based on Dry Service Condition.

Importance Factor : Normal Part code : Part 9

CONFORMS TO OBC 2012

AMENDED 2020

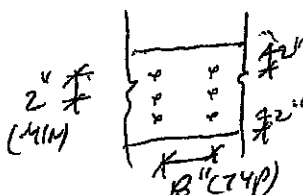

PROVIDE 3 ROWS OF 3/8" ARDOX
SPIRAL NAILS @ 8" O/C FOR
MULTI-PLY NAILING, MAINTAIN
A MIN. 2" LUMBER EDGE/END
DISTANCE. DO NOT USE AIR NAILS



DWG NO. TAM 5490-20
STRUCTURAL

Disclosure

Use of the Boise Cascade Software is subject to the terms of the End User License Agreement (EULA). Completeness and accuracy of input must be reviewed and verified by a qualified engineer or other appropriate expert to assure its adequacy, prior to anyone relying on such output as evidence of suitability for a particular application. The output here is based on building code-accepted design properties and analysis methods. Installation of Boise Cascade engineered wood products must be in accordance with current installation Guide and applicable building codes. To obtain Installation Guide or ask questions, please call (800)232-0788 before installation.

BC CALC®, BC FRAMER®, AJS™, ALLJOIST®, BC RIM BOARD™, BCI®, BOISE GLULAM™, BC FloorValue®, VERSA-LAM®, VERSA-RIM PLUS®,

NORDIC STRUCTURES

COMPANY
Feb. 19, 2020 10:40


PROJECT
J1 2ND FLOOR ABOVE GARAGE.wwb

Design Check Calculation Sheet Nordic Sizer - Canada 7.2

Loads:

Load	Type	Distribution	Pat-tern	Location [ft] Start End	Magnitude Start End	Unit
Load1	Dead	Full Area			20.00	psf
Load2	Live	Full Area			40.00	psf

Maximum Reactions (lbs) and Support Bearing (in):

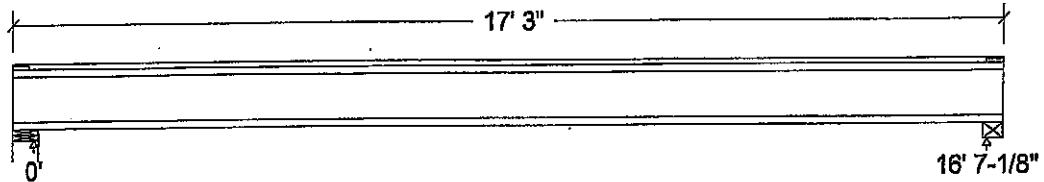

Unfactored:			
Dead	166		166
Live	332		332
Factored:			
Total	705		705
Bearing:			
Capacity			
Joist	2336		2336
Support	9724		-
Des ratio			
Joist	0.30		0.30
Support	0.07		-
Load case	#2		#2
Length	5-1/2		4-1/8
Min req'd	1-3/4		1-3/4
Stiffener	No		No
KD	1.00		1.00
KB support	-		-
fcp sup	769		-
Kzcp sup	-		-

Bearing for wall supports is perpendicular-to-grain bearing on top plate. No stud design included.

Nordic Joist 11-7/8" NI-40x Floor joist @ 12" o.c.

Supports: 1 - Lumber Wall, No.1/No.2; 2 - Steel Beam, W;

Total length: 17' 3"; Clear span: 16' 5-3/8"; 5/8" nailed and glued OSB sheathing

This section **PASSES** the design code check.

Limit States Design using CSA-O86-09 and Vibration Criterion:

Criterion	Analysis Value	Design Value	Unit	Analysis/Design
Shear	Vf = 705	Vr = 2336	lbs	Vf/Vr = 0.30
Moment (+)	Mf = 2926	Mr = 6255	lbs-ft	ME/Mr = 0.47
Perm. Defl'n	0.09 = < L/999	0.55 = L/360	in	0.16
Live Defl'n	0.18 = < L/999	0.41 = L/480	in	0.43
Total Defl'n	0.27 = L/741	0.83 = L/240	in	0.32
Bare Defl'n	0.21 = L/970	0.55 = L/360	in	0.37
Vibration	Lmax = 16'-7.1	Lv = 18'-3.6	ft	0.91
Defl'n	= 0.028	= 0.038	in	0.74



NO. YAM5476-20
STRUCTURAL
COMPONENT ONLY

Additional Data:

FACTORS:	f/E	KD	KH	KZ	KL	KT	KS	KN	LC#
Vr	2336	1.00	1.00	-	-	-	-	-	#2
Mr+	6255	1.00	1.00	-	1.000	-	-	-	#2
EI	371.1 million	-	-	-	-	-	-	-	#2

CRITICAL LOAD COMBINATIONS:

Shear : LC #2 = 1.25D + 1.5L

Moment(+) : LC #2 = 1.25D + 1.5L

Deflection: LC #1 = 1.0D (permanent)

LC #2 = 1.0D + 1.0L (live)

LC #2 = 1.0D + 1.0L (total)

LC #2 = 1.0D + 1.0L (bare joist)

Bearing : Support 1 - LC #2 = 1.25D + 1.5L

Support 2 - LC #2 = 1.25D + 1.5L

Load Types: D=dead W=wind S=snow H=earth,groundwater E=earthquake

L=live(use, occupancy) Ls=live(storage,equipment) f=fire

Load Patterns: s=S/2 L=L+Ls _no pattern load in this span

All Load Combinations (LCs) are listed in the Analysis output

CALCULATIONS:E_{ieff} = 432.91 lb-in² K= 6.18e06 lbs

"Live" deflection is due to all non-dead loads (live, wind, snow...)

CONFORMS TO OBC 2012

AMENDED 2020

Design Notes:

1. WoodWorks analysis and design are in accordance with the 2010 National Building Code of Canada (NBC), Division B, Part 4, and the CSA O86-09 Engineering Design in Wood standard, which includes Update No.1
2. Please verify that the default deflection limits are appropriate for your application.
3. Refer to Nordic Structures technical documentation for installation guidelines and construction details.
4. Nordic I-joists are listed in CCMC evaluation report 13032-R.
5. Joists shall be laterally supported at supports and continuously along the compression edge.
6. The design assumptions and specifications have been provided by the client. Any damages resulting from faulty or incorrect information, specifications, and/or designs furnished, and the correctness or accuracy of this information is their responsibility. This analysis does not constitute a record of the structural integrity of the building nor suitability of the design assumptions made. Nordic Structures is responsible only for the structural adequacy of this component based on the design criteria and loadings shown.



DWG NO. YAM5416-20
STRUCTURAL
COMPONENT ONLY

BC CALC® Member Report

Dry | 1 span | No cant.

October 27, 2020 17:08:32

Build 0

Job name:

File name: VALLEYCREEK 4

Address:

Description: 2ND FLR FRAMING\Flush Beams\B20(i2886)

City, Province, Postal Code: WATERDOWN

Specifier:


Customer:

Designer: AJ

Code reports:

CCMC 12472-R

Company:

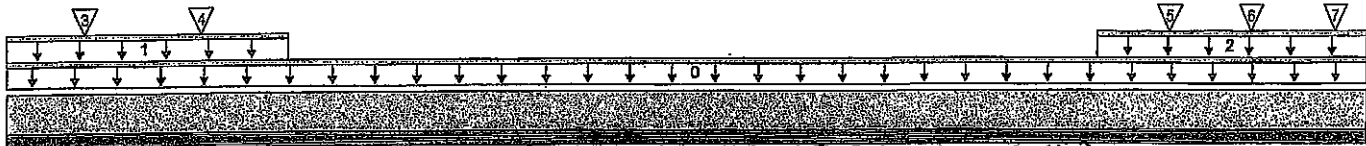

FULLY SUPPORTED BOTTOM EDGE ALONG FULL WIDTH & FULL LENGTH).
Total Horizontal Product Length = 16-00-00


Load Summary

Tag	Description	Load Type	Ref.	Start	End	Loc.	Live	Dead	Snow	Wind	Tributary
0	Self-Weight	Unf. Lin. (lb/ft)	L	00-00-00	16-00-00	Top	1.00	0.65	1.00	1.15	00-00-00
1	FC3 Floor Material	Unf. Lin. (lb/ft)	L	00-00-00	03-03-00	Top	6	3			n/a
2	FC3 Floor Material	Unf. Lin. (lb/ft)	L	12-09-00	16-00-00	Top	6	3			n/a
3	J2(i2907)	Conc. Pt. (lbs)	L	00-11-00	00-11-00	Top	386	193			n/a
4	J2(i2776)	Conc. Pt. (lbs)	L	02-03-00	02-03-00	Top	347	174			n/a
5	J2(i2814)	Conc. Pt. (lbs)	L	13-07-08	13-07-08	Top	267	133			n/a
6	J2(i2863)	Conc. Pt. (lbs)	L	14-07-08	14-07-08	Top	289	145			n/a
7	J2(i2855)	Conc. Pt. (lbs)	L	15-07-08	15-07-08	Top	253	127			n/a

Controls Summary

	Factored Demand	Factored Resistance	Demand/Resistance	Case	Location
Dist. Load	13.28 lb/ft	57645.00 lb/ft	n/a		
Conc. Load	820 lbs	16813 lbs	4.9%		

Connection Diagram: Full Length of Member

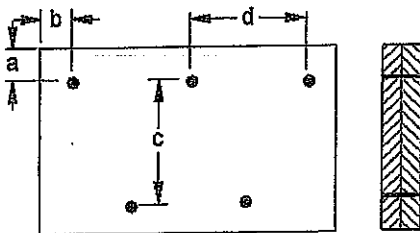

a minimum = 2"
b minimum = 3"

c = 7-7/8"
d = 8"

Calculated Side Load = 410.1 lb/ft
Connectors are: 16d GRN or Nails

3-1/2" ARDOX SPIRAL

CONFORMS TO UBC 2012
AMENDED 2020



UWG NO. TAM/4824-20
STRUCTURAL
CON. ONENT ONLY

Disclosure

Use of the Boise Cascade Software is subject to the terms of the End User License Agreement (EULA). Completeness and accuracy of input must be reviewed and verified by a qualified engineer or other appropriate expert to assure its adequacy, prior to anyone relying on such output as evidence of suitability for a particular application. The output here is based on building code-accepted design properties and analysis methods. Installation of Boise Cascade engineered wood products must be in accordance with current Installation Guide and applicable building codes. To obtain Installation Guide or ask questions, please call (800)232-0788 before installation.

BC CALC®, BC FRAMER®, AJST™, ALLJOIST®, BC RIM BOARD™, BCI®, BOISE GLULAM™, BC FloorValue®, VERSA-LAM®, VERSA-RIM PLUS®,



Triple 1-3/4" x 9-1/2" VERSA-LAM® 2.0 3100 SP

PASSED

2ND FLR FRAMING\Dropped Beams\B12 DR(i2764) (Dropped Beam)

BC CALC® Member Report

Dry | 1 span | No cant.

February 19, 2020 10:08:06

Build 7239

Job name:

File name: VALLEYCREEK 4 EL 1.mmdl

Address:

Description: 2ND FLR FRAMING\Dropped Beams\B12 DR(i2764)

City, Province, Postal Code: WATERDOWN


Specifier:

Customer:

Designer: AJ

Code reports: CCMC 12472-R

Company:

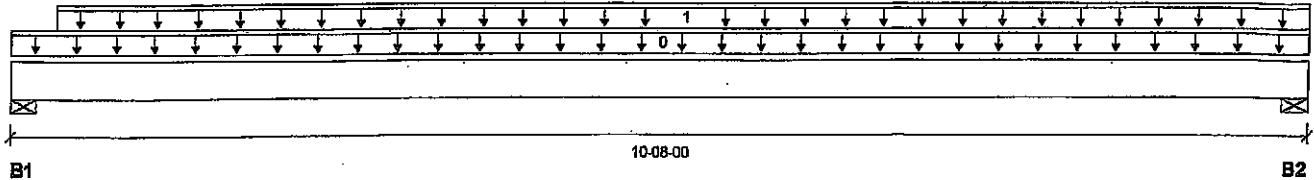

Reaction Summary (Down / Uplift) (lbs)

Bearing	Live	Dead	Snow	Wind
B1, 4"	3214 / 0	1685 / 0		
B2, 4"	3596 / 0	1876 / 0		

Load Summary

Tag	Description	Load Type	Ref.	Start	End	Loc.	Live	Dead	Snow	Wind	Tributary
0	Self-Weight	Unf. Lin. (lb/ft)	L	00-00-00	10-08-00	Top	1.00	0.65	1.00	1.15	
1	Smoothed Load	Unf. Lin. (lb/ft)	L	00-04-08	10-08-00	Top	662	331			00-00-00

Controls Summary	Factored Demand	Factored Resistance	Demand/Resistance	Case	Location
Pos. Moment	17365 ft-lbs	36222 ft-lbs	47.9%	1	05-00-08
End Shear	6320 lbs	17358 lbs	36.4%	1	01-01-08
Total Load Deflection	L/403 (0.302")	n/a	59.6%	4	05-03-11
Live Load Deflection	L/613 (0.198")	n/a	58.7%	5	05-03-11
Max Defl.	0.302"	n/a	n/a	4	05-03-11
Span / Depth	12.8				


Bearing Supports	Dim. (LxW)	Demand	Demand/Resistance Support	Demand/Resistance Member	Material
B1	Wall/Plate 4" x 5-1/4"	6928 lbs	24.7%	27.0%	Spruce-Pine-Fir
B2	Wall/Plate 4" x 5-1/4"	7738 lbs	27.6%	30.2%	Spruce-Pine-Fir

Notes

Design meets Code minimum (L/240) Total load deflection criteria.
 Design meets Code minimum (L/360) Live load deflection criteria.
 Calculations assume unbraced length of Top: 00-03-02, Bottom: 00-03-02.
 Resistance Factor phi has been applied to all presented results per CSA O86.
 BC CALC® analysis is based on Canadian Limit States Design, as per NBCC 2015 and CSA O86.
 Design based on Dry Service Condition.
 Importance Factor : Normal Part code : Part 9

CONFORMS TO OBC 2012

AMENDED 2020

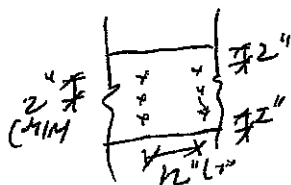

PROVIDE 3 ROWS OF 3/8" ARDOX SPIRAL NAILS @ 12" O/C FOR MULTI-PLY NAILING, MAINTAIN A MIN. 2" LUMBER EDGE/END DISTANCE. DO NOT USE AIR NAILS. STAGGER NAILS 6" BETWEEN PLYS.



ENGINE NO. TAM 5465-20
STRUCTURAL COMPONENT ONLY

Disclosure

Use of the Boise Cascade Software is subject to the terms of the End User License Agreement (EULA). Completeness and accuracy of input must be reviewed and verified by a qualified engineer or other appropriate expert to assure its adequacy, prior to anyone relying on such output as evidence of suitability for a particular application. The output here is based on building code-accepted design properties and analysis methods. Installation of Boise Cascade engineered wood products must be in accordance with current Installation Guide and applicable building codes. To obtain Installation Guide or ask questions, please call (800)232-0788 before installation.

BC CALC®, BC FRAMER®, AJS™, ALLJOIST®, BC RIM BOARD™, BCI®, BOISE GLULAM™, BC FloorValue®, VERSA-LAM®, VERSA-RIM PLUS®,



Boise Cascade



Single 1-3/4" x 11-7/8" VERSA-LAM® 2.0 3100 SP

2ND FLR FRAMING\Flush Beams\B10(i2802) (Flush Beam)

PASSED

BC CALC® Member Report

Build 7239

Job name:

Address:

City, Province, Postal Code: WATERDOWN

Customer:

Code reports: CCMC 12472-R

Dry | 1 span | No cant.

February 19, 2020 10:08:06


File name: VALLEYCREEK 4 EL 1.mmdl

Description: 2ND FLR FRAMING\Flush Beams\B10(i2802)

Specifier:

Designer: AJ

Company:

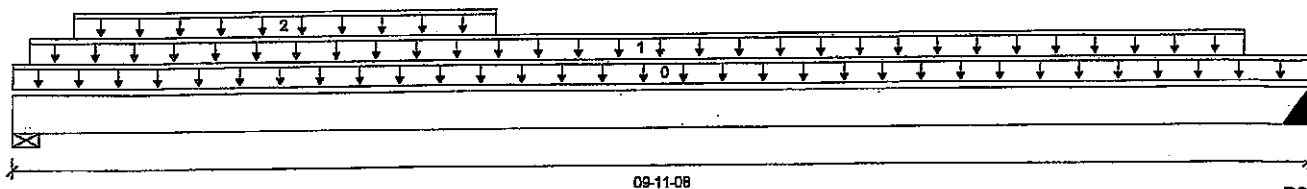

Total Horizontal Product Length = 09-11-08

Reaction Summary (Down / Uplift) (lbs)

Bearing	Live	Dead	Snow	Wind
B1, 5-1/2"	997 / 0	531 / 0		
B2, 2"	656 / 0	358 / 0		

Load Summary

Tag	Description	Load Type	Ref.	Start	End	Loc.	Live 1.00	Dead 0.65	Snow 1.00	Wind 1.15	Tributary
0	Self-Weight	Unf. Lin. (lb/ft)	L	00-00-00	09-11-08	Top		6			00-00-00
1	Smoothed Load	Unf. Lin. (lb/ft)	L	00-01-08	09-05-08	Top	136	68			n/a
2	STAIR	Unf. Lin. (lb/ft)	L	00-05-08	03-08-03	Top	120	60			n/a

Controls Summary

	Factored Demand	Factored Resistance	Demand/ Resistance	Case	Location
Pos. Moment	4082 ft-lbs	17696 ft-lbs	23.1%	1	04-09-08
End Shear	1640 lbs	7232 lbs	22.7%	1	01-05-06
Total Load Deflection	L/999 (0.095")	n/a	n/a	4	04-11-08
Live Load Deflection	L/999 (0.062")	n/a	n/a	5	04-11-08
Max Defl.	0.095"	n/a	n/a	4	04-11-08
Span / Depth	9.6				



DWG NO. TAM 5486 -20
STRUCTURAL
COMPONENT ONLY

Bearing Supports

	Dim. (LxW)	Demand	Demand/ Resistance Support	Demand/ Resistance Member	Material
B1	Wall/Plate 5-1/2" x 1-3/4"	2158 lbs	36.5%	18.4%	Spruce-Pine-Fir
B2	Hanger 2" x 1-3/4"	1433 lbs	n/a	33.6%	HUS1.81/10

Cautions

Header for the hanger HUS1.81/10 at B2 is a Double 1-3/4" x 11-7/8" VERSA-LAM® 1.7 2400 DF. Hanger model HUS1.81/10 and seat length were input by the user. Hanger has not been analyzed for adequate capacity.

Notes

Design meets Code minimum (L/240) Total load deflection criteria.
Design meets Code minimum (L/360) Live load deflection criteria.
Calculations assume member is fully braced.
Hanger Manufacturer: Unassigned
Resistance Factor phi has been applied to all presented results per CSA O86.
BC CALC® analysis is based on Canadian Limit States Design, as per NBCC 2015 and CSA O86.
Design based on Dry Service Condition.
Importance Factor : Normal Part code : Part 9

CONFORMS TO OBC 2012

AMENDED 2020

Disclosure

Use of the Boise Cascade Software is subject to the terms of the End User License Agreement (EULA). Completeness and accuracy of Input must be reviewed and verified by a qualified engineer or other appropriate expert to assure its adequacy, prior to anyone relying on such output as evidence of suitability for a particular application. The output here is based on building code-accepted design properties and analysis methods. Installation of Boise Cascade engineered wood products must be in accordance with current Installation Guide and applicable building codes. To obtain Installation Guide or ask questions, please call (800)232-0788 before installation.

BC CALC®, BC FRAMER®, AJS™, ALLJOIST®, BC RIM BOARD™, BCI®, BOISE GLULAM™, BC FloorValue®, VERSA-LAM®, VERSA-RIM PLUS®,



Double 1-3/4" x 11-7/8" VERSA-LAM® 2.0 3100 SP

PASSED

2ND FLR FRAMING\Flush Beams\B8(i2812) (Flush Beam)

Dry | 2 spans | No cant.

February 19, 2020 10:08:06

BC CALC® Member Report

Build 7239

Job name:

Address:

City, Province, Postal Code: WATERDOWN

Customer:

Code reports: CCMC 12472-R


File name: VALLEYCREEK 4 EL 1.mmdl

Description: 2ND FLR FRAMING\Flush Beams\B8(i2812)

Specifier:

Designer: AJ

Company:

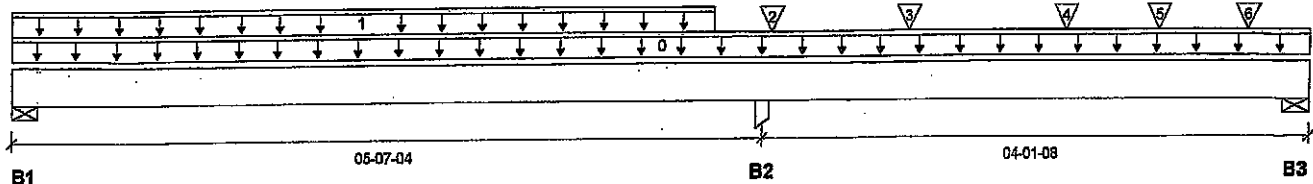

Reaction Summary (Down / Uplift) (lbs)

Bearing	Live	Dead	Snow	Wind
B1, 4"	1411 / 102	682 / 0		
B2, 3-1/2"	3338 / 0	1807 / 0		
B3, 2-3/4"	1097 / 241	448 / 0		

Load Summary

Tag	Description	Load Type	Ref.	Start	End	Loc.	Live	Dead	Snow	Wind	Tributary
0	Self-Weight	Unf. Lin. (lb/ft)	L	00-00-00	09-08-12	Top	1.00	0.65	1.00	1.15	00-00-00
1	Smoothed Load	Unf. Lin. (lb/ft)	L	00-00-00	05-03-00	Top	482	240			n/a
2	-	Conc. Pt. (lbs)	L	05-08-01	05-08-01	Top	861	500			n/a
3	-	Conc. Pt. (lbs)	L	06-08-11	06-08-11	Top	708	354			n/a
4	-	Conc. Pt. (lbs)	L	07-11-00	07-11-00	Top	714	356			n/a
5	J2(i2855)	Conc. Pt. (lbs)	L	08-07-08	08-07-08	Top	349	174			n/a
6	J1(i2838)	Conc. Pt. (lbs)	L	09-03-06	09-03-06	Top	345	174			n/a

Controls Summary

	Factored Demand	Factored Resistance	Demand/Resistance	Case	Location
Pos. Moment	2537 ft-lbs	35392 ft-lbs	7.2%	2	02-09-06
Neg. Moment	-3232 ft-lbs	-35392 ft-lbs	9.1%	1	05-07-04
End Shear	1704 lbs	14464 lbs	11.8%	2	01-03-14
Cont. Shear	2773 lbs	14464 lbs	19.2%	1	06-08-14
Total Load Deflection	L/999 (0.008")	n/a	n/a	9	02-08-01
Live Load Deflection	L/999 (0.006")	n/a	n/a	12	02-09-06
Total Neg. Defl.	L/999 (-0.001")	n/a	n/a	9	06-10-10
Max Defl.	0.008"	n/a	n/a	9	02-08-01
Span / Depth	5.4				

Bearing Supports	Dim. (LxW)	Demand	Demand/Resistance Support	Demand/Resistance Member	Material
B1	Wall/Plate 4" x 3-1/2"	2970 lbs	34.5%	17.4%	Spruce-Pine-Fir
B2	Column 3-1/2" x 3-1/2"	7266 lbs	73.0%	48.6%	Unspecified
B3	Wall/Plate 2-3/4" x 3-1/2"	2206 lbs	37.3%	18.8%	Spruce-Pine-Fir

Notes

Design meets Code minimum (L/240) Total load deflection criteria.

Design meets Code minimum (L/360) Live load deflection criteria.

Calculations assume member is fully braced.

Resistance Factor phi has been applied to all presented results per CSA O86. AMENDED 2020


BC CALC® analysis is based on Canadian Limit States Design, as per NBCC 2015 and CSA O86.

Design based on Dry Service Condition.

Importance Factor: Normal Part code: Part 9

CONFORMS TO OBC 2012

PROVIDE 3 ROWS OF 3/4" ARDOX SPIRAL NAILS @ 8" O/C FOR MULTI-PLY NAILING. MAINTAIN A MIN. 2" LUMBER EDGE/END DISTANCE. DO NOT USE AIR NAILS

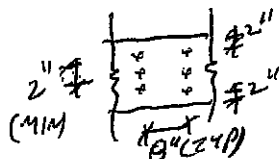

OWG NO. YAM 5467-20
STRUCTURAL
COMPONENT ONLY

Disclosure

Use of the Boise Cascade Software is subject to the terms of the End User License Agreement (EULA). Completeness and accuracy of input must be reviewed and verified by a qualified engineer or other appropriate expert to assure its adequacy, prior to anyone relying on such output as evidence of suitability for a particular application. The output here is based on building code-accepted design properties and analysis methods. Installation of Boise Cascade engineered wood products must be in accordance with current Installation Guide and applicable building codes. To obtain Installation Guide or ask questions, please call (800)232-0788 before installation.

BC CALC®, BC FRAMER®, AJS™, ALLJOIST®, BC RIM BOARD™, BC®, BOISE GLULAM™, BC FloorValue®, VERSA-LAM®, VERSA-RIM PLUS®,



Double 1-3/4" x 11-7/8" VERSA-LAM® 2.0 3100 SP

PASSED

2ND FLR FRAMING\Flush Beams\B9(i2771) (Flush Beam)

Dry | 1 span | No cant.

February 19, 2020 10:08:06

BC CALC® Member Report

Build 7239

Job name:

Address:

City, Province, Postal Code: WATERDOWN

Customer:

Code reports: CCMC 12472-R


File name: VALLEYCREEK 4 EL 1.mmdl

Description: 2ND FLR FRAMING\Flush Beams\B9(i2771)

Specifier:

Designer: AJ

Company:

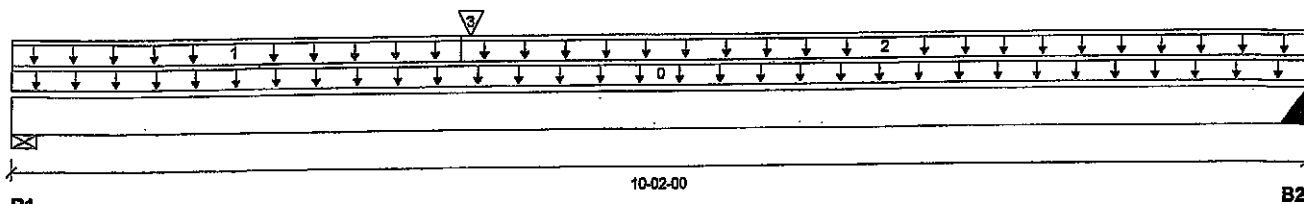

Total Horizontal Product Length = 10-02-00

Reaction Summary (Down / Uplift) (lbs)

Bearing	Live	Dead	Snow	Wind
B1, 4"	563 / 0	363 / 0		
B2, 4"	419 / 0	281 / 0		

Load Summary

Tag	Description	Load Type	Ref.	Start	End	Loc.	Live	Dead	Snow	Wind	Tributary
0	Self-Weight	Unf. Lin. (lb/ft)	L	00-00-00	10-02-00	Top	1.00	0.65	1.00	1.15	00-00-00
1	FC3 Floor Material	Unf. Lin. (lb/ft)	L	00-00-00	03-06-04	Top	18	9			n/a
2	FC3 Floor Material	Unf. Lin. (lb/ft)	L	03-06-04	10-02-00	Top	41	20			n/a
3	B10(i2802)	Conc. Pt. (lbs)	L	03-07-02	03-07-02	Top	649	355			n/a

Controls Summary

	Factored Demand	Factored Resistance	Demand/Resistance	Case	Location
Pos. Moment	3978 ft-lbs	35392 ft-lbs	11.2%	1	03-07-02
End Shear	1229 lbs	14464 lbs	8.5%	1	01-03-14
Total Load Deflection	L/999 (0.042")	n/a	n/a	4	04-09-14
Live Load Deflection	L/999 (0.026")	n/a	n/a	5	04-09-14
Max Defl.	0.042"	n/a	n/a	4	04-09-14
Span / Depth	9.7				

Bearing Supports

	Dim. (LxW)	Demand	Demand/Resistance Support	Demand/Resistance Member	Material
B1	Wall/Plate 4" x 3-1/2"	1298 lbs	15.1%	7.6%	Spruce-Pine-Fir
B2	Hanger 4" x 3-1/2"	980 lbs	n/a	5.7%	HGUS410

Cautions

Header for the hanger HGUS410 at B2 is a Double 1-3/4" x 11-7/8" VERSA-LAM® 1.7 2400 DF.
Hanger model HGUS410 and seat length were input by the user. Hanger has not been analyzed for adequate capacity.


Notes

Design meets Code minimum (L/240) Total load deflection criteria.
Design meets Code minimum (L/360) Live load deflection criteria.
Calculations assume member is fully braced.
Hanger Manufacturer: Unassigned
Resistance Factor phi has been applied to all presented results per CSA O86.
BC CALC® analysis is based on Canadian Limit States Design, as per NBCC 2015 and CSA O86.
Design based on Dry Service Condition.
Importance Factor: Normal Part code: Part 9

CONFORMS TO OBC 2012

AMENDED 2020

PROVIDE 3 ROWS OF 3/8" ARDOX SPIRAL NAILS @ 12" O/C FOR MULTI-PLY NAILING. MAINTAIN A MIN. 2" LUMBER EDGE/END DISTANCE. DO NOT USE AIR NAILS

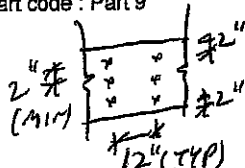


SWG NO. YAM 5488-20
STRUCTURAL
COMPONENT ONLY

Disclosure

Use of the Boise Cascade Software is subject to the terms of the End User License Agreement (EULA).
Completeness and accuracy of input must be reviewed and verified by a qualified engineer or other appropriate expert to assure its adequacy, prior to anyone relying on such output as evidence of suitability for a particular application. The output here is based on building code-accepted design properties and analysis methods.
Installation of Boise Cascade engineered wood products must be in accordance with current Installation Guide and applicable building codes. To obtain Installation Guide or ask questions, please call (800)232-0788 before installation.

BC CALC®, BC FRAMER®, AJS™, ALLJOIST®, BC RIM BOARD™, BCi®, BOISE GLULAM™, BC FloorValue®, VERSA-LAM®, VERSA-RIM PLUS®

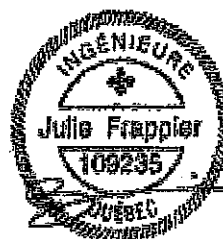

Maximum Floor Spans

Live Load = 40 psf, Dead Load = 30 psf
 Simple Spans, L/480 Deflection Limit
 3/4" OSB G&N Sheathing


Depth	Series	Bare				1/2" Gypsum Ceiling			
		On Centre Spacing				On Centre Spacing			
		12"	16"	19.2"	24"	12"	16"	19.2"	24"
9-1/2"	NI-20	15'-7"	14'-2"	13'-4"	12'-4"	15'-7"	14'-2"	13'-4"	12'-4"
	NI-40x	17'-0"	16'-0"	15'-1"	13'-11"	17'-5"	16'-1"	15'-1"	13'-11"
	NI-60	17'-2"	16'-2"	15'-5"	14'-3"	17'-6"	16'-5"	15'-5"	14'-3"
	NI-70	18'-0"	16'-11"	16'-3"	15'-6"	18'-5"	17'-3"	16'-7"	15'-6"
	NI-80	18'-3"	17'-1"	16'-5"	15'-9"	18'-8"	17'-5"	16'-9"	15'-10"
11-7/8"	NI-20	17'-10"	16'-10"	16'-0"	14'-10"	18'-6"	17'-1"	16'-0"	14'-10"
	NI-40x	19'-4"	17'-11"	17'-3"	15'-10"	19'-11"	18'-6"	17'-9"	15'-10"
	NI-60	19'-7"	18'-2"	17'-5"	16'-9"	20'-2"	18'-9"	17'-11"	17'-1"
	NI-70	20'-9"	19'-2"	18'-3"	17'-5"	21'-4"	19'-9"	18'-10"	17'-10"
	NI-80	21'-1"	19'-5"	18'-5"	17'-7"	21'-7"	20'-0"	19'-0"	18'-0"
14"	NI-90x	21'-8"	20'-0"	19'-1"	18'-0"	22'-2"	20'-6"	19'-6"	18'-6"
	NI-40x	21'-5"	19'-10"	18'-11"	17'-5"	22'-1"	20'-6"	19'-6"	17'-5"
	NI-60	21'-10"	20'-2"	19'-3"	18'-2"	22'-5"	20'-10"	19'-11"	18'-10"
	NI-70	23'-0"	21'-3"	20'-3"	19'-2"	23'-8"	21'-11"	20'-10"	19'-9"
	NI-80	23'-5"	21'-7"	20'-7"	19'-5"	24'-0"	22'-3"	21'-2"	20'-0"
16"	NI-90x	24'-1"	22'-3"	21'-2"	20'-0"	24'-8"	22'-10"	21'-9"	20'-7"
	NI-60	23'-9"	22'-0"	20'-11"	19'-10"	24'-6"	22'-9"	21'-8"	20'-6"
	NI-70	25'-1"	23'-2"	22'-0"	20'-10"	25'-9"	23'-10"	22'-9"	21'-6"
	NI-80	25'-6"	23'-6"	22'-4"	21'-2"	26'-1"	24'-2"	23'-1"	21'-10"
	NI-90x	26'-4"	24'-3"	23'-1"	21'-10"	26'-11"	24'-11"	23'-8"	22'-5"

Depth	Series	Mid-Span Blocking				Mid-Span Blocking and 1/2" Gypsum Ceiling			
		On Centre Spacing				On Centre Spacing			
		12"	16"	19.2"	24"	12"	16"	19.2"	24"
9-1/2"	NI-20	15'-7"	14'-2"	13'-4"	12'-4"	15'-7"	14'-2"	13'-4"	12'-4"
	NI-40x	17'-9"	16'-1"	15'-1"	13'-11"	17'-9"	16'-1"	15'-1"	13'-11"
	NI-60	18'-1"	16'-5"	15'-5"	14'-3"	18'-4"	16'-5"	15'-5"	14'-3"
	NI-70	19'-10"	17'-11"	16'-9"	15'-6"	19'-10"	17'-11"	16'-9"	15'-6"
	NI-80	20'-2"	18'-3"	17'-1"	15'-10"	20'-2"	18'-3"	17'-1"	15'-10"
11-7/8"	NI-20	18'-10"	17'-1"	16'-0"	14'-10"	18'-10"	17'-1"	16'-0"	14'-10"
	NI-40x	21'-3"	19'-3"	17'-9"	15'-10"	21'-3"	19'-3"	17'-9"	15'-10"
	NI-60	21'-9"	19'-8"	18'-5"	17'-1"	21'-9"	19'-8"	18'-5"	17'-1"
	NI-70	23'-4"	21'-5"	20'-1"	18'-6"	23'-8"	21'-5"	20'-1"	18'-6"
	NI-80	23'-7"	21'-10"	20'-5"	18'-11"	24'-1"	21'-10"	20'-5"	18'-11"
14"	NI-90x	24'-3"	22'-6"	21'-3"	19'-7"	24'-8"	22'-7"	21'-3"	19'-7"
	NI-40x	24'-2"	21'-5"	19'-6"	17'-5"	24'-2"	21'-5"	19'-6"	17'-5"
	NI-60	24'-9"	22'-5"	21'-0"	19'-6"	24'-9"	22'-5"	21'-0"	19'-6"
	NI-70	26'-1"	24'-3"	22'-9"	21'-0"	26'-8"	24'-3"	22'-9"	21'-0"
	NI-80	26'-6"	24'-7"	23'-3"	21'-6"	27'-1"	24'-10"	23'-3"	21'-6"
16"	NI-90x	27'-3"	25'-4"	24'-1"	22'-4"	27'-9"	25'-10"	24'-3"	22'-4"
	NI-60	27'-3"	24'-11"	23'-5"	21'-7"	27'-6"	24'-11"	23'-5"	21'-7"
	NI-70	28'-8"	26'-8"	25'-3"	23'-4"	29'-3"	26'-11"	25'-3"	23'-4"
	NI-80	29'-1"	27'-0"	25'-9"	23'-10"	29'-8"	27'-6"	25'-10"	23'-10"
	NI-90x	29'-11"	27'-10"	26'-6"	24'-10"	30'-6"	28'-5"	26'-11"	24'-10"

- Maximum clear span applicable to simple-span residential floor construction with a design live load of 40 psf and dead load of 30 psf. The ultimate limit states are based on the factored loads of $1.50L + 1.25D$. The serviceability limit states include the consideration for floor vibration, a live load deflection limit of $L/480$ and a total load deflection limit of $L/240$.
- Spans are based on a composite floor with glued-nailed oriented strand board (OSB) sheathing with a minimum thickness of 3/4 inch for a joist spacing of 24 inches or less. The composite floor may include 1/2 inch gypsum ceiling and/or one row of blocking at mid-span with strapping. Strapping shall be minimum 1x4 inch strap applied to underside of joists at blocking line or 1/2 inch gypsum ceiling attached to joists.
- Minimum bearing length shall be 1-3/4 inches for the end bearings.
- Bearing stiffeners are not required when I-joists are used with the spans and spacings given in this table, except as required for hangers.
- This span chart is based on uniform loads. For applications with other than uniformly distributed loads, an engineering analysis may be required based on the use of the design properties. Tables are based on Limit States Design per CSA O86-09, NBC 2010, and OBC 2012.
- Joists shall be laterally supported at supports and continuously along the compression edge. Refer to technical documentation for installation guidelines and construction details. Nordic I-joists are listed in CCMC evaluation report 13032-R and APA Product Report PR-L274C.

Maximum Floor Spans


Live Load = 40 psf, Dead Load = 15 psf
Simple Spans, L/480 Deflection Limit
5/8" OSB G&N Sheathing

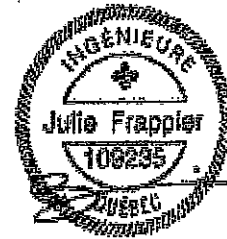

Depth	Series	Bare				1/2" Gypsum Ceiling			
		On Centre Spacing				On Centre Spacing			
		12"	16"	19.2"	24"	12"	16"	19.2"	24"
9-1/2"	NI-20	15'-1"	14'-2"	13'-9"	N/A	15'-7"	14'-8"	14'-2"	N/A
	NI-40x	16'-1"	15'-2"	14'-8"	N/A	16'-7"	15'-7"	15'-1"	N/A
	NI-60	16'-3"	15'-4"	14'-10"	N/A	16'-8"	15'-9"	15'-3"	N/A
	NI-70	17'-1"	16'-1"	15'-6"	N/A	17'-5"	16'-5"	15'-10"	N/A
	NI-80	17'-3"	16'-3"	15'-8"	N/A	17'-8"	16'-7"	16'-0"	N/A
11-7/8"	NI-20	16'-11"	16'-0"	15'-5"	N/A	17'-6"	16'-6"	16'-0"	N/A
	NI-40x	18'-1"	17'-0"	16'-5"	N/A	18'-9"	17'-6"	16'-11"	N/A
	NI-60	18'-4"	17'-3"	16'-7"	N/A	19'-0"	17'-8"	17'-1"	N/A
	NI-70	19'-6"	18'-0"	17'-4"	N/A	20'-1"	18'-7"	17'-9"	N/A
	NI-80	19'-9"	18'-3"	17'-6"	N/A	20'-4"	18'-10"	17'-11"	N/A
14"	NI-90x	20'-4"	18'-9"	17'-11"	N/A	20'-10"	19'-3"	18'-5"	N/A
	NI-40x	20'-1"	18'-7"	17'-10"	N/A	20'-10"	19'-4"	18'-6"	N/A
	NI-60	20'-5"	18'-11"	18'-1"	N/A	21'-2"	19'-7"	18'-9"	N/A
	NI-70	21'-7"	20'-0"	19'-1"	N/A	22'-3"	20'-7"	19'-8"	N/A
	NI-80	21'-11"	20'-3"	19'-4"	N/A	22'-7"	20'-11"	20'-0"	N/A
16"	NI-90x	22'-7"	20'-11"	19'-11"	N/A	23'-3"	21'-6"	20'-6"	N/A
	NI-60	22'-3"	20'-8"	19'-9"	N/A	23'-1"	21'-5"	20'-6"	N/A
	NI-70	23'-5"	21'-9"	20'-9"	N/A	24'-3"	22'-5"	21'-5"	N/A
	NI-80	23'-11"	22'-1"	21'-1"	N/A	24'-8"	22'-10"	21'-9"	N/A
	NI-90x	24'-8"	22'-9"	21'-9"	N/A	25'-4"	23'-5"	22'-4"	N/A

Depth	Series	Mid-Span Blocking				Mid-Span Blocking and 1/2" Gypsum Ceiling			
		On Centre Spacing				On Centre Spacing			
		12"	16"	19.2"	24"	12"	16"	19.2"	24"
9-1/2"	NI-20	16'-8"	15'-3"	14'-5"	N/A	16'-8"	15'-3"	14'-5"	N/A
	NI-40x	17'-11"	16'-11"	16'-1"	N/A	18'-5"	17'-1"	16'-1"	N/A
	NI-60	18'-2"	17'-1"	16'-4"	N/A	18'-7"	17'-4"	16'-4"	N/A
	NI-70	19'-2"	17'-10"	17'-2"	N/A	19'-7"	18'-3"	17'-7"	N/A
	NI-80	19'-5"	18'-0"	17'-4"	N/A	19'-10"	18'-5"	17'-8"	N/A
11-7/8"	NI-20	19'-6"	18'-1"	17'-3"	N/A	19'-11"	18'-3"	17'-3"	N/A
	NI-40x	21'-0"	19'-6"	18'-8"	N/A	21'-7"	20'-2"	19'-2"	N/A
	NI-60	21'-4"	19'-9"	18'-11"	N/A	21'-11"	20'-4"	19'-6"	N/A
	NI-70	22'-6"	20'-10"	19'-11"	N/A	23'-0"	21'-5"	20'-5"	N/A
	NI-80	22'-9"	21'-1"	20'-1"	N/A	23'-3"	21'-7"	20'-8"	N/A
14"	NI-90x	23'-4"	21'-8"	20'-8"	N/A	23'-10"	22'-2"	21'-2"	N/A
	NI-40x	23'-7"	21'-11"	20'-11"	N/A	24'-3"	22'-7"	21'-7"	N/A
	NI-60	24'-0"	22'-3"	21'-3"	N/A	24'-8"	22'-11"	21'-11"	N/A
	NI-70	25'-3"	23'-4"	22'-3"	N/A	25'-10"	24'-0"	22'-11"	N/A
	NI-80	25'-7"	23'-8"	22'-7"	N/A	26'-2"	24'-4"	23'-2"	N/A
16"	NI-90x	26'-4"	24'-4"	23'-3"	N/A	26'-10"	24'-11"	23'-9"	N/A
	NI-60	26'-5"	24'-6"	23'-4"	N/A	27'-2"	25'-3"	24'-2"	N/A
	NI-70	27'-9"	25'-8"	24'-6"	N/A	28'-5"	26'-5"	25'-2"	N/A
	NI-80	28'-2"	26'-1"	24'-10"	N/A	28'-10"	26'-9"	25'-6"	N/A
	NI-90x	29'-0"	26'-10"	25'-7"	N/A	29'-7"	27'-5"	26'-2"	N/A

- Maximum clear span applicable to simple-span residential floor construction with a design live load of 40 psf and dead load of 15 psf. The ultimate limit states are based on the factored loads of 1.50L + 1.25D. The serviceability limit states include the consideration for floor vibration, a live load deflection limit of L/480 and a total load deflection limit of L/240.
- Spans are based on a composite floor with glued-nailed oriented strand board (OSB) sheathing with a minimum thickness of 5/8 inch for a joist spacing of 19.2 inches or less. The composite floor may include 1/2 inch gypsum ceiling and/or one row of blocking at mid-span with strapping. Strapping shall be minimum 1x4 inch strap applied to underside of joists at blocking line or 1/2 inch gypsum ceiling attached to joists.
- Minimum bearing length shall be 1-3/4 inches for the end bearings.
- Bearing stiffeners are not required when I-joists are used with the spans and spacings given in this table, except as required for hangers.
- This span chart is based on uniform loads. For applications with other than uniformly distributed loads, an engineering analysis may be required based on the use of the design properties. Tables are based on Limit States Design per CSA O86-09, NBC 2010, and OBC 2012.
- Joists shall be laterally supported at supports and continuously along the compression edge. Refer to technical documentation for installation guidelines and construction details. Nordic I-joists are listed in CCMC evaluation report 13032-R and APA Product Report PR-L274C.

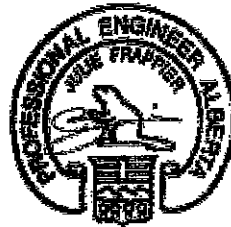

Maximum Floor Spans

Live Load = 40 psf, Dead Load = 15 psf
Simple Spans, L/480 Deflection Limit
3/4" OSB G&N Sheathing



Depth	Series	Bare				1/2" Gypsum Ceiling			
		On Centre Spacing				On Centre Spacing			
		12"	16"	19.2"	24"	12"	16"	19.2"	24"
9-1/2"	NI-20	15'-10"	15'-0"	14'-5"	13'-5"	16'-4"	15'-5"	14'-6"	13'-5"
	NI-40x	17'-0"	16'-0"	15'-5"	14'-9"	17'-5"	16'-5"	15'-10"	15'-2"
	NI-60	17'-2"	16'-2"	15'-7"	14'-11"	17'-6"	16'-7"	15'-11"	15'-3"
	NI-70	18'-0"	16'-11"	16'-3"	15'-7"	18'-5"	17'-3"	16'-7"	15'-11"
	NI-80	18'-3"	17'-1"	16'-5"	15'-9"	18'-8"	17'-5"	16'-9"	16'-1"
11-7/8"	NI-20	17'-10"	16'-10"	16'-2"	15'-6"	18'-6"	17'-4"	16'-9"	16'-1"
	NI-40x	19'-4"	17'-11"	17'-3"	16'-6"	19'-11"	18'-6"	17'-9"	17'-0"
	NI-60	19'-7"	18'-2"	17'-5"	16'-9"	20'-2"	18'-9"	17'-11"	17'-2"
	NI-70	20'-9"	19'-2"	18'-3"	17'-5"	21'-4"	19'-9"	18'-10"	17'-10"
	NI-80	21'-1"	19'-5"	18'-6"	17'-7"	21'-7"	20'-0"	18'-0"	18'-0"
14"	NI-90x	21'-8"	20'-0"	19'-1"	18'-0"	22'-2"	20'-6"	19'-6"	18'-6"
	NI-40x	21'-5"	19'-10"	18'-11"	17'-11"	22'-1"	20'-6"	19'-7"	18'-7"
	NI-60	21'-10"	20'-2"	19'-3"	18'-2"	22'-5"	20'-10"	19'-11"	18'-10"
	NI-70	23'-0"	21'-3"	20'-3"	19'-2"	23'-8"	21'-11"	20'-10"	19'-9"
	NI-80	23'-5"	21'-7"	20'-7"	19'-5"	24'-0"	22'-3"	21'-2"	20'-0"
16"	NI-90x	24'-1"	22'-3"	21'-2"	20'-0"	24'-8"	22'-10"	21'-9"	20'-7"
	NI-60	23'-9"	22'-0"	20'-11"	19'-10"	24'-6"	22'-9"	21'-8"	20'-6"
	NI-70	25'-1"	23'-2"	22'-0"	20'-10"	25'-9"	23'-10"	22'-9"	21'-6"
	NI-80	25'-6"	23'-6"	22'-4"	21'-2"	26'-1"	24'-2"	23'-1"	21'-10"
	NI-90x	26'-4"	24'-3"	23'-1"	21'-10"	26'-11"	24'-11"	23'-8"	22'-5"

Depth	Series	Mid-Span Blocking				Mid-Span Blocking and 1/2" Gypsum Ceiling			
		On Centre Spacing				On Centre Spacing			
		12"	16"	19.2"	24"	12"	16"	19.2"	24"
9-1/2"	NI-20	16'-10"	15'-5"	14'-6"	13'-5"	16'-10"	15'-5"	14'-6"	13'-5"
	NI-40x	18'-8"	17'-2"	16'-3"	15'-2"	18'-10"	17'-2"	16'-3"	15'-2"
	NI-60	18'-11"	17'-6"	16'-6"	15'-5"	19'-2"	17'-6"	16'-6"	15'-5"
	NI-70	20'-0"	18'-7"	17'-9"	16'-7"	20'-5"	18'-11"	17'-10"	16'-7"
	NI-80	20'-3"	18'-10"	17'-11"	16'-10"	20'-8"	19'-3"	18'-2"	16'-10"
11-7/8"	NI-20	20'-1"	18'-5"	17'-5"	16'-2"	20'-1"	18'-5"	17'-5"	16'-2"
	NI-40x	21'-10"	20'-4"	19'-4"	17'-8"	22'-5"	20'-6"	19'-4"	17'-8"
	NI-60	22'-1"	20'-7"	19'-7"	18'-4"	22'-8"	20'-10"	19'-8"	18'-4"
	NI-70	23'-4"	21'-8"	20'-8"	19'-7"	23'-10"	22'-3"	21'-2"	19'-9"
	NI-80	23'-7"	21'-11"	20'-11"	19'-9"	24'-1"	22'-6"	21'-5"	20'-0"
14"	NI-90x	24'-3"	22'-6"	21'-6"	20'-4"	24'-8"	23'-0"	22'-0"	20'-9"
	NI-40x	24'-5"	22'-9"	21'-8"	19'-5"	25'-1"	23'-2"	21'-9"	19'-5"
	NI-60	24'-10"	23'-1"	22'-0"	20'-10"	25'-6"	23'-8"	22'-4"	20'-10"
	NI-70	26'-1"	24'-3"	23'-2"	21'-10"	26'-8"	24'-11"	23'-9"	22'-4"
	NI-80	26'-6"	24'-7"	23'-5"	22'-2"	27'-1"	25'-3"	24'-1"	22'-9"
16"	NI-90x	27'-3"	25'-4"	24'-1"	22'-9"	27'-9"	25'-11"	24'-8"	23'-4"
	NI-60	27'-3"	25'-5"	24'-2"	22'-10"	28'-0"	26'-2"	24'-9"	23'-1"
	NI-70	28'-8"	26'-8"	25'-4"	23'-11"	29'-3"	27'-4"	26'-1"	24'-8"
	NI-80	29'-1"	27'-0"	25'-9"	24'-4"	29'-8"	27'-9"	26'-5"	25'-0"
	NI-90x	29'-11"	27'-10"	26'-6"	25'-0"	30'-6"	28'-5"	27'-2"	25'-8"

- Maximum clear span applicable to simple-span residential floor construction with a design live load of 40 psf and dead load of 15 psf. The ultimate limit states are based on the factored loads of 1.50L + 1.25D. The serviceability limit states include the consideration for floor vibration, a live load deflection limit of L/480 and a total load deflection limit of L/240.
- Spans are based on a composite floor with glued-nailed oriented strand board (OSB) sheathing with a minimum thickness of 3/4 inch for a joist spacing of 24 inches or less. The composite floor may include 1/2 inch gypsum ceiling and/or one row of blocking at mid-span with strapping. Strapping shall be minimum 1x4 inch strap applied to underside of joists at blocking line or 1/2 inch gypsum ceiling attached to joists.
- Minimum bearing length shall be 1-3/4 inches for the end bearings.
- Bearing stiffeners are not required when I-joists are used with the spans and spacings given in this table, except as required for hangers.
- This span chart is based on uniform loads. For applications with other than uniformly distributed loads, an engineering analysis may be required based on the use of the design properties. Tables are based on Limit States Design per CSA O86-09, NBC 2010, and OBC 2012.
- Joists shall be laterally supported at supports and continuously along the compression edge. Refer to technical documentation for installation guidelines and construction details. Nordic I-joists are listed in CCMC evaluation report 13032-R and APA Product Report PR-1274C.

Maximum Floor Spans

Live Load = 40 psf, Dead Load = 30 psf
 Simple Spans, L/480 Deflection Limit
 5/8" OSB G&N Sheathing

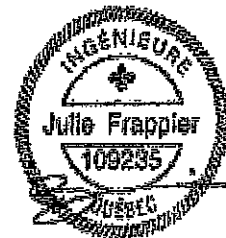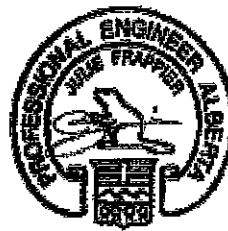

Depth	Series	Bare				1/2" Gypsum Ceiling			
		On Centre Spacing				On Centre Spacing			
		12"	16"	19.2"	24"	12"	16"	19.2"	24"
9-1/2"	NI-20	15'-1"	14'-1"	13'-3"	N/A	15'-7"	14'-1"	13'-3"	N/A
	NI-40x	16'-1"	15'-2"	14'-8"	N/A	16'-7"	15'-7"	15'-1"	N/A
	NI-60	16'-3"	15'-4"	14'-10"	N/A	16'-8"	15'-9"	15'-3"	N/A
	NI-70	17'-1"	16'-1"	15'-6"	N/A	17'-5"	16'-5"	15'-10"	N/A
	NI-80	17'-3"	16'-3"	15'-8"	N/A	17'-8"	16'-7"	16'-0"	N/A
11-7/8"	NI-20	16'-11"	16'-0"	15'-5"	N/A	17'-6"	16'-6"	16'-0"	N/A
	NI-40x	18'-1"	17'-0"	16'-5"	N/A	18'-9"	17'-6"	16'-11"	N/A
	NI-60	18'-4"	17'-3"	16'-7"	N/A	19'-0"	17'-8"	17'-1"	N/A
	NI-70	19'-6"	18'-0"	17'-4"	N/A	20'-1"	18'-7"	17'-9"	N/A
	NI-80	19'-9"	18'-3"	17'-6"	N/A	20'-4"	18'-10"	17'-11"	N/A
14"	NI-90x	20'-4"	18'-9"	17'-11"	N/A	20'-10"	19'-3"	18'-5"	N/A
	NI-40x	20'-1"	18'-7"	17'-10"	N/A	20'-10"	19'-4"	18'-6"	N/A
	NI-60	20'-5"	18'-11"	18'-1"	N/A	21'-2"	19'-7"	18'-9"	N/A
	NI-70	21'-7"	20'-0"	19'-1"	N/A	22'-3"	20'-7"	19'-8"	N/A
	NI-80	21'-11"	20'-3"	19'-4"	N/A	22'-7"	20'-11"	20'-0"	N/A
16"	NI-90x	22'-7"	20'-11"	19'-11"	N/A	23'-3"	21'-6"	20'-6"	N/A
	NI-60	22'-3"	20'-8"	19'-9"	N/A	23'-1"	21'-5"	20'-6"	N/A
	NI-70	23'-6"	21'-9"	20'-9"	N/A	24'-3"	22'-5"	21'-5"	N/A
	NI-80	23'-11"	22'-1"	21'-1"	N/A	24'-8"	22'-10"	21'-9"	N/A
	NI-90x	24'-8"	22'-9"	21'-9"	N/A	25'-4"	23'-5"	22'-4"	N/A

Depth	Series	Mid-Span Blocking				Mid-Span Blocking and 1/2" Gypsum Ceiling			
		On Centre Spacing				On Centre Spacing			
		12"	16"	19.2"	24"	12"	16"	19.2"	24"
9-1/2"	NI-20	15'-7"	14'-1"	13'-3"	N/A	15'-7"	14'-1"	13'-3"	N/A
	NI-40x	17'-9"	16'-1"	15'-1"	N/A	17'-9"	16'-1"	15'-1"	N/A
	NI-60	18'-1"	16'-4"	15'-4"	N/A	18'-1"	16'-4"	15'-4"	N/A
	NI-70	19'-2"	17'-10"	16'-9"	N/A	19'-7"	17'-10"	16'-9"	N/A
	NI-80	19'-5"	18'-0"	17'-1"	N/A	19'-10"	18'-3"	17'-1"	N/A
11-7/8"	NI-20	18'-9"	17'-0"	16'-0"	N/A	18'-9"	17'-0"	16'-0"	N/A
	NI-40x	21'-0"	19'-3"	17'-9"	N/A	21'-3"	19'-3"	17'-9"	N/A
	NI-60	21'-4"	19'-8"	18'-5"	N/A	21'-8"	19'-8"	18'-5"	N/A
	NI-70	22'-6"	20'-10"	19'-11"	N/A	23'-0"	21'-4"	20'-0"	N/A
	NI-80	22'-9"	21'-1"	20'-1"	N/A	23'-3"	21'-7"	20'-5"	N/A
14"	NI-90x	23'-4"	21'-8"	20'-8"	N/A	23'-10"	22'-2"	21'-2"	N/A
	NI-40x	23'-7"	21'-5"	19'-6"	N/A	24'-1"	21'-5"	19'-6"	N/A
	NI-60	24'-0"	22'-3"	21'-0"	N/A	24'-8"	22'-5"	21'-0"	N/A
	NI-70	25'-3"	23'-4"	22'-3"	N/A	25'-10"	24'-0"	22'-9"	N/A
	NI-80	25'-7"	23'-8"	22'-7"	N/A	26'-2"	24'-4"	23'-2"	N/A
16"	NI-90x	26'-4"	24'-4"	23'-3"	N/A	26'-10"	24'-11"	23'-9"	N/A
	NI-60	26'-5"	24'-6"	23'-4"	N/A	27'-2"	24'-10"	23'-4"	N/A
	NI-70	27'-9"	25'-8"	24'-6"	N/A	28'-5"	26'-5"	25'-2"	N/A
	NI-80	28'-2"	26'-1"	24'-10"	N/A	28'-10"	26'-9"	25'-6"	N/A
	NI-90x	29'-0"	26'-10"	25'-7"	N/A	29'-7"	27'-5"	26'-2"	N/A


- Maximum clear span applicable to simple-span residential floor construction with a design live load of 40 psf and dead load of 30 psf. The ultimate limit states are based on the factored loads of 1.50L + 1.25D. The serviceability limit states include the consideration for floor vibration, a live load deflection limit of L/480 and a total load deflection limit of L/240.
- Spans are based on a composite floor with glued-nailed oriented strand board (OSB) sheathing with a minimum thickness of 5/8 inch for a joist spacing of 19.2 inches or less. The composite floor may include 1/2 inch gypsum ceiling and/or one row of blocking at mid-span with strapping. Strapping shall be minimum 1x4 inch strap applied to underside of joists at blocking line or 1/2 inch gypsum ceiling attached to joists.
- Minimum bearing length shall be 1-3/4 inches for the end bearings.
- Bearing stiffeners are not required when I-joists are used with the spans and spacings given in this table, except as required for hangers.
- This span chart is based on uniform loads. For applications with other than uniformly distributed loads, an engineering analysis may be required based on the use of the design properties. Tables are based on Limit States Design per CSA O85-09, NBC 2010, and OBC 2012.
- Joists shall be laterally supported at supports and continuously along the compression edge. Refer to technical documentation for installation guidelines and construction details. Nordic I-joists are listed in CCMC evaluation report 13032-R and APA Product Report PR-L274C.

Allowance for Piping (Installation Notes)

The floor layouts have usually not been checked for heating and/or plumbing interference. On-site adjustment of joists of up to 3 inches is permitted to avoid interferences. When moving a joist, the subfloor thickness shall be checked with code requirements when the joist spacing exceeds 19.2 inches. Except for cutting to length, I-joist flanges should never be cut, drilled, or notched.



Installation of Nordic I-joists shall be as per *Nordic Joist Installation Guide for Residential Floors*. Refer to Tables 1 and 2 for maximum web hole and duct chase openings, respectively. These tables are based on the I-joists being used at their maximum spans. The minimum distance given may be reduced for shorter spans; contact your distributor for additional information.

The detail below shows the 3-inch allowance for piping. Every third joist may be shifted up to 3 inches to avoid heating/plumbing interference. For other applications, please contact your distributor.

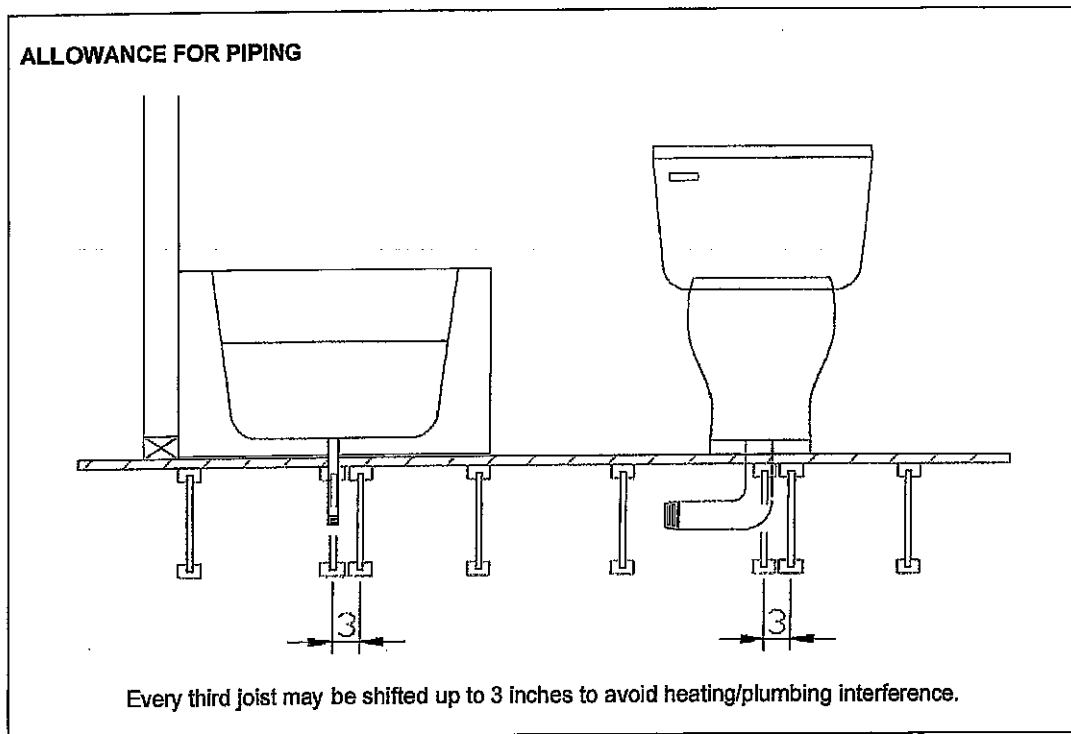

Revised April 12, 2012

1w-1

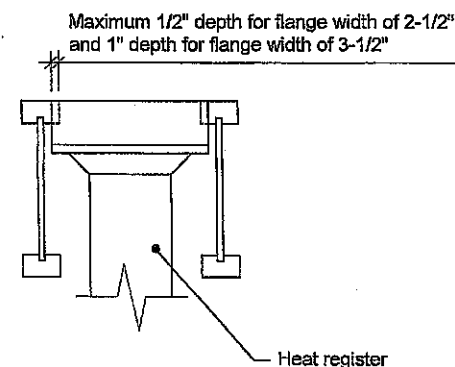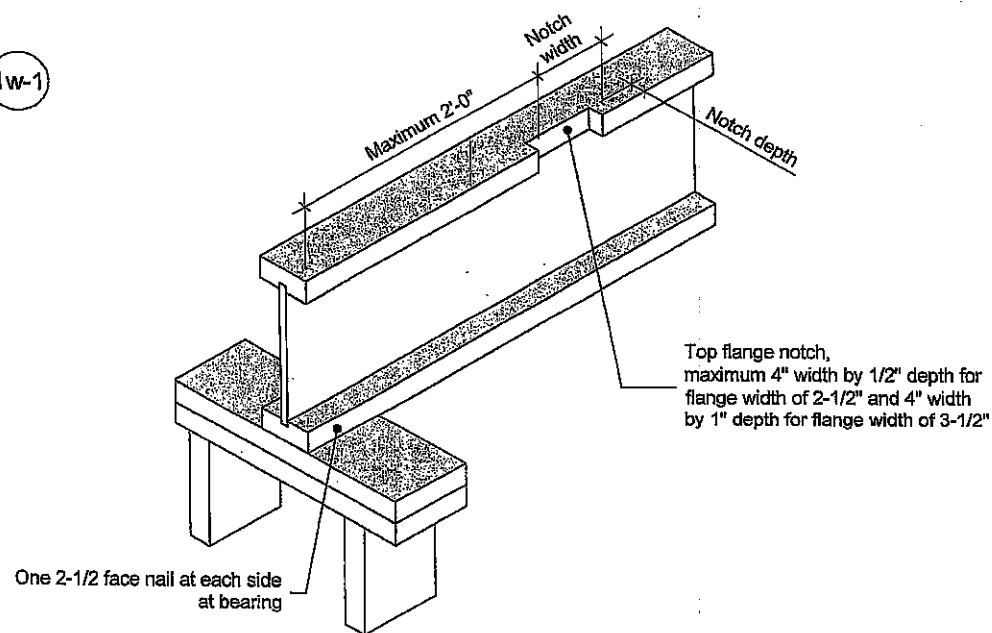

Notes:

1. Blocking required at bearing for lateral support, not shown for clarity.
2. The maximum dimensions for a notch on the side of the top flange are 4-inch width by 1/2-inch depth for flange width of 2-1/2 inches, and 4-inch width by 1-inch depth for flange width of 3-1/2 inches.
3. This detail applies to simple-span joists and multiple-span joists where the notch is located at the end half-span.
4. For other applications, contact Nordic Structures.

This document supersedes all previous versions. If the document has been in effect for more than one year, consult nordic.ca or contact Nordic Structures.

All nails shown in the details are assumed to be common nails unless otherwise noted. Nails shall have a diameter not less than 0.128 inch for 2-1/2-inch nails, or 0.144 inch for 3-inch nails. Individual components not shown to scale for clarity.

NORDIC
STRUCTURES

T 514-871-8526
1 866 817-3418
nordic.ca

TITLE

Notch in I-joist for Heat Register

CATEGORY

I-joist - Typical Floor Framing and Construction Details

DOCUMENT

-

DATE

2018-04-10

NUMBER

1w-1