It is the builder's complete responsibility to ensure that all plans submitted for approval fully comply with the Architectural Guidelines and all applicable regulations and requirements including zoning provisions and any provisions in the subdivision agreement. The Control Architect is not responsible in any way for examining or approving site (lotting) plans or working drawings with respect to any zoning or building code or permit matter or that any house can be properly built or located on its lot.

This is to certify that these plans comply with the applicable Architectural Design Guidelines approved by the City of HAMILTON.

JOHN G. WILLIAMS LTD., ARCHITECT
ARCHITECTURAL CONTROL REVIEW AND APPROVAL
APPROVED BY: _____
DATE: NOV 10, 2020
This stamp certifies compliance with the applicable Design Guidelines only and bears no further professional responsibility.

CITY OF HAMILTON
BUILDING DIVISION
Planning & Development Department
NOV 27 2020
REC'D BY _____ DATE _____
REF'D TO _____ DATE _____

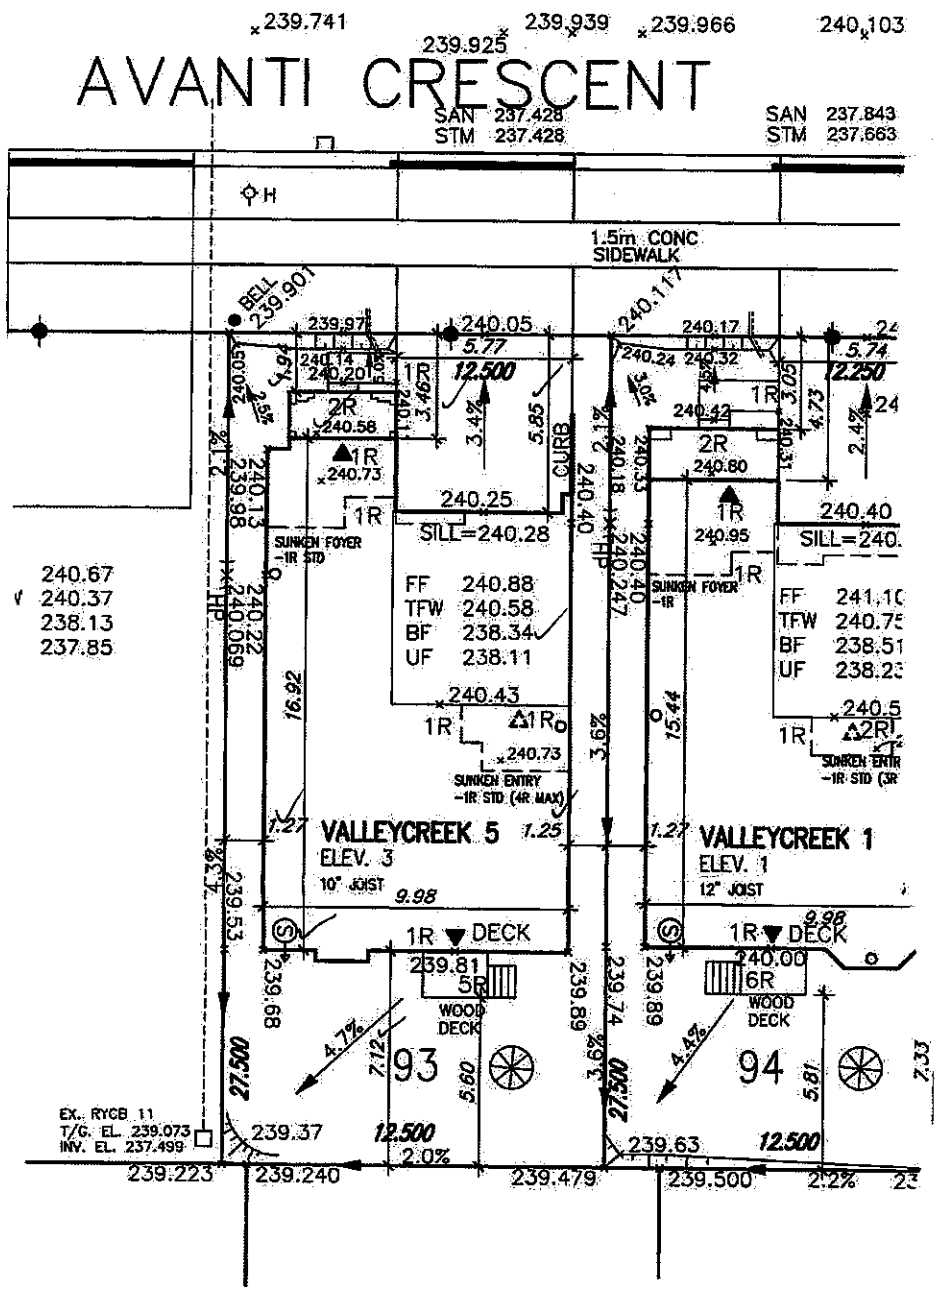

DECK PERMIT
20-197524

CITY OF HAMILTON
Building Division
Permit No. 20-196197
THESE STAMPED DRAWINGS SHALL BE AVAILABLE ON SITE
THE OWNER AND/OR CONTRACTOR SHALL COMPLY WITH THE ONTARIO BUILDING CODE AND ALL OTHER APPLICABLE LAW
These drawings and/or specifications have been reviewed by
G. Robinson 12/19/20.
FOR CHIEF BUILDING OFFICIAL DATE

THIS LOT GRADING PLAN HAS BEEN REVIEWED BY METROPOLITAN CONSULTING INC. FOR CONFORMANCE WITH THE APPROVED SUBDIVISION GRADING DESIGN. THE PROPOSED GRADES ON THIS PLAN ARE IN GENERAL CONFORMITY WITH THE APPROVED GRADING PLAN AS IT RELATES TO THIS LOT AND ADJACENT LOTS. WHERE THE BASEMENT FLOOR OR OTHER FOUNDATION ELEVATIONS ARE PROPOSED AT A DIFFERENT ELEVATION THAN THAT SHOWN ON THE APPROVED SUBDIVISION PLANS THE SEWER LATERALS HAVE BEEN REVIEWED AND WE ARE SATISFIED THAT THE MINIMUM GRADES FOR THESE LATERALS CAN BE MAINTAINED IN ACCORDANCE WITH THE REQUIREMENTS OF THE O.B.C. AND CITY DESIGN CRITERIA. NOTE: THIS CERTIFICATION DOES NOT REPLACE THE BUILDER'S RESPONSIBILITY TO EXPOSE THE SEWER LATERALS AND CONFIRM ELEVATIONS PRIOR TO EXCAVATING FOR THE FOUNDATION. BY USE OF THIS PLAN THE BUILDER AGREES THAT THEY SHALL BE RESPONSIBLE FOR IMMEDIATELY REPORTING TO METROPOLITAN CONSULTING ANY DISCREPANCY OR VARIATION BETWEEN THE LATERAL INFORMATION AND GRADES DEPICTED ON THIS PLAN AND THE CONDITIONS FOUND IN THE FIELD

LICENSED PROFESSIONAL ENGINEER
10/29/2020
N. R. POKHAREL
100156322
PROVINCE OF ONTARIO

LOT 93		
LOT No.	LOT WIDTH (M) (@ 6.0m)	LOT AREA (M^2)
93	12.50	343.75

Grading Notes:
It shall be the responsibility of the builder to have all grades and services verified and checked before construction by an approved grading engineer. These grades and the placement of storm and sanitary services off the street are to meet the requirements of the municipality having jurisdiction.

VA3 Design Inc. is to be notified promptly of any discrepancies at least 1 (one) week prior to excavation commences in order that the building can be re-sited. Failure to observe these conditions may require expensive remedial action that will not be the responsibility of or cost to VA3 Design Inc. Foundation wall shall be poured to a minimum of 6" above approved grades.

Finished grade lines as indicated on the house prototype are for reference only and do not necessarily depict finish grading conditions of any particular lot.

These drawings are to be read in conjunction with municipal approved site engineering drawings prepared by Metropolitan Consulting Inc.

NOTE: SUMP PUMP REQUIRED (S)
SUMP PUMPS CONNECTED TO STORM SEWER ARE REQUIRED AS PER THE APPROVED SITE ENGINEERING DRAWINGS. REFER TO DRAWINGS PREPARED BY METROPOLITAN CONSULTING INC. SHEET W14017-N1.

NOTE: REFER TO LANDSCAPE DRAWINGS FOR ALL FENCING TYPES, HEIGHTS AND LOCATIONS. CONTRACTOR TO VERIFY PRIOR TO INSTALLATION.

PROPOSED VALVE
LP LIGHT POLE
H HYDRANT
WATER SERVICE
TRANSFORMER
DOUBLE STM./SAN. CONNECTION
SINGLE STM./SAN. CONNECTION
CATCH BASIN
CABLE TELEVISION PEDESTAL
BELL PEDESTAL
_R No. OF RISERS
FF FINISHED FLOOR ELEVATION
ML FINISHED MAIN LEVEL ELEVATION
UF UNDERSIDE FOOTING ELEVATION
BF FIN. BASEMENT FLOOR SLAB
TFW TOP OF FOUNDATION WALL
UFR UNDERSIDE FOOTING AT REAR
UFF UNDERSIDE FOOTING AT FRONT
UFS UNDERSIDE FOOTING AT SIDE
W.O.D. WALK OUT DECK
W.O.B. WALK OUT BASEMENT
REV REVERSE PLAN
STREET SIGN
MAIL BOX
RETAINING WALL
CHAIN LINK FENCE (SEE LANDSCAPE PLAN)
ACOUSTICAL FENCE (SEE LANDSCAPE PLAN)
WOOD SCREEN FENCE (SEE LANDSCAPE PLAN)
HYDRO SERVICE LATERAL
HYDRO METER
GAS METER
SWALE DIRECTION
EMBANKMENT (3:1 SLOPE unless otherwise noted)
PROVIDE 3/4" DIA. CLEAR STONE IN THIS AREA
THIS LOT CONTAINS ENGINEERED FILL
AC AIR CONDITIONER REQUIRED
RAIN WATER DOWNSPOUT LOCATION (DISCHARGE ONTO SPLASHPAD)
SIDE WINDOW LOCATION
OPT. DOOR LOCATION
EXTERIOR DOOR LOCATION
REDUCE SIDE YARD
north arrow

no.	description	date	by
9	.	.	.
8	.	.	.
7	.	.	.
6	.	.	.
5	.	.	.
4	.	.	.
3	.	.	.
2	REVISED. REISSUED.	OCT 23/20	GW
1	ISSUED FOR PERMIT.	SEP 29/20	GW

The undersigned has reviewed and takes responsibility for this design and has the qualifications and meets the requirements set out in the Ontario Building Code to be a Designer.
qualification information
name: Richard Vink — signature: R Vink — registration information: BCIN 24488
VA3 Design Inc. 42658

Builder to verify location of all hydrants, street lights, transformers and other services. If minimum dimensions are not maintained, builder is to relocate at his own expense.
Builder to verify service connection elevations prior to constructing foundations. ** Drawings NOT to be scaled **

VA3 DESIGN
255 Consumers Rd Suite 120
Toronto ON M2J 1R4
t 416.630.2255 f 416.630.4782
va3design.com

Greenpark
project name: RUSSELL GARDENS PHASE 3
municipality: HAMILTON
date: SEPT. 2020
LOT SITING/GRADING
drawn by: GW
checked by: -
scale: 1:250
file name: 19014-RG3-SITE-LAYOUTS
GREG - H:\ARCHIVE\WORKING\2019\19014.GRE\SITE PLAN\19014-RG3-SITE-LAYOUTS.dwg - Mon - Oct 26 2020 - 9:40 AM
lot/block no. 093
registered plan no. 62M-1266
project no. 19014
drawing no. 1

All design specifications, related documents and designs are the copyright property of VA3 DESIGN. Reproduction of this property in whole or in part is strictly prohibited without VA3 DESIGN's written permission.