

3189 SF.

STRIP FOOTINGS - FOR SINGLES & SEMIS UP TO 2 STOREYS

8" OR 10" FOUNDATION WALLS WITH 2"x6" / 2"x10" FLOOR JOISTS
20"x8" CONCRETE STRIP FOOTINGS BELOW FOUNDATION WALLS.
24"x8" CONCRETE STRIP FOOTINGS BELOW PARTY WALLS.
FOUNDATION WALLS WITH ENGINEERED JOISTS OVER 16' SPANS
24"x8" CONCRETE STRIP FOOTINGS BELOW FOUNDATION WALLS.

FOOTINGS ON ENGINEERED FILL

24"x8" CONCRETE STRIP FOOTINGS WITH REINFORCING
BELOW EXTERIOR WALLS.
30"x8" CONCRETE STRIP FOOTINGS WITH REINFORCING
BELOW PARTY WALLS.
(REFER TO ENGINEER FILL FOOTING DETAIL)

ASSUME THE LARGER FOOTING SIZE WHEN TWO CONDITIONS APPLY

ASSUMED 120 KPa (18 p.s.i.) SOIL BEARING CAPACITY FOR SINGLES OR 90 KPa
FOR ENGINEERED FILL TO BE VERIFIED ON SITE.

PAD FOOTINGS

120 KPa NATIVE SOIL **90 KPa ENGINEERED FILL SOIL**
F1 = 42"x42"x18" CONCRETE PAD F1 = 48"x48"x20" CONCRETE PAD
F2 = 36"x36"x16" CONCRETE PAD F2 = 40"x40"x16" CONCRETE PAD
F3 = 30"x30"x12" CONCRETE PAD F3 = 34"x34"x14" CONCRETE PAD
F4 = 24"x24"x12" CONCRETE PAD F4 = 28"x28"x12" CONCRETE PAD
F5 = 16"x16"x8" CONCRETE PAD F5 = 18"x18"x8" CONCRETE PAD
(REFER TO FLOOR PLAN FOR UNUSUAL SIZE PADS/NOT ON CHART.)

VENEER CUT

WHEN VENEER CUT IS GREATER THAN 26", A 10"
POURED CONCRETE FOUNDATION WALL IS REQUIRED.

EXPOSED CONCRETE (FLATWORK)

ALL GARAGE SLABS, PORCH SLABS, STAIRS (EXPOSED CONC.
FLAT WORK) TO BE 32 MPa WITH 5-8% AIR ENTRAINMENT.

BRICK VENEER LINTELS (WL)

WL1 = 3-1/2" x 3-1/2" x 1/4" L (90x90x6.0L) + 2-2"x8" SPR. No.2
WL2 = 4" x 3-1/2" x 5/16" L (100x90x8.0L) + 2-2"x8" SPR. No.2
WL3 = 5" x 3-1/2" x 5/16" L (125x90x8.0L) + 2-2"x10" SPR. No.2
WL4 = 6" x 3-1/2" x 3/8" L (150x90x10.0L) + 2-2"x12" SPR. No.2
WL5 = 6" x 4" x 3/8" L (150x100x10.0L) + 2-2"x12" SPR. No.2
WL6 = 5" x 3-1/2" x 5/16" L (125x90x8.0L) + 2-2"x12" SPR. No.2
WL7 = 5" x 3-1/2" x 5/16" L (125x90x8.0L) + 3-2"x12" SPR. No.2
WL8 = 5" x 3-1/2" x 5/16" L (125x90x8.0L) + 3-2"x10" SPR. No.2
WL9 = 6" x 4" x 3/8" L (150x100x10.0L) + 3-2"x10" SPR. No.2

WOOD LINTELS AND BEAMS (WB)

WB1 = 2-2"x8" (2-38x184) SPR. No.2
WB2 = 3-2"x8" (3-38x184) SPR. No.2
WB3 = 2-2"x10" (2-38x235) SPR. No.2
WB4 = 3-2"x10" (3-38x235) SPR. No.2
WB5 = 2-2"x12" (2-38x286) SPR. No.2
WB6 = 3-2"x12" (3-38x286) SPR. No.2
WB7 = 5-2"x12" (5-38x286) SPR. No.2
WB11 = 4-2"x10" (4-38x235) SPR. No.2
WB12 = 4-2"x12" (4-38x286) SPR. No.2

LAMINATED VENEER LUMBER (LVL) BEAMS

LVL1A = 1-1 3/4" x 7 1/4" (1-45x184)
LVL1 = 2-1 3/4" x 7 1/4" (2-45x184)
LVL2 = 3-1 3/4" x 7 1/4" (3-45x184)
LVL3 = 4-1 3/4" x 7 1/4" (4-45x184)
LVL4A = 1-1 3/4" x 9 1/2" (1-45x240)
LVL4 = 2-1 3/4" x 9 1/2" (2-45x240)
LVL5 = 3-1 3/4" x 9 1/2" (3-45x240)
LVL5A = 4-1 3/4" x 9 1/2" (4-45x240)
LVL6A = 1-1 3/4" x 11 7/8" (1-45x300)
LVL6 = 2-1 3/4" x 11 7/8" (2-45x300)
LVL7 = 3-1 3/4" x 11 7/8" (3-45x300)
LVL8 = 2-1 3/4" x 14" (2-45x356)
LVL9 = 3-1 3/4" x 14" (3-45x356)

LOOSE STEEL LINTELS (L)

L1 = 3-1/2" x 3-1/2" x 1/4" L (90x90x6.0L)
L2 = 4" x 3-1/2" x 5/16" L (100x90x8.0L)
L3 = 5" x 3-1/2" x 5/16" L (125x90x8.0L)
L4 = 6" x 3-1/2" x 3/8" L (150x90x10.0L)
L5 = 6" x 4" x 3/8" L (150x100x10.0L)
L6 = 7" x 4" x 3/8" L (180x100x10.0L)

DOOR SCHEDULE

NOS.	WIDTH	HEIGHT 8'-9" CEILING	HEIGHT 10' OR MORE CEILING	TYPE
1	2'-10"	6'-8"	8'-0"	INSULATED ENTRANCE DOOR
1a	2'-8"	6'-8"	8'-0"	INSULATED FRONT DOORS
2	2'-8"	6'-8"	8'-0"	WOOD & GLASS DOOR
3	2'-8"	6'-8"	8'-0"	EXTERIOR SLAB DOOR
4	2'-8"	6'-8"	8'-0"	INTERIOR SLAB DOOR
5	2'-6"	6'-8"	8'-0"	INTERIOR SLAB DOOR
6	2'-2"	6'-8"	8'-0"	INTERIOR SLAB DOOR
7	1'-6"	6'-8"	8'-0"	INTERIOR SLAB DOOR

CERAMIC TILE FOR CONVENTIONAL LUMBER

(CBC 9.30.6)

SPACE ALL CONVENTIONAL FLOOR JOISTS @ 12" O.C.
BELOW ALL CERAMIC TILE AREAS.
PROVIDE 1 ROW BRIDGING FOR SPANS OF 5'-0"-7'-0".
2 ROWS FOR SPANS GREATER THAN 7'-0".

NOTE: ROOF FRAMING

REFER TO ROOF TRUSS SHOP DRAWINGS FOR ALL
ROOF FRAMING INFORMATION UNLESS OTHERWISE
NOTED.


PLANS NOT DRAWN TO ACTUAL GRADE. REFER TO
FINAL APPROVED GRADING PLAN.

NOTE: ENGINEERED FLOOR FRAMING

REFER TO ENGINEERED FLOOR LAYOUTS FOR ALL
ENGINEERED FLOOR FRAMING INFORMATION AND
DETAILS. UNLESS OTHERWISE NOTED.

**TWO STOREY HEIGHT
WALL DETAIL**


2-2"x6" STUD WALL NAILED TOGETHER AND
SPACED @ 12" O.C. FULL HEIGHT, 1/4" SOLID
BLOCKING @ 4'-0" O.C. VERTICAL AND 7/16"
EXT. PLYWOOD SHEATHING.

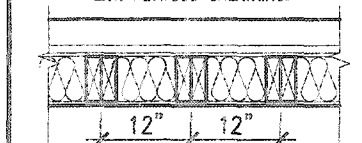

NOTE: MAXIMUM HEIGHT OF WALL FOR THIS
DETAIL IS 18'-0" AND MAX. SUPPORTED
LENGTH OF TRUSS IS 40'-0".

**TWO STOREY HEIGHT
WALL DETAIL**


2-1 1/2" x 5 1/2" TIMBERSTRAND (LS) 1.5E
STUD WALL CLUED & NAILED TOGETHER AND
SPACED MAX. @ 10" O.C. FULL HEIGHT, 1/4" SOLID
BLOCKING @ 8'-0" O.C. VERTICAL AND 7/16"
EXT. OSB SHEATHING.

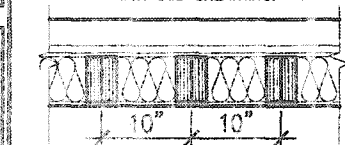

NOTE: MAXIMUM HEIGHT OF WALL FOR THIS
DETAIL IS 20'-2" AND MAX. SUPPORTED
LENGTH OF TRUSS IS 40'-0".

**TWO STOREY HEIGHT
WALL DETAIL**

2-1 1/2" x 5 1/2" TIMBERSTRAND (LS) 1.5E
STUD WALL CLUED & NAILED TOGETHER AND
SPACED MAX. @ 9" O.C. FULL HEIGHT, 1/4" SOLID
BLOCKING @ 8'-0" O.C. VERTICAL AND 7/16"
EXT. OSB SHEATHING.

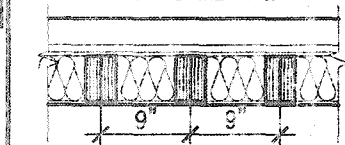

NOTE: MAXIMUM HEIGHT OF WALL FOR THIS
DETAIL IS 21'-5" AND MAX. SUPPORTED
LENGTH OF TRUSS IS 40'-0".

THE MINIMAL THERMAL PERFORMANCE OF BUILDING
ENVELOPE AND EQUIPMENT SHALL CONFORM TO
THE FOLLOWING SB-12 COMPLIANCE PACKAGE AS
PER CBC SUPPLEMENTARY STANDARD SB-12,
SECTION 3.1.1.1.

USE SB-12 COMPLIANCE PACKAGE (A1)

COMPONENT	A1	Notes:
Ceiling with Attic Space	10.56 (R60)	R20 at inner face
Minimum RSI (R) value		of exterior walls
Ceiling without Attic Space	5.46 (R31)	BATT or SPRAY
Minimum RSI (R) value		
Exposed Floor	5.46 (R31)	BATT or SPRAY
Minimum RSI (R) value		
Walls Above Grade	3.87 (R22)	6" R22 BATT
Minimum RSI (R) value		
Basement Walls	3.52ci (R20ci)	OPTION TO USE R12+R10ci.
Minimum RSI (R) value		
Edge of Below Grade Slab ≤ 600mm below grade	1.76 (R10)	RIGID INSUL
Minimum RSI (R) value		
Windows & Sliding glass Doors	0.28	
Maximum U-value		
Skylights	0.49	
Maximum U-value		
Space Heating Equipment	95% Min.	NATURAL GAS
Minimum AFUE		
Hot Water Heater	0.8	NATURAL GAS
Minimum EF		
HRV	75%	-
Minimum Efficiency		
Drain Water Heat Recovery Unit (DWHR)	Minimum 1 OR Maximum 2 Required. Dependent on number of showers installed. Refer to SB12-3.1.1.12 for information	

ci- Denotes Continuous Insulation without framing interruption.

It is the builder's complete responsibility to
ensure that all plans submitted for approval
fully comply with the Architectural Guidelines
and all applicable regulations and requirements
including zoning provisions and any provisions
in the subdivision agreement. The Control
Architect is not responsible in any way for
examining or approving site (lotting) plans or
working drawings with respect to any zoning or
building code or permit matter or that any
house can be properly built or located on its lot.

This is to certify that these plans comply
with the applicable Architectural Design
Guidelines approved by the City of
HAMILTON



STRUDET INC.
FOR STRUCTURE ONLY

MOUNTAINASH 4-014

COMPLIANCE PACKAGE 'A1'



255 Consumers Rd Suite 120
Toronto ON M2J 1R4
416.630.2255 f 416.630.4782
va3design.com



project name
RUSSELL GARDENS PH. 3 municipality
HAMILTON, ON.

MOUNTAINASH 4
13.5m project no.
19014

date
JAN. 2020 GENERAL NOTES & CHARTS
drawn by
N.HUR checked by
3/16" = 1'-0" title name
18014-MOUNTAINASH-4-014
drawing no.
A0

All drawings, specifications, related documents and design are the copyright property of VAS DESIGN. Reproduction of this property in whole or in part is strictly prohibited without VAS DESIGN's written permission.

UNINSULATED OPENINGS (PER CBC SB-12.3.1.1(7))			
MOUNTAINASH 4-014, EL. 3 (4 BED)	ENERGY EFFICIENCY - CBC SB12		
ELEVATION	WALL AREA S.F.	OPENING S.F.	PERCENTAGE
FRONT	824.75 S.F.	201.56 S.F.	24.44 %
LEFT SIDE	1482.43 S.F.	80.01 S.F.	5.40 %
RIGHT SIDE	1489.83 S.F.	69.06 S.F.	4.64 %
REAR	1194.00 S.F.	282.45 S.F.	23.66 %
* OPENINGS OMITTED AS PER SB-12 3.1.1.9(4) MAX 19.9 S.F. REFER TO ELEVATION FOR LOCATION			
TOTAL SQ. FT.	4891.01 S.F.	633.08 S.F.	12.68 %
TOTAL SQ. M.	463.88 S.M.	58.81 S.M.	12.68 %

CITY OF HAMILTON
Building Division

Permit No. **20-199355**

THESE STAMPED DRAWINGS SHALL BE AVAILABLE ON SITE

THE OWNER AND/OR CONTRACTOR SHALL COMPLY WITH
THE ONTARIO BUILDING CODE AND ALL OTHER APPLICABLE LAW

These drawings and/or specifications have been reviewed by

JAN 15 2021
FOR THE BUILDING OFFICIAL DATE

All drawings, specifications, related documents and design are the copyright property of VAS DESIGN. Reproduction of this property in whole or in part is strictly prohibited without VAS DESIGN's written permission.

Note:

- Piers/Footing/Foundation must bear on undisturbed soil.
- All plumbing is subject to field inspection by City of Hamilton.
- separate building permit is required to finish basement space.
- Beam bearing min. 3"
- Joist bearing min. 1 1/2"
- Lintel bearing min. 1 1/2"
- Rafter bearing min. 1 1/2"

3189 SF.

CITY OF HAMILTON
Building Division

Permit No. 20-199855

THESE STAMPED DRAWINGS SHALL BE AVAILABLE ON SITE

THE OWNER AND/OR CONTRACTOR SHALL COMPLY WITH
THE ONTARIO BUILDING CODE AND ALL OTHER APPLICABLE LAW

These drawings and/or specifications have been reviewed by
JAN 13 2021
DATE

COLD STORAGE SLAB
5" REINFORCED CONCRETE SLAB
WITH 10M BARS @ 7 7/8" O.C.
EACH WAY WITH MIN. 1 1/4"
CONC. COVER AND 10M BENT
(24" x 24") DOUELS SPACED NOT
MORE THAN 23 5/8" O.C.

COLD STORAGE

BASEMENT PLAN - ELEV. '3'

MOUNTAINASH 4-014
COMPLIANCE PACKAGE 'A1'

It is the builder's complete responsibility to ensure that all plans submitted for approval fully comply with the Architectural Guidelines and all applicable regulations and requirements including zoning provisions and any provisions in the subdivision agreement. The Control Architect is not responsible in any way for examining or approving site (footing) plans or working drawings with respect to any zoning or building code or permit matter or that any house can be properly built or located on its lot.

This is to certify that these plans comply with the applicable Architectural Design Guidelines approved by the City of HAMILTON

JOHN G. WILLIAMS LTD. ARCHITECT
ARCHITECTURAL CONTROL REVIEW
AND APPROVAL
APPROVED BY: [Signature]
DATE: DEC 20, 2020
This stamp certifies compliance with the applicable Design Guidelines only and does not constitute professional responsibility.



BASEMENT INSULATION AT STAIR/SUNKEN AREAS
-2" (R10) CONTINUOUS INSULATION (RIGID OR SPRAY FOAM).
-2"x4" @ 16" O.C. w/ R12 BATT INSULATION & 1/2" DRYWALL FINISH
-EXTEND EXTERIOR WALL FOOTING TO SUPPORT 2"x4" WALL WHERE LOAD BEARING.

BASEMENT WALL INSULATION (TYP) (13)
-6" (R20) CONTINUOUS BLANKET INSULATION. INSULATION UNINTERRUPTED BY FRAMING

no.	description	date	by	no.	description	date	by
18				8			
17				9			
16				10			
15				11			
14				12			
13				13			
12				14			
11				15			
10				16			
9				17			
8				18			
7				19			
6				20			
5				21			
4				22			
3				23			
2				24			
1				25			
				26			
				27			
VAS DESIGN
255 Consumers Rd Suite 120
Toronto ON M2J 1R4
416.630.2255 f 416.630.4782
vasdesign.com

Greenpark.
project name
RUSSELL GARDENS PH. 3
HAMILTON, ON.
date
JAN. 2020
drawn by
N.HUR
checked by
3/16" = 1'-0"
scale
18014-MOUNTAINASH-4-014
file name
18014-MOUNTAINASH-4-014.dwg - Thu - Apr 23 2020 - 6:51 PM

MOUNTAINASH 4
13.5m
project no.
19014
drawing no.
A2b

All drawings, specifications, related documents and design are the copyright property of VAS DESIGN. Reproduction of this property in whole or in part is strictly prohibited without VAS DESIGN's written permission.

Note:

Gas fireplace must be CSA/ULC/CCMC approved installed in accordance to local Utilization code.

3189 SF.

OUTDOOR AIR INTAKE SEPARATION
ALL OUTDOOR AIR INTAKE VENTS TO BE SEPARATED A MINIMUM DISTANCE FROM SOURCES OF CONTAMINATION PER OBC, DIV. B - TABLE 6.2.3.12.
• KITCHEN EXHAUST: 3.0m
• DRIVEWAY, PARKING SPACE, ROAD: 1.5m
• SOLID FUEL APPLIANCE EXHAUST: 3.0m

CANOPY FRAMING (TYP.)
2"x8" @ 12" O.C. P.T. CLG. JST.
w/ 2"x4" @ 12" O.C. P.T.
DIAGONALLY CUT CROSS PURLINS
w/ 5/8" EXTERIOR GRADE
SHEATHING + SINGLE PLY ROOF
MEMBRANE (SLOPE TO DRAIN)

CITY OF HAMILTON
Building Division

Permit No. 20-199355

THESE STAMPED DRAWINGS SHALL BE AVAILABLE ON SITE
THE OWNER AND/OR CONTRACTOR SHALL COMPLY WITH
THE ONTARIO BUILDING CODE AND ALL OTHER APPLICABLE LAW

These drawings and/or specifications have been reviewed by

JAN 15 2021
DATE

FOR CHIEF BUILDING OFFICIAL

DATE

DATE

3189 SF.

GRAB BAR NOTE:
STUD WALL REINFORCEMENT FOR FUTURE GRAB BARS IN MAIN BATHROOM
REINFORCEMENT OF STUD WALLS SHALL BE INSTALLED ADJACENT TO WATER CLOSETS AND SHOWER OR BATHTUB IN MAIN BATHROOM PER OBC DIV. 8-9.5.2.3. REFER TO FOLLOWING SECTIONS FOR THE FIXTURES LISTED: WATER CLOSET: 3.8.3.8(3)(a) & 3.8.3.8(3)(c); SHOWER: 3.8.3.13(2)(a); BATHTUB: 3.8.3.13(4)(a). FREE STANDING BATHTUB EXCLUDED. SEE DETAILS PROVIDED. (CB-NOTE-2020.dwg)

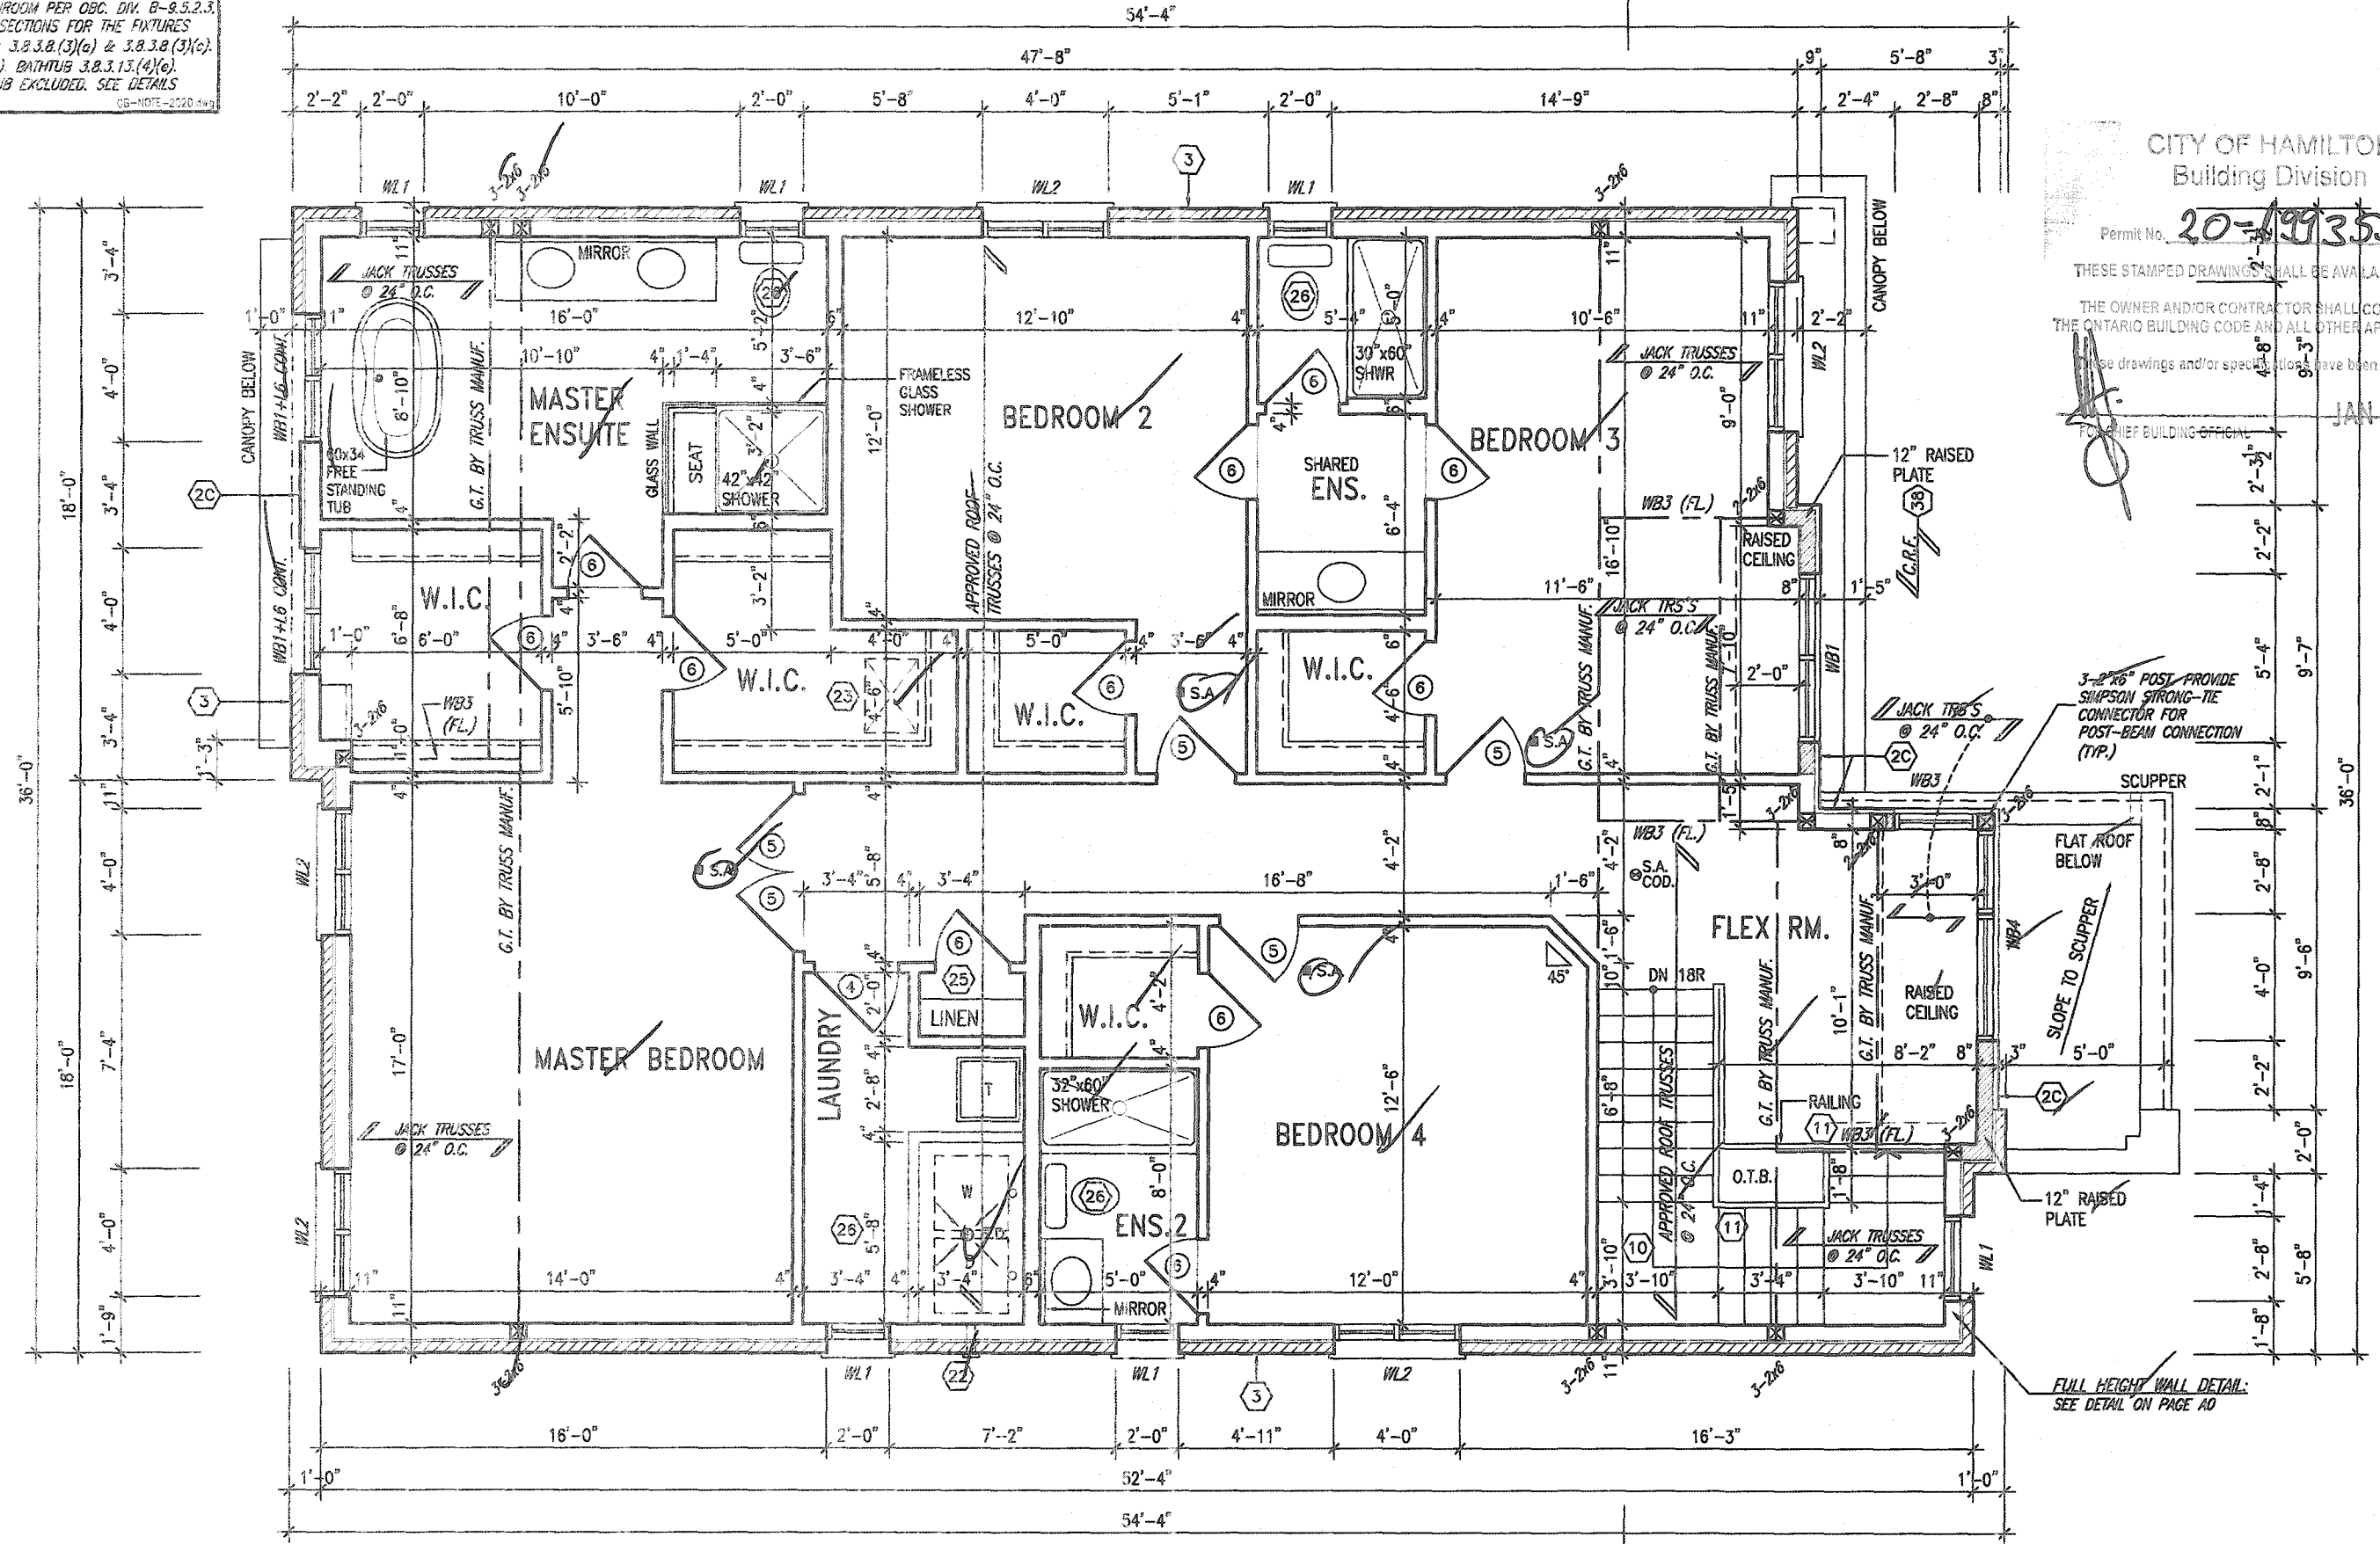

CITY OF HAMILTON
Building Division
Permit No. **20-199355**
THESE STAMPED DRAWINGS SHALL BE AVAILABLE ON SITE
THE OWNER AND/OR CONTRACTOR SHALL COMPLY WITH THE ONTARIO BUILDING CODE AND ALL OTHER APPLICABLE LAW
These drawings and/or specifications have been reviewed by
[Signature]
DATE **JAN 15 2021**

SECOND FLOOR PLAN - ELEV. '3'

It is the builder's complete responsibility to ensure that all plans submitted for approval fully comply with the Architectural Guidelines and all applicable regulations and requirements including zoning provisions and any provisions in the subdivision agreement. The Control Architect is not responsible in any way for examining or approving site (lotting) plans or working drawings with respect to any zoning or building code or permit matter or that any house can be properly built or located on its lot.

This is to certify that these plans comply with the applicable Architectural Design Guidelines approved by the City of HAMILTON.

JOHN G. WILLIAMS LTD. ARCHITECT
ARCHITECTURAL CONTROL REVIEW AND APPROVAL
APPROVED BY *[Signature]*
DATE **DEC 09 2020**
This stamp certifies compliance with the applicable Design Guidelines only and does not transfer professional responsibility.



18				8					
17				6					
16				7					
15				6					
14				5					
13				4	CUSTOM DWG PER PURCHASER REQUEST.	AUG 20/20	GW		
12				3	ISSUED FOR PERMIT.	MAR 31/20	GW		
11				2	UPDATED PER ENG & CLIENT COMMENTS.	MAR 19/20	GW		
10				1	PRELIMINARY, ISSUED FOR CLIENT REVIEW.	JAN 28/20	GW		
9	description	date	by	no.	description	date	by	no.	

The undersigned has reviewed and takes responsibility for this design and has the qualifications and meets the requirements set out in the Ontario Building Code to be a Designer.
qualification information
Richard Vink *[Signature]* 24488
BCO
42658
The undersigned has reviewed and takes responsibility for this design and has the qualifications and meets the requirements set out in the Ontario Building Code to be a Designer.
qualification information
Richard Vink *[Signature]* 24488
BCO
42658
Contractor must verify all dimensions on the job and report any discrepancy to the Designer before proceeding with the work. All drawings and specifications are instruments of service and the property of the Designer which must be returned at the completion of the work. Drawings are not to be copied.

VAS DESIGN
255 Consumers Rd Suite 120
Toronto ON M2J 1R4
t 416.630.2235 f 416.630.4782
vasdesign.com


Greenpark	MOUNTAINASH 4 13.5m
project name RUSSELL GARDENS PH. 3	municipality HAMILTON, ON.
date JAN. 2020	project no. 19014
drawn by N.HUR	checked by 3/16" = 1'-0"
SECOND FLOOR PLAN - ELEV. 3	
19014-MOUNTAINASH-4-014	
A4b	

All drawings, specifications, related documents and design are the copyright property of VAS DESIGN. Reproduction of this property in whole or in part is strictly prohibited without VAS DESIGN's written permission.


3189 SF.

Note:
Provide roof natural ventilation for every 1/300sq.ft
of the roof attic space

CITY OF HAMILTON
Building Division
Permit No. 20-199365
THESE STAMPED DRAWINGS SHALL BE AVAILABLE ON SITE
THE OWNER AND/OR CONTRACTOR SHALL COMPLY WITH
THE ONTARIO BUILDING CODE AND ALL OTHER APPLICABLE LAW
These drawings and/or specifications have been reviewed by
JAN 15 2021
DATE

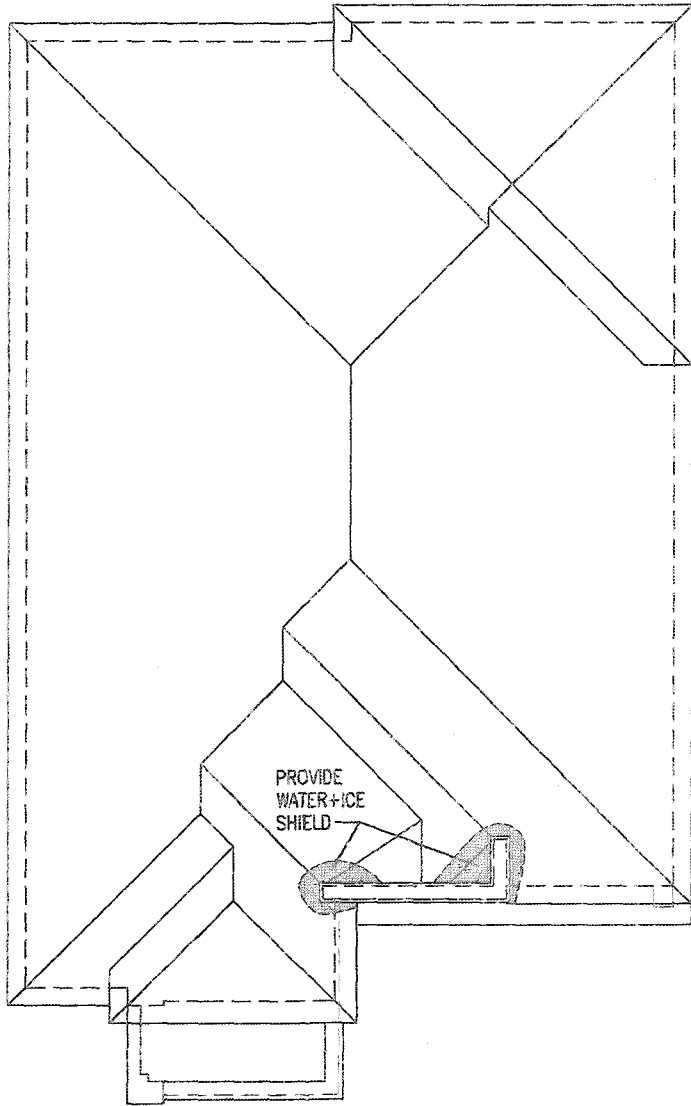

ROOF PLAN - ELEV. '3'

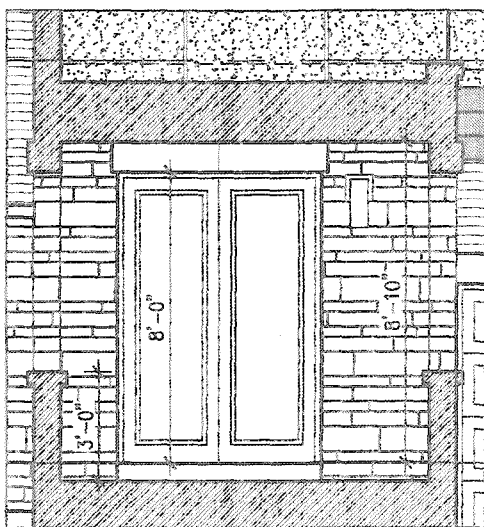

INSIDE PORTICO
ELEVATION '3'



FRONT ELEVATION - ELEV. '3'

It is the builder's complete responsibility to ensure that all plans submitted for approval fully comply with the Architectural Guidelines and all applicable regulations and requirements including zoning provisions and any provisions in the subdivision agreement. The Control Architect is not responsible in any way for examining or approving site (lotting) plans or working drawings with respect to any zoning or building code or permit matter or that any house can be properly built or located on its lot.

This is to certify that these plans comply with the applicable Architectural Design Guidelines approved by the City of HAMILTON

JOHN G. WILLIAMS LTD., ARCHITECT
ARCHITECTURAL CONTROL REVIEW
AND APPROVAL
APPROVED BY: [Signature]
DATE: DEC 2020
This stamp certifies compliance with the applicable Design Guidelines only and does not further constitute professional responsibility.

18.			9.				
17.			8.				
16.			7.				
15.			6.				
14.			5.				
13.			4.	CUSTOM DWG PER PURCHASER REQUEST.	AUG 20/20	GW	
12.			3.	ISSUED FOR PERMIT.	MAR 31/20	GW	
11.			2.	UPDATED PER ENG & CLIENT COMMENTS.	MAR 19/20	GW	
10.			1.	PRELIMINARY. ISSUED FOR CLIENT REVIEW	JAN. 28/20	GW	
no.	description	date	by	no.	description	date	by

The undersigned has reviewed and takes responsibility for this design and has the qualifications and meets the requirements set out in the Ontario Building Code to be a Designer.
qualification information
Richard Vink 24488
signature
registration information
VAB Design Inc. 42658
Contractor must verify all dimensions on the job and report any discrepancy to the Designer before proceeding with the work. All drawings and specifications are instruments of service and the property of the Designer which must be returned at the completion of the work. Drawings are not to be copied.

VAB
DESIGN
255 Consumers Rd Suite 120
Toronto ON M2J 1R4
t 416.630.2255 f 416.630.4782
vabdesign.com

Greenpark.
project name
RUSSELL GARDENS PH. 3
municipality
HAMILTON, ON.
date
JAN. 2020
checked by
N.HUR
scale
3/16" = 1'-0"
drawing no.
19014-MOUNTAINASH-4-014

MOUNTAINASH 4
13.5m
project no.
19014
drawing no.
A5b

If it is the builder's complete responsibility to ensure that all plans submitted for approval fully comply with the Architectural Guidelines and all applicable regulations and requirements including zoning provisions and any provisions in the subdivision agreement, The Control Architect is not responsible in any way for examining or approving site (lotting), plans or working drawings with respect to any zoning or building code or permit matter or that any house can be properly built or located on its lot.

JOHN C. WILLIAMS LTD., ARCHITECT
ARCHITECTURAL CONTROL REVIEW
AND APPROVALS

APPROVED BY _____

This stamp certifies compliance with the applicable

This stamp certifies compliance with the applicable
Design Guidelines only and bears no further
professional responsibility.

Permit No. 20-199355

THESE STAMPED DRAWINGS SHALL BE AVAILABLE ON SITE

THE OWNER AND/OR CONTRACTOR SHALL COMPLY WITH
THE ONTARIO BUILDING CODE AND ALL OTHER APPLICABLE LAW

These drawings and/or specifications have been reviewed by

JAN 15 2021

ITE

FOR CHIEF BUILDING OFFICIAL

— ASPHALT SHINGLES (TYP.)

— VALLEY FLASHING (TYP.)

— PREFIN. ALUM. R.W.L.,
FASCIA, GUTTER &
VENTED SOFFIT (TYP.)

TOP OF PLATE

1"x6" ALUM. CLAD TOP OF WINDOW
FRIEZE BD. (TYP.)

— PREFIN. METAL COPING
(TYP.)

FIN. SECOND FLOOR

10" PRECAST CONC.
HEADER (TYP.)

TOP OF WINDOW

CONTEMPORARY
STONE PATTERN

RAILING AS
GRADE REQ'D.

FIN. GROUND FLOOR

FIN. GRADE

POURED CONC. FOUNDATION
WALLS & FOOTINGS (TYP.)

TOP OF SLAB

MOUNTAINASH 4-014
COMPLIANCE PACKAGE 'A1'

18				9		The undersigned has reviewed and taken responsibility for this design and has the qualifications and meets the requirements set out in the <u>Criticus Building Code</u> to be a Designer.	
17				8		qualification information	
16				7		Richard Vink	2449B
15				6			BCH
14				5		name signature	
13				4	CUSTOM DWG PER PURCHASER REQUEST.	AUG 20/20 GW	registration information
12				3	ISSUED FOR PERMIT.	MAR 31/20 GW	VAB Design Inc. 42658
11				2	UPDATED PER ENG & CLIENT COMMENTS.	MAR 19/20 GW	
10				1	PRELIMINARY ISSUED FOR CLIENT REVIEW.	JAN. 28/20 GW	
a.	description	date	by	no.	description	date	by

**VA3
DESIGN**
255 Consumers Rd Suite
Toronto ON M2J 1R4
t 416.630.2255 f 416.630.
va3design.com



project name	municipality
RUSSELL GARDENS PH. 3	HAMILTON, ON.

date JAN. 2020

drawn by N.HUR checked by scale 3/16" = 1'-0"

LEFT SIDE ELEVATION - ELEV. 3

file name
19014-MOUNTAINASH-4-014

6b1

6b

All drawings specifications, related documents and design are the copyright property of VA3 DESIGN. Reproduction of this property in whole or in part is strictly prohibited without VA3 DESIGN's written permission.




