










RECEIVED

CONSTRUCTION SUMMARY			
PURCHASERS: NITABEN, A PATEL and PRAGNESH KUMAR JAYANTIBHAI PATEL			
Mountainview Heights 3 (G) - Russell Gardens Building Ltd.			
TEL:			
LOT / PHASE	REG. PLAN #	HOUSE TYPE	
318 / 3	62M-1266	Mountainash Five (4 Bedroom) Elev 1	
ELECTRICAL			
I - 200 AMP ELECTRICAL SERVICE			
22Dec20 Note:			
MIRRORS AND GLASS			
I - FRAMELESS GLASS SHOWER DOOR & FRONT WALL AT SEAT - INCLUDES CHROME KNOB & HINGES - MASTER ENSUITE BATHROOM			
22Dec20 Note:			
PLUMBING			
2 - TOE TESTER - ADD TOE TESTER TO SHOWER - MASTER ENSUITE BATHROOM & ENSUITE 2 BATHROOM			
22Dec20 Note:			
PROMOTIONAL			
I - PARTIAL REDEMPTION OF PROMOTIONAL PACKAGE \$3665.00 BALANCE FORWARD (\$8335.00) TO BE USED AT A LATER DATE, ORIGINAL PROMOTIONAL PACKAGE OF \$12,000.00 AS PER SCHEDULE PE			
22Dec20 Note:			

EXTRAS AS PER OFFER

10 FOOT CEILING ON MAIN LEVEL	
Worksheet Note:	
PURCHASER(S) ACKNOWLEDGES THAT THE PURCHASE PRICE IS INCLUSIVE OF ALL CREDITS AND PROMOTIONAL PACKAGES AVAILABLE AT TIME OF PURCHASE.	
Worksheet Note:	
(1) The Vendor agrees that notwithstanding any other term or provision in this Agreement included in the Purchase Price and in addition to those items detailed in Schedule GP to the Agreement of Purchase and Sale, the Purchaser is entitled to a credit of	
Worksheet Note:	

This Document is Extremely Time Sensitive - Printed 22 Dec 20 at 10:27

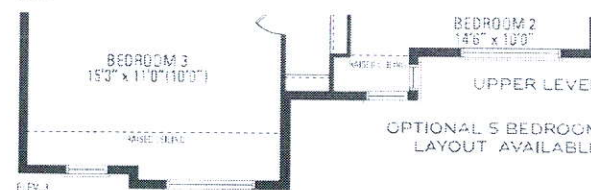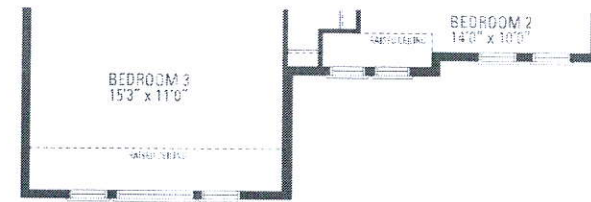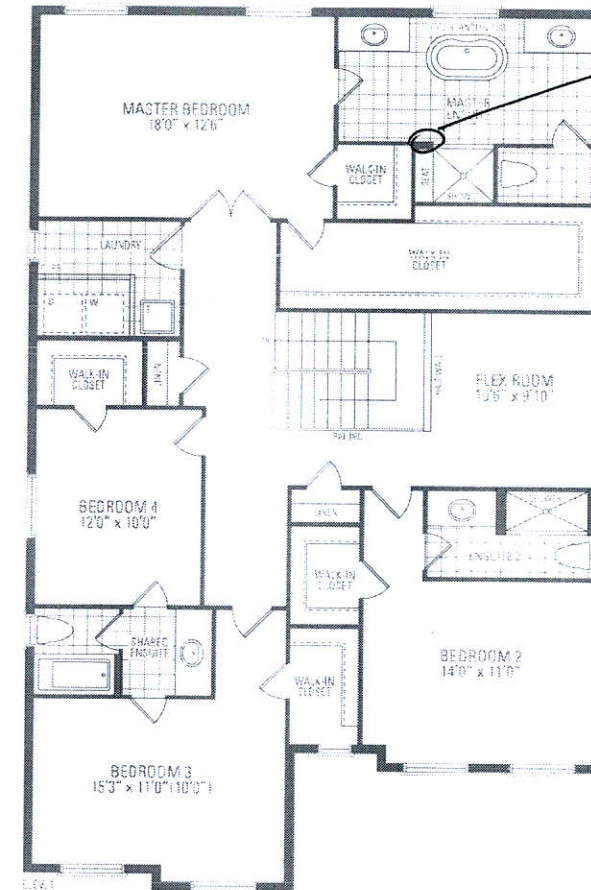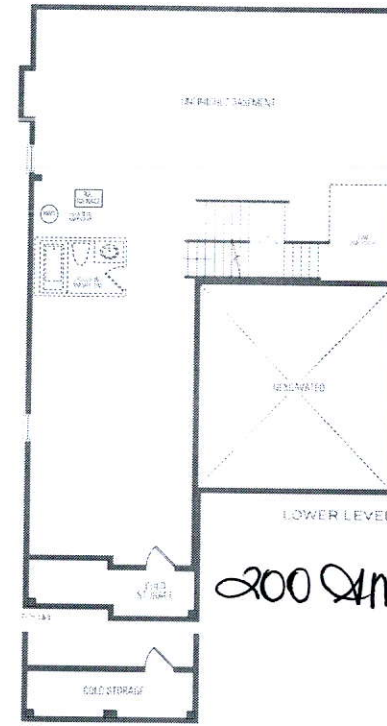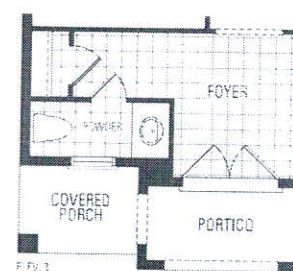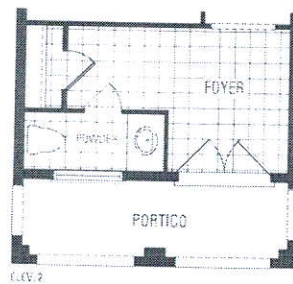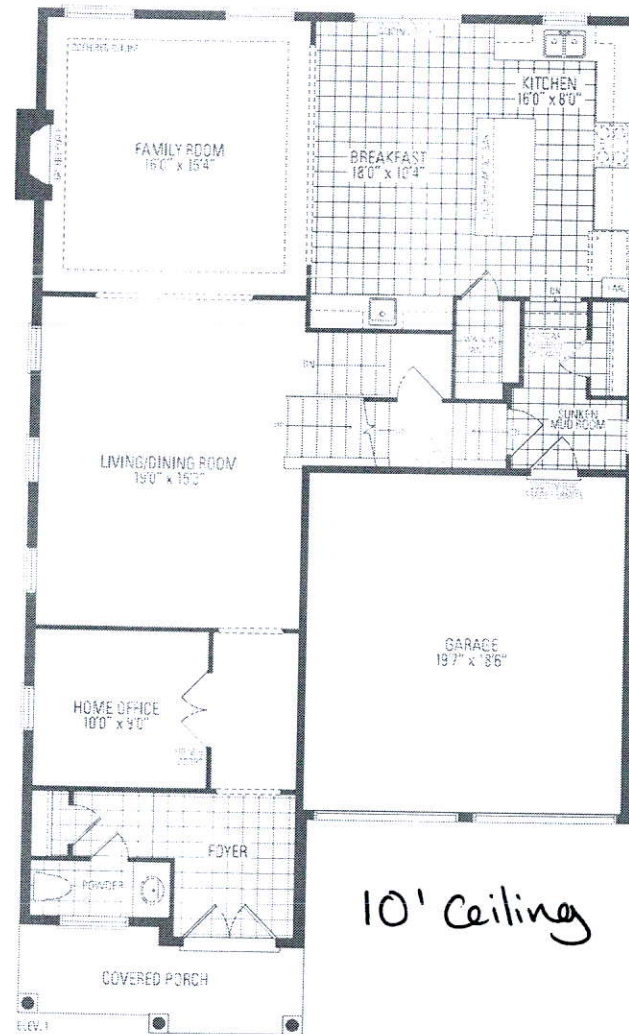

Delete Wall
Frameless
Glass Shower
Door + Front
Wall @ Seat.

10' Ceiling


MOUNTAINASH FIVE ELEV. 1 • 3,288 sq.ft. | ELEV. 2 • 3,291 sq.ft. | ELEV. 3 • 3,298 sq.ft.

Orientation of home may be reversed and purchaser agrees to accept the same. Steps and porches may vary at any exterior entrance ways due to grading variance. Actual usable floor space may vary from the stated floor areas. All renderings are artist's concept. Dimensions, specifications and architectural detailing subject to modifications. Roofline and adjoining model types may vary due to site. E. & D. E. May 2020