


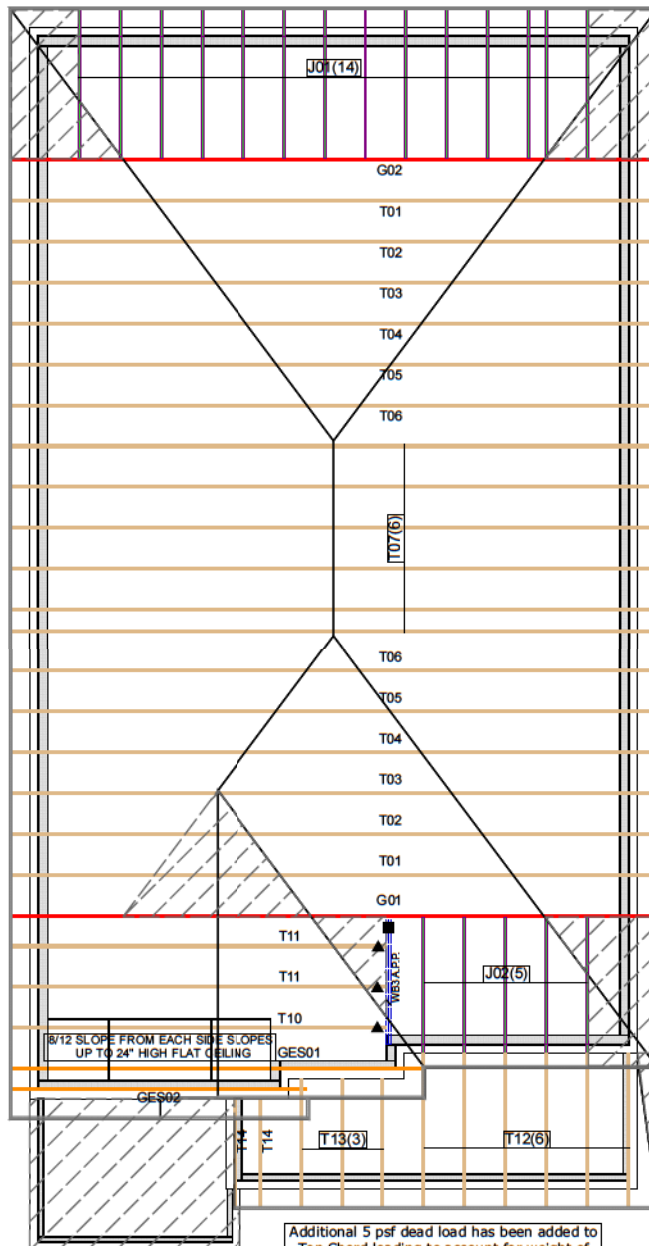

Hanger Name	Symbol	QTY
LJS26DS	▲	3
HGUS26-2	■	1



These plans have been reviewed for use with the corrections as noted. No other changes may be made without written approval of the Building Standards Branch. All work must comply with Zoning By-Law 2018-043, as amended, and the Ontario Building Code, as amended. These approved documents must be kept on site at all times. The building permit must be clearly posted on site at all times.

Discipline	Reviewer	BCIN	Date
Building Code	H. Authier	43236	2021-02-04
Sewage System			
Zoning			

CONVENTIONAL FRAMING BY OTHERS

ALL CONVENTIONAL FRAMING TO CONFORM WITH PART 9 OF THE OBC. ROOF RAFTERS THAT CROSS OVER TRUSSES TO BE MIN. 2x4 SIF @ 24" C/C WITH A 2x4 VERTICAL POST TO THE TRUSS BELOW. VERTICAL POSTS TO BE LATERALLY BRACED SO THAT UNBRACED LENGTH DOES NOT EXCEED 6'. DESIGN OF CONVENTIONAL FRAMING IS THE RESPONSIBILITY OF THE PROJECT ENGINEER.

JOB INFORMATION

Customer	GREENPARK HOMES
Job #	20-00415R0
Address	TRINAR HALL EAST GWILLIMBURY, ON
Model	BRENTWOOD 2 EL 3
Sales Rep	RALPH MIRIGELLO
Designer	KR
Date	12/18/2020
Path	C:\MITEK\CA\JOBS\GREENPARK HOMES\TRINAR HALL\BRENTWOOD 2\EL 3\T-BRENTWOOD2-3\

DESIGN INFORMATION

Code	NBCC 2015
Bldg	Residential - HSB (NBCC Part 9)
TC LL	34.8 lb/ft ²
TC DL	8.0 lb/ft ²
BC LL	10.5 lb/ft ²
BC DL	7.3 lb/ft ²
Deflection	LL=L/360 TL=L/360
Spacing	24" O/C unless otherwise noted
Complies With	OBC 2012 (2019 Amendment) CSA O86-14 and TPIC 2014

IMPORTANT INFORMATION

Refer to truss drawings in the Truss Engineering Package for ply-to-ply attachment notes

For site-framed valleys: top chords of all roof trusses must be laterally supported using 2x4 continuous bracing @24 O/C - all bracing must be anchored at ends as per TPIC Installation Guidelines

Read all notes on this page in addition to those shown on the KOTT Truss Engineering package

Field erection, handling and bracing are not the responsibility of KOTT, or KOTT Engineering

Unless noted otherwise, hurricane ties are to be installed at the bearings of all trusses > 40 ft clear span, and any girder or beam supporting trusses with a clear span >40 ft. See hanger legend for type.

Unless noted otherwise, for Part 9 bldgs, all trusses are to be anchored to the top of supporting walls as follows: trusses with a clear span <40 ft use 3-1/4" nails @ each bearing; trusses with a clear span >40 ft use 3-1/4" nails @ each bearing in addition to the appropriate hurricane tie.

KOTT Inc.
14 Anderson Blvd.
Uxbridge, ON
905.642.4400





These plans have been reviewed for use with the corrections as noted. No other changes may be made without written approval of the Building Standards Branch. All work must comply with Zoning By-Law 2018-043, as amended, and the Ontario Building Code, as amended. These approved documents must be kept on site at all times. The building permit must be clearly posted on site at all times.

Discipline	Reviewer	BCIN	Date
Building Code	H. Authier	43236	2021-02-04
Sewage System			
Zoning			

NE1220-114
GREENPARK - TRINAR
HALL - BRENTWOOD 2 EL 3

ENGINEERING NOTE PAGE (ENP-1)

PLEASE READ PRIOR TO INSTALLATION

RESPONSIBILITIES

THIS DESIGN IS FOR AN INDIVIDUAL BUILDING COMPONENT AND HAS BEEN BASED ON INFORMATION PROVIDED BY KOTT DESIGN. THE UNDERSIGNED ENGINEER DISCLAIMS ANY RESPONSIBILITY FOR DAMAGES AS A RESULT OF FAULTY OR INCORRECT INFORMATION, SPECIFICATION AND/OR DESIGNS FURNISHED TO THE ENGINEER. THE UNDERSIGNED ENGINEER IS ONLY RESPONSIBLE FOR THE STRUCTURAL INTEGRITY OF THIS BUILDING COMPONENT FOR THE CONDITIONS AND LOADS SHOWN ON THIS DRAWING. THE STRUCTURAL INTEGRITY OF THE BUILDING AND THE VERIFICATION OF THE DIMENSIONS AND THE DESIGN LOADS USED ARE THE RESPONSIBILITY OF THE BUILDING DESIGNER.

TRUSSES ARE DESIGNED IN CONFORMANCE WITH THE RELEVANT SECTIONS OF THE NATIONAL BUILDING CODE OF CANADA OR THE CANADIAN CODE FOR FARM BUILDINGS, WHICHEVER APPLIES TO THE BUILDING TYPE INDICATED ON THE DRAWING

IT IS THE RESPONSIBILITY OF KOTT TO ENSURE THAT TRUSSES ARE MANUFACTURED IN CONFORMANCE WITH THESE DESIGNS AND WITH THE SPECIFICATIONS OUTLINED BELOW. THE UNDERSIGNED ENGINEER IS NOT RESPONSIBLE FOR QUALITY CONTROL IN THE TRUSS MANUFACTURING PLANT.

USE AND OCCUPANCY

- The building is of the type indicated on the drawing

LOADING

- The truss loading intensity and distribution as well as load transfer mechanism is that indicated on the drawing
- No buildings, trees, parapets or other projections higher than the roof for which the trusses are used are located within a distance less than ten (10) times the difference in height, or five metres (16 ft) whichever is greater, unless the drawing indicates that the snow drifting has been taken into account

HANDLING, INSTALLATION AND BRACING


- The trusses must be handled and installed by a qualified professional as per the supplied document titled *Information for Truss Installers* and the BCSI-B1 and BCSI-B3 Summary Sheets
- The compression chords are laterally braced by continuous rigid diaphragm sheathing or as specified on the drawing
- Temporary and permanent bracing must be installed as indicated on the truss drawing and according to the BCSI-B1 and BCSI-B3 Summary Sheets. Bracing for the lateral stability of the truss is to be provided by the building designer
- **It is recommended that a Professional Engineer's advice be obtained for the bracing of trusses spanning more than 12.37m (40'-7")**

SUPPORTS

- The trusses are to be supported at the bearing points indicated and anchored to the supports where considered necessary by the designer of the overall structure
- Bearing sizes shown are the minimum required to prevent crushing of the truss members and do not necessarily take into account stability of the overall building structure
- Elevation of bearings must be carefully checked and shimmed to alignment for solid bearings
- Adequate wood truss bearing is the responsibility of the building designer.

DIMENSIONS

- Geometry of the truss and dimensions indicated on the drawing are identical to those of the installed truss.

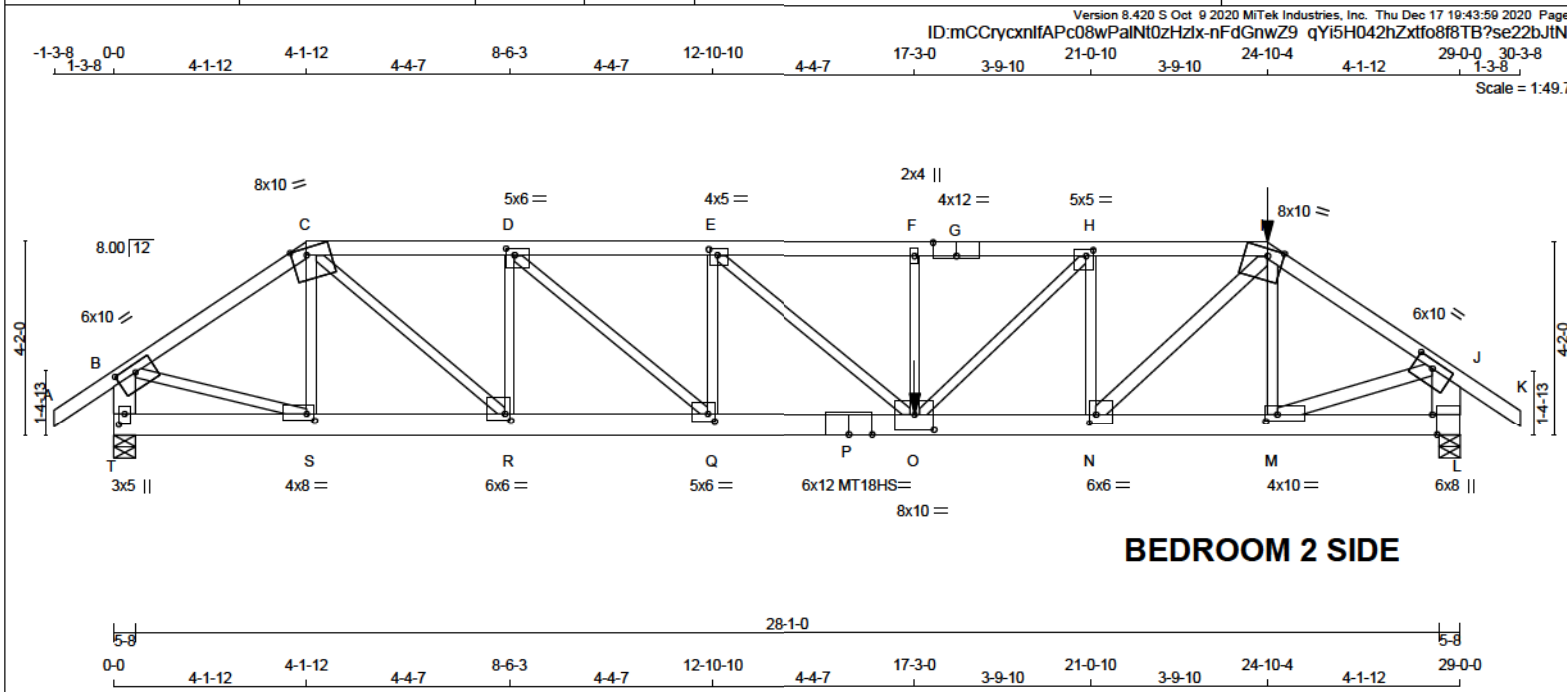

LUMBER
N. L. G. A. RULES

CHORDS	SIZE	LUMBER	DESCR.
A - C	2x4	DRY	2100F 1.8E
C - G	2x4	DRY	2100F 1.8E
G - I	2x4	DRY	2100F 1.8E
I - K	2x4	DRY	2100F 1.8E
T - B	2x6	DRY	No.2
L - J	2x6	DRY	No.2
T - P	2x6	DRY	2100F 1.8E
P - L	2x6	DRY	2100F 1.8E
ALL WEBS	2x3	DRY	No.2
EXCEPT			
N - I	2x4	DRY	No.2
M - J	2x4	DRY	No.2

SPF

DRY: SEASONED LUMBER.

PLATES (table is in inches)

JT	TYPE	PLATES	W	LEN	Y	X
B	TMVW-t	MT20	6.0	10.0	2.00	5.00
C	TTWW-m	MT20	8.0	10.0	Edge	4.00
D	TMVW-t	MT20	5.0	6.0	1.75	2.25
E	TMVW-t	MT20	4.0	5.0	1.50	2.25
F	TMVW-t	MT20	2.0	4.0		
G	TS-t	MT20	4.0	12.0	Edge	8.00
H	TMVW-t	MT20	5.0	5.0	1.50	1.75
I	TTWW-m	MT20	8.0	10.0	Edge	4.00
J	TMVW-t	MT20	6.0	10.0	2.00	4.75
L	BMV1+H	MT20	6.0	8.0	Edge	1.25
M	BMVW-t	MT20	4.0	10.0	1.75	3.00
N	BMVW-t	MT20	6.0	6.0	2.25	1.75
O	BMVW-t	MT20	8.0	10.0	4.25	5.00
P	BS-t	MT18HS	6.0	12.0		
Q	BMVW-t	MT20	5.0	6.0	2.00	1.75
R	BMVW-t	MT20	6.0	6.0	1.75	1.50
S	BMVW-t	MT20	4.0	8.0	1.75	2.00
T	BMV1+p	MT20	3.0	5.0	2.75	1.50

Edge - INDICATES REFERENCE CORNER OF PLATE TOUCHES EDGE OF CHORD.

DIMENSIONS, SUPPORTS AND LOADINGS SPECIFIED BY FABRICATOR TO BE VERIFIED BY BUILDING DESIGNER

BEARINGS

FACTORED GROSS REACTION	MAXIMUM FACTORED GROSS REACTION	INPUT BRG	REQRD BRG
JT VERT	3872	0	5-8
T VERT	5267	0	5-8
L VERT	5267	0	5-8

UNFACTORED REACTIONS

1ST LCASE	MAX	MIN	COMPONENT REACTIONS
JT COMBINED	2858	1673 / 0	472 / 0
T COMBINED	3897	2249 / 0	667 / 0
L COMBINED	3897	2249 / 0	667 / 0

BEARING MATERIAL TO BE SPF NO.2 OR BETTER AT JOINT(S) T, L
BEARING SIZE FACTOR = 1.15 AT JNT(S) L (BASED ON SUPPORT DEPTH = 1-8)

BRACING
TOP CHORD TO BE SHEATHED OR MAX. PURLIN SPACING = 1.81 FT.
MAX. UNBRACED BOTTOM CHORD LENGTH = 10.00 FT OR RIGID CEILING DIRECTLY APPLIED.

LOADING
TOTAL LOAD CASES: (4)

CHORDS				WEBS			
MEMB.	FORCE (LBS)	FACTORED VERT. LOAD (PLF)	MAX. FACTORED (LC1) MAX. (LC)	MEMB.	FORCE (LBS)	MAX. FACTORED (LC1) MAX. (LC)	MAX. FACTORED (LC1) MAX. (LC)
FR-TO				FR-TO			
A-B	0 / 47	-124.4	-124.4 0.12 (1)	10.00	S-C	-852 / 0	0.17 (1)
B-C	-4500 / 0	-124.4	-124.4 0.42 (1)	3.74	C-R	0 / 4057	1.00 (1)
C-D	-6788 / 0	-124.4	-124.4 0.51 (1)	3.03	R-D	-2531 / 0	0.66 (1)
D-E	-9031 / 0	-124.4	-124.4 0.72 (1)	2.43	D-Q	0 / 2970	0.74 (1)
E-F	-10356 / 0	-124.4	-124.4 0.80 (1)	2.20	Q-E	-1684 / 0	0.44 (1)
F-G	-10356 / 0	-242.4	-242.4 0.97 (1)	1.81	E-O	0 / 1754	0.43 (1)
G-H	-10356 / 0	-242.4	-242.4 0.97 (1)	1.81	O-F	-672 / 0	0.17 (1)
H-I	-8489 / 0	-242.4	-242.4 0.77 (1)	2.34	F-H	0 / 2636	0.65 (1)
I-J	-8169 / 0	-124.4	-124.4 0.54 (1)	3.14	N-H	-2897 / 0	0.75 (1)
J-K	0 / 47	-124.4	-124.4 0.12 (1)	10.00	N-I	0 / 4707	0.83 (1)
T-B	-3810 / 0	0.0	0.0 0.27 (1)	5.43	M-I	-953 / 0	0.24 (1)
L-J	-5126 / 0	0.0	0.0 0.28 (1)	5.39	B-S	0 / 3839	0.95 (1)
T-S	0 / 0	-39.2	-39.2 0.04 (2)	10.00	M-J	0 / 5278	0.93 (1)
S-R	0 / 3720	-39.2	-39.2 0.23 (1)	10.00			
R-Q	0 / 6788	-39.2	-39.2 0.41 (1)	10.00			
Q-P	0 / 9031	-39.2	-39.2 0.62 (1)	10.00			
P-O	0 / 9031	-39.2	-39.2 0.62 (1)	10.00			
O-N	0 / 8489	-76.5	-76.5 0.60 (1)	10.00			
N-M	0 / 5151	-76.5	-76.5 0.30 (1)	10.00			
M-L	0 / 0	-76.5	-76.5 0.06 (3)	10.00			

FACTORED CONCENTRATED LOADS (LBS)

JT	LOC.	LC1	MAX-	MAX+	FACE	DIR.	TYPE	HEEL	CONN.
I	24-10-4	-408	-408	—	FRONT	VERT	TOTAL	—	C1
O	17-3-0	-2309	-2309	—	FRONT	VERT	TOTAL	—	C1

CONNECTION REQUIREMENTS

1) C1: A SUITABLE HANGER/MECHANICAL CONNECTION IS REQUIRED.

DESIGN CRITERIA

*** SPECIAL LOADS ANALYSIS ***
GEOMETRY AND/OR BASIC LOADS CHANGED BY USER.
LOADS WERE DERIVED FROM USER INPUT
NO FURTHER MODIFICATIONS WERE MADE

SPECIFIED LOADS:
TOP CH. LL = 34.8 PSF
DL = 8.0 PSF
BOT CH. LL = 10.5 PSF
DL = 7.3 PSF
TOTAL LOAD = 60.6 PSF

SPACING = 24.0 IN. C/C

LOADING IN FLAT SECTION BASED ON A SLOPE OF 2.00/12 MINIMUM

GIRDER TYPE: CPrimeHip
SIDE SETBACK = 4-1-12
END SETBACK = 6-3-0
END WALL WIDTH = 5-8
CORNER FRAMING TYPE: CONVENTIONAL
END JACK TYPE: CONVENTIONAL
APPLIED TO FRONT SIDE
- ADDTL LOADS BASED ON 55 % OF G.S.L.
LOADS APPLIED TO FIRST 11-9-0 OF SPAN MEASURED FROM THE RIGHT.

*** NON STANDARD GIRDER ***
ADDTL USER-DEFINED LOADS APPLIED TO ALL LOAD CASES.

THIS TRUSS IS DESIGNED FOR RESIDENTIAL OR SMALL BUILDING REQUIREMENTS OF PART 9, NBC 2015

THIS DESIGN COMPLIES WITH:
- PART 9 OF BCBC 2018, ABC 2019
- PART 9 OF OBC 2012 (2019 AMENDMENT)
- CSA 086-14
- TPIC 2014

(55 % OF 48.1 P.S.F. G.S.L. PLUS 8.4 P.S.F. RAIN LOAD)
EQUALS 34.8 P.S.F. SPECIFIED ROOF LIVE LOAD

ALLOWABLE DEFL. (LL) = L/360 (0.97")
CALCULATED VERT. DEFL. (LL) = L/959 (0.38")
ALLOWABLE DEFL. (TL) = L/360 (0.97")
CALCULATED VERT. DEFL. (TL) = L/575 (0.01")

CSI: TC=0.97/1.00 (F-H:1) , BC=0.62/1.00 (O-Q:1) ,
WB=1.00/1.00 (C-R:1) , SSI=0.47/1.00 (H-I:1)

DOL LUMBER=1.00 NAIL=1.00 LS BEND=1.00 COMP=1.00
SHEAR=1.00 TENS=1.00

COMPANION LIVE LOAD FACTOR = 1.00

TRUSS PLATE MANUFACTURER IS NOT RESPONSIBLE FOR QUALITY CONTROL IN THE TRUSS MANUFACTURING PLANT .

NAIL VALUES
PLATE GRIP(DRY) SHEAR SECTION
(PSI) (PLI) (PLI)
MAX MIN MAX MIN MAX MIN
MT20 650 371 1747 788 1987 1873
MT18HS 586 403 2455 1382 3163 3004



READ ALL NOTES ON THIS PAGE AND ON ENGINEERING NOTE PAGE ENP-1. THIS NOTE PAGE IS AN INTEGRAL PART OF THIS DRAWING AS IT CONTAINS SPECIFICATIONS AND CRITERIA USED IN THE DESIGN OF THIS COMPONENT.




These plans have been reviewed for use with the corrections as noted. No other changes may be made without written approval of the Building Standards Branch. All work must comply with Zoning By-Law 2015-043, as amended, and the Ontario Building Code, as amended. These approved documents must be kept on site at all times. The building permit must be clearly posted on site at all times.

Discipline	Reviewer	BCIN	Date
Building Code	H. Authier	43236	2021-02-04
Sewage System			
Zoning			



CONTINUED ON PAGE 2

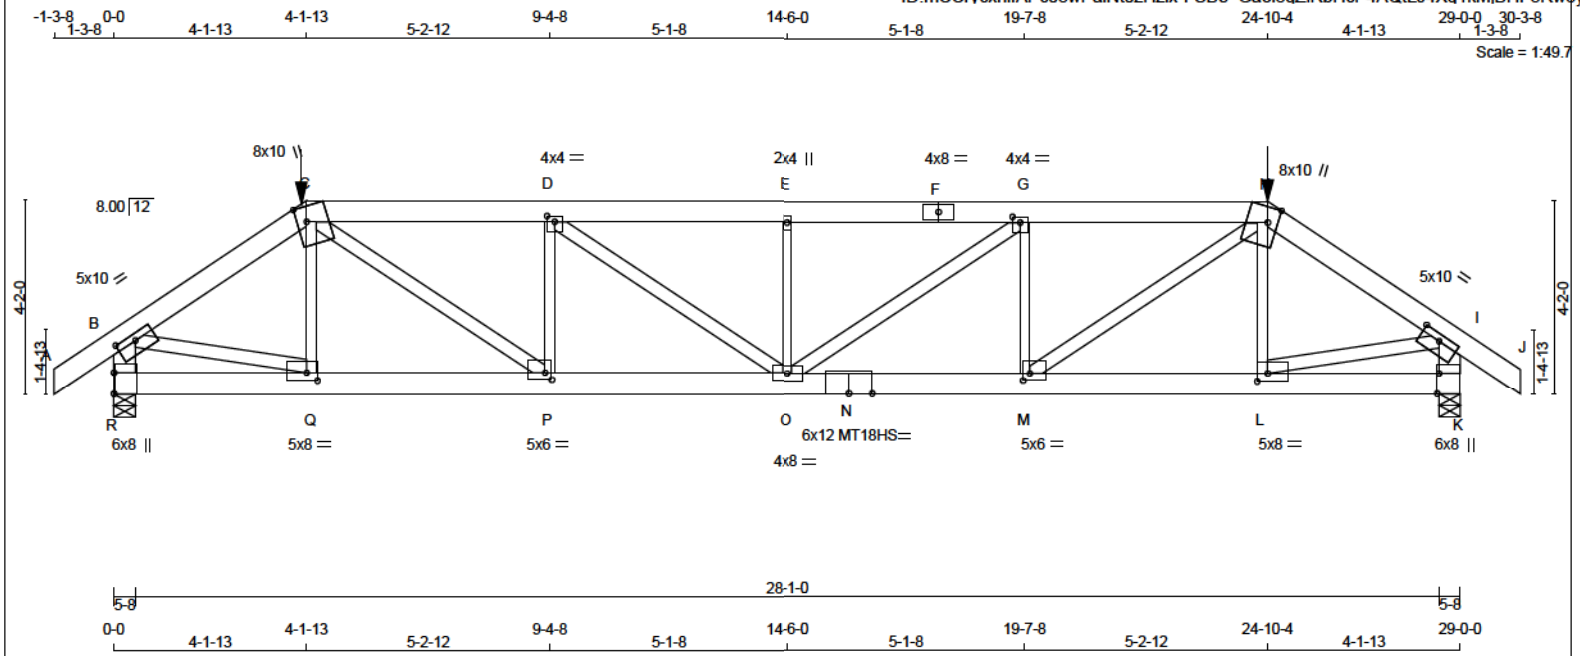

TOTAL WEIGHT = 165 lb

LUMBER				
N. L. G. A. RULES				
CHORDS	SIZE	LUMBER		DESCR.
A - C	2x6	DRY	No.2	SPF
C - F	2x6	DRY	No.2	SPF
F - H	2x6	DRY	No.2	SPF
H - J	2x6	DRY	No.2	SPF
R - B	2x6	DRY	No.2	SPF
K - I	2x6	DRY	No.2	SPF
R - N	2x6	DRY	2100F 1.8E	SPF
N - K	2x6	DRY	2100F 1.8E	SPF
ALL WEBS EXCEPT	2x4	DRY	No.2	SPF
Q - C	2x3	DRY	No.2	SPF
P - D	2x3	DRY	No.2	SPF
O - E	2x3	DRY	No.2	SPF
M - G	2x3	DRY	No.2	SPF
L - H	2x3	DRY	No.2	SPF

DRY: SEASONED LUMBER.

PLATES (table is in inches)

JT	TYPE	PLATES	W	LEN	Y	X
B	TMVW-t	MT20	5.0	10.0	1.75	5.00
C	TTWW+m	MT20	8.0	10.0	Edge	2.50
D	TMVW-t	MT20	4.0	4.0	1.50	2.50
E	TMVW+w	MT20	2.0	4.0		
F	TS-t	MT20	4.0	8.0		
G	TMVW-t	MT20	4.0	8.0	1.50	2.00
H	TTWW+m	MT20	8.0	10.0	Edge	2.50
I	TMVW-t	MT20	5.0	10.0	1.75	5.00
K	BMV1+p	MT20	6.0	8.0	Edge	0.50
L	BMVW-t	MT20	5.0	8.0	2.00	2.75
M	BMVW-t	MT20	5.0	6.0	1.75	1.75
N	BS-t	MT18HS	6.0	12.0		
O	BMVWW-t	MT20	4.0	8.0		
P	BMVW-t	MT20	5.0	8.0	1.75	1.75
Q	BMVW-t	MT20	5.0	8.0	2.00	2.75
R	BMV1+p	MT20	6.0	8.0	5.50	

Edge - INDICATES REFERENCE CORNER OF PLATE TOUCHES
EDGE OF CHORD.

DIMENSIONS, SUPPORTS AND LOADINGS SPECIFIED BY FABRICATOR TO BE VERIFIED BY BUILDING DESIGNER

BEARINGS

	FACTORED GROSS REACTION		MAXIMUM FACTORED GROSS REACTION		INPUT BRG	REQRD BRG
JT	VERT	HORZ	DOWN	HORZ	UPLIFT	IN-SX
R	4582	0	4582	0	0	5-8
K	4582	0	4582	0	0	5-8

UNFACTORED REACTIONS

1ST LCASE MAX /MIN. COMPONENT REACTIONS

JT	COMBINED	SNOW	LIVE	PERM.LIVE	WIND	DEAD	SOIL
R	3387	1983 / 0	574 / 0	0 / 0	0 / 0	850 / 0	0 / 0
K	3387	1983 / 0	574 / 0	0 / 0	0 / 0	850 / 0	0 / 0

BEARING MATERIAL TO BE SPF NO.2 OR BETTER AT JOINT(S) R, K

BRACING

TOP CHORD TO BE SHEATHED OR MAX. PURLIN SPACING = 1.88 FT.

MAX. UNBRACED BOTTOM CHORD LENGTH = 10.00 FT OR RIGID CEILING DIRECTLY APPLIED.

ALL PITCH BREAKS AND PERIMETER CORNER JOINTS MUST BE LATERALLY RESTRAINED

LOADING

TOTAL LOAD CASES: (4)

CHORDS					WEBS			
MEMB.	MAX. FACTORED FORCE (LBS)	FACTORED VERT. LOAD (PLF)	LC1 MAX CASI	MAX. UNBRAC	MEMB.	MAX. FACTORED FORCE (LBS)	MAX CASI (LC)	
FR-TO		FROM TO		LENGTH	FR-TO			
A-B	0 / 49	-124.4	-124.4 0.10 (1)	10.00	Q-C	-557 / 87	0.14 (1)	
B-C	-5491 / 0	-124.4	-124.4 0.38 (1)	3.41	C-P	0 / 4221	0.75 (1)	
C-D	-7991 / 0	-234.6	-234.6 0.88 (1)	2.23	P-D	-2061 / 0	0.50 (1)	
D-E	-8908 / 0	-234.6	-234.6 0.99 (1)	1.88	D-O	0 / 1242	0.22 (1)	
E-F	-8908 / 0	-234.6	-234.6 0.99 (1)	1.88	O-E	-1106 / 0	0.27 (1)	
F-G	-8908 / 0	-234.6	-234.6 0.99 (1)	1.88	O-G	0 / 1242	0.22 (1)	
G-H	-7991 / 0	-234.6	-234.6 0.88 (1)	2.23	M-G	-2061 / 0	0.50 (1)	
H-I	-5491 / 0	-124.4	-124.4 0.38 (1)	3.41	M-H	0 / 4221	0.75 (1)	
I-J	0 / 49	-124.4	-124.4 0.10 (1)	10.00	L-H	-557 / 87	0.14 (1)	
R-B	-4459 / 0	0.0	0.0 0.32 (1)	5.05	B-Q	0 / 4657	0.82 (1)	
K-I	-4459 / 0	0.0	0.0 0.32 (1)	5.05	L-I	0 / 4657	0.82 (1)	
R-Q	0 / 0	-74.0	-74.0 0.08 (3)	10.00				
Q-P	0 / 4541	-74.0	-74.0 0.30 (1)	10.00				
P-O	0 / 7992	-74.0	-74.0 0.52 (1)	10.00				
O-N	0 / 7992	-74.0	-74.0 0.52 (1)	10.00				
N-M	0 / 7992	-74.0	-74.0 0.52 (1)	10.00				
M-L	0 / 4541	-74.0	-74.0 0.30 (1)	10.00				
L-K	0 / 0	-74.0	-74.0 0.08 (3)	10.00				

FACTORED CONCENTRATED LOADS (LBS)

JT	LOC.	LC1	MAX-	MAX+	FACE	DIR.	TYPE	HEEL	CONN.
C	4-1-13	-387	-387	—	FRONT	VERT	TOTAL	—	C1
H	24-10-4	-387	-387	—	FRONT	VERT	TOTAL	—	C1

CONNECTION REQUIREMENTS

1) C1: A SUITABLE HANGER/MECHANICAL CONNECTION IS REQUIRED.



**READ ALL NOTES ON THIS PAGE AND ON
ENGINEERING NOTE PAGE ENP-1. THIS
NOTE PAGE IS AN INTEGRAL PART OF
THIS DRAWING AS IT CONTAINS
SPECIFICATIONS AND CRITERIA USED IN
THE DESIGN OF THIS COMPONENT.**




These plans have been reviewed for use with the corrections as noted. No other changes may be made without written approval of the Building Standards Branch. All work must comply with Zoning By-Law 2018-043, as amended, and the Ontario Building Code, as amended. These approved documents must be kept on site at all times. The building permit must be clearly posted on site at all times.

Discipline	Reviewer	BCIN	Date
Building Code	H. Authier	43236	2021-02-0
Sewage System			
Zoning			



Version 8.420 S Oct 9 2020 Mitek Industries, Inc. Thu Dec 17 19:44:01 2020 Page 1

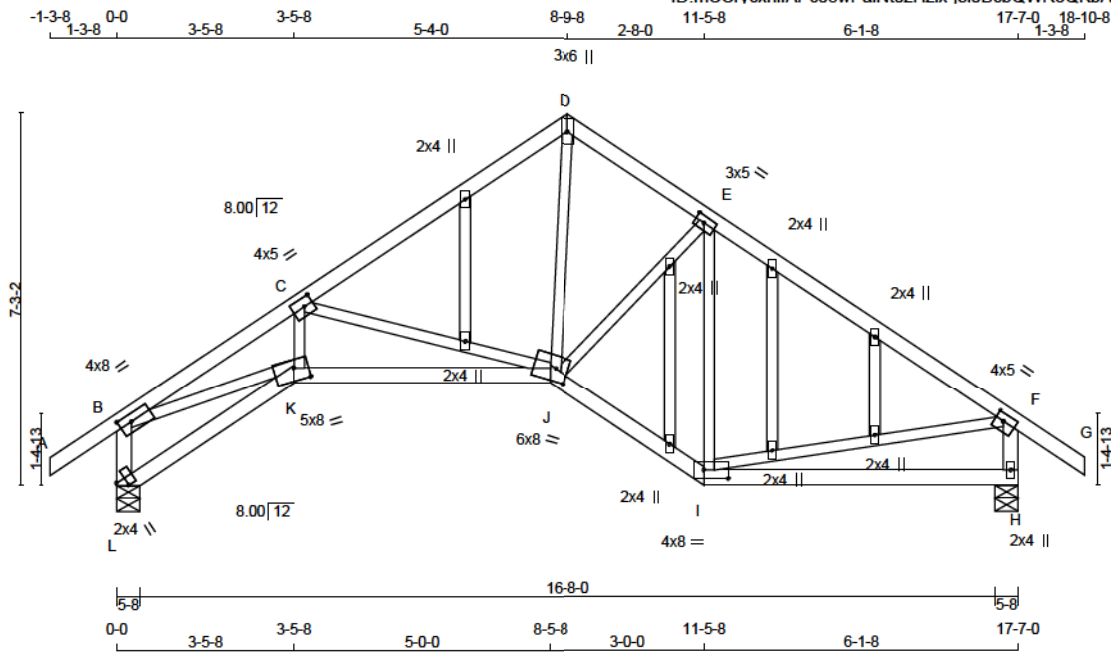

LUMBER
N. L. G. A. RULES

CHORDS	SIZE	LUMBER	DESCR.
L - B	2x4	DRY No.2	SPF
A - D	2x4	DRY No.2	SPF
D - G	2x4	DRY No.2	SPF
H - F	2x4	DRY No.2	SPF
L - K	2x4	DRY No.2	SPF
K - J	2x4	DRY No.2	SPF
J - I	2x4	DRY No.2	SPF
I - H	2x4	DRY No.2	SPF
ALL WEBS	2x3	DRY No.2	SPF
EXCEPT			
ALL GABLE WEBS	2x3	DRY No.2	SPF
DRY: SEASONED LUMBER.			
GABLE STUDS SPACED AT	2-0-0	OC.	

PLATES (table is in inches)

JT	TYPE	PLATES	W	LEN	Y	X
B	TMVW-t	MT20	4.0	8.0	1.75	3.00
C	TMVW-t	MT20	4.0	5.0	2.00	2.00
D	TTW+p	MT20	3.0	6.0		
E	TMVW-t	MT20	3.0	5.0	1.50	2.25
F	TMVW-t	MT20	4.0	5.0	1.75	2.00
H	BMV+1+p	MT20	2.0	4.0		
I	BBWW-p	MT20	4.0	8.0	2.00	5.75
J	BBWW-m	MT20	6.0	8.0	3.00	2.75
K	BBWW-m	MT20	5.0	8.0	3.00	3.25
L	BMV+1+H	MT20	2.0	4.0	2.00	2.00
M, N, O, P, Q, R, S, T						
M	NP+w	MT20	2.0	4.0		

DIMENSIONS, SUPPORTS AND LOADINGS SPECIFIED BY FABRICATOR TO BE VERIFIED BY BUILDING DESIGNER

BEARINGS

FACTORED GROSS REACTION	MAXIMUM FACTORED GROSS REACTION	INPUT BRG	REQRD BRG
JT VERT	DOWN	UPLIFT	IN-SX
L 1610 0	1610 0	0 5-8	1-12
H 1610 0	1610 0	0 5-8	1-12

UNFACTORED REACTIONS

1ST LCASE	MAX	MIN	COMPONENT REACTIONS
JT COMBINED	SNOW	LIVE	PERM. LIVE WIND DEAD SOIL
L 1183	708 / 0	185 / 0	0 / 0 0 / 0 291 / 0 0 / 0
H 1183	708 / 0	185 / 0	0 / 0 0 / 0 291 / 0 0 / 0

BEARING MATERIAL TO BE SPF NO.2 OR BETTER AT JOINT(S) L, H

BRACING
TOP CHORD TO BE SHEATHED OR MAX. PURLIN SPACING = 3.34 FT.
MAX. UNBRACED BOTTOM CHORD LENGTH = 10.00 FT OR RIGID CEILING DIRECTLY APPLIED.

ALL PITCH BREAKS AND PERIMETER CORNER JOINTS MUST BE Laterally RESTRAINED.

LOADING
TOTAL LOAD CASES: (4)

CHORDS				WEBS			
MEMB.	MAX. FACTORED FORCE (LBS)	FACTORED VERT. LOAD (PLF)	FACTORED LC1 MAX CSI (LC)	MEMB.	MAX. FACTORED FORCE (LBS)	FACTORED VERT. LOAD (PLF)	FACTORED LC1 MAX CSI (LC)
FR-TO				FR-TO			
L-B	-1542 / 0	0.0	0.0 0.16 (1)	B-K	0 / 3181	0.72 (1)	
A-B	0 / 47	-124.4	-124.4 0.17 (1)	K-C	0 / 999	0.22 (1)	
B-C	-3653 / 0	-124.4	-124.4 0.42 (1)	C-J	-1746 / 0	0.80 (1)	
C-D	-1617 / 0	-124.4	-124.4 0.47 (1)	J-D	0 / 1400	0.32 (1)	
D-E	-1559 / 0	-124.4	-124.4 0.45 (1)	E-F	0 / 89	0.01 (2)	
E-F	-1406 / 0	-124.4	-124.4 0.57 (1)	F-G	-821 / 0	0.36 (1)	
F-G	0 / 47	-124.4	-124.4 0.17 (1)	G-H	0 / 1221	0.27 (1)	
H-F	-1490 / 0	0.0	0.0 0.15 (1)				
L-K	0 / 0	-39.3	-39.3 0.11 (3)				
K-J	0 / 2999	-39.2	-39.2 0.65 (1)				
J-I	0 / 1426	-39.2	-39.2 0.29 (1)				
I-H	0 / 0	-39.2	-39.2 0.35 (3)				

DESIGN CRITERIA

SPECIFIED LOADS:
TOP CH. LL = 34.8 PSF
DL = 8.0 PSF
BOT CH. LL = 10.5 PSF
DL = 7.3 PSF
TOTAL LOAD = 60.6 PSF

SPACING = 24.0 IN. C/C

THIS TRUSS IS DESIGNED FOR RESIDENTIAL OR SMALL BUILDING REQUIREMENTS OF PART 9, NBCC 2015

THIS DESIGN COMPLIES WITH:
- PART 9 OF BCBC 2018, ABC 2019
- PART 9 OF OBC 2012 (2019 AMENDMENT)
- CSA 088-14
- TPIC 2014

(55 % OF 48.1 P.S.F. G.S.L. PLUS 8.4 P.S.F. RAIN LOAD)
EQUALS 34.8 P.S.F. SPECIFIED ROOF LIVE LOAD

ALLOWABLE DEFL.(LL)= L/360 (0.59")
CALCULATED VERT. DEFL.(LL) = L/969 (0.13")
ALLOWABLE DEFL.(TL)= L/360 (0.59")
CALCULATED VERT. DEFL.(TL) = L/918 (0.23")

CSI: TC=0.57/1.00 (E-F:1) , BC=0.65/1.00 (J-K:1) ,
WB=0.80/1.00 (C-J:1) , SSI=0.29/1.00 (E-F:1)

DOL LUMBER=1.00 NAIL=1.00 LS BEND=1.10 COMP=1.10
SHEAR=1.10 TENS=1.10

COMPANION LIVE LOAD FACTOR = 1.00

TRUSS PLATE MANUFACTURER IS NOT RESPONSIBLE FOR QUALITY CONTROL IN THE TRUSS MANUFACTURING PLANT .

NAIL VALUES

PLATE	GRIP(DRY)	SHEAR (PSI)	SECTION (PLI)
MAX MIN	MAX MIN	MAX MIN	MAX MIN
MT20	850 371	1747 788	1987 1873

PLATE PLACEMENT TOL. = 0.250 inches

PLATE ROTATION TOL. = 5.0 Deg.

JSI GRIP= 0.90 (K) (INPUT = 0.90)
JSI METAL = 0.75 (L) (INPUT = 1.00)




These plans have been reviewed for use with the corrections as noted. No other changes may be made without written approval of the Building Standards Branch. All work must comply with Zoning By-Law 2015-043, as amended, and the Ontario Building Code, as amended. These approved documents must be kept on site at all times. The building permit must be clearly posted on site at all times.

Discipline	Reviewer	BCIN	Date
Building Code	H. Authier	43236	2021-02-04
Sewage System			
Zoning			



READ ALL NOTES ON THIS PAGE AND ON ENGINEERING NOTE PAGE ENP-1. THIS NOTE PAGE IS AN INTEGRAL PART OF THIS DRAWING AS IT CONTAINS SPECIFICATIONS AND CRITERIA USED IN THE DESIGN OF THIS COMPONENT.

Version 8.420 S Oct 9 2020 MTEK Industries, Inc. Thu Dec 17 19:44:01 2020 Page 1
ID:mCCrvcxnlfAPc08wPaINt0zHzlx-iel0BcbQWRoQKbATA6bPy4tNxEQTwJLWvo Say7z

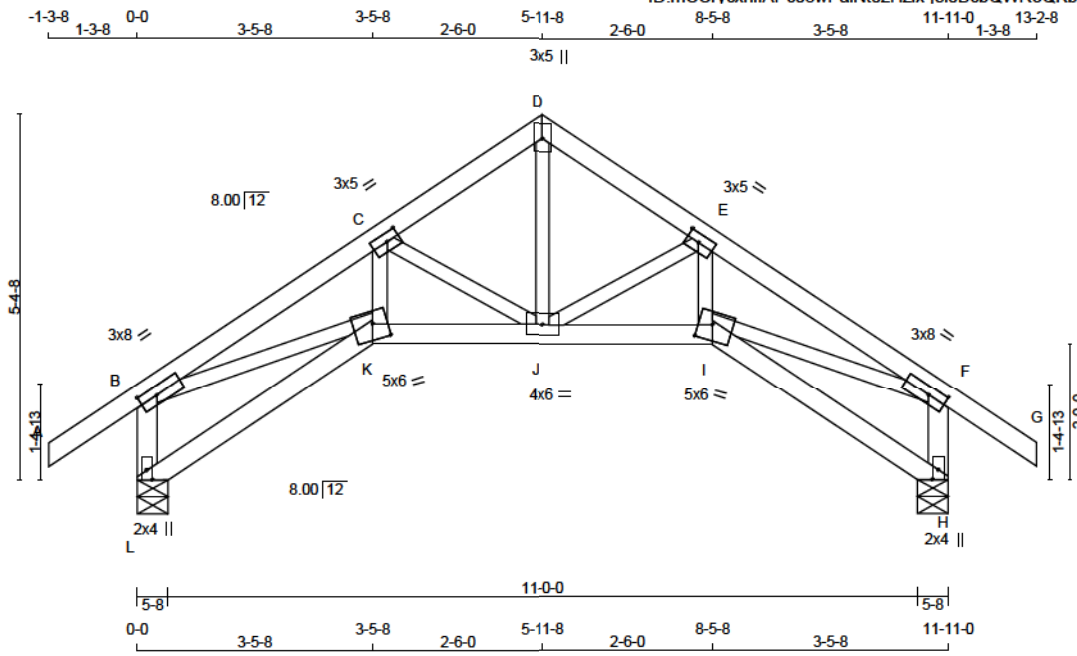

TOTAL WEIGHT = 52 lb

LUMBER				DESCR.
N. L. G. A. RULES	CHORDS	SIZE	LUMBER	
L - B	2x4	DRY	No.2	SPF
A - D	2x4	DRY	No.2	SPF
D - G	2x4	DRY	No.2	SPF
H - F	2x4	DRY	No.2	SPF
L - K	2x4	DRY	No.2	SPF
K - I	2x4	DRY	No.2	SPF
I - H	2x4	DRY	No.2	SPF
ALL WEBS 2x3 DRY				SPF
DRY: SEASONED LUMBER.				
GABLE STUDS SPACED AT 2-0-0 OC.				

PLATES (table is in inches)					
JT	TYPE	PLATES	W	LEN	X
B	TMVW-t	MT20	3.0	8.0	1.50 3.25
C	TMVW-t	MT20	3.0	5.0	1.50 2.25
D	TTW+p	MT20	3.0	5.0	
E	TMVW-t	MT20	3.0	5.0	1.50 2.25
F	TMVW-t	MT20	3.0	8.0	1.50 3.25
H	BMV1+p	MT20	2.0	4.0	Edge
I	BBWW-m	MT20	5.0	6.0	2.75 2.50
J	BBWWW-t	MT20	4.0	6.0	
K	BBWW-m	MT20	5.0	6.0	2.75 2.50
L	BMV1+p	MT20	2.0	4.0	Edge

Edge - INDICATES REFERENCE CORNER OF PLATE TOUCHES EDGE OF CHORD.

DIMENSIONS, SUPPORTS AND LOADINGS SPECIFIED BY FABRICATOR TO BE VERIFIED BY BUILDING DESIGNER

BEARINGS							
JT	FACTORED GROSS REACTION		MAXIMUM FACTORED GROSS REACTION		INPUT BRG		REQRD BRG
	VERT	HORZ	DOWN	HORZ	UPLIFT	IN-SX	IN-SX
L	1148	0	1148	0	0	5-8	1-8
H	1148	0	1148	0	0	5-8	1-8

UNFACTORED REACTIONS							
JT	1ST LCASE		MAX. MIN. COMPONENT REACTIONS		LIVE		DEAD
	COMBINED	SNOW	PERM. LIVE	WIND	SOIL		
L	840	510 / 0	125 / 0	0 / 0	0 / 0	204 / 0	0 / 0
H	840	510 / 0	125 / 0	0 / 0	0 / 0	204 / 0	0 / 0

BEARING MATERIAL TO BE SPF NO.2 OR BETTER AT JOINT(S) L, H

BRACING
TOP CHORD TO BE SHEATHED OR MAX. PURLIN SPACING = 4.43 FT.
MAX. UNBRACED BOTTOM CHORD LENGTH = 10.00 FT OR RIGID CEILING DIRECTLY APPLIED.

ALL PITCH BREAKS AND PERIMETER CORNER JOINTS MUST BE LATERALLY RESTRAINED.

LOADING
TOTAL LOAD CASES: (4)

CHORDS				WEBS			
MEMB.	MAX. FACTORED FORCE (LBS)	FACTORED VERT. LOAD (PLF)	FACTORED LC1 MAX CSI (LC)	MEMB.	MAX. FACTORED FORCE (LBS)	MAX. FACTORED CSI (LC)	
FR-TO		FROM TO	LENGTH	FR-TO			
L-B	-1078 / 0	0.0	0.0 0.11 (1)	J-D	0 / 1056	0.24 (1)	
A-B	0 / 47	-124.4	-124.4 0.17 (1)	J-E	-923 / 0	0.17 (1)	
B-C	-2141 / 0	-124.4	-124.4 0.26 (1)	I-E	0 / 803	0.14 (1)	
C-D	-1174 / 0	-124.4	-124.4 0.11 (1)	I-F	0 / 1857	0.42 (1)	
D-E	-1174 / 0	-124.4	-124.4 0.11 (1)	C-J	-923 / 0	0.17 (1)	
E-F	-2141 / 0	-124.4	-124.4 0.26 (1)	K-C	0 / 803	0.14 (1)	
F-G	0 / 47	-124.4	-124.4 0.17 (1)	B-K	0 / 1857	0.42 (1)	
H-F	-1078 / 0	0.0	0.0 0.11 (1)				
L-K	0 / 0	-39.3	-39.3 0.11 (3)				
K-J	0 / 1749	-39.2	-39.2 0.32 (1)				
J-I	0 / 1749	-39.3	-39.3 0.32 (1)				
I-H	0 / 0	-39.3	-39.3 0.11 (3)				

DESIGN CRITERIA

SPECIFIED LOADS:
TOP CH. LL = 34.8 PSF
DL = 8.0 PSF
BOT CH. LL = 10.5 PSF
DL = 7.3 PSF
TOTAL LOAD = 60.6 PSF

SPACING = 24.0 IN. C/C

THIS TRUSS IS DESIGNED FOR RESIDENTIAL OR SMALL BUILDING REQUIREMENTS OF PART 9, NBC 2015

THIS DESIGN COMPLIES WITH:
- PART 9 OF CBC 2018, ABC 2019
- PART 9 OF OBC 2012 (2019 AMENDMENT)
- CSA 088-14
- TPIC 2014

(55 % OF 48.1 P.S.F. G.S.L. PLUS 8.4 P.S.F. RAIN LOAD)
EQUALS 34.8 P.S.F. SPECIFIED ROOF LIVE LOAD

ALLOWABLE DEFL.(LL)= L/360 (0.40")
CALCULATED VERT. DEFL.(LL) = L/999 (0.07")
ALLOWABLE DEFL.(TL)= L/360 (0.40")
CALCULATED VERT. DEFL.(TL) = L/999 (0.11")

CSI: TC=0.26/1.00 (E-F:1) , BC=0.32/1.00 (I-J:1) ,
WB=0.42/1.00 (F-I:1) , SSI=0.16/1.00 (E-F:1)

DOL LUMBER=1.00 NAIL=1.00 LS BEND=1.10 COMP=1.10
SHEAR=1.10 TENS=1.10

COMPANION LIVE LOAD FACTOR = 1.00

TRUSS PLATE MANUFACTURER IS NOT RESPONSIBLE FOR QUALITY CONTROL IN THE TRUSS MANUFACTURING PLANT .

NAIL VALUES			
PLATE	GRIP(DRY)	SHEAR	SECTION
(PSI)	(PLI)	(PLI)	(PLI)
MAX MIN	MAX MIN	MAX MIN	MAX MIN
MT20	850	371	1747 788 1987 1873

PLATE PLACEMENT TOL. = 0.250 inches

PLATE ROTATION TOL. = 5.0 Deg.

JSI GRIP= 0.90 (J) (INPUT = 0.90)

JSI METAL = 0.53 (H) (INPUT = 1.00)




These plans have been reviewed for use with the corrections as noted. No other changes may be made without written approval of the Building Standards Branch. All work must comply with Zoning By-Law 2018-043, as amended, and the Ontario Building Code, as amended. These approved documents must be kept on site at all times. The building permit must be clearly posted on site at all times.

Discipline	Reviewer	BCIN	Date
Building Code	H. Authier	43236	2021-02-04
Sewage System			
Zoning			

READ ALL NOTES ON THIS PAGE AND ON ENGINEERING NOTE PAGE ENP-1. THIS NOTE PAGE IS AN INTEGRAL PART OF THIS DRAWING AS IT CONTAINS SPECIFICATIONS AND CRITERIA USED IN THE DESIGN OF THIS COMPONENT.



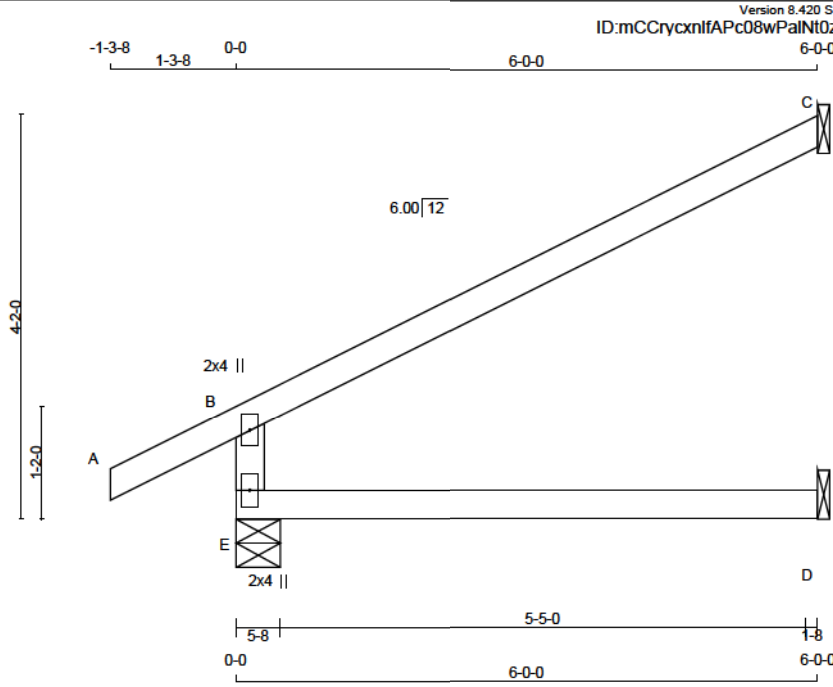

Scale = 1:23.7

LUMBER
N. L. G. A. RULES

CHORDS	SIZE	LUMBER	DESCR.
E - B	2x4	DRY	No.2
A - C	2x4	DRY	No.2
E - D	2x4	DRY	No.2

DRY: SEASONED LUMBER.

PLATES (table is in inches)

JT	TYPE	PLATES	W	LEN	Y	X
B	TMV+p	MT20	2.0	4.0		
E	BMV1+p	MT20	2.0	4.0		

DIMENSIONS, SUPPORTS AND LOADINGS SPECIFIED BY FABRICATOR TO BE VERIFIED BY BUILDING DESIGNER

BEARINGS

JT	FACTORED GROSS REACTION		MAXIMUM FACTORED GROSS REACTION		INPUT BRG	REQRD BRG
	VERT	HORZ	DOWN	HORZ		
E	774	0	774	0	5-8	1-8
C	280	0	280	0	1-8	1-8
D	97	0	123	0	1-8	1-8

SEE MITEK STANDARD DETAIL B97791H FOR CONNECTION TO JOINT(S) C, D

UNFACTORED REACTIONS

JT	COMBINED	1ST LCASE		MAX/MIN COMPONENT REACTIONS		WIND	DEAD	SOIL
		SNOW	LIVE	PERM. LIVE	UNBRAC			
E	563	355 / 0	74 / 0	0 / 0	0 / 0	133 / 0	0 / 0	0 / 0
C	193	157 / 0	0 / 0	0 / 0	0 / 0	36 / 0	0 / 0	0 / 0
D	88	0 / 0	52 / 0	0 / 0	0 / 0	36 / 0	0 / 0	0 / 0

BEARING MATERIAL TO BE SPF NO.2 OR BETTER AT JOINT(S) E, C

BRACING
TOP CHORD TO BE SHEATHED OR MAX. PURLIN SPACING = 8.25 FT.
MAX. UNBRACED BOTTOM CHORD LENGTH = 10.00 FT OR RIGID CEILING DIRECTLY APPLIED.

ALL PITCH BREAKS AND PERIMETER CORNER JOINTS MUST BE Laterally RESTRAINED.

LOADING
TOTAL LOAD CASES: (4)

CHORDS				WEBS			
MEMB.	MAX. FACTORED FORCE (LBS)	FACTORED VERT. LOAD (PLF)	FACTORED HORZ. LOAD (LC)	MAX. UNBRAC LENGTH	MEMB.	MAX. FACTORED FORCE (LBS)	MAX. FACTORED HORZ. LOAD (LC)
FR-TO		FROM TO			FR-TO		
E-B	-635 / 0	0.0	0.0 0.24 (3)	7.81			
A-B	0 / 38	-124.4	-124.4 0.16 (1)	10.00			
B-C	-42 / 0	-124.4	-124.4 0.76 (1)	6.25			
E-D	0 / 0	-39.2	-39.2 0.24 (3)	10.00			

DESIGN CRITERIA

SPECIFIED LOADS:
TOP CH. LL = 34.8 PSF
DL = 8.0 PSF
BOT CH. LL = 10.5 PSF
DL = 7.3 PSF
TOTAL LOAD = 60.6 PSF

SPACING = 24.0 IN. C/C
THIS TRUSS IS DESIGNED FOR RESIDENTIAL OR SMALL BUILDING REQUIREMENTS OF PART 9, NBCC 2015

THIS DESIGN COMPLIES WITH:
- PART 9 OF BCBC 2018, ABC 2019
- PART 9 OF OBC 2012 (2019 AMENDMENT)
- CSA 086-14
- TPIC 2014

DESIGN ASSUMPTIONS
- OVERHANG NOT TO BE ALTERED OR CUT OFF.
(55 % OF 48.1 P.S.F. G.S.L. PLUS 8.4 P.S.F. RAIN LOAD)
EQUALS 34.8 P.S.F. SPECIFIED ROOF LIVE LOAD

ALLOWABLE DEFL.(LL)= L/360 (0.20")
CALCULATED VERT. DEFL.(LL) = L/999 (0.05")
ALLOWABLE DEFL.(TL)= L/360 (0.20")
CALCULATED VERT. DEFL.(TL) = L/874 (0.08")

CSI: TC=0.76/1.00 (B-C:1) , BC=0.24/1.00 (D-E:3) ,
WB=0.00/1.00 (n/a:0) , SSI=0.33/1.00 (B-C:1)

DOL LUMBER=1.00 NAIL=1.00 LS BEND=1.10 COMP=1.10
SHEAR=1.10 TENS= 1.10

COMPANION LIVE LOAD FACTOR = 1.00

TRUSS PLATE MANUFACTURER IS NOT RESPONSIBLE FOR QUALITY CONTROL IN THE TRUSS MANUFACTURING PLANT .

NAIL VALUES

PLATE	GRIP(DRY)	SHEAR (PSI)	SECTION (PLI)
MT20	650	371	1747 788 1987 1873

PLATE PLACEMENT TOL. = 0.250 inches

PLATE ROTATION TOL. = 5.0 Deg.

JSI GRIP= 0.36 (B) (INPUT = 0.90)
JSI METAL= 0.26 (B) (INPUT = 1.00)




READ ALL NOTES ON THIS PAGE AND ON ENGINEERING NOTE PAGE ENP-1. THIS NOTE PAGE IS AN INTEGRAL PART OF THIS DRAWING AS IT CONTAINS SPECIFICATIONS AND CRITERIA USED IN THE DESIGN OF THIS COMPONENT.



These plans have been reviewed for use with the corrections as noted. No other changes may be made without written approval of the Building Standards Branch. All work must comply with Zoning By-Law 2018-043, as amended, and the Ontario Building Code, as amended. These approved documents must be kept on site at all times. The building permit must be clearly posted on site at all times.

Discipline	Reviewer	BCIN	Date
Building Code	H. Authier	43236	2021-02-04
Sewage System			
Zoning			



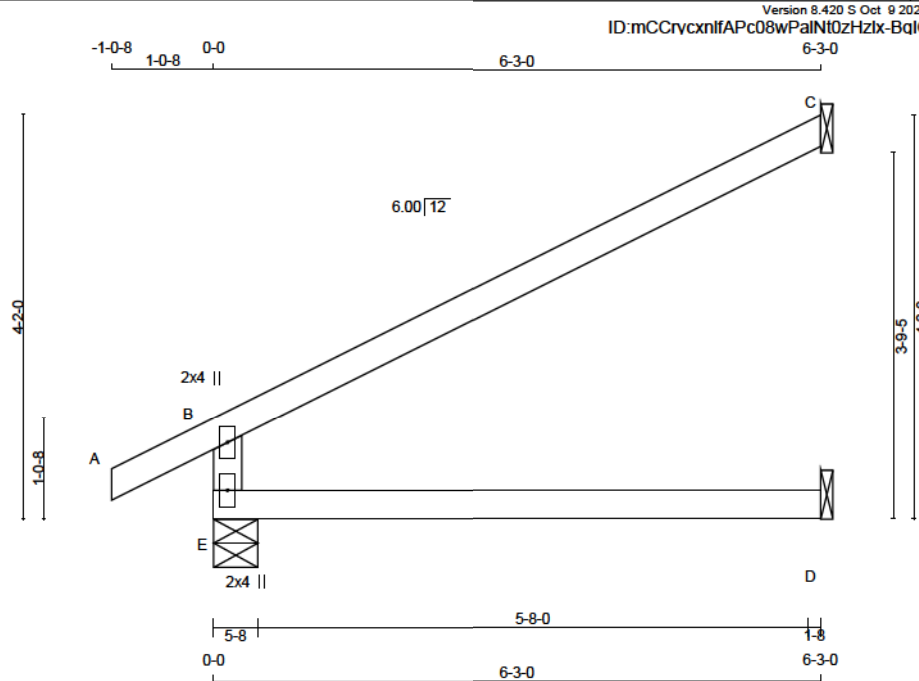

TOTAL WEIGHT = $5 \times 17 = 86$ lb

LUMBER			
N L G A. RULES			
CHORDS	SIZE	LUMBER	DESCR.
E - B	2x4	DRY No.2	SPF
A - C	2x4	DRY No.2	SPF
E - D	2x4	DRY No.2	SPF

DRY: SEASONED LUMBER.

DRY; SEASONED LUMBER.

PLATES (table is in inches)					
JT	TYPE	PLATES	W	LEN	Y X
B	TMV+p	MT20	2.0	4.0	
E	BMV1+p	MT20	2.0	4.0	

DIMENSIONS, SUPPORTS AND LOADINGS SPECIFIED BY FABRICATOR TO BE VERIFIED BY BUILDING DESIGNER

BEARINGS

JT	FACTORED GROSS REACTION		MAXIMUM FACTORED GROSS REACTION			INPUT BRG	REQRD BRG
	VERT	HORZ	DOWN	HORZ	UPLIFT	IN-SX	IN-SX
E	789	0	789	0	0	5-8	1-8
C	292	0	292	0	0	1-8	1-8
D	100	0	127	0	0	1-8	1-8

SEE MITEK STANDARD DETAIL B97791H FOR CONNECTION TO JOINT(S) C, D

UNFACTORED REACTIONS

SN REPORTED HERE ONLY							
1ST LCASE		MAX/MIN COMPONENT REACTIONS					
JT	COMBINED	SNOW	LIVE	PERM.LIVE	WIND	DEAD	SOIL
E	561	348 / 0	78 / 0	0 / 0	0 / 0	134 / 0	0 / 0
C	201	163 / 0	0 / 0	0 / 0	0 / 0	38 / 0	0 / 0
D	91	0 / 0	53 / 0	0 / 0	0 / 0	37 / 0	0 / 0

BEARING MATERIAL TO BE SPF NO.2 OR BETTER AT JOINT(S) E

BRACING

TOP CHORD TO BE SHEATHED OR MAX. PURLIN SPACING = 8.25 FT.
MAX. UNBRACED BOTTOM CHORD LENGTH = 10.00 FT. OR RIGID CEILING DIRECTLY APPLIED.

ALL PITCH BREAKS AND PERIMETER CORNER JOINTS MUST BE LATERALLY RESTRAINED

LOADING

TOTAL LOAD CASES: (4)

CHORDS				WEBS			
MEMB.	MAX. FACTORED (LBS)	FACTORED VERT. LOAD (PLF)	LC1 MAX CSI (LC)	MAX. UNBRGD LENGTH	MEMB.	MAX. FACTORED FORCE (LBS)	MAX. CSI (LC)
FR-TO		FROM	TO	FR-TO			
E-B	-624 / 0	0.0	0.0	0.22 (3)		7.81	
A-B	0 / 31	-124.4	-124.4	0.11 (1)		10.00	
B-C	-43 / 0	-124.4	-124.4	0.84 (1)		6.25	
E-D	0 / 0	-39.2	-39.2	0.27 (3)		10.00	

DESIGN CRITERIA

SPECIFIED LOADS:-

TOP	CH.	LL = 34.8	PSF
		DL = 8.0	PSF
BOT	CH.	LL = 10.5	PSF
		DL = 7.3	PSF
TOTAL LOAD		= 60.6	PSF

TOTAL LOAD = 60.6 PSF

SPACING = 24.0 IN. C/C

THIS TRUSS IS DESIGNED FOR RESIDENTIAL OR SMALL BUILDING REQUIREMENTS OF PART 9, NBCC 2015

THIS DESIGN COMPLIES WITH:

- PART 9 OF BCBC 2018 , ABC 2019
- PART 9 OF OBC 2012 (2019 AMENDMENT)
- CSA 086-14
- TPIC 2014

DESIGN ASSUMPTIONS

-OVERHANG NOT TO BE ALTERED OR CUT OFF.

(55 % OF 48.1 P.S.F. G.S.L. PLUS 8.4 P.S.F. RAIN LOAD)
EQUALS 34.8 P.S.F. SPECIFIED ROOF LIVE LOAD

ALLOWABLE DEFL.(LL)= L/360 (0.21")
CALCULATED VERT. DEFL.(LL) = L/ 999 (0.05")
ALLOWABLE DEFL.(TL)= L/360 (0.21")
CALCULATED VERT. DEFL.(TL) = L/ 805 (0.08")

CSI: TC=0.64/1.00 (B-C:1) , BC=0.27/1.00 (D-E:3) ,
WB=0.00/1.00 (n/a:0) , SSI=0.34/1.00 (B-C:1)

DOL LUMBER=1.00 NAIL=1.00 LS BEND=1.10 COMP=1.10
SHEAR=1.10 TENS= 1.10

COMPANION LIVE LOAD FACTOR = 1.00

TRUSS PLATE MANUFACTURER IS NOT RESPONSIBLE
FOR QUALITY CONTROL IN THE TRUSS
MANUFACTURING PLANT .

NAIL VALUES

PLATE	GRIP(DRY) (PSI)		SHEAR (PLI)		SECTION (PLI)	
	MAX	MIN	MAX	MIN	MAX	MIN
MT20	650	371	1747	788	1987	1873

PLATE PLACEMENT TOL. - 0.250 inches

PLATE ROTATION TOL. = 5.0 Deg

JSI GRIP= 0.35 (B) (INPUT = 0.90)
JSI METAL= 0.26 (B) (INPUT = 1.00)




**READ ALL NOTES ON THIS PAGE AND ON
ENGINEERING NOTE PAGE ENP-1. THIS
NOTE PAGE IS AN INTEGRAL PART OF
THIS DRAWING AS IT CONTAINS
SPECIFICATIONS AND CRITERIA USED IN
THE DESIGN OF THIS COMPONENT.**



These plans have been reviewed for use with the corrections as noted. No other changes may be made without written approval of the Building Standards Branch. All work must comply with Zoning By-Law 2018-043, as amended, and the Ontario Building Code, as amended. These approved documents must be kept on site at all times. The building permit must be clearly posted on site at all times.

Discipline	Reviewer	BCIN	Date
Building Code	H. Authier	43236	2021-02-0
Sewage System			
Zoning			



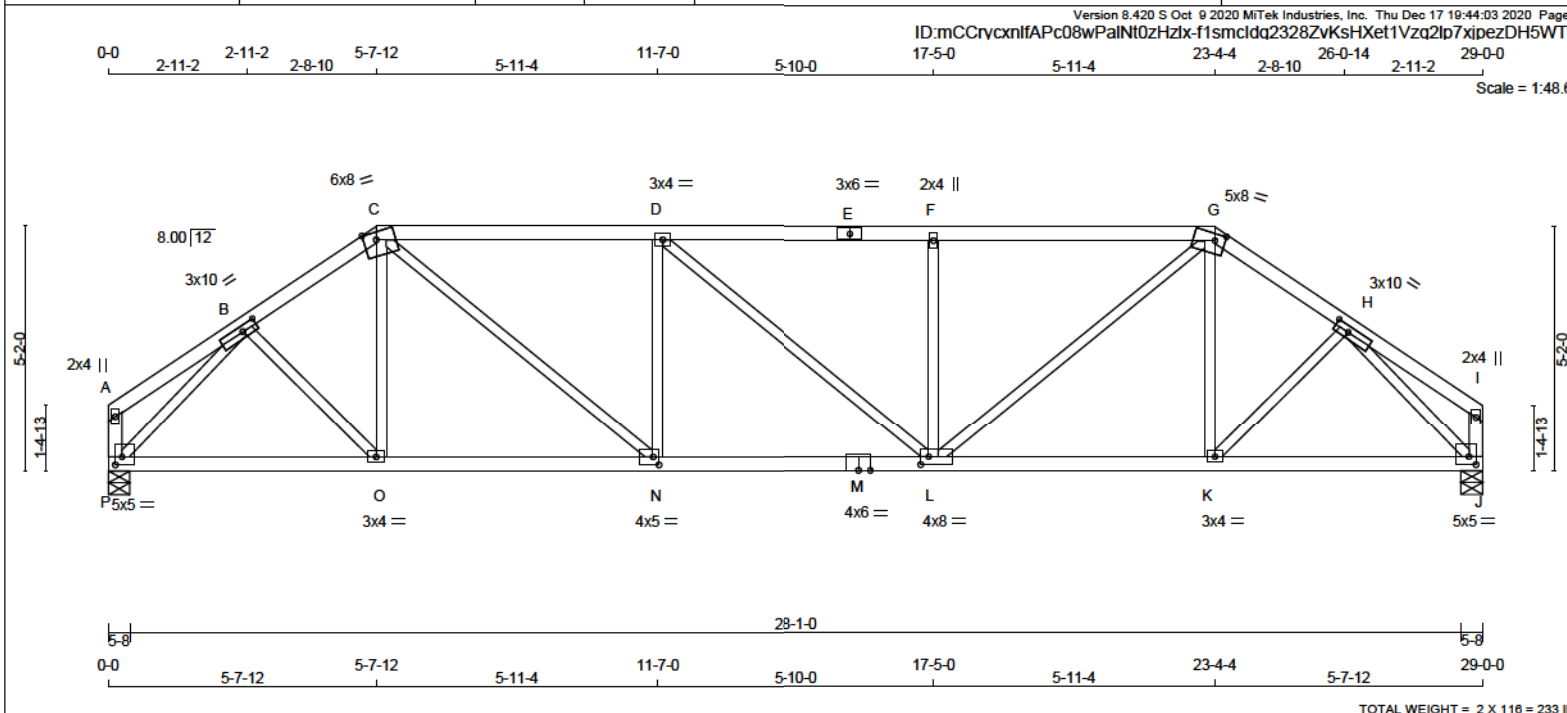

LUMBER										DIMENSIONS, SUPPORTS AND LOADINGS SPECIFIED BY FABRICATOR TO BE VERIFIED BY BUILDING DESIGNER										DESIGN CRITERIA									
N. L. G. A. RULES										BEARINGS										SPECIFIED LOADS:									
CHORDS SIZE LUMBER DESCR.										FACTORED GROSS REACTION MAXIMUM FACTORED GROSS REACTION INPUT BRG REQRD BRG										TOP CH. LL = 34.8 PSF									
A - C 2x4 DRY No.2 SPF										JT VERT HORZ DOWN HORZ UPLIFT IN-SX IN-SX										DL = 8.0 PSF									
C - E 2x4 DRY No.2 SPF										P 2373 0 2373 0 0 5-8 2-9										BOT CH. LL = 10.5 PSF									
E - G 2x4 DRY No.2 SPF										J 2373 0 2373 0 0 5-8 2-9										DL = 7.3 PSF									
G - I 2x4 DRY No.2 SPF										UNFACTORED REACTIONS										TOTAL LOAD = 60.6 PSF									
P - A 2x4 DRY No.2 SPF										1ST LCASE MAX/MIN COMPONENT REACTIONS										SPACING = 24.0 IN. C/C									
J - I 2x4 DRY No.2 SPF										JT COMBINED SNOW LIVE PERM.LIVE WIND DEAD SOIL										LOADING IN FLAT SECTION BASED ON A SLOPE OF 2.00/12 MINIMUM									
P - M 2x4 DRY No.2 SPF										P 1758 1009 / 0 305 / 0 0 / 0 0 / 0 444 / 0 0 / 0										THIS TRUSS IS DESIGNED FOR RESIDENTIAL OR SMALL BUILDING REQUIREMENTS OF PART 9, NBCC 2015									
M - J 2x4 DRY No.2 SPF										J 1758 1009 / 0 305 / 0 0 / 0 0 / 0 444 / 0 0 / 0										THIS DESIGN COMPLIES WITH: - PART 9 OF BCBC 2018 , ABC 2019 - PART 9 OF OBC 2012 (2019 AMENDMENT) - CSA 086-14 - TPIC 2014									
ALL WEBS 2x3 DRY No.2 SPF										BEARING MATERIAL TO BE SPF NO.2 OR BETTER AT JOINT(S) P, J										(55 % OF 48.1 P.S.F. G.S.L. PLUS 8.4 P.S.F. RAIN LOAD) EQUALS 34.8 P.S.F. SPECIFIED ROOF LIVE LOAD									
EXCEPT										BRACING										ALLOWABLE DEFL.(LL)= L/380 (0.97")									
DRY: SEASONED LUMBER.										TOP CHORD TO BE SHEATHED OR MAX. PURLIN SPACING = 2.80 FT.										CALCULATED VERT. DEFL.(LL) = L/ 999 (0.17")									
										MAX. UNBRACED BOTTOM CHORD LENGTH = 10.00 FT OR RIGID CEILING DIRECTLY APPLIED.										ALLOWABLE DEFL.(TL)= L/380 (0.97")									
										ALL PITCH BREAKS AND PERIMETER CORNER JOINTS MUST BE Laterally RESTRAINED.										CALCULATED VERT. DEFL.(TL)= L/ 999 (0.29")									
PLATES (table is in inches)										LOADING										CSI: TC=0.95/1.00 (C-D:1) , BC=0.68/1.00 (L-N:1) , WB=0.80/1.00 (H-J:1) , SSI=0.34/1.00 (C-D:1)									
										TOTAL LOAD CASES: (4)										DOL LUMBER=1.00 NAIL=1.00 LS BEND=1.10 COMP=1.10 SHEAR=1.10 TENS=1.10									
										CHORDS WEBS										COMPANION LIVE LOAD FACTOR = 1.00									
										MAX. FACTORED FORCE (LBS) FACTORED VERT. LOAD (PLF) LC1 MAX CSI (LC) UNBRAC										TRUSS PLATE MANUFACTURER IS NOT RESPONSIBLE FOR QUALITY CONTROL IN THE TRUSS MANUFACTURING PLANT .									
										MEMB. MAX. FACTORED FORCE (LBS) MAX. FACTORED CSI (LC)										NAIL VALUES									
										FR-TO FROM TO LENGTHFR-TO										PLATE GRIP(DRY) SHEAR SECTION									
										A-B 0 / 16 -124.4 -124.4 0.12 (1) 10.00 B-O 0 / 303 0.07 (1)										(PSI) (PLI) (PLI)									
										B-C -2726 / 0 -124.4 -124.4 0.21 (1) 4.03 O-C 0 / 172 0.04 (3)																			
										C-D -3490 / 0 -124.4 -124.4 0.95 (1) 2.80 C-N 0 / 1603 0.36 (1)																			
										D-E -3488 / 0 -124.4 -124.4 0.93 (1) 2.80 N-D -792 / 0 0.31 (1)																			
										E-F -3488 / 0 -124.4 -124.4 0.93 (1) 2.80 D-L -2 / 0 0.00 (1)																			
										F-G -3488 / 0 -124.4 -124.4 0.94 (1) 2.81 L-F -792 / 0 0.31 (1)																			
										G-H -2727 / 0 -124.4 -124.4 0.21 (1) 4.03 L-G 0 / 1600 0.36 (1)																			
										H-I 0 / 16 -124.4 -124.4 0.12 (1) 10.00 K-G 0 / 172 0.04 (3)																			
										P-A -146 / 0 0.0 0.0 0.02 (1) 7.81 K-H 0 / 303 0.07 (1)																			
										J-I -146 / 0 0.0 0.0 0.02 (1) 7.81 P-B -2952 / 0 0.80 (1)																			
																				H-J -2952 / 0 0.80 (1)									

These plans have been reviewed for use with the corrections as noted. No other changes may be made without written approval of the Building Standards Branch. All work must comply with Zoning By-Law 2015-043, as amended, and the Ontario Building Code, as amended. These approved documents must be kept on site at all times. The building permit must be clearly posted on site at all times.

Discipline	Reviewer	BCIN	Date
Building Code	H. Authier	43236	2021-02-04
Sewage System			
Zoning			

DESIGN CRITERIA

SPECIFIED LOADS:

TOP CH. LL = 34.8 PSF
DL = 8.0 PSF

BOT CH. LL = 10.5 PSF
DL = 7.3 PSF

TOTAL LOAD = 60.6 PSF

SPACING = 24.0 IN. C/C

LOADING IN FLAT SECTION BASED ON A SLOPE OF 2.00/12 MINIMUM

THIS TRUSS IS DESIGNED FOR RESIDENTIAL OR SMALL BUILDING REQUIREMENTS OF PART 9, NBCC 2015

THIS DESIGN COMPLIES WITH:

- PART 9 OF BCBC 2018, ABC 2019
- PART 9 OF OBC 2012 (2019 AMENDMENT)
- CSA 088-14
- TPIC 2014

(55 % OF 48.1 P.S.F. G.S.L. PLUS 8.4 P.S.F. RAIN LOAD) EQUALS 34.8 P.S.F. SPECIFIED ROOF LIVE LOAD

ALLOWABLE DEFL.(LL)= L/360 (0.97")
CALCULATED VERT. DEFL.(LL)= L/999 (0.17")
ALLOWABLE DEFL.(TL)= L/360 (0.97")
CALCULATED VERT. DEFL.(TL)= L/999 (0.29")

CSI: TC=0.95/1.00 (C-D-1) , BC=0.68/1.00 (L-N-1) , WB=0.80/1.00 (H-J-1) , SSI=0.34/1.00 (C-D-1)

DOL LUMBER=1.00 NAIL=1.00 LS BEND=1.10 COMP=1.10
SHEAR=1.10 TENS=1.10

COMPANION LIVE LOAD FACTOR = 1.00

TRUSS PLATE MANUFACTURER IS NOT RESPONSIBLE FOR QUALITY CONTROL IN THE TRUSS MANUFACTURING PLANT .

NAIL VALUES


PLATE GRIP(DRY) SHEAR	SECTION (PSI)	(PLI)	(PLI)
MAX MIN MAX MIN MAX MIN			
MT20 650 371 1747 788 1987 1873			

PLATE PLACEMENT TOL. = 0.250 inches

PLATE ROTATION TOL. = 5.0 Deg.

JSI GRIP= 0.90 (G) (INPUT = 0.90)
JSI METAL = 0.81 (M) (INPUT = 1.00)

READ ALL NOTES ON THIS PAGE AND ON ENGINEERING NOTE PAGE ENP-1. THIS NOTE PAGE IS AN INTEGRAL PART OF THIS DRAWING AS IT CONTAINS SPECIFICATIONS AND CRITERIA USED IN THE DESIGN OF THIS COMPONENT.

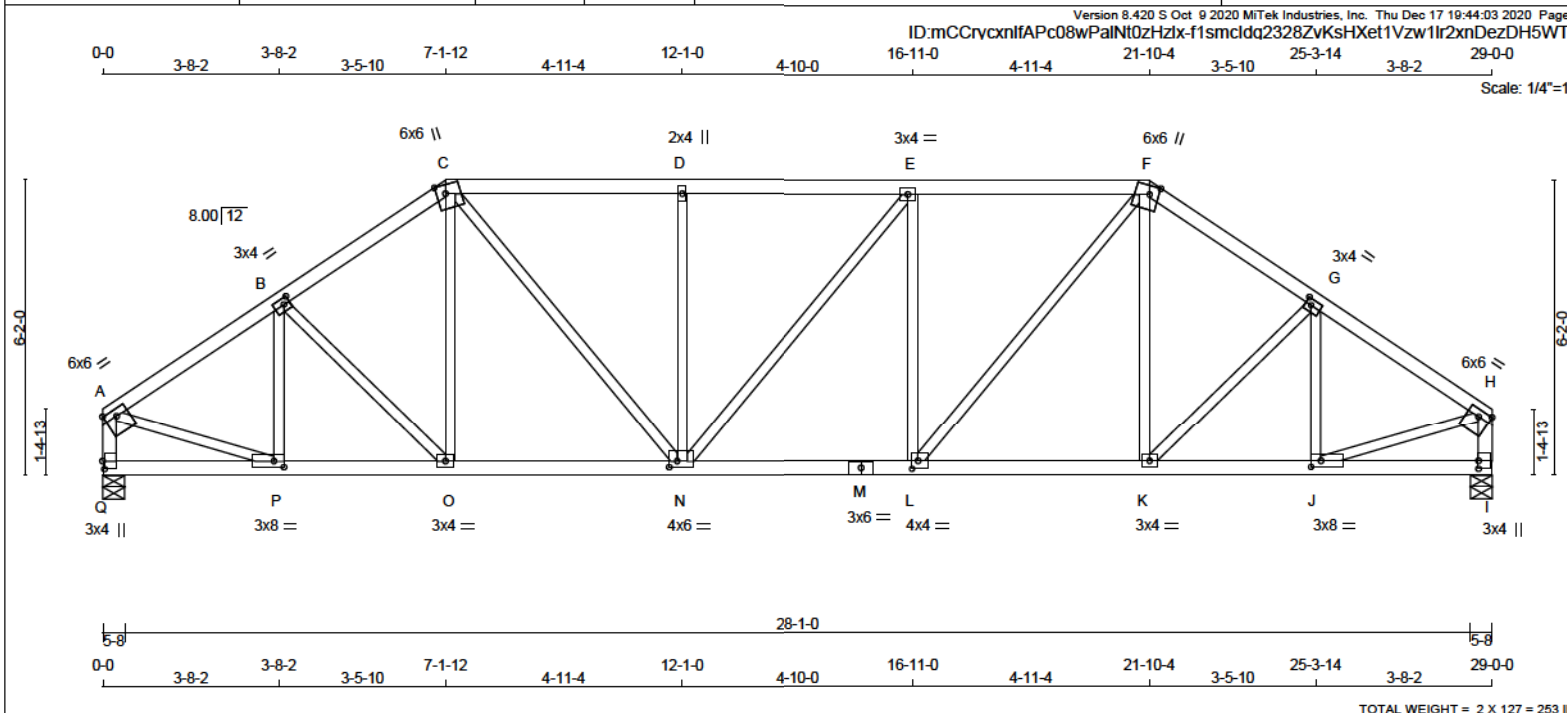

LUMBER

N. L. G. A. RULES

CHORDS	SIZE	LUMBER	DESCR.
A - C	2x4	DRY No.2	SPF
C - F	2x4	DRY No.2	SPF
F - H	2x4	DRY No.2	SPF
Q - A	2x4	DRY No.2	SPF
I - H	2x4	DRY No.2	SPF
Q - M	2x4	DRY No.2	SPF
M - I	2x4	DRY No.2	SPF

ALL WEBS	2x3	DRY No.2	SPF
----------	-----	----------	-----

EXCEPT

DRY: SEASONED LUMBER.

PLATES (table is in inches)

JT TYPE	PLATES	W	LEN	Y	X	
A	TMVW-t	MT20	6.0	6.0	1.75	Edge
B	TMWW-t	MT20	3.0	4.0	1.50	1.50
C	TTWW+m	MT20	6.0	6.0	2.25	2.25
D	TMW+w	MT20	2.0	4.0		
E	TMWW-t	MT20	3.0	4.0		
F	TTWW+m	MT20	6.0	6.0	2.25	2.25
G	TMWW-t	MT20	3.0	4.0	1.50	1.50
H	TMVW-t	MT20	6.0	6.0	1.75	Edge
I	BMV1+p	MT20	3.0	4.0	2.00	
J	BMWW-t	MT20	3.0	8.0	1.50	2.50
K	BMWW-t	MT20	3.0	4.0		
L	BMWW-t	MT20	4.0	4.0	2.00	1.50
M	BS-t	MT20	3.0	6.0		
N	BMWWW-t	MT20	4.0	6.0	1.50	2.00
O	BMWW-t	MT20	3.0	4.0		
P	BMVW-t	MT20	3.0	8.0	1.50	2.50
Q	BMV1+p	MT20	3.0	4.0	2.00	0.50

Edge - INDICATES REFERENCE CORNER OF PLATE TOUCHES EDGE OF CHORD.

DIMENSIONS, SUPPORTS AND LOADINGS SPECIFIED BY FABRICATOR TO BE VERIFIED BY BUILDING DESIGNER

BEARINGS

FACTORED GROSS REACTION	MAXIMUM FACTORED GROSS REACTION	INPUT BRG	REQRD BRG			
JT VERT	DOWN	HORIZ	UPLIFT	IN-SX	IN-SX	
Q	2373	0	2373	0	5-8	4-3
I	2373	0	2373	0	5-8	4-3

UNFACTORED REACTIONS

1ST LCASE	MAX. MIN. COMPONENT REACTIONS
JT	COMBINED SNOW LIVE PERM. LIVE WIND DEAD SOIL
Q	1758 1009 / 0 305 / 0 0 / 0 0 / 0 444 / 0 0 / 0
I	1758 1009 / 0 305 / 0 0 / 0 0 / 0 444 / 0 0 / 0

BEARING MATERIAL TO BE SPF NO.2 OR BETTER AT JOINT(S) Q, I

BRACING

TOP CHORD TO BE SHEATHED OR MAX. PURLIN SPACING = 3.52 FT.

MAX. UNBRACED BOTTOM CHORD LENGTH = 10.00 FT OR RIGID CEILING DIRECTLY APPLIED.

ALL PITCH BREAKS AND PERIMETER CORNER JOINTS MUST BE LATERALLY RESTRAINED.

LOADING

TOTAL LOAD CASES: (4)

CHORDS				WEBS			
MEMB.	MAX. FACTORED FORCE (LBS)	FACTORED VERT. LOAD (PLF)	LC1 MAX CSI (LC)	MEMB.	MAX. FACTORED FORCE (LBS)	MAX. FACTORED FORCE (LBS)	MAX. FACTORED FORCE (LBS)
FR-TO		FROM TO	LENGTH	FR-TO			
A-B	-2634 / 0	-124.4 -124.4	0.35 (1)	3.94	P-B	-514 / 0	0.12 (1)
B-C	-2666 / 0	-124.4 -124.4	0.34 (1)	3.92	B-O	-31 / 2	0.01 (1)
C-D	-2605 / 0	-124.4 -124.4	0.55 (1)	3.53	O-C	0 / 233	0.05 (2)
D-E	-2605 / 0	-124.4 -124.4	0.56 (1)	3.52	C-N	0 / 1104	0.25 (1)
E-F	-2608 / 0	-124.4 -124.4	0.56 (1)	3.52	N-D	-854 / 0	0.39 (1)
F-G	-2665 / 0	-124.4 -124.4	0.34 (1)	3.92	N-E	-4 / 0	0.00 (1)
G-H	-2634 / 0	-124.4 -124.4	0.35 (1)	3.94	L-E	-855 / 0	0.39 (1)
Q-A	-2307 / 0	0.0 0.0	0.24 (1)	5.62	L-F	0 / 1108	0.25 (1)
I-H	-2307 / 0	0.0 0.0	0.24 (1)	5.62	K-F	0 / 231	0.05 (2)
Q-P	0 / 0	-39.2 -39.2	0.09 (3)	10.00	J-G	-513 / 0	0.12 (1)
P-O	0 / 2213	-39.2 -39.2	0.44 (1)	10.00	A-P	0 / 2306	0.52 (1)
O-N	0 / 2194	-39.2 -39.2	0.44 (1)	10.00	J-H	0 / 2306	0.52 (1)
N-M	0 / 2908	-39.2 -39.2	0.56 (1)	10.00			
M-L	0 / 2908	-39.2 -39.2	0.56 (1)	10.00			
L-K	0 / 2194	-39.2 -39.2	0.45 (1)	10.00			
K-J	0 / 2213	-39.2 -39.2	0.44 (1)	10.00			
J-I	0 / 0	-39.2 -39.2	0.09 (3)	10.00			

DESIGN CRITERIA

SPECIFIED LOADS:

TOP CH.	LL	= 34.8	PSF
	DL	= 8.0	PSF
BOT CH.	LL	= 10.5	PSF
	DL	= 7.3	PSF
TOTAL LOAD		= 60.6	PSF

SPACING = 24.0 IN. C/C

LOADING IN PLAT SECTION BASED ON A SLOPE OF 2.00/12 MINIMUM

THIS TRUSS IS DESIGNED FOR RESIDENTIAL OR SMALL BUILDING REQUIREMENTS OF PART 9, NBCC 2015

THIS DESIGN COMPLIES WITH:
- PART 9 OF CBC 2018 , ABC 2019
- PART 9 OF OBC 2012 (2019 AMENDMENT)
- CSA 086-14
- TPIC 2014

(55 % OF 48.1 P.S.F. G.S.L. PLUS 8.4 P.S.F. RAIN LOAD)
EQUALS 34.8 P.S.F. SPECIFIED ROOF LIVE LOAD

ALLOWABLE DEFL.(LL)= L/360 (0.97")
CALCULATED VERT. DEFL.(LL) = L/ 999 (0.12")
ALLOWABLE DEFL.(TL)= L/360 (0.97")
CALCULATED VERT. DEFL.(TL) = L/ 999 (0.21")

CSI: TC=0.56/1.00 (E-F:1) , BC=0.56/1.00 (L-N:1) ,
WB=0.52/1.00 (H-J:1) , SSI=0.28/1.00 (E-F:1)

DOL LUMBER=1.00 NAIL=1.00 LS BEND=1.10 COMP=1.10
SHEAR=1.10 TENS= 1.10

COMPANION LIVE LOAD FACTOR = 1.00

TRUSS PLATE MANUFACTURER IS NOT RESPONSIBLE FOR QUALITY CONTROL IN THE TRUSS MANUFACTURING PLANT .

NAIL VALUES

PLATE GRIP(DRY) SHEAR SECTION

(PSI) (PLI) (PLI)

MAXIMUM MINIMUM MINIMUM

DESIGN CRITERIA

SPECIFIED LOADS:
 TOP CH. LL = 34.8 PSF
 DL = 8.0 PSF
 BOT CH. LL = 10.5 PSF
 DL = 7.3 PSF
 TOTAL LOAD = 60.6 PSF

SPACING = 24.0 IN. C/C

LOADING IN FLAT SECTION BASED ON A SLOPE OF 2.00/12 MINIMUM

THIS TRUSS IS DESIGNED FOR RESIDENTIAL OR SMALL BUILDING REQUIREMENTS OF PART 9, NBCC 2015

THIS DESIGN COMPLIES WITH:
 - PART 9 OF BCBC 2018, ABC 2019
 - PART 9 OF OBC 2012 (2019 AMENDMENT)
 - CSA 088-14
 - TPIC 2014

(55% OF 48.1 P.S.F. G.S.L. PLUS 8.4 P.S.F. RAIN LOAD)
 EQUALS 34.8 P.S.F. SPECIFIED ROOF LIVE LOAD

ALLOWABLE DEFL.(LL)= L/360 (0.97")
 CALCULATED VERT. DEFL.(LL) = L/999 (0.12")
 ALLOWABLE DEFL.(TL)= L/360 (0.97")
 CALCULATED VERT. DEFL.(TL) = L/999 (0.21")

CSI: TC=0.56/1.00 (E-F:1) . BC=0.56/1.00 (L-N:1) .
 WB=0.52/1.00 (H-J:1) . SSI=0.28/1.00 (E-F:1)

DOL LUMBER=1.00 NAIL=1.00 LS BEND=1.10 COMP=1.10
 SHEAR=1.10 TENS=1.10

COMPANION LIVE LOAD FACTOR = 1.00

TRUSS PLATE MANUFACTURER IS NOT RESPONSIBLE FOR QUALITY CONTROL IN THE TRUSS MANUFACTURING PLANT .

NAIL VALUES
 PLATE GRIP(DRY) SHEAR SECTION (PSI) (PLI) (PLI)
 MAX MIN MAX MIN MAX MIN
 MT20 650 371 1747 788 1987 1873


PLATE PLACEMENT TOL. = 0.250 inches

PLATE ROTATION TOL. = 5.0 Deg.

JSI GRIP= 0.90 (H) (INPUT = 0.90)
 JSI METAL = 0.85 (M) (INPUT = 1.00)

READ ALL NOTES ON THIS PAGE AND ON ENGINEERING NOTE PAGE ENP-1. THIS NOTE PAGE IS AN INTEGRAL PART OF THIS DRAWING AS IT CONTAINS SPECIFICATIONS AND CRITERIA USED IN THE DESIGN OF THIS COMPONENT.

Discipline Reviewer BCIN Date
 Building Code H. Authier 43236 2021-02-04
 Sewage System
 Zoning

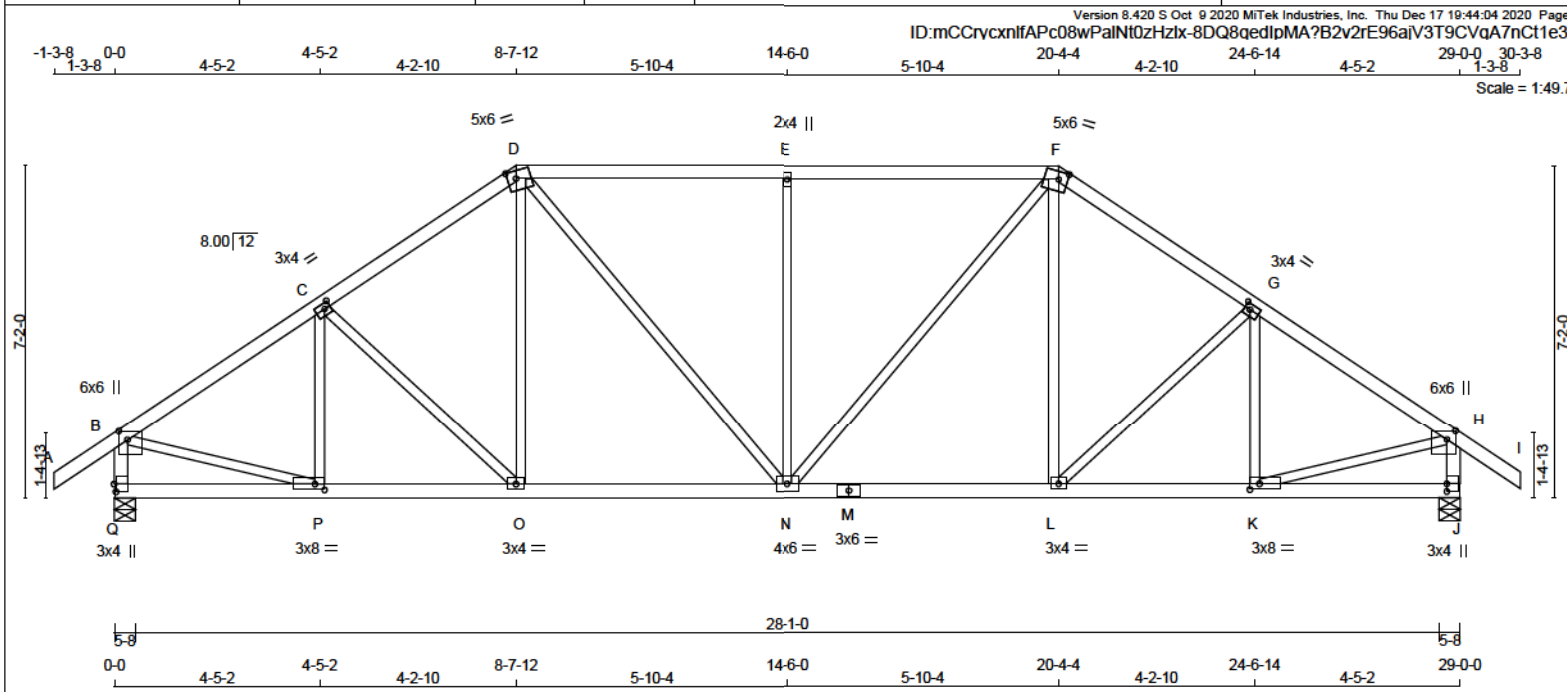

LUMBER
N. L. G. A. RULES

CHORDS	SIZE	LUMBER	DESCR.
A - D	2x4	DRY No.2	SPF
D - F	2x4	DRY No.2	SPF
F - I	2x4	DRY No.2	SPF
Q - B	2x4	DRY No.2	SPF
J - H	2x4	DRY No.2	SPF
Q - M	2x4	DRY No.2	SPF
M - J	2x4	DRY No.2	SPF
ALL WEBS EXCEPT	2x3	DRY No.2	SPF

DRY: SEASONED LUMBER.

PLATES (table is in inches)

JT TYPE	PLATES	W	LEN	Y	X
B - TMVW+p	MT20	6.0	4.0	2.25	2.25
C - TMVW-t	MT20	3.0	4.0	1.50	1.50
D - TTWW-m	MT20	5.0	6.0	2.00	2.25
E - TMW+w	MT20	2.0	4.0		
F - TTWW-m	MT20	5.0	6.0	2.00	2.25
G - TMVW-t	MT20	3.0	4.0	1.50	1.50
H - TMVW+p	MT20	6.0	6.0	2.25	2.25
J - BMV1+p	MT20	3.0	4.0	2.00	
K - BMW-t	MT20	3.0	8.0	1.50	2.50
L - BMW-t	MT20	3.0	4.0		
M - BS-t	MT20	3.0	6.0		
N - BMW-t	MT20	4.0	6.0		
O - BMW-t	MT20	3.0	4.0		
P - BMW-t	MT20	3.0	8.0	1.50	2.50
Q - BMV1+p	MT20	3.0	4.0	2.00	0.50



READ ALL NOTES ON THIS PAGE AND ON ENGINEERING NOTE PAGE ENP-1. THIS NOTE PAGE IS AN INTEGRAL PART OF THIS DRAWING AS IT CONTAINS SPECIFICATIONS AND CRITERIA USED IN THE DESIGN OF THIS COMPONENT.

DIMENSIONS, SUPPORTS AND LOADINGS SPECIFIED BY FABRICATOR TO BE VERIFIED BY BUILDING DESIGNER

BEARINGS

	FACTORED GROSS REACTION	MAXIMUM FACTORED GROSS REACTION	INPUT BRG	REQRD BRG
JT VERT	0	0	0	0
Q 2544	0	2544	0	5-8
J 2544	0	2544	0	5-8

UNFACTORED REACTIONS

1ST LCASE	MAX	MIN	COMPONENT REACTIONS
JT COMBINED	SNOW	LIVE	PERM.LIVE WIND DEAD SOIL
Q 1875	1105 / 0	304 / 0	0 / 0 486 / 0 0 / 0
J 1875	1105 / 0	304 / 0	0 / 0 486 / 0 0 / 0

BEARING MATERIAL TO BE SPF NO.2 OR BETTER AT JOINT(S) Q, J

BRACING
TOP CHORD TO BE SHEATHED OR MAX. PURLIN SPACING = 3.55 FT.
MAX. UNBRACED BOTTOM CHORD LENGTH = 10.00 FT OR RIGID CEILING DIRECTLY APPLIED.
ALL PITCH BREAKS AND PERIMETER CORNER JOINTS MUST BE LATERALLY RESTRAINED.

LOADING
TOTAL LOAD CASES: (4)

CHORDS				WEBS			
MEMB.	MAX. FACTORED FORCE (LBS)	FACTORED VERT. LOAD (PLF)	LC1 MAX (LC)	MEMB.	MAX. FACTORED FORCE (LBS)	MAX. FACTORED FORCE (LBS)	MAX. FACTORED FORCE (LBS)
FR-TO		FROM	TO	LENGTH	FR-TO		
A-B	0 / 47	-124.4	-124.4	0.17 (1)	10.00	P-C	-384 / 0
B-C	-2714 / 0	-124.4	-124.4	0.39 (1)	3.87	C-O	-243 / 0
C-D	-2573 / 0	-124.4	-124.4	0.37 (1)	3.97	O-D	0 / 388
D-E	-2592 / 0	-124.4	-124.4	0.65 (1)	3.55	D-N	0 / 738
E-F	-2592 / 0	-124.4	-124.4	0.65 (1)	3.55	N-E	-890 / 0
F-G	-2573 / 0	-124.4	-124.4	0.37 (1)	3.97	N-F	0 / 738
G-H	-2714 / 0	-124.4	-124.4	0.39 (1)	3.87	L-F	0 / 388
H-I	0 / 47	-124.4	-124.4	0.17 (1)	10.00	L-G	-243 / 0
Q-B	-2468 / 0	0.0	0.0	0.25 (1)	5.46	K-G	-384 / 0
J-H	-2468 / 0	0.0	0.0	0.25 (1)	5.46	B-P	0 / 2353
						K-H	0 / 2353
Q-P	0 / 0	-39.2	-39.2	0.13 (3)	10.00		
P-O	0 / 2286	-39.2	-39.2	0.48 (1)	10.00		
O-N	0 / 2114	-39.2	-39.2	0.48 (1)	10.00		
N-M	0 / 2114	-39.2	-39.2	0.48 (1)	10.00		
M-L	0 / 2114	-39.2	-39.2	0.48 (1)	10.00		
L-K	0 / 2286	-39.2	-39.2	0.48 (1)	10.00		
K-J	0 / 0	-39.2	-39.2	0.13 (3)	10.00		

DESIGN CRITERIA

SPECIFIED LOADS:
TOP CH. LL = 34.8 PSF
DL = 8.0 PSF
BOT CH. LL = 10.5 PSF
DL = 7.3 PSF
TOTAL LOAD = 60.6 PSF

SPACING = 24.0 IN. C/C

LOADING IN FLAT SECTION BASED ON A SLOPE OF 2.00/12 MINIMUM

THIS TRUSS IS DESIGNED FOR RESIDENTIAL OR SMALL BUILDING REQUIREMENTS OF PART 9, NBCC 2015

THIS DESIGN COMPLIES WITH:
- PART 9 OF BCBC 2018, ABC 2019
- PART 9 OF OBC 2012 (2019 AMENDMENT)
- CSA 088-14
- TPIC 2014

(55% OF 48.1 P.S.F. G.S.L. PLUS 8.4 P.S.F. RAIN LOAD)
EQUALS 34.8 P.S.F. SPECIFIED ROOF LIVE LOAD

ALLOWABLE DEFL.(LL) = L/360 (0.97")
CALCULATED VERT. DEFL.(LL) = L/999 (0.11")
ALLOWABLE DEFL.(TL) = L/360 (0.97")
CALCULATED VERT. DEFL.(TL) = L/999 (0.10")

CSI: TC=0.65/1.00 (D-E-1), BC=0.48/1.00 (O-P-1),
WB=0.80/1.00 (E-N-1), SSI=0.35/1.00 (E-F-1)

DOL LUMBER=1.00 NAIL=1.00 LS BEND=1.10 COMP=1.10
SHEAR=1.10 TENS=1.10

COMPANION LIVE LOAD FACTOR = 1.00

TRUSS PLATE MANUFACTURER IS NOT RESPONSIBLE FOR QUALITY CONTROL IN THE TRUSS MANUFACTURING PLANT.

NAIL VALUES
PLATE GRIP(DRY) SHEAR SECTION (PSI) (PLI) (PLI)
MAX MIN MAX MIN MAX MIN
MT20 650 371 1747 788 1987 1873

PLATE PLACEMENT TOL. = 0.250 inches

PLATE ROTATION TOL. = 5.0 Deg.

JSI GRIP= 0.90 (Q) (INPUT = 0.90)
JSI METAL = 0.63 (M) (INPUT = 1.00)




These plans have been reviewed for use with the corrections as noted. No other changes may be made without written approval of the Building Standards Branch. All work must comply with Zoning By-Law 2015-043, as amended, and the Ontario Building Code, as amended. These approved documents must be kept on site at all times. The building permit must be clearly posted on site at all times.

Discipline	Reviewer	BCIN	Date
Building Code	H. Authier	43236	2021-02-04
Sewage System			
Zoning			



Version 8.420 S Oct 9 2020 Mitek Industries, Inc. Thu Dec 17 19:44:06 2020 Page 1
ID:mCCrycxnlfAPc08wPalNt0zHzlx-4cYvFJfYL QlQM3RvfBaf8bOoyt085C4fBWl7oy7z

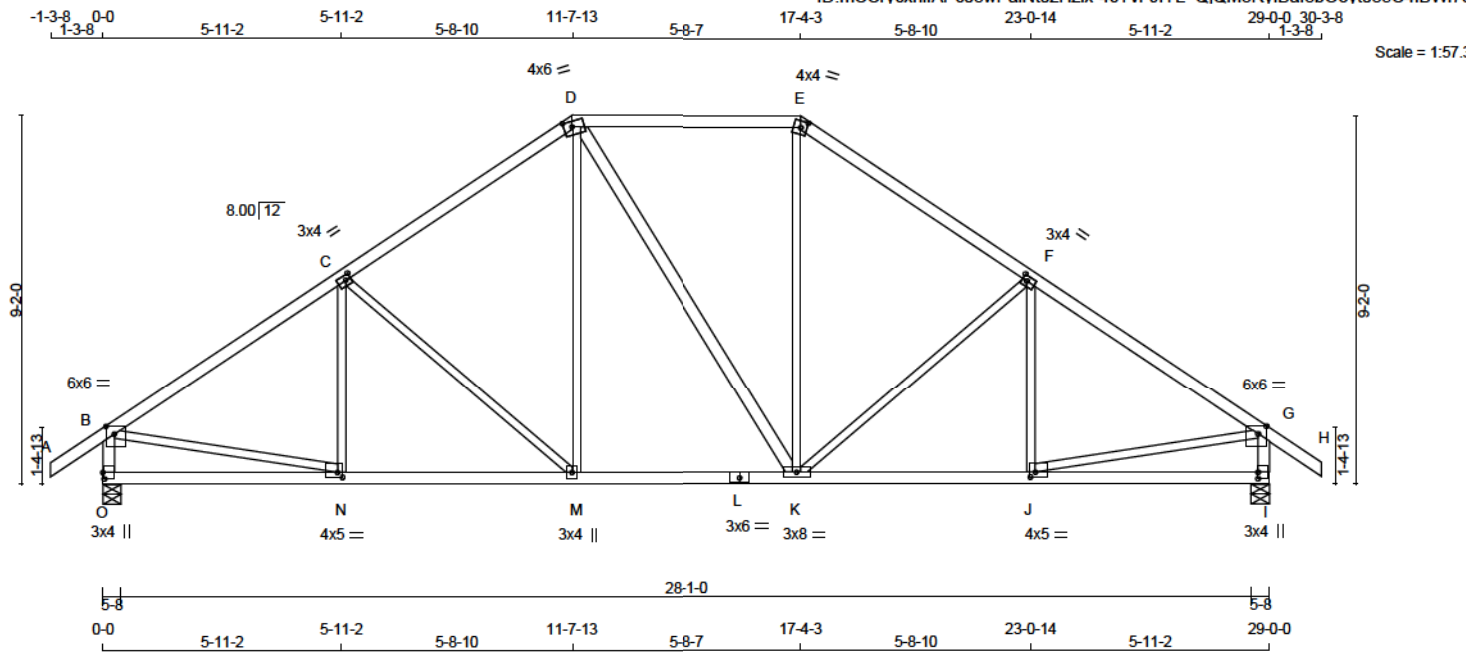

TOTAL WEIGHT = 2 X 132 = 264 lb

LUMBER			
N. L. G. A. RULES	SIZE	LUMBER	DESCR.
CHORDS			
A - D	2x4	DRY	No.2
D - E	2x4	DRY	No.2
E - H	2x4	DRY	No.2
O - B	2x4	DRY	No.2
I - G	2x4	DRY	No.2
O - L	2x4	DRY	No.2
L - I	2x4	DRY	No.2
ALL WEBS	2x3	DRY	No.2
EXCEPT			
D - K	2x4	DRY	No.2

DRY: SEASONED LUMBER.

PLATES (table is in inches)				
JT TYPE	PLATES	W	LEN	Y X
B TMWW-p	MT20	6.0	6.0	2.25 2.50
C TMWW-t	MT20	3.0	4.0	1.50 1.50
D TTWW-m	MT20	4.0	6.0	1.75 2.50
E TTWW-m	MT20	4.0	4.0	2.00 1.75
F TMWW-t	MT20	3.0	4.0	1.50 1.50
G TMWW-p	MT20	6.0	6.0	2.25 2.50
I BMV1+p	MT20	3.0	4.0	2.00
J BMWW-t	MT20	4.0	5.0	1.50 1.50
K BMWW-t	MT20	3.0	8.0	
L BS-t	MT20	3.0	6.0	
M BMWW-t	MT20	3.0	4.0	
N BMWW-t	MT20	4.0	5.0	1.50 1.50
O BMV1+p	MT20	3.0	4.0	2.00 0.50

DIMENSIONS, SUPPORTS AND LOADINGS SPECIFIED BY FABRICATOR TO BE VERIFIED BY BUILDING DESIGNER

BEARINGS					
	FACTORED GROSS REACTION	MAXIMUM FACTORED GROSS REACTION	INPUT BRG	REQRD BRG	
JT	VERT	HORZ	DOWN	HORZ	UPLIFT IN-SX
O	2544	0	2544	0	0 5-8 4-12
I	2544	0	2544	0	0 5-8 4-12

UNFACTORED REACTIONS							
1ST LCASE MAX/MIN COMPONENT REACTIONS							
JT	COMBINED	SNOW	LIVE	PERM.LIVE	WIND	DEAD	SOIL
O	1875	1105 / 0	305 / 0	0 / 0	0 / 0	466 / 0	0 / 0
I	1875	1105 / 0	305 / 0	0 / 0	0 / 0	466 / 0	0 / 0

BEARING MATERIAL TO BE SPF NO.2 OR BETTER AT JOINT(S) O, I

BRACING
TOP CHORD TO BE SHEATHED OR MAX. PURLIN SPACING = 3.41 FT.
MAX. UNBRACED BOTTOM CHORD LENGTH = 10.00 FT OR RIGID CEILING DIRECTLY APPLIED.
ALL PITCH BREAKS AND PERIMETER CORNER JOINTS MUST BE LATERALLY RESTRAINED.

LOADING					
TOTAL LOAD CASES: (4)					
CHORDS			WEBS		
MEMB.	MAX. FACTORED FORCE (LBS)	FACTORED VERT. LOAD (PLF)	LC1 MAX (LC)	UNBRACED LENGTH	MEMB. MAX. FACTORED FORCE (LBS)
FR-TO		FROM	TO		FR-TO
A-B	0 / 47	-124.4	-124.4	0.17 (1)	10.00
B-C	-2776 / 0	-124.4	-124.4	0.72 (1)	3.41
C-D	-2301 / 0	-124.4	-124.4	0.85 (1)	3.78
D-E	-1880 / 0	-124.4	-124.4	0.57 (1)	4.20
E-F	-2302 / 0	-124.4	-124.4	0.85 (1)	3.78
F-G	-2776 / 0	-124.4	-124.4	0.72 (1)	3.41
G-H	0 / 47	-124.4	-124.4	0.17 (1)	10.00
O-B	-2448 / 0	0.0	0.0	0.25 (1)	5.47
I-G	-2448 / 0	0.0	0.0	0.25 (1)	5.47
O-N	0 / 0	-39.2	-39.2	0.26 (3)	10.00
N-M	0 / 2349	-39.2	-39.2	0.54 (2)	10.00
M-L	0 / 1879	-39.2	-39.2	0.44 (1)	10.00
L-K	0 / 1879	-39.2	-39.2	0.44 (1)	10.00
K-J	0 / 2349	-39.2	-39.2	0.54 (2)	10.00
J-I	0 / 0	-39.2	-39.2	0.26 (3)	10.00

DESIGN CRITERIA	
SPECIFIED LOADS:	
TOP CH.	LL = 34.8 PSF
	DL = 8.0 PSF
BOT CH.	LL = 10.5 PSF
	DL = 7.3 PSF
TOTAL LOAD = 60.6 PSF	

SPACING = 24.0 IN. C/C

LOADING IN FLAT SECTION BASED ON A SLOPE OF 2.00/12 MINIMUM

THIS TRUSS IS DESIGNED FOR RESIDENTIAL OR SMALL BUILDING REQUIREMENTS OF PART 9, NBCC 2015

THIS DESIGN COMPLIES WITH:
- PART 9 OF BCBC 2018, ABC 2019
- PART 9 OF OBC 2012 (2019 AMENDMENT)
- CSA 088-14
- TPIC 2014

(55% OF 48.1 P.S.F. G.S.L. PLUS 8.4 P.S.F. RAIN LOAD) EQUALS 34.8 P.S.F. SPECIFIED ROOF LIVE LOAD

ALLOWABLE DEFL.(LL)= L/360 (0.97")
CALCULATED VERT. DEFL.(LL) = L/999 (0.10")
ALLOWABLE DEFL.(TL)= L/360 (0.97")
CALCULATED VERT. DEFL.(TL) = L/999 (0.17")

CSI: TC=0.72/1.00 (B-C-1) , BC=0.54/1.00 (M-N-2) , WB=0.76/1.00 (C-M-1) , SSI=0.29/1.00 (F-G-1)

DOL LUMBER=1.00 NAIL=1.00 LS BEND=1.10 COMP=1.10 SHEAR=1.10 TENS=1.10

COMPANION LIVE LOAD FACTOR = 1.00

TRUSS PLATE MANUFACTURER IS NOT RESPONSIBLE FOR QUALITY CONTROL IN THE TRUSS MANUFACTURING PLANT .

NAIL VALUES			
PLATE GRIP(DRY) SHEAR	SECTION (PSI)	(PLI)	(PLI)
MAX MIN	MAX MIN	MAX MIN	MAX MIN
MT20	650	371	1747 788 1987 1873

PLATE PLACEMENT TOL. = 0.250 inches

PLATE ROTATION TOL. = 5.0 Deg.

JSI GRIP= 0.89 (K) (INPUT = 0.80)
JSI METAL = 0.67 (N) (INPUT = 1.00)




These plans have been reviewed for use with the corrections as noted. No other changes may be made without written approval of the Building Standards Branch. All work must comply with Zoning By-Law 2015-043, as amended, and the Ontario Building Code, as amended. These approved documents must be kept on site at all times. The building permit must be clearly posted on site at all times.

Discipline	Reviewer	BCIN	Date
Building Code	H. Authier	43236	2021-02-04
Sewage System			
Zoning			



READ ALL NOTES ON THIS PAGE AND ON ENGINEERING NOTE PAGE ENP-1. THIS NOTE PAGE IS AN INTEGRAL PART OF THIS DRAWING AS IT CONTAINS SPECIFICATIONS AND CRITERIA USED IN THE DESIGN OF THIS COMPONENT.

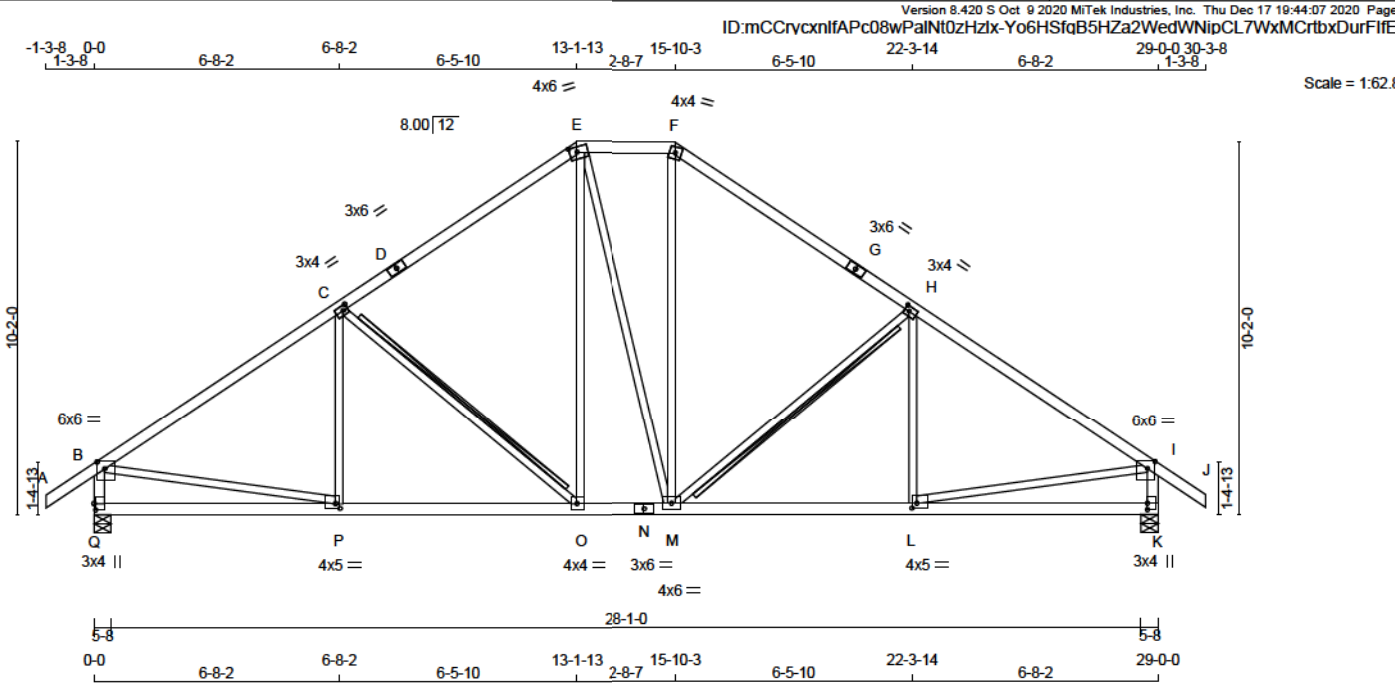

TOTAL WEIGHT = 2 X 134 = 269 lb

LUMBER				
N. L. G. A. RULES	CHORDS	SIZE	LUMBER	DESCR.
A - D	2x4	DRY	No.2	SPF
D - E	2x4	DRY	No.2	SPF
E - F	2x4	DRY	No.2	SPF
F - G	2x4	DRY	No.2	SPF
G - J	2x4	DRY	No.2	SPF
Q - B	2x4	DRY	No.2	SPF
K - I	2x4	DRY	No.2	SPF
Q - N	2x4	DRY	No.2	SPF
N - K	2x4	DRY	No.2	SPF
ALL WEBS	2x3	DRY	No.2	SPF
EXCEPT				

DRY: SEASONED LUMBER.

PLATES (table is in inches)					
JT	TYPE	PLATES	W	LEN	X
B	TMVW-p	MT20	6.0	6.0	2.25 2.50
C	TMVW-t	MT20	3.0	4.0	1.50 1.50
D	TS-t	MT20	3.0	6.0	
E	TTWW-m	MT20	4.0	6.0	1.75 2.50
F	TTWW-m	MT20	4.0	4.0	
G	TS-t	MT20	3.0	6.0	
H	TMVW-t	MT20	3.0	4.0	1.50 1.50
I	TMVW-p	MT20	6.0	6.0	2.25 2.50
K	BMV1+p	MT20	3.0	4.0	2.00
L	BMVW-t	MT20	4.0	5.0	1.50 1.50
M	BMVW-t	MT20	4.0	6.0	
N	BS-t	MT20	3.0	6.0	
O	BMVW-t	MT20	4.0	4.0	
P	BMVW-t	MT20	4.0	5.0	1.50 1.50
Q	BMV1+p	MT20	3.0	4.0	2.00 0.50

DIMENSIONS, SUPPORTS AND LOADINGS SPECIFIED BY FABRICATOR TO BE VERIFIED BY BUILDING DESIGNER

BEARINGS					
JT	VERT	HORZ	DOWN	HORZ	UPLIFT
Q	2544	0	2544	0	0
K	2544	0	2544	0	0

UNFACTORED REACTIONS							
1ST LCASE MAX/MIN COMPONENT REACTIONS							
JT	COMBINED	SNOW	LIVE	PERM.LIVE	WIND	DEAD	SOIL
Q	1875	1105 / 0	305 / 0	0 / 0	0 / 0	486 / 0	0 / 0
K	1875	1105 / 0	305 / 0	0 / 0	0 / 0	486 / 0	0 / 0

BEARING MATERIAL TO BE SPF NO.2 OR BETTER AT JOINT(S) Q, K

BRACING
TOP CHORD TO BE SHEATHED OR MAX. PURLIN SPACING = 2.98 FT.
MAX. UNBRACED BOTTOM CHORD LENGTH = 10.00 FT OR RIGID CEILING DIRECTLY APPLIED.

ALL PITCH BREAKS AND PERIMETER CORNER JOINTS MUST BE LATERALLY RESTRAINED.

2x4 DRY SPF No.2 T-BRACE AT C-O, H-M

FASTEN T AND I-BRACES TO NARROW EDGE OF WEB WITH ONE ROW PER PLY OF 3" COMMON WIRE NAILS @ 6" O.C. WITH 3" MINIMUM END DISTANCE. BRACE MUST COVER 90% OF WEB LENGTH.

END VERTICAL(S) MUST BE SHEATHED OR HAVE BRACES AS INDICATED IN THE MAX. UNBRACED LENGTH COLUMN OF THE TABLE BELOW

LOADING
TOTAL LOAD CASES: (4)

CHORDS				WEBS			
MEMB.	MAX. FACTORED FORCE (LBS)	FACTORED VERT. LOAD (PLF)	MAX. FACTORED UNBRACED LENGTH (LC)	MEMB.	MAX. FACTORED FORCE (LBS)	FACTORED VERT. LOAD (PLF)	MAX. FACTORED UNBRACED LENGTH (LC)
FR-TO				FR-TO			
A-B	0 / 47	-124.4 -124.4	0.17 (1)	10.00	P-C	-79 / 225	0.08 (3)
B-C	-2776 / 0	-124.4 -124.4	0.95 (1)	2.98	C-O	-816 / 0	0.46 (1)
C-D	-2138 / 0	-124.4 -124.4	0.83 (1)	3.53	O-E	0 / 679	0.15 (1)
D-E	-2138 / 0	-124.4 -124.4	0.83 (1)	3.53	E-M	0 / 9	0.00 (1)
E-F	-1740 / 0	-124.4 -124.4	0.15 (1)	4.93	M-F	0 / 690	0.16 (1)
F-G	-2141 / 0	-124.4 -124.4	0.83 (1)	3.53	M-H	-812 / 0	0.46 (1)
G-H	-2141 / 0	-124.4 -124.4	0.83 (1)	3.53	H-I	-84 / 222	0.05 (3)
H-I	-2775 / 0	-124.4 -124.4	0.95 (1)	2.98	B-P	0 / 2386	0.54 (1)
I-J	0 / 47	-124.4 -124.4	0.17 (1)	10.00	L-I	0 / 2385	0.54 (1)
Q-B	-2438 / 0	0.0	0.0	0.25 (1)			
K-I	-2438 / 0	0.0	0.0	0.25 (1)			
Q-P	0 / 0	-39.2 -39.2	0.36 (3)	10.00			
P-O	0 / 2355	-39.2 -39.2	0.83 (2)	10.00			
O-N	0 / 1738	-39.2 -39.2	0.41 (1)	10.00			
N-M	0 / 1738	-39.2 -39.2	0.41 (1)	10.00			
M-L	0 / 2354	-39.2 -39.2	0.83 (2)	10.00			
L-K	0 / 0	-39.2 -39.2	0.35 (3)	10.00			

DESIGN CRITERIA

SPECIFIED LOADS:
TOP CH. LL = 34.8 PSF
DL = 8.0 PSF
BOT CH. LL = 10.5 PSF
DL = 7.3 PSF
TOTAL LOAD = 60.6 PSF

SPACING = 24.0 IN. C/C

LOADING IN FLAT SECTION BASED ON A SLOPE OF 2.00/12 MINIMUM

THIS TRUSS IS DESIGNED FOR RESIDENTIAL OR SMALL BUILDING REQUIREMENTS OF PART 9, NBCC 2015

THIS DESIGN COMPLIES WITH:
- PART 9 OF BCBC 2018, ABC 2019
- PART 9 OF OBC 2012 (2019 AMENDMENT)
- CSA 088-14
- TPIC 2014

(55 % OF 48.1 P.S.F. G.S.L. PLUS 8.4 P.S.F. RAIN LOAD) EQUALS 34.8 P.S.F. SPECIFIED ROOF LIVE LOAD

ALLOWABLE DEFL.(LL) = L/360 (0.97")
CALCULATED VERT. DEFL.(LL) = L/999 (0.12")
ALLOWABLE DEFL.(TL) = L/360 (0.97")
CALCULATED VERT. DEFL.(TL) = L/999 (0.21")

CSI: TC=0.95/1.00 (B-C-1) , BC=0.63/1.00 (O-P-2) , WB=0.54/1.00 (B-P-1) , SSI=0.33/1.00 (B-C-1)

DOL LUMBER=1.00 NAIL=1.00 LS BEND=1.10 COMP=1.10 SHEAR=1.10 TENS=1.10

COMPANION LIVE LOAD FACTOR = 1.00

TRUSS PLATE MANUFACTURER IS NOT RESPONSIBLE FOR QUALITY CONTROL IN THE TRUSS MANUFACTURING PLANT .

NAIL VALUES
PLATE GRIP(DRY) SHEAR SECTION (PSI) (PLI) (PLI)
MAX MIN MAX MIN MAX MIN
MT20 650 371 1747 788 1987 1873

PLATE PLACEMENT TOL. = 0.250 inches

PLATE ROTATION TOL. = 5.0 Deg.

JSI GRIP= 0.88 (Q) (INPUT = 0.90)
JSI METAL = 0.67 (P) (INPUT = 1.00)




These plans have been reviewed for use with the corrections as noted. No other changes may be made without written approval of the Building Standards Branch. All work must comply with Zoning By-Law 2015-043, as amended, and the Ontario Building Code, as amended. These approved documents must be kept on site at all times. The building permit must be clearly posted on site at all times.

Discipline	Reviewer	BCIN	Date
Building Code	H. Authier	43236	2021-02-04
Sewage System			
Zoning			



READ ALL NOTES ON THIS PAGE AND ON ENGINEERING NOTE PAGE ENP-1. THIS NOTE PAGE IS AN INTEGRAL PART OF THIS DRAWING AS IT CONTAINS SPECIFICATIONS AND CRITERIA USED IN THE DESIGN OF THIS COMPONENT.

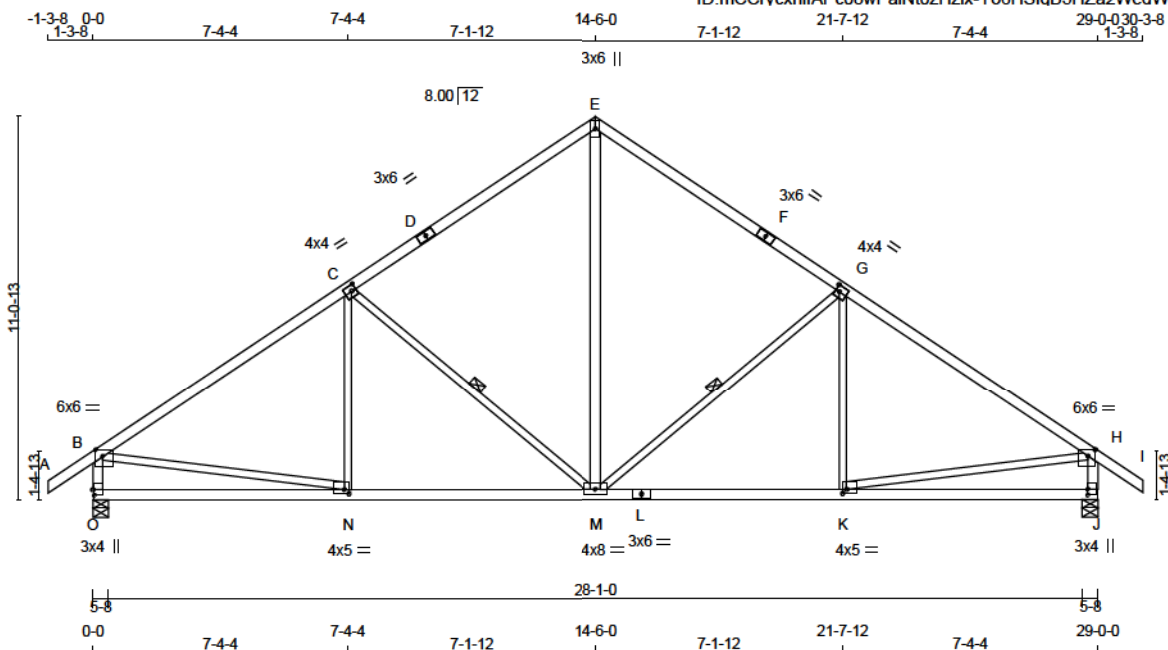

TOTAL WEIGHT = 6 X 126 = 757 LB

LUMBER					DESCR.
N. L. G. A. RULES	SIZE	LUMBER			
CHORDS					
A - D	2x4	DRY	2100F 1.8E		SPF
D - E	2x4	DRY	2100F 1.8E		SPF
E - F	2x4	DRY	2100F 1.8E		SPF
F - I	2x4	DRY	2100F 1.8E		SPF
O - B	2x4	DRY	No.2		SPF
J - H	2x4	DRY	No.2		SPF
O - L	2x4	DRY	No.2		SPF
L - J	2x4	DRY	No.2		SPF
ALL WEBS					SPF
EXCEPT					
M - E	2x4	DRY	No.2		SPF

DRY: SEASONED LUMBER.

PLATES (table is in inches)

JT TYPE	PLATES	W	LEN	Y	X
B TMVW-p	MT20	6.0	6.0	2.25	2.50
C TMWW-t	MT20	4.0	4.0	2.00	1.50
D TS-t	MT20	3.0	6.0		
E TTW+p	MT20	3.0	6.0		
F TS-t	MT20	3.0	6.0		
G TMWW-t	MT20	4.0	4.0	2.00	1.50
H TMVW-p	MT20	6.0	6.0	2.25	2.50
J BMV1+p	MT20	3.0	4.0	2.00	
K BMWW-t	MT20	4.0	5.0	1.50	1.50
L BS-t	MT20	3.0	6.0		
M BMWW-t	MT20	4.0	8.0		
N BMWW-t	MT20	4.0	5.0	1.50	1.50
O BMV1+p	MT20	3.0	4.0	2.00	0.50

DIMENSIONS, SUPPORTS AND LOADINGS SPECIFIED BY FABRICATOR TO BE VERIFIED BY BUILDING DESIGNER

BEARINGS

	FACTORED GROSS REACTION	MAXIMUM FACTORED GROSS REACTION	INPUT BRG	REQRD BRG
JT VERT	DOWN	DOWN	UPLIFT	IN-SX
O	2544	0	0	5-8
J	2544	0	0	4-12

UNFACTORED REACTIONS

1ST LCASE	MAX	MIN	COMPONENT REACTIONS						
JT COMBINED	SNOW	LIVE	PERM.LIVE	WIND	DEAD	SOIL			
O	1875	1105 / 0	305 / 0	0 / 0	0 / 0	486 / 0	0 / 0		
J	1875	1105 / 0	305 / 0	0 / 0	0 / 0	486 / 0	0 / 0		

BEARING MATERIAL TO BE SPF NO.2 OR BETTER AT JOINT(S) O, J

BRACING

TOP CHORD TO BE SHEATHED OR MAX. PURLIN SPACING = 4.25 FT.
MAX. UNBRACED BOTTOM CHORD LENGTH = 10.00 FT OR RIGID CEILING DIRECTLY APPLIED.

ALL PITCH BREAKS AND PERIMETER CORNER JOINTS MUST BE LATERALLY RESTRAINED.

1 - 1x4 LATERAL BRACE(S) AT 1/2 LENGTH OF G-M, C-M. DBS = 20-0-0. CBF = 119 LBS.

DBS = DIAGONAL BRACE SPACING (MAX). CBF = CUMULATIVE BRACING FORCE (PER BRACE). FASTEN LATERAL BRACE(S) USING (0.122"x3") SPIRAL NAILS : 1 NAIL FOR 2x3 BRACE(S), 2 FOR 1x4, 2x4, 2x5, 3 FOR 2x6, 4 FOR 2x8, 5 FOR 2x10, AND 6 FOR 2x12.

END VERTICAL(S) MUST BE SHEATHED OR HAVE BRACES AS INDICATED IN THE MAX. UNBRACED LENGTH COLUMN OF THE TABLE BELOW

LOADING

TOTAL LOAD CASES: (4)

CHORDS				WEBS			
MEMB.	MAX. FACTORED FORCE (LBS)	FACTORED VERT. LOAD (PLF)	FACTORED LC1 MAX (LC)	MEMB.	MAX. FACTORED FORCE (LBS)	FACTORED VERT. LOAD (PLF)	FACTORED LC1 MAX (LC)
FR-TO		FROM TO	LENGTH	FR-TO		FROM TO	LENGTH
A-B	0 / 47	-124.4 -124.4	0.11 (1)	10.00	M-E	0 / 1486	0.24 (1)
B-C	-2757 / 0	-124.4 -124.4	0.89 (1)	4.25	M-G	-951 / 0	0.58 (1)
C-D	-2002 / 0	-124.4 -124.4	0.82 (1)	4.88	K-G	-24 / 265	0.07 (3)
D-E	-2002 / 0	-124.4 -124.4	0.82 (1)	4.88	C-M	-951 / 0	0.58 (1)
E-F	-2002 / 0	-124.4 -124.4	0.82 (1)	4.88	N-C	-24 / 265	0.07 (3)
F-G	-2002 / 0	-124.4 -124.4	0.82 (1)	4.88	B-N	0 / 2369	0.53 (1)
G-H	-2757 / 0	-124.4 -124.4	0.89 (1)	4.25	K-H	0 / 2369	0.53 (1)
H-I	0 / 47	-124.4 -124.4	0.11 (1)	10.00			
O-B	-2427 / 0	0.0	0.0	0.25 (1)	5.49		
J-H	-2427 / 0	0.0	0.0	0.25 (1)	5.49		
O-N	0 / 0	-39.2	-39.2	0.41 (3)	10.00		
N-M	0 / 2344	-39.2	-39.2	0.88 (2)	10.00		
M-L	0 / 2344	-39.2	-39.2	0.88 (2)	10.00		
L-K	0 / 2344	-39.2	-39.2	0.88 (2)	10.00		
K-J	0 / 0	-39.2	-39.2	0.41 (3)	10.00		

DESIGN CRITERIA

SPECIFIED LOADS:

TOP CH. LL	= 34.8 PSF
DL	= 8.0 PSF
BOT CH. LL	= 10.5 PSF
DL	= 7.3 PSF
TOTAL LOAD	= 60.6 PSF

SPACING = 24.0 IN. C/C

THIS TRUSS IS DESIGNED FOR RESIDENTIAL OR SMALL BUILDING REQUIREMENTS OF PART 9, NBCC 2015

THIS DESIGN COMPLIES WITH:

- PART 9 OF BCBC 2018, ABC 2019
- PART 9 OF OBC 2012 (2019 AMENDMENT)
- CSA 086-14
- TPIC 2014

(55 % OF 48.1 P.S.F. G.S.L. PLUS 8.4 P.S.F. RAIN LOAD)
EQUALS 34.8 P.S.F. SPECIFIED ROOF LIVE LOAD

ALLOWABLE DEFL.(LL) = $L/360$ (0.97")
CALCULATED VERT. DEFL.(LL) = $L/999$ (0.13")
ALLOWABLE DEFL.(TL) = $L/360$ (0.97")
CALCULATED VERT. DEFL.(TL) = $L/999$ (0.22")

CSI: TC=0.69/1.00 (B-C-1), BC=0.68/1.00 (K-M-2),
WB=0.58/1.00 (G-M-1), SSI=0.37/1.00 (B-C-1)

DOL LUMBER=1.00 NAIL=1.00 LS BEND=1.10 COMP=1.10
SHEAR=1.10 TENS=1.10

COMPANION LIVE LOAD FACTOR = 1.00

TRUSS PLATE MANUFACTURER IS NOT RESPONSIBLE FOR QUALITY CONTROL IN THE TRUSS MANUFACTURING PLANT.

NAIL VALUES

PLATE (PSI)	DRY (PLI)	SHEAR (PLI)	SECTION (PLI)
MAX MIN	MAX MIN	MAX MIN	MAX MIN
MT20	850	371	1747
	788	1987	1873

PLATE PLACEMENT TOL. = 0.250 inches

PLATE ROTATION TOL. = 5.0 Deg.

JSI GRIP= 0.88 (O) (INPUT = 0.90)
JSI METAL = 0.87 (K) (INPUT = 1.00)




These plans have been reviewed for use with the corrections as noted. No other changes may be made without written approval of the Building Standards Branch. All work must comply with Zoning By-Law 2015-043, as amended, and the Ontario Building Code, as amended. These approved documents must be kept on site at all times. The building permit must be clearly posted on site at all times.

Discipline	Reviewer	BCIN	Date
Building Code	H. Authier	43236	2021-02-04
Sewage System			
Zoning			



READ ALL NOTES ON THIS PAGE AND ON ENGINEERING NOTE PAGE ENP-1. THIS NOTE PAGE IS AN INTEGRAL PART OF THIS DRAWING AS IT CONTAINS SPECIFICATIONS AND CRITERIA USED IN THE DESIGN OF THIS COMPONENT.

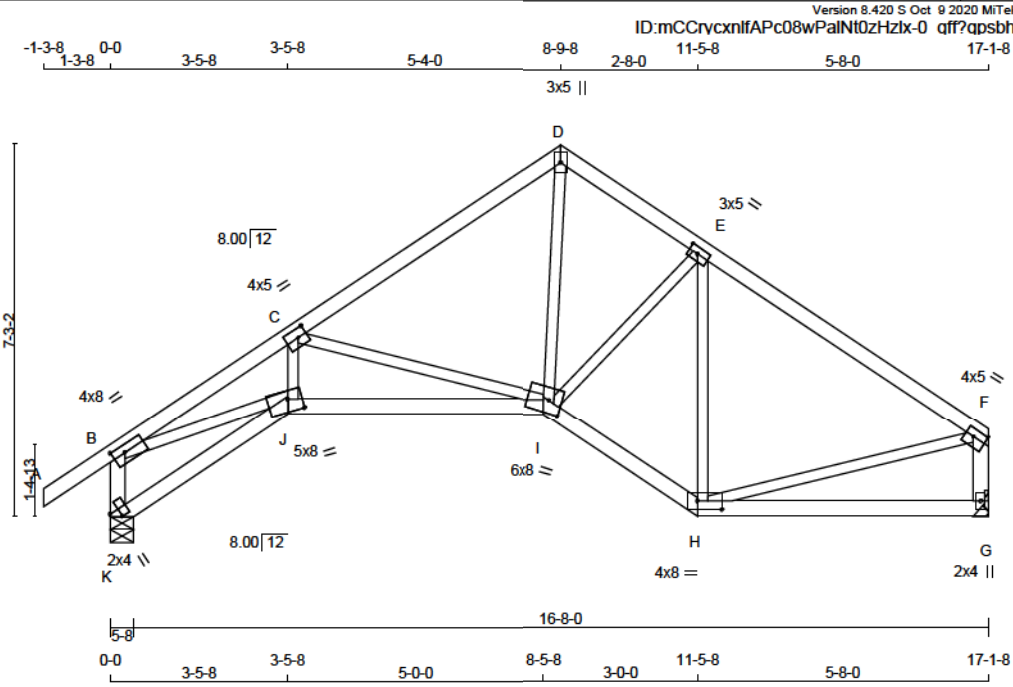

LUMBER				N. L. G. A. RULES	
CHORDS	SIZE	LUMBER	DESCR.		
K - B	2x4	DRY	No.2	SPF	
A - D	2x4	DRY	No.2	SPF	
D - F	2x4	DRY	No.2	SPF	
G - F	2x4	DRY	No.2	SPF	
K - J	2x4	DRY	No.2	SPF	
J - I	2x4	DRY	No.2	SPF	
I - H	2x4	DRY	No.2	SPF	
H - G	2x4	DRY	No.2	SPF	
ALL WEBS	2x3	DRY	No.2	SPF	

EXCEPT
 DRY: SEASONED LUMBER.

PLATES (table is in inches)						
JT	TYPE	PLATES	W	LEN	Y	X
B	TMVW-t	MT20	4.0	8.0	1.75	3.00
C	TMVW-t	MT20	4.0	5.0	2.00	2.00
D	TTW+p	MT20	3.0	5.0		
E	TMVW-t	MT20	3.0	5.0	1.50	2.25
F	TMVW-t	MT20	4.0	5.0	1.75	Edge
G	BMV1+p	MT20	2.0	4.0		
H	BBWW-p	MT20	4.0	8.0	2.00	5.75
I	BBWWW-m	MT20	6.0	8.0	3.00	3.00
J	BBWW-m	MT20	5.0	8.0	3.00	3.25
K	BMV1+H	MT20	2.0	4.0	2.00	2.00

Edge - INDICATES REFERENCE CORNER OF PLATE TOUCHES
 EDGE OF CHORD.

DIMENSIONS, SUPPORTS AND LOADINGS SPECIFIED BY FABRICATOR TO BE VERIFIED BY BUILDING DESIGNER

BEARINGS					
FACTORED GROSS REACTION		MAXIMUM FACTORED GROSS REACTION		INPUT REQRD BRG	
JT	VERT	HORZ	DOWN	HORZ	UPLIFT IN-SX
K	1572	0	1572	0	5-8
G	1401	0	1401	0	MECHANICAL

A SUITABLE HANGER/MECHANICAL CONNECTION IS REQUIRED AT JOINT G. MINIMUM BEARING LENGTH AT JOINT G = 1-8.

UNFACTORED REACTIONS						
1ST LCASE MAX/MIN COMPONENT REACTIONS						
JT	COMBINED	SNOW	LIVE	PERM.LIVE	WIND	DEAD
K	1155	692 / 0	180 / 0	0 / 0	0 / 0	284 / 0
G	1038	596 / 0	180 / 0	0 / 0	0 / 0	262 / 0

BEARING MATERIAL TO BE SPF NO.2 OR BETTER AT JOINT(S) K

BRACING
 TOP CHORD TO BE SHEATHED OR MAX. PURLIN SPACING = 3.40 FT.
 MAX. UNBRACED BOTTOM CHORD LENGTH = 10.00 FT OR RIGID CEILING DIRECTLY APPLIED.

ALL PITCH BREAKS AND PERIMETER CORNER JOINTS MUST BE Laterally RESTRAINED.

LOADING
 TOTAL LOAD CASES: (4)

CHORDS				WEBS			
MEMB.	MAX. FACTORED FORCE (LBS)	FACTORED VERT. LOAD (PLF)	FACTORED HORZ. LOAD (LC1 MAX)	MEMB.	MAX. FACTORED FORCE (LBS)	FACTORED VERT. LOAD (LC1 MAX)	FACTORED HORZ. LOAD (LC1 MAX)
FR-TO				FR-TO			
K-B	-1504 / 0	0.0	0.0 0.16 (1)	B-J	0 / 3085	0.89 (1)	0.22 (1)
A-B	0 / 47	-124.4	-124.4 0.17 (1)	J-C	0 / 974	0.22 (1)	0.79 (1)
B-C	-3542 / 0	-124.4	-124.4 0.41 (1)	C-I	-1721 / 0	0.28 (1)	0.28 (1)
C-D	-1537 / 0	-124.4	-124.4 0.47 (1)	I-D	0 / 1293	0.03 (1)	0.38 (1)
D-E	-1474 / 0	-124.4	-124.4 0.38 (1)	E-H	0 / 112	0.03 (1)	0.38 (1)
E-F	-1296 / 0	-124.4	-124.4 0.48 (1)	H-F	-824 / 0	0.28 (1)	0.28 (1)
G-F	-1290 / 0	0.0	0.0 0.14 (1)				
K-J	0 / 0	-39.3	-39.3 0.11 (3)				
J-I	0 / 2908	-39.2	-39.2 0.63 (1)				
I-H	0 / 1310	-39.2	-39.2 0.27 (1)				
H-G	0 / 0	-39.3	-39.3 0.30 (3)				

DESIGN CRITERIA

SPECIFIED LOADS:
 TOP CH. LL = 34.8 PSF
 DL = 8.0 PSF
 BOT CH. LL = 10.5 PSF
 DL = 7.3 PSF
 TOTAL LOAD = 60.6 PSF

SPACING = 24.0 IN. C/C

THIS TRUSS IS DESIGNED FOR RESIDENTIAL OR SMALL BUILDING REQUIREMENTS OF PART 9, NBCC 2015

THIS DESIGN COMPLIES WITH:
 - PART 9 OF BCBC 2018, ABC 2019
 - PART 9 OF OBC 2012 (2019 AMENDMENT)
 - CSA 088-14
 - TPIC 2014

(55 % OF 48.1 P.S.F. G.S.L. PLUS 8.4 P.S.F. RAIN LOAD)
 EQUALS 34.8 P.S.F. SPECIFIED ROOF LIVE LOAD

ALLOWABLE DEFL. (LL) = L/360 (0.57")
 CALCULATED VERT. DEFL. (LL) = L/969 (0.12")
 ALLOWABLE DEFL. (TL) = L/360 (0.57")
 CALCULATED VERT. DEFL. (TL) = L/834 (0.22")

CSI: TC=0.48/1.00 (E-F:1), BC=0.63/1.00 (I-J:1),
 WB=0.79/1.00 (C-I:1), SSI=0.28/1.00 (E-F:1)

DOL LUMBER=1.00 NAIL=1.00 LS BEND=1.10 COMP=1.10
 SHEAR=1.10 TENS=1.10

COMPANION LIVE LOAD FACTOR = 1.00

TRUSS PLATE MANUFACTURER IS NOT RESPONSIBLE FOR QUALITY CONTROL IN THE TRUSS MANUFACTURING PLANT.

NAIL VALUES
 PLATE GRIP(DRY) SHEAR SECTION
 (PSI) (PLI) (PLI)
 MAX MIN MAX MIN MAX MIN
 MT20 850 371 1747 788 1987 1873

PLATE PLACEMENT TOL. = 0.250 inches

PLATE ROTATION TOL. = 5.0 Deg.

JSI GRIP= 0.90 (E) (INPUT = 0.90)
 JSI METAL = 0.73 (K) (INPUT = 1.00)




READ ALL NOTES ON THIS PAGE AND ON ENGINEERING NOTE PAGE ENP-1. THIS NOTE PAGE IS AN INTEGRAL PART OF THIS DRAWING AS IT CONTAINS SPECIFICATIONS AND CRITERIA USED IN THE DESIGN OF THIS COMPONENT.



These plans have been reviewed for use with the corrections as noted. No other changes may be made without written approval of the Building Standards Branch. All work must comply with Zoning By-Law 2015-043, as amended, and the Ontario Building Code, as amended. These approved documents must be kept on site at all times. The building permit must be clearly posted on site at all times.

Discipline	Reviewer	BCIN	Date
Building Code	H. Authier	43236	2021-02-04
Sewage System			
Zoning			



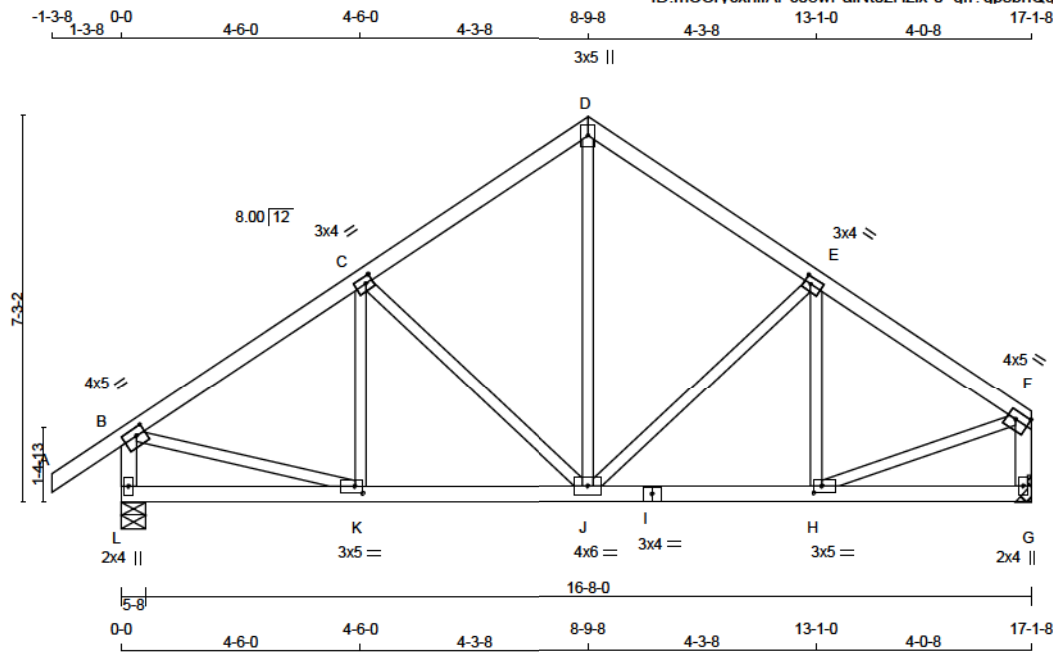

TOTAL WEIGHT = 2 X 75 = 150 LB
[M/F]

LUMBER					DESCR.
N. L. G. A. RULES	CHORDS	SIZE	LUMBER		
A - D	2x4	DRY	No.2	SPF	
D - F	2x4	DRY	No.2	SPF	
L - B	2x4	DRY	No.2	SPF	
G - F	2x4	DRY	No.2	SPF	
L - I	2x4	DRY	No.2	SPF	
I - G	2x4	DRY	No.2	SPF	
ALL WEBS 2x3 DRY No.2					SPF
EXCEPT					
DRY: SEASONED LUMBER.					

PLATES (table is in inches)						
JT	TYPE	PLATES	W	LEN	Y	X
B	TMVW-t	MT20	4.0	5.0	1.75	2.00
C	TMVW-t	MT20	3.0	4.0	1.50	1.50
D	TTW+p	MT20	3.0	5.0		
E	TMVW-t	MT20	3.0	4.0	1.50	1.50
F	TMVW-t	MT20	4.0	5.0	1.75	Edge
G	BMV1+p	MT20	2.0	4.0		
H	BMVW-t	MT20	3.0	5.0	1.50	1.75
I	BS-t	MT20	3.0	4.0		
J	BMVW-t	MT20	4.0	6.0		
K	BMVW-t	MT20	3.0	5.0	1.50	1.75
L	BMV1+p	MT20	2.0	4.0		

Edge - INDICATES REFERENCE CORNER OF PLATE TOUCHES EDGE OF CHORD.

DIMENSIONS, SUPPORTS AND LOADINGS SPECIFIED BY FABRICATOR TO BE VERIFIED BY BUILDING DESIGNER

BEARINGS							
		FACTORED GROSS REACTION		MAXIMUM FACTORED GROSS REACTION		INPUT REQRD BRG	
JT	VERT	HORZ	DOWN	HORZ	UPLIFT	IN-SX	IN-SX
L	1572	0	1572	0	0	5-8	1-11
G	1401	0	1401	0	0	MECHANICAL	

A SUITABLE HANGER/MECHANICAL CONNECTION IS REQUIRED AT JOINT G. MINIMUM BEARING LENGTH AT JOINT G = 1-8.

UNFACTORED REACTIONS							
1ST CASE		MAX/MIN COMPONENT REACTIONS					
JT	COMBINED	SNOW	LIVE	PERM.LIVE	WIND	DEAD	SOIL
L	1155	692 / 0	180 / 0	0 / 0	0 / 0	284 / 0	0 / 0
G	1038	596 / 0	180 / 0	0 / 0	0 / 0	262 / 0	0 / 0

BEARING MATERIAL TO BE SPF NO.2 OR BETTER AT JOINT(S) L

BRACING
TOP CHORD TO BE SHEATHED OR MAX. PURLIN SPACING = 5.08 FT.
MAX. UNBRACED BOTTOM CHORD LENGTH = 10.00 FT OR RIGID CEILING DIRECTLY APPLIED.

ALL PITCH BREAKS AND PERIMETER CORNER JOINTS MUST BE Laterally RESTRAINED.

LOADING
TOTAL LOAD CASES: (4)

CHORDS				WEBS			
MEMB.	MAX. FACTORED FORCE (LBS)	FACTORED VERT. LOAD (PLF)	FACTORED HORZ. LOAD (LC) (1)	MEMB.	MAX. FACTORED FORCE (LBS)	FACTORED VERT. LOAD (PLF)	FACTORED HORZ. LOAD (LC) (1)
FR-TO		FROM TO	LENGTH	FR-TO		FROM TO	LENGTH
A-B	0 / 47	-124.4 -124.4	0.17 (1)	10.00	K-C	-105 / 122	0.03 (1)
B-C	-1437 / 0	-124.4 -124.4	0.33 (1)	5.08	C-J	-488 / 0	0.28 (1)
C-D	-1084 / 0	-124.4 -124.4	0.31 (1)	5.88	J-D	0 / 754	0.17 (1)
D-E	-1080 / 0	-124.4 -124.4	0.28 (1)	5.73	J-E	-366 / 0	0.22 (1)
E-F	-1331 / 0	-124.4 -124.4	0.29 (1)	5.29	H-E	-212 / 67	0.08 (1)
L-B	-1498 / 0	0.0	0.0 0.15 (1)	6.70	B-K	0 / 1260	0.28 (1)
G-F	-1336 / 0	0.0	0.0 0.14 (1)	7.00	H-F	0 / 1202	0.27 (1)
L-K	0 / 0	-39.2	-39.2 0.14 (3)	10.00			
K-J	0 / 1225	-39.2	-39.2 0.29 (2)	10.00			
J-I	0 / 1137	-39.2	-39.2 0.26 (2)	10.00			
I-H	0 / 1137	-39.2	-39.2 0.26 (2)	10.00			
H-G	0 / 0	-39.2	-39.2 0.12 (3)	10.00			

DESIGN CRITERIA

SPECIFIED LOADS:
TOP CH. LL = 34.8 PSF
DL = 8.0 PSF
BOT CH. LL = 10.5 PSF
DL = 7.3 PSF
TOTAL LOAD = 60.6 PSF

SPACING = 24.0 IN. C/C

THIS TRUSS IS DESIGNED FOR RESIDENTIAL OR SMALL BUILDING REQUIREMENTS OF PART 9, NBCC 2015

THIS DESIGN COMPLIES WITH:
- PART 9 OF CBC 2018, ABC 2019
- PART 9 OF CBC 2012 (2019 AMENDMENT)
- CSA 086-14
- TPIC 2014

(55 % OF 48.1 P.S.F. G.S.L. PLUS 8.4 P.S.F. RAIN LOAD)
EQUALS 34.8 P.S.F. SPECIFIED ROOF LIVE LOAD

ALLOWABLE DEFL.(LL) = L/360 (0.57")
CALCULATED VERT. DEFL.(LL) = L/999 (0.03")
ALLOWABLE DEFL.(TL) = L/360 (0.57")
CALCULATED VERT. DEFL.(TL) = L/999 (0.06")

CSI: TC=0.33/1.00 (B-C:1), BC=0.29/1.00 (J-K:2), WB=0.29/1.00 (C-J:1), SSI=0.22/1.00 (B-C:1)

DOL LUMBER=1.00 NAIL=1.00 LS BEND=1.10 COMP=1.10
SHEAR=1.10 TENS=1.10

COMPANION LIVE LOAD FACTOR = 1.00

TRUSS PLATE MANUFACTURER IS NOT RESPONSIBLE FOR QUALITY CONTROL IN THE TRUSS MANUFACTURING PLANT.

NAIL VALUES
PLATE GRIP(DRY) SHEAR SECTION (PSI) (PLI) (PLI)
MAX MIN MAX MIN MAX MIN
MT20 850 371 1747 788 1987 1873

PLATE PLACEMENT TOL. = 0.250 inches

PLATE ROTATION TOL. = 5.0 Deg.

JSI GRIP= 0.89 (K) (INPUT = 0.90)
JSI METAL= 0.46 (B) (INPUT = 1.00)



READ ALL NOTES ON THIS PAGE AND ON ENGINEERING NOTE PAGE ENP-1. THIS NOTE PAGE IS AN INTEGRAL PART OF THIS DRAWING AS IT CONTAINS SPECIFICATIONS AND CRITERIA USED IN THE DESIGN OF THIS COMPONENT.




These plans have been reviewed for use with the corrections as noted. No other changes may be made without written approval of the Building Standards Branch. All work must comply with Zoning By-Law 2018-043, as amended, and the Ontario Building Code, as amended. These approved documents must be kept on site at all times. The building permit must be clearly posted on site at all times.

Discipline	Reviewer	BCIN	Date
Building Code	H. Authier	43236	2021-02-04
Sewage System			
Zoning			



Version 8.420 S Oct 9 2020 Mitek Industries, Inc. Thu Dec 17 19:44:09 2020 Page 1
ID:mCCrycxfAPc08wPaInt0zHztX-UBE1tLhRdvpHHqn?eokHHmD2sAsiLabWL9kPk7y7Z

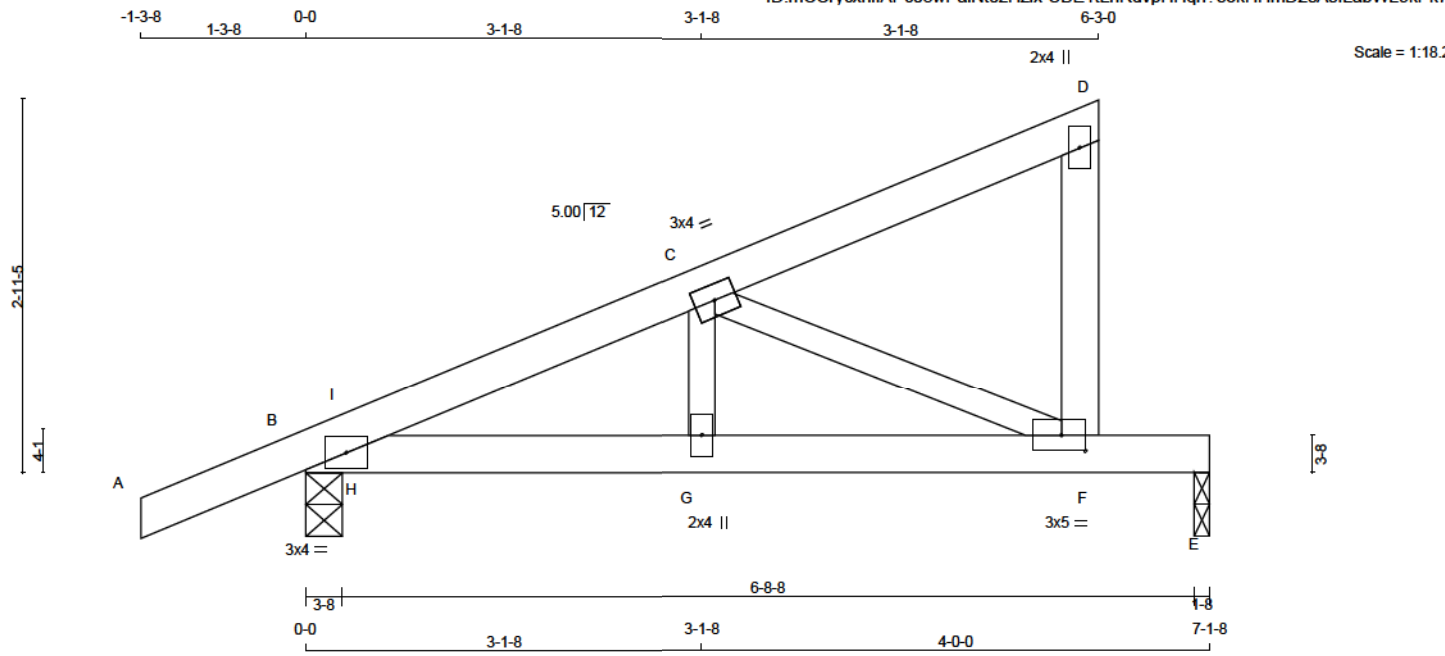

LUMBER				DESCR.	
N. L. G. A. RULES	CHORDS	SIZE	LUMBER		
A - D	2x4	DRY	No.2	SPF	
F - D	2x4	DRY	No.2	SPF	
B - E	2x4	DRY	No.2	SPF	
ALL WEBS	2x3	DRY	No.2	SPF	
DRY: SEASONED LUMBER.					

PLATES (table is in inches)					
JT	TYPE	PLATES	W	LEN	Y X
B	TM81-I	MT20	3.0	4.0	
C	TMWW-I	MT20	3.0	4.0	
D	TMV+p	MT20	2.0	4.0	
F	BMVW-I	MT20	3.0	5.0	1.50 2.25
G	BMW+w	MT20	2.0	4.0	

DIMENSIONS, SUPPORTS AND LOADINGS SPECIFIED BY FABRICATOR TO BE VERIFIED BY BUILDING DESIGNER

BEARINGS					
	FACTORED GROSS REACTION	MAXIMUM FACTORED GROSS REACTION	INPUT BRG	REQRD BRG	
JT	VERT	HORZ	DOWN	HORZ	UPLIFT IN-SX
B	744	0	744	0	0
E	481	0	481	0	0

UNFACTORED REACTIONS							
1ST CASE	MAX/MIN COMPONENT REACTIONS						
JT	COMBINED	SNOW	LIVE	PERM. LIVE	WIND	DEAD	SOIL
B	543	338 / 0	75 / 0	0 / 0	0 / 0	130 / 0	0 / 0
E	362	191 / 0	75 / 0	0 / 0	0 / 0	96 / 0	0 / 0

BEARING MATERIAL TO BE SPF NO.2 OR BETTER AT JOINT(S) B, E

BRACING
TOP CHORD TO BE SHEATHED OR MAX. PURLIN SPACING = 6.18 FT.
MAX. UNBRACED BOTTOM CHORD LENGTH = 10.00 FT OR RIGID CEILING DIRECTLY APPLIED.

ALL PITCH BREAKS AND PERIMETER CORNER JOINTS MUST BE Laterally RESTRAINED.

LOADING
TOTAL LOAD CASES: (4)

CHORDS				WEBS			
MEMB.	MAX. FACTORED FORCE (LBS)	FACTORED VERT. LOAD (PLF)	LC1 MAX (LC)	MAX. UNBRACED LENGTH	MEMB.	MAX. FACTORED FORCE (LBS)	MAX. CSI (LC)
FR-TO		FROM	TO		HFR-TO		
A-B	0 / 31	-124.4	-124.4	0.16 (1)	10.00	G-C	0 / 361
B-I	-1005 / 0	-124.4	-124.4	0.03 (1)	6.22	C-F	-997 / 0
I-C	-982 / 0	-124.4	-124.4	0.11 (1)	6.18	H-I	-134 / 7
C-D	-12 / 0	-124.4	-124.4	0.13 (1)	6.25		
F-D	-164 / 0	0.0	0.0	0.02 (1)	7.81		
B-H	0 / 917	-39.2	-39.2	0.23 (1)	10.00		
H-G	0 / 917	-39.2	-39.2	0.32 (1)	10.00		
G-F	0 / 917	-39.2	-39.2	0.70 (1)	10.00		
F-E	0 / 0	-39.2	-39.2	0.55 (1)	10.00		

DESIGN CRITERIA

SPECIFIED LOADS:
TOP CH. LL = 34.8 PSF
DL = 8.0 PSF
BOT CH. LL = 10.5 PSF
DL = 7.3 PSF
TOTAL LOAD = 60.6 PSF

SPACING = 24.0 IN. C/C

THIS TRUSS IS DESIGNED FOR RESIDENTIAL OR SMALL BUILDING REQUIREMENTS OF PART 9, NBCC 2015

THIS DESIGN COMPLIES WITH:
- PART 9 OF BCBC 2018, ABC 2019
- PART 9 OF OBC 2012 (2019 AMENDMENT)
- CSA 086-14
- TPIC 2014

(55 % OF 48.1 P.S.F. G.S.L. PLUS 8.4 P.S.F. RAIN LOAD)
EQUALS 34.8 P.S.F. SPECIFIED ROOF LIVE LOAD

ALLOWABLE DEFL.(LL)= L/360 (0.24")
CALCULATED VERT. DEFL.(LL) = L/969 (0.07")
ALLOWABLE DEFL.(TL)= L/360 (0.24")
CALCULATED VERT. DEFL.(TL) = L/725 (0.12")

CSI: TC=0.16/1.00 (A-B:1), BC=0.70/1.00 (F-G:1), WB=0.21/1.00 (C-F:1), SSI=0.38/1.00 (E-F:1)

DOL LUMBER=1.00 NAIL=1.00 LS BEND=1.10 COMP=1.10
SHEAR=1.10 TENS=1.10

COMPANION LIVE LOAD FACTOR = 1.00

TRUSS PLATE MANUFACTURER IS NOT RESPONSIBLE FOR QUALITY CONTROL IN THE TRUSS MANUFACTURING PLANT .

NAIL VALUES
PLATE GRIP(DRY) SHEAR SECTION (PSI) (PLI) (PLI)
MAX MIN MAX MIN MAX MIN
MT20 850 371 1747 788 1987 1873

PLATE PLACEMENT TOL. = 0.250 inches

PLATE ROTATION TOL. = 5.0 Deg.

JSI GRIP= 0.87 (C) (INPUT = 0.90)
JSI METAL = 0.32 (B) (INPUT = 1.00)




These plans have been reviewed for use with the corrections as noted. No other changes may be made without written approval of the Building Standards Branch. All work must comply with Zoning By-Law 2018-043, as amended, and the Ontario Building Code, as amended. These approved documents must be kept on site at all times. The building permit must be clearly posted on site at all times.

Discipline	Reviewer	BCIN	Date
Building Code	H. Authier	43236	2021-02-04
Sewage System			
Zoning			

READ ALL NOTES ON THIS PAGE AND ON ENGINEERING NOTE PAGE ENP-1. THIS NOTE PAGE IS AN INTEGRAL PART OF THIS DRAWING AS IT CONTAINS SPECIFICATIONS AND CRITERIA USED IN THE DESIGN OF THIS COMPONENT.



Version 8.420 S Oct 9 2020 Mitek Industries, Inc. Thu Dec 17 19:44:09 2020 Page 1
ID:mCCrvcxnlfAPc08wPalNi0zHzlx-UBE1tLhRdvpHqon?eokHHmD1?Au?Lc1WL9kPk7y7z

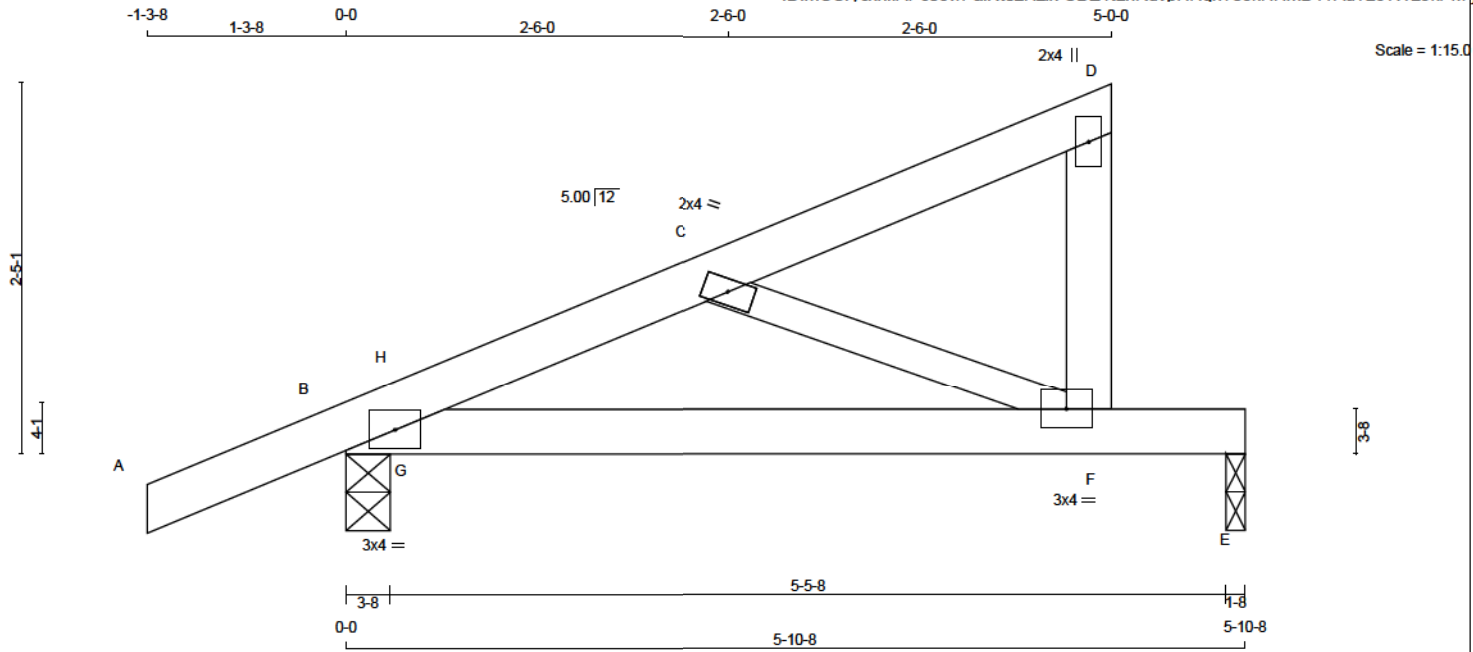

TOTAL WEIGHT = 3 X 19 = 56 LB

LUMBER					DESCR.
N. L. G. A. RULES	SIZE	LUMBER			
CHORDS					
A - D	2x4	DRY	No.2		SPF
F - D	2x4	DRY	No.2		SPF
B - E	2x4	DRY	No.2		SPF
ALL WEBS	2x3	DRY	No.2		SPF
DRY: SEASONED LUMBER.					

PLATES (table is in inches)				
JT TYPE	PLATES	W	LEN	Y X
B	TM81-I	MT20	3.0	4.0
C	TMW+w	MT20	2.0	4.0
D	TMV+p	MT20	2.0	4.0
F	BMVW-I	MT20	3.0	4.0

DIMENSIONS, SUPPORTS AND LOADINGS SPECIFIED BY FABRICATOR TO BE VERIFIED BY BUILDING DESIGNER

BEARINGS

	FACTORED GROSS REACTION	MAXIMUM FACTORED GROSS REACTION	INPUT BRG	REQRD BRG
JT	VERT	HORZ	DOWN	HORZ
B	640	0	640	0
E	380	0	380	0

UNFACTORED REACTIONS

1ST LCASE	MAX	MIN	COMPONENT REACTIONS					
JT	COMBINED	SNOW	LIVE	PERM.LIVE	WIND	DEAD	SOIL	
B	466	294 / 0	62 / 0	0 / 0	0 / 0	110 / 0	0 / 0	
E	287	148 / 0	62 / 0	0 / 0	0 / 0	77 / 0	0 / 0	

BEARING MATERIAL TO BE SPF NO.2 OR BETTER AT JOINT(S) B, E

BRACING

TOP CHORD TO BE SHEATHED OR MAX. PURLIN SPACING = 6.25 FT.

MAX. UNBRACED BOTTOM CHORD LENGTH = 10.00 FT OR RIGID CEILING DIRECTLY APPLIED.

ALL PITCH BREAKS AND PERIMETER CORNER JOINTS MUST BE Laterally RESTRAINED.

LOADING

TOTAL LOAD CASES: (4)

CHORDS				WEBS			
MEMB.	MAX. FACTORED FORCE (LBS)	FACTORED VERT. LOAD (PLF)	LC1 MAX (LC)	MEMB.	MAX. FACTORED FORCE (LBS)	MAX (LC)	
FR-TO		FROM	TO	FR-TO			
A-B	0 / 31	-124.4	-124.4	0.16 (1)	10.00	C-F	-838 / 0
B-H	-833 / 0	-124.4	-124.4	0.21 (2)	6.25	G-H	0 / 491
H-C	-577 / 0	-124.4	-124.4	0.21 (2)	6.25		
C-D	-18 / 0	-124.4	-124.4	0.13 (1)	6.25		
F-D	-112 / 0	0.0	0.0	0.01 (1)	7.81		
B-G	0 / 500	-39.2	-39.2	0.26 (1)	10.00		
G-F	0 / 500	-39.2	-39.2	0.53 (1)	10.00		
F-E	0 / 0	-39.2	-39.2	0.43 (1)	10.00		

DESIGN CRITERIA

SPECIFIED LOADS:

TOP CH.	LL = 34.8	PSF
	DL = 8.0	PSF
BOT CH.	LL = 10.5	PSF
	DL = 7.3	PSF
TOTAL LOAD	= 60.6	PSF

SPACING = 24.0 IN. C/C

THIS TRUSS IS DESIGNED FOR RESIDENTIAL OR SMALL BUILDING REQUIREMENTS OF PART 9, NBCC 2015

THIS DESIGN COMPLIES WITH:

- PART 9 OF BCBC 2018, ABC 2019
- PART 9 OF OBC 2012 (2019 AMENDMENT)
- CSA 086-14
- TPIC 2014

(55 % OF 48.1 P.S.F. G.S.L. PLUS 8.4 P.S.F. RAIN LOAD) EQUALS 34.8 P.S.F. SPECIFIED ROOF LIVE LOAD

ALLOWABLE DEFL.(LL)= L/360 (0.20")
CALCULATED VERT. DEFL.(LL) = L/ 846 (0.08")
ALLOWABLE DEFL.(TL)= L/360 (0.20")
CALCULATED VERT. DEFL.(TL) = L/ 474 (0.15")

CSI: TC=0.21/1.00 (B-H-2), BC=0.53/1.00 (F-G-1), WB=0.11/1.00 (C-F-1), SSI=0.30/1.00 (B-H-2)

DOL LUMBER=1.00 NAIL=1.00 LS BEND=1.10 COMP=1.10 SHEAR=1.10 TENS=1.10

COMPANION LIVE LOAD FACTOR = 1.00

TRUSS PLATE MANUFACTURER IS NOT RESPONSIBLE FOR QUALITY CONTROL IN THE TRUSS MANUFACTURING PLANT .

NAIL VALUES

PLATE	GRIP(DRY)	SHEAR (PSI)	SECTION (PLI)
	MAX MIN	MAX MIN	MAX MIN
MT20	850 371	1747 788	1987 1873

PLATE PLACEMENT TOL. = 0.250 inches

PLATE ROTATION TOL. = 5.0 Deg.

JSI GRIP= 0.85 (F) (INPUT = 0.80)
JSI METAL = 0.32 (C) (INPUT = 1.00)



READ ALL NOTES ON THIS PAGE AND ON ENGINEERING NOTE PAGE ENP-1. THIS NOTE PAGE IS AN INTEGRAL PART OF THIS DRAWING AS IT CONTAINS SPECIFICATIONS AND CRITERIA USED IN THE DESIGN OF THIS COMPONENT.




These plans have been reviewed for use with the corrections as noted. No other changes may be made without written approval of the Building Standards Branch. All work must comply with Zoning By-Law 2015-043, as amended, and the Ontario Building Code, as amended. These approved documents must be kept on site at all times. The building permit must be clearly posted on site at all times.

Discipline	Reviewer	BCIN	Date
Building Code	H. Authier	43236	2021-02-04
Sewage System			
Zoning			



Version 8.420 S Oct 9 2020 MITek Industries, Inc. Thu Dec 17 19:44:09 2020 Page 1
ID:mCCrvcxnlFAPc08wPalNt0zHzlx-UBE1tLhRdvpHHqn?eokHHmD0RAxnLdpWL9kPk7y7z

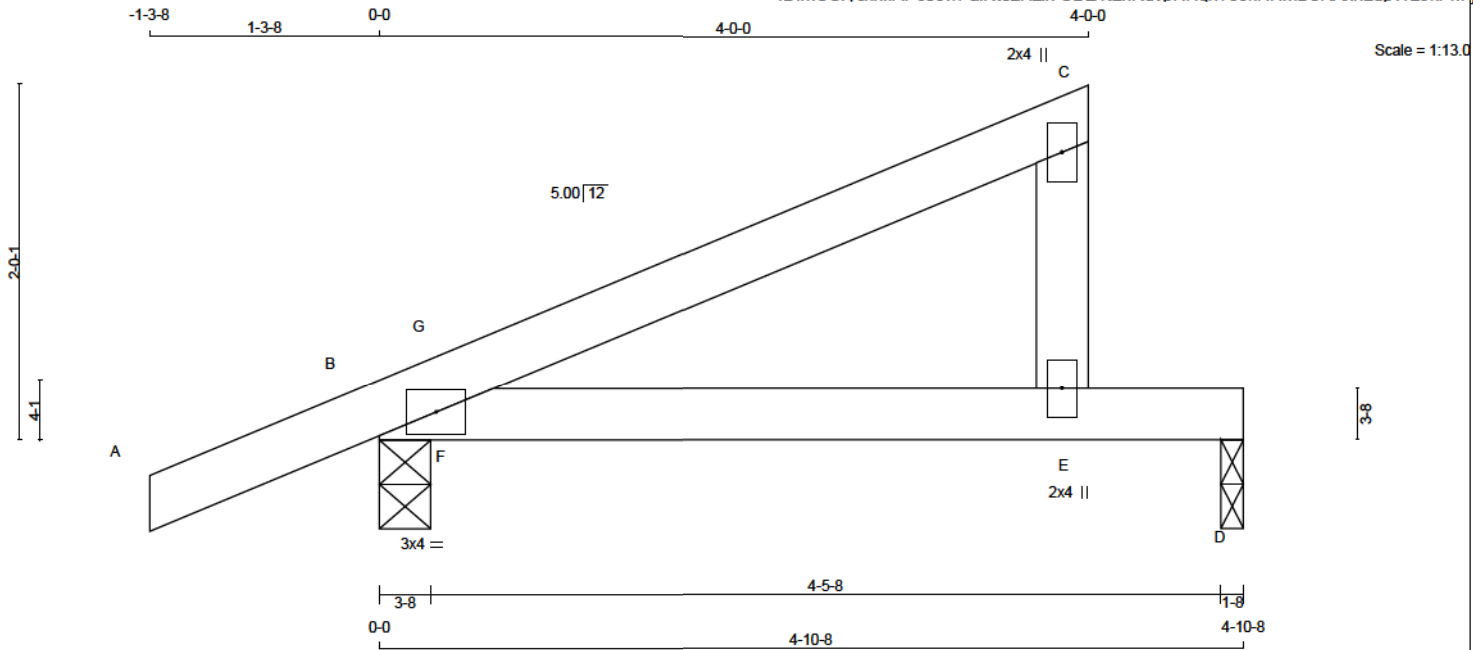

TOTAL WEIGHT = 2 X 14 = 28 lb

LUMBER					DESCR.
N. L. G. A. RULES	CHORDS	SIZE	LUMBER		
A - C	2x4	DRY	No.2		SPF
E - C	2x4	DRY	No.2		SPF
B - D	2x4	DRY	No.2		SPF

DRY: SEASONED LUMBER.

PLATES (table is in inches)					
JT	TYPE	PLATES	W	LEN	Y X
B	TMB1-I	MT20	3.0	4.0	
C	TMV+p	MT20	2.0	4.0	
E	BMV+p	MT20	2.0	4.0	

DIMENSIONS, SUPPORTS AND LOADINGS SPECIFIED BY FABRICATOR TO BE VERIFIED BY BUILDING DESIGNER

BEARINGS		FACTORED GROSS REACTION	MAXIMUM FACTORED GROSS REACTION	INPUT BRG	REQRD BRG
JT	VERT	HORZ	DOWN	HORZ	UPLIFT
B	557	0	557	0	0
D	300	0	300	0	0

UNFACTORED REACTIONS

1ST LCASE	MAX	MIN	COMPONENT REACTIONS						
JT	COMBINED	SNOW	LIVE	PERM.LIVE	WIND	DEAD	SOIL		
B	404	258 / 0	51 / 0	0 / 0	0 / 0	95 / 0	0 / 0		
D	227	114 / 0	51 / 0	0 / 0	0 / 0	62 / 0	0 / 0		

BEARING MATERIAL TO BE SPF NO.2 OR BETTER AT JOINT(S) B, D

BRACING

TOP CHORD TO BE SHEATHED OR MAX. PURLIN SPACING = 6.25 FT.
MAX. UNBRACED BOTTOM CHORD LENGTH = 10.00 FT OR RIGID CEILING DIRECTLY APPLIED.

ALL PITCH BREAKS AND PERIMETER CORNER JOINTS MUST BE Laterally RESTRAINED.

LOADING

TOTAL LOAD CASES: (4)

CHORDS				WEBS			
MEMB.	MAX. FACTORED FORCE (LBS)	FACTORED VERT. LOAD (PLF)	LC1 MAX (LC)	MEMB.	MAX. FACTORED FORCE (LBS)	MAX (LC)	
FR-TO		FROM	TO	FR-TO		FROM	TO
A-B	0 / 31	-124.4	-124.4 0.16 (1)	10.00	F-G	-83 / 142	0.00 (1)
B-G	-76 / 0	-124.4	-124.4 0.12 (3)	6.25			
G-C	0 / 9	-124.4	-124.4 0.31 (1)	10.00			
E-C	-239 / 0	0.0	0.0 0.03 (1)	7.81			
B-F	0 / 0	-39.2	-39.2 0.13 (1)	10.00			
F-E	0 / 0	-39.2	-39.2 0.35 (1)	10.00			
E-D	0 / 0	-39.2	-39.2 0.34 (1)	10.00			

DESIGN CRITERIA

SPECIFIED LOADS:

TOP CH.	LL	= 34.8	PSF
	DL	= 8.0	PSF
BOT CH.	LL	= 10.5	PSF
	DL	= 7.3	PSF
TOTAL LOAD		= 60.6	PSF

SPACING = 24.0 IN. C/C

THIS TRUSS IS DESIGNED FOR RESIDENTIAL OR SMALL BUILDING REQUIREMENTS OF PART 9, NBCC 2015

THIS DESIGN COMPLIES WITH:

- PART 9 OF BCBC 2018, ABC 2019
- PART 9 OF OBC 2012 (2019 AMENDMENT)
- CSA 086-14
- TPIC 2014

(55 % OF 48.1 P.S.F. G.S.L. PLUS 8.4 P.S.F. RAIN LOAD)
EQUALS 34.8 P.S.F. SPECIFIED ROOF LIVE LOAD

ALLOWABLE DEFL.(LL)= L/360 (0.19")
CALCULATED VERT. DEFL.(LL) = L/ 833 (0.07")
ALLOWABLE DEFL.(TL)= L/360 (0.19")
CALCULATED VERT. DEFL.(TL) = L/ 485 (0.12")

CSI: TC=0.31/1.00 (C-G-1) , BC=0.35/1.00 (E-F-1) ,
WB=0.00/1.00 (F-G-1) , SSI=0.23/1.00 (D-E-1)

DOL LUMBER=1.00 NAIL=1.00 LS BEND=1.10 COMP=1.10
SHEAR=1.10 TENS=1.10

COMPANION LIVE LOAD FACTOR = 1.00

TRUSS PLATE MANUFACTURER IS NOT RESPONSIBLE FOR QUALITY CONTROL IN THE TRUSS MANUFACTURING PLANT .

NAIL VALUES

PLATE	GRIP(DRY)	SHEAR	SECTION
	(PSI)	(PLI)	(PLI)
MAX MIN	MAX MIN	MAX MIN	MAX MIN
MT20	850	371	1747

PLATE PLACEMENT TOL. = 0.250 inches

PLATE ROTATION TOL. = 5.0 Deg.

JSI GRIP= 0.31 (B) (INPUT = 0.90)
JSI METAL= 0.09 (C) (INPUT = 1.00)



READ ALL NOTES ON THIS PAGE AND ON ENGINEERING NOTE PAGE ENP-1. THIS NOTE PAGE IS AN INTEGRAL PART OF THIS DRAWING AS IT CONTAINS SPECIFICATIONS AND CRITERIA USED IN THE DESIGN OF THIS COMPONENT.



These plans have been reviewed for use with the corrections as noted. No other changes may be made without written approval of the Building Standards Branch. All work must comply with Zoning By-Law 2015-043, as amended, and the Ontario Building Code, as amended. These approved documents must be kept on site at all times. The building permit must be clearly posted on site at all times.

Discipline	Reviewer	BCIN	Date
Building Code	H. Authier	43236	2021-02-04
Sewage System			
Zoning			



1) ENSURE TRUSS HAS BEEN DESIGNED WITH ADDITIONAL TOP CHORD DEAD LOAD EQUAL TO OR GREATER THAN WEIGHT OF SOLAR PANELS BEING INSTALLED

2) ATTACH SOLAR PANELS TO EACH TRUSS LOCATED UNDER THE SOLAR PANELS (I.E. @ 24" C/C PERPENDICULAR TO THE TRUSS DIRECTION)



3) ATTACH A SPF No.1/2 SCAB OF THE SAME SIZE AS TRUSS CHORD ON ONE SIDE ALONG THE FULL LENGTH OF THE MEMBER UNDER THE SOLAR PANELS USING 2 ROWS OF 3" WIRE NAILS @ 6" C/C

4) ATTACH SOLAR PANELS TO SCAB AT A MAXIMUM SPACING OF 48" C/C ALONG THE MEMBER (PARALLEL TO TRUSS DIRECTION) AS PER MANUFACTURER'S INSTRUCTIONS

5) DO NOT USE LAG SCREWS IN TRUSS MEMBERS. LAG SCREWS SHOULD ATTACH TO SCABS ONLY

6) MAXIMUM NUMBER OF SCAB SPLICES IS TWO

7) THIS DETAIL IS APPLICABLE TO PART 9 BUILDINGS ONLY

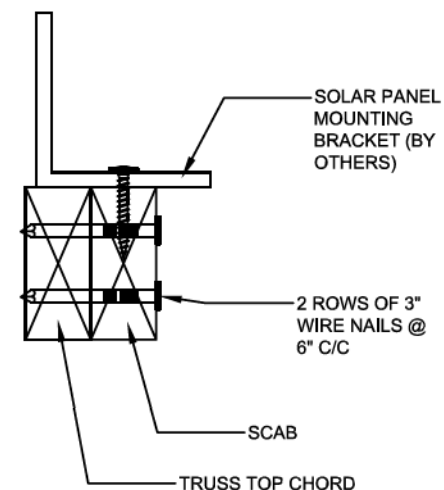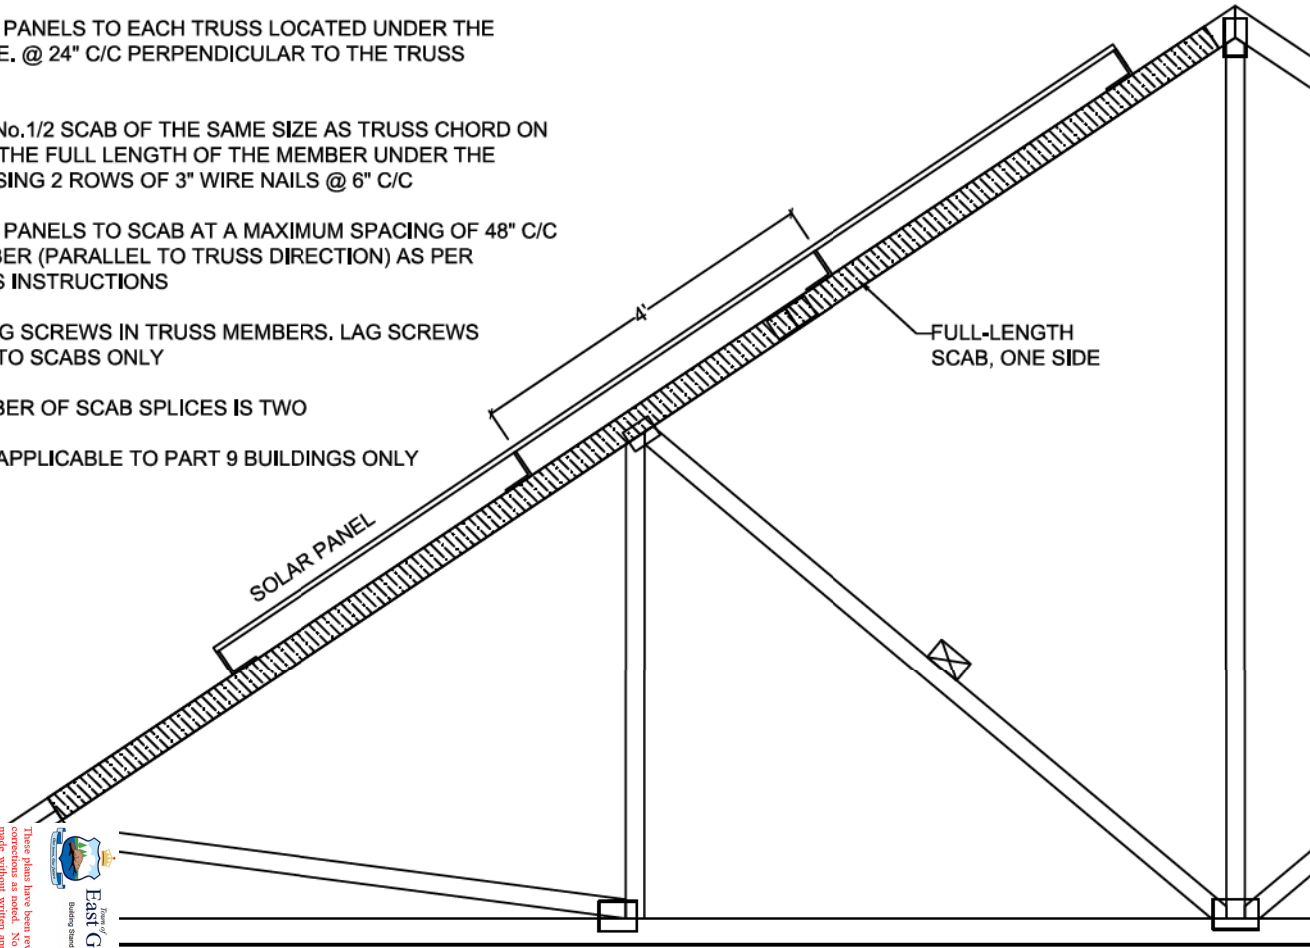

These plans have been reviewed for use with the corrections as noted. No other changes may be made without written approval of the Building Standards Branch. All work must comply with Ontario Building Code, as amended. These approved documents must be kept on site at all times. The building permit must be clearly posted on site at all times.

East Gwillimbury
Building Standards Branch (2436 9000)

Designation	Revision	BCIN	Date
Building Code	H. Adhoni	43286	2021-02-04
Sealing System			
Zoning			

NE1220-114
GREENPARK - TRINAR HALL -
BRENTWOOD 2 EL 3

Detail for Installation of Solar Panels - Scab Method



NE1220-114
GREENPARK - TRINAR
HALL - BRENTWOOD 2 EL 3


BEARING ANCHORAGE BY TOE-NAILS FOR LATERAL CAPACITY

B97791H1


NAIL TYPE	LENGTH (IN)	DIAMETER (IN)	NAIL LATERAL CAPACITY (LB)	
			S-P-F	D. FIR
COMMON WIRE	3.00	0.144	132	147
	3.25	0.144	132	147
	3.50	0.160	159	177
COMMON SPIRAL	3.00	0.122	97	108
	3.25	0.122	97	108
	3.50	0.152	145	162

NOTES:

- Rafter and ceiling members may be anchored to top and bottom chords of girder truss by toe-nailing rafter and ceiling members to girder chords provided the reaction does not exceed the lateral capacities in the table. Hangers (specified by others) are required for reactions higher than the maximum toe-nail capacity. Reactions are based on factored loads.
- Toe nail capacities shown in the table are for **one** toe-nail. For additional toe-nails multiply values in table by the number of toe-nails used. Toe-nail capacities take into account toe-nailing factor J_A in CSA O86-14, section 12.9.4.1.
- For 9- 3/4 gauge 3.25" common wire gun nails (diameter = 0.120") use 3" common spiral nail values.
- Maximum number of toe-nails allowed depends on the lumber size & species to be toe-nailed to supporting member and nail diameter, as shown in tables below.
- Nail values in table are based on the following relative lumber densities: G = 0.42 (SPF), G = 0.49 (D. Fir).
- Toe-nails shall be driven at approximately 1/3 the nail length from the edge of the joist/truss chord and driven at an angle of 30° to the grain of the member (See next page for nailing on bearing plate).
- For loads due to **wind** the nail lateral capacity in this table may be multiplied by 1.15 (K_D factor).
- Lumber must be dry (< 19% moisture content) at the time of nail installation.
- Nail values in this table comply with CSA O86-14, section 12.9.4
- This design is not valid after March 31, 2021.

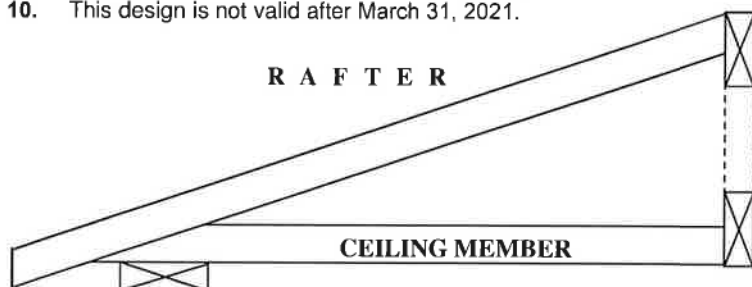

GIRDER TRUSS

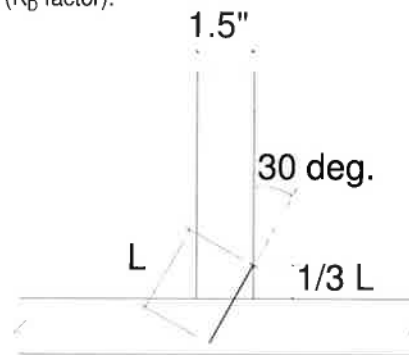

TOE-NAIL INSTALLATION

Nail type	Common wire	Common spiral	Common wire	Common spiral
Nail dia. (in)	0.160	0.152	0.144	0.122
	(3.5" nail)		(3" and 3.25" nail)	
LUMBER SIZE	MAXIMUM NUMBER OF TOE-NAILS			
2X4 SPF	2	2	3	3
2X4 D. Fir	2	2	2	2
2X6 SPF	4	4	4	5
2X6 D. Fir	3	3	3	4

MiTek

MiTek Canada Inc
100 Industrial Rd.
Bradford, Ontario L3Z 3G7




Town of East Gwillimbury
Building Standards Branch BCIN #15487

December

These plans have been reviewed for use with the corrections as noted. No other changes may be made without written approval of the Building Standards Branch. All work must comply with Zoning By-Law 2015-043, as amended, and the Ontario Building Code, as amended. These approved documents must be kept on site at all times. The building permit must be clearly posted on site at all times.

Discipline	Reviewer	BCIN	Date
Building Code	H. Authier	43236	2021-02-04
Sewage System			
Zoning			

PEO
Certificate No. 10889485

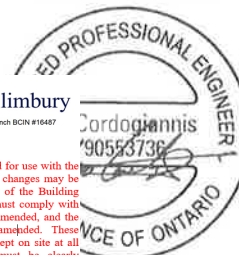

NE1220-114
GREENPARK - TRINAR
HALL - BRENTWOOD 2 EL 3

BEARING ANCHORAGE BY TOE-NAILS FOR WIND LOADING

B97791H2



NAIL TYPE	LENGTH (IN)	DIAMETER (IN)	NAIL WITHDRAWAL CAPACITY (LB)	
			S-P-F	D. FIR
COMMON WIRE	3.00	0.144	30	42
	3.25	0.144	32	45
	3.50	0.160	38	52
COMMON SPIRAL	3.00	0.122	26	36
	3.25	0.122	28	40
	3.50	0.152	36	50

Note: If using truss with D. Fir lumber and S-P-F bearing plate, use values in table for S-P-F.



NOTES:

1. Truss chord, rafter, or ceiling members may be anchored to bearing plate by toe-nails, provided that the actual factored uplift force due to **wind** or **earthquake** load does not exceed the withdrawal capacities in the table. Hangers (specified by others) are required for uplift forces that are higher than the maximum toe-nail withdrawal capacity.
2. Toe nail capacities shown in the table are for **one** toe-nail. For additional toe-nails multiply values in table by the number of toe-nails used. Toe-nail capacities take into account toe-nailing factor J_A in CSA O86-14, section 12.9.5.2.
3. For 9- 3/4 gauge 3.25" common wire gun nails (diameter = 0.120") use 3" common spiral nail values.
4. Maximum number of toe-nails allowed depends on the lumber size & species to be toe-nailed to supporting member and nail diameter, as shown in table above.
5. Nail values in table are based on the following relative lumber densities: $G = 0.42$ (SPF), $G = 0.49$ (D. Fir).
6. Toe-nails shall be driven at approximately 1/3 the nail length from the edge of the joist/truss chord and driven at an angle of 30° to the grain of the member (See drawing on detail B37579H1).
7. Lumber must be dry (< 19% moisture content) at the time of nail installation.
8. Nail values in this table comply with CSA O86-14, section 12.9.5
9. This design is not valid after March 31, 2021.

Toe-nailing on 2x6 Bearing Plate

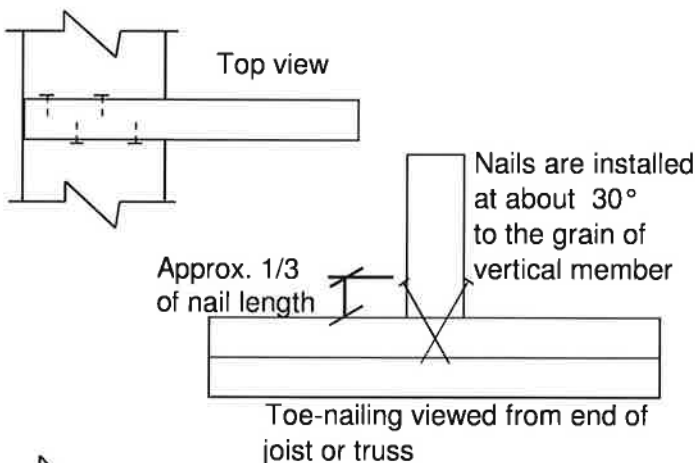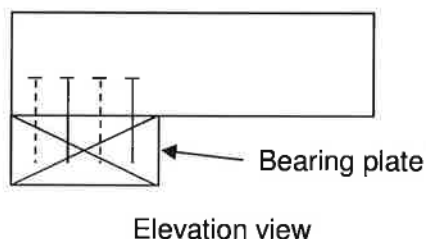

Toe-nailing on 2x4 Bearing Plate

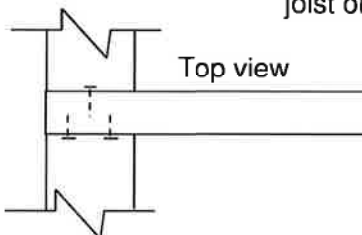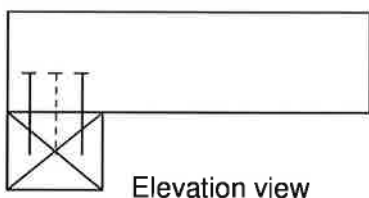


MiTek

MiTek Canada Inc
100 Industrial Rd.
Bradford, Ontario L3Z 3G7



Town of East Gwillimbury
Building Standards Branch BCIN #16487

PEO
Certificate No. 10889485

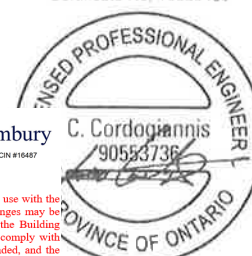

These plans have been reviewed for use with the corrections as noted. No other changes may be made without written approval of the Building Standards Branch. All work must comply with Zoning By-Law 2018-043, as amended, and the Ontario Building Code, as amended. These approved documents must be kept on site at all times. The building permit must be clearly posted on site at all times.

Discipline	Reviewer	BCIN	Date
Building Code	H. Authier	43236	2021-02-04
Sewage System			
Zoning			