


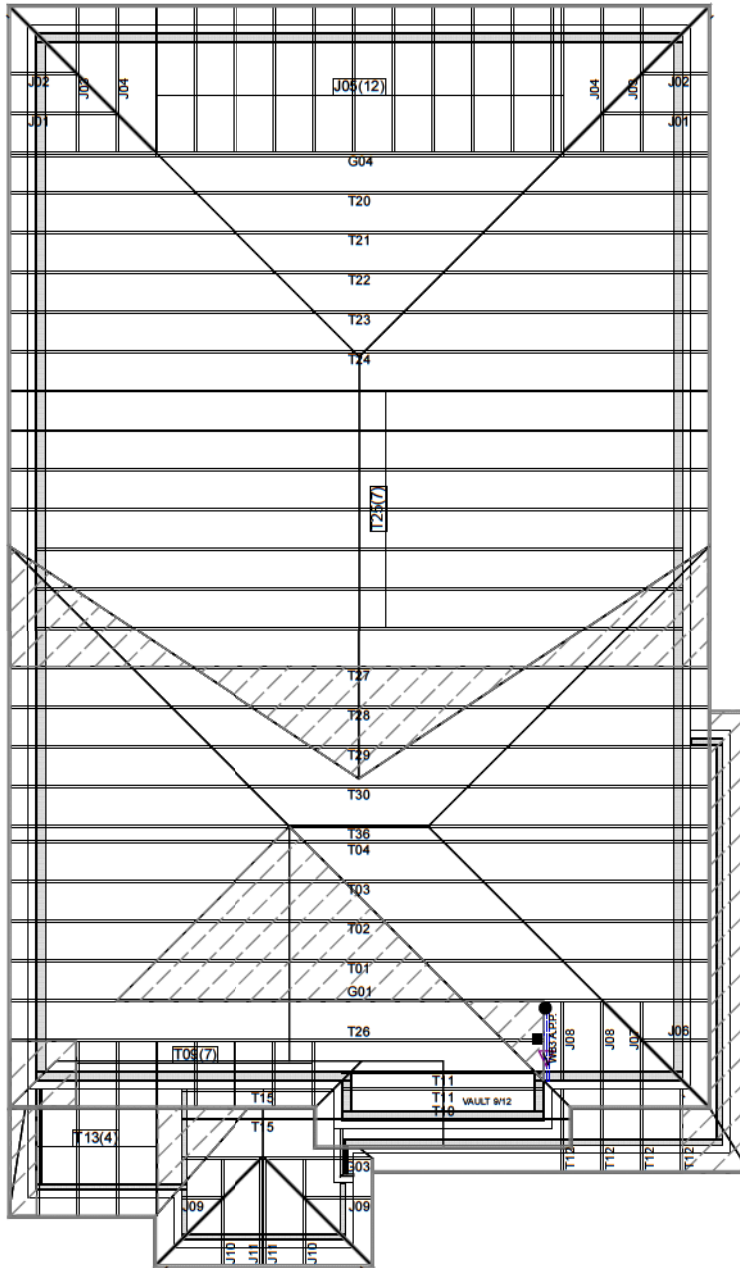

Hanger Name	Symbol	QTY
LUS24	▲	0
LJS26DS	■	1
HGUS26-2	●	1

PIGGYBACK TRUSSES TO BE SUPPORTED ON 2X4 SPF #1/2 MEMBERS @ 24" O/C PLACED PERPENDICULAR TO THE PIGGYBACK DIRECTION. PLACE 2X4 MEMBERS BETWEEN THE BOTTOM CHORD OF THE PIGGYBACK TRUSS AND THE TOP CHORD OF THE SUPPORTING TRUSS.



These plans have been reviewed for use with the corrections as noted. No other changes may be made without written approval of the Building Standards Branch. All work must comply with Zoning By-Law 2018-043, as amended, and the Ontario Building Code, as amended. These approved documents must be kept on site at all times. The building permit must be clearly posted on site at all times.

Discipline	Reviewer	BCIN	Date
Building Code	H. Authier	43236	2021-02-03
Sewage System			
Zoning			

CONVENTIONAL FRAMING BY OTHERS

ALL CONVENTIONAL FRAMING TO CONFORM WITH PART 9 OF THE OBC. ROOF RAFTERS THAT CROSS OVER TRUSSES TO BE MIN. 2x4 SPF @ 24" C/C WITH A 2x4 VERTICAL POST TO THE TRUSS BELOW. VERTICAL POSTS TO BE Laterally BRACED SO THAT UNBRACED LENGTH DOES NOT EXCEED 6'. DESIGN OF CONVENTIONAL FRAMING IS THE RESPONSIBILITY OF THE PROJECT ENGINEER.

JOB INFORMATION

Customer	GREENPARK HOMES
Job #	T20-00773
Address	LOT 34 TRINAR HALL EAST GWILLIMBURY, ON
Model	GLENWAY 7A ELEV 1
Sales Rep	RALPH MIRIGELLO
Designer	DM
Date	12/17/2020
Path	C:\DATA\JOBS\GREENPARK\TRINAR HALL\MODELS\LOT 34\T-00773\

DESIGN INFORMATION

Code	NBCC 2015
Bldg	Residential - HSB (NBCC Part 9)
TC LL	34.8 lb/ft ²
TC DL	8.0 lb/ft ²
BC LL	10.5 lb/ft ²
BC DL	7.3 lb/ft ²
Deflection	LL=L/360 TL=L/360
Spacing	24" O/C unless otherwise noted
Complies With	OBC 2012 (2019 Amendment) CSA O86-14 and TPIC 2014

IMPORTANT INFORMATION

Refer to truss drawings in the Truss Engineering Package for ply-to-ply attachment notes

For site-framed valleys: top chords of all roof trusses must be laterally supported using 2x4 continuous bracing @24 O/C - all bracing must be anchored at ends as per TPIC Installation Guidelines

Read all notes on this page in addition to those shown on the KOTT Truss Engineering package

Field erection, handling and bracing are not the responsibility of KOTT, or KOTT Engineering

Unless noted otherwise, hurricane ties are to be installed at the bearings of all trusses > 40 ft clear span, and any girder or beam supporting trusses with a clear span >40 ft. See hanger legend for type.

Unless noted otherwise, for Part 9 bldgs, all trusses are to be anchored to the top of supporting walls as follows: trusses with a clear span <40 ft use 3-1/4" nails @ each bearing; trusses with a clear span >40 ft use 3-1/4" nails @ each bearing in addition to the appropriate hurricane tie.

KOTT Inc.
14 Anderson Blvd.
Uxbridge, ON
905.642.4400





These plans have been reviewed for use with the corrections as noted. No other changes may be made without written approval of the Building Standards Branch. All work must comply with Zoning By-Law 2018-043, as amended, and the Ontario Building Code, as amended. These approved documents must be kept on site at all times. The building permit must be clearly posted on site at all times.

Discipline	Reviewer	BCIN	Date
Building Code	H. Authier	43236	2021-02-03
Sewage System			
Zoning			

NE1220-133

GREENPARK - TRINAR

HALL - LOT 34

ENGINEERING NOTE PAGE (ENP-1)**PLEASE READ PRIOR TO INSTALLATION****RESPONSIBILITIES**

THIS DESIGN IS FOR AN INDIVIDUAL BUILDING COMPONENT AND HAS BEEN BASED ON INFORMATION PROVIDED BY KOTT DESIGN. THE UNDERSIGNED ENGINEER DISCLAIMS ANY RESPONSIBILITY FOR DAMAGES AS A RESULT OF FAULTY OR INCORRECT INFORMATION, SPECIFICATION AND/OR DESIGNS FURNISHED TO THE ENGINEER. THE UNDERSIGNED ENGINEER IS ONLY RESPONSIBLE FOR THE STRUCTURAL INTEGRITY OF THIS BUILDING COMPONENT FOR THE CONDITIONS AND LOADS SHOWN ON THIS DRAWING. THE STRUCTURAL INTEGRITY OF THE BUILDING AND THE VERIFICATION OF THE DIMENSIONS AND THE DESIGN LOADS USED ARE THE RESPONSIBILITY OF THE BUILDING DESIGNER.

TRUSSES ARE DESIGNED IN CONFORMANCE WITH THE RELEVANT SECTIONS OF THE NATIONAL BUILDING CODE OF CANADA OR THE CANADIAN CODE FOR FARM BUILDINGS, WHICHEVER APPLIES TO THE BUILDING TYPE INDICATED ON THE DRAWING

IT IS THE RESPONSIBILITY OF KOTT TO ENSURE THAT TRUSSES ARE MANUFACTURED IN CONFORMANCE WITH THESE DESIGNS AND WITH THE SPECIFICATIONS OUTLINED BELOW. THE UNDERSIGNED ENGINEER IS NOT RESPONSIBLE FOR QUALITY CONTROL IN THE TRUSS MANUFACTURING PLANT.

USE AND OCCUPANCY

- The building is of the type indicated on the drawing

LOADING

- The truss loading intensity and distribution as well as load transfer mechanism is that indicated on the drawing
- No buildings, trees, parapets or other projections higher than the roof for which the trusses are used are located within a distance less than ten (10) times the difference in height, or five metres (16 ft) whichever is greater, unless the drawing indicates that the snow drifting has been taken into account

HANDLING, INSTALLATION AND BRACING


- The trusses must be handled and installed by a qualified professional as per the supplied document titled *Information for Truss Installers* and the BCSI-B1 and BCSI-B3 Summary Sheets
- The compression chords are laterally braced by continuous rigid diaphragm sheathing or as specified on the drawing
- Temporary and permanent bracing must be installed as indicated on the truss drawing and according to the BCSI-B1 and BCSI-B3 Summary Sheets. Bracing for the lateral stability of the truss is to be provided by the building designer
- **It is recommended that a Professional Engineer's advice be obtained for the bracing of trusses spanning more than 12.37m (40'-7")**

SUPPORTS

- The trusses are to be supported at the bearing points indicated and anchored to the supports where considered necessary by the designer of the overall structure
- Bearing sizes shown are the minimum required to prevent crushing of the truss members and do not necessarily take into account stability of the overall building structure
- Elevation of bearings must be carefully checked and shimmed to alignment for solid bearings
- Adequate wood truss bearing is the responsibility of the building designer.

DIMENSIONS

- Geometry of the truss and dimensions indicated on the drawing are identical to those of the installed truss.

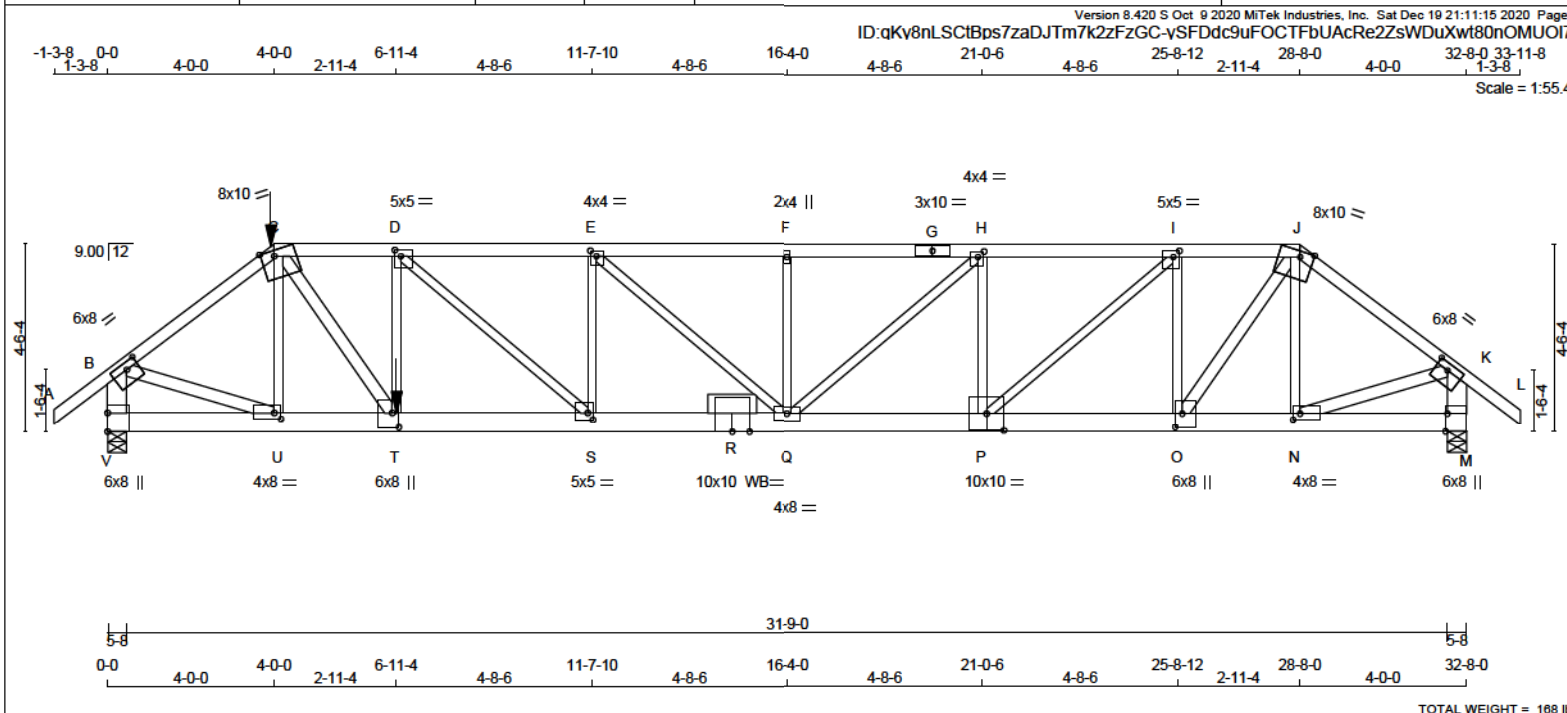

LUMBER				DIMENSIONS, SUPPORTS AND LOADINGS SPECIFIED BY FABRICATOR TO BE VERIFIED BY BUILDING DESIGNER										DESIGN CRITERIA			
N. L. G. A. RULES				BEARINGS										*** SPECIAL LOADS ANALYSIS ***			
CHORDS SIZE LUMBER DESCR.				FACTORED GROSS REACTION MAXIMUM FACTORED GROSS REACTION INPUT BRG REQRD										GEOMETRY AND/OR BASIC LOADS CHANGED BY USER.			
A - C 2x4 DRY No.2 SPF				JT VERT HORZ DOWN HORZ UPLIFT IN-SX IN-SX										LOADS WERE DERIVED FROM USER INPUT			
C - G 2x4 DRY 2100F 1.8E SPF				V 4893 0 4893 0 0 5-8 5-8										NO FURTHER MODIFICATIONS WERE MADE			
G - J 2x4 DRY 2100F 1.8E SPF				M 3351 0 3351 0 0 5-8 3-10													
J - L 2x4 DRY No.2 SPF				UNFACTORED REACTIONS										SPECIFIED LOADS:			
V - B 2x6 DRY No.2 SPF				1ST LCASE MAX/MIN COMPONENT REACTIONS										TOP CH. LL = 34.8 PSF			
M - K 2x6 DRY No.2 SPF				JT COMBINED SNOW LIVE PERM.LIVE WIND DEAD SOIL										DL = 8.0 PSF			
V - R 2x6 DRY 2100F 1.8E SPF				V 3615 2104 / 0 608 / 0 0 / 0 0 / 0 905 / 0 0 / 0										BOT CH. LL = 10.5 PSF			
R - P 2x6 DRY 2100F 1.8E SPF				M 2472 1450 / 0 408 / 0 0 / 0 0 / 0 616 / 0 0 / 0										DL = 7.3 PSF			
P - M 2x6 DRY 2100F 1.8E SPF				BEARING MATERIAL TO BE SPF NO.2 OR BETTER AT JOINT(S) V, M										TOTAL LOAD = 60.6 PSF			
ALL WEBS 2x3 DRY No.2 SPF				BRACING										SPACING = 24.0 IN. C/C			
EXCEPT				TOP CHORD TO BE SHEATHED OR MAX. PURLIN SPACING = 2.13 FT.										LOADING IN FLAT SECTION BASED ON A SLOPE OF 2.00/12 MINIMUM			
C - T 2x4 DRY No.2 SPF				MAX. UNBRACED BOTTOM CHORD LENGTH = 10.00 FT OR RIGID CEILING DIRECTLY APPLIED.										GIRDER TYPE: CPrimeHip			
O - J 2x4 DRY No.2 SPF				ALL PITCH BREAKS AND PERIMETER CORNER JOINTS MUST BE LATERALLY RESTRAINED.										SIDE SETBACK = 4-0-0			
B - U 2x4 DRY No.2 SPF				LOADING										END SETBACK = 4-0-0			
N - K 2x4 DRY No.2 SPF				TOTAL LOAD CASES: (4)										END WALL WIDTH = 5-8			
DRY: SEASONED LUMBER.				CHORDS WEBS										CORNER FRAMING TYPE: CONVENTIONAL			
				MAX. FACTORED FORCE (LBS) FACTORED VERT. LOAD (PLF) MAX. FACTORED UNBRACED (LC) MEMB. MAX. FACTORED FORCE (LBS) MAX. FACTORED UNBRACED (LC)										END JACK TYPE: CONVENTIONAL			
PLATES (table is in inches)				FR-TO FROM TO LENGTHFR-TO FROM TO										APPLIED TO BACK SIDE			
JT TYPE PLATES W LEN Y X				A-B 0 / 51 -124.4 -124.4 0.19 (1) 10.00 U-C -884 / 0 0.26 (1)										- ADDTL LOADS BASED ON 55 % OF G.S.L.			
B TMWW-t MT20 6.0 8.0 2.00 3.50				B-C -5351 / 0 -124.4 -124.4 0.97 (1) 2.13 C-T 0 / 4186 0.74 (1)										LOADS APPLIED TO FIRST 6-10-8 OF SPAN MEASURED FROM THE LEFT.			
C TTWW-m MT20 8.0 10.0 Edge 4.00				C-D -6676 / 0 -172.4 -172.4 0.40 (1) 3.13 T-D -1229 / 0 0.36 (1)										*** NON STANDARD GIRDER ***			
D TMWW-t MT20 5.0 5.0 1.75 1.75				D-E -7448 / 0 -124.4 -124.4 0.60 (1) 2.84 D-S 0 / 1030 0.25 (1)										ADDTL USER-DEFINED LOADS APPLIED TO ALL LOAD CASES.			
E TMWW-t MT20 4.0 4.0 1.50 1.75				E-F -7282 / 0 -124.4 -124.4 0.59 (1) 2.89 S-E -456 / 0 0.13 (1)										THIS TRUSS IS DESIGNED FOR RESIDENTIAL OR SMALL BUILDING REQUIREMENTS OF PART 9, NBCC 2015			
F TMWW+ MT20 2.0 4.0				F-G -7282 / 0 -124.4 -124.4 0.59 (1) 2.89 E-Q -221 / 0 0.15 (1)										THIS DESIGN COMPLIES WITH:			
G TS-t MT20 3.0 10.0				G-H -7282 / 0 -124.4 -124.4 0.59 (1) 2.89 Q-F -572 / 0 0.17 (1)										- PART 9 OF CBC 2018 , ABC 2019			
H TMWW-t MT20 4.0 4.0 1.50 1.75				H-I -8303 / 0 -124.4 -124.4 0.59 (1) 3.17 Q-H 0 / 1306 0.32 (1)										- PART 9 OF OBC 2012 (2019 AMENDMENT)			
I TMWW-t MT20 5.0 5.0 1.75 1.75				I-J -4422 / 0 -124.4 -124.4 0.28 (1) 3.90 P-H -1463 / 0 0.43 (1)										- CSA 086-14			
J TTWW-m MT20 8.0 10.0 Edge 4.00				J-K -3493 / 0 -124.4 -124.4 0.65 (1) 3.11 P-I 0 / 2508 0.62 (1)										- TPIC 2014			
K TMWW-t MT20 6.0 8.0 2.00 3.50				K-L 0 / 51 -124.4 -124.4 0.19 (1) 10.00 O-I -2158 / 0 0.84 (1)										(55 % OF 48.1 P.S.F. G.S.L. PLUS 8.4 P.S.F. RAIN LOAD)			
M BMV-t MT20 6.0 8.0 Edge 0.50				V-B -4798 / 0 0.0 0.0 0.35 (1) 4.87 O-J 0 / 2845 0.50 (1)										EQUALS 34.8 P.S.F. SPECIFIED ROOF LIVE LOAD			
N BMWW-t MT20 4.0 8.0 1.75 2.00				M-K -3278 / 0 0.0 0.0 0.24 (1) 5.81 N-J -613 / 0 0.18 (1)										ALLOWABLE DEFL. (LL)= L/360 (1.09")			
O BMWW-t MT20 6.0 8.0 4.25 2.00				V-U 0 / 0 -54.4 -54.4 0.05 (3) 10.00 N-K 0 / 2889 0.51 (1)													
P BSWW-t MT20 10.0 10.0 5.25 5.00				U-T 0 / 4249 -54.4 -54.4 0.27 (1) 10.00													
Q BMWW-t MT20 4.0 8.0				T-S 0 / 6076 -39.2 -39.2 0.42 (1) 10.00													
R BS-t MT20 10.0 10.0				S-R 0 / 7448 -39.2 -39.2 0.46 (1) 10.00													
S BMWW-t MT20 5.0 5.0 2.00 1.50																	
T BMWW-t MT20 6.0 8.0 4.25 2.00																	
U BMWW-t MT20 4.0 8.0 1.75 2.00																	
V BMV-t MT20 6.0 8.0 5.50																	

READ ALL NOTES ON THIS PAGE AND ON ENGINEERING NOTE PAGE ENP-1. THIS NOTE PAGE IS AN INTEGRAL PART OF THIS DRAWING AS IT CONTAINS SPECIFICATIONS AND CRITERIA USED IN THE DESIGN OF THIS COMPONENT.

CONNECTION REQUIREMENTS

1) C1: A SUITABLE HANGER/MECHANICAL CONNECTION IS REQUIRED.

LOC.	LC1	MAX.	MAX+	FACE	DIR.	TYPE	HEEL	CONN.
C	4-0-0	-207	-207	—	BACK	VERT	TOTAL	C1
T	6-11-4	-2101	-2101	—	BACK	VERT	TOTAL	C1


Town of East Gwillimbury
Building Standards Branch BCN #18467

These plans have been reviewed for use with the corrections as noted. No other changes may be made without written approval of the Building Standards Branch. All work must comply with Zoning By-Law 2018-043, as amended, and the Ontario Building Code, as amended. These approved documents must be kept on site at all times. The building permit must be clearly posted on site at all times.

Discipline	Reviewer	BCIN	Date
Building Code	H. Authier	43236	2021-02-03
Seismic System			
Zoning			

CONTINUED ON PAGE 2

Version 8.420 S Oct 9 2020 MITek Industries, Inc. Sat Dec 19 21:11:16 2020 Page 1

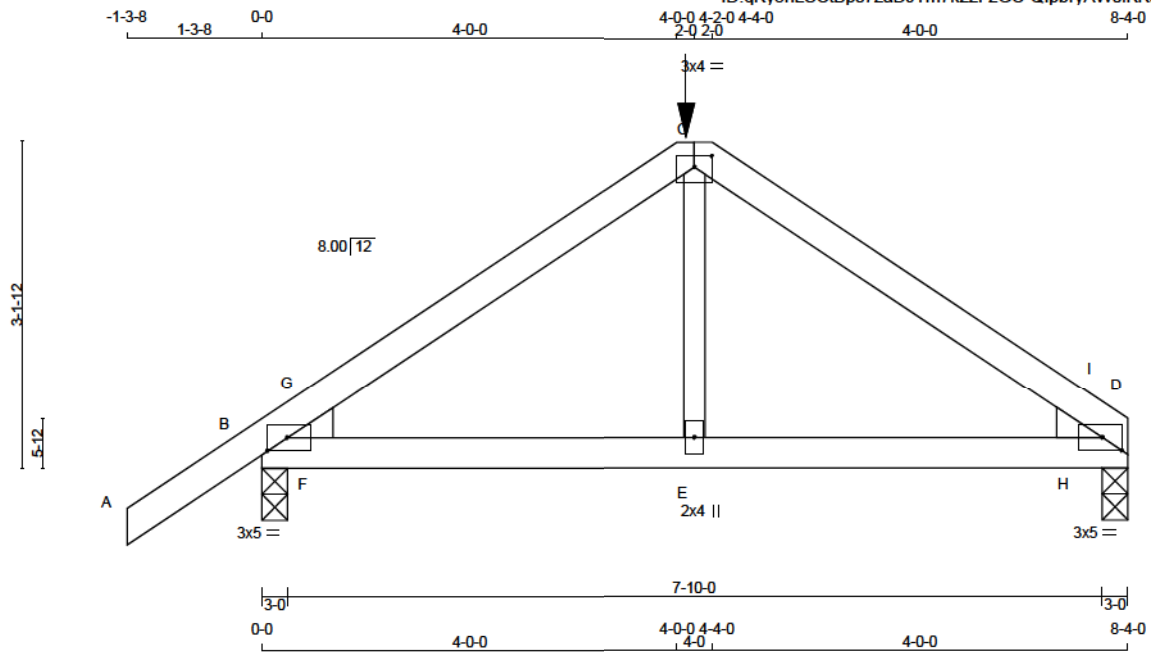

TOTAL WEIGHT = 26 lb

LUMBER					DESCR.
N. L. G. A. RULES	SIZE	LUMBER			
CHORDS					
A - C	2x4	DRY	No.2		SPF
C - D	2x4	DRY	No.2		SPF
B - D	2x4	DRY	No.2		SPF
ALL WEBS	2x3	DRY	No.2		SPF
DRY: SEASONED LUMBER.					

PLATES (table is in inches)					
JT TYPE	PLATES	W	LEN	Y	X
B	TMBH1-I	MT20	3.0	5.0	Edge 2.25
C	TTW-p	MT20	3.0	4.0	1.25 2.00
D	TMBH1-I	MT20	3.0	5.0	Edge 2.25
E	BMW+w	MT20	2.0	4.0	

Edge - INDICATES REFERENCE CORNER OF PLATE TOUCHES EDGE OF CHORD.

DIMENSIONS, SUPPORTS AND LOADINGS SPECIFIED BY FABRICATOR TO BE VERIFIED BY BUILDING DESIGNER

BEARINGS							
	FACTORED GROSS REACTION	MAXIMUM FACTORED GROSS REACTION	INPUT BRG	REQRD BRG	HEEL		
JT	VERT	HORZ	DOWN	HORZ	UPLIFT	IN-SX	WEDGE
B	1132	0	1132	0	0	3-0	1-8
D	961	0	961	0	0	3-0	1-8

UNFACTORED REACTIONS							
1ST LCASE	MAX/MIN COMPONENT REACTIONS						
JT	COMBINED	SNOW	LIVE	PERM.LIVE	WIND	DEAD	SOIL
B	830	502 / 0	126 / 0	0 / 0	0 / 0	203 / 0	0 / 0
D	713	406 / 0	126 / 0	0 / 0	0 / 0	181 / 0	0 / 0

BEARING MATERIAL TO BE SPF NO.2 OR BETTER AT JOINT(S) B, D

BRACING
TOP CHORD TO BE SHEATHED OR MAX. PURLIN SPACING = 5.70 FT.
MAX. UNBRACED BOTTOM CHORD LENGTH = 10.00 FT OR RIGID CEILING DIRECTLY APPLIED.

ALL PITCH BREAKS AND PERIMETER CORNER JOINTS MUST BE Laterally RESTRAINED.

LOADING

TOTAL LOAD CASES: (4)

CHORDS				WEBS			
MEMB.	MAX. FACTORED FORCE (LBS)	FACTORED VERT. LOAD (PLF)	LC1 MAX (LC)	UNBRAC	MEMB.	MAX. FACTORED FORCE (LBS)	MAX (LC)
FR-TO		FROM TO	LENGTH	FR-TO			
A-B	0 / 41	-124.4 -124.4	0.18 (1)	10.00	E-C	0 / 386	0.10 (2)
B-G	-1123 / 0	-124.4 -124.4	0.13 (1)	5.81	F-G	-161 / 106	0.00 (1)
G-C	-1070 / 0	-124.4 -124.4	0.28 (1)	5.70	H-I	-161 / 106	0.00 (1)
C-I	-1070 / 0	-124.4 -124.4	0.28 (1)	5.70			
I-D	-1123 / 0	-124.4 -124.4	0.13 (1)	5.81			
B-F	0 / 880	-56.4 -56.4	0.32 (1)	10.00			
F-E	0 / 880	-56.4 -56.4	0.38 (1)	10.00			
E-H	0 / 880	-56.4 -56.4	0.38 (1)	10.00			
H-D	0 / 880	-56.4 -56.4	0.32 (1)	10.00			

FACTORED CONCENTRATED LOADS (LBS)							
JT	LOC.	LC1	MAX-	MAX+	FACE	DIR.	TYPE
C	4-2-0	-415	-415	—	FRONT	VERT	HEEL
							CONN.
							C1

CONNECTION REQUIREMENTS

1) C1: A SUITABLE HANGER/MECHANICAL CONNECTION IS REQUIRED.

DESIGN CRITERIA

SPECIFIED LOADS:

TOP CH.	LL = 34.8	PSF
	DL = 8.0	PSF
BOT CH.	LL = 10.5	PSF
	DL = 7.3	PSF
TOTAL LOAD	= 60.6	PSF

SPACING = 24.0 IN. C/C

GIRDER TYPE: CPrimeHip
SIDE SETBACK = 4-0-0
END SETBACK = 4-0-0
END WALL WIDTH = 3-0
CORNER FRAMING TYPE: CONVENTIONAL
END JACK TYPE: CONVENTIONAL
APPLIED TO FRONT SIDE
- ADDTL LOADS BASED ON 55 % OF GSL.

THIS TRUSS IS DESIGNED FOR RESIDENTIAL OR SMALL BUILDING REQUIREMENTS OF PART 9, NBCC 2015

THIS DESIGN COMPLIES WITH:
- PART 9 OF BCBC 2018, ABC 2019
- PART 9 OF OBC 2012 (2019 AMENDMENT)
- CSA 086-14
- TPIC 2014

(55 % OF 48.1 P.S.F. G.S.L. PLUS 8.4 P.S.F. RAIN LOAD)
EQUALS 34.8 P.S.F. SPECIFIED ROOF LIVE LOAD

ALLOWABLE DEFL.(LL)= L/360 (0.28")
CALCULATED VERT. DEFL.(LL) = L/999 (0.02")
ALLOWABLE DEFL.(TL)= L/360 (0.28")
CALCULATED VERT. DEFL.(TL) = L/999 (0.04")

CSI: TC=0.28/1.00 (C-G-1), BC=0.38/1.00 (E-F-1),
WB=0.10/1.00 (C-E-2), SS=0.19/1.00 (B-F-1)

DOL LUMBER=1.00 NAIL=1.00 LS BEND=1.00 COMP=1.00
SHEAR=1.00 TENS=1.00

COMPANION LIVE LOAD FACTOR = 1.00

TRUSS PLATE MANUFACTURER IS NOT RESPONSIBLE FOR QUALITY CONTROL IN THE TRUSS MANUFACTURING PLANT.

NAIL VALUES			
PLATE	GRIP(DRY)	SHEAR	SECTION
	(PSI)	(PLI)	(PLI)
	MAX MIN	MAX MIN	MAX MIN
MT20	650 371	1747 788	1987 1873

PLATE PLACEMENT TOL. = 0.250 inches

PLATE ROTATION TOL. = 5.0 Deg.

JSI GRIP= 0.81 (D) (INPUT = 0.90)
JSI METAL= 0.29 (B) (INPUT = 1.00)




These plans have been reviewed for use with the corrections as noted. No other changes may be made without written approval of the Building Standards Branch. All work must comply with Zoning By-Law 2018-043, as amended, and the Ontario Building Code, as amended. These approved documents must be kept on site at all times. The building permit must be clearly posted on site at all times.

Discipline	Reviewer	BCIN	Date
Building Code	H. Authier	43236	2021-02-03
Severage System			
Zoning			



READ ALL NOTES ON THIS PAGE AND ON ENGINEERING NOTE PAGE ENP-1. THIS NOTE PAGE IS AN INTEGRAL PART OF THIS DRAWING AS IT CONTAINS SPECIFICATIONS AND CRITERIA USED IN THE DESIGN OF THIS COMPONENT.

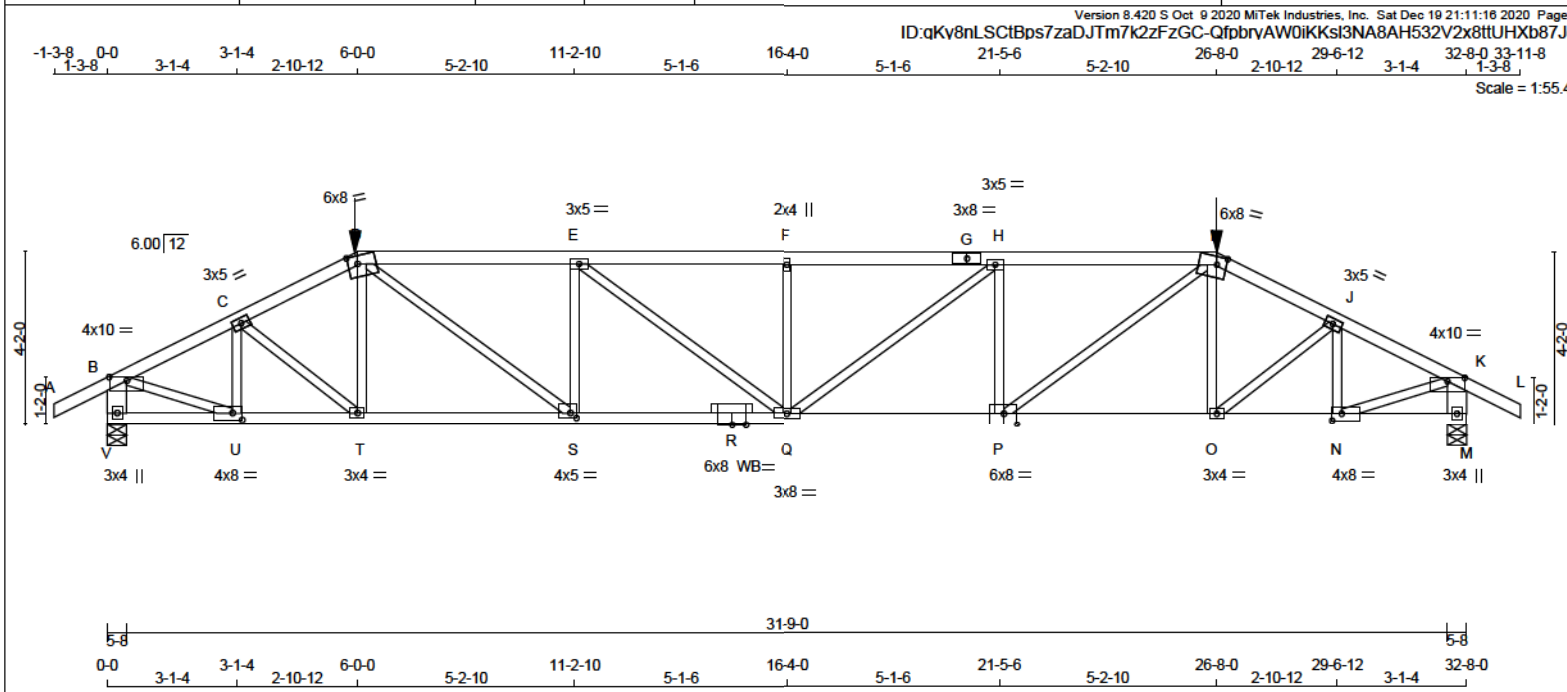

LUMBER			
N. L. G. A. RULES	CHORDS	SIZE	DESCR.
A - D	2x4	DRY	No.2
D - G	2x4	DRY	2100F 1.8E
G - I	2x4	DRY	2100F 1.8E
I - L	2x4	DRY	No.2
V - B	2x6	DRY	No.2
M - K	2x6	DRY	No.2
V - R	2x4	DRY	No.2
R - P	2x4	DRY	2100F 1.8E
P - M	2x4	DRY	No.2
ALL WEBS	2x3	DRY	No.2
EXCEPT			

DRY: SEASONED LUMBER.

DESIGN CONSISTS OF 2 TRUSSES BUILT SEPARATELY THEN FASTENED TOGETHER AS FOLLOWS:

CHORDS#ROWS	SURFACE SPACING (IN)	LOAD(PLF)
TOP CHORDS : (0.122"x3") SPIRAL NAILS		
A - D	12	SIDE(0.0)
D - G	12	SIDE(55.1)
G - I	12	SIDE(55.1)
I - L	12	SIDE(0.0)
V - B	12	TOP
M - K	12	TOP
BOTTOM CHORDS : (0.122"x3") SPIRAL NAILS		
V - R	12	SIDE(22.0)
R - P	12	SIDE(22.0)
P - M	12	SIDE(22.0)
WEBS : (0.122"x3") SPIRAL NAILS		
2x3	6	

NAILS TO BE DRIVEN FROM ONE SIDE ONLY.

GIRDER NAILING ASSUMES NAILED HANGERS ARE FASTENED WITH MIN. 3-0 INCH NAILS.

TOP - COMPONENTS ARE LOADED FROM THE TOP AND MUST BE PLACED ON TOP EDGE OF ALL PLIES FOR THE LOAD TO BE TRANSFERRED TO EACH PLY.

DIMENSIONS, SUPPORTS AND LOADINGS SPECIFIED BY FABRICATOR TO BE VERIFIED BY BUILDING DESIGNER									
BEARINGS									
FACTORED GROSS REACTION		MAXIMUM FACTORED GROSS REACTION		INPUT BRG		REQRD BRG			
JT	VERT	HORZ	DOWN	HORZ	UPLIFT	IN-SX	IN-SX		
V	5108	0	5108	0	0	5-8	2-13		
M	5108	0	5108	0	0	5-8	2-13		
UNFACTORED REACTIONS									
1ST LCASE MAX/MIN COMPONENT REACTIONS									
JT	COMBINED	SNOW	LIVE	PERM.LIVE	WIND	DEAD	SOIL		
V	3780	2182 / 0	647 / 0	0 / 0	0 / 0	951 / 0	0 / 0		
M	3780	2182 / 0	647 / 0	0 / 0	0 / 0	951 / 0	0 / 0		
BEARING MATERIAL TO BE SPF NO.2 OR BETTER AT JOINT(S) V, M									
BRACING									
TOP CHORD TO BE SHEATHED OR MAX. PURLIN SPACING = 3.28 FT.									
MAX. UNBRACED BOTTOM CHORD LENGTH = 10.00 FT OR RIGID CEILING DIRECTLY APPLIED.									
ALL PITCH BREAKS AND PERIMETER CORNER JOINTS MUST BE LATERALLY RESTRAINED.									
LOADING									
TOTAL LOAD CASES: (4)									
CHORDS		FACTORED		WEBS		FACTORED			
MEMB.	FORCE (LBS)	VERT. LOAD (PLF)	LC1 MAX	MAX. MEMB. FORCE (LBS)	MEMB. FORCE (LBS)	MAX. FORCE (LBS)	MAX. FORCE (LBS)		
FR-TO		FROM	TO	LENGTH	FR-TO				
A - B	0 / 38	-124.4	-124.4	0.09 (1)	10.00	U - C	-1494 / 0	0.13 (1)	
B - C	-8671 / 0	-124.4	-124.4	0.25 (1)	3.61	C - T	0 / 1047	0.13 (1)	
C - D	-7606 / 0	-124.4	-124.4	0.28 (1)	3.38	T - D	-294 / 181	0.04 (1)	
D - E	-10121 / 0	-234.6	-234.6	0.52 (1)	3.47	D - S	0 / 4156	0.51 (1)	
E - F	-11106 / 0	-234.6	-234.6	0.55 (1)	3.29	S - E	-2104 / 0	0.28 (1)	
F - G	-11106 / 0	-234.6	-234.6	0.58 (1)	3.28	E - Q	0 / 1240	0.15 (1)	
G - H	-11106 / 0	-234.6	-234.6	0.58 (1)	3.28	Q - F	-1110 / 0	0.15 (1)	
H - I	-10094 / 0	-234.6	-234.6	0.52 (1)	3.47	Q - H	0 / 1274	0.18 (1)	
I - J	-7619 / 0	-124.4	-124.4	0.28 (1)	3.37	P - H	-2127 / 0	0.29 (1)	
J - K	-8666 / 0	-124.4	-124.4	0.25 (1)	3.62	P - I	0 / 4109	0.51 (1)	
K - L	0 / 38	-124.4	-124.4	0.09 (1)	10.00	O - I	-260 / 236	0.04 (1)	
V - B	-4982 / 0	0.0	0.0	0.18 (1)	6.52	O - J	0 / 1064	0.13 (1)	
M - K	-4979 / 0	0.0	0.0	0.18 (1)	6.52	N - J	-1510 / 0	0.14 (1)	
V - U	0 / 0	-74.0	-74.0	0.09 (2)	10.00	B - U	0 / 6197	0.77 (1)	
U - T	0 / 5973	-74.0	-74.0	0.83 (1)	10.00	N - K	0 / 6193	0.77 (1)	
T - S	0 / 6782	-74.0	-74.0	0.70 (1)	10.00				
S - R	0 / 10121	-74.0	-74.0	0.98 (1)	10.00				
R - Q	0 / 10121	-74.0	-74.0	0.98 (1)	10.00				
Q - P	0 / 10094	-74.0	-74.0	0.51 (1)	10.00				
P - O	0 / 6792	-74.0	-74.0	0.73 (1)	10.00				
O - N	0 / 5970	-74.0	-74.0	0.86 (1)	10.00				
N - M	0 / 0	-74.0	-74.0	0.09 (2)	10.00				
FACTORED CONCENTRATED LOADS (LBS)									
JT	LOC.	LC1	MAX.	MAX+	FACE	DIR.	TYPE	HEEL	CONN.
D	6-0-0	-560	-560	—	FRONT	VERT	TOTAL	—	C1
I	26-8-0	-560	-560	—	FRONT	VERT	TOTAL	—	C1

DESIGN CRITERIA	
SPECIFIED LOADS:	
TOP CH. LL = 34.8 PSF	
DL = 8.0 PSF	
BOT CH. LL = 10.5 PSF	
DL = 7.3 PSF	
TOTAL LOAD = 60.6 PSF	
SPACING = 24.0 IN. C/C	
LOADING IN FLAT SECTION BASED ON A SLOPE OF 2.00/12 MINIMUM	
GIRDER TYPE: CPrimeHip	
SIDE SETBACK = 6-0-0	
END SETBACK = 6-0-0	
END WALL WIDTH = 5-8	
CORNER FRAMING TYPE: CONVENTIONAL	
END JACK TYPE: CONVENTIONAL	
APPLIED TO FRONT SIDE	
- ADDTL LOADS BASED ON 55 % OF GSL	
THIS TRUSS IS DESIGNED FOR RESIDENTIAL OR SMALL BUILDING REQUIREMENTS OF PART 9, NBCC 2015	
THIS DESIGN COMPLIES WITH:	
- PART 9 OF BCBC 2018, ABC 2019	
- PART 9 OF OBC 2012 (2019 AMENDMENT)	
- CSA 086-14	
- TPIC 2014	
(55 % OF 48.1 P.S.F. G.S.L. PLUS 8.4 P.S.F. RAIN LOAD)	
EQUALS 34.8 P.S.F. SPECIFIED ROOF LIVE LOAD	
ALLOWABLE DEFL.(LL) = L/360 (1.09")	
CALCULATED VERT. DEFL.(LL) = L/969 (0.29")	
ALLOWABLE DEFL.(TL) = L/360 (1.09")	
CALCULATED VERT. DEFL.(TL) = L/798 (0.49")	
CSI: TC=0.56/1.00 (F-H:1), BC=0.98/1.00 (Q-S:1), WB=0.77/1.00 (B-U:1), SS=0.31/1.00 (H-I:1)	
DOL LUMBER=1.00 NAIL=1.00 LS BEND=1.00 COMP=1.00	
SHEAR=1.00 TENS=1.00	
COMPANION LIVE LOAD FACTOR = 1.00	
TRUSS PLATE MANUFACTURER IS NOT RESPONSIBLE FOR QUALITY CONTROL IN THE TRUSS MANUFACTURING PLANT	
NAIL VALUES	
PLATE GRIP(DRY) SHEAR SECTION	
(PSI) (PLI) (PLI)	
MAX MIN MAX MIN MAX MIN	
MT20 650 371 1747 788 1987 1873	
PLATE PLACEMENT TOL. = 0.250 inches	
PLATE ROTATION TOL. = 5.0 Deg.	
JSI GRIP= 0.90 (P) (INPUT = 0.90)	
JSI METAL = 0.97 (P) (INPUT = 1.00)	



READ ALL NOTES ON THIS PAGE AND ON ENGINEERING NOTE PAGE ENP-1. THIS NOTE PAGE IS AN INTEGRAL PART OF THIS DRAWING AS IT CONTAINS SPECIFICATIONS AND CRITERIA USED IN THE DESIGN OF THIS COMPONENT.

CONNECTION REQUIREMENTS

1) C1: A SUITABLE HANGER/MECHANICAL CONNECTION IS REQUIRED.



These plans have been reviewed for use with the corrections as noted. No other changes may be made without written approval of the Building Standards Branch. All work must comply with Zoning By-Law 2018-043, as amended, and the Ontario Building Code, as amended. These approved documents must be kept on site at all times. The building permit must be clearly posted on site at all times.

Discipline	Reviewer	BCIN	Date
Building Code	H. Authier	43236	2021-02-03
Seismic System			
Zoning			

CONTINUED ON PAGE 2



PLATES (table is in inches)					
JT	TYPE	PLATES	W	LEN	Y X
B	TMVW-p	MT20	4.0	10.0	1.00 5.00
C, E, H, J					
C	TMWW-t	MT20	3.0	5.0	
D	TTWW-m	MT20	6.0	8.0	2.25 2.75
F	TMW+w	MT20	2.0	4.0	
G	TS-t	MT20	3.0	8.0	
I	TTWW-m	MT20	6.0	8.0	2.25 2.75
K	TMVW-p	MT20	4.0	10.0	1.00 5.00
M	BMV1+p	MT20	3.0	4.0	
N	BMWW-t	MT20	4.0	8.0	2.00 2.75
O	BMWW-t	MT20	3.0	4.0	
P	BSWW-t	MT20	6.0	8.0	3.25 3.75
Q	BMWWW-t	MT20	3.0	8.0	
R	BS-t	MT20	6.0	8.0	
S	BMWW-t	MT20	4.0	5.0	1.50 1.75
T	BMWW-t	MT20	3.0	4.0	
U	BMWW-t	MT20	4.0	8.0	2.00 2.75
V	BMV1+p	MT20	3.0	4.0	

WB - INDICATES BLOCKING REQUIRED


READ ALL NOTES ON THIS PAGE AND ON
ENGINEERING NOTE PAGE ENP-1. THIS
NOTE PAGE IS AN INTEGRAL PART OF
THIS DRAWING AS IT CONTAINS
SPECIFICATIONS AND CRITERIA USED IN
THE DESIGN OF THIS COMPONENT.



These plans have been reviewed for use with the corrections as noted. No other changes may be made without written approval of the Building Standards Branch. All work must comply with Zoning By-Law 2018-043, as amended, and the Ontario Building Code, as amended. These approved documents must be kept on site at all times. The building permit must be clearly posted on site at all times.

Discipline	Reviewer	BCIN	Date
Building Code	H. Authier	43236	2021-02-03
Sewage System			
Zoning			



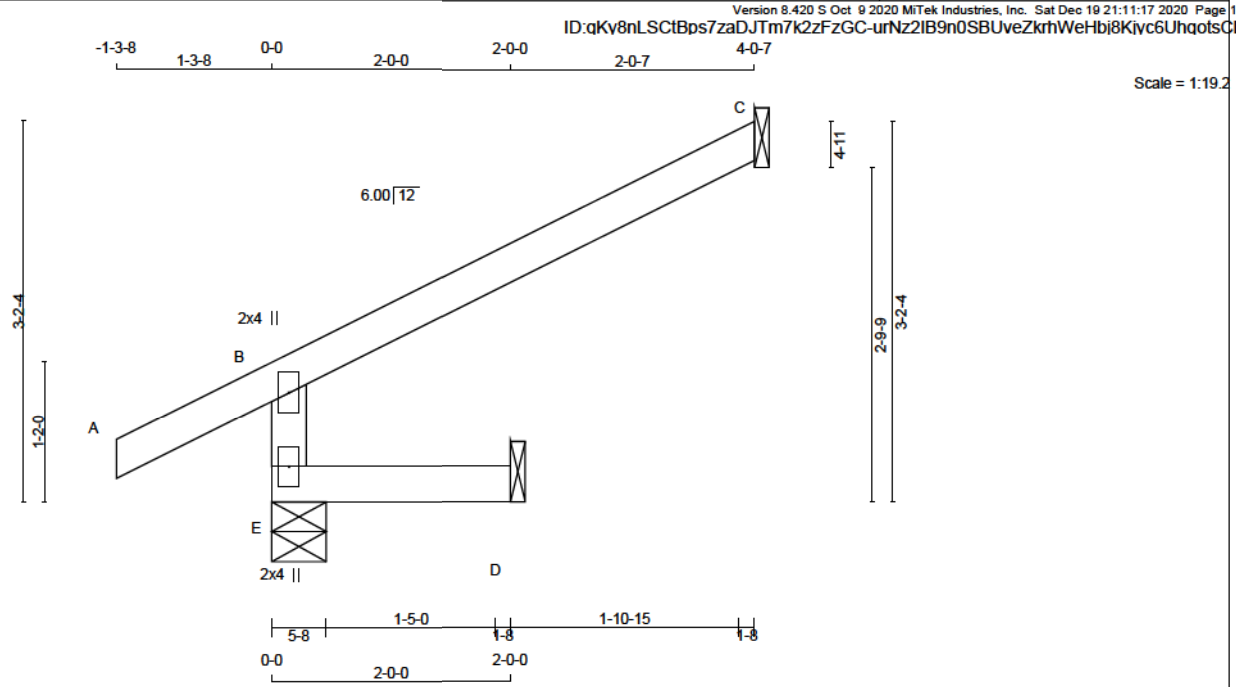

LUMBER
N. L. G. A. RULES

CHORDS	SIZE	LUMBER	DESCR.
E - B	2x4	DRY	No.2
A - C	2x4	DRY	No.2
E - D	2x4	DRY	No.2

DRY: SEASONED LUMBER.

PLATES (table is in inches)

JT	TYPE	PLATES	W	LEN	Y	X
B	TMV+p	MT20	2.0	4.0		
E	BMV1+p	MT20	2.0	4.0		

DIMENSIONS, SUPPORTS AND LOADINGS SPECIFIED BY FABRICATOR TO BE VERIFIED BY BUILDING DESIGNER

BEARINGS

	FACTORED GROSS REACTION	MAXIMUM FACTORED GROSS REACTION	INPUT BRG	REQRD BRG
JT	VERT	HORZ	DOWN	HORZ
E	528	0	528	0
C	188	0	188	0
D	35	0	44	0

SEE MITEK STANDARD DETAIL B97791H FOR CONNECTION TO JOINT(S) C, D

UNFACTORED REACTIONS

JT	1ST CASE	SNOW	LIVE	PERM. LIVE	WIND	DEAD	SOIL
E	372	270 / 0	23 / 0	0 / 0	0 / 0	78 / 0	0 / 0
C	130	105 / 0	0 / 0	0 / 0	0 / 0	24 / 0	0 / 0
D	32	0 / 0	19 / 0	0 / 0	0 / 0	13 / 0	0 / 0

BEARING MATERIAL TO BE SPF NO.2 OR BETTER AT JOINT(S) E

BRACING
TOP CHORD TO BE SHEATHED OR MAX. PURLIN SPACING = 8.25 FT.
MAX. UNBRACED BOTTOM CHORD LENGTH = 10.00 FT OR RIGID CEILING DIRECTLY APPLIED.

ALL PITCH BREAKS AND PERIMETER CORNER JOINTS MUST BE LATERALLY RESTRAINED.

LOADING
TOTAL LOAD CASES: (4)

CHORDS				WEBS			
MEMB.	MAX. FACTORED FORCE (LBS)	FACTORED VERT. LOAD (PLF)	FACTORED LC1 MAX. CSI (LC)	MEMB.	MAX. FACTORED FORCE (LBS)	MAX. FACTORED CSI (LC)	UNBRACED LENGTH
FR-TO		FROM TO		FR-TO			
E-B	-483 / 0	0.0	0.0 0.02 (3)	7.81			
A-B	0 / 38	-124.4	-124.4 0.16 (1)	10.00			
B-C	-28 / 0	-124.4	-124.4 0.34 (1)	6.25			
E-D	0 / 0	-39.2	-39.2 0.03 (3)	10.00			

DESIGN CRITERIA

SPECIFIED LOADS:
TOP CH. LL = 34.8 PSF
DL = 8.0 PSF
BOT CH. LL = 10.5 PSF
DL = 7.3 PSF
TOTAL LOAD = 60.6 PSF

SPACING = 24.0 IN. C/C

THIS TRUSS IS DESIGNED FOR RESIDENTIAL OR SMALL BUILDING REQUIREMENTS OF PART 9, NBCC 2015

THIS DESIGN COMPLIES WITH:
- PART 9 OF BCBC 2018, ABC 2019
- PART 9 OF OBC 2012 (2019 AMENDMENT)
- CSA 088-14
- TPIC 2014

DESIGN ASSUMPTIONS
- OVERHANG NOT TO BE ALTERED OR CUT OFF.

(55 % OF 48.1 P.S.F. G.S.L. PLUS 8.4 P.S.F. RAIN LOAD)
EQUALS 34.8 P.S.F. SPECIFIED ROOF LIVE LOAD

ALLOWABLE DEFL.(LL)= L/360 (0.19")
CALCULATED VERT. DEFL.(LL) = L/999 (0.00")
ALLOWABLE DEFL.(TL)= L/360 (0.19")
CALCULATED VERT. DEFL.(TL) = L/999 (0.00")

CSI: TC=0.34/1.00 (B-C:1) , BC=0.03/1.00 (D-E:3) , WB=0.00/1.00 (n/a:0) , SSI=0.22/1.00 (B-C:1)

DOL LUMBER=1.00 NAIL=1.00 LS BEND=1.10 COMP=1.10
SHEAR=1.10 TENS=1.10

COMPANION LIVE LOAD FACTOR = 1.00

TRUSS PLATE MANUFACTURER IS NOT RESPONSIBLE FOR QUALITY CONTROL IN THE TRUSS MANUFACTURING PLANT .

NAIL VALUES
PLATE GRIP(DRY) SHEAR SECTION (PSI) (PLI) (PLI)
MAX MIN MAX MIN MAX MIN
MT20 650 371 1747 788 1987 1873

PLATE PLACEMENT TOL. = 0.250 inches

PLATE ROTATION TOL. = 5.0 Deg.

JSI GRIP= 0.27 (B) (INPUT = 0.90)
JSI METAL= 0.20 (B) (INPUT = 1.00)



READ ALL NOTES ON THIS PAGE AND ON ENGINEERING NOTE PAGE ENP-1. THIS NOTE PAGE IS AN INTEGRAL PART OF THIS DRAWING AS IT CONTAINS SPECIFICATIONS AND CRITERIA USED IN THE DESIGN OF THIS COMPONENT.




These plans have been reviewed for use with the corrections as noted. No other changes may be made without written approval of the Building Standards Branch. All work must comply with Zoning By-Law 2018-043, as amended, and the Ontario Building Code, as amended. These approved documents must be kept on site at all times. The building permit must be clearly posted on site at all times.

Discipline	Reviewer	BCIN	Date
Building Code	H. Authier	43236	2021-02-03
Sewage System			
Zoning			



Scale = 1:14.0

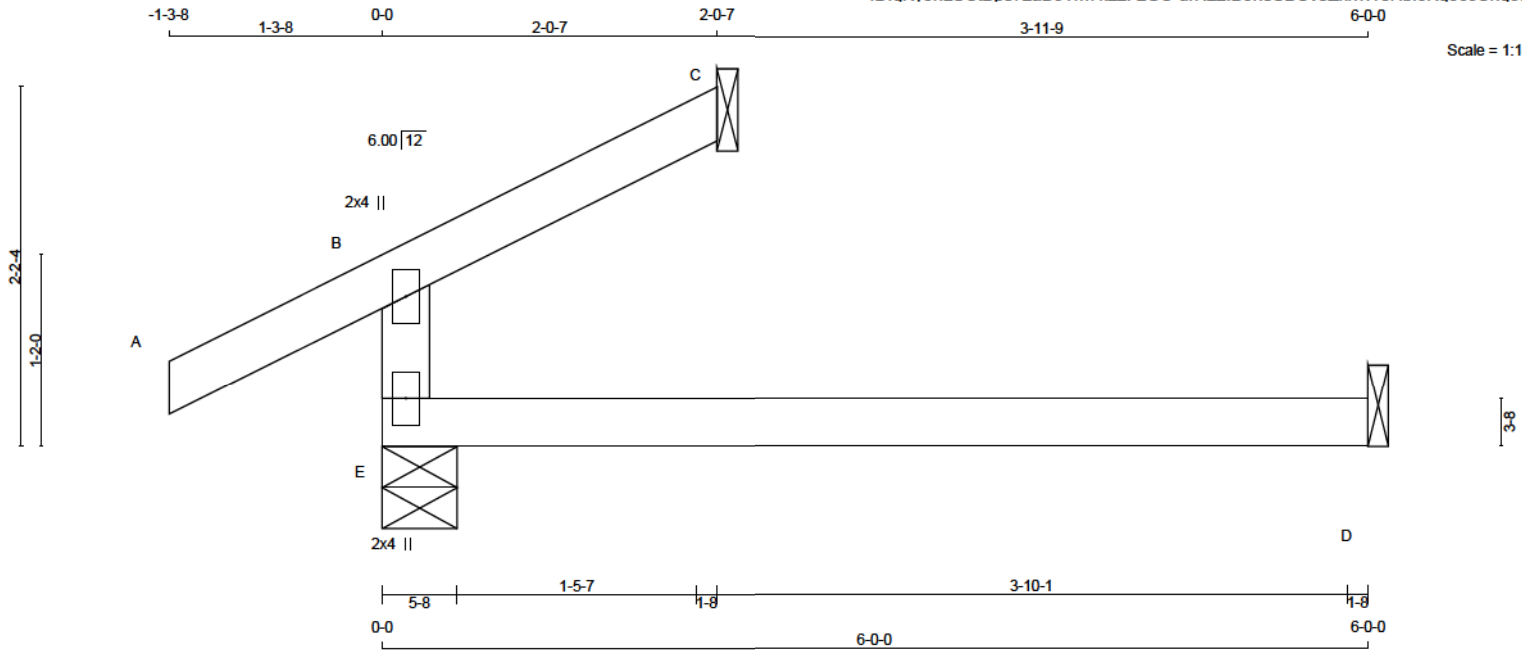

TOTAL WEIGHT = 2 X 12 = 24 LB

LUMBER					DESCR.
N. L. G. A. RULES	CHORDS	SIZE	LUMBER		
E - B	2x4	DRY	No.2		SPF
A - C	2x4	DRY	No.2		SPF
E - D	2x4	DRY	No.2		SPF

DRY: SEASONED LUMBER.

PLATES (table is in inches)					
JT	TYPE	PLATES	W	LEN	Y X
B	TMV+p	MT20	2.0	4.0	
E	BMV1+p	MT20	2.0	4.0	

DIMENSIONS, SUPPORTS AND LOADINGS SPECIFIED BY FABRICATOR TO BE VERIFIED BY BUILDING DESIGNER

BEARINGS									
		FACTORED GROSS REACTION		MAXIMUM FACTORED GROSS REACTION		INPUT BRG		REQRD BRG	
JT	VERT	HORZ	DOWN	HORZ	UPLIFT	IN-SX	IN-SX	IN-SX	IN-SX
E	485	0	485	0	0	5-8	1-8	1-8	1-8
C	96	0	96	0	0	1-8	1-8	1-8	1-8
D	97	0	123	0	0	1-8	1-8	1-8	1-8

SEE MITEK STANDARD DETAIL B97791H FOR CONNECTION TO JOINT(S) C, D

UNFACTORED REACTIONS							
JT	1ST LCASE	MAX	MIN	COMPONENT	REACTIONS		
E	COMBINED	SNOW	LIVE	PERM.LIVE	WIND	DEAD	SOIL
E	350	183 / 0	74 / 0	0 / 0	0 / 0	93 / 0	0 / 0
C	86	54 / 0	0 / 0	0 / 0	0 / 0	12 / 0	0 / 0
D	88	0 / 0	52 / 0	0 / 0	0 / 0	36 / 0	0 / 0

BEARING MATERIAL TO BE SPF NO.2 OR BETTER AT JOINT(S) E, C

BRACING

TOP CHORD TO BE SHEATHED OR MAX. PURLIN SPACING = 8.25 FT.
MAX. UNBRACED BOTTOM CHORD LENGTH = 10.00 FT OR RIGID CEILING DIRECTLY APPLIED.

ALL PITCH BREAKS AND PERIMETER CORNER JOINTS MUST BE LATERALLY RESTRAINED.

LOADING

TOTAL LOAD CASES: (4)

CHORDS				WEBS			
MEMB.	MAX. FACTORED FORCE (LBS)	FACTORED VERT. LOAD (PLF)	FACTORED LC1 MAX. CSI (LC)	MEMB.	MAX. FACTORED FORCE (LBS)	MAX. FACTORED CSI (LC)	
FR-TO		FROM TO		FR-TO			
E-B	-327 / 0	0.0	0.0 0.22 (3)	7.81			
A-B	0 / 38	-124.4	-124.4 0.16 (1)	10.00			
B-C	-14 / 0	-124.4	-124.4 0.09 (1)	6.25			
E-D	0 / 0	-39.2	-39.2 0.22 (3)	10.00			

DESIGN CRITERIA

SPECIFIED LOADS:

TOP CH.	LL = 34.8	PSF
	DL = 8.0	PSF
BOT CH.	LL = 10.5	PSF
	DL = 7.3	PSF
TOTAL LOAD	= 60.6	PSF

SPACING = 24.0 IN. C/C

THIS TRUSS IS DESIGNED FOR RESIDENTIAL OR SMALL BUILDING REQUIREMENTS OF PART 9, NBCC 2015

THIS DESIGN COMPLIES WITH:

- PART 9 OF BCBC 2018, ABC 2019
- PART 9 OF OBC 2012 (2019 AMENDMENT)
- CSA 086-14
- TPIC 2014

DESIGN ASSUMPTIONS

-OVERHANG NOT TO BE ALTERED OR CUT OFF.

(55 % OF 48.1 P.S.F. G.S.L. PLUS 8.4 P.S.F. RAIN LOAD)
EQUALS 34.8 P.S.F. SPECIFIED ROOF LIVE LOAD

ALLOWABLE DEFL.(LL)= L/360 (0.20")
CALCULATED VERT. DEFL.(LL) = L/ 999 (0.05")
ALLOWABLE DEFL.(TL)= L/360 (0.20")
CALCULATED VERT. DEFL.(TL) = L/ 874 (0.08")

CSI: TC=0.22/1.00 (B-E:3) , BC=0.22/1.00 (D-E:3) ,
WB=0.00/1.00 (n/a:0) , SSI=0.14/1.00 (D-E:3)

DOL LUMBER=1.00 NAIL=1.00 LS BEND=1.10 COMP=1.10
SHEAR=1.10 TENS=1.10

COMPANION LIVE LOAD FACTOR = 1.00

TRUSS PLATE MANUFACTURER IS NOT RESPONSIBLE FOR QUALITY CONTROL IN THE TRUSS MANUFACTURING PLANT .

NAIL VALUES

PLATE	GRIP(DRY)	SHEAR	SECTION
	(PSI)	(PLI)	(PLI)
MT20	650	371	1747
	788	1987	1873

PLATE PLACEMENT TOL. = 0.250 inches

PLATE ROTATION TOL. = 5.0 Deg.

JSI GRIP= 0.18 (B) (INPUT = 0.90)

JSI METAL= 0.14 (B) (INPUT = 1.00)




These plans have been reviewed for use with the corrections as noted. No other changes may be made without written approval of the Building Standards Branch. All work must comply with Zoning By-Law 2018-043, as amended, and the Ontario Building Code, as amended. These approved documents must be kept on site at all times. The building permit must be clearly posted on site at all times.

Discipline	Reviewer	BCIN	Date
Building Code	H. Authier	43236	2021-02-03
Sewage System			
Zoning			



READ ALL NOTES ON THIS PAGE AND ON ENGINEERING NOTE PAGE ENP-1. THIS NOTE PAGE IS AN INTEGRAL PART OF THIS DRAWING AS IT CONTAINS SPECIFICATIONS AND CRITERIA USED IN THE DESIGN OF THIS COMPONENT.

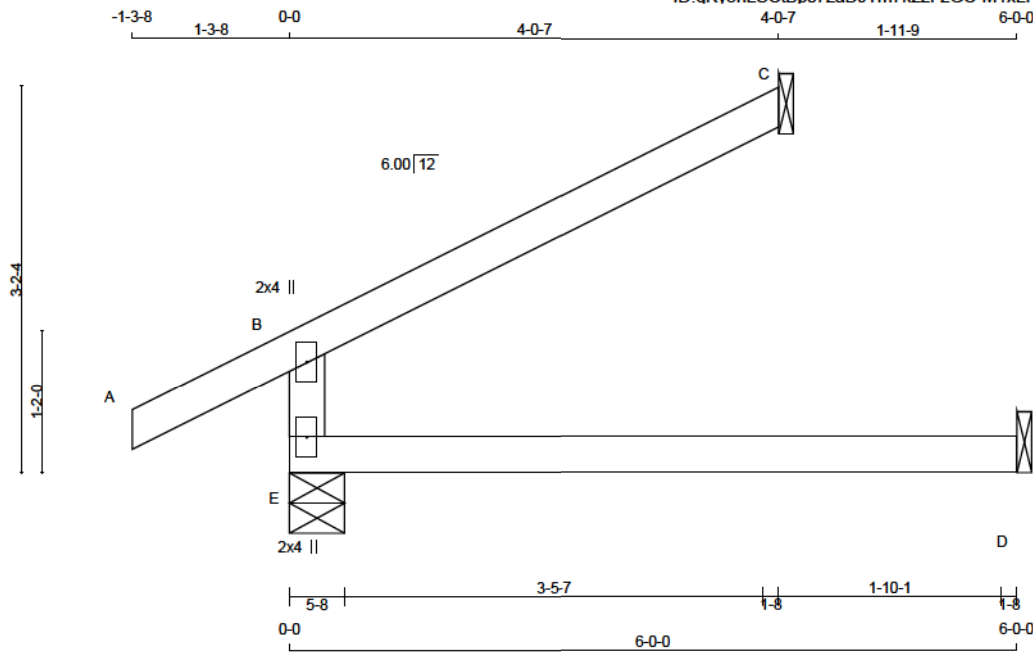

TOTAL WEIGHT = 2 X 15 = 29 lb

LUMBER				DESCR.
N. L. G. A. RULES	CHORDS	SIZE	LUMBER	
E - B	2x4	DRY	No.2	SPF
A - C	2x4	DRY	No.2	SPF
E - D	2x4	DRY	No.2	SPF

DRY: SEASONED LUMBER.

PLATES (table is in inches)				
JT	TYPE	PLATES	W	LEN Y X
B	TMV+p	MT20	2.0	4.0
E	BMV1+p	MT20	2.0	4.0

DIMENSIONS, SUPPORTS AND LOADINGS SPECIFIED BY FABRICATOR TO BE VERIFIED BY BUILDING DESIGNER

BEARINGS

JT	FACTORED GROSS REACTION		MAXIMUM FACTORED GROSS REACTION		INPUT BRG	REQRD BRG
	VERT	HORZ	DOWN	HORZ		
E	621	0	621	0	5-8	1-8
C	188	0	188	0	1-8	1-8
D	97	0	123	0	1-8	1-8

SEE MITEK STANDARD DETAIL B97791H FOR CONNECTION TO JOINT(S) C, D

UNFACTORED REACTIONS

1ST LCASE		MAX / MIN COMPONENT REACTIONS					
JT	COMBINED	SNOW	LIVE	PERM.LIVE	WIND	DEAD	SOIL
E	458	270 / 0	74 / 0	0 / 0	0 / 0	114 / 0	0 / 0
C	130	105 / 0	0 / 0	0 / 0	0 / 0	24 / 0	0 / 0
D	88	0 / 0	52 / 0	0 / 0	0 / 0	36 / 0	0 / 0

BEARING MATERIAL TO BE SPF NO.2 OR BETTER AT JOINT(S) E, C

BRACING

TOP CHORD TO BE SHEATHED OR MAX. PURLIN SPACING = 8.25 FT.
MAX. UNBRACED BOTTOM CHORD LENGTH = 10.00 FT OR RIGID CEILING DIRECTLY APPLIED.

ALL PITCH BREAKS AND PERIMETER CORNER JOINTS MUST BE Laterally RESTRAINED.

LOADING

TOTAL LOAD CASES: (4)

MEMB.	C H O R D S			W E B S		
	MAX. FACTORED FORCE (LBS)	FACTORED VERT. LOAD (PLF)	FACTORED L1 MAX. CSI (LC)	MEMB. MAX. FACTORED FORCE (LBS)	MAX. FACTORED FORCE (LBS)	MAX. FACTORED CSI (LC)
FR-TO		FROM TO	LENGTH	FR-TO		
E-B	-483 / 0	0.0	0.0 0.23 (3)	7.81		
A-B	0 / 38	-124.4	-124.4 0.16 (1)	10.00		
B-C	-28 / 0	-124.4	-124.4 0.34 (1)	6.25		
E-D	0 / 0	-39.2	-39.2 0.23 (3)	10.00		

DESIGN CRITERIA

SPECIFIED LOADS:

TOP CH. LL = 34.8 PSF
DL = 8.0 PSF
BOT CH. LL = 10.5 PSF
DL = 7.3 PSF
TOTAL LOAD = 60.6 PSF

SPACING = 24.0 IN. C/C

THIS TRUSS IS DESIGNED FOR RESIDENTIAL OR SMALL BUILDING REQUIREMENTS OF PART 9, NBCC 2015

THIS DESIGN COMPLIES WITH:

- PART 9 OF BCBC 2018, ABC 2019
- PART 9 OF OBC 2012 (2019 AMENDMENT)
- CSA 088-14
- TPIC 2014

DESIGN ASSUMPTIONS

-OVERHANG NOT TO BE ALTERED OR CUT OFF.

(55 % OF 48.1 P.S.F. G.S.L. PLUS 8.4 P.S.F. RAIN LOAD)
EQUALS 34.8 P.S.F. SPECIFIED ROOF LIVE LOAD

ALLOWABLE DEFL.(LL)= L/360 (0.20")
CALCULATED VERT. DEFL.(LL) = L/ 999 (0.05")
ALLOWABLE DEFL.(TL)= L/360 (0.20")
CALCULATED VERT. DEFL.(TL) = L/ 874 (0.08")

CSI: TC=0.34/1.00 (B-C:1) , BC=0.23/1.00 (D-E:3) ,
WB=0.00/1.00 (n/a:0) , SSI=0.22/1.00 (B-C:1)

DOL LUMBER=1.00 NAIL=1.00 LS BEND=1.10 COMP=1.10
SHEAR=1.10 TENS= 1.10

COMPANION LIVE LOAD FACTOR = 1.00

TRUSS PLATE MANUFACTURER IS NOT RESPONSIBLE FOR QUALITY CONTROL IN THE TRUSS MANUFACTURING PLANT .

NAIL VALUES

PLATE GRIP(DRY) SHEAR SECTION
(PSI) (PLI)
MAX MIN MAX MIN MAX MIN
MT20 650 371 1747 788 1987 1873

PLATE PLACEMENT TOL = 0.250 inches

PLATE ROTATION TOL = 5.0 Deg.

JSI GRIP= 0.27 (B) (INPUT = 0.90)
JSI METAL= 0.20 (B) (INPUT = 1.00)




READ ALL NOTES ON THIS PAGE AND ON ENGINEERING NOTE PAGE ENP-1. THIS NOTE PAGE IS AN INTEGRAL PART OF THIS DRAWING AS IT CONTAINS SPECIFICATIONS AND CRITERIA USED IN THE DESIGN OF THIS COMPONENT.



These plans have been reviewed for use with the corrections as noted. No other changes may be made without written approval of the Building Standards Branch. All work must comply with Zoning By-Law 2018-043, as amended, and the Ontario Building Code, as amended. These approved documents must be kept on site at all times. The building permit must be clearly posted on site at all times.

Discipline	Reviewer	BCIN	Date
Building Code	H. Authier	43236	2021-02-03
Sewage System			
Zoning			



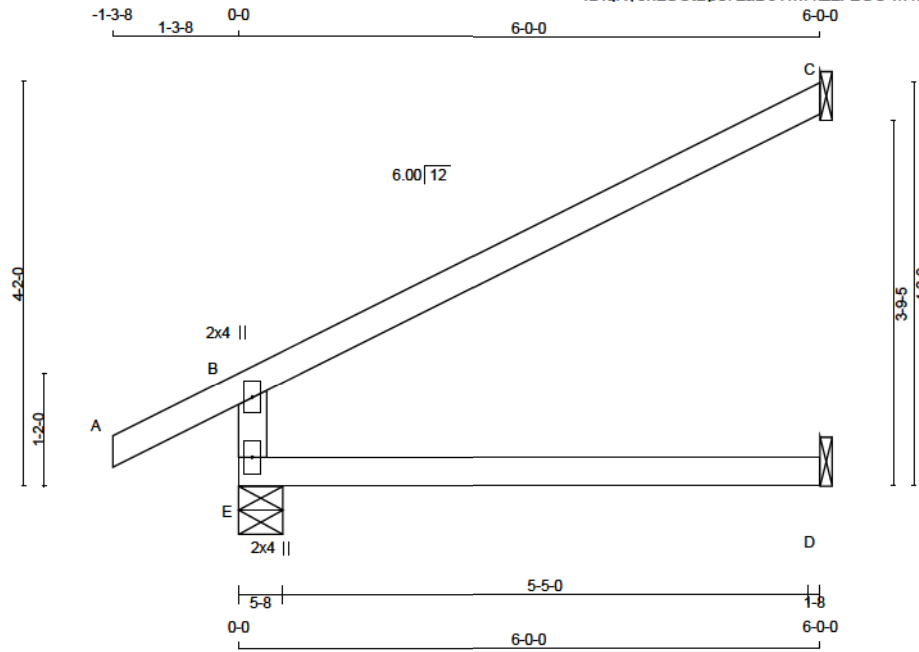

Scale = 1:23.7

TOTAL WEIGHT = 12 X 17 = 205 lb

LUMBER					DESCR.
N. L. G. A. RULES	CHORDS	SIZE	LUMBER		
E - B	2x4	DRY	No.2		SPF
A - C	2x4	DRY	No.2		SPF
E - D	2x4	DRY	No.2		SPF

DRY: SEASONED LUMBER.

PLATES (table is in inches)					
JT	TYPE	PLATES	W	LEN	Y X
B	TMV+p	MT20	2.0	4.0	
E	BMV1+p	MT20	2.0	4.0	

DIMENSIONS, SUPPORTS AND LOADINGS SPECIFIED BY FABRICATOR TO BE VERIFIED BY BUILDING DESIGNER

BEARINGS		FACTORED GROSS REACTION	MAXIMUM FACTORED GROSS REACTION	INPUT BRG	REQRD BRG
JT	VERT	HORZ	DOWN	HORZ	UPLIFT IN-SX
E	774	0	774	0	5-8
C	280	0	280	0	1-8
D	97	0	123	0	1-8

SEE MITEK STANDARD DETAIL B97791H FOR CONNECTION TO JOINT(S) C, D

UNFACTORED REACTIONS		1ST LCASE	MAX / MIN	COMPONENT REACTIONS
JT	COMBINED	SNOW	LIVE	PERM. LIVE
E	563	355 / 0	74 / 0	0 / 0
C	193	157 / 0	0 / 0	0 / 0
D	88	0 / 0	52 / 0	0 / 0

BEARING MATERIAL TO BE SPF NO.2 OR BETTER AT JOINT(S) E

BRACING
TOP CHORD TO BE SHEATHED OR MAX. PURLIN SPACING = 8.25 FT.
MAX. UNBRACED BOTTOM CHORD LENGTH = 10.00 FT OR RIGID CEILING DIRECTLY APPLIED.

ALL PITCH BREAKS AND PERIMETER CORNER JOINTS MUST BE LATERALLY RESTRAINED.

LOADING
TOTAL LOAD CASES: (4)

CHORDS		WEBS	
MEMB.	MAX. FACTORED FORCE (LBS)	MEMB.	MAX. FACTORED FORCE (LBS)
FR-TO		FR-TO	

DESIGN CRITERIA

SPECIFIED LOADS:
TOP CH. LL = 34.8 PSF
DL = 8.0 PSF
BOT CH. LL = 10.5 PSF
DL = 7.3 PSF
TOTAL LOAD = 60.6 PSF

SPACING = 24.0 IN. C/C

THIS TRUSS IS DESIGNED FOR RESIDENTIAL OR SMALL BUILDING REQUIREMENTS OF PART 9, NBCC 2015

THIS DESIGN COMPLIES WITH:
- PART 9 OF BCBC 2018, ABC 2019
- PART 9 OF OBC 2012 (2019 AMENDMENT)
- CSA 086-14
- TPIC 2014

DESIGN ASSUMPTIONS
- OVERHANG NOT TO BE ALTERED OR CUT OFF.

(55 % OF 48.1 P.S.F. G.S.L. PLUS 8.4 P.S.F. RAIN LOAD)
EQUALS 34.8 P.S.F. SPECIFIED ROOF LIVE LOAD

ALLOWABLE DEFL.(LL)= L/360 (0.20")
CALCULATED VERT. DEFL.(LL) = L/999 (0.05")
ALLOWABLE DEFL.(TL)= L/360 (0.20")
CALCULATED VERT. DEFL.(TL) = L/874 (0.08")

CSI: TC=0.76/1.00 (B-C:1) , BC=0.24/1.00 (D-E:3) ,
WB=0.00/1.00 (n/a:0) , SSI=0.33/1.00 (B-C:1)

DOL LUMBER=1.00 NAIL=1.00 LS BEND=1.10 COMP=1.10
SHEAR=1.10 TENS=1.10

COMPANION LIVE LOAD FACTOR = 1.00

TRUSS PLATE MANUFACTURER IS NOT RESPONSIBLE FOR QUALITY CONTROL IN THE TRUSS MANUFACTURING PLANT .

NAIL VALUES
PLATE GRIP(DRY) SHEAR SECTION
(PSI) (PLI) (PLI)
MAX MIN MAX MIN MAX MIN
MT20 650 371 1747 788 1987 1873

PLATE PLACEMENT TOL. = 0.250 inches

PLATE ROTATION TOL. = 5.0 Deg.

JSI GRIP= 0.36 (B) (INPUT = 0.90)
JSI METAL = 0.26 (B) (INPUT = 1.00)




READ ALL NOTES ON THIS PAGE AND ON ENGINEERING NOTE PAGE ENP-1. THIS NOTE PAGE IS AN INTEGRAL PART OF THIS DRAWING AS IT CONTAINS SPECIFICATIONS AND CRITERIA USED IN THE DESIGN OF THIS COMPONENT.



These plans have been reviewed for use with the corrections as noted. No other changes may be made without written approval of the Building Standards Branch. All work must comply with Zoning By-Law 2018-043, as amended, and the Ontario Building Code, as amended. These approved documents must be kept on site at all times. The building permit must be clearly posted on site at all times.

Discipline	Reviewer	BCIN	Date
Building Code	H. Authier	43236	2021-02-03
Sewage System			
Zoning			



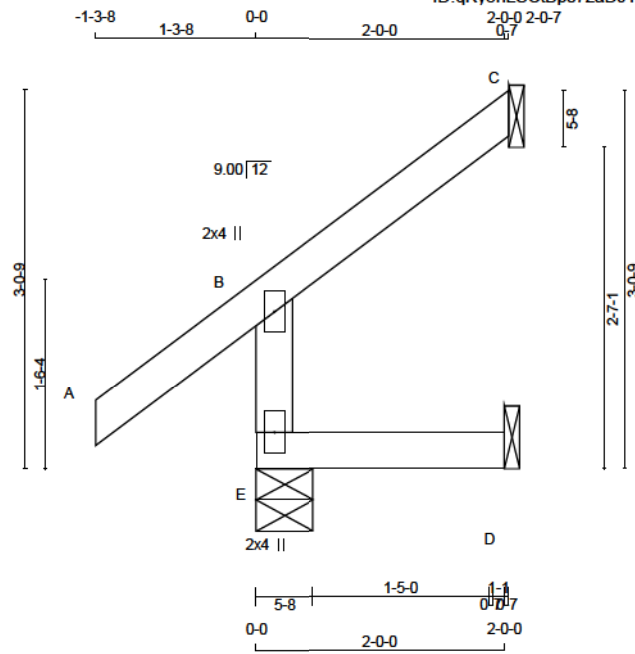

LUMBER			
N. L. G. A. RULES			
CHORDS	SIZE	LUMBER	DESCR.
E - B	2x4	DRY	No.2
A - C	2x4	DRY	No.2
E - D	2x4	DRY	No.2

DRY: SEASONED LUMBER.

PLATES (table is in inches)				
JT	TYPE	PLATES	W	LEN Y X
B	TMV+p	MT20	2.0	4.0
E	BMV1+p	MT20	2.0	4.0

DIMENSIONS, SUPPORTS AND LOADINGS SPECIFIED BY FABRICATOR TO BE VERIFIED BY BUILDING DESIGNER

BEARINGS		FACTORED GROSS REACTION	MAXIMUM FACTORED GROSS REACTION	INPUT BRG	REQD BRG
JT	VERT	HORZ	DOWN	HORZ	UPLIFT IN-SX
E	372	0	372	0	5-8
C	96	0	96	0	1-8
D	36	0	45	0	1-8

SEE MITEK STANDARD DETAIL B97791H FOR CONNECTION TO JOINT(S) C, D

UNFACTORED REACTIONS		1ST LCASE	MAX	MIN	COMPONENT REACTIONS
JT	COMBINED	SNOW	LIVE	PERM.LIVE	WIND DEAD SOIL
E	265	184 / 0	23 / 0	0 / 0	0 / 0 58 / 0 0 / 0
C	86	54 / 0	0 / 0	0 / 0	0 / 0 12 / 0 0 / 0
D	32	0 / 0	19 / 0	0 / 0	0 / 0 13 / 0 0 / 0

BEARING MATERIAL TO BE SPF NO.2 OR BETTER AT JOINT(S) E

BRACING
TOP CHORD TO BE SHEATHED OR MAX. PURLIN SPACING = 8.25 FT.
MAX. UNBRACED BOTTOM CHORD LENGTH = 10.00 FT OR RIGID CEILING DIRECTLY APPLIED.

ALL PITCH BREAKS AND PERIMETER CORNER JOINTS MUST BE Laterally RESTRAINED.

LOADING
TOTAL LOAD CASES: (5)

CHORDS		WEBS	
MEMB.	MAX. FACTORED FORCE (LBS)	MAX. FACTORED VERT. LOAD (PLF)	MAX. FACTORED HORZ. LOAD (LC)
FR-TO		FROM TO	LENGTH
E-B	-329 / 0	0.0 0.0 0.01 (3)	7.81
A-B	0 / 51	-124.4 -124.4 0.17 (1)	10.00
B-C	-18 / 0	-124.4 -124.4 0.09 (1)	6.25
E-D	0 / 0	-39.2 -39.2 0.03 (3)	10.00

CANTILEVER ANALYSIS HAS BEEN CONSIDERED IN THIS DESIGN

DESIGN CRITERIA

SPECIFIED LOADS:
TOP CH. LL = 34.8 PSF
DL = 8.0 PSF
BOT CH. LL = 10.5 PSF
DL = 7.3 PSF
TOTAL LOAD = 60.6 PSF

SPACING = 24.0 IN. C/C

THIS TRUSS IS DESIGNED FOR RESIDENTIAL OR SMALL BUILDING REQUIREMENTS OF PART 9, NBCC 2015

THIS DESIGN COMPLIES WITH:
- PART 9 OF BCBC 2018, ABC 2019
- PART 9 OF OBC 2012 (2019 AMENDMENT)
- CSA 086-14
- TPIC 2014

DESIGN ASSUMPTIONS
- OVERHANG NOT TO BE ALTERED OR CUT OFF.

(55 % OF 48.1 P.S.F. G.S.L. PLUS 8.4 P.S.F. RAIN LOAD)
EQUALS 34.8 P.S.F. SPECIFIED ROOF LIVE LOAD

ALLOWABLE DEFL.(LL)= L/360 (0.19")
CALCULATED VERT. DEFL.(LL) = L/999 (0.00")
ALLOWABLE DEFL.(TL)= L/360 (0.19")
CALCULATED VERT. DEFL.(TL) = L/999 (0.00")

CSI: TC=0.17/1.00 (A-B:1) . BC=0.03/1.00 (D-E:3) .
WB=0.00/1.00 (n/a:0) . SSI=0.11/1.00 (A-B:1)

DOL LUMBER=1.00 NAIL=1.00 LS BEND=1.10 COMP=1.10
SHEAR=1.10 TENS=1.10

COMPANION LIVE LOAD FACTOR = 1.00

TRUSS PLATE MANUFACTURER IS NOT RESPONSIBLE FOR QUALITY CONTROL IN THE TRUSS MANUFACTURING PLANT .

NAIL VALUES
PLATE GRIP(DRY) SHEAR SECTION
(PSI) (PLI) (PLI)
MAX MIN MAX MIN MAX MIN
MT20 650 371 1747 788 1987 1873

PLATE PLACEMENT TOL. = 0.250 inches

PLATE ROTATION TOL. = 5.0 Deg.

JSI GRIP= 0.21 (B) (INPUT = 0.90)
JSI METAL= 0.17 (B) (INPUT = 1.00)




READ ALL NOTES ON THIS PAGE AND ON ENGINEERING NOTE PAGE ENP-1. THIS NOTE PAGE IS AN INTEGRAL PART OF THIS DRAWING AS IT CONTAINS SPECIFICATIONS AND CRITERIA USED IN THE DESIGN OF THIS COMPONENT.



These plans have been reviewed for use with the corrections as noted. No other changes may be made without written approval of the Building Standards Branch. All work must comply with Zoning By-Law 2018-043, as amended, and the Ontario Building Code, as amended. These approved documents must be kept on site at all times. The building permit must be clearly posted on site at all times.

Discipline	Reviewer	BCIN	Date
Building Code	H. Authier	43236	2021-02-03
Sewage System			
Zoning			



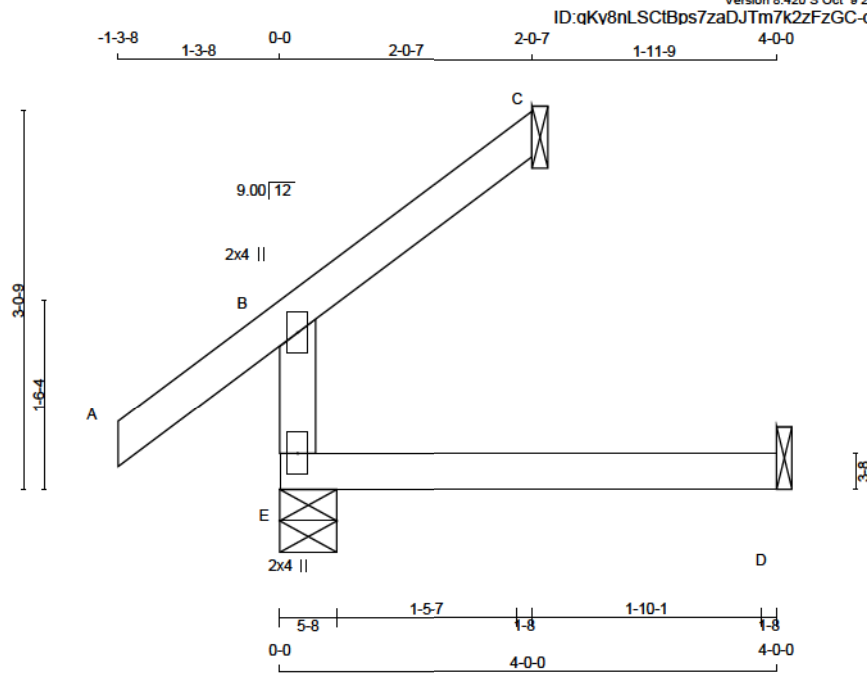

LUMBER
N. L. G. A. RULES

CHORDS	SIZE	LUMBER	DESCR.
E - B	2x4	DRY	No.2
A - C	2x4	DRY	No.2
E - D	2x4	DRY	No.2

SPF
SPF
SPF

DRY: SEASONED LUMBER.

PLATES (table is in inches)

JT	TYPE	PLATES	W	LEN	Y	X
B	TMV+p	MT20	2.0	4.0		
E	BMV1+p	MT20	2.0	4.0		

DIMENSIONS, SUPPORTS AND LOADINGS SPECIFIED BY FABRICATOR TO BE VERIFIED BY BUILDING DESIGNER

BEARINGS

	FACTORED GROSS REACTION	MAXIMUM FACTORED GROSS REACTION	INPUT BRG	REQD BRG
JT	VERT	HORZ	DOWN	HORZ
E	418	0	418	0
C	96	0	96	0
D	68	0	68	0

SEE MITEK STANDARD DETAIL B97791H FOR CONNECTION TO JOINT(S) C, D

UNFACTORED REACTIONS

JT	1ST LCASE	MAX	MIN	COMPONENT REACTIONS
JT	COMBINED	SNOW	LIVE	PERM. LIVE
E	307	184 / 0	48 / 0	0 / 0
C	66	54 / 0	0 / 0	0 / 0
D	62	0 / 0	36 / 0	0 / 0

BEARING MATERIAL TO BE SPF NO.2 OR BETTER AT JOINT(S) E, C

BRACING
TOP CHORD TO BE SHEATHED OR MAX. PURLIN SPACING = 8.25 FT.
MAX. UNBRACED BOTTOM CHORD LENGTH = 10.00 FT OR RIGID CEILING DIRECTLY APPLIED.

ALL PITCH BREAKS AND PERIMETER CORNER JOINTS MUST BE LATERALLY RESTRAINED.

LOADING
TOTAL LOAD CASES: (4)

CHORDS				WEBS			
MEMB.	MAX. FACTORED FORCE (LBS)	FACTORED VERT. LOAD (PLF)	FACTORED HORZ. LOAD (LC)	MEMB.	MAX. FACTORED FORCE (LBS)	FACTORED VERT. LOAD (PLF)	FACTORED HORZ. LOAD (LC)
FR-TO		FROM TO		FR-TO		FROM TO	

DESIGN CRITERIA

SPECIFIED LOADS:
TOP CH. LL = 34.8 PSF
DL = 8.0 PSF
BOT CH. LL = 10.5 PSF
DL = 7.3 PSF
TOTAL LOAD = 60.6 PSF

SPACING = 24.0 IN. C/C

THIS TRUSS IS DESIGNED FOR RESIDENTIAL OR SMALL BUILDING REQUIREMENTS OF PART 9, NBCC 2015

THIS DESIGN COMPLIES WITH:
- PART 9 OF BCBC 2018, ABC 2019
- PART 9 OF OBC 2012 (2019 AMENDMENT)
- CSA 086-14
- TPIC 2014

DESIGN ASSUMPTIONS
- OVERHANG NOT TO BE ALTERED OR CUT OFF.

(55 % OF 48.1 P.S.F. G.S.L. PLUS 8.4 P.S.F. RAIN LOAD)
EQUALS 34.8 P.S.F. SPECIFIED ROOF LIVE LOAD

ALLOWABLE DEFL.(LL)= L/360 (0.19")
CALCULATED VERT. DEFL.(LL) = L/999 (0.01")
ALLOWABLE DEFL.(TL)= L/360 (0.19")
CALCULATED VERT. DEFL.(TL) = L/999 (0.02")

CSI: TC=0.17/1.00 (A-B:1) , BC=0.11/1.00 (D-E:3) ,
WB=0.00/1.00 (n/a:0) , SSI=0.11/1.00 (A-B:1)

DOL LUMBER=1.00 NAIL=1.00 LS BEND=1.10 COMP=1.10
SHEAR=1.10 TENS=1.10

COMPANION LIVE LOAD FACTOR = 1.00

TRUSS PLATE MANUFACTURER IS NOT RESPONSIBLE FOR QUALITY CONTROL IN THE TRUSS MANUFACTURING PLANT .

NAIL VALUES
PLATE GRIP(DRY) SHEAR SECTION
(PSI) (PLI)
MAX MIN MAX MIN MAX MIN
MT20 650 371 1747 788 1987 1873

PLATE PLACEMENT TOL. = 0.250 inches

PLATE ROTATION TOL. = 5.0 Deg.

JSI GRIP= 0.21 (B) (INPUT = 0.90)
JSI METAL= 0.17 (B) (INPUT = 1.00)




READ ALL NOTES ON THIS PAGE AND ON ENGINEERING NOTE PAGE ENP-1. THIS NOTE PAGE IS AN INTEGRAL PART OF THIS DRAWING AS IT CONTAINS SPECIFICATIONS AND CRITERIA USED IN THE DESIGN OF THIS COMPONENT.



These plans have been reviewed for use with the corrections as noted. No other changes may be made without written approval of the Building Standards Branch. All work must comply with Zoning By-Law 2018-043, as amended, and the Ontario Building Code, as amended. These approved documents must be kept on site at all times. The building permit must be clearly posted on site at all times.

Discipline	Reviewer	BCIN	Date
Building Code	H. Authier	43236	2021-02-03
Sewage System			
Zoning			



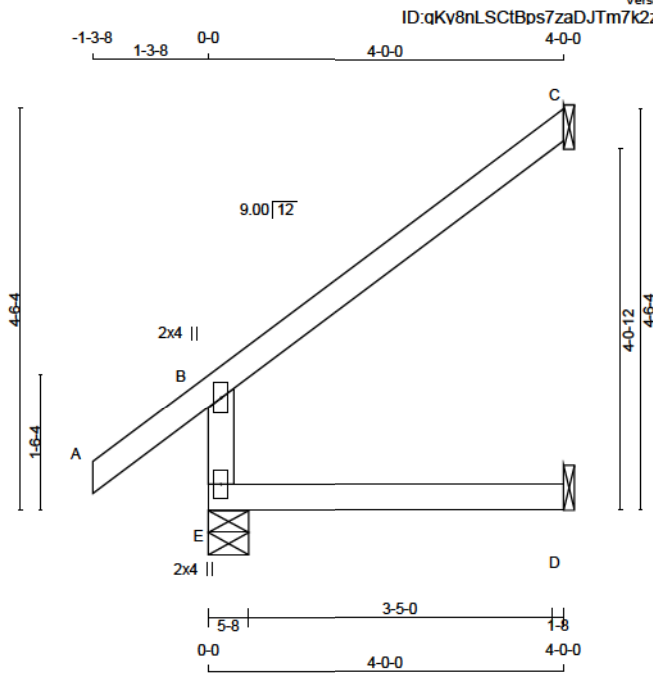

Scale = 1:25.9

TOTAL WEIGHT = 2 X 14 = 27 LB

LUMBER				
N. L. G. A. RULES	CHORDS	SIZE	LUMBER	DESCR.
E - B	2x4	DRY	No.2	SPF
A - C	2x4	DRY	No.2	SPF
E - D	2x4	DRY	No.2	SPF

DRY: SEASONED LUMBER.

PLATES (table is in inches)					
JT	TYPE	PLATES	W	LEN	X
B	TMV+p	MT20	2.0	4.0	
E	BMV1+p	MT20	2.0	4.0	

DIMENSIONS, SUPPORTS AND LOADINGS SPECIFIED BY FABRICATOR TO BE VERIFIED BY BUILDING DESIGNER

BEARINGS							
FACTORED GROSS REACTION		MAXIMUM FACTORED GROSS REACTION		INPUT BRG		REQRD BRG	
JT	VERT	HORZ	DOWN	HORZ	UPLIFT	IN-SX	IN-SX
E	571	0	571	0	0	5-8	1-8
C	187	0	187	0	0	1-8	1-8
D	68	0	86	0	0	1-8	1-8

SEE MITEK STANDARD DETAIL B97791H FOR CONNECTION TO JOINT(S) C, D

UNFACTORED REACTIONS							
JT	1ST CASE	SNOW	LIVE	PERM. LIVE	WIND	DEAD	SOIL
E	413	270 / 0	48 / 0	0 / 0	0 / 0	95 / 0	0 / 0
C	129	105 / 0	0 / 0	0 / 0	0 / 0	24 / 0	0 / 0
D	62	0 / 0	36 / 0	0 / 0	0 / 0	25 / 0	0 / 0

BEARING MATERIAL TO BE SPF NO.2 OR BETTER AT JOINT(S) E

BRACING
TOP CHORD TO BE SHEATHED OR MAX. PURLIN SPACING = 8.25 FT.
MAX. UNBRACED BOTTOM CHORD LENGTH = 10.00 FT OR RIGID CEILING DIRECTLY APPLIED.

ALL PITCH BREAKS AND PERIMETER CORNER JOINTS MUST BE Laterally RESTRAINED.

LOADING				TOTAL LOAD CASES: (4)			
CHORDS				WEBS			
MEMB.	MAX. FACTORED FORCE (LBS)	FACTORED VERT. LOAD (PLF)	FACTORED L1 MAX. CSI (LC)	MEMB.	MAX. FACTORED FORCE (LBS)	MAX. FACTORED CSI (LC)	MAX. FACTORED LENGTH
FR-TO		FROM TO		FR-TO			
E-B	-482 / 0	0.0	0.0 0.08 (3)	7.81			
A-B	0 / 51	-124.4	-124.4 0.17 (1)	10.00			
B-C	-37 / 0	-124.4	-124.4 0.34 (1)	6.25			
E-D	0 / 0	-39.2	-39.2 0.12 (3)	10.00			

DESIGN CRITERIA

SPECIFIED LOADS:
TOP CH. LL = 34.8 PSF
DL = 8.0 PSF
BOT CH. LL = 10.5 PSF
DL = 7.3 PSF
TOTAL LOAD = 60.6 PSF

SPACING = 24.0 IN. C/C

THIS TRUSS IS DESIGNED FOR RESIDENTIAL OR SMALL BUILDING REQUIREMENTS OF PART 9, NBCC 2015

THIS DESIGN COMPLIES WITH:
- PART 9 OF BCBC 2018, ABC 2019
- PART 9 OF OBC 2012 (2019 AMENDMENT)
- CSA 086-14
- TPIC 2014

DESIGN ASSUMPTIONS
- OVERHANG NOT TO BE ALTERED OR CUT OFF.

(55 % OF 48.1 P.S.F. G.S.L. PLUS 8.4 P.S.F. RAIN LOAD)
EQUALS 34.8 P.S.F. SPECIFIED ROOF LIVE LOAD

ALLOWABLE DEFL.(LL)= L/360 (0.19")
CALCULATED VERT. DEFL.(LL)= L/999 (0.01")
ALLOWABLE DEFL.(TL)= L/360 (0.19")
CALCULATED VERT. DEFL.(TL)= L/999 (0.02")

CSI: TC=0.34/1.00 (B-C:1) , BC=0.12/1.00 (D-E:3) ,
WB=0.00/1.00 (n/a:0) , SSI=0.19/1.00 (B-C:1)

DOL LUMBER=1.00 NAIL=1.00 LS BEND=1.10 COMP=1.10
SHEAR=1.10 TENS=1.10

COMPANION LIVE LOAD FACTOR = 1.00

TRUSS PLATE MANUFACTURER IS NOT RESPONSIBLE FOR QUALITY CONTROL IN THE TRUSS MANUFACTURING PLANT .

NAIL VALUES
PLATE GRIP(DRY) SHEAR SECTION
(PSI) (PLI)
MAX MIN MAX MIN MAX MIN
MT20 650 371 1747 788 1987 1873

PLATE PLACEMENT TOL. = 0.250 inches

PLATE ROTATION TOL. = 5.0 Deg.

JSI GRIP= 0.31 (B) (INPUT = 0.90)
JSI METAL= 0.26 (B) (INPUT = 1.00)




These plans have been reviewed for use with the corrections as noted. No other changes may be made without written approval of the Building Standards Branch. All work must comply with Zoning By-Law 2018-043, as amended, and the Ontario Building Code, as amended. These approved documents must be kept on site at all times. The building permit must be clearly posted on site at all times.

Discipline	Reviewer	BCIN	Date
Building Code	H. Authier	43236	2021-02-03
Seismic System			
Zoning			

READ ALL NOTES ON THIS PAGE AND ON ENGINEERING NOTE PAGE ENP-1. THIS NOTE PAGE IS AN INTEGRAL PART OF THIS DRAWING AS IT CONTAINS SPECIFICATIONS AND CRITERIA USED IN THE DESIGN OF THIS COMPONENT.



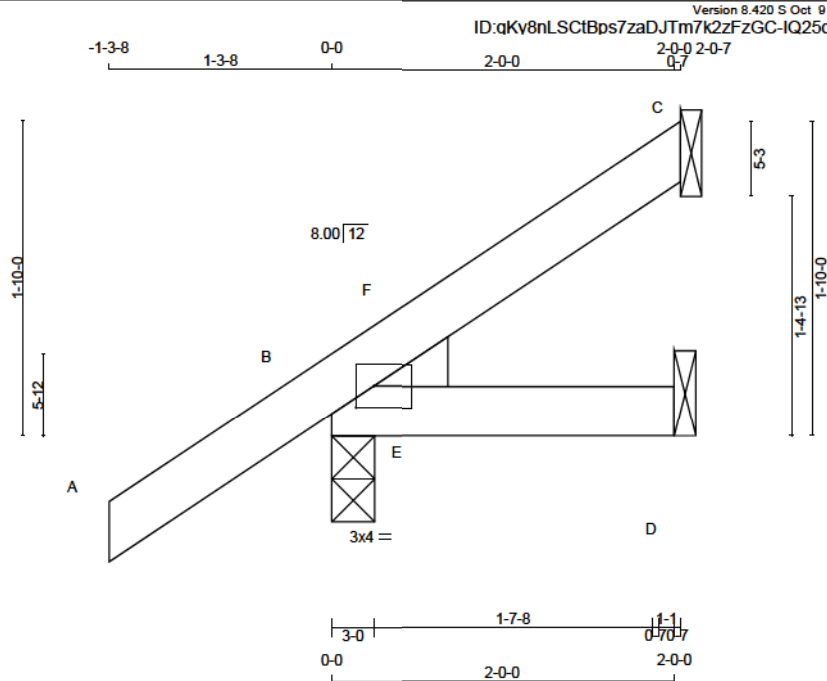

TOTAL WEIGHT = $2 \times 8 = 15 \text{ lb}$

LUMBER				
N. L. G. A. RULES				
CHORDS	SIZE		LUMBER	DESCR.
A - C	2x4	DRY	No.2	SPF
B - D	2x4	DRY	No.2	SPF

DRY: SEASONED LUMBER.

PLATES (table is in inches)						
JT	TYPE	PLATES	W	LEN	Y	X
B	TMBH1-I	MT20	3.0	4.0	1.50	1.25

DIMENSIONS, SUPPORTS AND LOADINGS SPECIFIED BY FABRICATOR TO BE VERIFIED BY BUILDING DESIGNER

BEARINGS

	FACTORED GROSS REACTION		MAXIMUM FACTORED GROSS REACTION		INPUT BRG	REQRD BRG	HEEL
JT	VERT	HORZ	DOWN	HORZ	UPLIFT IN-SX	IN-SX	WEDGE
C	106	0	106	0	0	1-8	
B	336	0	336	0	0	1-8	2x4 L
D	61	0	61	0	0	1-8	

SEE MITEK STANDARD DETAIL B97791H FOR CONNECTION TO JOINT(S) C , D

UNFACTORED REACTIONS

1ST LCASE		MAX / MIN COMPONENT REACTIONS					
JT	COMBINED	SNOW	LIVE	PERM.LIVE	WIND	DEAD	SOIL
C	74	55 / 0	4 / 0	0 / 0	0 / 0	15 / 0	0 / 0
B	240	166 / 0	21 / 0	0 / 0	0 / 0	53 / 0	0 / 0
D	49	16 / 0	17 / 0	0 / 0	0 / 0	16 / 0	0 / 0

BEARING MATERIAL TO BE SPF NO.2 OR BETTER AT JOINT(S) B. D

BRACING

TOP CHORD TO BE SHEATHED OR MAX. PURLIN SPACING = 6.25 FT.
MAX. UNBRACED BOTTOM CHORD LENGTH = 10.00 FT OR RIGID CEILING DIRECTLY APPLIED.

ALL PITCH BREAKS AND PERIMETER CORNER JOINTS MUST BE LATERALLY RESTRAINED.

LOADING

TOTAL LOAD CASES: (5)

CHORDS				WEBS			
MEMB.	MAX. FACTORED FORCE (LBS)	FACTORED VERT. LOAD (PLF)	LC1 MAX CSI (LC)	MAX. UNBRAC	MEMB.	MAX. FACTORED FORCE (LBS)	MAX CSI (LC)
FR-TO		FROM TO		LENGTH-FR-TO			
A - B	0 / 41	-124.4	-124.4	0.17 (1)	10.00	E - F	-83 / 16
B - F	-24 / 0	-124.4	-124.4	0.02 (2)	8.25		
F - C	0 / 8	-124.4	-124.4	0.06 (1)	10.00		0.00 (1)
B - E	0 / 0	-39.2	-39.2	0.06 (1)	10.00		
E - D	0 / 0	-39.2	-39.2	0.06 (1)	10.00		

CANTILEVER ANALYSIS HAS BEEN CONSIDERED IN THIS DESIGN

DESIGN CRITERIA

SPECIFIED LOADS:

TOP	CH.	LL = 34.8	PSF
		DL = 8.0	PSF
BOT	CH.	LL = 10.5	PSF
		DL = 7.3	PSF
TOTAL LOAD		= 60.6	PSF

SPACING = 24.0 IN. C/C

THIS TRUSS IS DESIGNED FOR RESIDENTIAL OR SMALL BUILDING REQUIREMENTS OF PART 9, NBCC 2015

THIS DESIGN COMPLIES WITH:

- PART 9 OF BCBC 2018 , ABC 2019
- PART 9 OF OBC 2012 (2019 AMENDMENT)
- CSA 086-14
- TPIC 2014

(55 % OF 48.1 P.S.F. G.S.L. PLUS 8.4 P.S.F. RAIN LOAD)
EQUALS 34.8 P.S.F. SPECIFIED ROOF LIVE LOAD

ALLOWABLE DEFL.(LL)= $L/360$ (0.19")
CALCULATED VERT. DEFL.(LL) = $L/999$ (0.00")
ALLOWABLE DEFL.(TL)= $L/360$ (0.19")
CALCULATED VERT. DEFL.(TL) = $L/999$ (0.00")

CSI: TC=0.17/1.00 (A-B:1) , BC=0.06/1.00 (B-E:1) ,
WB=0.00/1.00 (E-F:1) , SSI=0.12/1.00 (A-B:1)

DOL LUMBER=1.00 NAIL=1.00 LS BEND=1.10 COMP=1.10
SHEAR=1.10 TENS= 1.10

COMPANION LIVE LOAD FACTOR = 1.00

TRUSS PLATE MANUFACTURER IS NOT RESPONSIBLE
FOR QUALITY CONTROL IN THE TRUSS
MANUFACTURING PLANT .

NAIL VALUES

PLATE	GRIP(DRY)		SHEAR		SECTION	
	(PSI)		(PLI)		(PLI)	
	MAX	MIN	MAX	MIN	MAX	MIN
MT20	650	371	1747	788	1987	1873

PLATE PLACEMENT TOL. = 0.250 inches

PLATE ROTATION TOL. = 5.0 Deg.

JSI GRIP= 0.38 (B) (INPUT = 0.90)
JSI METAL= 0.05 (B) (INPUT = 1.00)




**READ ALL NOTES ON THIS PAGE AND ON
ENGINEERING NOTE PAGE ENP-1. THIS
NOTE PAGE IS AN INTEGRAL PART OF
THIS DRAWING AS IT CONTAINS
SPECIFICATIONS AND CRITERIA USED IN
THE DESIGN OF THIS COMPONENT.**



These plans have been reviewed for use with the corrections as noted. No other changes may be made without written approval of the Building Standards Branch. All work must comply with Zoning By-Law 2018-043, as amended, and the Ontario Building Code, as amended. These approved documents must be kept on site at all times. The building permit must be clearly posted on site at all times.

Discipline	Reviewer	BCIN	Date
Building Code	H. Authier	43236	2021-02-06
Sewage System			
Zoning			



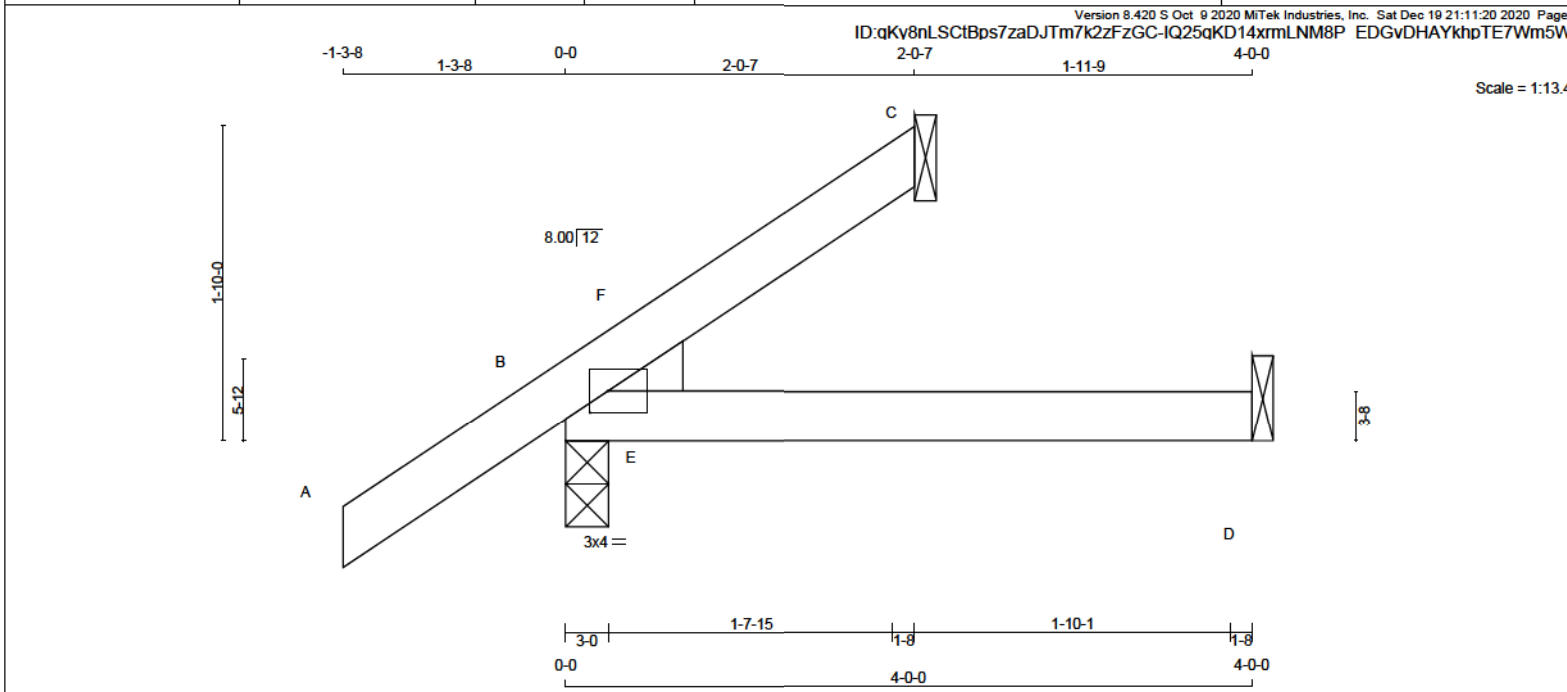

LUMBER
N. L. G. A. RULES
CHORDS SIZE LUMBER
A - C 2x4 DRY No.2
B - D 2x4 DRY No.2

DESCR.
SPF
SPF

DRY: SEASONED LUMBER.

PLATES (table is in inches)
JT TYPE PLATES W LEN Y X
B TMBH1-I MT20 3.0 4.0 1.50 1.25

DIMENSIONS, SUPPORTS AND LOADINGS SPECIFIED BY FABRICATOR TO BE VERIFIED BY BUILDING DESIGNER

BEARINGS		FACTORED GROSS REACTION		MAXIMUM FACTORED GROSS REACTION		INPUT BRG		REQRD BRG		HEEL WEDGE	
JT	VERT	HORZ	DOWN	HORZ	UPLIFT	IN-SX	IN-SX	IN-SX	IN-SX	IN-SX	WEDGE
C	144	0	144	0	0	1-8	1-8	1-8	1-8	2x4 L	
B	368	0	368	0	0	3-0	1-8	1-8	1-8		
D	70	0	84	0	0	1-8	1-8	1-8	1-8		

SEE MITEK STANDARD DETAIL B97791H FOR CONNECTION TO JOINT(S) C, D

UNFACTORED REACTIONS		1ST LCASE		MAX / MIN COMPONENT REACTIONS							
JT	COMBINED	SNOW	LIVE	PERM. LIVE	WIND	DEAD	SOIL				
C	106	62 / 0	18 / 0	0 / 0	0 / 0	27 / 0	0 / 0				
B	267	171 / 0	33 / 0	0 / 0	0 / 0	62 / 0	0 / 0				
D	61	4 / 0	33 / 0	0 / 0	0 / 0	24 / 0	0 / 0				

BEARING MATERIAL TO BE SPF NO.2 OR BETTER AT JOINT(S) C, B

BRACING
TOP CHORD TO BE SHEATHED OR MAX. PURLIN SPACING = 8.25 FT.
MAX. UNBRACED BOTTOM CHORD LENGTH = 10.00 FT OR RIGID CEILING DIRECTLY APPLIED.

ALL PITCH BREAKS AND PERIMETER CORNER JOINTS MUST BE Laterally RESTRAINED.

LOADING
TOTAL LOAD CASES: (4)

CHORDS				WEBS			
MEMB.	MAX. FACTORED FORCE (LBS)	FACTORED VERT. LOAD (PLF)	FACTORED L1 MAX. (LC)	MEMB.	MAX. FACTORED FORCE (LBS)	FACTORED MAX. (LC)	
FR-TO		FROM TO	LENGTH	FR-TO			
A-B	0 / 41	-124.4 -124.4	0.17 (1)	10.00	E-F	0 / 156	0.00 (1)
B-F	-111 / 0	-124.4 -124.4	0.11 (2)	6.25			
F-C	0 / 30	-124.4 -124.4	0.12 (1)	10.00			
B-E	0 / 0	-39.2 -39.2	0.04 (3)	10.00			
E-D	0 / 0	-39.2 -39.2	0.10 (2)	10.00			

DESIGN CRITERIA

SPECIFIED LOADS:
TOP CH. LL = 34.8 PSF
DL = 8.0 PSF
BOT CH. LL = 10.5 PSF
DL = 7.3 PSF
TOTAL LOAD = 60.6 PSF

SPACING = 24.0 IN. C/C

THIS TRUSS IS DESIGNED FOR RESIDENTIAL OR SMALL BUILDING REQUIREMENTS OF PART 9, NBCC 2015

THIS DESIGN COMPLIES WITH:
- PART 9 OF BCBC 2018, ABC 2019
- PART 9 OF OBC 2012 (2019 AMENDMENT)
- CSA 088-14
- TPIC 2014

(55 % OF 48.1 P.S.F. G.S.L. PLUS 8.4 P.S.F. RAIN LOAD)
EQUALS 34.8 P.S.F. SPECIFIED ROOF LIVE LOAD

ALLOWABLE DEFL.(LL)= L/360 (0.19")
CALCULATED VERT. DEFL.(LL) = L/999 (0.01")
ALLOWABLE DEFL.(TL)= L/360 (0.19")
CALCULATED VERT. DEFL.(TL) = L/999 (0.02")

CSI: TC=0.17/1.00 (A-B:1) , BC=0.10/1.00 (D-E:2) ,
WB=0.00/1.00 (E-F:1) , SSI=0.12/1.00 (A-B:1)

DOL LUMBER=1.00 NAIL=1.00 LS BEND=1.10 COMP=1.10
SHEAR=1.10 TENS=1.10

COMPANION LIVE LOAD FACTOR = 1.00

TRUSS PLATE MANUFACTURER IS NOT RESPONSIBLE FOR QUALITY CONTROL IN THE TRUSS MANUFACTURING PLANT .

NAIL VALUES
PLATE GRIP(DRY) SHEAR SECTION
(PSI) (PLI) (PLI)
MAX MIN MAX MIN MAX MIN
MT20 850 371 1747 788 1987 1873

PLATE PLACEMENT TOL. = 0.250 inches

PLATE ROTATION TOL. = 5.0 Deg.

JSI GRIP= 0.32 (B) (INPUT = 0.90)
JSI METAL = 0.04 (B) (INPUT = 1.00)




READ ALL NOTES ON THIS PAGE AND ON ENGINEERING NOTE PAGE ENP-1. THIS NOTE PAGE IS AN INTEGRAL PART OF THIS DRAWING AS IT CONTAINS SPECIFICATIONS AND CRITERIA USED IN THE DESIGN OF THIS COMPONENT.



These plans have been reviewed for use with the corrections as noted. No other changes may be made without written approval of the Building Standards Branch. All work must comply with Zoning By-Law 2018-043, as amended, and the Ontario Building Code, as amended. These approved documents must be kept on site at all times. The building permit must be clearly posted on site at all times.

Discipline	Reviewer	BCIN	Date
Building Code	H. Authier	43236	2021-02-03
Seismic System			
Zoning			



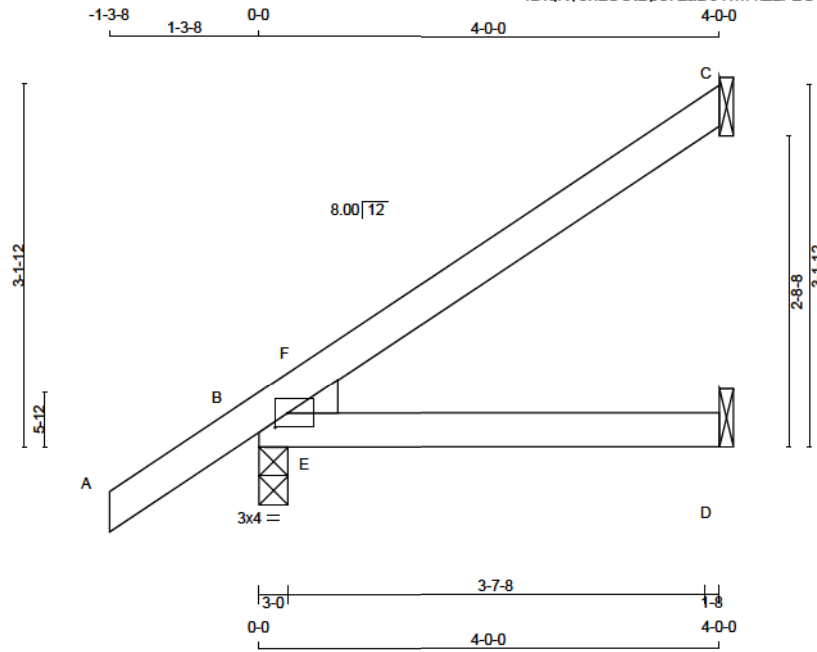

Scale = 1:20.0

TOTAL WEIGHT = $2 \times 13 = 25$ lb

N. L. G. A. RULES			
CHORDS	SIZE		LUMBER
A - C	2x4	DRY	No.2
B - D	2x4	DRY	No.2

PLATES (table is in inches)						
JT	TYPE	PLATES	W	LEN	Y	X
B	TMBH1-I	MT20	3.0	4.0	1.50	1.25

JT	TYPE	PLATES	W	LEN	Y	X
B	TMBH1-I	MT20	3.0	4.0	1.50	1.25

JT	FACTORED GROSS REACTION		MAXIMUM FACTORED GROSS REACTION			INPUT BRG	REQD BRG	HEEL
	VERT	HORZ	DOWN	HORZ	UPLIFT	IN-SX	IN-SX	WEDGE
C	217	0	217	0	0	1-8	1-8	
B	498	0	498	0	0	3-0	1-8	2x4 L
D	110	0	116	0	0	1-8	1-8	

SEE MITEK STANDARD DETAIL B97791H FOR CONNECTION TO JOINT(S) C , D

JT	1ST LCASE MAX/MIN COMPONENT REACTIONS						
	COMBINED	SNOW	LIVE	PERM.LIVE	WIND	DEAD	SOIL
C	152	115 / 0	6 / 0	0 / 0	0 / 0	31 / 0	0 / 0
B	360	235 / 0	42 / 0	0 / 0	0 / 0	83 / 0	0 / 0
D	91	24 / 0	36 / 0	0 / 0	0 / 0	31 / 0	0 / 0

BEARING MATERIAL TO BE SPF NO.2 OR BETTER AT JOINT(S) B, D

TOP CHORD TO BE SHEATHED OR MAX. PURLIN SPACING = 6.25 FT.
MAX. UNBRACED BOTTOM CHORD LENGTH = 10.00 FT OR RIGID CEILING DIRECTLY APPLIED.

ALL PITCH BREAKS AND PERIMETER CORNER JOINTS MUST BE LATERALLY RESTRAINED.

TOTAL LOAD CASES: (4)

CHORDS				WEBS			
MEMB.	MAX. FACTORED FORCE (LBS)	FACTORED VERT. LOAD (PLF)	LC1 MAX. CSI (LC)	MAX. UNBRAC.	MEMB.	MAX. FACTORED FORCE (LBS)	MAX. CSI (LC)
FR-TO		FROM TO		LENGTH	FR-TO		
A-B	0/41	-124.4	-124.4	0.17 (1)	10.00	E-F	-248/56
B-C	-58/0	-124.4	-124.4	0.07 (9)	6.25		0.00 (1)
F-C	0/7	-124.4	-124.4	0.26 (1)	10.00		
B-E	0/0	-39.2	-39.2	0.20 (1)	10.00		
E-D	0/0	-39.2	-39.2	0.21 (1)	10.00		

TOP	CH.	LL	= 34.8	PSF
		DL	= 8.0	PSF
BOT	CH.	LL	= 10.5	PSF
		DL	= 7.3	PSF
TOTAL		LOAD	= 60.6	PSF

SPACING = 24.0 IN. C/C

THIS TRUSS IS DESIGNED FOR RESIDENTIAL OR SMALL
BUILDING REQUIREMENTS OF PART 9, NBCC 2015

THIS DESIGN COMPLIES WITH:

- PART 9 OF BCBC 2018 , ABC 2019
- PART 9 OF OBC 2012 (2019 AMENDMENT)
- CSA 088-14
- TPIC 2014

(55 % OF 48.1 P.S.F. G.S.L. PLUS 8.4 P.S.F. RAIN LOAD)
EQUALS 34.8 P.S.F. SPECIFIED ROOF LIVE LOAD

ALLOWABLE DEFL.(LL)= L/360 (0.19")
CALCULATED VERT. DEFL.(LL) = L/ 999 (0.03")
ALLOWABLE DEFL.(TL)= L/360 (0.19")
CALCULATED VERT. DEFL.(TL) = L/ 999 (0.05")

CSI: TC=0.26/1.00 (C-F:1) , BC=0.21/1.00 (D-E:1) ,
WB=0.00/1.00 (E-F:1) , SSI=0.23/1.00 (B-E:1)

DOL LUMBER=1.00 NAIL=1.00 LS BEND=1.10 COMP=1.10
SHEAR=1.10 TENS= 1.10

COMPANION LIVE LOAD FACTOR = 1.00

TRUSS PLATE MANUFACTURER IS NOT RESPONSIBLE
FOR QUALITY CONTROL IN THE TRUSS
MANUFACTURING PLANT .

PLATE	GRIP(DRY)		SHEAR		SECTION	
	(PSI)		(PLI)		(PLI)	
	MAX	MIN	MAX	MIN	MAX	MIN
MT20	650	371	1747	788	1987	1873

PLATE PLACEMENT TOL. = 0.250 inches

PLATE ROTATION TOL. = 5.0 Deg.

JSI GRIP= 0.57 (B) (INPUT = 0.90)
JSI METAL= 0.07 (B) (INPUT = 1.00)




**READ ALL NOTES ON THIS PAGE AND ON
ENGINEERING NOTE PAGE ENP-1. THIS
NOTE PAGE IS AN INTEGRAL PART OF
THIS DRAWING AS IT CONTAINS
SPECIFICATIONS AND CRITERIA USED IN
THE DESIGN OF THIS COMPONENT.**



These plans have been reviewed for use with the corrections as noted. No other changes may be made without written approval of the Building Standards Branch. All work must comply with Zoning By-Law 2018-043, as amended, and the Ontario Building Code, as amended. These approved documents must be kept on site at all times. The building permit must be clearly posted on site at all times.

Discipline	Reviewer	BCIN	Date
Building Code	H. Authier	43236	2021-02
Sewage System			
Zoning			



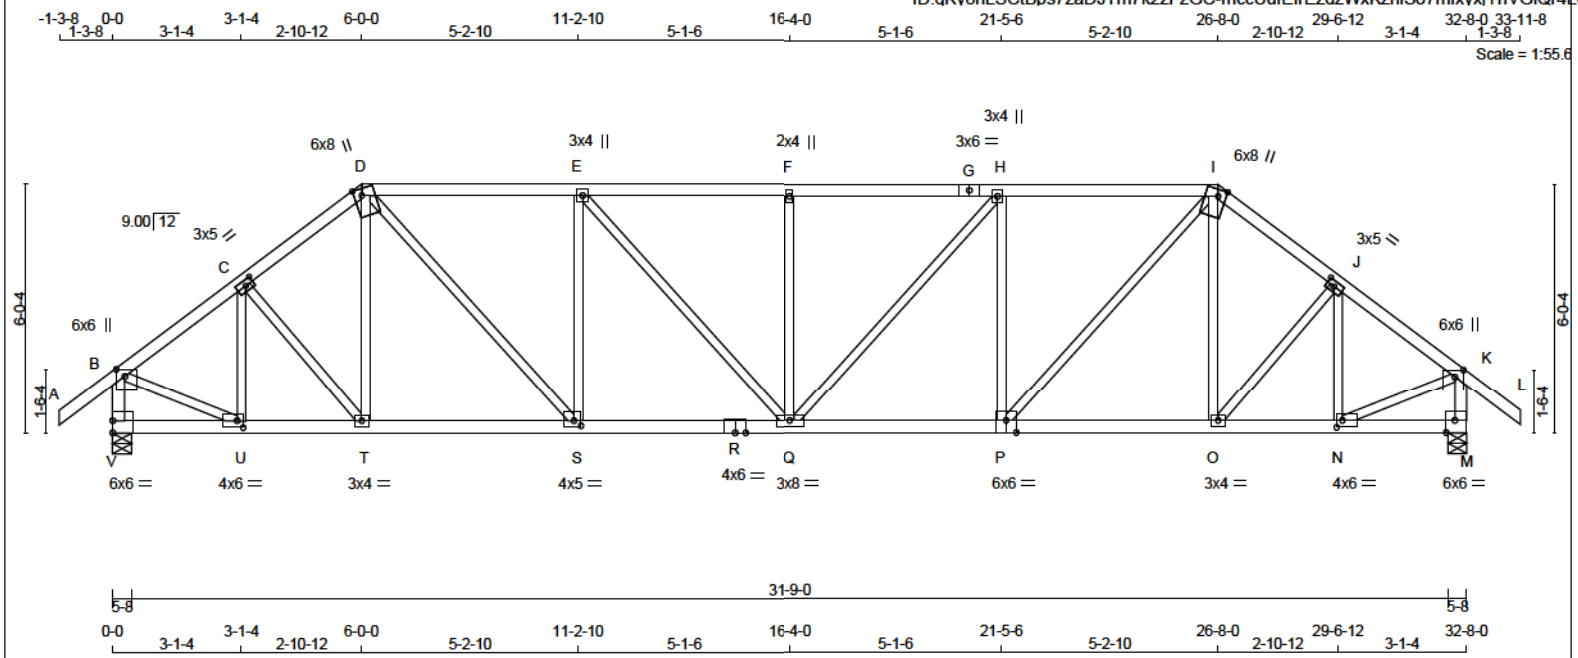

TOTAL WEIGHT = 148 LB

LUMBER				DESCR.	
N. L. G. A. RULES	CHORDS	SIZE	LUMBER		
A - D	2x4	DRY	No.2	SPF	
D - G	2x4	DRY	No.2	SPF	
G - I	2x4	DRY	No.2	SPF	
I - L	2x4	DRY	No.2	SPF	
V - B	2x4	DRY	No.2	SPF	
M - K	2x4	DRY	No.2	SPF	
V - R	2x4	DRY	No.2	SPF	
R - P	2x4	DRY	No.2	SPF	
P - M	2x4	DRY	No.2	SPF	
ALL WEBS EXCEPT	2x3	DRY	No.2	SPF	

DRY: SEASONED LUMBER.

PLATES (table is in inches)					
JT	TYPE	PLATES	W	LEN	Y X
B	TMVW+p	MT20	6.0	6.0	2.00 2.50
C	TMVW-t	MT20	3.0	5.0	1.50 2.25
D	TTVW+m	MT20	6.0	8.0	2.00 2.25
E	TMVW-t	MT20	3.0	4.0	
F	TMVW-w	MT20	2.0	4.0	
G	TS-t	MT20	3.0	6.0	
H	TMVW-t	MT20	3.0	4.0	
I	TTVW+m	MT20	6.0	8.0	2.00 2.25
J	TMVW-t	MT20	3.0	5.0	1.50 2.25
K	TMVW+p	MT20	6.0	6.0	2.00 2.50
M	BMV1-t	MT20	6.0	6.0	Edge 2.50
N	BMVW-t	MT20	4.0	6.0	2.00 1.75
O	BMVW-t	MT20	3.0	4.0	
P	BSWW-t	MT20	6.0	6.0	Edge 3.00
Q	QMWW-t	MT20	3.0	8.0	
R	BS-t	MT20	4.0	6.0	
S	BMVW-t	MT20	4.0	5.0	1.50 2.00
T	BMVW-t	MT20	3.0	4.0	
U	BMVW-t	MT20	4.0	6.0	2.00 1.75
V	BMV1-t	MT20	6.0	6.0	3.50

Edge - INDICATES REFERENCE CORNER OF PLATE TOUCHES EDGE OF CHORD.

DIMENSIONS, SUPPORTS AND LOADINGS SPECIFIED BY FABRICATOR TO BE VERIFIED BY BUILDING DESIGNER

BEARINGS					
	FACTORED GROSS REACTION	MAXIMUM FACTORED GROSS REACTION	INPUT BRG	REQRD BRG	
JT	VERT	HORZ	DOWN	HORZ	UPLIFT IN-SX
V	2845	0	2845	0	5-8
M	2845	0	2845	0	5-8

UNFACTORED REACTIONS					
1ST LCASE	MAX/MIN COMPONENT REACTIONS				
JT	COMBINED	SNOW	LIVE	PERM.LIVE	WIND
V	2098	1233 / 0	343 / 0	0 / 0	0 / 0
M	2098	1233 / 0	343 / 0	0 / 0	0 / 0

BEARING MATERIAL TO BE SPF NO.2 OR BETTER AT JOINT(S) V, M

BRACING
TOP CHORD TO BE SHEATHED OR MAX. PURLIN SPACING = 2.82 FT.
MAX. UNBRACED BOTTOM CHORD LENGTH = 10.00 FT OR RIGID CEILING DIRECTLY APPLIED.
ALL PITCH BREAKS AND PERIMETER CORNER JOINTS MUST BE LATERALLY RESTRAINED.

LOADING					
TOTAL LOAD CASES: (4)					
CHORDS			WEBS		
MEMB.	MAX. FACTORED FORCE (LBS)	FACTORED VERT. LOAD (PLF)	MAX. FACTORED FORCE (LBS)	MAX. FACTORED FORCE (LBS)	MAX. FACTORED FORCE (LBS)
FR-TO		FROM TO	LENGTH	FR-TO	
A-B	0 / 51	-124.4 -124.4 0.17 (1)	10.00	U-C	-735 / 0
B-C	-2686 / 0	-124.4 -124.4 0.26 (1)	4.01	C-T	0 / 216
C-D	-2916 / 0	-124.4 -124.4 0.27 (1)	3.86	T-D	0 / 133
D-E	-3506 / 0	-124.4 -124.4 0.76 (1)	3.01	D-S	0 / 1782
E-F	-3862 / 0	-124.4 -124.4 0.80 (1)	2.82	S-E	-1116 / 0
F-G	-3862 / 0	-124.4 -124.4 0.80 (1)	2.82	E-Q	0 / 530
G-H	-3862 / 0	-124.4 -124.4 0.80 (1)	2.82	Q-F	-586 / 0
H-I	-3496 / 0	-124.4 -124.4 0.76 (1)	3.02	Q-H	0 / 549
I-J	-2921 / 0	-124.4 -124.4 0.27 (1)	3.85	P-H	-1131 / 0
J-K	-2684 / 0	-124.4 -124.4 0.25 (1)	4.02	P-I	0 / 1757
K-L	0 / 51	-124.4 -124.4 0.17 (1)	10.00	O-I	0 / 164
V-B	-2785 / 0	0.0 0.0 0.29 (1)	5.17	O-J	0 / 225
M-K	-2783 / 0	0.0 0.0 0.29 (1)	5.17	N-J	-746 / 0
V-U	0 / 0	-39.2 -39.2 0.07 (2)	10.00	B-U	0 / 2321
U-T	0 / 2167	-39.2 -39.2 0.45 (1)	10.00	N-K	0 / 2319
T-S	0 / 2307	-39.2 -39.2 0.47 (1)	10.00		
S-R	0 / 3509	-39.2 -39.2 0.68 (1)	10.00		
R-Q	0 / 3509	-39.2 -39.2 0.68 (1)	10.00		
Q-P	0 / 3467	-39.2 -39.2 0.69 (1)	10.00		
P-O	0 / 2312	-39.2 -39.2 0.50 (1)	10.00		
O-N	0 / 2165	-39.2 -39.2 0.48 (1)	10.00		
N-M	0 / 0	-39.2 -39.2 0.08 (2)	10.00		

DESIGN CRITERIA	
SPECIFIED LOADS:	
TOP CH. LL	= 34.8 PSF
DL	= 8.0 PSF
BOT CH. LL	= 10.5 PSF
DL	= 7.3 PSF
TOTAL LOAD	= 60.6 PSF

SPACING = 24.0 IN. C/C

LOADING IN FLAT SECTION BASED ON A SLOPE OF 2.00/12 MINIMUM

THIS TRUSS IS DESIGNED FOR RESIDENTIAL OR SMALL BUILDING REQUIREMENTS OF PART 9, NBCC 2015

THIS DESIGN COMPLIES WITH:
- PART 9 OF CBC 2018, ABC 2019
- PART 9 OF OBC 2012 (2019 AMENDMENT)
- CSA 088-14
- TPIC 2014

(55 % OF 48.1 P.S.F. G.S.L. PLUS 8.4 P.S.F. RAIN LOAD)
EQUALS 34.8 P.S.F. SPECIFIED ROOF LIVE LOAD

ALLOWABLE DEFL.(LL)= L/360 (1.09")
CALCULATED VERT. DEFL.(LL)= L/999 (0.19")
ALLOWABLE DEFL.(TL)= L/360 (1.09")
CALCULATED VERT. DEFL.(TL)= L/999 (0.32")

CSI: TC=0.80/1.00 (F-H:1), BC=0.60/1.00 (P-Q:1),
WB=0.64/1.00 (H-P:1), SSI=0.30/1.00 (H-I:1)

DOL LUMBER=1.00 NAIL=1.00 LS BEND=1.10 COMP=1.10
SHEAR=1.10 TENS=1.10

COMPANION LIVE LOAD FACTOR = 1.00

TRUSS PLATE MANUFACTURER IS NOT RESPONSIBLE FOR QUALITY CONTROL IN THE TRUSS MANUFACTURING PLANT .

NAIL VALUES			
PLATE GRIP(DRY)	SHEAR	SECTION	
(PSI)	(PLI)	(PLI)	
MAX MIN	MAX MIN	MAX MIN	
MT20	650	371	1747

PLATE PLACEMENT TOL. = 0.250 inches

PLATE ROTATION TOL. = 5.0 Deg.

JSI GRIP= 0.90 (J) (INPUT = 0.90)

JSI METAL= 0.80 (R) (INPUT = 1.00)




These plans have been reviewed for use with the corrections as noted. No other changes may be made without written approval of the Building Standards Branch. All work must comply with Zoning By-Law 2018-043, as amended, and the Ontario Building Code, as amended. These approved documents must be kept on site at all times. The building permit must be clearly posted on site at all times.

Discipline	Reviewer	BCIN	Date
Building Code	H. Authier	43236	2021-02-03
Seismic System			
Zoning			



READ ALL NOTES ON THIS PAGE AND ON ENGINEERING NOTE PAGE ENP-1. THIS NOTE PAGE IS AN INTEGRAL PART OF THIS DRAWING AS IT CONTAINS SPECIFICATIONS AND CRITERIA USED IN THE DESIGN OF THIS COMPONENT.



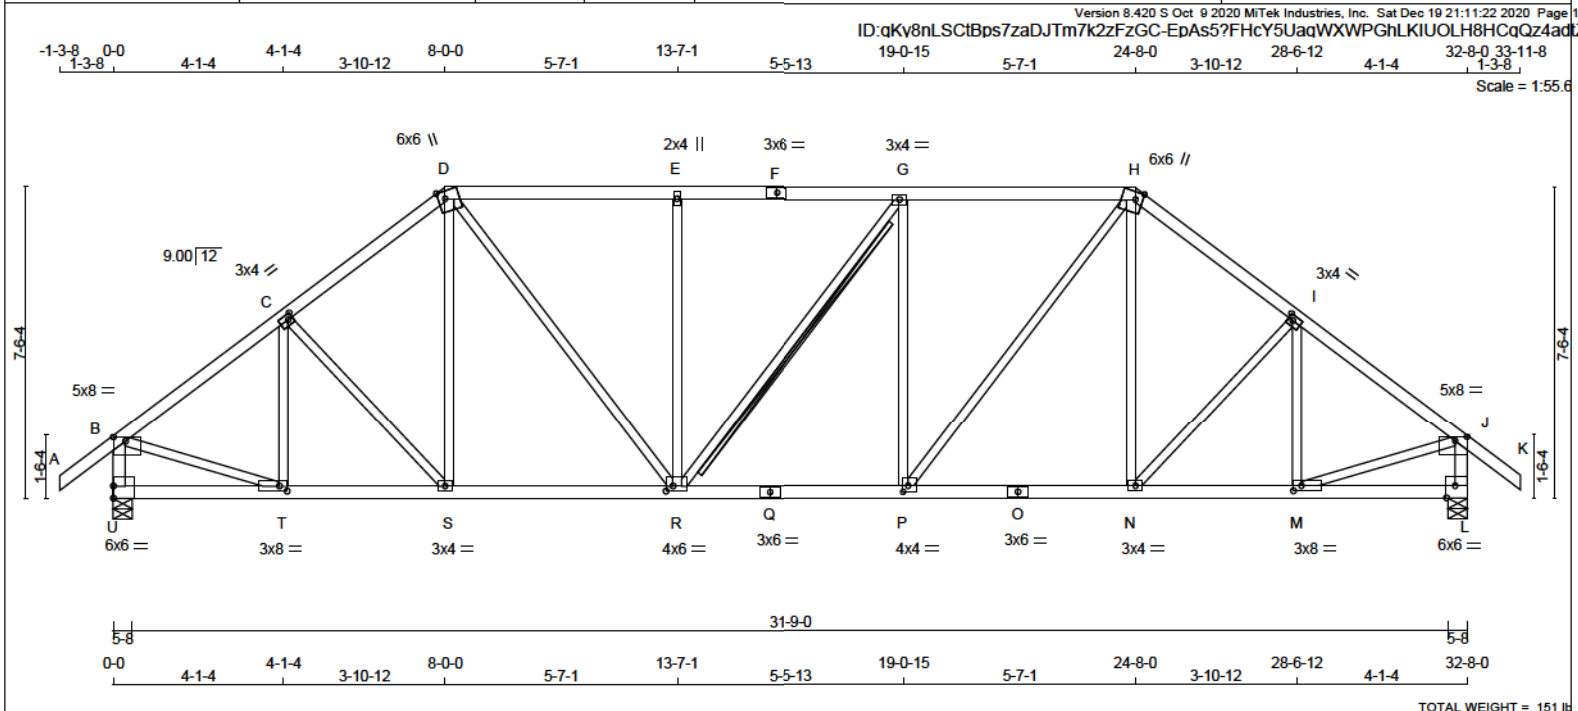

LUMBER				
N. L. G. A. RULES				
CHORDS	SIZE	LUMBER		DESCR.
A - D	2x4	DRY	No.2	SPF
D - F	2x4	DRY	No.2	SPF
F - H	2x4	DRY	No.2	SPF
H - K	2x4	DRY	No.2	SPF
U - B	2x4	DRY	No.2	SPF
L - J	2x4	DRY	No.2	SPF
U - Q	2x4	DRY	No.2	SPF
Q - O	2x4	DRY	No.2	SPF
O - L	2x4	DRY	No.2	SPF
ALL WEBS	2x3	DRY	No.2	SPF
EXCEPT				
DRY: SEASONED LUMBER.				

PLATES (table is in inches)						
JT	TYPE	PLATES	W	LEN	Y	X
B	TMVW-p	MT20	5.0	8.0	1.25	3.50
C	TMVW-t	MT20	3.0	4.0	1.50	1.50
D	TTWW+m	MT20	6.0	6.0	Edge	2.00
E	TMW+w	MT20	2.0	4.0		
F	TS-t	MT20	3.0	6.0		
G	TMVW-t	MT20	3.0	4.0		
H	TTWW+m	MT20	6.0	6.0	Edge	2.00
I	TMVW-t	MT20	3.0	4.0	1.50	1.50
J	TMVW-p	MT20	5.0	8.0	1.25	3.50
L	BMV1-t	MT20	6.0	6.0	Edge	2.50
M	BMVW-t	MT20	3.0	8.0	1.50	2.25
N	BMVW-t	MT20	3.0	4.0		
O	BS-t	MT20	3.0	6.0		
P	BMVW-t	MT20	4.0	4.0	1.75	1.50
Q	BS-t	MT20	3.0	6.0		
R	BMVW-t	MT20	4.0	6.0	1.50	2.00
S	BMVW-t	MT20	3.0	4.0		
T	BMVW-t	MT20	3.0	8.0	1.50	2.25
U	BMV1-t	MT20	6.0	6.0	3.50	

Edge - INDICATES REFERENCE CORNER OF PLATE TOUCHES EDGE OF CHORD.

DIMENSIONS, SUPPORTS AND LOADINGS SPECIFIED BY FABRICATOR TO BE VERIFIED BY BUILDING DESIGNER

BEARINGS		FACTORED GROSS REACTION		MAXIMUM FACTORED GROSS REACTION		INPUT BRG		REQRD BRG	
JT	VERT	HORZ	DOWN	HORZ	UPLIFT	IN-SX	IN-SX	IN-SX	IN-SX
U	2845	0	2845	0	0	5-8	5-8	5-8	5-8
L	2845	0	2845	0	0	5-8	5-8	5-8	5-8

UNFACTORED REACTIONS		1ST LCASE		MAX/MIN COMPONENT REACTIONS		FACTORED		MAXIMUM FACTORED		INPUT		REQRD	
JT	COMBINED	SNOW	LIVE	PERM.	LIVE	WIND	DEAD	SOIL	JT	VERT	HORZ	DOWN	HORZ
U	2098	1233	0	343	0	0	0	0	522	0	0	0	0
L	2098	1233	0	343	0	0	0	0	522	0	0	0	0

BEARING MATERIAL TO BE SPF NO.2 OR BETTER AT JOINT(S) U, L

BRACING

TOP CHORD TO BE SHEATHED OR MAX. PURLIN SPACING = 3.23 FT.
MAX. UNBRACED BOTTOM CHORD LENGTH = 10.00 FT OR RIGID CEILING DIRECTLY APPLIED.

ALL PITCH BREAKS AND PERIMETER CORNER JOINTS MUST BE LATERALLY RESTRAINED.

2x4 DRY SPF No.2 T-BRACE AT G-R

FASTEN T AND I-BRACES TO NARROW EDGE OF WEB WITH ONE ROW PER PLY OF 3" COMMON WIRE NAILS @ 6" O.C. WITH 3" MINIMUM END DISTANCE. BRACE MUST COVER 90% OF WEB LENGTH.

END VERTICAL(S) MUST BE SHEATHED OR HAVE BRACES AS INDICATED IN THE MAX. UNBRACED LENGTH COLUMN OF THE TABLE BELOW

LOADING

TOTAL LOAD CASES: (4)

CHORDS		MAX. FACTORED		FACTORED		WEBS		MAX. FACTORED	
MEMB.	FORCE (LBS)	VERT.	LOAD (PLF)	MAX. CS1 (LC)	UNBRAC LENGTH	MEMB.	FORCE (LBS)	MAX. CS1 (LC)	UNBRAC LENGTH
FR-TO	0 / 51	-124.4	-124.4	0.17 (1)	10.00	T-C	-515 / 0	0.18 (1)	
A-B	-2851 / 0	-124.4	-124.4	0.47 (1)	3.69	C-S	-86 / 0	0.05 (1)	
B-C	-2852 / 0	-124.4	-124.4	0.46 (1)	3.69	S-D	0 / 292	0.07 (2)	
C-D	-2852 / 0	-124.4	-124.4	0.46 (1)	3.69	D-R	0 / 1216	0.27 (1)	
D-E	-2997 / 0	-124.4	-124.4	0.75 (1)	3.23	R-E	-743 / 0	0.76 (1)	
E-F	-2997 / 0	-124.4	-124.4	0.75 (1)	3.23	R-G	-3 / 0	0.00 (1)	
F-G	-2997 / 0	-124.4	-124.4	0.75 (1)	3.23	P-G	-744 / 0	0.76 (1)	
G-H	-2999 / 0	-124.4	-124.4	0.76 (1)	3.23	P-H	0 / 1219	0.27 (1)	
H-I	-2852 / 0	-124.4	-124.4	0.46 (1)	3.69	N-H	0 / 290	0.07 (2)	
I-J	-2851 / 0	-124.4	-124.4	0.47 (1)	3.69	N-I	-86 / 0	0.05 (1)	
J-K	0 / 51	-124.4	-124.4	0.17 (1)	10.00	M-I	-514 / 0	0.18 (1)	
U-B	-2773 / 0	0.0	0.0	0.29 (1)	5.17	B-T	0 / 2403	0.54 (1)	
L-J	-2773 / 0	0.0	0.0	0.29 (1)	5.17	M-J	0 / 2403	0.54 (1)	
U-T	0 / 0	-39.2	-39.2	0.11 (3)	10.00				
T-S	0 / 2307	-39.2	-39.2	0.48 (1)	10.00				
S-R	0 / 2253	-39.2	-39.2	0.48 (1)	10.00				
R-Q	0 / 2999	-39.2	-39.2	0.61 (1)	10.00				
Q-P	0 / 2999	-39.2	-39.2	0.61 (1)	10.00				
P-O	0 / 2252	-39.2	-39.2	0.49 (1)	10.00				
O-N	0 / 2252	-39.2	-39.2	0.49 (1)	10.00				
N-M	0 / 2308	-39.2	-39.2	0.48 (1)	10.00				
M-L	0 / 0	-39.2	-39.2	0.11 (3)	10.00				

DESIGN CRITERIA

SPECIFIED LOADS:

TOP CH. LL = 34.8 PSF
DL = 8.0 PSF
BOT CH. LL = 10.5 PSF
DL = 7.3 PSF
TOTAL LOAD = 60.6 PSF

SPACING = 24.0 IN. C/C

LOADING IN FLAT SECTION BASED ON A SLOPE OF 2.00/12 MINIMUM

THIS TRUSS IS DESIGNED FOR RESIDENTIAL OR SMALL BUILDING REQUIREMENTS OF PART 9, NBCC 2015

THIS DESIGN COMPLIES WITH:

- PART 9 OF BCBC 2018, ABC 2019
- PART 9 OF OBC 2012 (2019 AMENDMENT)
- CSA 088-14
- TPIC 2014

(55 % OF 48.1 P.S.F. G.S.L. PLUS 8.4 P.S.F. RAIN LOAD) EQUALS 34.8 P.S.F. SPECIFIED ROOF LIVE LOAD

ALLOWABLE DEFL.(LL) = L/360 (1.09")
CALCULATED VERT. DEFL.(LL) = L/999 (0.14")
ALLOWABLE DEFL.(TL) = L/360 (1.09")
CALCULATED VERT. DEFL.(TL) = L/999 (0.24")

CSI: TC=0.76/1.00 (G-H-I), BC=0.61/1.00 (P-R-I),

WB=0.76/1.00 (G-P-I), SSI=0.32/1.00 (G-H-I)

DOL LUMBER=1.00 NAIL=1.00 LS BEND=1.10 COMP=1.10
SHEAR=1.10 TENS=1.10

COMPANION LIVE LOAD FACTOR = 1.00

TRUSS PLATE MANUFACTURER IS NOT RESPONSIBLE FOR QUALITY CONTROL IN THE TRUSS MANUFACTURING PLANT.

NAIL VALUES

PLATE GRIP(DRY) SHEAR SECTION
(PSI) (PLI) (PLI)
MAX MIN MAX MIN MAX MIN
MT20 650 371 1747 788 1987 1873

PLATE PLACEMENT TOL. = 0.250 inches

PLATE ROTATION TOL. = 5.0 Deg.

JSI GRIP= 0.90 (J) (INPUT = 0.90)
JSI METAL = 0.98 (Q) (INPUT = 1.00)



These plans have been reviewed for use with the corrections as noted. No other changes may be made without written approval of the Building Standards Branch. All work must comply with Zoning By-Law 2018-043, as amended, and the Ontario Building Code, as amended. These approved documents must be kept on site at all times. The building permit must be clearly posted on site at all times.

Discipline	Reviewer	BCIN	Date
Building Code	H. Authier	43236	2021-02-03
Service System			
Zoning			




READ ALL NOTES ON THIS PAGE AND ON ENGINEERING NOTE PAGE ENP-1. THIS NOTE PAGE IS AN INTEGRAL PART OF THIS DRAWING AS IT CONTAINS SPECIFICATIONS AND CRITERIA USED IN THE DESIGN OF THIS COMPONENT.



Version 8.420 S Oct 9 2020 MTEK Industries, Inc. Sat Dec 19 21:11:23 2020 Page 1

ID:qKy8nLSCIbPs7zaDJTm7k2FzGC-7kEJLGVNsDLQ5j46owtYr7f7ef0iNZCkKAQ?y7

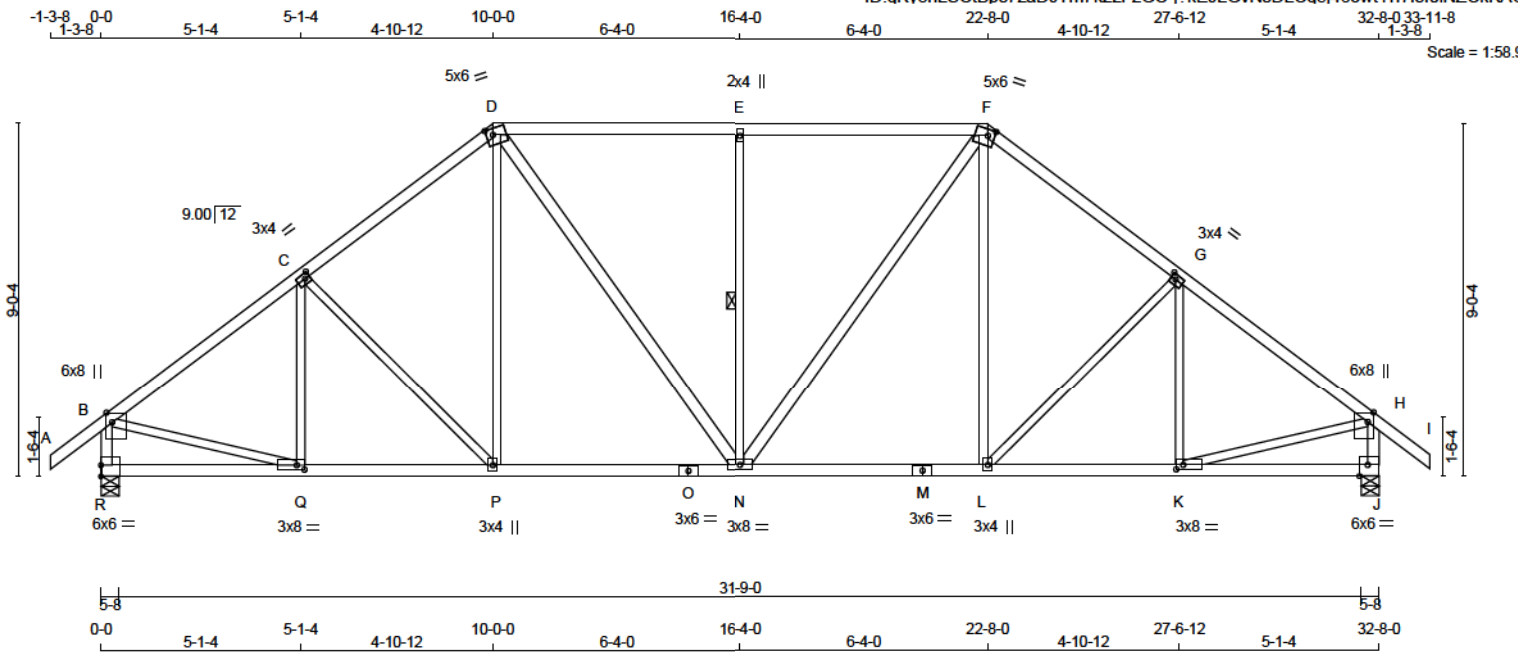

TOTAL WEIGHT = 158 LB
(M/F)

LUMBER			
N. L. G. A. RULES	CHORDS	SIZE	LUMBER
A - D	2x4	DRY	No.2
B - F	2x4	DRY	No.2
F - I	2x4	DRY	No.2
R - B	2x4	DRY	No.2
J - H	2x4	DRY	No.2
R - O	2x4	DRY	No.2
O - M	2x4	DRY	No.2
M - J	2x4	DRY	No.2
ALL WEBS	2x3	DRY	No.2
EXCEPT			
D - N	2x4	DRY	No.2
N - F	2x4	DRY	No.2

DESCR. SPF

DRY: SEASONED LUMBER.

PLATES (table is in inches)					
JT	TYPE	PLATES	W	LEN	Y X
B	TMVW+p	MT20	6.0	8.0	3.00 1.75
C	TMVW-l	MT20	3.0	4.0	1.50 1.50
D	TTWW-m	MT20	5.0	6.0	2.00 2.00
E	TMVW+w	MT20	2.0	4.0	
F	TTWW-m	MT20	5.0	6.0	2.00 2.00
G	TMVW-l	MT20	3.0	4.0	1.50 1.50
H	TMVW+p	MT20	6.0	8.0	3.00 1.75
J	BMV-l	MT20	6.0	6.0	Edge 2.50
K	BMVW-l	MT20	3.0	8.0	1.50 2.25
L	BMVW+l	MT20	3.0	4.0	
M	BS-l	MT20	3.0	6.0	
N	BMVW+l	MT20	3.0	6.0	
O	BS-l	MT20	3.0	6.0	
P	BMVW+l	MT20	3.0	4.0	
Q	BMVW-l	MT20	3.0	8.0	1.50 2.25
R	BMV-l	MT20	6.0	6.0	3.50

Edge - INDICATES REFERENCE CORNER OF PLATE TOUCHES EDGE OF CHORD.

DIMENSIONS, SUPPORTS AND LOADINGS SPECIFIED BY FABRICATOR TO BE VERIFIED BY BUILDING DESIGNER

BEARINGS					
	FACTORED GROSS REACTION	MAXIMUM FACTORED GROSS REACTION	INPUT DOWN	REQD BRG UPLIFT	REQD BRG IN-SX
JT	VERT	HORZ	DOWN	HORZ	UPLIFT
R	2845	0	2845	0	5-8
J	2845	0	2845	0	5-8

UNFACTORED REACTIONS						
1ST CASE	MAX/MIN COMPONENT REACTIONS					
JT	COMBINED	SNOW	LIVE	PERM.LIVE	WIND	DEAD
R	2098	1233 / 0	343 / 0	0 / 0	0 / 0	522 / 0
J	2098	1233 / 0	343 / 0	0 / 0	0 / 0	522 / 0

BEARING MATERIAL TO BE SPF NO.2 OR BETTER AT JOINT(S) R, J

BRACING
TOP CHORD TO BE SHEATHED OR MAX. PURLIN SPACING = 3.33 FT.
MAX. UNBRACED BOTTOM CHORD LENGTH = 10.00 FT OR RIGID CEILING DIRECTLY APPLIED.
ALL PITCH BREAKS AND PERIMETER CORNER JOINTS MUST BE Laterally RESTRAINED.

1 - 1x4 LATERAL BRACE(S) AT 1/2 LENGTH OF E-N. DBS = 20-0-0. CBF = 121 LBS.

DBS = DIAGONAL BRACE SPACING (MAX). CBF = CUMULATIVE BRACING FORCE (PER BRACE). FASTEN LATERAL BRACE(S) USING (0.122"x3") SPIRAL NAILS : 1 NAIL FOR 2x3 BRACE(S), 2 FOR 1x4, 2x4, 2x5, 3 FOR 2x6, 4 FOR 2x8, 5 FOR 2x10, AND 6 FOR 2x12.

END VERTICAL(S) MUST BE SHEATHED OR HAVE BRACES AS INDICATED IN THE MAX. UNBRACED LENGTH COLUMN OF THE TABLE BELOW

LOADING
TOTAL LOAD CASES: (4)

CHORDS				WEBS			
MEMB.	MAX. FACTORED FORCE (LBS)	FACTORED VERT. LOAD (PLF)	FACTORED LC1 MAX CSI (LC)	MEMB.	MAX. FACTORED FORCE (LBS)	FACTORED UNBRAC LENGTH (FT)	MAX. FACTORED FORCE (LBS)
FR-TO				FR-TO			
A-B	0 / 51	-124.4	-124.4 0.17 (1)	10.00	Q-C	-348 / 36	0.15 (1)
B-C	-2934 / 0	-124.4	-124.4 0.55 (1)	3.57	C-P	-347 / 0	0.33 (1)
C-D	-2721 / 0	-124.4	-124.4 0.52 (1)	3.72	P-D	0 / 479	0.11 (2)
D-E	-2585 / 0	-124.4	-124.4 0.76 (1)	3.33	D-N	0 / 754	0.12 (1)
E-F	-2585 / 0	-124.4	-124.4 0.76 (1)	3.33	N-E	-965 / 0	0.51 (1)
F-G	-2721 / 0	-124.4	-124.4 0.52 (1)	3.72	N-F	0 / 754	0.12 (1)
G-H	-2934 / 0	-124.4	-124.4 0.55 (1)	3.57	L-F	0 / 479	0.11 (2)
H-I	0 / 51	-124.4	-124.4 0.17 (1)	10.00	L-G	-347 / 0	0.33 (1)
R-B	-2760 / 0	0.0	0.0 0.29 (1)	5.19	K-G	-348 / 36	0.15 (1)
J-H	-2760 / 0	0.0	0.0 0.29 (1)	5.19	B-Q	0 / 2446	0.55 (1)
					K-H	0 / 2446	0.55 (1)
R-Q	0 / 0	-39.2	-39.2 0.17 (3)	10.00			
Q-P	0 / 2382	-39.2	-39.2 0.52 (1)	10.00			
P-O	0 / 2142	-39.2	-39.2 0.53 (2)	10.00			
O-N	0 / 2142	-39.2	-39.2 0.53 (2)	10.00			
N-M	0 / 2142	-39.2	-39.2 0.53 (2)	10.00			
M-L	0 / 2142	-39.2	-39.2 0.53 (2)	10.00			
L-K	0 / 2382	-39.2	-39.2 0.52 (1)	10.00			
K-J	0 / 0	-39.2	-39.2 0.17 (3)	10.00			

DESIGN CRITERIA	
SPECIFIED LOADS:	
TOP CH. LL	= 34.8 PSF
DL	= 8.0 PSF
BOT CH. LL	= 10.5 PSF
DL	= 7.3 PSF
TOTAL LOAD	= 60.6 PSF

SPACING = 24.0 IN. C/C

LOADING IN FLAT SECTION BASED ON A SLOPE OF 2.00/12 MINIMUM

THIS TRUSS IS DESIGNED FOR RESIDENTIAL OR SMALL BUILDING REQUIREMENTS OF PART 9, NBCC 2015

THIS DESIGN COMPLIES WITH:
- PART 9 OF CBC 2018, ABC 2019
- PART 9 OF OBC 2012 (2019 AMENDMENT)
- CSA 088-14
- TPIC 2014

(55 % OF 48.1 P.S.F. G.S.L. PLUS 8.4 P.S.F. RAIN LOAD)
EQUALS 34.8 P.S.F. SPECIFIED ROOF LIVE LOAD

ALLOWABLE DEFL.(LL)= L/360 (1.09")
CALCULATED VERT. DEFL.(LL) = L/999 (0.12")
ALLOWABLE DEFL.(TL)= L/360 (1.09")
CALCULATED VERT. DEFL.(TL) = L/999 (0.21")

CSI: TC=0.76/1.00 (D-E-1) , BC=0.53/1.00 (N-P-2) ,
WB=0.55/1.00 (B-Q-1) , SSI=0.38/1.00 (D-E-1)

DOL LUMBER=1.00 NAIL=1.00 LS BEND=1.10 COMP=1.10
SHEAR=1.10 TENS=1.10

COMPANION LIVE LOAD FACTOR = 1.00

TRUSS PLATE MANUFACTURER IS NOT RESPONSIBLE FOR QUALITY CONTROL IN THE TRUSS MANUFACTURING PLANT .

NAIL VALUES
PLATE GRIP(DRY) SHEAR SECTION
(PSI) (PLI) (PLI)
MAX MIN MAX MIN MAX MIN
MT20 650 371 1747 788 1987 1873

PLATE PLACEMENT TOL. = 0.250 inches

PLATE ROTATION TOL. = 5.0 Deg.

JSI GRIP= 0.87 (F) (INPUT = 0.90)
JSI METAL = 0.69 (M) (INPUT = 1.00)




These plans have been reviewed for use with the corrections as noted. No other changes may be made without written approval of the Building Standards Branch. All work must comply with Zoning By-Law 2018-043, as amended, and the Ontario Building Code, as amended. These approved documents must be kept on site at all times. The building permit must be clearly posted on site at all times.

Discipline	Reviewer	BCIN	Date
Building Code	H. Authier	43236	2021-02-03
Seismic System			
Zoning			



READ ALL NOTES ON THIS PAGE AND ON ENGINEERING NOTE PAGE ENP-1. THIS NOTE PAGE IS AN INTEGRAL PART OF THIS DRAWING AS IT CONTAINS SPECIFICATIONS AND CRITERIA USED IN THE DESIGN OF THIS COMPONENT.

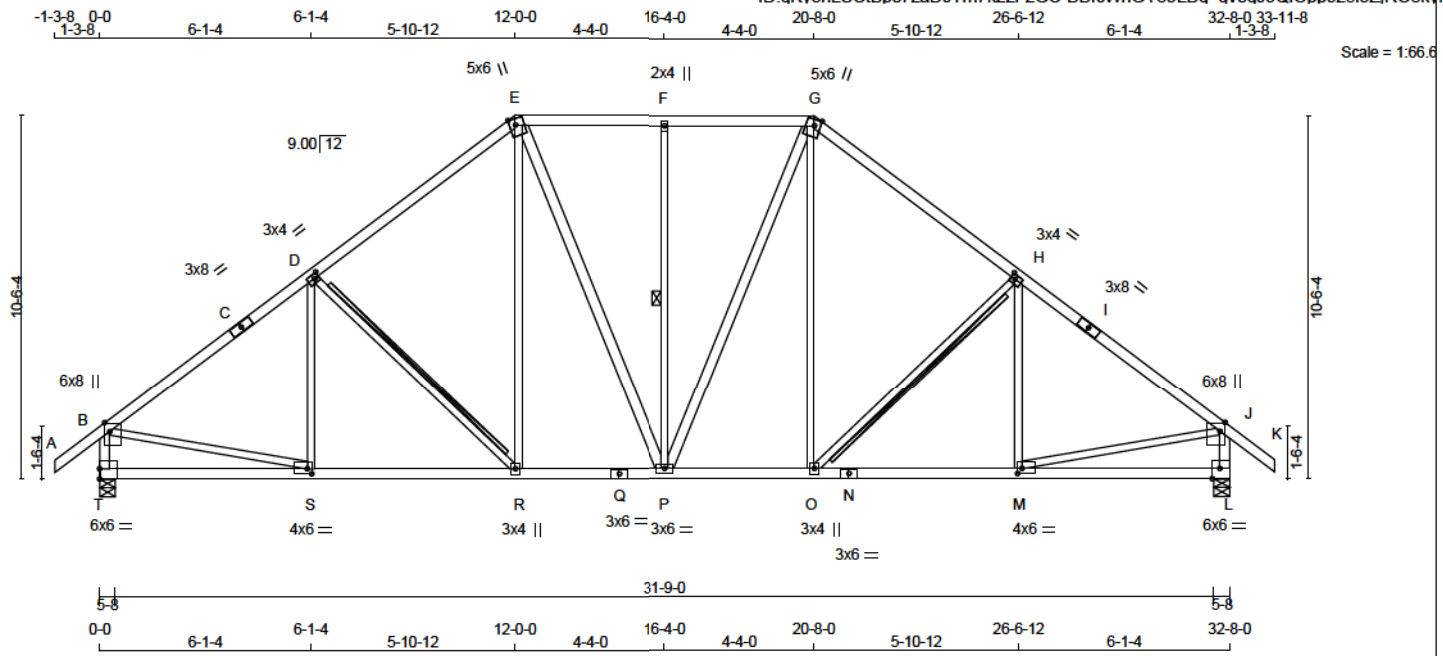

TOTAL WEIGHT = 168 LB

LUMBER				DESCR.
N. L. G. A. RULES	CHORDS	SIZE	LUMBER	
A - C	2x4	DRY	No.2	SPF
C - E	2x4	DRY	No.2	SPF
E - G	2x4	DRY	No.2	SPF
G - I	2x4	DRY	No.2	SPF
I - K	2x4	DRY	No.2	SPF
T - B	2x4	DRY	No.2	SPF
L - J	2x4	DRY	No.2	SPF
T - Q	2x4	DRY	No.2	SPF
Q - N	2x4	DRY	No.2	SPF
N - L	2x4	DRY	No.2	SPF
ALL WEBS	2x3	DRY	No.2	SPF
EXCEPT				
E - P	2x4	DRY	No.2	SPF
P - G	2x4	DRY	No.2	SPF

DRY: SEASONED LUMBER.

PLATES (table is in inches)

JT TYPE	PLATES	W	LEN	Y	X
B TMVW+p	MT20	6.0	8.0	3.00	1.75
C TS-t	MT20	3.0	8.0		
D TMWW-t	MT20	3.0	4.0	1.50	1.50
E TTWW+m	MT20	5.0	6.0	Edge 2.00	
F TMW+w	MT20	2.0	4.0		
G TTWW+m	MT20	5.0	6.0	Edge 2.00	
H TMWW-t	MT20	3.0	4.0	1.50	1.50
I TS-t	MT20	3.0	8.0		
J TMVW+p	MT20	6.0	8.0	3.00	1.75
L BMV1-t	MT20	6.0	6.0	Edge 2.50	
M BMWW-t	MT20	4.0	6.0	1.75	1.50
N BS-t	MT20	3.0	6.0		
O BMWW-t	MT20	3.0	4.0		
P BMWW-t	MT20	3.0	6.0		
Q BS-t	MT20	3.0	6.0		
R BMWW-t	MT20	3.0	4.0		
S BMWW-t	MT20	4.0	6.0	1.75	1.50
T BMV1-t	MT20	6.0	6.0	3.50	

Edge - INDICATES REFERENCE CORNER OF PLATE TOUCHES EDGE OF CHORD.

DIMENSIONS, SUPPORTS AND LOADINGS SPECIFIED BY FABRICATOR TO BE VERIFIED BY BUILDING DESIGNER

BEARINGS

	FACTORED GROSS REACTION	MAXIMUM FACTORED GROSS REACTION	INPUT DOWN	REQD BRG
JT VERT	2845	2845	0	5-8
T	2845	2845	0	5-8
L	2845	2845	0	5-8

UNFACTORED REACTIONS

1ST LCASE	MAX	MIN	COMPONENT REACTIONS	
JT COMBINED	SNOW	LIVE	PERM.LIVE	WIND
T	2098	1233 / 0	343 / 0	0 / 0
L	2098	1233 / 0	343 / 0	0 / 0

BEARING MATERIAL TO BE SPF NO.2 OR BETTER AT JOINT(S) T, L

BRACING

TOP CHORD TO BE SHEATHED OR MAX. PURLIN SPACING = 3.19 FT.
MAX. UNBRACED BOTTOM CHORD LENGTH = 10.00 FT OR RIGID CEILING DIRECTLY APPLIED.

ALL PITCH BREAKS AND PERIMETER CORNER JOINTS MUST BE LATERALLY RESTRAINED.

1 - 1x4 LATERAL BRACE(S) AT 1/2 LENGTH OF F-P. DBS = 20-00. CBF = 81 LBS.
2x4 DRY SPF No.2 T-BRACE AT D-R, H-O

DBS = DIAGONAL BRACE SPACING (MAX). CBF = CUMULATIVE BRACING FORCE (PER BRACE). FASTEN LATERAL BRACE(S) USING (0.122"x3") SPIRAL NAILS: 1 NAIL FOR 2x3 BRACE(S), 2 FOR 1x4, 2x4, 2x5, 3 FOR 2x6, 4 FOR 2x8, 5 FOR 2x10, AND 6 FOR 2x12.

FASTEN T AND I-BRACES TO NARROW EDGE OF WEB WITH ONE ROW PER PLY OF 3" COMMON WIRE NAILS @ 6" O.C. WITH 3" MINIMUM END DISTANCE. BRACE MUST COVER 90% OF WEB LENGTH.

END VERTICAL(S) MUST BE SHEATHED OR HAVE BRACES AS INDICATED IN THE MAX. UNBRACED LENGTH COLUMN OF THE TABLE BELOW

LOADING

TOTAL LOAD CASES: (4)

CHORDS				WEBS			
MEMB.	FORCE (LBS)	FACTORED (PLF)	VERT. LOAD (LC)	MAX UNBRAC LENGTH	MEMB.	FORCE (LBS)	MAX FACTORED (LC)
FR-TO					FR-TO		
A-B	0 / 51	-124.4	-124.4	0.17 (1)	10.00	S-D	-203 / 146
B-C	-2908 / 0	-124.4	-124.4	0.83 (1)	3.19	D-R	-592 / 0
C-D	-2908 / 0	-124.4	-124.4	0.83 (1)	3.19	R-E	0 / 610
D-E	-2547 / 0	-124.4	-124.4	0.73 (1)	3.52	E-P	0 / 432
E-F	-2165 / 0	-124.4	-124.4	0.34 (1)	4.30	P-F	-840 / 0
F-G	-2165 / 0	-124.4	-124.4	0.34 (1)	4.30	P-G	0 / 432
G-H	-2547 / 0	-124.4	-124.4	0.73 (1)	3.52	O-G	0 / 610
H-I	-2908 / 0	-124.4	-124.4	0.83 (1)	3.19	O-H	-592 / 0
I-J	-2908 / 0	-124.4	-124.4	0.83 (1)	3.19	M-H	-203 / 146
J-K	0 / 51	-124.4	-124.4	0.17 (1)	10.00	B-S	0 / 2462
T-B	-2748 / 0	0.0	0.0	0.29 (1)	5.20	M-J	0 / 2462
L-J	-2748 / 0	0.0	0.0	0.29 (1)	5.20		
T-S	0 / 0	-39.2	-39.2	0.29 (3)	10.00		
S-R	0 / 2417	-39.2	-39.2	0.58 (2)	10.00		
R-Q	0 / 1997	-39.2	-39.2	0.43 (1)	10.00		
Q-P	0 / 1997	-39.2	-39.2	0.43 (1)	10.00		
P-O	0 / 1997	-39.2	-39.2	0.43 (1)	10.00		
O-N	0 / 2417	-39.2	-39.2	0.58 (2)	10.00		
N-M	0 / 2417	-39.2	-39.2	0.58 (2)	10.00		
M-L	0 / 0	-39.2	-39.2	0.29 (3)	10.00		

DESIGN CRITERIA

SPECIFIED LOADS:

TOP CH. LL	= 34.8	PSF
DL	= 8.0	PSF
BOT CH. LL	= 10.5	PSF
DL	= 7.3	PSF
TOTAL LOAD	= 60.6	PSF

SPACING = 24.0 IN. C/C

LOADING IN FLAT SECTION BASED ON A SLOPE OF 2.00/12 MINIMUM

THIS TRUSS IS DESIGNED FOR RESIDENTIAL OR SMALL BUILDING REQUIREMENTS OF PART 9, NBCC 2015

THIS DESIGN COMPLIES WITH:

- PART 9 OF CBC 2018, ABC 2019
- PART 9 OF OBC 2012 (2019 AMENDMENT)
- CSA 088-14
- TPIC 2014

(55 % OF 48.1 P.S.F. G.S.L. PLUS 8.4 P.S.F. RAIN LOAD) EQUALS 34.8 P.S.F. SPECIFIED ROOF LIVE LOAD

ALLOWABLE DEFL.(LL)= L/360 (1.09")
CALCULATED VERT. DEFL.(LL)= L/999 (0.11")
ALLOWABLE DEFL.(TL)= L/360 (1.09")
CALCULATED VERT. DEFL.(TL)= L/999 (0.19")

CSI: TC=0.83/1.00 (B-D-1), BC=0.58/1.00 (R-S-2), WB=0.55/1.00 (B-S-1), SSI=0.29/1.00 (B-D-1)

DOL LUMBER=1.00 NAIL=1.00 LS BEND=1.10 COMP=1.10 SHEAR=1.10 TENS=1.10

COMPANION LIVE LOAD FACTOR = 1.00

TRUSS PLATE MANUFACTURER IS NOT RESPONSIBLE FOR QUALITY CONTROL IN THE TRUSS MANUFACTURING PLANT.

NAIL VALUES

PLATE GRIP(DRY) SHEAR SECTION (PSI) (PLI) (PLI)
MAX MIN MAX MIN MAX MIN
MT20 650 371 1747 788 1987 1873

PLATE PLACEMENT TOL = 0.250 inches

PLATE ROTATION TOL = 5.0 Deg.

JSI GRIP= 0.88 (P) (INPUT = 0.80)
JSI METAL = 0.71 (N) (INPUT = 1.00)




These plans have been reviewed for use with the corrections as noted. No other changes may be made without written approval of the Building Standards Branch. All work must comply with Zoning By-Law 2018-043, as amended, and the Ontario Building Code, as amended. These approved documents must be kept on site at all times. The building permit must be clearly posted on site at all times.

Discipline	Reviewer	BCIN	Date
Building Code	H. Author	43236	2021-02-03
Seismic System			
Zoning			



READ ALL NOTES ON THIS PAGE AND ON ENGINEERING NOTE PAGE ENP-1. THIS NOTE PAGE IS AN INTEGRAL PART OF THIS DRAWING AS IT CONTAINS SPECIFICATIONS AND CRITERIA USED IN THE DESIGN OF THIS COMPONENT.



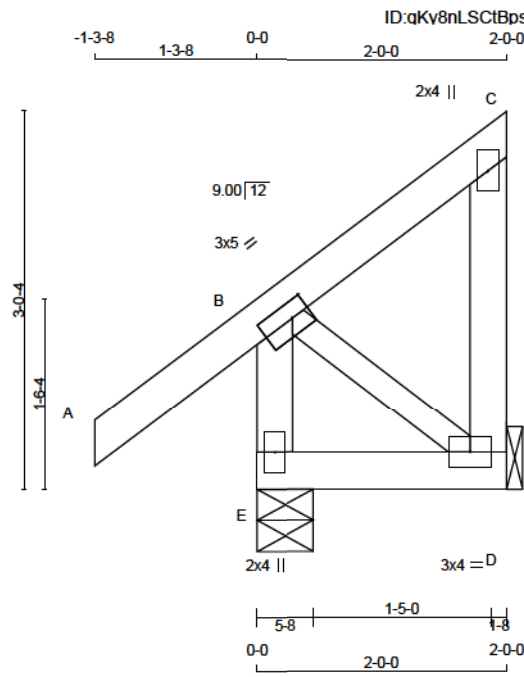

LUMBER
N. L. G. A. RULES

CHORDS	SIZE	LUMBER	DESCR.
E - B	2x4	DRY No.2	SPF
A - C	2x4	DRY No.2	SPF
D - C	2x4	DRY No.2	SPF
E - D	2x4	DRY No.2	SPF

ALL WEBS 2x3 DRY No.2 SPF
DRY: SEASONED LUMBER.

PLATES (table is in inches)

JT TYPE	PLATES	W	LEN	Y	X
B	TMVW-t	MT20	3.0	5.0	1.50 1.75
C	TMV+p	MT20	2.0	4.0	
D	BMVW1-t	MT20	3.0	4.0	
E	BMV1+p	MT20	2.0	4.0	

DIMENSIONS, SUPPORTS AND LOADINGS SPECIFIED BY FABRICATOR TO BE VERIFIED BY BUILDING DESIGNER

BEARINGS

JT	FACTORED GROSS REACTION	MAXIMUM FACTORED GROSS REACTION	INPUT BRG	REQRD BRG
E	335 0	335 0	5-8	1-8
D	164 0	164 0	1-8	1-8

SEE MITEK STANDARD DETAIL B97791H FOR CONNECTION TO JOINT(S) D

UNFACTORED REACTIONS

JT	1ST LCASE	MAX	MIN	COMPONENT REACTIONS
E	239	166 / 0	21 / 0	PERM. LIVE 0 / 0 WIND 0 / 0 DEAD 53 / 0 SOIL 0 / 0
D	121	70 / 0	21 / 0	0 / 0 0 / 0 31 / 0 0 / 0

BEARING MATERIAL TO BE SPF NO.2 OR BETTER AT JOINT(S) E

BRACING
TOP CHORD TO BE SHEATHED OR MAX. PURLIN SPACING = 10.00 FT.
MAX. UNBRACED BOTTOM CHORD LENGTH = 10.00 FT OR RIGID CEILING DIRECTLY APPLIED.

ALL PITCH BREAKS AND PERIMETER CORNER JOINTS MUST BE Laterally RESTRAINED.

LOADING
TOTAL LOAD CASES: (5)

MEMB.	CHORDS		WEBS	
	MAX. FACTORED FORCE (LBS)	FACTORED VERT. LOAD (PLF)	MAX. FACTORED FORCE (LBS)	FACTORED VERT. LOAD (PLF)
FR-TO		FROM TO	FR-TO	FROM TO
E-B	-298 / 0	0.0 0.0 0.03 (1)	7.81	0 / 0 0.00 (1)
A-B	0 / 51	-124.4 -124.4 0.17 (1)	10.00	
B-C	0 / 0	-124.4 -124.4 0.08 (1)	10.00	
D-C	-124 / 0	0.0 0.0 0.02 (1)	7.81	
E-D	0 / 0	-39.2 -39.2 0.04 (3)	10.00	

CANTILEVER ANALYSIS HAS BEEN CONSIDERED IN THIS DESIGN

DESIGN CRITERIA

SPECIFIED LOADS:
TOP CH. LL = 34.8 PSF
DL = 8.0 PSF
BOT CH. LL = 10.5 PSF
DL = 7.3 PSF
TOTAL LOAD = 60.6 PSF

SPACING = 24.0 IN. C/C

THIS TRUSS IS DESIGNED FOR RESIDENTIAL OR SMALL BUILDING REQUIREMENTS OF PART 9, NBCC 2015

THIS DESIGN COMPLIES WITH:
- PART 9 OF BCBC 2018, ABC 2019
- PART 9 OF OBC 2012 (2019 AMENDMENT)
- CSA 086-14
- TPIC 2014

(55 % OF 48.1 P.S.F. G.S.L. PLUS 8.4 P.S.F. RAIN LOAD)
EQUALS 34.8 P.S.F. SPECIFIED ROOF LIVE LOAD

ALLOWABLE DEFL.(LL)= L/360 (0.19")
CALCULATED VERT. DEFL.(LL) = L/999 (0.00")
ALLOWABLE DEFL.(TL)= L/360 (0.19")
CALCULATED VERT. DEFL.(TL) = L/999 (0.00")

CSI: TC=0.17/1.00 (A-B:1), BC=0.04/1.00 (D-E:3), WB=0.00/1.00 (B-D:1), SS=0.11/1.00 (A-B:1)

DOL LUMBER=1.00 NAIL=1.00 LS BEND=1.10 COMP=1.10
SHEAR=1.10 TENS=1.10

COMPANION LIVE LOAD FACTOR = 1.00

TRUSS PLATE MANUFACTURER IS NOT RESPONSIBLE FOR QUALITY CONTROL IN THE TRUSS MANUFACTURING PLANT .

NAIL VALUES

PLATE	GRIP(DRY)	SHEAR (PSI)	SECTION (PLI)
MT20	850	371	1747 788 1987 1873

PLATE PLACEMENT TOL. = 0.250 inches

PLATE ROTATION TOL. = 5.0 Deg.

JSI GRIP= 0.24 (B) (INPUT = 0.90)
JSI METAL = 0.07 (C) (INPUT = 1.00)




READ ALL NOTES ON THIS PAGE AND ON ENGINEERING NOTE PAGE ENP-1. THIS NOTE PAGE IS AN INTEGRAL PART OF THIS DRAWING AS IT CONTAINS SPECIFICATIONS AND CRITERIA USED IN THE DESIGN OF THIS COMPONENT.



These plans have been reviewed for use with the corrections as noted. No other changes may be made without written approval of the Building Standards Branch. All work must comply with Zoning By-Law 2018-043, as amended, and the Ontario Building Code, as amended. These approved documents must be kept on site at all times. The building permit must be clearly posted on site at all times.

Discipline	Reviewer	BCIN	Date
Building Code	H. Authier	43236	2021-02-03
Sewage System			
Zoning			



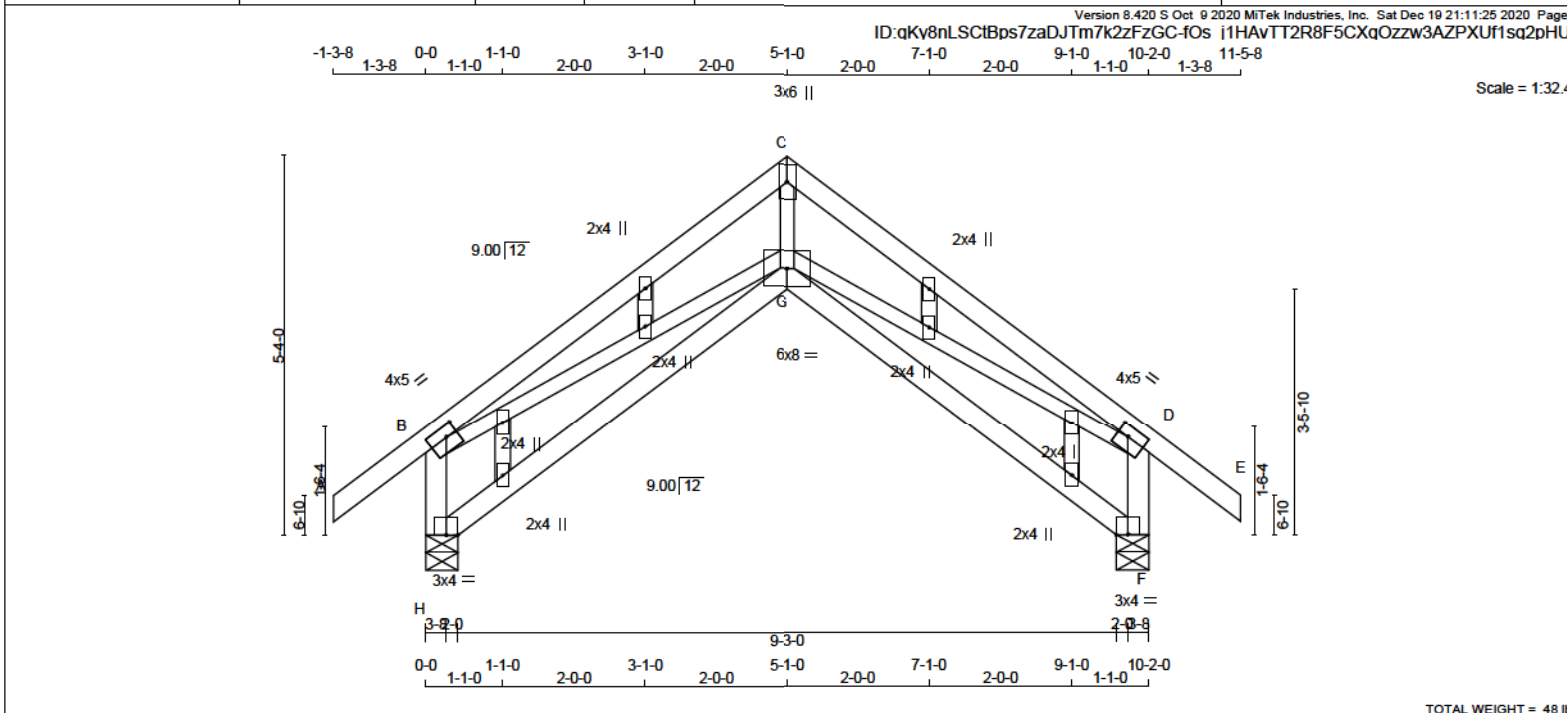


LUMBER										DIMENSIONS, SUPPORTS AND LOADINGS SPECIFIED BY FABRICATOR TO BE VERIFIED BY BUILDING DESIGNER										DESIGN CRITERIA									
N. L. G. A. RULES										BEARINGS										SPECIFIED LOADS:									
CHORDS SIZE LUMBER										FACTORED GROSS REACTION MAXIMUM FACTORED GROSS REACTION INPUT BRG REQRD BRG										TOP CH. LL = 34.8 PSF									
H - B 2x4 DRY No.2 SPF										JT VERT HORZ DOWN HORZ UPLIFT IN-SX IN-SX										DL = 8.0 PSF									
A - C 2x4 DRY No.2 SPF										H 1004 0 1004 0 0 5-8 5-8										BOT CH. LL = 10.5 PSF									
C - E 2x4 DRY No.2 SPF										F 1004 0 1004 0 0 5-8 5-8										DL = 7.3 PSF									
F - D 2x4 DRY No.2 SPF																				TOTAL LOAD = 60.6 PSF									
H - G 2x4 DRY No.2 SPF																													
G - F 2x4 DRY No.2 SPF																													
										UNFACTORED REACTIONS										SPACING = 24.0 IN. C/C									
ALL WEBS 2x3 DRY No.2 SPF										1ST LCASE MAX/MIN COMPONENT REACTIONS										THIS TRUSS IS DESIGNED FOR RESIDENTIAL OR SMALL BUILDING REQUIREMENTS OF PART 9, NBCC 2015									
ALL GABLE WEBS 2x3 DRY No.2 SPF										JT COMBINED SNOW LIVE PERM.LIVE WIND DEAD SOIL										THIS DESIGN COMPLIES WITH:									
DRY: SEASONED LUMBER.										H 734 450 / 0 107 / 0 0 / 0 0 / 0 178 / 0 0 / 0										- PART 9 OF BCBC 2018, ABC 2019									
										F 734 450 / 0 107 / 0 0 / 0 0 / 0 178 / 0 0 / 0										- PART 9 OF OBC 2012 (2019 AMENDMENT)									
																				- CSA 086-14									
GABLE STUDS SPACED AT 2-0-0 OC.										BEARING MATERIAL TO BE SPF NO.2 OR BETTER AT JOINT(S) H, F										- TPIC 2014									
										BRACING																			
										TOP CHORD TO BE SHEATHED OR MAX. PURLIN SPACING = 4.51 FT.																			
										MAX. UNBRACED BOTTOM CHORD LENGTH = 10.00 FT OR RIGID CEILING DIRECTLY APPLIED.																			
										ALL PITCH BREAKS AND PERIMETER CORNER JOINTS MUST BE Laterally RESTRAINED.										(55 % OF 48.1 P.S.F. G.S.L. PLUS 8.4 P.S.F. RAIN LOAD) EQUALS 34.8 P.S.F. SPECIFIED ROOF LIVE LOAD									
PLATES (table is in inches)										LOADING										ALLOWABLE DEFL.(LL)= L/360 (0.34")									
JT TYPE PLATES W LEN Y X										TOTAL LOAD CASES: (4)										CALCULATED VERT. DEFL.(LL) = L/ 969 (0.09")									
B TMVW-t MT20 4.0 5.0 1.75 2.00										CHORDS										ALLOWABLE DEFL.(TL)= L/360 (0.34")									
C TTW+p MT20 3.0 6.0										MEMB. MAX. FACTORED FORCE (LBS) VERT. LOAD (PLF) CSI (LC) UNBRACED LENGTH										CALCULATED VERT. DEFL.(TL) = L/ 819 (0.15")									
D TMVW-t MT20 4.0 5.0 1.75 2.00										FR-TO FROM TO										CSI: TC=0.47/1.00 (C-D-1), BC=0.25/1.00 (G-H-3), WB=0.35/1.00 (D-G-1), SSI=0.20/1.00 (C-D-1)									
F BVM1-p MT20 3.0 4.0										H-B -904 / 0 0.0 0.0 0.10 (1) 7.81										DOL LUMBER=1.00 NAIL=1.00 LS BEND=1.10 COMP=1.10 SHEAR=1.10 TENS=1.10									
G BBWWW-p MT20 6.0 8.0										A-B 0 / 51 -124.4 -124.4 0.17 (1) 10.00										COMPANION LIVE LOAD FACTOR = 1.00									
H BVM1-p MT20 3.0 4.0										B-C -1702 / 0 -124.4 -124.4 0.47 (1) 4.51										TRUSS PLATE MANUFACTURER IS NOT RESPONSIBLE FOR QUALITY CONTROL IN THE TRUSS MANUFACTURING PLANT .									
I J, K, L, M, N, O, P										C-D -1702 / 0 -124.4 -124.4 0.47 (1) 4.51										NAIL VALUES									
I NF+rw MT20 2.0 4.0										D-E 0 / 51 -124.4 -124.4 0.17 (1) 10.00										PLATE GRIP(DRY) SHEAR SECTION (PSI) (PLI) (PLI)									
										F-D -904 / 0 0.0 0.0 0.10 (1) 7.81										MAX MIN MAX MIN MAX MIN									
																				MT20 850 371 1747 788 1987 1873									
										H-G 0 / 0 -39.2 -39.2 0.25 (3) 10.00										PLATE PLACEMENT TOL. = 0.250 inches									
										G-F 0 / 0 -39.2 -39.2 0.25 (3) 10.00																			

These plans have been reviewed for use with the corrections as noted. No other changes may be made without written approval of the Building Standards Branch. All work must comply with Zoning By-Law 2018-043, as amended, and the Ontario Building Code, as amended. These approved documents must be kept on site at all times. The building permit must be clearly posted on site at all times.

Discipline	Reviewer	BCIN	Date
Building Code	H. Author	43236	2021-02-03
Severage System			
Zoning			

READ ALL NOTES ON THIS PAGE AND ON ENGINEERING NOTE PAGE ENP-1. THIS NOTE PAGE IS AN INTEGRAL PART OF THIS DRAWING AS IT CONTAINS SPECIFICATIONS AND CRITERIA USED IN THE DESIGN OF THIS COMPONENT.

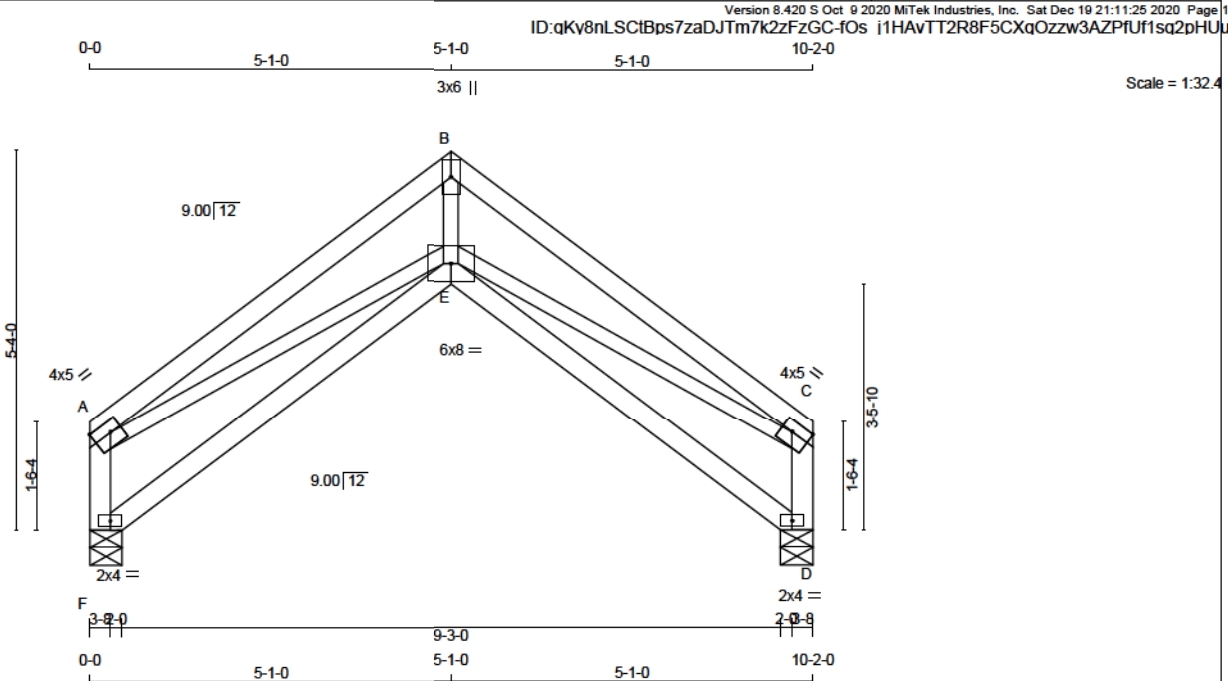

LUMBER					DESCR.
N. L. G. A. RULES	CHORDS	SIZE	LUMBER		
F - A	2x4	DRY	No.2		SPF
A - B	2x4	DRY	No.2		SPF
B - C	2x4	DRY	No.2		SPF
D - C	2x4	DRY	No.2		SPF
F - E	2x4	DRY	No.2		SPF
E - D	2x4	DRY	No.2		SPF
ALL WEBS 2x3 DRY No.2					SPF
DRY: SEASONED LUMBER.					

PLATES (table is in inches)					
JT TYPE	PLATES	W	LEN	Y	X
A TMVW-t	MT20	4.0	5.0	1.75	Edge
B TTW+p	MT20	3.0	6.0		
C TMVW-t	MT20	4.0	5.0	1.75	Edge
D BVM1-p	MT20	2.0	4.0		
E BVM1-p	MT20	2.0	4.0		
F BVM1-p	MT20	2.0	4.0		

Edge - INDICATES REFERENCE CORNER OF PLATE TOUCHES
EDGE OF CHORD.

DIMENSIONS, SUPPORTS AND LOADINGS SPECIFIED BY FABRICATOR TO BE VERIFIED BY BUILDING DESIGNER

BEARINGS

JT	FACTORED GROSS REACTION		MAXIMUM FACTORED GROSS REACTION		INPUT BRG		REQRD BRG	
	VERT	HORZ	DOWN	HORZ	UPLIFT	IN-SX	IN-SX	
F	832	0	832	0	0	5-8	1-8	
D	832	0	832	0	0	5-8	1-8	

UNFACTORED REACTIONS

1ST LCASE MAX/MIN COMPONENT REACTIONS							
JT	COMBINED	SNOW	LIVE	PERM.LIVE	WIND	DEAD	SOIL
F	616	354 / 0	107 / 0	0 / 0	0 / 0	156 / 0	0 / 0
D	616	354 / 0	107 / 0	0 / 0	0 / 0	156 / 0	0 / 0

BEARING MATERIAL TO BE SPF NO.2 OR BETTER AT JOINT(S) F, D

BRACING

TOP CHORD TO BE SHEATHED OR MAX. PURLINE SPACING = 4.51 FT.
MAX. UNBRACED BOTTOM CHORD LENGTH = 10.00 FT OR RIGID CEILING DIRECTLY APPLIED.

ALL PITCH BREAKS AND PERIMETER CORNER JOINTS MUST BE Laterally RESTRAINED.

LOADING

TOTAL LOAD CASES: (4)

CHORDS				WEBS			
MEMB.	MAX. FACTORED FORCE (LBS)	FACTORED VERT. LOAD (PLF)	FACTORED LC1 MAX (LC) UNBRAC	MEMB.	MAX. FACTORED FORCE (LBS)	MAX. FACTORED CS1 (LC)	
FR-TO		FROM TO	LENGTH	FR-TO			
F-A	-732 / 0	0.0	0.0 0.08 (1)	E-B	0 / 1482	0.33 (1)	
A-B	-1762 / 0	-124.4	-124.4 0.47 (1)	E-C	0 / 1549	0.35 (1)	
B-C	-1762 / 0	-124.4	-124.4 0.47 (1)	A-E	0 / 1549	0.35 (1)	
D-C	-732 / 0	0.0	0.0 0.08 (1)				
F-E	0 / 0	-39.2	-39.2 0.24 (3)				
E-D	0 / 0	-39.2	-39.2 0.24 (3)				

DESIGN CRITERIA

SPECIFIED LOADS:

TOP CH.	LL = 34.8	PSF
	DL = 8.0	PSF
BOT CH.	LL = 10.5	PSF
	DL = 7.3	PSF
TOTAL LOAD	= 60.6	PSF

SPACING = 24.0 IN. C/C

THIS TRUSS IS DESIGNED FOR RESIDENTIAL OR SMALL BUILDING REQUIREMENTS OF PART 9, NBCC 2015

THIS DESIGN COMPLIES WITH:

- PART 9 OF BCBC 2018, ABC 2019
- PART 9 OF OBC 2012 (2019 AMENDMENT)
- CSA 086-14
- TPIC 2014

(55 % OF 48.1 P.S.F. G.S.L. PLUS 8.4 P.S.F. RAIN LOAD)
EQUALS 34.8 P.S.F. SPECIFIED ROOF LIVE LOAD

ALLOWABLE DEFL.(LL) = L/360 (0.34")
CALCULATED VERT. DEFL.(LL) = L/969 (0.09")
ALLOWABLE DEFL.(TL) = L/360 (0.34")
CALCULATED VERT. DEFL.(TL) = L/821 (0.15")

CSI: TC=0.47/1.00 (B-C:1), BC=0.24/1.00 (E-F:3),
WB=0.35/1.00 (C-E:1), SSI=0.20/1.00 (B-C:1)

DOL LUMBER=1.00 NAIL=1.00 LS BEND=1.10 COMP=1.10
SHEAR=1.10 TENS=1.10

COMPANION LIVE LOAD FACTOR = 1.00

TRUSS PLATE MANUFACTURER IS NOT RESPONSIBLE FOR QUALITY CONTROL IN THE TRUSS MANUFACTURING PLANT .

NAIL VALUES

PLATE GRIP(DRY) SHEAR	SECTION
(PSI)	(PLI)
MAX MIN	MAX MIN
MT20 650 371 1747 788 1987 1873	

PLATE PLACEMENT TOL. = 0.250 inches

PLATE ROTATION TOL. = 5.0 Deg.

JSI GRIP= 0.82 (C) (INPUT = 0.90)
JSI METAL = 0.84 (D) (INPUT = 1.00)




READ ALL NOTES ON THIS PAGE AND ON ENGINEERING NOTE PAGE ENP-1. THIS NOTE PAGE IS AN INTEGRAL PART OF THIS DRAWING AS IT CONTAINS SPECIFICATIONS AND CRITERIA USED IN THE DESIGN OF THIS COMPONENT.



These plans have been reviewed for use with the corrections as noted. No other changes may be made without written approval of the Building Standards Branch. All work must comply with Zoning By-Law 2018-043, as amended, and the Ontario Building Code, as amended. These approved documents must be kept on site at all times. The building permit must be clearly posted on site at all times.

Discipline	Reviewer	BCIN	Date
Building Code	H. Authier	43236	2021-02-03
Severage System			
Zoning			




 


MI

CANTILEVER ANALYSIS HAS BEEN CONSIDERED IN THIS DESIGN

JSI GRIP= 0.45 (B) (INPUT = 0.90)
JSI METAL= 0.07 (B) (INPUT = 1.00)

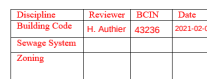

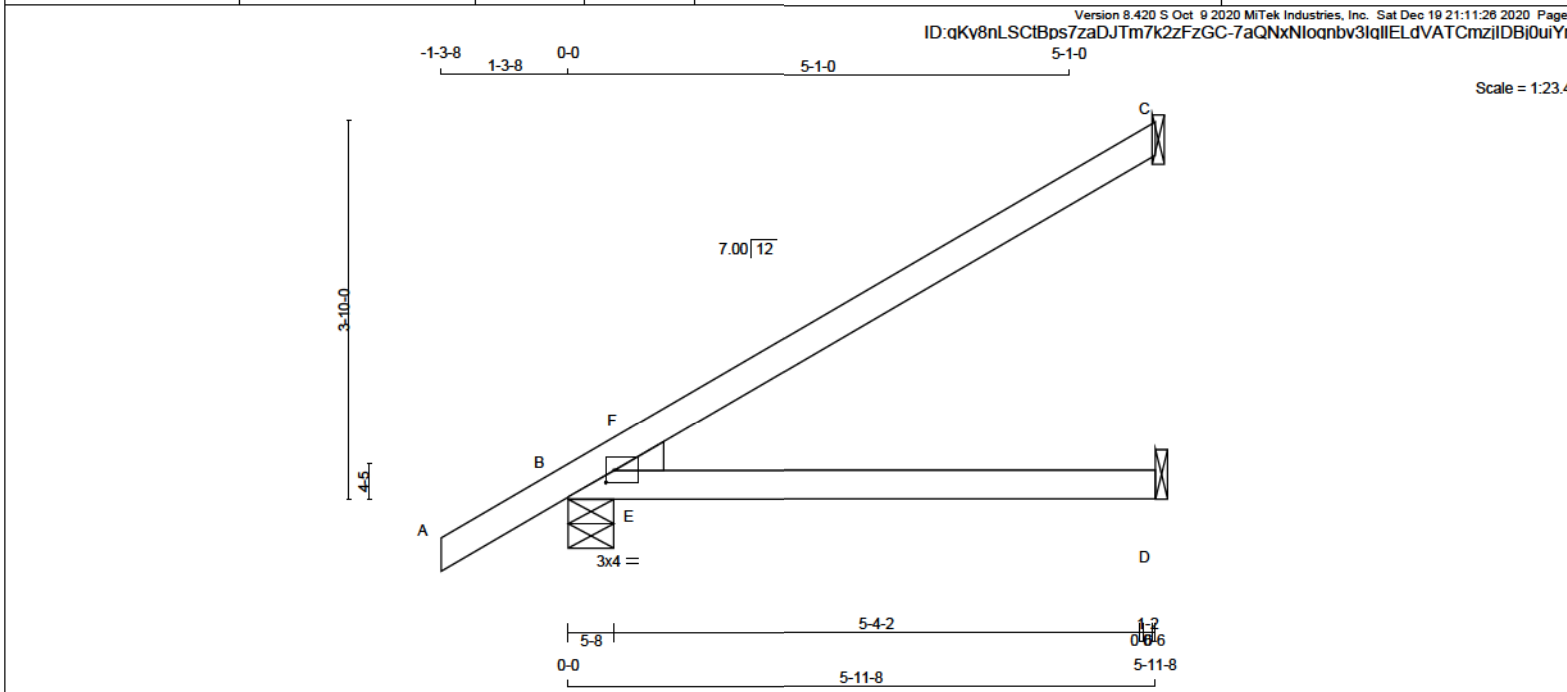

LUMBER
N. L. G. A. RULES
CHORDS SIZE LUMBER DESCR.
A - C 2x4 DRY No.2 SPF
B - D 2x4 DRY 2100F 1.8E SPF
DRY: SEASONED LUMBER.

PLATES (table is in inches)
JT TYPE PLATES W LEN Y X
B TMBH1-I MT20 3.0 4.0 1.50 1.00

DIMENSIONS, SUPPORTS AND LOADINGS SPECIFIED BY FABRICATOR TO BE VERIFIED BY BUILDING DESIGNER

BEARINGS		FACTORED GROSS REACTION		MAXIMUM FACTORED GROSS REACTION		INPUT BRG		REQRD BRG		HEEL WEDGE	
JT	VERT	HORZ	DOWN	HORZ	UPLIFT	IN-SX	BRG	IN-SX	BRG	HEEL	WEDGE
C	315	0	315	0	0	1-8	1-8	1-8	1-8	2x4 L	
B	657	0	657	0	0	5-8	1-8	1-8	1-8		
D	172	0	180	0	0	1-8	1-8	1-8	1-8		

SEE MITEK STANDARD DETAIL B97791H FOR CONNECTION TO JOINT(S) C, D

UNFACTORED REACTIONS		1ST LCASE		MAX / MIN COMPONENT REACTIONS		WIND		DEAD		SOIL	
JT	COMBINED	SNOW	LIVE	PERM. LIVE	WIND	DEAD	SOIL	JT	COMBINED	SNOW	LIVE
C	220	168 / 0	8 / 0	0 / 0	0 / 0	44 / 0	0 / 0	C	220	168 / 0	8 / 0
B	478	302 / 0	63 / 0	0 / 0	0 / 0	113 / 0	0 / 0	B	478	302 / 0	63 / 0
D	141	39 / 0	55 / 0	0 / 0	0 / 0	47 / 0	0 / 0	D	141	39 / 0	55 / 0

BEARING MATERIAL TO BE SPF NO.2 OR BETTER AT JOINT(S) C, B

BRACING
TOP CHORD TO BE SHEATHED OR MAX. PURLIN SPACING = 6.25 FT.
MAX. UNBRACED BOTTOM CHORD LENGTH = 10.00 FT OR RIGID CEILING DIRECTLY APPLIED.

ALL PITCH BREAKS AND PERIMETER CORNER JOINTS MUST BE Laterally RESTRAINED.

LOADING
TOTAL LOAD CASES: (4)

CHORDS		MAX. FACTORED FORCE (LBS)		FACTORED VERT. LOAD (PLF)		MAX. FACTORED FORCE (LBS)		WEBS		MAX. FACTORED FORCE (LBS)		MAX. FACTORED FORCE (LBS)	

DESIGN CRITERIA

SPECIFIED LOADS:
TOP CH. LL = 34.8 PSF
DL = 8.0 PSF
BOT CH. LL = 10.5 PSF
DL = 7.3 PSF
TOTAL LOAD = 60.6 PSF

SPACING = 24.0 IN. C/C

THIS TRUSS IS DESIGNED FOR RESIDENTIAL OR SMALL BUILDING REQUIREMENTS OF PART 9, NBCC 2015

THIS DESIGN COMPLIES WITH:
- PART 9 OF BCBC 2018, ABC 2019
- PART 9 OF OBC 2012 (2019 AMENDMENT)
- CSA 088-14
- TPIC 2014

(55 % OF 48.1 P.S.F. G.S.L. PLUS 8.4 P.S.F. RAIN LOAD)
EQUALS 34.8 P.S.F. SPECIFIED ROOF LIVE LOAD

ALLOWABLE DEFL.(LL)= L/360 (0.20")
CALCULATED VERT. DEFL.(LL) = L/626 (0.11")
ALLOWABLE DEFL.(TL)= L/360 (0.20")
CALCULATED VERT. DEFL.(TL) = L/365 (0.20")

CSI: TC=0.54/1.00 (C-F:1), BC=0.34/1.00 (D-E:1),
WB=0.00/1.00 (E-F:1), SSI=0.40/1.00 (B-E:1)

DOL LUMBER=1.00 NAIL=1.00 LS BEND=1.10 COMP=1.10
SHEAR=1.10 TENS=1.10

COMPANION LIVE LOAD FACTOR = 1.00

TRUSS PLATE MANUFACTURER IS NOT RESPONSIBLE FOR QUALITY CONTROL IN THE TRUSS MANUFACTURING PLANT .

NAIL VALUES
PLATE GRIP(DRY) SHEAR SECTION
(PSI) (PLI) (PLI)
MAX MIN MAX MIN MAX MIN
MT20 650 371 1747 788 1987 1873

PLATE PLACEMENT TOL. = 0.250 inches

PLATE ROTATION TOL. = 5.0 Deg.

JSI GRIP= 0.85 (B) (INPUT = 0.90)
JSI METAL = 0.10 (B) (INPUT = 1.00)




READ ALL NOTES ON THIS PAGE AND ON ENGINEERING NOTE PAGE ENP-1. THIS NOTE PAGE IS AN INTEGRAL PART OF THIS DRAWING AS IT CONTAINS SPECIFICATIONS AND CRITERIA USED IN THE DESIGN OF THIS COMPONENT.




These plans have been reviewed for use with the corrections as noted. No other changes may be made without written approval of the Building Standards Branch. All work must comply with Zoning By-Law 2018-043, as amended, and the Ontario Building Code, as amended. These approved documents must be kept on site at all times. The building permit must be clearly posted on site at all times.

Discipline	Reviewer	BCIN	Date
Building Code	H. Authier	43236	2021-02-03
Sewage System			
Zoning			



 

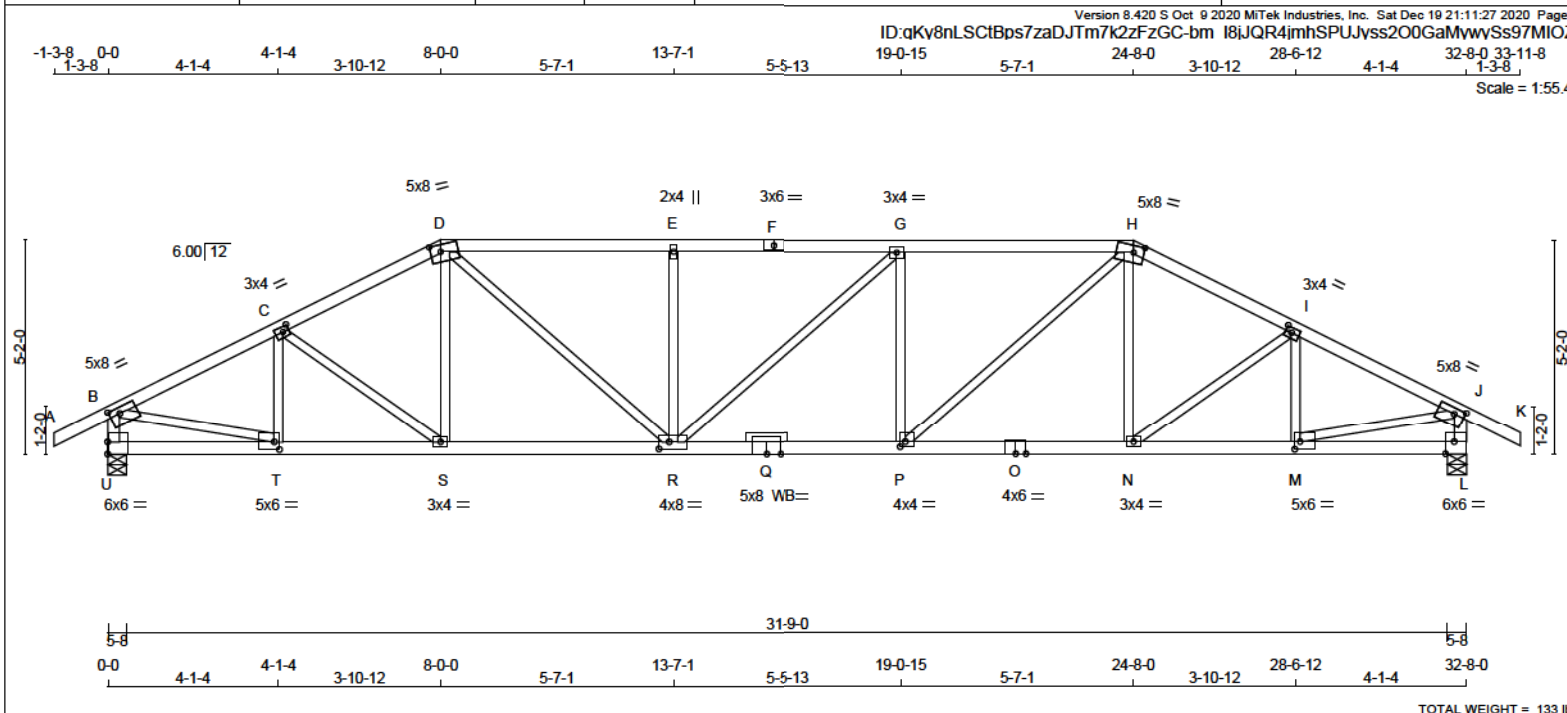


LUMBER										DIMENSIONS, SUPPORTS AND LOADINGS SPECIFIED BY FABRICATOR TO BE VERIFIED BY BUILDING DESIGNER										DESIGN CRITERIA									
N. L. G. A. RULES										BEARINGS										SPECIFIED LOADS:									
CHORDS SIZE LUMBER DESCR.										FACTORED GROSS REACTION MAXIMUM FACTORED GROSS REACTION INPUT BRG REQRD BRG										TOP CH. LL = 34.8 PSF									
A - D 2x4 DRY No.2 SPF										JT VERT HORZ DOWN HORZ UPLIFT IN-SX IN-SX										DL = 8.0 PSF									
D - F 2x4 DRY No.2 SPF										U 2842 0 2842 0 0 5-8 5-8										BOT CH. LL = 10.5 PSF									
F - H 2x4 DRY No.2 SPF										L 2842 0 2842 0 0 5-8 5-8										DL = 7.3 PSF									
H - K 2x4 DRY No.2 SPF																				TOTAL LOAD = 60.6 PSF									
U - B 2x4 DRY No.2 SPF																													
L - J 2x4 DRY No.2 SPF																													
U - Q 2x4 DRY No.2 SPF																													
Q - O 2x4 DRY No.2 SPF																													
O - L 2x4 DRY No.2 SPF																													
ALL WEBS EXCEPT 2x3 DRY No.2 SPF																													
DRY: SEASONED LUMBER.																													
										UNFACTORED REACTIONS										SPACING = 24.0 IN. C/C									
										1ST LCASE MAX/MIN COMPONENT REACTIONS																			
										JT COMBINED SNOW LIVE PERM.LIVE WIND DEAD SOIL										LOADING IN FLAT SECTION BASED ON A SLOPE OF 2.00/12 MINIMUM									
										U 2098 1232 / 0 343 / 0 0 / 0 0 / 0 522 / 0 0 / 0																			
										L 2098 1232 / 0 343 / 0 0 / 0 0 / 0 522 / 0 0 / 0																			
										BEARING MATERIAL TO BE SPF NO.2 OR BETTER AT JOINT(S) U, L										THIS TRUSS IS DESIGNED FOR RESIDENTIAL OR SMALL BUILDING REQUIREMENTS OF PART 9, NBCC 2015									
										BRACING										THIS DESIGN COMPLIES WITH:									
										TOP CHORD TO BE SHEATHED OR MAX. PURLIN SPACING = 2.46 FT.										- PART 9 OF BCBC 2018 , ABC 2019									
										MAX. UNBRACED BOTTOM CHORD LENGTH = 10.00 FT OR RIGID CEILING DIRECTLY APPLIED.										- PART 9 OF OBC 2012 (2019 AMENDMENT)									
										ALL PITCH BREAKS AND PERIMETER CORNER JOINTS MUST BE LATERALLY RESTRAINED.										- CSA 086-14									
																				- TPIC 2014									
PLATES (table is in inches)										LOADING										(55 % OF 48.1 P.S.F. G.S.L. PLUS 8.4 P.S.F. RAIN LOAD) EQUALS 34.8 P.S.F. SPECIFIED ROOF LIVE LOAD									
JT TYPE PLATES W LEN Y X										TOTAL LOAD CASES: (4)																			
B TMVW-t MT20 5.0 8.0 1.75 3.00										CHORDS																			
C TMVW-t MT20 3.0 4.0 1.50 1.75										MAX. FACTORED FORCE (LBS) FACTORED VERT. LOAD (PLF) MAX. FACTORED LC1 MAX (LC) UNBRAC										WEBS									
D TTWW-m MT20 5.0 8.0 2.00 3.00										MEMB. (LBS) (PLF) CSI (LC) MEMB. (LBS) MAX. FACTORED FORCE (LBS) MAX. FACTORED FORCE (LBS)										MAX. FACTORED FORCE (LBS) MAX. FACTORED FORCE (LBS)									
E TMW+w MT20 2.0 4.0										FR-TO FROM TO LENGTHFR-TO																			
F TS-t MT20 3.0 6.0										A-B 0 / 38 -124.4 -124.4 0.16 (1) 10.00 T-C -560 / 0 0.11 (1)																			
G TMVW-t MT20 3.0 4.0										B-C -3747 / 0 -124.4 -124.4 0.51 (1) 3.21 C-S -47 / 0 0.02 (1)																			
H TTWW-m MT20 5.0 8.0 2.00 3.00										C-D -3753 / 0 -124.4 -124.4 0.50 (1) 3.21 S-D 0 / 269 0.06 (2)																			
I TMVW-t MT20 3.0 4.0 1.50 1.75										D-E -4441 / 0 -124.4 -124.4 0.98 (1) 2.48 D-R 0 / 1462 0.33 (1)																			
J TMVW-t MT20 5.0 8.0 1.75 3.00										E-F -4441 / 0 -124.4 -124.4 0.97 (1) 2.47 R-E -745 / 0 0.29 (1)																			
L BMV1-t MT20 6.0 6.0 Edge 2.50										F-G -4441 / 0 -124.4 -124.4 0.97 (1) 2.47 R-G -3 / 0 0.00 (1)																			
M BMVW-t MT20 5.0 6.0 2.25 1.50										G-H -4443 / 0 -124.4 -124.4 0.99 (1) 2.46 P-G -746 / 0 0.29 (1)																			
N BMVW-t MT20 3.0 4.0										H-I -3753 / 0 -124.4 -124.4 0.50 (1) 3.21 P-H 0 / 1466 0.33 (1)																			
O BS-t MT20 4.0 6.0										I-J -3747 / 0 -124.4 -124.4 0.51 (1) 3.21 N-H 0 / 268 0.06 (2)																			
P BMVW-t MT20 4.0 4.0 1.50 1.50										J-K 0 / 38 -124.4 -124.4 0.16 (1) 10.00 N-I -48 / 0 0.02 (1)																			
Q BS-t MT20 5.0 8.0										U-B -2765 / 0 0.0 0.0 0.28 (1) 5.18 M-I -560 / 0 0.11 (1)																			
R BMVWW-t MT20 4.0 8.0 2.00 3.00										L-J -2765 / 0 0.0 0.0 0.28 (1) 5.18 B-T 0 / 3444 0.78 (1)																			
S BMVW-t MT20 3.0 4.0										U-T 0 / 0 -39.2 -39.2 0.12 (2) 10.00 M-J 0 / 3444 0.78 (1)																			
T BMVW-t MT20 5.0 6.0 2.25 1.50										T-S 0 / 3371 -39.2 -39.2 0.66 (1) 10.00																			
U BMV1-t MT20 6.0 6.0 3.50										S-R 0 / 3338 -39.2 -39.2 0.65 (1) 10.00																			
										R-Q 0 / 4443 -39.2 -39.2 0.83 (1) 10.00																			
										Q-P 0 / 4443 -39.2 -39.2 0.83 (1) 10.00																			
Edge - INDICATES REFERENCE CORNER OF PLATE TOUCHES EDGE OF CHORD.																				TRUSS PLATE MANUFACTURER IS NOT RESPONSIBLE FOR QUALITY CONTROL IN THE TRUSS MANUFACTURING PLANT .									
WB - INDICATES BLOCKING REQUIRED																				NAIL VALUES									
																				PLATE GRIP(DRY) SHEAR SECTION (PSI) (PLI) (PLI)									

These plans have been reviewed for use with the corrections as noted. No other changes may be made without written approval of the Building Standards Branch. All work must comply with Zoning By-Law 2018-043, as amended, and the Ontario Building Code, as amended. These approved documents must be kept on site at all times. The building permit must be clearly posted on site at all times.

READ ALL NOTES ON THIS PAGE AND ON ENGINEERING NOTE PAGE ENP-1. THIS NOTE PAGE IS AN INTEGRAL PART OF THIS DRAWING AS IT CONTAINS SPECIFICATIONS AND CRITERIA USED IN THE DESIGN OF THIS COMPONENT.

Discipline	Reviewer	BCIN	Date
Building Code	H. Authier	43236	2021-02-03
Zoning			

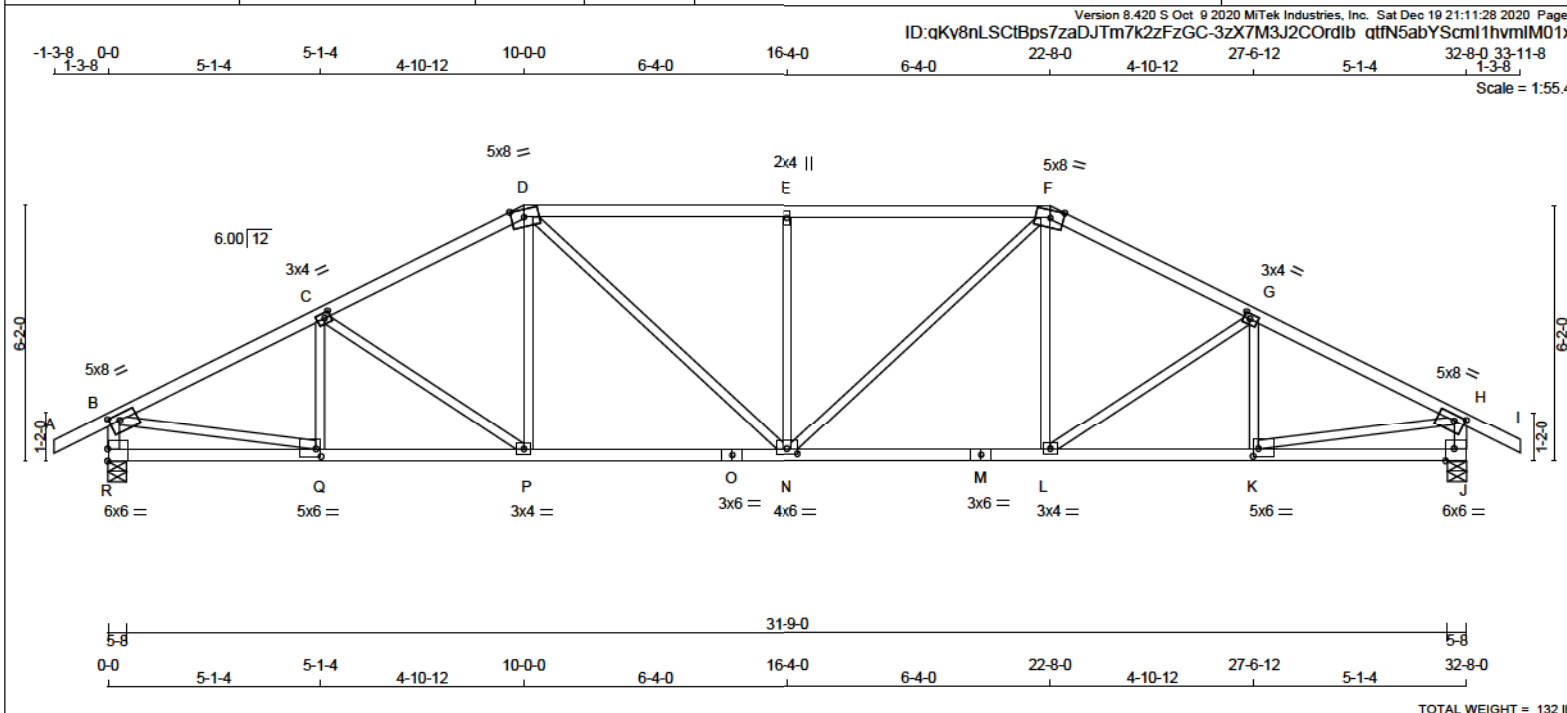


LUMBER										DIMENSIONS, SUPPORTS AND LOADINGS SPECIFIED BY FABRICATOR TO BE VERIFIED BY BUILDING DESIGNER										DESIGN CRITERIA									
N. L. G. A. RULES										BEARINGS										SPECIFIED LOADS:									
CHORDS SIZE LUMBER DESCR.										FACTORED GROSS REACTION MAXIMUM FACTORED GROSS REACTION INPUT BRG REQRD BRG										TOP CH. LL = 34.8 PSF									
A - D 2x4 DRY No.2 SPF										JT VERT HORZ DOWN HORZ UPLIFT IN-SX IN-SX										DL = 8.0 PSF									
D - F 2x4 DRY No.2 SPF										R 2842 0 2842 0 0 5-8 5-8										BOT CH. LL = 10.5 PSF									
R - B 2x4 DRY No.2 SPF										J 2842 0 2842 0 0 5-8 5-8										DL = 7.3 PSF									
J - H 2x4 DRY No.2 SPF																				TOTAL LOAD = 60.6 PSF									
R - O 2x4 DRY No.2 SPF																													
O - M 2x4 DRY No.2 SPF																													
M - J 2x4 DRY No.2 SPF																													
ALL WEBS 2x3 DRY No.2 SPF																				SPACING = 24.0 IN. C/C									
EXCEPT																													
DRY: SEASONED LUMBER.																				LOADING IN FLAT SECTION BASED ON A SLOPE OF 2.00/12 MINIMUM									
										BEARING MATERIAL TO BE SPF NO.2 OR BETTER AT JOINT(S) R, J										THIS TRUSS IS DESIGNED FOR RESIDENTIAL OR SMALL BUILDING REQUIREMENTS OF PART 9, NBCC 2015									
										BRACING										THIS DESIGN COMPLIES WITH:									
										TOP CHORD TO BE SHEATHED OR MAX. PURLIN SPACING = 2.55 FT.										- PART 9 OF BCBC 2018, ABC 2019									
										MAX. UNBRACED BOTTOM CHORD LENGTH = 10.00 FT OR RIGID CEILING DIRECTLY APPLIED.										- PART 9 OF OBC 2012 (2019 AMENDMENT)									
										ALL PITCH BREAKS AND PERIMETER CORNER JOINTS MUST BE LATERALLY RESTRAINED.										- CSA 088-14									
																				- TPIC 2014									
PLATES (table is in inches)										LOADING										(55 % OF 48.1 P.S.F. G.S.L. PLUS 8.4 P.S.F. RAIN LOAD)									
JT TYPE PLATES W LEN Y X										TOTAL LOAD CASES: (4)										EQUALS 34.8 P.S.F. SPECIFIED ROOF LIVE LOAD									
B TMVW-t MT20 5.0 8.0 1.75 3.00																				ALLOWABLE DEFL.(LL)= L/360 (1.09")									
C TMVW-t MT20 3.0 4.0 1.50 1.75																				CALCULATED VERT. DEFL.(LL) = L/999 (0.21")									
D TTWW-m MT20 5.0 8.0 2.25 3.75																				ALLOWABLE DEFL.(TL)= L/360 (1.09")									
E TMW+w MT20 2.0 4.0																				CALCULATED VERT. DEFL.(TL) = L/999 (0.38")									
F TTWW-m MT20 5.0 8.0 2.25 3.75																				CSI: TC=0.90/1.00 (D-E-1), BC=0.71/1.00 (P-Q-1),									
G TMVW-t MT20 3.0 4.0 1.50 1.75																				WB=0.80/1.00 (B-Q-1), SSI=0.38/1.00 (D-E-1)									
H TMVW-t MT20 5.0 8.0 1.75 3.00																				DOL LUMBER=1.00 NAIL=1.00 LS BEND=1.10 COMP=1.10									
J BMV1-t MT20 6.0 6.0 Edge 2.50																				SHEAR=1.10 TENS=1.10									
K BMVW-t MT20 5.0 6.0 2.25 1.50																				COMPANION LIVE LOAD FACTOR = 1.00									
L BMVW-t MT20 3.0 4.0																													
M BS-t MT20 3.0 6.0																													
N BMVWW-t MT20 4.0 6.0 1.50 3.00																				TRUSS PLATE MANUFACTURER IS NOT RESPONSIBLE									
O BS-t MT20 3.0 6.0																				FOR QUALITY CONTROL IN THE TRUSS									
P BMVW-t MT20 3.0 4.0																				MANUFACTURING PLANT .									
Q BMVW-t MT20 5.0 6.0 2.25 1.50																													
R BMV1-t MT20 6.0 6.0 3.50																				NAIL VALUES									
Edge - INDICATES REFERENCE CORNER OF PLATE TOUCHES																				PLATE GRIP(DRY) SHEAR SECTION									
EDGE OF CHORD.																				(PSI) (PLI) (PLI)									

These plans have been reviewed for use with the corrections as noted. No other changes may be made without written approval of the Building Standards Branch. All work must comply with Zoning By-Law 2018-043, as amended, and the Ontario Building Code, as amended. These approved documents must be kept on site at all times. The building permit must be clearly posted on site at all times.

Discipline	Reviewer	BCIN	Date
Building Code	H. Authier	43236	2021-02-03
Severage System			
Zoning			

READ ALL NOTES ON THIS PAGE AND ON ENGINEERING NOTE PAGE ENP-1. THIS NOTE PAGE IS AN INTEGRAL PART OF THIS DRAWING AS IT CONTAINS SPECIFICATIONS AND CRITERIA USED IN THE DESIGN OF THIS COMPONENT.

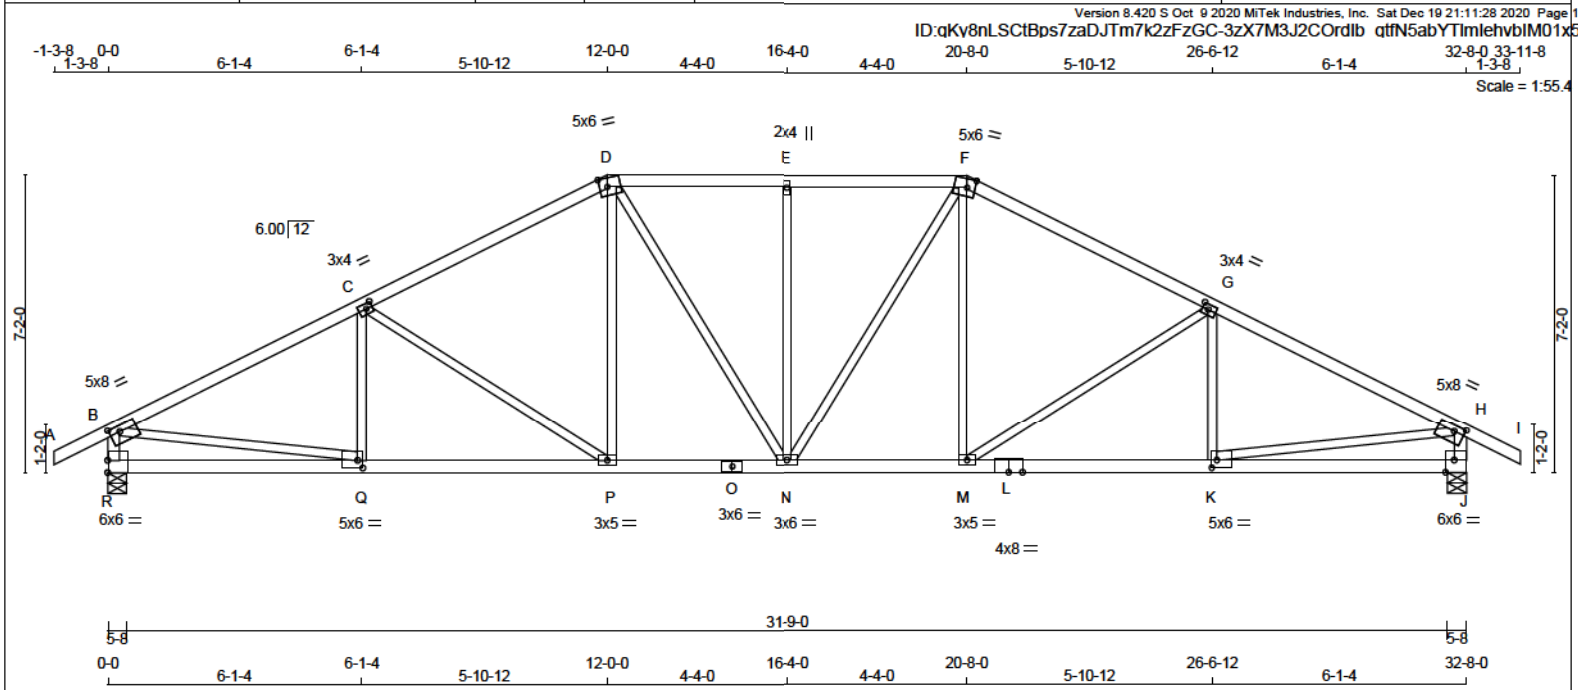

LUMBER
N. L. G. A. RULES

CHORDS	SIZE	LUMBER	DESCR.
A - D	2x4	DRY No.2	SPF
D - F	2x4	DRY No.2	SPF
F - I	2x4	DRY No.2	SPF
R - B	2x4	DRY No.2	SPF
J - H	2x4	DRY No.2	SPF
R - O	2x4	DRY No.2	SPF
O - L	2x4	DRY No.2	SPF
L - J	2x4	DRY No.2	SPF
ALL WEBS	2x3	DRY No.2	SPF

EXCEPT
DRY: SEASONED LUMBER.

PLATES (table is in inches)

JT TYPE	PLATES	W	LEN	Y	X
B TMVW-t	MT20	5.0	8.0	1.75	3.00
C TMVW-t	MT20	3.0	4.0	1.50	1.75
D TTWW-m	MT20	5.0	8.0	2.50	2.25
E TMW+w	MT20	2.0	4.0		
F TTWW-m	MT20	5.0	8.0	2.50	2.25
G TMVW-t	MT20	3.0	4.0	1.50	1.75
H TMVW-t	MT20	5.0	8.0	1.75	3.00
J BMV1-t	MT20	6.0	6.0	Edge	2.50
K BMWW-t	MT20	5.0	6.0	2.25	1.50
L BS-t	MT20	4.0	8.0		
M BMWW-t	MT20	3.0	5.0		
N BMWW-t	MT20	3.0	6.0		
O BS-t	MT20	3.0	6.0		
P BMWW-t	MT20	3.0	5.0		
Q BMWW-t	MT20	5.0	6.0	2.25	1.50
R BMV1-t	MT20	6.0	6.0	3.50	

Edge - INDICATES REFERENCE CORNER OF PLATE TOUCHES
EDGE OF CHORD.

DIMENSIONS, SUPPORTS AND LOADINGS SPECIFIED BY FABRICATOR TO BE VERIFIED BY BUILDING DESIGNER

BEARINGS

FACTORED GROSS REACTION	MAXIMUM FACTORED GROSS REACTION	INPUT BRG	REQRD BRG
JT VERT	DOWN	UPLIFT	IN-SX
R 2842	0	0	5-8
J 2842	0	0	5-8

UNFACTORED REACTIONS

1ST LCASE	MAX	MIN	COMPONENT REACTIONS
JT COMBINED	SNOW	LIVE	PERM. LIVE WIND DEAD SOIL
R 2098	1232 / 0	343 / 0	0 / 0 0 / 0 522 / 0 0 / 0
J 2098	1232 / 0	343 / 0	0 / 0 0 / 0 522 / 0 0 / 0

BEARING MATERIAL TO BE SPF NO.2 OR BETTER AT JOINT(S) R, J

BRACING
TOP CHORD TO BE SHEATHED OR MAX. PURLIN SPACING = 2.06 FT.
MAX. UNBRACED BOTTOM CHORD LENGTH = 10.00 FT OR RIGID CEILING DIRECTLY APPLIED.
ALL PITCH BREAKS AND PERIMETER CORNER JOINTS MUST BE laterally RESTRAINED.

LOADING
TOTAL LOAD CASES: (4)

CHORDS				WEBS			
MEMB.	MAX. FACTORED FORCE (LBS)	FACTORED VERT. LOAD (PLF)	LC1 MAX CSI (LC)	MEMB.	MAX. FACTORED FORCE (LBS)	MAX. FACTORED FORCE (LBS)	MAX. FACTORED FORCE (LBS)
FR-TO		FROM	TO	LENGTH	FR-TO		
A-B	0 / 38	-124.4	-124.4	0.16 (1)	10.00	Q-C	-239 / 131
B-C	-3939 / 0	-124.4	-124.4	0.90 (1)	2.66	C-P	-711 / 0
C-D	-3352 / 0	-124.4	-124.4	0.78 (1)	3.03	P-D	0 / 598
D-E	-3219 / 0	-124.4	-124.4	0.41 (1)	3.55	D-N	0 / 467
E-F	-3219 / 0	-124.4	-124.4	0.41 (1)	3.55	N-E	-850 / 0
F-G	-3352 / 0	-124.4	-124.4	0.78 (1)	3.03	N-F	0 / 467
G-H	-3939 / 0	-124.4	-124.4	0.90 (1)	2.66	M-F	0 / 598
H-I	0 / 38	-124.4	-124.4	0.16 (1)	10.00	M-G	-711 / 0
R-B	-2742 / 0	0.0	0.0	0.28 (1)	5.20	K-G	-239 / 131
J-H	-2742 / 0	0.0	0.0	0.28 (1)	5.20	B-Q	0 / 3592
R-Q	0 / 0	-39.2	-39.2	0.27 (3)	10.00	K-H	0 / 3592
Q-P	0 / 3557	-39.2	-39.2	0.73 (1)	10.00		
P-O	0 / 2970	-39.2	-39.2	0.60 (1)	10.00		
O-N	0 / 2970	-39.2	-39.2	0.60 (1)	10.00		
N-M	0 / 2970	-39.2	-39.2	0.60 (1)	10.00		
M-L	0 / 3557	-39.2	-39.2	0.73 (1)	10.00		
L-K	0 / 3557	-39.2	-39.2	0.73 (1)	10.00		
K-J	0 / 0	-39.2	-39.2	0.27 (3)	10.00		

DESIGN CRITERIA

SPECIFIED LOADS:
TOP CH. LL = 34.8 PSF
DL = 8.0 PSF
BOT CH. LL = 10.5 PSF
DL = 7.3 PSF
TOTAL LOAD = 60.6 PSF

SPACING = 24.0 IN. C/C

LOADING IN FLAT SECTION BASED ON A SLOPE OF 2.00/12 MINIMUM

THIS TRUSS IS DESIGNED FOR RESIDENTIAL OR SMALL BUILDING REQUIREMENTS OF PART 9, NBCC 2015

THIS DESIGN COMPLIES WITH:
- PART 9 OF CBC 2018, ABC 2019
- PART 9 OF OBC 2012 (2019 AMENDMENT)
- CSA 088-14
- TPIC 2014

(55 % OF 48.1 P.S.F. G.S.L. PLUS 8.4 P.S.F. RAIN LOAD)
EQUALS 34.8 P.S.F. SPECIFIED ROOF LIVE LOAD

ALLOWABLE DEFL.(LL)= L/360 (1.09")
CALCULATED VERT. DEFL.(LL) = L/999 (0.19")
ALLOWABLE DEFL.(TL)= L/360 (1.09")
CALCULATED VERT. DEFL.(TL) = L/999 (0.32")

CSI: TC=0.90/1.00 (G-H:1) , BC=0.73/1.00 (K-M:1) ,
WB=0.81/1.00 (H-K:1) , SSI=0.32/1.00 (G-H:1)

DOL LUMBER=1.00 NAIL=1.00 LS BEND=1.10 COMP=1.10
SHEAR=1.10 TENS=1.10

COMPANION LIVE LOAD FACTOR = 1.00

TRUSS PLATE MANUFACTURER IS NOT RESPONSIBLE FOR QUALITY CONTROL IN THE TRUSS MANUFACTURING PLANT .

NAIL VALUES
PLATE GRIP(DRY) SHEAR SECTION
(PSI) (PLI) (PLI)
MAX MIN MAX MIN MAX MIN
MT20 650 371 1747 788 1987 1873

PLATE PLACEMENT TOL. = 0.250 inches

PLATE ROTATION TOL. = 5.0 Deg.

JSI GRIP= 0.90 (N) (INPUT = 0.90)
JSI METAL= 0.90 (O) (INPUT = 1.00)




READ ALL NOTES ON THIS PAGE AND ON ENGINEERING NOTE PAGE ENP-1. THIS NOTE PAGE IS AN INTEGRAL PART OF THIS DRAWING AS IT CONTAINS SPECIFICATIONS AND CRITERIA USED IN THE DESIGN OF THIS COMPONENT.



These plans have been reviewed for use with the corrections as noted. No other changes may be made without written approval of the Building Standards Branch. All work must comply with Zoning By-Law 2018-043, as amended, and the Ontario Building Code, as amended. These approved documents must be kept on site at all times. The building permit must be clearly posted on site at all times.

Discipline	Reviewer	BCIN	Date
Building Code	H. Authier	43236	2021-02-03
Sewage System			
Zoning			



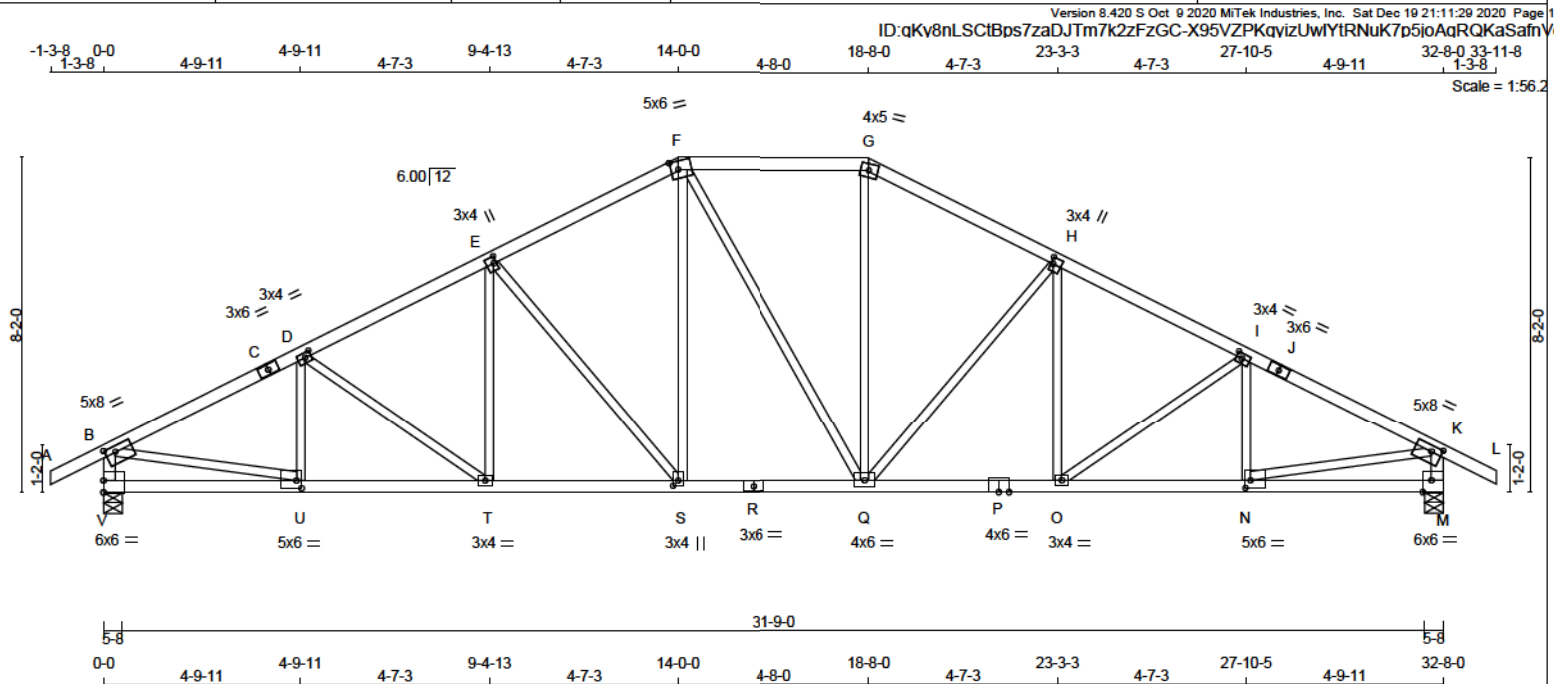

TOTAL WEIGHT = 144 lb

LUMBER				
N. L. G. A. RULES				
CHORDS	SIZE	LUMBER		DESCR.
A - C	2x4	DRY	No.2	SPF
C - F	2x4	DRY	No.2	SPF
F - G	2x4	DRY	No.2	SPF
G - J	2x4	DRY	No.2	SPF
J - L	2x4	DRY	No.2	SPF
V - B	2x4	DRY	No.2	SPF
M - K	2x4	DRY	No.2	SPF
V - R	2x4	DRY	No.2	SPF
P - P	2x4	DRY	No.2	SPF
P - M	2x4	DRY	No.2	SPF
ALL WEBS	2x3	DRY	No.2	SPF

DRY; SEASONED LUMBER.

PLATES (table is in inches)						
JT	TYPE	PLATES	W	LEN	Y	X
B	TMVW-t	MT20	5.0	8.0	1.75	3.00
C	TS-t	MT20	3.0	8.0		
D	TMVW-t	MT20	3.0	4.0	1.50	1.75
E	TMVW-t	MT20	3.0	4.0	2.00	0.75
F	TTWV-m	MT20	5.0	8.0	2.50	2.25
G	TW-m	MT20	4.0	5.0		
H	TMVW-t	MT20	3.0	4.0	1.50	0.75
J	TS-t	MT20	3.0	8.0		
K	TMVW-t	MT20	5.0	8.0	1.75	3.00
M	BMV1-t	MT20	6.0	8.0	Edge 2.50	
N	BMVW-t	MT20	5.0	8.0	2.25	1.50
O	BMVW-t	MT20	3.0	4.0		
P	BS-t	MT20	4.0	8.0		
Q	BMVWV-t	MT20	4.0	8.0		
R	BS-t	MT20	3.0	8.0		
S	TMVW-t	MT20	3.0	4.0	1.50	1.50
T	BMVW-t	MT20	3.0	4.0		
U	BMVW-t	MT20	5.0	8.0	2.25	1.50
V	BMV1-t	MT20	6.0	8.0	3.50	

Edge - INDICATES REFERENCE CORNER OF PLATE TOUCHES
EDGE OF CHORD.

DIMENSIONS, SUPPORTS AND LOADINGS SPECIFIED BY FABRICATOR TO BE VERIFIED BY BUILDING DESIGNER

BEARINGS							
FACTORED GROSS REACTION			MAXIMUM FACTORED GROSS REACTION			INPUT BRG	REQRD BRG
JT	VERT	HORZ	DOWN	HORZ	UPLIFT	IN-SX	IN-SX
V	2842	0	2842	0	0	5-8	5-8
M	2842	0	2842	0	0	5-8	5-8

UNFACTORED REACTIONS

1ST LCASE		MAX/MIN COMPONENT REACTIONS					
JT	COMBINED	SNOW	LIVE	PERM.LIVE	WIND	DEAD	SOIL
V	2096	1232 / 0	343 / 0	0 / 0	0 / 0	522 / 0	0 / 0
M	2096	1232 / 0	343 / 0	0 / 0	0 / 0	522 / 0	0 / 0

BEARING MATERIAL TO BE SPF NO.2 OR BETTER AT JOINT(S) V, M

BRACING

TOP CHORD TO BE SHEATHED OR MAX. PURLIN SPACING = 3.14 FT.
MAX. UNBRACED BOTTOM CHORD LENGTH = 10.00 FT. OR RIGID CEILING DIRECTLY APPLIED.

ALL PITCH BREAKS AND PERIMETER CORNER JOINTS MUST BE Laterally RESTRAINED.

LOADING

TOTAL LOAD CASES: (4)

CHORDS					WEBS				
MAX. FACTORED		FACTORED		FACTORED		MAX. FACTORED		MAX. FACTORED	
MEMB.	FORCE	VERT. LOAD	LO1 MAX	C/SI	MAX.	MEMB.	FORCE	MAX	C/SI
	(LBS)	(PLF)	(C/L)	(C/L)	UNBRAC		(LBS)	(C/L)	(C/L)
FR-TO		FROM	TO		LENGTH	FR-TO			
A-B	0 / 38	-124.4	-124.4	0.16	(1)	10.00	U-D	-422 / 0	0.09
B-C	-3835 / 0	-124.4	-124.4	0.56	(1)	3.14	D-T	-215 / 0	0.12
C-D	-3835 / 0	-124.4	-124.4	0.56	(1)	3.14	T-E	0 / 336	0.08
D-E	-3864 / 0	-124.4	-124.4	0.46	(1)	3.33	E-S	-864 / 0	0.89
E-F	-3601 / 0	-124.4	-124.4	0.43	(1)	3.63	S-F	0 / 438	0.19
F-G	-3864 / 0	-124.4	-124.4	0.44	(1)	3.77	F-Q	0 / 4	0.00
G-H	-3066 / 0	-124.4	-124.4	0.43	(1)	3.63	Q-G	0 / 842	0.19
H-I	-2729 / 0	-124.4	-124.4	0.48	(1)	3.33	Q-H	-861 / 0	0.89
I-J	-3835 / 0	-124.4	-124.4	0.56	(1)	3.14	Q-H	0 / 332	0.07
J-K	-3835 / 0	-124.4	-124.4	0.56	(1)	3.14	Q-I	-216 / 0	0.12
K-L	0 / 38	-124.4	-124.4	0.16	(1)	10.00	N-I	-421 / 0	0.09
V-B	-2758 / 0	0.0	0.0	0.28	(1)	5.19	B-U	0 / 3505	0.79
M-K	-2759 / 0	0.0	0.0	0.28	(1)	5.19	N-K	0 / 3505	0.79
V-U	0 / 0	-39.2	-39.2	0.15	(3)	10.00			
U-T	0 / 3450	-39.2	-39.2	0.63	(1)	10.00			
T-S	0 / 3275	-39.2	-39.2	0.61	(1)	10.00			
S-R	0 / 2728	-39.2	-39.2	0.54	(1)	10.00			
R-Q	0 / 2728	-39.2	-39.2	0.54	(1)	10.00			
Q-P	0 / 3274	-39.2	-39.2	0.63	(1)	10.00			
P-O	0 / 3274	-39.2	-39.2	0.63	(1)	10.00			
O-N	0 / 3450	-39.2	-39.2	0.63	(1)	10.00			
N-M	0 / 0	-39.2	-39.2	0.15	(3)	10.00			

DESIGN CRITERIA

SPECIFIED LOADS:

TOP	CH.	LL = 34.8	PSF
		DL = 8.0	PSF
BOT	CH.	LL = 10.5	PSF
		DL = 7.3	PSF
TOTAL LOAD		= 60.6	PSF

SPACING = 24.0 IN. C/C

LOADING IN FLAT SECTION BASED ON A SLOPE OF 2.00/12 MINIMUM

THIS TRUSS IS DESIGNED FOR RESIDENTIAL OR SMALL
BUILDING REQUIREMENTS OF PART 9, NBCC 2015

THIS DESIGN COMPLIES WITH:

- PART 9 OF BCBC 2018 , ABC 2019
- PART 9 OF OBC 2012 (2019 AMENDMENT)
- CSA 086-14
- TPIC 2014

(55 % OF 48.1 P.S.F. G.S.L. PLUS 8.4 P.S.F. RAIN LOAD)
EQUALS 34.8 P.S.F. SPECIFIED ROOF LIVE LOAD

ALLOWABLE DEFL.(LL)= L/360 (1.09")
CALCULATED VERT. DEFL.(LL) = L/999 (0.18")
ALLOWABLE DEFL.(TL)= L/360 (1.09")
CALCULATED VERT. DEFL.(TL) = L/999 (0.31")

CSI: TC=0.56/1.00 (I-K:1) , BC=0.63/1.00 (T-U:1) ,
WB=0.89/1.00 (E-S:1) , SSI=0.24/1.00 (B-D:1)

DOL LUMBER=1.00 NAIL=1.00 LS BEND=1.10 COMP=1.10
SHEAR=1.10 TENS= 1.10

COMPANION LIVE LOAD FACTOR = 1.00

TRUSS PLATE MANUFACTURER IS NOT RESPONSIBLE
FOR QUALITY CONTROL IN THE TRUSS
MANUFACTURING PLANT .

NAIL VALUES
PLATE GRIP(DRY) SHEAR SECTION

	(PSI)		(PLI)		(PLI)	
	MAX	MIN	MAX	MIN	MAX	MIN
MT20	850	371	1747	788	1987	1873

PLATE PLACEMENT TOL = 0.250 inches

PLATE ROTATION TOL. = 5.0 Deg.

JSI GRIP= 0.89 (E) (INPUT = 0.90)
JSI METAL= 0.83 (R) (INPUT = 1.00)



These plans have been reviewed for use with the corrections as noted. No other changes may be made without written approval of the Building Standards Branch. All work must comply with Zoning By-Law 2018-043, as amended, and the Ontario Building Code, as amended. These approved documents must be kept on site at all times. The building permit must be clearly posted on site at all times.


Discipline	Reviewer	BCIN	Date
Building Code	H. Authier	43236	2021-02-0
Sewage System			
Zoning			



**READ ALL NOTES ON THIS PAGE AND ON
ENGINEERING NOTE PAGE ENP-1. THIS
NOTE PAGE IS AN INTEGRAL PART OF
THIS DRAWING AS IT CONTAINS
SPECIFICATIONS AND CRITERIA USED IN
THE DESIGN OF THIS COMPONENT.**

Version 8.420 S Oct 9 2020 Mitek Industries, Inc. Sat Dec 19 21:11:30 2020 Page 1

ID:qKy8nLSCtBps7zaDJTm7k2zFzGC-0LftnkLj?5LYv73 4QZg0erAa?v9ofBpJW295y

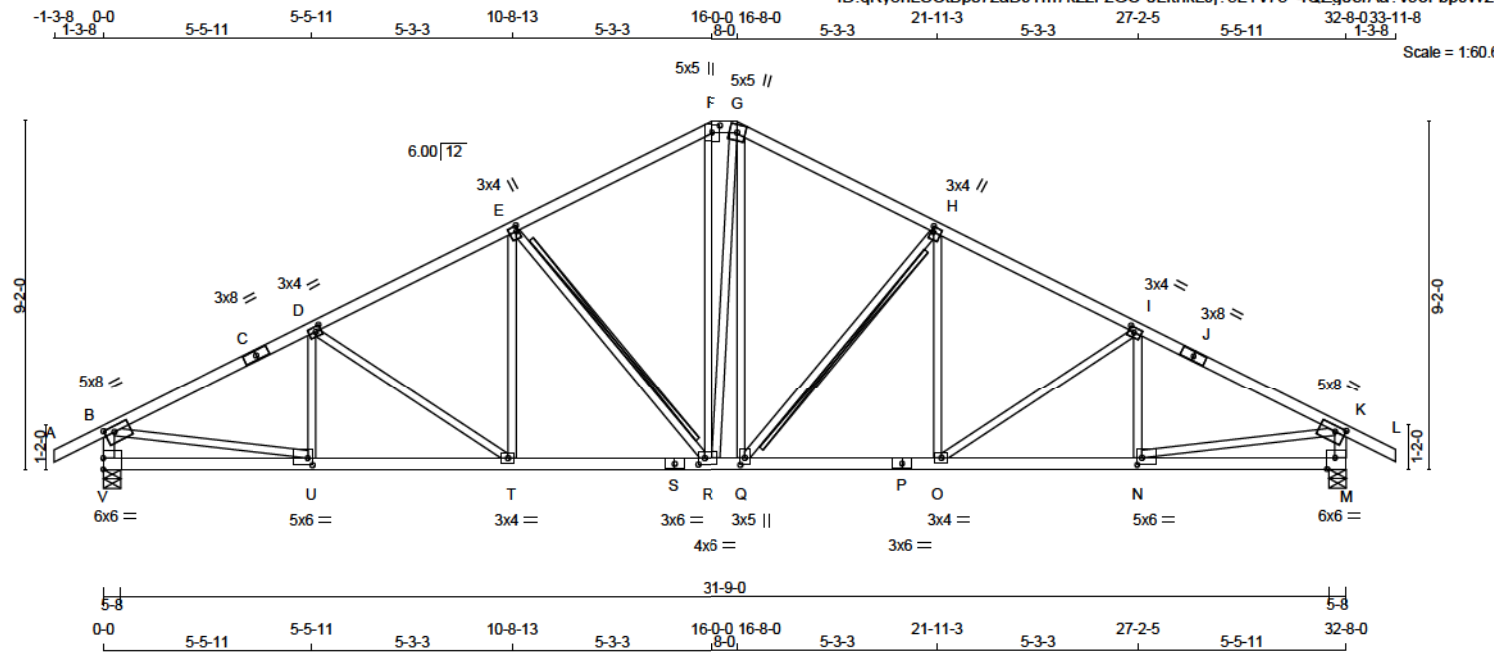

TOTAL WEIGHT = 151 LB

LUMBER

N. L. G. A. RULES

CHORDS	SIZE	LUMBER	DESCR.
A - C	2x4	DRY No.2	SPF
C - F	2x4	DRY No.2	SPF
F - G	2x4	DRY No.2	SPF
G - J	2x4	DRY No.2	SPF
J - L	2x4	DRY No.2	SPF
V - B	2x4	DRY No.2	SPF
M - K	2x4	DRY No.2	SPF
V - S	2x4	DRY No.2	SPF
S - P	2x4	DRY No.2	SPF
P - M	2x4	DRY No.2	SPF
ALL WEBS	2x3	DRY No.2	SPF

EXCEPT

DRY: SEASONED LUMBER.

PLATES (table is in inches)

JT	TYPE	PLATES	W	LEN	Y	X
B	TMVW-t	MT20	5.0	8.0	1.75	3.00
C	TS-t	MT20	3.0	8.0		
D	TMVW-t	MT20	3.0	4.0	1.50	1.75
E	TMVW-t	MT20	3.0	4.0	1.75	0.75
F	TTW+p	MT20	5.0	5.0	2.25	2.50
G	TTW+m	MT20	5.0	5.0		
H	TMVW-t	MT20	3.0	4.0	1.75	0.75
I	TMVW-t	MT20	3.0	4.0	1.50	1.75
J	TS-t	MT20	3.0	8.0		
K	TMVW-t	MT20	5.0	8.0	1.75	3.00
N	BMV1-t	MT20	6.0	6.0	Edge 2.50	
O	BMVW-t	MT20	5.0	6.0	2.25	1.50
P	BS-t	MT20	3.0	4.0		
Q	BMVW-t	MT20	3.0	5.0	2.25	1.50
R	BMVW-t	MT20	4.0	6.0	2.00	2.00
S	BS-t	MT20	3.0	6.0		
T	BMVW-t	MT20	3.0	4.0		
U	BMVW-t	MT20	5.0	6.0	2.25	1.50
V	BMV1-t	MT20	6.0	6.0	3.50	

Edge - INDICATES REFERENCE CORNER OF PLATE TOUCHES EDGE OF CHORD.

DIMENSIONS, SUPPORTS AND LOADINGS SPECIFIED BY FABRICATOR TO BE VERIFIED BY BUILDING DESIGNER

BEARINGS

	FACTORED GROSS REACTION	MAXIMUM FACTORED GROSS REACTION	INPUT DOWN	REQD BRG
JT	VERT	HORZ	DOWN	HORZ
V	2842	0	2842	0
M	2842	0	2842	0

UNFACTORED REACTIONS

1ST LCASE	MAX	MIN	COMPONENT REACTIONS
JT	COMBINED	SNOW	LIVE
V	2098	1232 / 0	343 / 0
M	2098	1232 / 0	343 / 0

BEARING MATERIAL TO BE SPF NO.2 OR BETTER AT JOINT(S) V, M

BRACING
TOP CHORD TO BE SHEATHED OR MAX. PURLIN SPACING = 2.97 FT.
MAX. UNBRACED BOTTOM CHORD LENGTH = 10.00 FT OR RIGID CEILING DIRECTLY APPLIED.
ALL PITCH BREAKS AND PERIMETER CORNER JOINTS MUST BE LATERALLY RESTRAINED.

2x4 DRY SPF No.2 T-BRACE AT E-R, H-Q
FASTEN T AND I-BRACES TO NARROW EDGE OF WEB WITH ONE ROW PER PLY OF 3" COMMON WIRE NAILS @ 6" O.C. WITH 3" MINIMUM END DISTANCE. BRACE MUST COVER 90% OF WEB LENGTH.

END VERTICAL(S) MUST BE SHEATHED OR HAVE BRACES AS INDICATED IN THE MAX. UNBRACED LENGTH COLUMN OF THE TABLE BELOW

LOADING
TOTAL LOAD CASES: (4)

CHORDS				WEBS			
MEMB.	MAX. FORCE (LBS)	FACTORED VERT. LOAD (PLF)	MAX. LENGTH (LC)	MEMB.	MAX. FORCE (LBS)	FACTORED VERT. LOAD (PLF)	MAX. LENGTH (LC)
FR-TO				FR-TO			
A-B	0 / 38	-124.4 -124.4 0.16 (1)	10.00	U-D	-319 / 85	0.08 (1)	
B-C	-3890 / 0	-124.4 -124.4 0.71 (1)	2.97	D-T	-418 / 0	0.30 (1)	
C-D	-3890 / 0	-124.4 -124.4 0.71 (1)	2.97	T-E	0 / 446	0.10 (2)	
D-E	-3531 / 0	-124.4 -124.4 0.57 (1)	3.28	E-R	-1054 / 0	0.52 (1)	
E-F	-2809 / 0	-124.4 -124.4 0.52 (1)	3.66	R-F	0 / 941	0.21 (1)	
F-G	-2475 / 0	-124.4 -124.4 0.07 (1)	4.35	R-G	0 / 102	0.02 (1)	
G-H	-2798 / 0	-124.4 -124.4 0.52 (1)	3.67	Q-G	0 / 834	0.19 (1)	
H-I	-3535 / 0	-124.4 -124.4 0.57 (1)	3.28	Q-H	-1075 / 0	0.53 (1)	
I-J	-3888 / 0	-124.4 -124.4 0.71 (1)	2.97	O-H	0 / 467	0.11 (2)	
J-K	-3888 / 0	-124.4 -124.4 0.71 (1)	2.97	O-I	-412 / 0	0.30 (1)	
K-L	0 / 38	-124.4 -124.4 0.16 (1)	10.00	N-I	-325 / 82	0.08 (1)	
V-B	-2750 / 0	0.0 0.0 0.28 (1)	5.19	B-U	0 / 3548	0.80 (1)	
M-K	-2748 / 0	0.0 0.0 0.28 (1)	5.20	N-K	0 / 3548	0.80 (1)	
V-U	0 / 0	-39.2 -39.2 0.20 (3)	10.00				
U-T	0 / 3503	-39.2 -39.2 0.68 (1)	10.00				
T-S	0 / 3158	-39.2 -39.2 0.67 (1)	10.00				
S-R	0 / 3158	-39.2 -39.2 0.67 (1)	10.00				
R-Q	0 / 2466	-39.2 -39.2 0.56 (1)	10.00				
Q-P	0 / 3162	-39.2 -39.2 0.62 (1)	10.00				
P-O	0 / 3162	-39.2 -39.2 0.62 (1)	10.00				
O-N	0 / 3502	-39.2 -39.2 0.68 (1)	10.00				
N-M	0 / 0	-39.2 -39.2 0.20 (3)	10.00				

DESIGN CRITERIA

SPECIFIED LOADS:
TOP CH. LL = 34.8 PSF
DL = 8.0 PSF
BOT CH. LL = 10.5 PSF
DL = 7.3 PSF
TOTAL LOAD = 60.6 PSF

SPACING = 24.0 IN. C/C

LOADING IN FLAT SECTION BASED ON A SLOPE OF 2.00/12 MINIMUM

THIS TRUSS IS DESIGNED FOR RESIDENTIAL OR SMALL BUILDING REQUIREMENTS OF PART 9, NBCC 2015

THIS DESIGN COMPLIES WITH:
- PART 9 OF BCBC 2018, ABC 2019
- PART 9 OF OBC 2012 (2019 AMENDMENT)
- CSA 088-14
- TPIC 2014

(55 % OF 48.1 P.S.F. G.S.L. PLUS 8.4 P.S.F. RAIN LOAD)
EQUALS 34.8 P.S.F. SPECIFIED ROOF LIVE LOAD

ALLOWABLE DEFL.(LL)= L/360 (1.09")
CALCULATED VERT. DEFL.(LL) = L/999 (0.20")
ALLOWABLE DEFL.(TL)= L/360 (1.09")
CALCULATED VERT. DEFL.(TL) = L/999 (0.34")

CSI: TC=0.71/1.00 (B-D-1), BC=0.68/1.00 (N-O-1), WB=0.80/1.00 (B-U-1), SSI=0.28/1.00 (B-D-1)

DOL LUMBER=1.00 NAIL=1.00 LS BEND=1.10 COMP=1.10
SHEAR=1.10 TENS=1.10

COMPANION LIVE LOAD FACTOR = 1.00

TRUSS PLATE MANUFACTURER IS NOT RESPONSIBLE FOR QUALITY CONTROL IN THE TRUSS MANUFACTURING PLANT.

NAIL VALUES
PLATE GRIP(DRY) SHEAR SECTION (PSI) (PLI) (PLI)
MAX MIN MAX MIN MAX MIN
MT20 650 371 1747 788 1987 1873

PLATE PLACEMENT TOL. = 0.250 inches

PLATE ROTATION TOL. = 5.0 Deg.

JSI GRIP= 0.90 (Q) (INPUT = 0.90)
JSI METAL = 0.98 (S) (INPUT = 1.00)




These plans have been reviewed for use with the corrections as noted. No other changes may be made without written approval of the Building Standards Branch. All work must comply with Zoning By-Law 2018-043, as amended, and the Ontario Building Code, as amended. These approved documents must be kept on site at all times. The building permit must be clearly posted on site at all times.

Discipline	Reviewer	BCIN	Date
Building Code	H. Authier	43236	2021-02-03
Service System			
Zoning			

READ ALL NOTES ON THIS PAGE AND ON ENGINEERING NOTE PAGE ENP-1. THIS NOTE PAGE IS AN INTEGRAL PART OF THIS DRAWING AS IT CONTAINS SPECIFICATIONS AND CRITERIA USED IN THE DESIGN OF THIS COMPONENT.



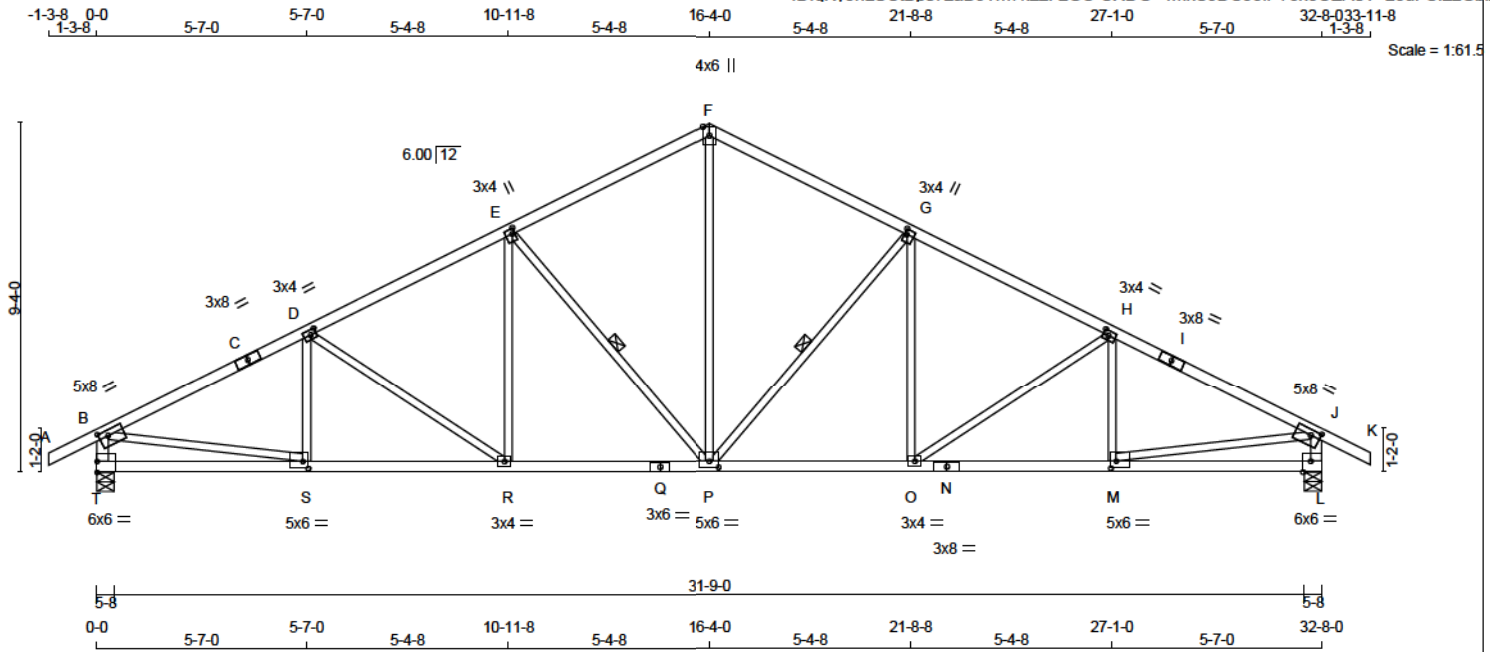

TOTAL WEIGHT = 7 X 138 = 966 lb

LUMBER			
N. L. G. A. RULES	CHORDS	SIZE	LUMBER
A - C	2x4	DRY	No.2
C - F	2x4	DRY	No.2
F - I	2x4	DRY	No.2
I - K	2x4	DRY	No.2
T - B	2x4	DRY	No.2
L - J	2x4	DRY	No.2
T - Q	2x4	DRY	No.2
Q - N	2x4	DRY	No.2
N - L	2x4	DRY	No.2
ALL WEBS	2x3	DRY	No.2
EXCEPT			

DRY: SEASONED LUMBER.

PLATES (table is in inches)

JT	TYPE	PLATES	W	LEN	Y	X
B	TMVW-t	MT20	5.0	8.0	1.75	3.00
C	TS-t	MT20	3.0	8.0		
D	TMVW-t	MT20	3.0	4.0	1.50	1.75
E	TMVW-t	MT20	3.0	4.0	1.75	0.75
F	TTW+p	MT20	4.0	6.0	Edge	
G	TMVW-t	MT20	3.0	4.0	1.75	0.75
H	TMVW-t	MT20	3.0	4.0	1.50	1.75
I	TS-t	MT20	3.0	8.0		
J	TMVW-t	MT20	5.0	8.0	1.75	3.00
L	BMV1-t	MT20	6.0	6.0	Edge	2.50
M	BMVW-t	MT20	5.0	6.0	2.25	1.75
N	BS-t	MT20	3.0	8.0		
O	BMVW-t	MT20	3.0	4.0		
P	BMVW-t	MT20	5.0	6.0	2.00	3.00
Q	BS-t	MT20	3.0	8.0		
R	BMVW-t	MT20	3.0	4.0		
S	BMVW-t	MT20	5.0	6.0	2.25	1.75
T	BMV1-t	MT20	6.0	6.0	3.50	

Edge - INDICATES REFERENCE CORNER OF PLATE TOUCHES EDGE OF CHORD.

DIMENSIONS, SUPPORTS AND LOADINGS SPECIFIED BY FABRICATOR TO BE VERIFIED BY BUILDING DESIGNER

BEARINGS

	FACTORED GROSS REACTION	MAXIMUM FACTORED GROSS REACTION	INPUT BRG	REQD BRG
JT	VERT	HORZ	DOWN	HORZ
T	2842	0	2842	0
L	2842	0	2842	0

UNFACTORED REACTIONS

1ST LCASE	MAX	MIN	COMPONENT REACTIONS						
JT	COMBINED	SNOW	LIVE	PERM.LIVE	WIND	DEAD	SOIL		
T	2098	1232 / 0	343 / 0	0 / 0	0 / 0	522 / 0	0 / 0		
L	2098	1232 / 0	343 / 0	0 / 0	0 / 0	522 / 0	0 / 0		

BEARING MATERIAL TO BE SPF NO.2 OR BETTER AT JOINT(S) T, L

BRACING

TOP CHORD TO BE SHEATHED OR MAX. PURLIN SPACING = 2.94 FT.
MAX. UNBRACED BOTTOM CHORD LENGTH = 10.00 FT OR RIGID CEILING DIRECTLY APPLIED.

ALL PITCH BREAKS AND PERIMETER CORNER JOINTS MUST BE Laterally RESTRAINED.

1 - 1x4 LATERAL BRACE(S) AT 1/2 LENGTH OF G-P, E-P. DBS = 20-0-0. CBF = 137 LBS.

DBS = DIAGONAL BRACE SPACING (MAX). CBF = CUMULATIVE BRACING FORCE (PER BRACE). FASTEN LATERAL BRACE(S) USING (0.122"x3") SPIRAL NAILS : 1 NAIL FOR 2x3 BRACE(S), 2 FOR 1x4, 2x4, 2x5, 3 FOR 2x6, 4 FOR 2x8, 5 FOR 2x10, AND 6 FOR 2x12.

END VERTICAL(S) MUST BE SHEATHED OR HAVE BRACES AS INDICATED IN THE MAX. UNBRACED LENGTH COLUMN OF THE TABLE BELOW

LOADING

TOTAL LOAD CASES: (4)

CHORDS				WEBS			
MEMB.	MAX. FACTORED FORCE (LBS)	FACTORED VERT. LOAD (PLF)	FACTORED LC1 MAX CSI (LC)	MEMB.	MAX. FACTORED FORCE (LBS)	MAX. FACTORED UNBRACED LENGTH (FT)	MAX. FACTORED FORCE (LBS)
FR-TO				FR-TO			
A-B	0 / 38	-124.4	-124.4 0.16 (1)	10.00	P-F	0 / 1889	0.43 (1)
B-C	-3896 / 0	-124.4	-124.4 0.74 (1)	2.94	P-G	-1093 / 0	0.51 (1)
C-D	-3896 / 0	-124.4	-124.4 0.74 (1)	2.94	O-G	0 / 473	0.11 (2)
D-E	-3508 / 0	-124.4	-124.4 0.59 (1)	3.27	O-H	-449 / 0	0.34 (1)
E-F	-2746 / 0	-124.4	-124.4 0.54 (1)	3.67	M-H	-306 / 76	0.07 (1)
F-G	-2746 / 0	-124.4	-124.4 0.54 (1)	3.67	E-P	-1093 / 0	0.51 (1)
G-H	-3508 / 0	-124.4	-124.4 0.59 (1)	3.27	R-E	0 / 473	0.11 (2)
H-I	-3896 / 0	-124.4	-124.4 0.74 (1)	2.94	D-R	-449 / 0	0.34 (1)
I-J	-3896 / 0	-124.4	-124.4 0.74 (1)	2.94	S-D	-306 / 76	0.07 (1)
J-K	0 / 38	-124.4	-124.4 0.16 (1)	10.00	B-S	0 / 3551	0.80 (1)
T-B	-2746 / 0	0.0	0.0 0.28 (1)	5.20	M-J	0 / 3551	0.80 (1)
L-J	-2746 / 0	0.0	0.0 0.28 (1)	5.20			
T-S	0 / 0	-39.2	-39.2 0.21 (3)	10.00			
S-R	0 / 3509	-39.2	-39.2 0.68 (1)	10.00			
R-Q	0 / 3138	-39.2	-39.2 0.64 (1)	10.00			
Q-P	0 / 3138	-39.2	-39.2 0.64 (1)	10.00			
P-O	0 / 3138	-39.2	-39.2 0.64 (1)	10.00			
O-N	0 / 3509	-39.2	-39.2 0.68 (1)	10.00			
N-M	0 / 3509	-39.2	-39.2 0.68 (1)	10.00			
M-L	0 / 0	-39.2	-39.2 0.21 (3)	10.00			

DESIGN CRITERIA

SPECIFIED LOADS:

TOP CH.	LL	= 34.8	PSF
	DL	= 8.0	PSF
BOT CH.	LL	= 10.5	PSF
	DL	= 7.3	PSF
TOTAL LOAD	= 60.6	PSF	

SPACING = 24.0 IN. C/C

THIS TRUSS IS DESIGNED FOR RESIDENTIAL OR SMALL BUILDING REQUIREMENTS OF PART 9, NBCC 2015

THIS DESIGN COMPLIES WITH:
- PART 9 OF BCBC 2018, ABC 2019
- PART 9 OF OBC 2012 (2019 AMENDMENT)
- CSA 086-14
- TPIC 2014

(55 % OF 48.1 P.S.F. G.S.L. PLUS 8.4 P.S.F. RAIN LOAD)
EQUALS 34.8 P.S.F. SPECIFIED ROOF LIVE LOAD

ALLOWABLE DEFL.(LL) = $L/360 (1.00")$
CALCULATED VERT. DEFL.(LL) = $L/999 (0.20")$
ALLOWABLE DEFL.(TL) = $L/360 (1.00")$
CALCULATED VERT. DEFL.(TL) = $L/999 (0.34")$

CSI: TC=0.74/1.00 (B-D-1), BC=0.68/1.00 (M-O-1), WB=0.80/1.00 (J-M-1), SSI=0.29/1.00 (B-D-1)

DOL LUMBER=1.00 NAIL=1.00 LS BEND=1.10 COMP=1.10
SHEAR=1.10 TENS=1.10

COMPANION LIVE LOAD FACTOR = 1.00

TRUSS PLATE MANUFACTURER IS NOT RESPONSIBLE FOR QUALITY CONTROL IN THE TRUSS MANUFACTURING PLANT.

NAIL VALUES
PLATE GRIP(DRY) SHEAR SECTION (PSI) (PLI) (PLI)
MAX MIN MAX MIN MAX MIN
MT20 850 371 1747 788 1987 1873

PLATE PLACEMENT TOL. = 0.250 inches

PLATE ROTATION TOL. = 5.0 Deg.

JSI GRIP= 0.90 (M) (INPUT = 0.90)
JSI METAL = 1.00 (N) (INPUT = 1.00)




These plans have been reviewed for use with the corrections as noted. No other changes may be made without written approval of the Building Standards Branch. All work must comply with Zoning By-Law 2018-043, as amended, and the Ontario Building Code, as amended. These approved documents must be kept on site at all times. The building permit must be clearly posted on site at all times.

Discipline	Reviewer	BCIN	Date
Building Code	H. Authier	43236	2021-02-03
Seismic System			
Zoning			



READ ALL NOTES ON THIS PAGE AND ON ENGINEERING NOTE PAGE ENP-1. THIS NOTE PAGE IS AN INTEGRAL PART OF THIS DRAWING AS IT CONTAINS SPECIFICATIONS AND CRITERIA USED IN THE DESIGN OF THIS COMPONENT.

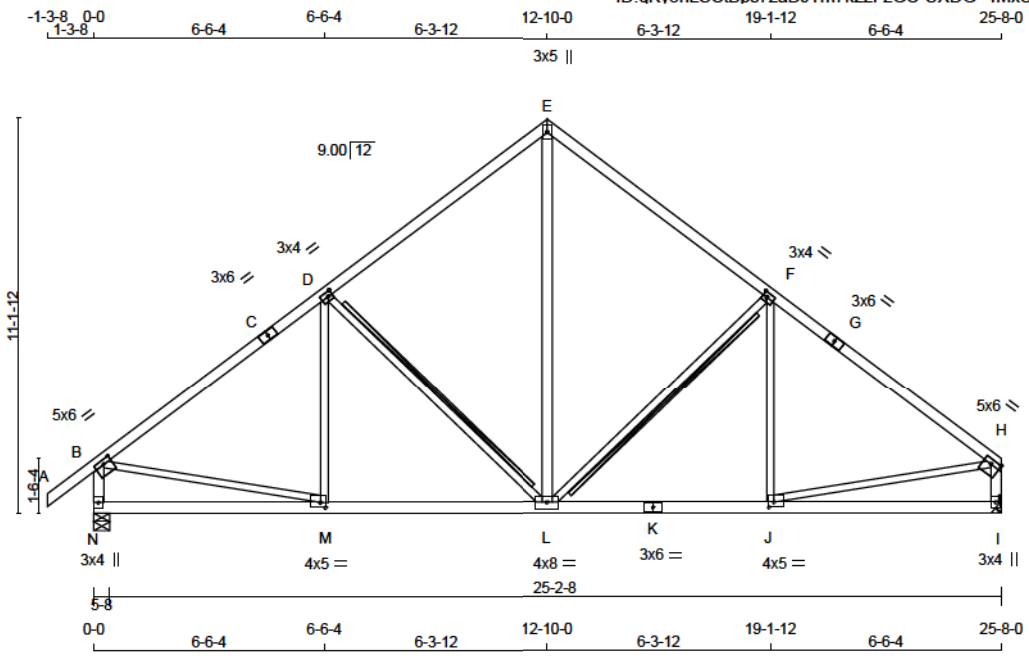

Scale = 1:65.1

TOTAL WEIGHT = 116 LB


LUMBER			
N. L. G. A. RULES	CHORDS	SIZE	LUMBER
A - C	2x4	DRY	No.2
C - E	2x4	DRY	No.2
E - G	2x4	DRY	No.2
G - H	2x4	DRY	No.2

PLATES (table is in inches)					
JT TYPE	SIZE	PLATES	W	LEN	Y X
B	TMVW-t	MT20	5.0	6.0	1.50 2.75
C	TS-t	MT20	3.0	6.0	
D	TMVW-t	MT20	3.0	4.0	1.50 1.50
E	TTW-t	MT20	3.0	5.0	
F	TMVW-t	MT20	3.0	4.0	1.50 1.50
G	TS-t	MT20	3.0	6.0	
H	TMVW-t	MT20	5.0	6.0	1.50 Edge
I	BMV/t+p	MT20	3.0	4.0	
J	BMVW-t	MT20	4.0	5.0	1.75 1.75
K	BS-t	MT20	3.0	6.0	
L	BMVW-t	MT20	4.0	8.0	
M	BMVW-t	MT20	4.0	5.0	1.75 1.75
N	BMV/t+p	MT20	3.0	4.0	

Edge - INDICATES REFERENCE CORNER OF PLATE TOUCHES EDGE OF CHORD.

DIMENSIONS, SUPPORTS AND LOADINGS SPECIFIED BY FABRICATOR TO BE VERIFIED BY BUILDING DESIGNER

FACTORED			MAXIMUM FACTORED		INPUT	REQRD	
GROSS REACTION			GROSS REACTION		BRG	BRG	
JT	VERT	HORZ	DOWN	HORZ	UPLIFT	IN-SX	IN-SX
N	2272	0	2272	0	0	5-8	3-14
I	2101	0	2101	0	0	MECHANICAL	

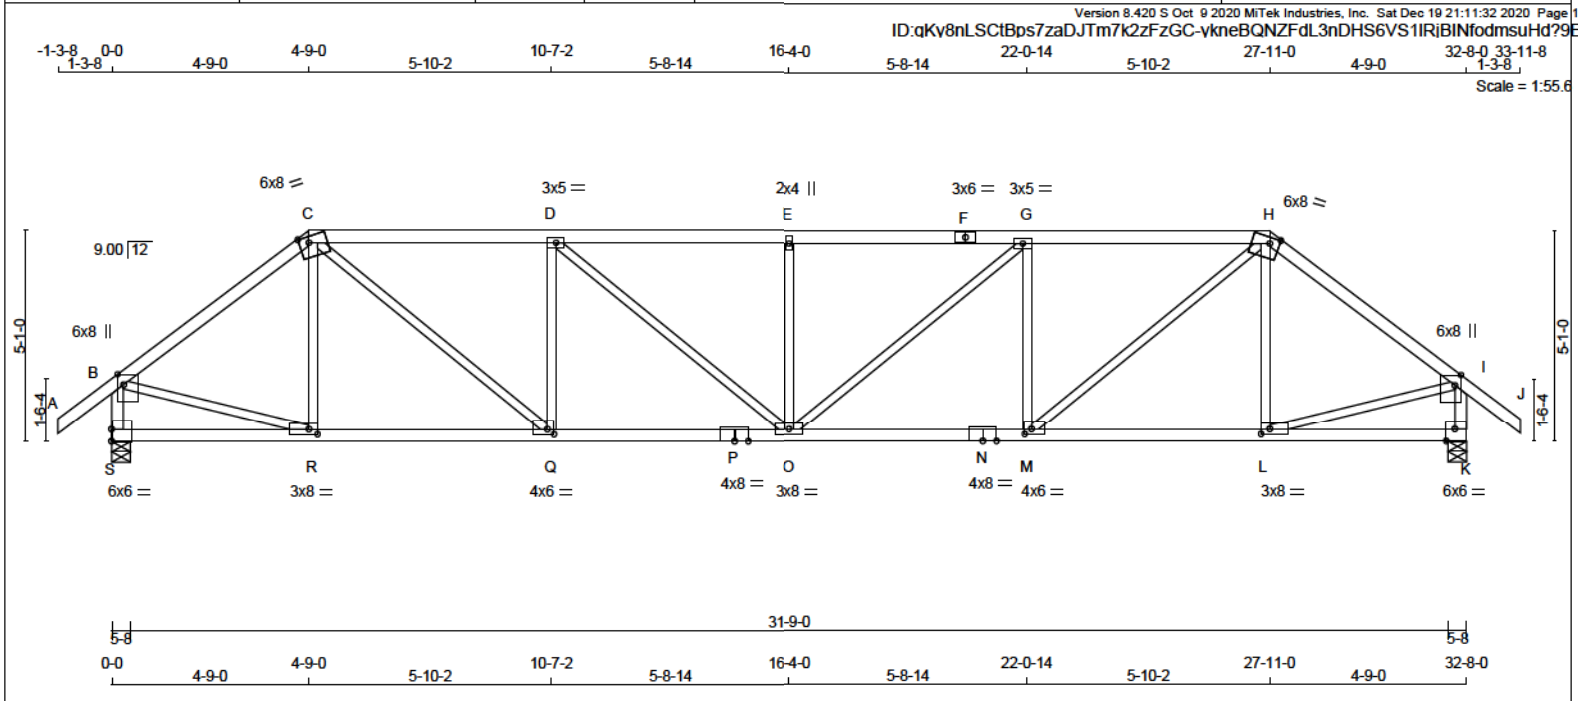


TOTAL WEIGHT = 133 LBS										[M]	
LUMBER N. L. G. A. RULES CHORDS SIZE LUMBER DESCR. A - C 2x4 DRY No.2 SPF C - F 2x4 DRY 2100F 1.8E SPF F - H 2x4 DRY 2100F 1.8E SPF H - J 2x4 DRY No.2 SPF S - B 2x4 DRY No.2 SPF K - I 2x4 DRY No.2 SPF S - P 2x4 DRY No.2 SPF P - N 2x4 DRY No.2 SPF N - K 2x4 DRY No.2 SPF ALL WEBS 2x3 DRY No.2 SPF EXCEPT DRY: SEASONED LUMBER.				DIMENSIONS, SUPPORTS AND LOADINGS SPECIFIED BY FABRICATOR TO BE VERIFIED BY BUILDING DESIGNER BEARINGS <table><tr><td></td><td>FACTORED</td><td>MAXIMUM FACTORED</td><td>INPUT</td><td>REQRD</td></tr><tr><td></td><td>GROSS REACTION</td><td>GROSS REACTION</td><td>BRG</td><td>BRG</td></tr><tr><td>JT VERT</td><td>HORZ</td><td>DOWN</td><td>HORZ</td><td>UPLIFT IN-SX</td></tr><tr><td>S</td><td>2845</td><td>0</td><td>2845</td><td>0</td></tr><tr><td>K</td><td>2845</td><td>0</td><td>2845</td><td>0</td></tr></table> UNFACTORED REACTIONS <table><tr><td>1ST LCASE</td><td colspan="5">MAX/MIN COMPONENT REACTIONS</td></tr><tr><td>JT COMBINED</td><td>SNOW</td><td>LIVE</td><td>PERM.LIVE</td><td>WIND</td><td>DEAD</td><td>SOIL</td></tr><tr><td>S</td><td>2098</td><td>1233 / 0</td><td>343 / 0</td><td>0 / 0</td><td>0 / 0</td><td>522 / 0</td></tr><tr><td>K</td><td>2098</td><td>1233 / 0</td><td>343 / 0</td><td>0 / 0</td><td>0 / 0</td><td>522 / 0</td></tr></table> BEARING MATERIAL TO BE SPF NO.2 OR BETTER AT JOINT(S) S, K BRACING TOP CHORD TO BE SHEATHED OR MAX. PURLIN SPACING = 3.36 FT. MAX. UNBRACED BOTTOM CHORD LENGTH = 10.00 FT OR RIGID CEILING DIRECTLY APPLIED. ALL PITCH BREAKS AND PERIMETER CORNER JOINTS MUST BE Laterally RESTRAINED.											FACTORED	MAXIMUM FACTORED	INPUT	REQRD		GROSS REACTION	GROSS REACTION	BRG	BRG	JT VERT	HORZ	DOWN	HORZ	UPLIFT IN-SX	S	2845	0	2845	0	K	2845	0	2845	0	1ST LCASE	MAX/MIN COMPONENT REACTIONS					JT COMBINED	SNOW	LIVE	PERM.LIVE	WIND	DEAD	SOIL	S	2098	1233 / 0	343 / 0	0 / 0	0 / 0	522 / 0	K	2098	1233 / 0	343 / 0	0 / 0	0 / 0	522 / 0	
	FACTORED	MAXIMUM FACTORED	INPUT	REQRD	
	GROSS REACTION	GROSS REACTION	BRG	BRG	
JT VERT	HORZ	DOWN	HORZ	UPLIFT IN-SX	
S	2845	0	2845	0	
K	2845	0	2845	0	
1ST LCASE	MAX/MIN COMPONENT REACTIONS	
JT COMBINED	SNOW	LIVE	PERM.LIVE	WIND	DEAD	SOIL	
S	2098	1233 / 0	343 / 0	0 / 0	0 / 0	522 / 0	
K	2098	1233 / 0	343 / 0	0 / 0	0 / 0	522 / 0	
PLATES (table is in inches) <table><tr><td>JT TYPE</td><td>PLATES</td><td>W</td><td>LEN</td><td>Y</td><td>X</td></tr><tr><td>B TMVW+p</td><td>MT20</td><td>6.0</td><td>8.0</td><td>3.00</td><td>1.75</td></tr><tr><td>C TTWW-m</td><td>MT20</td><td>6.0</td><td>8.0</td><td>1.75</td><td>2.75</td></tr><tr><td>D TMWW-t</td><td>MT20</td><td>3.0</td><td>5.0</td><td></td><td></td></tr><tr><td>E TMW+w</td><td>MT20</td><td>2.0</td><td>4.0</td><td></td><td></td></tr><tr><td>F TS-t</td><td>MT20</td><td>3.0</td><td>6.0</td><td></td><td></td></tr><tr><td>G TMWW-t</td><td>MT20</td><td>3.0</td><td>5.0</td><td></td><td></td></tr><tr><td>H TTWW-m</td><td>MT20</td><td>6.0</td><td>8.0</td><td>1.75</td><td>2.75</td></tr><tr><td>I TMVW+p</td><td>MT20</td><td>6.0</td><td>8.0</td><td>3.00</td><td>1.75</td></tr><tr><td>K BMV1-t</td><td>MT20</td><td>6.0</td><td>6.0</td><td>Edge</td><td>2.50</td></tr><tr><td>L BMWW-t</td><td>MT20</td><td>3.0</td><td>8.0</td><td>1.50</td><td>2.50</td></tr><tr><td>M BMWW-t</td><td>MT20</td><td>4.0</td><td>6.0</td><td>1.50</td><td>2.00</td></tr><tr><td>N BS-t</td><td>MT20</td><td>4.0</td><td>8.0</td><td></td><td></td></tr><tr><td>O BMWWW-t</td><td>MT20</td><td>3.0</td><td>8.0</td><td></td><td></td></tr><tr><td>P BS-t</td><td>MT20</td><td>4.0</td><td>8.0</td><td></td><td></td></tr><tr><td>Q BMWW-t</td><td>MT20</td><td>4.0</td><td>6.0</td><td>1.50</td><td>2.00</td></tr><tr><td>R BMWW-t</td><td>MT20</td><td>3.0</td><td>8.0</td><td>1.50</td><td>2.50</td></tr><tr><td>S BMV1-t</td><td>MT20</td><td>6.0</td><td>6.0</td><td>3.50</td><td></td></tr>0	1.50	2.00	N BS-t	MT20	4.0	8.0			O BMWWW-t	MT20	3.0	8.0			P BS-t	MT20	4.0	8.0			Q BMWW-t	MT20	4.0	6.0	1.50	2.00	R BMWW-t	MT20	3.0	8.0	1.50	2.50	S BMV1-t	MT20	6.0	6.0	3.50		LOADING TOTAL LOAD CASES: (4) <table><tr><td colspan="4">CHORDS</td><td colspan="4">WEBS</td></tr><tr><td>MEMB.</td><td>MAX. FACTORED</td><td>FACTORED</td><td></td><td>MEMB.</td><td>MAX. FACTORED</td><td></td><td></td></tr><tr><td></td><td>FORCE</td><td>VERT. LOAD</td><td>LC1 MAX</td><td></td><td>FORCE</td><td>MAX</td><td></td></tr><tr><td></td><td>(LBS)</td><td>(PLF)</td><td>CSI (LC)</td><td></td><td>(LBS)</td><td>CSI (LC)</td><td></td></tr><tr><td>FR-TO</td><td>FROM</td><td>TO</td><td>LENGTH</td><td>FR-TO</td><td>FROM</td><td>TO</td><td>LENGTH</td></tr><tr><td>A-B</td><td>0 / 51</td><td>-124.4 -124.4</td><td>0.17 (1)</td><td>10.00</td><td>R-C</td><td>-333 / 48</td><td>0.13 (1)</td></tr><tr><td>B-C</td><td>-2888 / 0</td><td>-124.4 -124.4</td><td>0.73 (1)</td><td>3.36</td><td>C-Q</td><td>0 / 2326</td><td>0.52 (1)</td></tr><tr><td>C-D</td><td>-4100 / 0</td><td>-124.4 -124.4</td><td>0.56 (1)</td><td>3.79</td><td>Q-D</td><td>-1250 / 0</td><td>0.48 (1)</td></tr><tr><td>D-E</td><td>-4631 / 0</td><td>-124.4 -124.4</td><td>0.60 (1)</td><td>3.58</td><td>D-O</td><td>0 / 691</td><td>0.16 (1)</td></tr><tr><td>E-F</td><td>-4631 / 0</td><td>-124.4 -124.4</td><td>0.60 (1)</td><td>3.58</td><td>O-E</td><td>-960 / 0</td><td>0.25 (1)</td></tr><tr><td>F-G</td><td>-4631 / 0</td><td>-124.4 -124.4</td><td>0.60 (1)</td><td>3.58</td><td>O-G</td><td>0 / 691</td><td>0.16 (1)</td></tr><tr><td>G-H</td><td>-4100 / 0</td><td>-124.4 -124.4</td><td>0.56 (1)</td><td>3.79</td><td>M-G</td><td>-1250 / 0</td><td>0.48 (1)</td></tr><tr><td>H-I</td><td>-2888 / 0</td><td>-124.4 -124.4</td><td>0.73 (1)</td><td>3.36</td><td>M-H</td><td>0 / 2326</td><td>0.52 (1)</td></tr><tr><td>I-J</td><td>0 / 51</td><td>-124.4 -124.4</td><td>0.17 (1)</td><td>10.00</td><td>L-H</td><td>-333 / 48</td><td>0.13 (1)</td></tr><tr><td>S-B</td><td>-2772 / 0</td><td>0.0</td><td>0.0</td><td>0.29 (1)</td><td>5.17</td><td>B-R</td><td>0 / 2375</td><td>0.53 (1)</td></tr><tr><td>K-I</td><td>-2772 / 0</td><td>0.0</td><td>0.0</td><td>0.29 (1)</td><td>5.17</td><td>L-I</td><td>0 / 2375</td><td>0.53 (1)</td></tr><tr><td>S-R</td><td>0 / 0</td><td>-39.2 -39.2</td><td>0.21 (3)</td><td>10.00</td><td></td><td></td><td></td><td></td></tr><tr><td>R-Q</td><td>0 / 2299</td><td>-39.2 -39.2</td><td>0.52 (1)</td><td>10.00</td><td></td><td></td><td></td><td></td></tr><tr><td>Q-P</td><td>0 / 4100</td><td>-39.2 -39.2</td><td>0.78 (1)</td><td>10.00</td><td></td><td></td><td></td><td></td></tr><tr><td>P-O</td><td>0 / 4100</td><td>-39.2 -39.2</td><td>0.78 (1)</td><td>10.00</td><td></td><td></td><td></td><td></td></tr><tr><td>O-N</td><td>0 / 4100</td><td>-39.2 -39.2</td><td>0.78 (1)</td><td>10.00</td><td></td><td></td><td></td><td></td></tr><tr><td>N-M</td><td>0 / 4100</td><td>-39.2 -39.2</td><td>0.78 (1)</td><td>10.00</td><td></td><td></td><td></td><td></td></tr><tr><td>M-L</td><td>0 / 2299</td><td>-39.2 -39.2</td><td>0.52 (1)</td><td>10.00</td><td></td><td></td><td></td><td></td></tr><tr><td>L-K</td><td>0 / 0</td><td>-39.2 -39.2</td><td>0.21 (3)</td><td>10.00</td><td></td><td></td><td></td><td></td></tr>
JT TYPE	PLATES	W	LEN	Y	X	
B TMVW+p	MT20	6.0	8.0	3.00	1.75	
C TTWW-m	MT20	6.0	8.0	1.75	2.75	
D TMWW-t	MT20	3.0	5.0	
E TMW+w	MT20	2.0	4.0	
F TS-t	MT20	3.0	6.0	
G TMWW-t	MT20	3.0	5.0	
H TTWW-m	MT20	6.0	8.0	1.75	2.75	
I TMVW+p	MT20	6.0	8.0	3.00	1.75	
K BMV1-t	MT20	6.0	6.0	Edge	2.50	
L BMWW-t	MT20	3.0	8.0	1.50	2.50	
M BMWW-t	MT20	4.0	6.0	1.50	2.00	
N BS-t	MT20	4.0	8.0	
O BMWWW-t	MT20	3.0	8.0	
P BS-t	MT20	4.0	8.0	
Q BMWW-t	MT20	4.0	6.0	1.50	2.00	
R BMWW-t	MT20	3.0	8.0	1.50	2.50	
S BMV1-t	MT20	6.0	6.0	3.50	
CHORDS				WEBS	
MEMB.	MAX. FACTORED	FACTORED		MEMB.	MAX. FACTORED	
	FORCE	VERT. LOAD	LC1 MAX		FORCE	MAX	
	(LBS)	(PLF)	CSI (LC)		(LBS)	CSI (LC)	
FR-TO	FROM	TO	LENGTH	FR-TO	FROM	TO	LENGTH	
A-B	0 / 51	-124.4 -124.4	0.17 (1)	10.00	R-C	-333 / 48	0.13 (1)	
B-C	-2888 / 0	-124.4 -124.4	0.73 (1)	3.36	C-Q	0 / 2326	0.52 (1)	
C-D	-4100 / 0	-124.4 -124.4	0.56 (1)	3.79	Q-D	-1250 / 0	0.48 (1)	
D-E	-4631 / 0	-124.4 -124.4	0.60 (1)	3.58	D-O	0 / 691	0.16 (1)	
E-F	-4631 / 0	-124.4 -124.4	0.60 (1)	3.58	O-E	-960 / 0	0.25 (1)	
F-G	-4631 / 0	-124.4 -124.4	0.60 (1)	3.58	O-G	0 / 691	0.16 (1)	
G-H	-4100 / 0	-124.4 -124.4	0.56 (1)	3.79	M-G	-1250 / 0	0.48 (1)	
H-I	-2888 / 0	-124.4 -124.4	0.73 (1)	3.36	M-H	0 / 2326	0.52 (1)	
I-J	0 / 51	-124.4 -124.4	0.17 (1)	10.00	L-H	-333 / 48	0.13 (1)	
S-B	-2772 / 0	0.0	0.0	0.29 (1)	5.17	B-R	0 / 2375	0.53 (1)	
K-I	-2772 / 0	0.0	0.0	0.29 (1)	5.17	L-I	0 / 2375	0.53 (1)	
S-R	0 / 0	-39.2 -39.2	0.21 (3)	10.00	
R-Q	0 / 2299	-39.2 -39.2	0.52 (1)	10.00	
Q-P	0 / 4100	-39.2 -39.2	0.78 (1)	10.00	
P-O	0 / 4100	-39.2 -39.2	0.78 (1)	10.00	
O-N	0 / 4100	-39.2 -39.2	0.78 (1)	10.00	
N-M	0 / 4100	-39.2 -39.2	0.78 (1)	10.00	
M-L	0 / 2299	-39.2 -39.2	0.52 (1)	10.00	
L-K	0 / 0	-39.2 -39.2	0.21 (3)	10.00	
				DESIGN CRITERIA SPECIFIED LOADS: TOP CH. LL = 34.8 PSF DL = 8.0 PSF BOT CH. LL = 10.5 PSF DL = 7.3 PSF TOTAL LOAD = 60.6 PSF SPACING = 24.0 IN. C/C LOADING IN FLAT SECTION BASED ON A SLOPE OF 2.00/12 MINIMUM THIS TRUSS IS DESIGNED FOR RESIDENTIAL OR SMALL BUILDING REQUIREMENTS OF PART 9, NBCC 2015 THIS DESIGN COMPLIES WITH: - PART 9 OF BCBC 2018, ABC 2019 - PART 9 OF OBC 2012 (2019 AMENDMENT) - CSA 088-14 - TPIC 2014 (55% OF 48.1 P.S.F. G.S.L. PLUS 8.4 P.S.F. RAIN LOAD) EQUALS 34.8 P.S.F. SPECIFIED ROOF LIVE LOAD ALLOWABLE DEFL.(LL)= L/360 (1.09") CALCULATED VERT. DEFL.(LL) = L/999 (0.23") ALLOWABLE DEFL.(TL)= L/360 (1.09") CALCULATED VERT. DEFL.(TL) = L/999 (0.38") CSI: TC=0.73/1.00 (H-I-1), BC=0.78/1.00 (M-O-1), WB=0.53/1.00 (I-L-1), SSI=0.34/1.00 (C-D-1) DOL LUMBER=1.00 NAIL=1.00 LS BEND=1.10 COMP=1.10 SHEAR=1.10 TENS=1.10 COMPANION LIVE LOAD FACTOR = 1.00 TRUSS PLATE MANUFACTURER IS NOT RESPONSIBLE FOR QUALITY CONTROL IN THE TRUSS MANUFACTURING PLANT . NAIL VALUES PLATE GRIP(DRY) SHEAR SECTION (PSI) (PLI) (PLI) MAX MIN MAX MIN MAX MIN MT20 650 371 1747 788 1987 1873	

READ ALL NOTES ON THIS PAGE AND ON ENGINEERING NOTE PAGE ENP-1. THIS NOTE PAGE IS AN INTEGRAL PART OF THIS DRAWING AS IT CONTAINS SPECIFICATIONS AND CRITERIA USED IN THE DESIGN OF THIS COMPONENT.

Town of East Gwillimbury
Building Standards Branch BCN #18467

These plans have been reviewed for use with the corrections as noted. No other changes may be made without written approval of the Building Standards Branch. All work must comply with Zoning By-Law 2018-043, as amended, and the Ontario Building Code, as amended. These approved documents must be kept on site at all times. The building permit must be clearly posted on site at all times.

Discipline	Reviewer	BCIN	Date
Building Code	H. Authier	43236	2021-02-03
Sewage System			
Zoning			

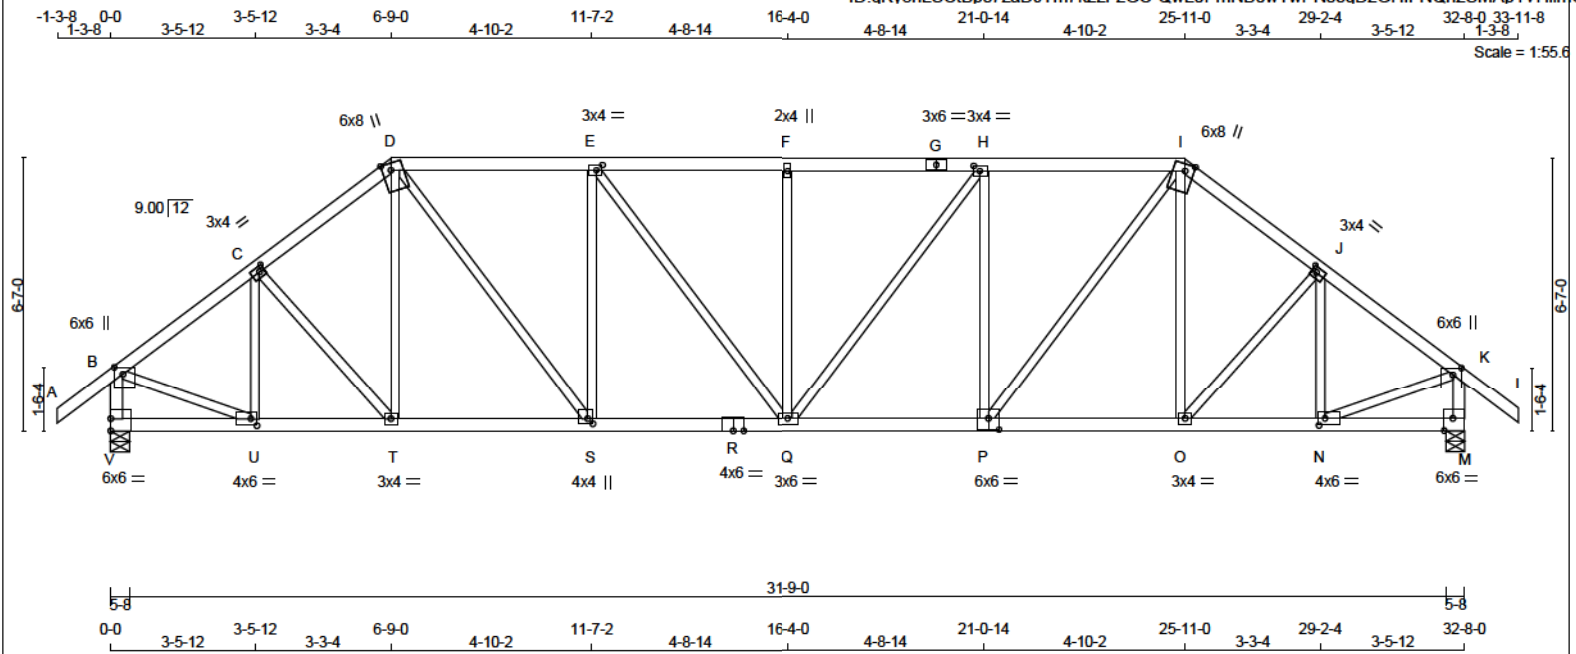

TOTAL WEIGHT = 153 lb

LUMBER			
N. L. G. A. RULES			
CHORDS	SIZE	LUMBER	DESCR.
A - D	2x4	DRY No.2	SPF
D - G	2x4	DRY No.2	SPF
G - I	2x4	DRY No.2	SPF
I - L	2x4	DRY No.2	SPF
V - B	2x4	DRY No.2	SPF
M - K	2x4	DRY No.2	SPF
V - R	2x4	DRY No.2	SPF
R - P	2x4	DRY No.2	SPF
P - M	2x4	DRY No.2	SPF
ALL WEBS EXCEPT	2x3	DRY No.2	SPF

DRY: SEASONED LUMBER.

PLATES (table is in inches)

J	T	PLATES	W	LEN	Y
B	TMW+p	MT20	6.0	8.0	2.00 2.50
C	TMWW-t	MT20	3.0	4.0	1.50 1.50
D	TTWW+m	MT20	6.0	8.0	2.00 2.50
E	TMWW-t	MT20	3.0	4.0	1.50 1.75
F	TMW+w	MT20	2.0	4.0	
G	TS-t	MT20	3.0	8.0	
H	TMWW-t	MT20	3.0	4.0	1.50 1.75
I	TTWW+m	MT20	6.0	8.0	2.00 2.50
J	TMWW-t	MT20	3.0	4.0	1.50 1.50
K	TMW+p	MT20	6.0	8.0	2.00 2.50
M	BMV1-t	MT20	6.0	6.0	Edge 2.50
N	BMWW-t	MT20	4.0	6.0	2.00 1.75
O	BMWW-t	MT20	3.0	4.0	
P	BSWW-t	MT20	6.0	6.0	3.25 3.00
Q	BMWWW-t	MT20	3.0	6.0	
R	BS-t	MT20	4.0	6.0	
S	BMWW+t	MT20	4.0	4.0	1.50 1.50
T	BMWW-t	MT20	3.0	4.0	
U	BMWW-t	MT20	4.0	6.0	2.00 1.75
V	BMV1-t	MT20	6.0	6.0	3.50

Edge - INDICATES REFERENCE CORNER OF PLATE TOUCHES
EDGE OF CHORD.

DIMENSIONS, SUPPORTS AND LOADINGS SPECIFIED BY FABRICATOR TO BE VERIFIED BY BUILDING DESIGNER

BEARINGS

JT	FACTORED GROSS REACTION		MAXIMUM FACTORED GROSS REACTION			INPUT BRG	REQRD BRG
	VERT	HORZ	DOWN	HORZ	UPLIFT	IN-SX	IN-SX
V	2845	0	2845	0	0	5-8	5-8
M	2845	0	2845	0	0	5-8	5-8

UNFACTORED REACTIONS

1ST LCASE MAX./MIN. COMPONENT REACTIONS

JT	COMBINED	SNOW	LIVE	PERM.LIVE	WIND	DEAD	SOIL
V	2098	1233 / 0	343 / 0	0 / 0	0 / 0	522 / 0	0 / 0
M	2098	1233 / 0	343 / 0	0 / 0	0 / 0	522 / 0	0 / 0

BEARING MATERIAL TO BE SPF NO.2 OR BETTER AT JOINT(S) V, M

BRACING

TOP CHORD TO BE SHEATHED OR MAX. PURLIN SPACING = 3.14 FT.

MAX. UNBRACED BOTTOM CHORD LENGTH = 10.00 FT OR RIGID CEILING DIRECTLY APPLIED

ALL PITCH BREAKS AND PERIMETER CORNER JOINTS MUST BE Laterally RESTRAINED

LOADING

TOTAL LOAD CASES: (4)

CHORDS					WEBS				
MEMB.	MAX. FACTORED FORCE (LBS)	FACTORED VERT. LOAD (PLF)	LOAD L1 MAX (LBS)	MAX UNBRAC (LBS)	MEMB.	MAX. FACTORED FORCE (LBS)	MAX CASI (LBS)		
FR-TO		FROM TO		LENGTH	FR-TO				
A-B	0 / 51	-124.4 -124.4	0.17 (1)	10.00	U-C	-839 / 0	0.17 (1)		
B-C	-2762 / 0	-124.4 -124.4	0.33 (1)	3.89	C-T	0 / 93	0.02 (1)		
C-D	-2901 / 0	-124.4 -124.4	0.33 (1)	3.80	T-D	0 / 167	0.04 (3)		
D-E	-3234 / 0	-124.4 -124.4	0.82 (1)	3.30	D-S	0 / 1540	0.35 (1)		
E-F	-3510 / 0	-124.4 -124.4	0.04 (1)	3.14	S-E	-1033 / 0	0.74 (1)		
F-G	-3510 / 0	-124.4 -124.4	0.94 (1)	3.14	E-Q	0 / 157	0.10 (1)		
G-H	-3510 / 0	-124.4 -124.4	0.04 (1)	3.14	Q-F	-542 / 0	0.39 (1)		
H-I	-3224 / 0	-124.4 -124.4	0.82 (1)	3.30	Q-H	0 / 474	0.11 (1)		
I-J	-2905 / 0	-124.4 -124.4	0.33 (1)	3.80	P-H	-1047 / 0	0.75 (1)		
J-K	-2780 / 0	-124.4 -124.4	0.33 (1)	3.89	P-I	0 / 1518	0.34 (1)		
K-L	0 / 51	-124.4 -124.4	0.17 (1)	10.00	O-I	0 / 195	0.05 (3)		
V-B	-2781 / 0	0.0 0.0	0.29 (1)	5.17	O-J	0 / 99	0.02 (1)		
M-K	-2780 / 0	0.0 0.0	0.29 (1)	5.17	N-J	-847 / 0	0.17 (1)		
					B-U	0 / 2358	0.53 (1)		
					N-K	0 / 2357	0.53 (1)		
V-U	0 / 0	-39.2 -39.2	0.08 (3)	10.00					
U-T	0 / 2230	-39.2 -39.2	0.44 (1)	10.00					
T-S	0 / 2294	-39.2 -39.2	0.40 (1)	10.00					
R-Q	0 / 2325	-39.2 -39.2	0.81 (1)	10.00					
S-R	0 / 2325	-39.2 -39.2	0.81 (1)	10.00					
Q-P	0 / 3224	-39.2 -39.2	0.83 (1)	10.00					
P-O	0 / 2297	-39.2 -39.2	0.48 (1)	10.00					
O-N	0 / 2229	-39.2 -39.2	0.47 (1)	10.00					
N-M	0 / 0	-39.2 -39.2	0.09 (3)	10.00					

DESIGN CRITERIA

SPECIFIED LOADS:

TOP	CH.	LL = 34.8	PSF
		DL = 8.0	PSF
BOT	CH.	LL = 10.5	PSF
		DL = 7.3	PSF
TOTAL LOAD		= 60.6	PSF

SPACING = 24.0 IN. C/C

LOADING IN FLAT SECTION BASED ON A SLOPE OF 2.00/12 MINIMUM

THIS TRUSS IS DESIGNED FOR RESIDENTIAL OR SMALL BUILDING REQUIREMENTS OF PART 9, NBCC 2015

THIS DESIGN COMPLIES WITH:

- PART 9 OF BCBC 2018 , ABC 2019
- PART 9 OF OBC 2012 (2019 AMENDMENT)
- CSA 088-14
- TPIC 2014

(55 % OF 48.1 P.S.F. G.S.L. PLUS 8.4 P.S.F. RAIN LOAD)
EQUALS 34.8 P.S.F. SPECIFIED ROOF LIVE LOAD

ALLOWABLE DEFL.(LL)= L/360 (1.09")
CALCULATED VERT. DEFL.(LL) = L/ 999 (0.17")
ALLOWABLE DEFL.(TL)= L/360 (1.09")
CALCULATED VERT. DEFL.(TL) = L/ 999 (0.28")

CSI: TC=0.64/1.00 (F-H:1) , BC=0.63/1.00 (P-Q:1) ,
WB=0.75/1.00 (H-P:1) . SS=0.28/1.00 (H-I:1)

DOL LUMBER=1.00 NAIL=1.00 LS BEND=1.10 COMP=1.10
SHEAR=1.10 TENS= 1.10

COMPANION LIVE LOAD FACTOR = 1.00

TRUSS PLATE MANUFACTURER IS NOT RESPONSIBLE
FOR QUALITY CONTROL IN THE TRUSS
MANUFACTURING PLANT .

NAIL VALUES

PLATE	GRIP(DRY)		SHEAR		SECTION	
	(PSI)	(PLI)	(PSI)	(PLI)	(PSI)	(PLI)
MT20	850	371	1747	788	1987	1873

PLATE PLACEMENT TOL. = 0.250 inches

PLATE ROTATION TOL. = 5.0 Deg.

JSI GRIP= 0.90 (C) (INPUT = 0.90)

SS(METAL) = 0.75 (K) (INT ST = 1.00)




These plans have been reviewed for use with the corrections as noted. No other changes may be made without written approval of the Building Standards Branch. All work must comply with Zoning By-Law 2018-043, as amended, and the Ontario Building Code, as amended. These approved documents must be kept on site at all times. The building permit must be clearly posted on site at all times.

Discipline	Reviewer	BCIN	Date
Building Code	H. Authier	43236	2021-02-06
Sewage System			
Zoning			



**READ ALL NOTES ON THIS PAGE AND ON
ENGINEERING NOTE PAGE ENP-1. THIS
NOTE PAGE IS AN INTEGRAL PART OF
THIS DRAWING AS IT CONTAINS
SPECIFICATIONS AND CRITERIA USED IN
THE DESIGN OF THIS COMPONENT.**

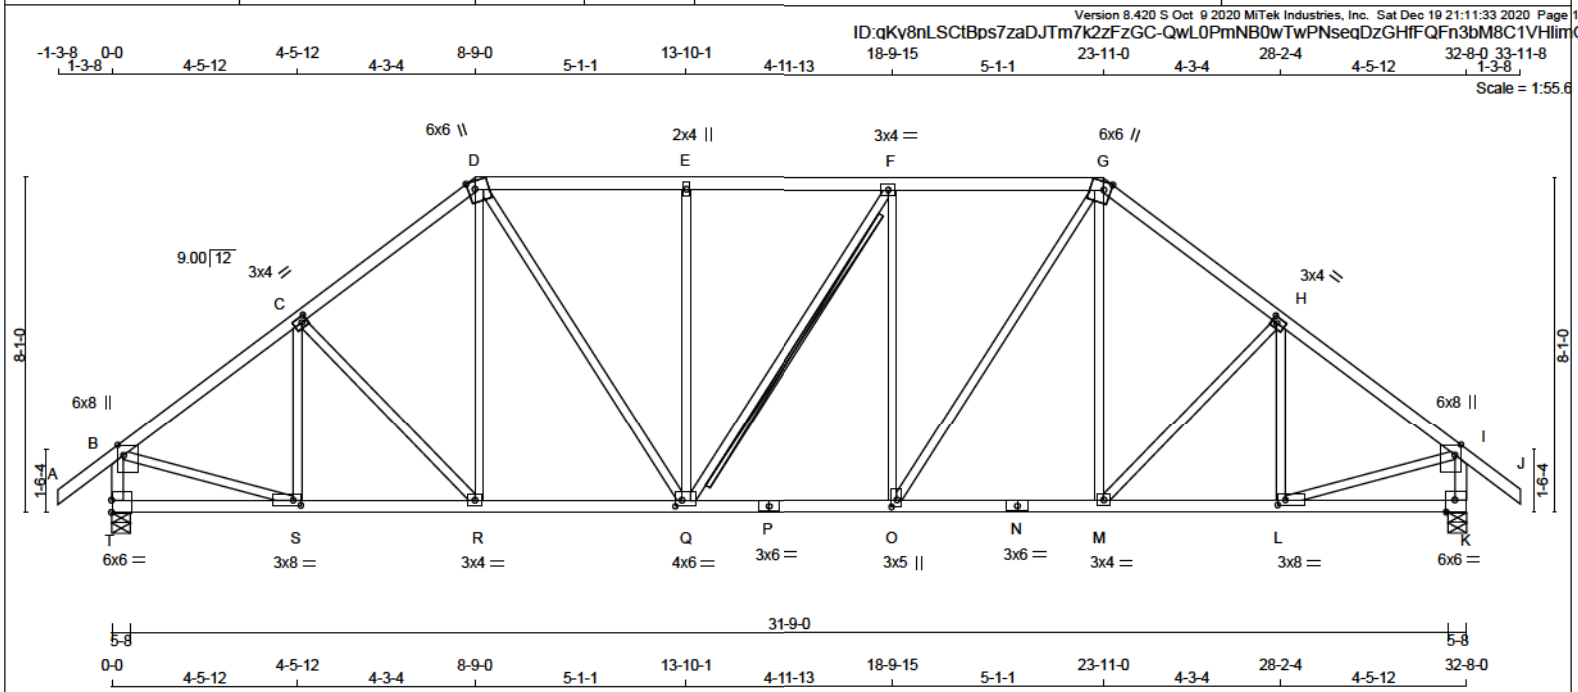

LUMBER
N. L. G. A. RULES

CHORDS	SIZE	LUMBER	DESCR.
A - D	2x4	DRY No.2	SPF
B - G	2x4	DRY No.2	SPF
G - J	2x4	DRY No.2	SPF
T - B	2x4	DRY No.2	SPF
K - I	2x4	DRY No.2	SPF
T - P	2x4	DRY No.2	SPF
P - N	2x4	DRY No.2	SPF
N - K	2x4	DRY No.2	SPF
ALL WEBS	2x3	DRY No.2	SPF
EXCEPT			

DRY: SEASONED LUMBER.

PLATES (Table is in inches)

JT TYPE	PLATES	W	LEN	Y	X
B TMVW+p	MT20	6.0	8.0	3.00	1.75
C TMVW-t	MT20	3.0	4.0	1.50	1.50
D TTWW+m	MT20	6.0	8.0	Edge 2.00	
E TMVW+w	MT20	2.0	4.0		
F TMVW-t	MT20	3.0	4.0		
G TTWW+m	MT20	6.0	6.0	Edge 2.00	
H TMVW-t	MT20	3.0	4.0	1.50	1.50
I TMVW+p	MT20	6.0	8.0	3.00	1.75
K BMV1-t	MT20	6.0	6.0	Edge 2.50	
L BMVW-t	MT20	3.0	8.0	1.50	2.25
M BMVW-t	MT20	3.0	4.0		
N BS-t	MT20	3.0	6.0		
O BMVW+t	MT20	3.0	5.0	2.00	1.50
P BS-t	MT20	3.0	6.0		
Q BMVW-t	MT20	4.0	6.0	1.75	2.00
R BMVW-t	MT20	3.0	4.0		
S BMVW-t	MT20	3.0	8.0	1.50	2.25
T BMV1-t	MT20	6.0	6.0	3.50	

Edge - INDICATES REFERENCE CORNER OF PLATE TOUCHES EDGE OF CHORD.

DIMENSIONS, SUPPORTS AND LOADINGS SPECIFIED BY FABRICATOR TO BE VERIFIED BY BUILDING DESIGNER

BEARINGS

	FACTORED GROSS REACTION	MAXIMUM FACTORED GROSS REACTION	INPUT BRG	REQD BRG
JT VERT	2845	2845	5-8	5-8
T 2845	0	0	5-8	5-8
K 2845	0	0	5-8	5-8

UNFACTORED REACTIONS

1ST LCASE	MAX	MIN	COMPONENT REACTIONS
JT COMBINED	1233	0	343
T 2098	1233	0	343
K 2098	1233	0	343

BEARING MATERIAL TO BE SPF NO.2 OR BETTER AT JOINT(S) T, K

BRACING
TOP CHORD TO BE SHEATHED OR MAX. PURLIN SPACING = 3.72 FT.
MAX. UNBRACED BOTTOM CHORD LENGTH = 10.00 FT OR RIGID CEILING DIRECTLY APPLIED.
ALL PITCH BREAKS AND PERIMETER CORNER JOINTS MUST BE LATERALLY RESTRAINED.

2x4 DRY SPF No.2 T-BRACE AT F-Q

FASTEN T AND I-BRACES TO NARROW EDGE OF WEB WITH ONE ROW PER PLY OF 3" COMMON WIRE NAILS @ 6" O.C. WITH 3" MINIMUM END DISTANCE. BRACE MUST COVER 90% OF WEB LENGTH.

END VERTICAL(S) MUST BE SHEATHED OR HAVE BRACES AS INDICATED IN THE MAX. UNBRACED LENGTH COLUMN OF THE TABLE BELOW

LOADING
TOTAL LOAD CASES: (4)

CHORDS				WEBS			
MEMB.	MAX. FACTORED FORCE (LBS)	FACTORED VERT. LOAD (PLF)	MAX. UNBRACED LENGTH (FT)	MEMB.	MAX. FACTORED FORCE (LBS)	MAX. UNBRACED LENGTH (FT)	CS (LC)
FR-TO	0 / 51	-124.4	0.17 (1)	10.00	S-C	-443	0
A-B	-2891	-124.4	0.42 (1)	3.74	C-R	-191	0
B-C	-2807	-124.4	0.41 (1)	3.80	R-D	0 / 348	0.08 (2)
C-D	-2784	-124.4	0.46 (1)	3.73	D-Q	0 / 1040	0.23 (1)
D-E	-2784	-124.4	0.43 (1)	3.77	Q-E	-674	0
E-F	-2786	-124.4	0.46 (1)	3.72	Q-F	-4	0.00 (1)
F-G	-2806	-124.4	0.41 (1)	3.80	O-F	-675	0
G-H	-2891	-124.4	0.42 (1)	3.74	O-G	0 / 1045	0.24 (1)
H-I	0 / 51	-124.4	0.17 (1)	10.00	M-G	0 / 348	0.08 (2)
I-J	-2768	0.0	0.0 0.29 (1)	5.17	M-H	-192	0
J-K	-2768	0.0	0.0 0.29 (1)	5.17	L-H	-442	0
					B-S	0 / 2424	0.55 (1)
					L-I	0 / 2424	0.59 (1)
T-S	0 / 0	-39.2	-39.2 0.13 (3)	10.00			
S-R	0 / 2342	-39.2	-39.2 0.48 (1)	10.00			
R-Q	0 / 2214	-39.2	-39.2 0.46 (1)	10.00			
Q-P	0 / 2786	-39.2	-39.2 0.55 (1)	10.00			
P-O	0 / 2786	-39.2	-39.2 0.55 (1)	10.00			
O-N	0 / 2214	-39.2	-39.2 0.46 (1)	10.00			
N-M	0 / 2214	-39.2	-39.2 0.46 (1)	10.00			
M-L	0 / 2342	-39.2	-39.2 0.47 (1)	10.00			
L-K	0 / 0	-39.2	-39.2 0.13 (3)	10.00			

DESIGN CRITERIA

SPECIFIED LOADS:	
TOP CH. LL	= 34.8 PSF
DL	= 8.0 PSF
BOT CH. LL	= 10.5 PSF
DL	= 7.3 PSF
TOTAL LOAD	= 60.6 PSF

SPACING = 24.0 IN. C/C

LOADING IN FLAT SECTION BASED ON A SLOPE OF 2.00/12 MINIMUM

THIS TRUSS IS DESIGNED FOR RESIDENTIAL OR SMALL BUILDING REQUIREMENTS OF PART 9, NBCC 2015

THIS DESIGN COMPLIES WITH:
- PART 9 OF BCBC 2018, ABC 2019
- PART 9 OF OBC 2012 (2019 AMENDMENT)
- CSA 088-14
- TPIC 2014

(55% OF 48.1 P.S.F. G.S.L. PLUS 8.4 P.S.F. RAIN LOAD) EQUALS 34.8 P.S.F. SPECIFIED ROOF LIVE LOAD

ALLOWABLE DEFL.(LL) = L/360 (1.09")
CALCULATED VERT. DEFL.(LL) = L/999 (0.13")
ALLOWABLE DEFL.(TL) = L/360 (1.09")
CALCULATED VERT. DEFL.(TL) = L/999 (0.22")

CSI: TC=0.46/1.00 (D-E-1), BC=0.55/1.00 (O-Q-1), WB=0.85/1.00 (F-O-1), SSI=0.29/1.00 (F-G-1)

DOL LUMBER=1.00 NAIL=1.00 LS BEND=1.10 COMP=1.10 SHEAR=1.10 TENS=1.10

COMPANION LIVE LOAD FACTOR = 1.00

TRUSS PLATE MANUFACTURER IS NOT RESPONSIBLE FOR QUALITY CONTROL IN THE TRUSS MANUFACTURING PLANT.

NAIL VALUES
PLATE GRIP(DRY) SHEAR SECTION (PSI) (PLI) (PLI)
MAX MIN MAX MIN MAX MIN
MT20 650 371 1747 788 1987 1873

PLATE PLACEMENT TOL = 0.250 inches

PLATE ROTATION TOL = 5.0 Deg.

JSI GRIP= 0.90 (Q) (INPUT = 0.90)
JSI METAL= 0.90 (P) (INPUT = 1.00)




These plans have been reviewed for use with the corrections as noted. No other changes may be made without written approval of the Building Standards Branch. All work must comply with Zoning By-Law 2018-043, as amended, and the Ontario Building Code, as amended. These approved documents must be kept on site at all times. The building permit must be clearly posted on site at all times.

Discipline	Reviewer	BCIN	Date
Building Code	H. Authier	43236	2021-02-03
Severage System			
Zoning			





READ ALL NOTES ON THIS PAGE AND ON ENGINEERING NOTE PAGE ENP-1. THIS NOTE PAGE IS AN INTEGRAL PART OF THIS DRAWING AS IT CONTAINS SPECIFICATIONS AND CRITERIA USED IN THE DESIGN OF THIS COMPONENT.



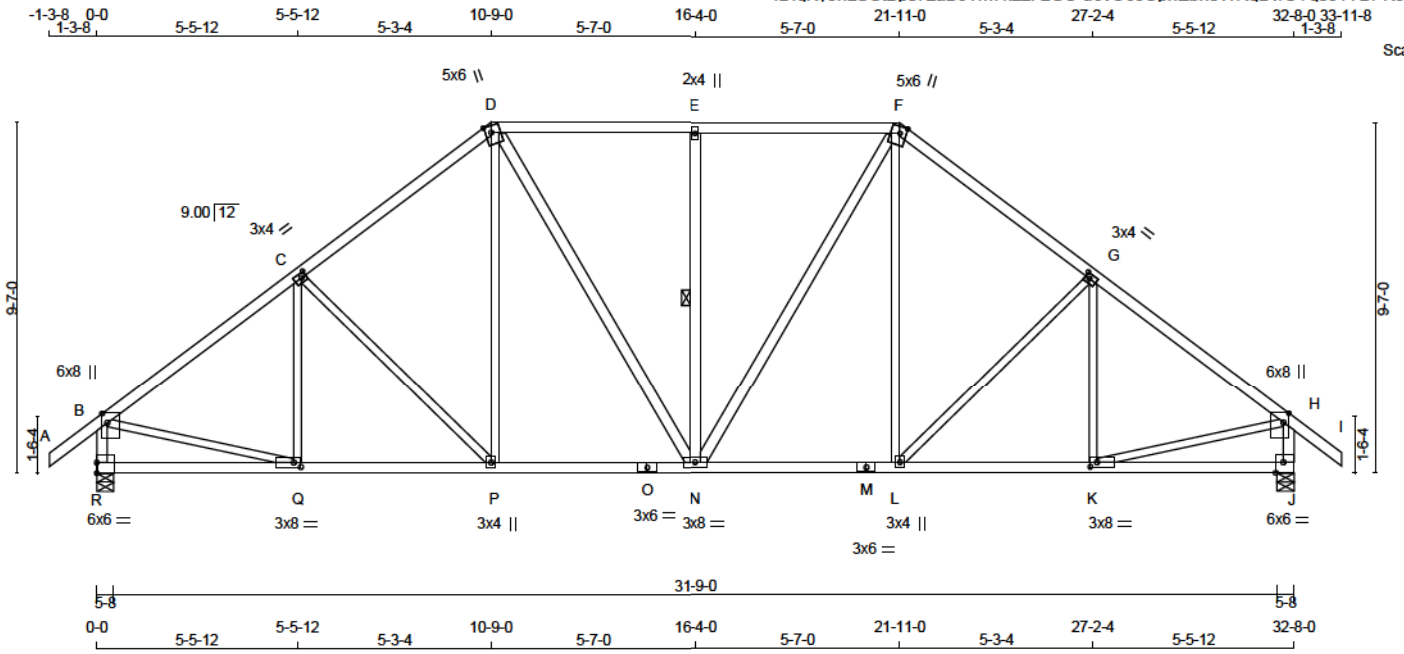

B1 S-P-F #2 2.000" X 10.000" 2-Ply - PASSED

Level: Level

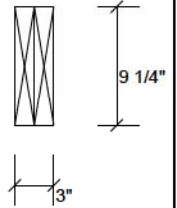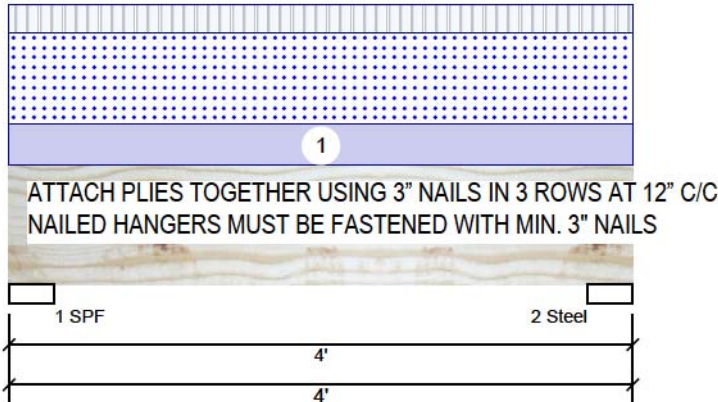

Member Information

Type:	Girder	Application:	Roof (Residential)
Plies:	2	Slope:	0/12
Moisture Condition:	Dry	Design Method:	LSD
Deflection LL:	360	Building Code:	NBCC 2015 / OBC 2012
Deflection TL:	360	Load Sharing:	No
Importance:	Normal - II	Deck:	Not Checked
		Vibration:	Not Checked

Unfactored Reactions UNPATTERNED lb (Uplift)

Brg	Live	Dead	Snow	Wind
1	270	393	893	0
2	270	393	893	0

Bearings and Factored Reactions

Bearing	Length	Cap.	React D/L lb	Total	Ld. Case	Ld. Comb.
1 - SPF	3.500"	33%	491 / 1609	2100	L	1.25D+1.5S +L
2 - Steel	3.500"	33%	491 / 1609	2100	L	1.25D+1.5S +L

Analysis Results

Analysis	Actual	Location	Allowed	Capacity	Comb.	Case
Moment	1646 ft-lb	2'	6039 ft-lb	0.273 (27%)	1.25D+1.5S +L	L
Unbraced	1646 ft-lb	2'	5667 ft-lb	0.291 (29%)	1.25D+1.5S +L	L
Shear	1860 lb	1'	3984 lb	0.467 (47%)	1.25D+1.5S +L	L
LL Defl inch	0.007 (L/6366)	2' 1/16"	0.118 (L/360)	0.060 (6%)	S+0.5L	L
TL Defl inch	0.009 (L/4607)	2' 1/16"	0.118 (L/360)	0.080 (8%)	D+S+0.5L	L

Design Notes

- Girders are designed to be supported on the bottom edge only.
- Multiple plies must be fastened together as per manufacturer's details.
- Top braced at bearings.
- Bottom braced at bearings.
- Lateral slenderness ratio based on single ply width.



ID	Load Type	Location	Trib Width	Side	Dead	Live	Snow	Wind	Comments
1	Uniform		12-10-0	Far Face	15.3 PSF	10.5 PSF	34.8 PSF	0 PSF	

READ ALL NOTES ON THIS PAGE AND ON ENGINEERING NOTE PAGE ENP-1. THIS NOTE PAGE IS AN INTEGRAL PART OF THIS DRAWING AS IT CONTAINS SPECIFICATIONS AND CRITERIA USED IN THE DESIGN OF THIS COMPONENT.



These plans have been reviewed for use with the corrections as noted. No other changes may be made without written approval of the Building Standards Branch. All work must comply with Zoning By-Law 2018-043, as amended, and the Ontario Building Code, as amended. These approved documents must be kept on site at all times. The building permit must be clearly posted on site at all times.

Kott Group
14 Anderson Blvd., On
L4A7X4
905-642-4400



This design is valid until 10/10/2023

Discipline	Reviewer	BCIN	Date
Building Code	H. Authier	43236	2021-02-03
Sewage System			
Zoning			



1) ENSURE TRUSS HAS BEEN DESIGNED WITH ADDITIONAL TOP CHORD DEAD LOAD EQUAL TO OR GREATER THAN WEIGHT OF SOLAR PANELS BEING INSTALLED

2) ATTACH SOLAR PANELS TO EACH TRUSS LOCATED UNDER THE SOLAR PANELS (I.E. @ 24" C/C PERPENDICULAR TO THE TRUSS DIRECTION)



3) ATTACH A SPF No.1/2 SCAB OF THE SAME SIZE AS TRUSS CHORD ON ONE SIDE ALONG THE FULL LENGTH OF THE MEMBER UNDER THE SOLAR PANELS USING 2 ROWS OF 3" WIRE NAILS @ 6" C/C

4) ATTACH SOLAR PANELS TO SCAB AT A MAXIMUM SPACING OF 48" C/C ALONG THE MEMBER (PARALLEL TO TRUSS DIRECTION) AS PER MANUFACTURER'S INSTRUCTIONS

5) DO NOT USE LAG SCREWS IN TRUSS MEMBERS. LAG SCREWS SHOULD ATTACH TO SCABS ONLY

6) MAXIMUM NUMBER OF SCAB SPLICES IS TWO

7) THIS DETAIL IS APPLICABLE TO PART 9 BUILDINGS ONLY

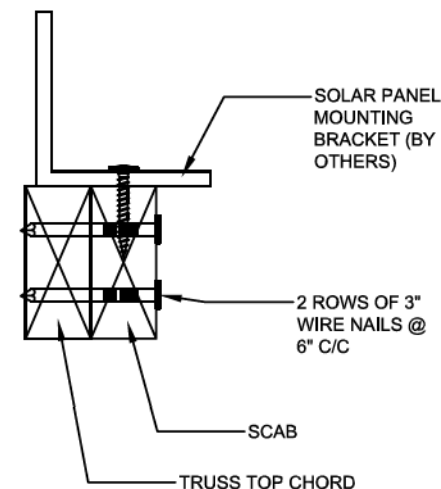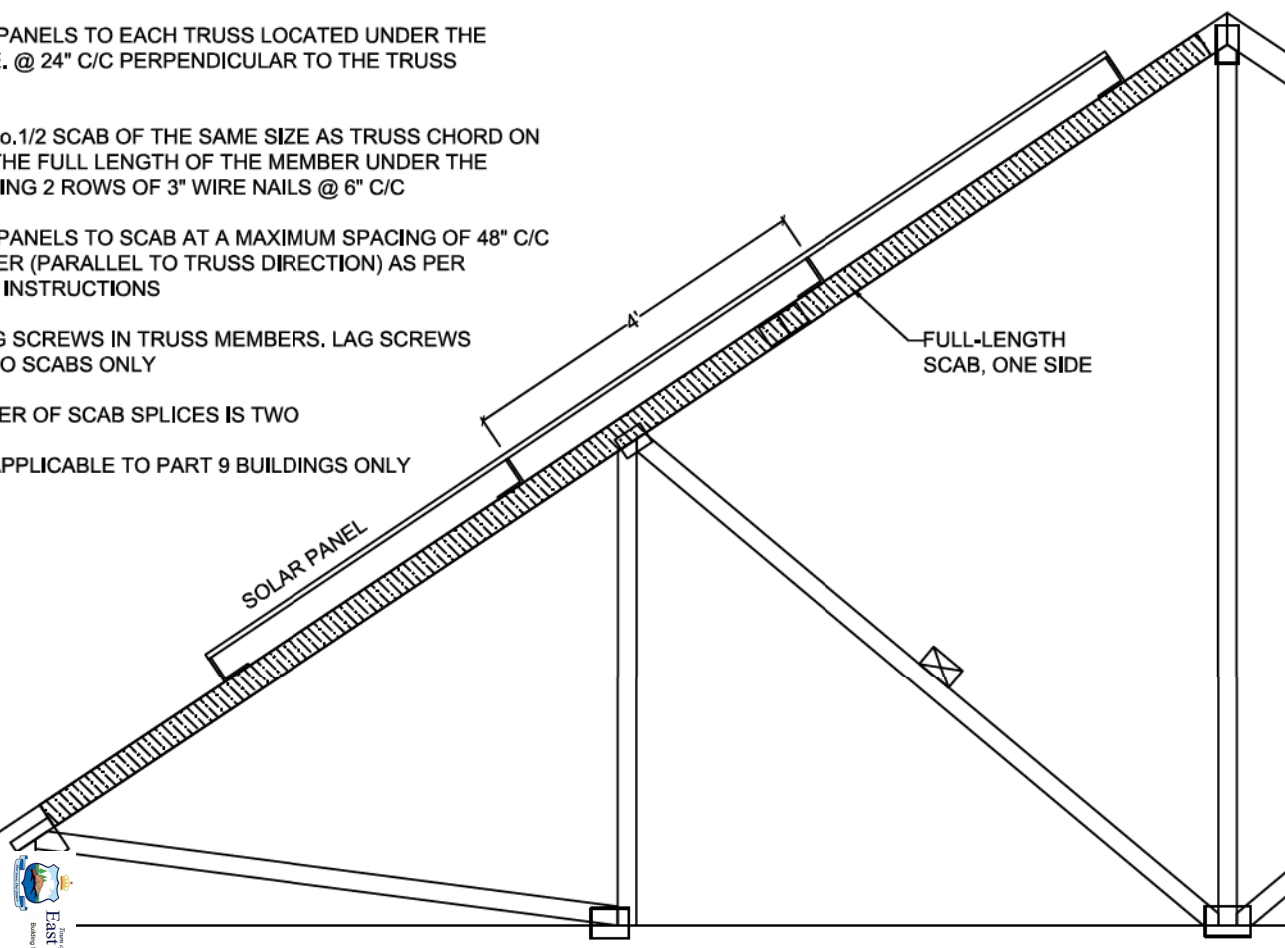




NE1220-133
GREENPARK - TRINAR
HALL - LOT 34

Detail for Installation of Solar Panels - Scab Method



NE1220-133
GREENPARK - TRINAR
HALL - LOT 34


BEARING ANCHORAGE BY TOE-NAILS FOR LATERAL CAPACITY

B97791H1


NAIL TYPE	LENGTH (IN)	DIAMETER (IN)	NAIL LATERAL CAPACITY (LB)	
			S-P-F	D. FIR
COMMON WIRE	3.00	0.144	132	147
	3.25	0.144	132	147
	3.50	0.160	159	177
COMMON SPIRAL	3.00	0.122	97	108
	3.25	0.122	97	108
	3.50	0.152	145	162

NOTES:

1. Rafter and ceiling members may be anchored to top and bottom chords of girder truss by toe-nailing rafter and ceiling members to girder chords provided the reaction does not exceed the lateral capacities in the table. Hangers (specified by others) are required for reactions higher than the maximum toe-nail capacity. Reactions are based on factored loads.
2. Toe nail capacities shown in the table are for **one** toe-nail. For additional toe-nails multiply values in table by the number of toe-nails used. Toe-nail capacities take into account toe-nailing factor J_A in CSA O86-14, section 12.9.4.1.
3. For 9- 3/4 gauge 3.25" common wire gun nails (diameter = 0.120") use 3" common spiral nail values.
4. Maximum number of toe-nails allowed depends on the lumber size & species to be toe-nailed to supporting member and nail diameter, as shown in tables below.
5. Nail values in table are based on the following relative lumber densities: G = 0.42 (SPF), G = 0.49 (D. Fir).
6. Toe-nails shall be driven at approximately 1/3 the nail length from the edge of the joist/truss chord and driven at an angle of 30° to the grain of the member (See next page for nailing on bearing plate).
7. For loads due to **wind** the nail lateral capacity in this table may be multiplied by 1.15 (K_D factor).
8. Lumber must be dry (< 19% moisture content) at the time of nail installation.
9. Nail values in this table comply with CSA O86-14, section 12.9.4
10. This design is not valid after March 31, 2021.

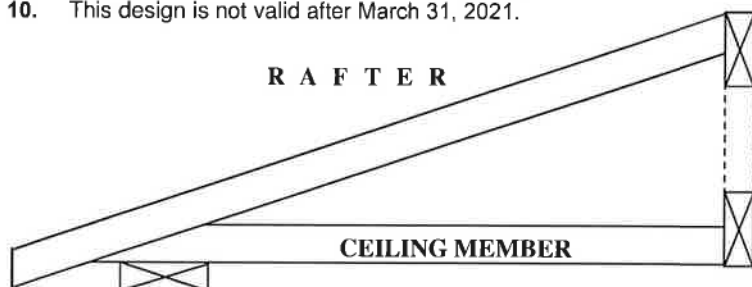

G
I
R
D
E
R

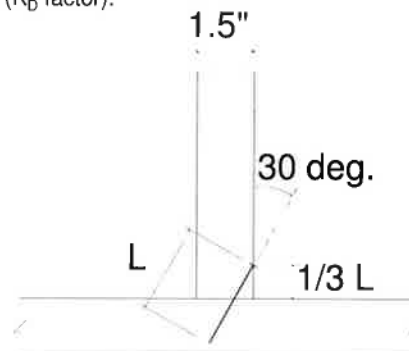

TOE-NAIL INSTALLATION

Nail type	Common wire	Common spiral	Common wire	Common spiral
Nail dia. (in)	0.160	0.152	0.144	0.122
	(3.5" nail)		(3" and 3.25" nail)	
LUMBER SIZE	MAXIMUM NUMBER OF TOE-NAILS			
2X4 SPF	2	2	3	3
2X4 D. Fir	2	2	2	2
2X6 SPF	4	4	4	5
2X6 D. Fir	3	3	3	4

MiTek

MiTek Canada Inc
100 Industrial Rd.
Bradford, Ontario L3Z 3G7




Town of
East Gwillimbury
Building Standards Branch BCN #1647

These plans have been reviewed for use with the corrections as noted. No other changes may be made without written approval of the Building Standards Branch. All work must comply with Zoning By-Law 2018-043, as amended, and the Ontario Building Code, as amended. These approved documents must be kept on site at all times. The building permit must be clearly posted on site at all times.

December 2,

Discipline	Reviewer	BCIN	Date
Building Code	H. Aufrer	43236	2021-02-03
Sewage System			
Zoning			

PEO
Certificate No. 10889485

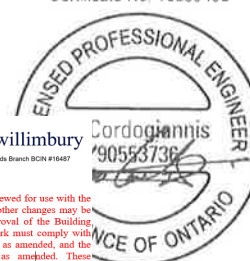

BEARING ANCHORAGE BY TOE-NAILS FOR WIND LOADING

B97791H2



NAIL TYPE	LENGTH (IN)	DIAMETER (IN)	NAIL WITHDRAWAL CAPACITY (LB)	
			S-P-F	D. FIR
COMMON WIRE	3.00	0.144	30	42
	3.25	0.144	32	45
	3.50	0.160	38	52
COMMON SPIRAL	3.00	0.122	26	36
	3.25	0.122	28	40
	3.50	0.152	36	50

Note: If using truss with D. Fir lumber and S-P-F bearing plate, use values in table for S-P-F.



NOTES:

1. Truss chord, rafter, or ceiling members may be anchored to bearing plate by toe-nails, provided that the actual factored uplift force due to **wind** or **earthquake** load does not exceed the withdrawal capacities in the table. Hangers (specified by others) are required for uplift forces that are higher than the maximum toe-nail withdrawal capacity.
2. Toe nail capacities shown in the table are for **one** toe-nail. For additional toe-nails multiply values in table by the number of toe-nails used. Toe-nail capacities take into account toe-nailing factor J_A in CSA O86-14, section 12.9.5.2.
3. For 9- 3/4 gauge 3.25" common wire gun nails (diameter = 0.120") use 3" common spiral nail values.
4. Maximum number of toe-nails allowed depends on the lumber size & species to be toe-nailed to supporting member and nail diameter, as shown in table above.
5. Nail values in table are based on the following relative lumber densities: $G = 0.42$ (SPF), $G = 0.49$ (D. Fir).
6. Toe-nails shall be driven at approximately 1/3 the nail length from the edge of the joist/truss chord and driven at an angle of 30° to the grain of the member (See drawing on detail B37579H1).
7. Lumber must be dry (< 19% moisture content) at the time of nail installation.
8. Nail values in this table comply with CSA O86-14, section 12.9.5
9. This design is not valid after March 31, 2021.

Toe-nailing on 2x6 Bearing Plate

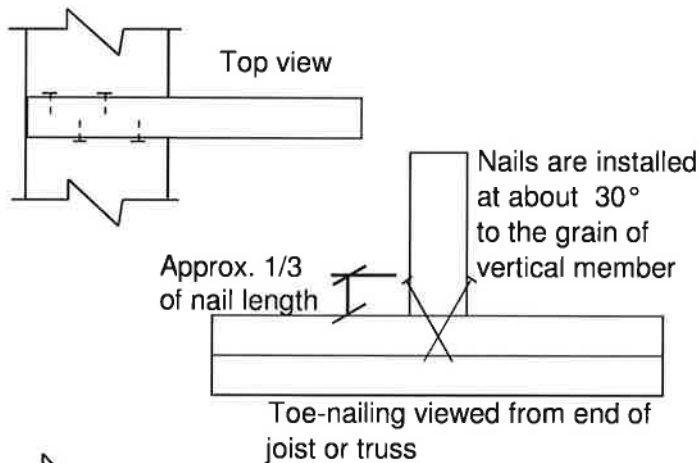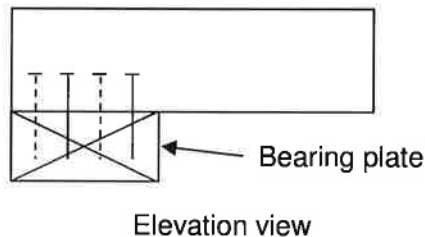

Toe-nailing on 2x4 Bearing Plate

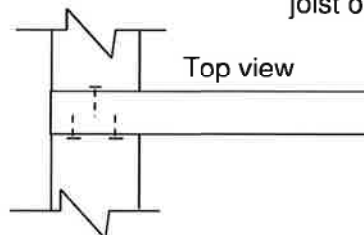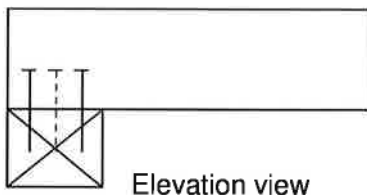

MiTek

MiTek Canada Inc
100 Industrial Rd.
Bradford, Ontario L3Z 3G7



Decel

These plans have been reviewed for use with the corrections as noted. No other changes may be made without written approval of the Building Standards Branch. All work must comply with Zoning By-Law 2018-043, as amended, and the Ontario Building Code, as amended. These approved documents must be kept on site at all times. The building permit must be clearly posted on site at all times.

Discipline	Reviewer	BCIN	Date
Building Code	H. Authier	43236	2021-02-03
Sewage System			
Zoning			