


REC'D BY _____ DATE _____
REF'D TO _____ DATE _____

**This stamp certifies compliance with the applicable
Design Guidelines only and bears no further
professional responsibility.**

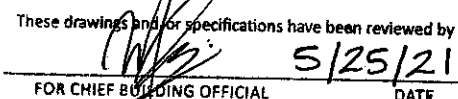

These drawings are to be read in conjunction with municipal approved site engineering drawings prepared by Metropolitan Consulting Inc.

north arrow



data: SEPT. 2020 LOT SITING/GRADING drawing no. 1

drawn by	checked by	scale	file name
GW	--	1:250	19014-RG3-SITE-LAYOUTS

GW: H:\ARCHIVE\WORKING\2019\19014\RG3SITE PLANS\19014-RG3-SITE-LAYOUTS.dwg -- Mod: 04-26-2020 -- 9:39 AM

