Greenpark.

_	CONG	STRUCTION SUMMARY	7		
				_	
PUDCHASEDS, Vhughha D		eights 3 (G) - Russell Gardens Bui	llding Lto	1.	
T UKCHASEKS: Kilushou K	ushabh SHETH and Rushabh I	P. SHETH			TEL:
LOT / PHASE	REG. PLAN #	HOUSE TYPE			
391 / 4	62M-1266	Valleycreek Four A Elev 3			
CONSTRUCTION			Naconal de la constitución de la		
	WINDOWS (MAY REQUIRE	WINDOW WELLS) - WINDOW IS 30 IN	CHES X 2	4 INCHES	
26May21 Note:					
ELECTRICAL					
1 - 200 AMP ELECTRICAL S	SERVICE				
26May21 Note:					
PLUMBING					
3 - TOE TESTER - ADD TOE	TESTER TO SHOWER				
26May21 Note:	The state of the s				
•					
PROMOTIONAL					
1 - LESS CREDIT FROM PUR	RCHASER EXTRA SHEET II	N OFFER			
26May21 Note: NEW PROMO BALANCE \$7210.00					
8					
	EXT	RAS AS PER OFFER			
(1) The West leaves 1		· · · · · · · · · · · · · · · · · · ·			
(1) The Vendor agrees that i	led in Schedule GP to the A	erm or provision in this Agreement includerement of Purchase and Sale, the Pu	uded in the	e Purchase Price and	l in
Worksheet Note:	led in Schedule of to the A	agreement of Furchase and Sale, the Fu	renaser is	entitied to a credit o	1
PURCHASER(S) ACKNOW	WLEDGES THAT THE PU	RCHASE PRICE IS INCLUSIVE OF	ALL CRE	DITS AND	
PROMOTIONAL PACKAC	SES AVAILABLE AT TIM	E OF PURCHASE.			
Worksheet Note:					
Granite kitchen counter top,	from Vendor?s standard sa	mples			
Worksheet Note:					

This Document is Extremely Time Sensitive - Printed <u>26 May 21</u> at <u>11:22</u>

CONSTRUCTION SUMMARY
PRELIMINARY: DATE JUN 2 5 2021
FINAL: DATE

VALLEYCREEK FOUR A








ELEVATION 2 · 2,818 sq.ft.



ELEVATION 3 • 2,819 sq.ft.

Orientation of home may be reversed and purchaser agrees to accept same. Steps and purches may vary at any extensor entrance ways due to grading variance. Actual usable floor space may vary from the staced floor areas. All renderings are artist's concept. Dimensions, specifications and architectural detailing subject to modifications. Rentline and adjoining model types may vary due to stone, E. A.O.F. May 2021

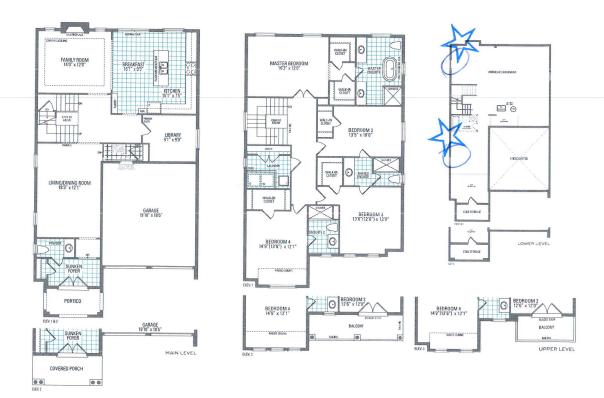

VALLEYCREEK FOUR A ELEV. 1 · 2,827 sq.ft. | ELEV. 2 · 2,818 sq.ft. | ELEV. 3 · 2,819 sq.ft. | Include 10 sq.ft. of open area.

Onestation of home may be reversed and purchaser agrees to accept same. Steps and porches may vary at any exterior entrance ways due to grading variance. Actual usable floor space may vary from the stated floor areas. All renderings are antial's concept, Dimensions, specifications and architectural detailing publict to modifications. Rendline and adjoining model types may vary due to stone, E. & O.E. May 2001