

BASEMENT INSULATION AT
STAIR/SUNKEN AREAS
-2" (R10) CONTINUOUS INSULATION
(RIGID OR SPRAY FOAM).
-2"x4" @ 16"o.c. w/ R12 BATT
INSULATION & 1/2" DRYWALL FINISH
-EXTEND EXTERIOR WALL FOOTING TO
SUPPORT 2"x4" WALL WHERE LOAD
BEARING.

CITY OF HAMILTON
Building Division
21-107131
Permit No. _____
DATE AVAILABLE ON SITE _____

Permit No. 21

THESE STAMPED DRAWINGS SHALL BE AVAILABLE ON SITE

0° 5'-0"


THE OWNER AND/OR CONTRACTOR SHALL COMPLY WITH
THE ONTARIO BUILDING CODE AND ALL OTHER APPLICABLE LAW

These drawings and/or specifications have been reviewed by

[Signature] JUN 22 2021

DATE

FOR CHIEF BUILDING OFFICIAL

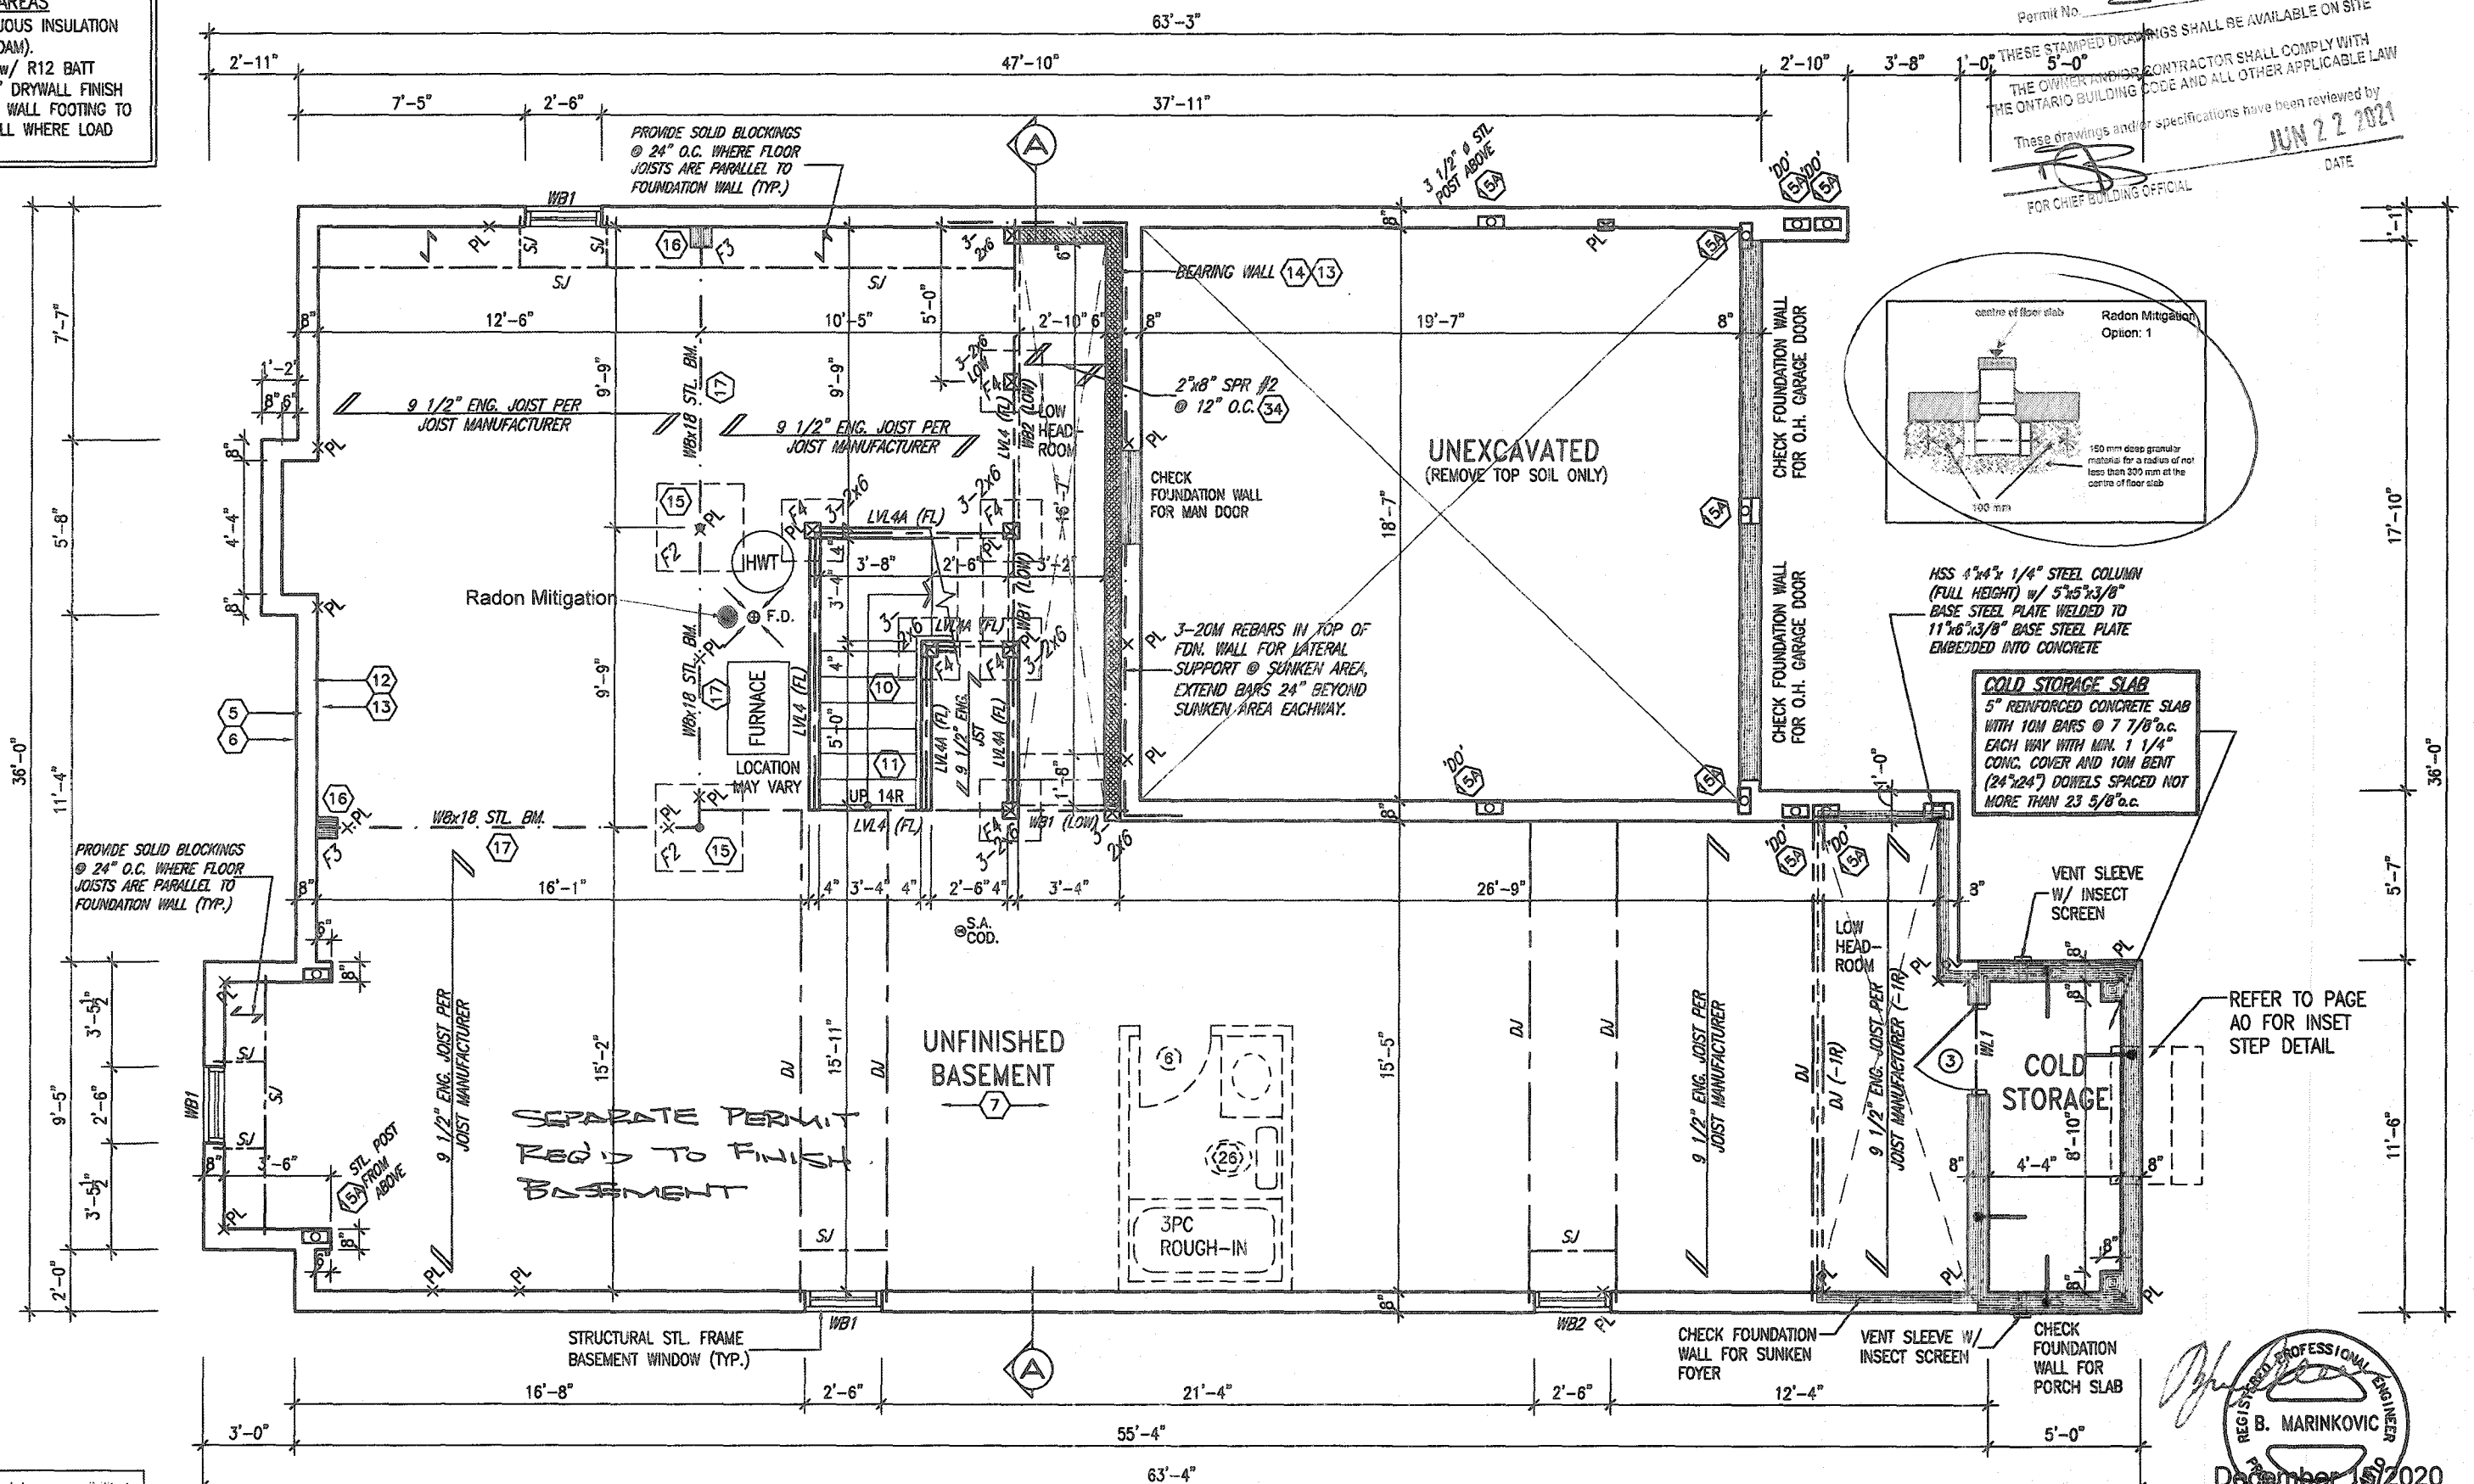

It is the builder's complete responsibility to ensure that all plans submitted for approval fully comply with the Architectural Guidelines and all applicable regulations and requirements including zoning provisions and any provisions in the subdivision agreement. The Control Architect is not responsible in any way for examining or approving site (lotting) plans or working drawings with respect to any zoning or building code or permit matter or that any house can be properly built or located on its lot.

This is to certify that these plans comply with the applicable Architectural Design Guidelines approved by the City of HAMILTON

JOHN C. WILLIAMS LTD., ARCHITECT
ARCHITECTURAL CONTROL REVIEW
AND APPROVAL

APPROVED BY: 

DATE: JAN 28, 2021

This stamp certifies compliance with the applicable
Design Guidelines only and bears no further
professional responsibility.



 December 15, 2020

STRUDET INC.
FOR STRUCTURE ONLY

MOUNTAINASH 6-316
COMPLIANCE PACKAGE 'A1'

MOUNTAINASH 6
13.5m

BASEMENT PLAN - ELEV. '3'

1b

18	
----	--	--	

VA3
DESIGN
255 Consumers Rd Suite 120
Toronto ON M2J 1R4
t 416.630.2255 f 416.630.4782
va3design.com

 Greenpark™	
project name RUSSELL GARDENS PH. 3	municipality HAMILTON, ONTARIO
date JAN 2020	BASEMENT PLAN
drawn by BD/EIM	checked by scale 3/16" = 1'-0"


MOUNTAINASH 6	
13.5m	
project no. 19014	
LAN - ELEV. '3'	drawing no.
file name 4-MOUNTAINASH-6-316	A1b

All drawings, specifications, related documents and design are the copyright property of VAS DESIGN. Reproduction of this property in whole or in part is strictly prohibited without VAS DESIGN's written permission.

3409 SF.



STRUDET INC.
FOR STRUCTURE ONLY

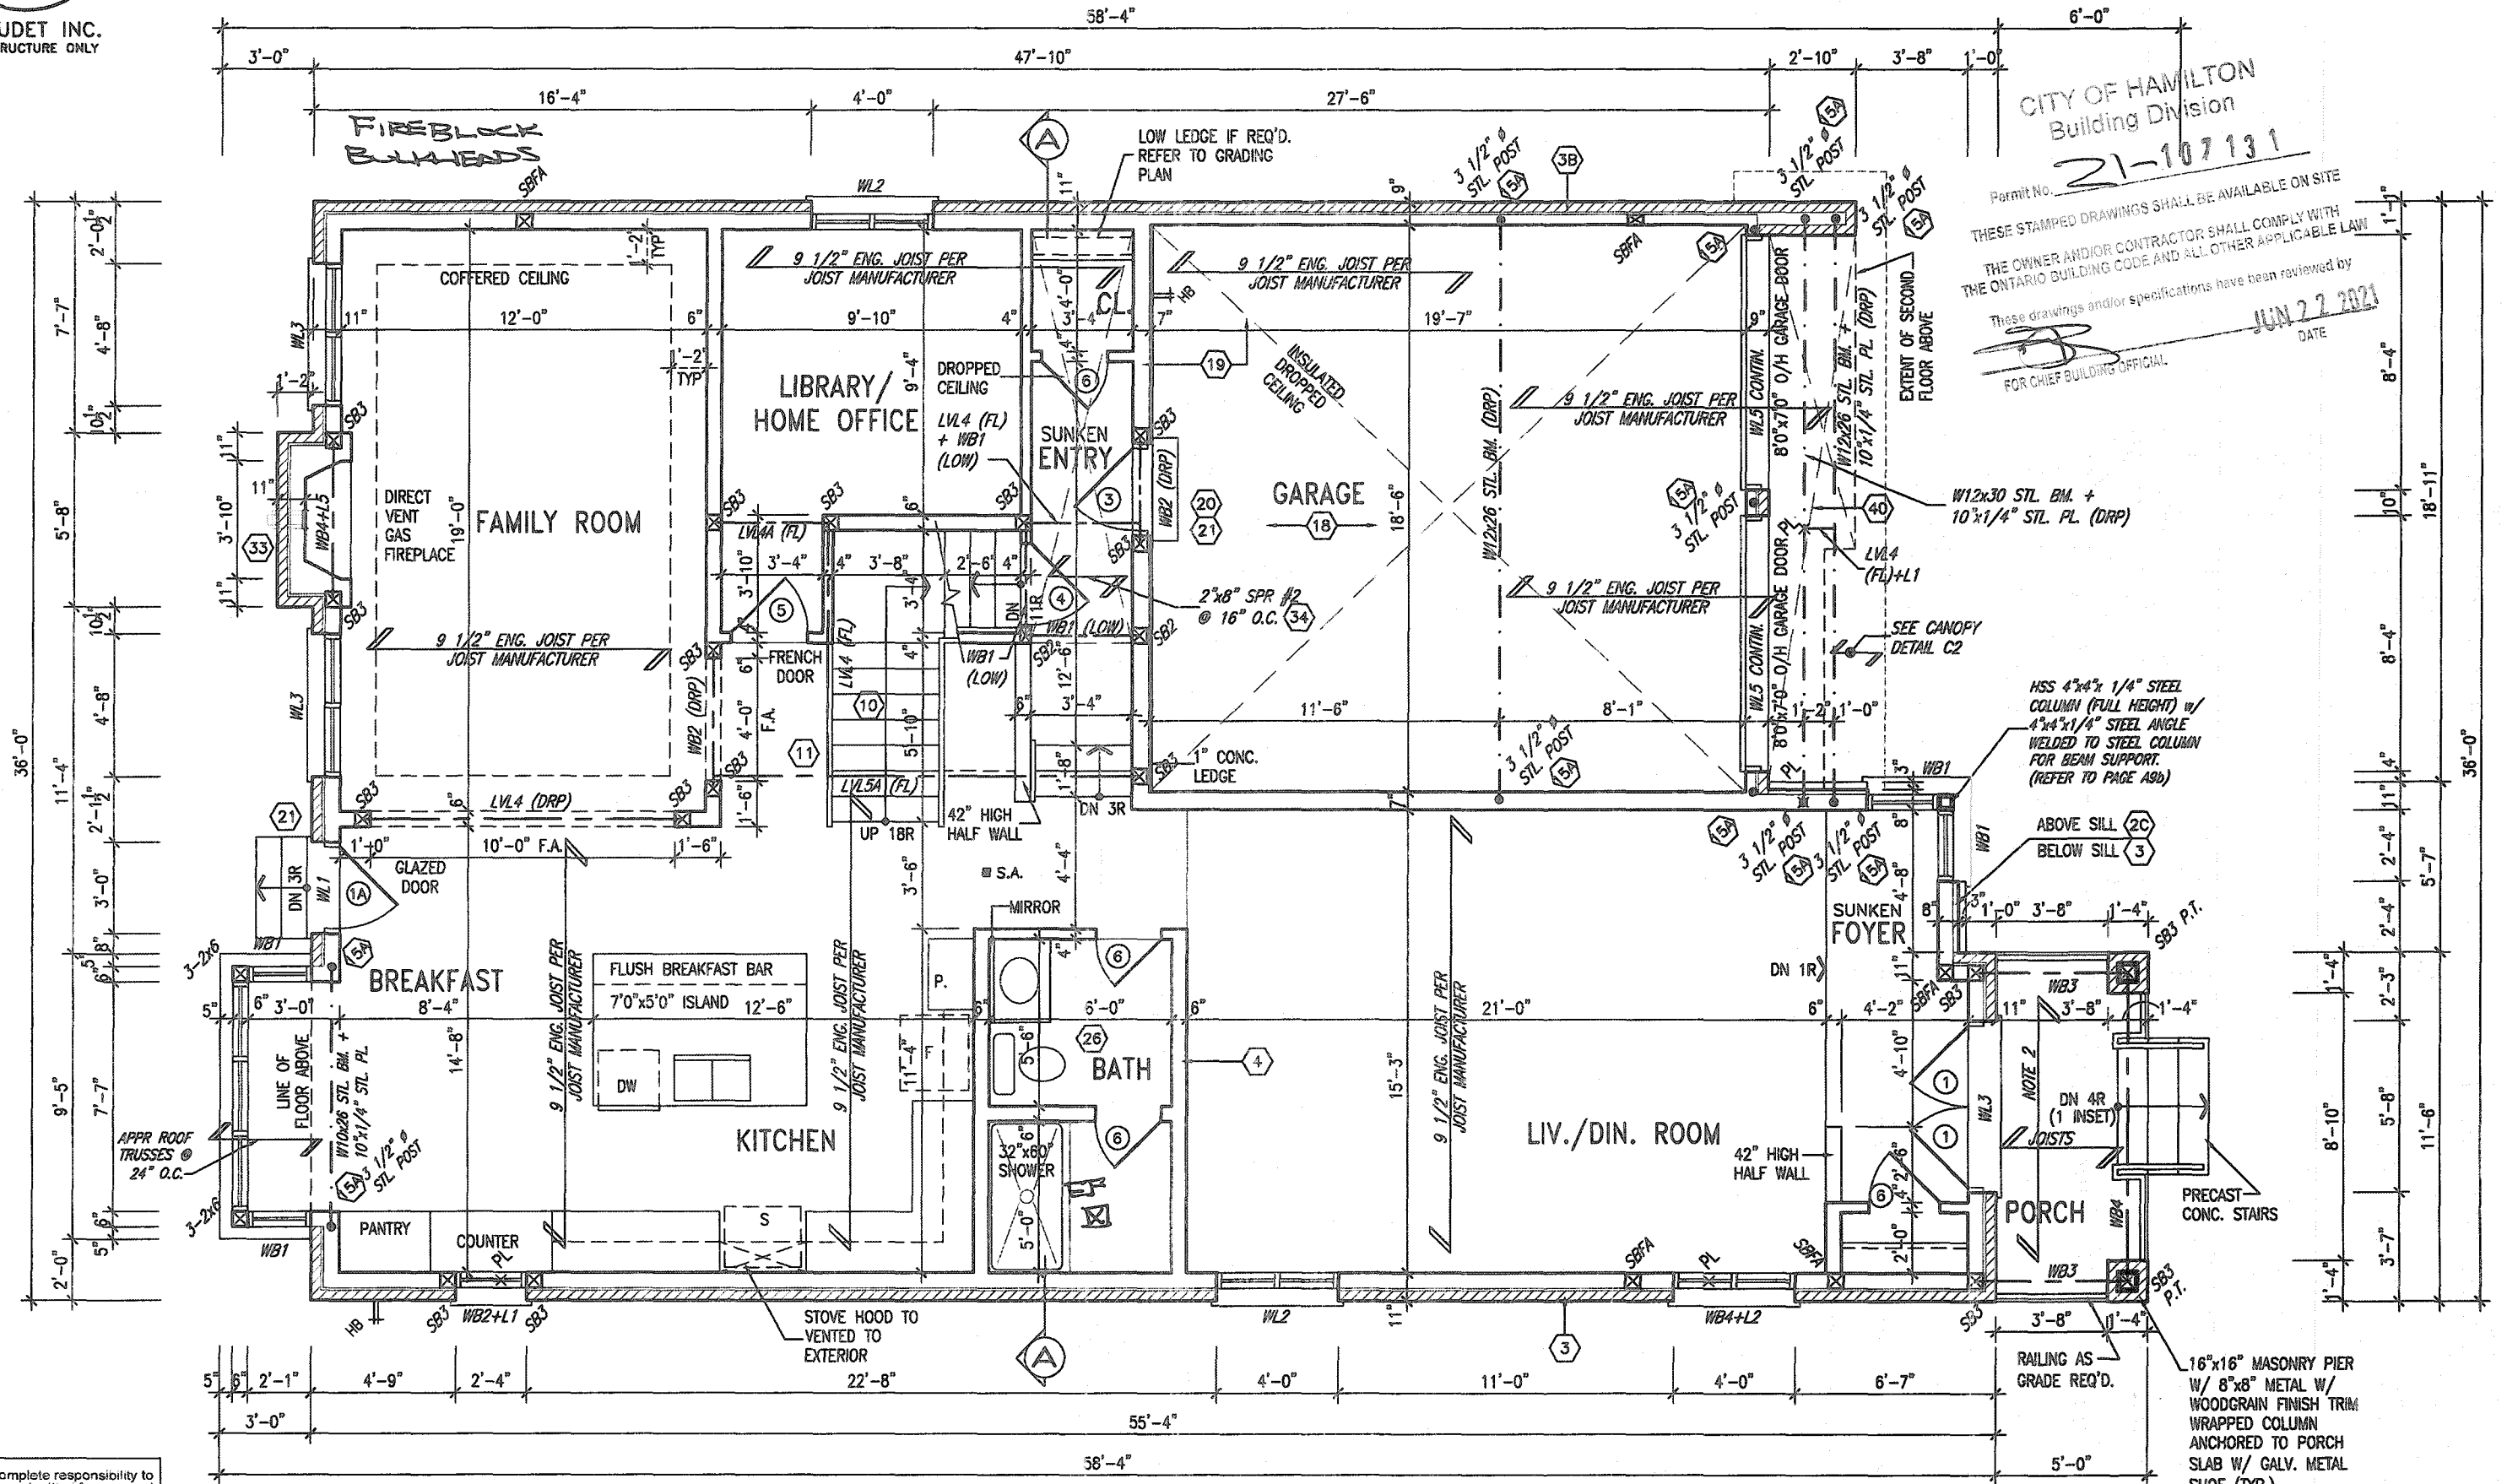

GROUND FLOOR PLAN - ELEV. '3'

It is the builder's complete responsibility to ensure that all plans submitted for approval fully comply with the Architectural Guidelines and all applicable regulations and requirements including zoning provisions and any provisions in the subdivision agreement. The Control Architect is not responsible in any way for examining or approving site (lotting) plans or working drawings with respect to any zoning or building code or permit matter or that any house can be properly built or located on its lot.

This is to certify that these plans comply with the applicable Architectural Design Guidelines approved by the City of Hamilton.

JOHN G. WILLIAMS LTD., ARCHITECT
ARCHITECTURAL CONTROL REVIEW
AND APPROVAL
This stamp certifies compliance with the applicable Design Guidelines only and does not bear any further professional responsibility.

OUTDOOR AIR INTAKE SEPARATION
ALL OUTDOOR AIR INTAKE VENTS TO BE SEPARATED A MINIMUM DISTANCE FROM SOURCES OF CONTAMINATION PER CBC, DIV. 8 - TABLE 6.2.3.12.
• KITCHEN EXHAUST. 3.0m
• DRIVEWAY, PARKING SPACE, ROAD. 1.5m
• SOLID FUEL APPLIANCE EXHAUST. 3.0m

NOTE 2: BALCONY OVER PORCH
2"x8" @ 16" O.C. P.T. W/ 2"x4" @ 12" O.C. DIAGONALLY CUT CROSS PURLINS W/ 5/8" EXTERIOR GRADE SHEATHING W/ SINGLE PLY ROOF MEMBRANE

MOUNTAINASH 6-316

COMPLIANCE PACKAGE 'A1'

Greenpark.

MOUNTAINASH 6
13.5m

18		9			
17		8			
16		7			
15		6	REVISED REAR BOX BAY PER CLIENT.	DEC. 15/20	WT
14		5	CUSTOM DRAWING FOR PURCHASER REQUEST.	AUG. 27/20	DB
13		4	STAIRWAY WIDTH CORRECTED.	AUG. 05/20	GW
12		3	ISSUED FOR PERMIT.	APR. 13/20	GW
11		2	UPDATED PER ENG & CLIENT COMMENTS.	MAR. 24/20	GW
10		1	PRELIMINARY. ISSUED FOR CLIENT REVIEW.	JAN. 28/20	GW
no.	description	date	by	no.	description

This undersigned has reviewed and takes responsibility for this design and has the qualifications and meets the requirements set out in the Ontario Building Code to be a Designer.
Richard Vink
signature
2446B
BOB
4265B
V3 DESIGN INC.
255 Consumers Rd Suite 120
Toronto ON M2J 1R4
416.630.2255 f 416.630.4782
va3design.com

V3 DESIGN

project name
RUSSELL GARDENS PH. 3

location
HAMILTON, ONTARIO

drawing no.
GROUND FLOOR PLAN - ELEV. '3'

project no.
19014

date
JAN 2020

checked by
BD.BIM

scale
3/16" = 1'-0"


title name
19014-MOUNTAINASH-6-316

drawing no.
A2b

All drawings, specifications, related documents and design are the copyright property of VAS DESIGN. Reproduction of this property in whole or in part is strictly prohibited without VAS DESIGN's written permission.

CITY OF HAMILTON
Building Division
1007121

These drawings and/or specifications have been approved by the undersigned:

 
 _____

FOR CHIEF BUILDING OFFICIAL: 

DATE: JUN 22 2021

 Greenpark.		MOUNTAINASH 6 13.5m
project name RUSSELL GARDENS PH. 3	municipality HAMILTON, ONTARIO	project no. 19014
date JAN 2020	OPT. SECOND FLOOR PLAN (5 BDRM) - ELEV. '3'	
drawing by B.G.BIM	checked by -	scale 3/16" = 1'-0"
file name 19014-MOUNTAINASH-6-316		drawing no. A3b

All drawings specifications, related documents and design are the copyright property of VA3 DESIGN. Reproduction of this property in whole or in part is strictly prohibited without VA3 DESIGN's written permission.

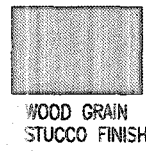

CITY OF HAMILTON
Building Division
107131

Building Division

Permit No. 21-107131


THESE STAMPED DRAWINGS SHALL BE AVAILABLE ON SITE

THE OWNER AND/OR CONTRACTOR SHALL COMPLY WITH
THE ONTARIO BUILDING CODE AND ALL OTHER APPLICABLE LAW

These drawings and/or specifications have been reviewed by

[Signature] JUN 22 2021

FOR CHIEF BUILDING OFFICIAL DATE

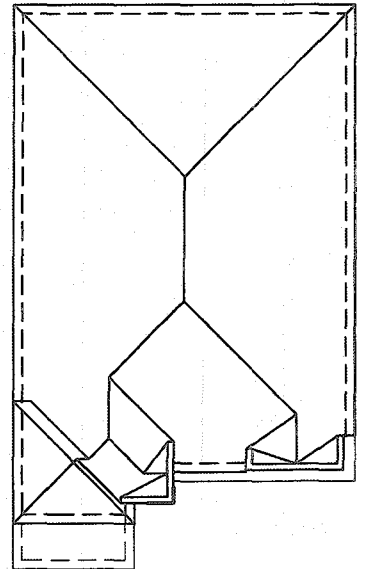

ROOF PLAN-3



FRONT ELEVATION - ELEV. '3'

PORCH STEPS (TYP.)
PRECAST CONCRETE STEPS
w/ MASONRY INSERTS WHERE
GRADE REQUIRES.

MOUNTAINASH 6-316
COMPLIANCE PACKAGE 'A1'

It is the builder's complete responsibility to ensure that all plans submitted for approval fully comply with the Architectural Guidelines and all applicable regulations and requirements including zoning provisions and any provisions in the subdivision agreement. The Control Architect is not responsible in any way for examining or approving site (lotting) plans or working drawings with respect to any zoning or building code or permit matter or that any house can be properly built or located on its lot.

This is to certify that these plans comply
with the applicable Architectural Design
Guidelines approved by the City of
HAMILTON

EXTERIOR RAILINGS:
3'-6" HIGH RAILING IF LANDING IS MORE
THAN 5'-11" ABOVE FINISHED GRADE
AND 3'-0" HIGH RAILING WHEN LANDING
IS LESS THAN 5'-11" ABOVE ADJACENT
FINISHED GRADE.

18				9				The undersigned has reviewed and takes responsibility for this design and has the qualifications and meets the requirements set out in the Ontario Building Code to be a Designer.
17				8				
16				7				qualification information
15				6	REVISED REAR BOX BAY PER CLIENT.	DEC. 15/20	WT	Richard Mink <i>R Mink</i> 2440
14				5	CUSTOM DRAWING FOR PURCHASER REQUEST.	AUG. 27/20	DB	none signature BC
13				4	STAIRWAY WIDTH CORRECTED.	AUG. 05/20	GW	registration information VAS Design Inc. 4265
12				3	ISSUED FOR PERMIT.	APR 13/20	GW	
11				2	UPDATED PER ENG & CLIENT COMMENTS	MAR 24/20	GW	Contractor must verify all dimensions on the job and report any discrepancy to the Designer before proceeding with the work. All drawings and specifications are instruments of service and the property of the Designer which must be returned at the completion of the work. Drawings are not to be scaled.
10				1	PRELIMINARY. ISSUED FOR CLIENT REVIEW.	JAN. 28/20	GW	
no. description		date		by	no. description	date		by

The undersigned has reviewed and takes responsibility for this design and has the qualifications and meets the requirements set out in the Ontario Building Code to be a Designer.	
qualification information	
Richard Vink	2448
name	BC
signature information	
VA3 Design Inc.	4263
Contractor must verify all dimensions on the job and report any discrepancy to the Designer before proceeding with the work. All drawings and specifications are instruments of service and the property of the Designer which must be returned at the completion of the work. Drawings are not to be copied.	

VA3
DESIGN

255 Consumers Rd Suite 120
Toronto ON M2J 1R4
t 416.630.2255 f 416.630.478
va3design.com

MOUNTAINASH 6
13.5m


project name RUSSELL GARDENS PH. 3	municipality HAMILTON, ONTARIO	project no. 19014
date JAN 2020		drawing no. A4b
description FRONT ELEVATION - ELEV. '3'		
drawn by B.D.M.	checked by -	scale 3/16" = 1'-0"
file name 19014-MOUNTAINASH-6-316		

All drawings specifications, related documents and design are the copyright property of VA3 DESIGN. Reproduction of this property in whole or in part is strictly prohibited without VA3 DESIGN's written permission.

All drawings, specifications, related documents and design are the copyright property of VAS DESIGN. Reproduction of this property in whole or in part is strictly prohibited without VAS DESIGN's written permission.

3409 SF.

1'-0" CITY OF HAMILTON
Building Division
Permit No. 21-107131
THESE STAMPED DRAWINGS SHALL BE AVAILABLE ON SITE
THE OWNER AND/OR CONTRACTOR SHALL COMPLY WITH
THE ONTARIO BUILDING CODE AND ALL OTHER APPLICABLE LAW
These drawings and/or specifications have been reviewed by
FOR CHIEF BUILDING OFFICIAL
DATE JUN 22 2021

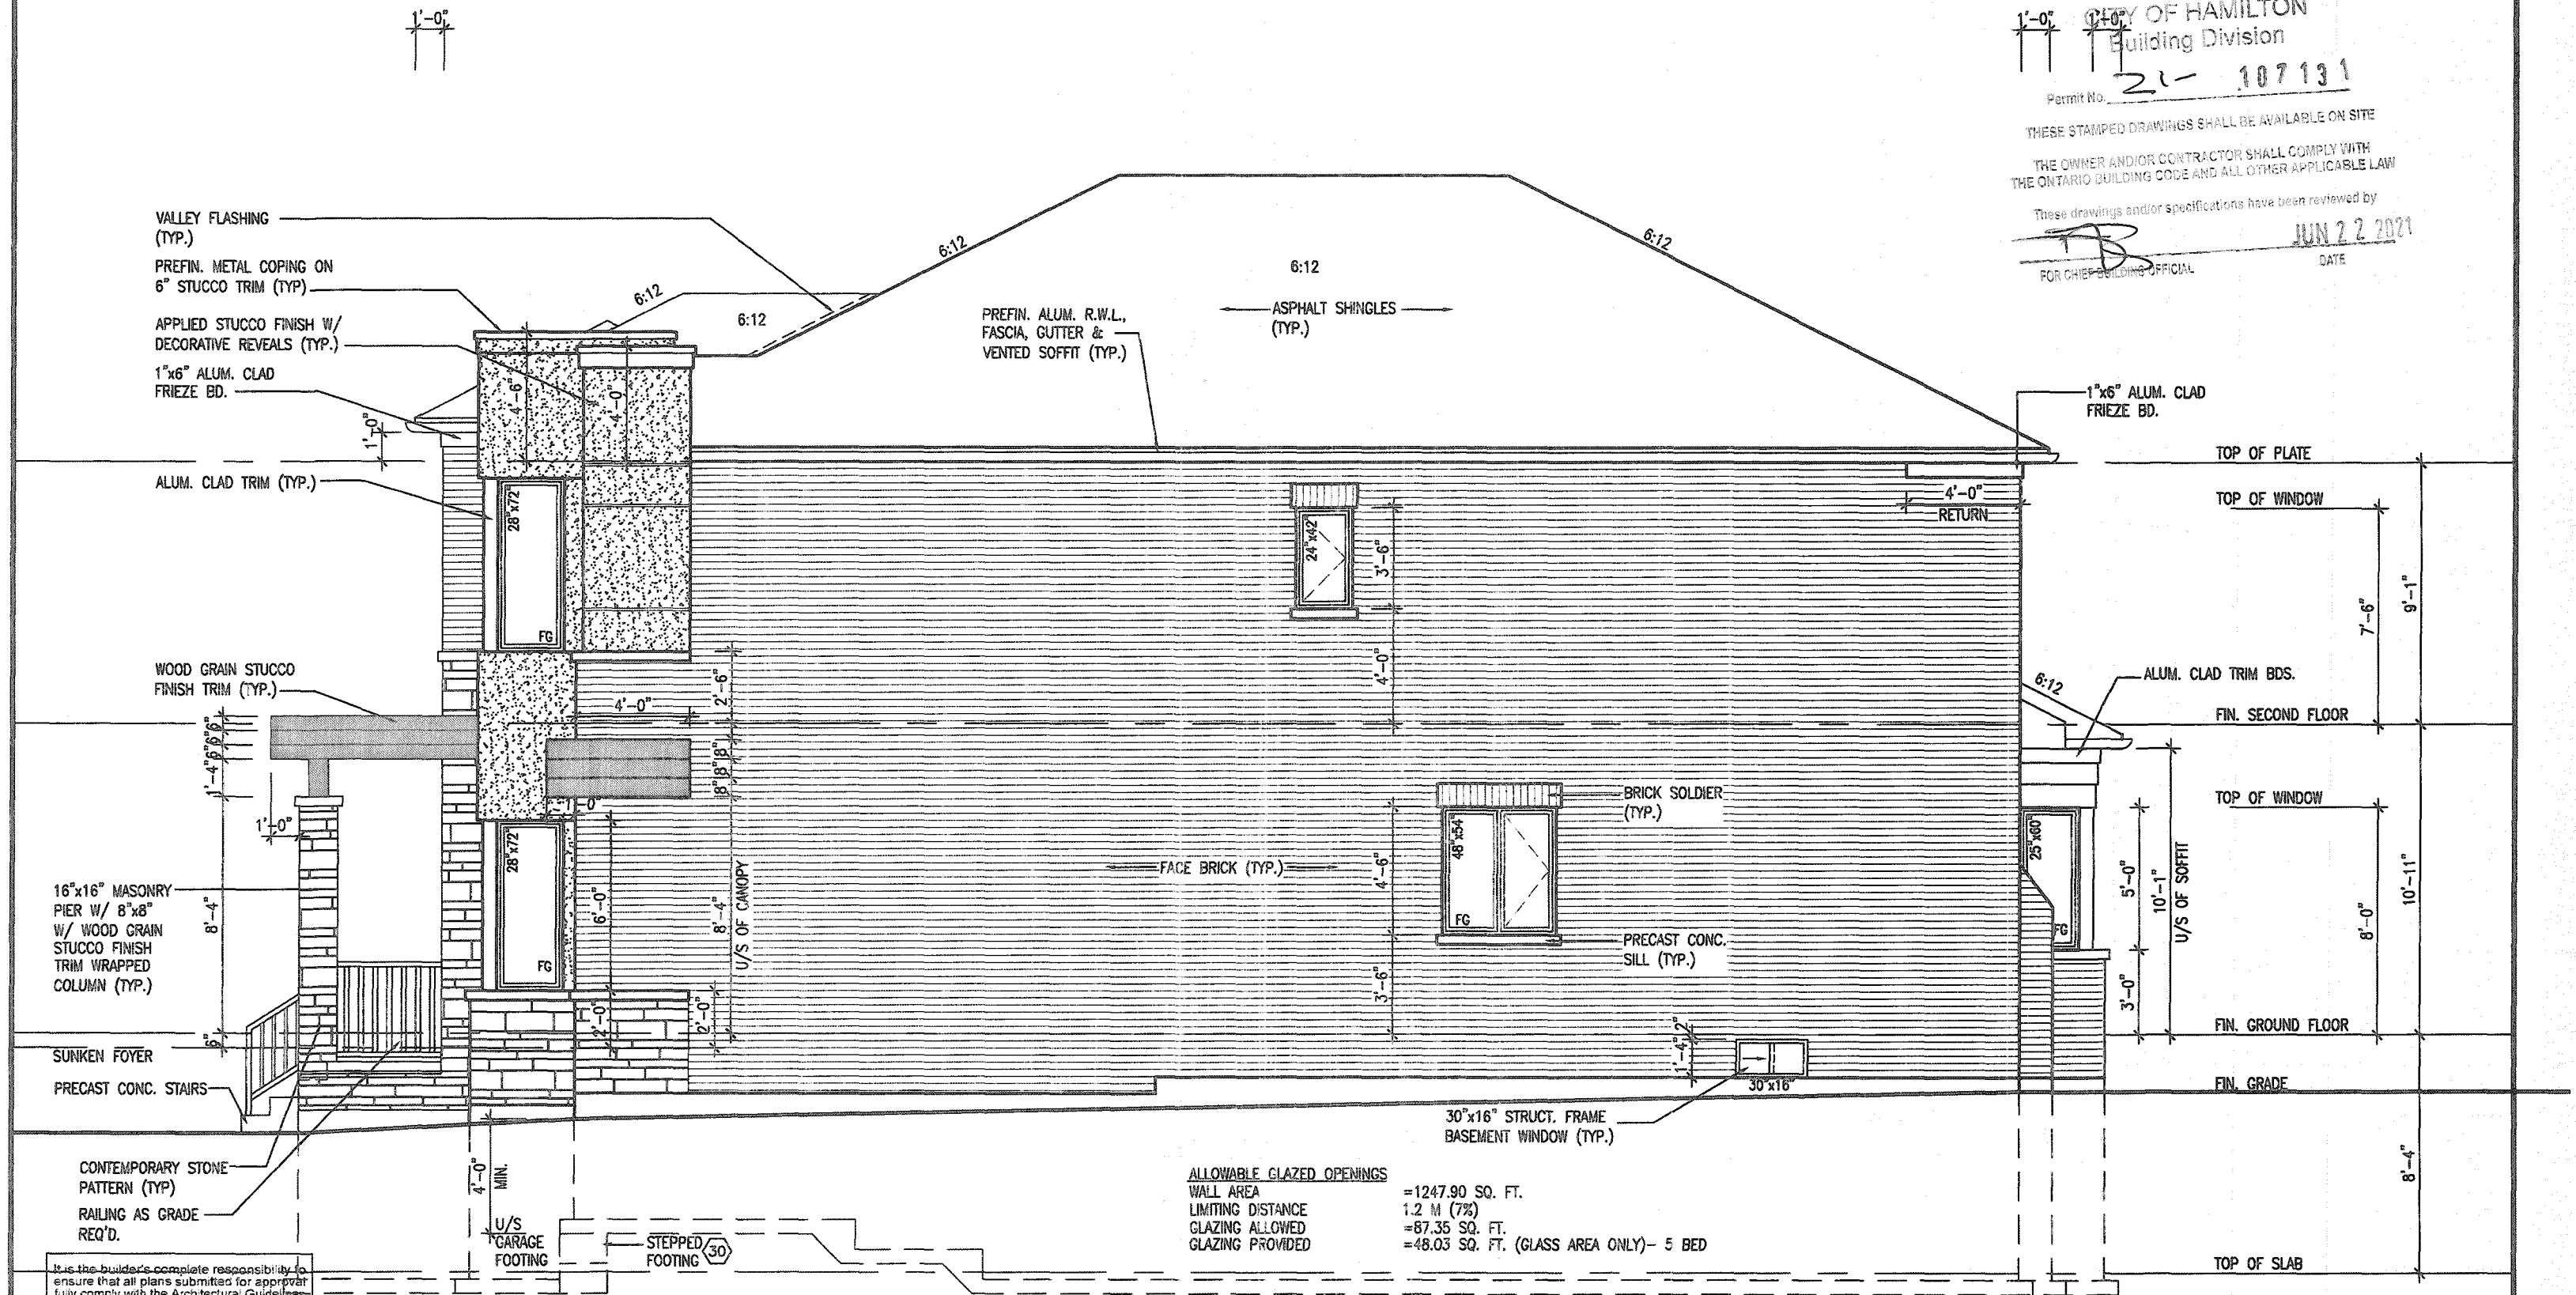

RIGHT SIDE ELEVATION -
ELEV '3' OPT. 5 BED

MOUNTAINASH 6-316
COMPLIANCE PACKAGE 'A1'

It is the builder's complete responsibility to ensure that all plans submitted for approval fully comply with the Architectural Guidelines and all applicable regulations and requirements including zoning provisions and any provisions in the subdivision agreement. The Control Architect is not responsible in any way for examining or approving site (lotting) plans or working drawings with respect to any zoning or building code or permit matter or that any house can be properly built or located on its lot.

This is to certify that these plans comply with the applicable Architectural Design Guidelines approved by the City of HAMILTON

JOHN G. WILLIAMS LTD., ARCHITECT
ARCHITECTURAL CONTROL REVIEW
AND APPROVAL
APPROVED BY
DATE JAN 28 2021
This stamp certifies compliance with the applicable Design Guidelines only and bears no further professional responsibility

18			9				
17			8				
16			7				
15			6	REVISED REAR BOX BAY PER CLIENT.	DEC. 15/20	WT	
14			5	CUSTOM DRAWING FOR PURCHASER REQUEST.	AUG. 27/20	DB	
13			4	STAIRWAY WIDTH CORRECTED.	AUG. 05/20	GW	
12			3	ISSUED FOR PERMIT.	APR 13/20	GW	
11			2	UPDATED PER ENG & CLIENT COMMENTS	MAR 24/20	GW	
10			1	PRELIMINARY, ISSUED FOR CLIENT REVIEW.	JAN. 28/20	GW	
no. description		date	by	no. description	date	by	

The undersigned has reviewed and takes responsibility for this design and that the qualifications and meet the requirements set out in the Ontario Building Code to be a Designer.
qualification information
Richard Vink 24488
name
signature
VA3 Design Inc. 42858
registration information
Contractor must verify all dimensions on the job and report any discrepancy to the Designer before proceeding with the work. All drawings and specifications are instruments of service and the property of the Designer which must be returned at the completion of the work. Drawings are not to be scaled.

VA3
DESIGN
255 Consumers Rd Suite 120
Toronto ON M2J 1R4
t 416.630.2255 f 416.630.4782
va3design.com

project name RUSSELL GARDENS PH. 3	city HAMILTON, ONTARIO	project no. 19014
date JAN 2020	drawn by BD.BIM	checked by 3/16" = 1'-0"
scale 3/16" = 1'-0"	RIGHT SIDE ELEVATION - ELEV '3' OPT. 5 BED	file name 19014-MOUNTAINASH-6-316
drawing no. A6b		

All drawings, specifications, related documents and design are the copyright property of VA3 DESIGN. Reproduction of this property in whole or in part is strictly prohibited without VA3 DESIGN's written permission.

3409 SF.

CITY OF HAMILTON
Building Division

Permit No. 21-107131

THESE STAMPED DRAWINGS SHALL BE AVAILABLE ON SITE

THE OWNER AND/OR CONTRACTOR SHALL COMPLY WITH
THE ONTARIO BUILDING CODE AND ALL OTHER APPLICABLE LAW

These drawings and/or specifications have been reviewed by

[Signature] JUN 22 2021
FOR CHIEF BUILDING OFFICIAL DATE



REAR ELEVATION - ELEV. '3' OPT. 5 BED

MOUNTAINASH 6-316
COMPLIANCE PACKAGE 'A1'

It is the builder's complete responsibility to ensure that all plans submitted for approval fully comply with the Architectural Guidelines and all applicable regulations and requirements including zoning provisions and any provisions in the subdivision agreement. The Control Architect is not responsible in any way for examining or approving site (plotting) plans or working drawings with respect to any zoning or building code or permit matter or that any house can be properly built or located on its lot.

This is to certify that these plans comply with the applicable Architectural Design Guidelines approved by the City of HAMILTON

JOHN G. WILLIAMS LTD., ARCHITECT
ARCHITECTURAL CONTROL REVIEW
AND APPROVAL
APPROVED BY [Signature]
DATE JAN 28, 2021
This stamp certifies compliance with the applicable Design Guidelines only and bears no further professional responsibility.

18				9				The undersigned has referred and takes responsibility for this design and has the qualifications and meets the requirements set out in the Ontario Building Code to be a Designer.
17				8				qualification information
16				7				Richard Vink signature 24488 BCN
15				6	REVISED REAR BOX BAY PER CLIENT.	DEC 15/20	WT	name registration information
14				5	CUSTOM DRAWING FOR PURCHASER REQUEST.	AUG. 27/20	DB	VAS Design Inc. 42652
13				4	STAIRWAY WIDTH CORRECTED.	AUG. 05/20	GW	
12				3	ISSUED FOR PERMIT.	APR 13/20	GW	
11				2	UPDATED PER ENG & CLIENT COMMENTS	MAR 24/20	GW	
10				1	PRELIMINARY, ISSUED FOR CLIENT REVIEW.	JAN. 28/20	GW	
no.	description		date	by	no.	description	date	by

VAS DESIGN
255 Consumers Rd Suite 120
Toronto ON M2J 1R4
t 416.630.2255 f 416.630.4782
vasdesign.com

Greenpark.

project name	RUSSELL GARDENS PH. 3	municipality	HAMILTON, ONTARIO	project no.	MOUNTAINASH 6 19014
date	JAN 2020	checked by	BDHIM	drawing no.	A7b
drawn by	BDHIM	scale	3/16" = 1'-0"		
notes	19014-MOUNTAINASH-6-316				

All drawings, specifications, related documents and design are the copyright property of VAS DESIGN. Reproduction of this property in whole or in part is strictly prohibited without VAS DESIGN's written permission.

CITY OF HAMILTON
Building Division
21- 107131
Permit No. _____

Permit No. 2


THESE STAMPED DRAWINGS SHALL BE AVAILABLE ON SITE

THE OWNER AND/OR CONTRACTOR SHALL COMPLY WITH
THE ONTARIO BUILDING CODE AND ALL OTHER APPLICABLE LAWS


These drawings and/or specifications have been reviewed by

 JUN 22 2021
DATE


FOR CHIEF BUILDING OFFICIAL

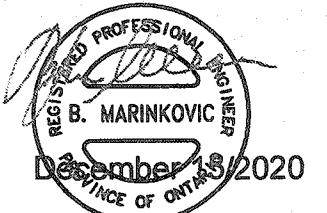

STRUDET INC.
FOR STRUCTURE ONLY

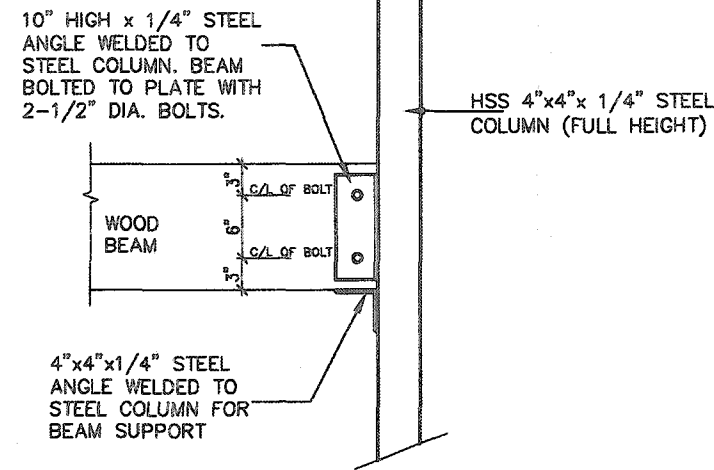

ELEV.
WOOD LINTEL AT STEEL COLUMN
SCALE: NOT TO SCALE

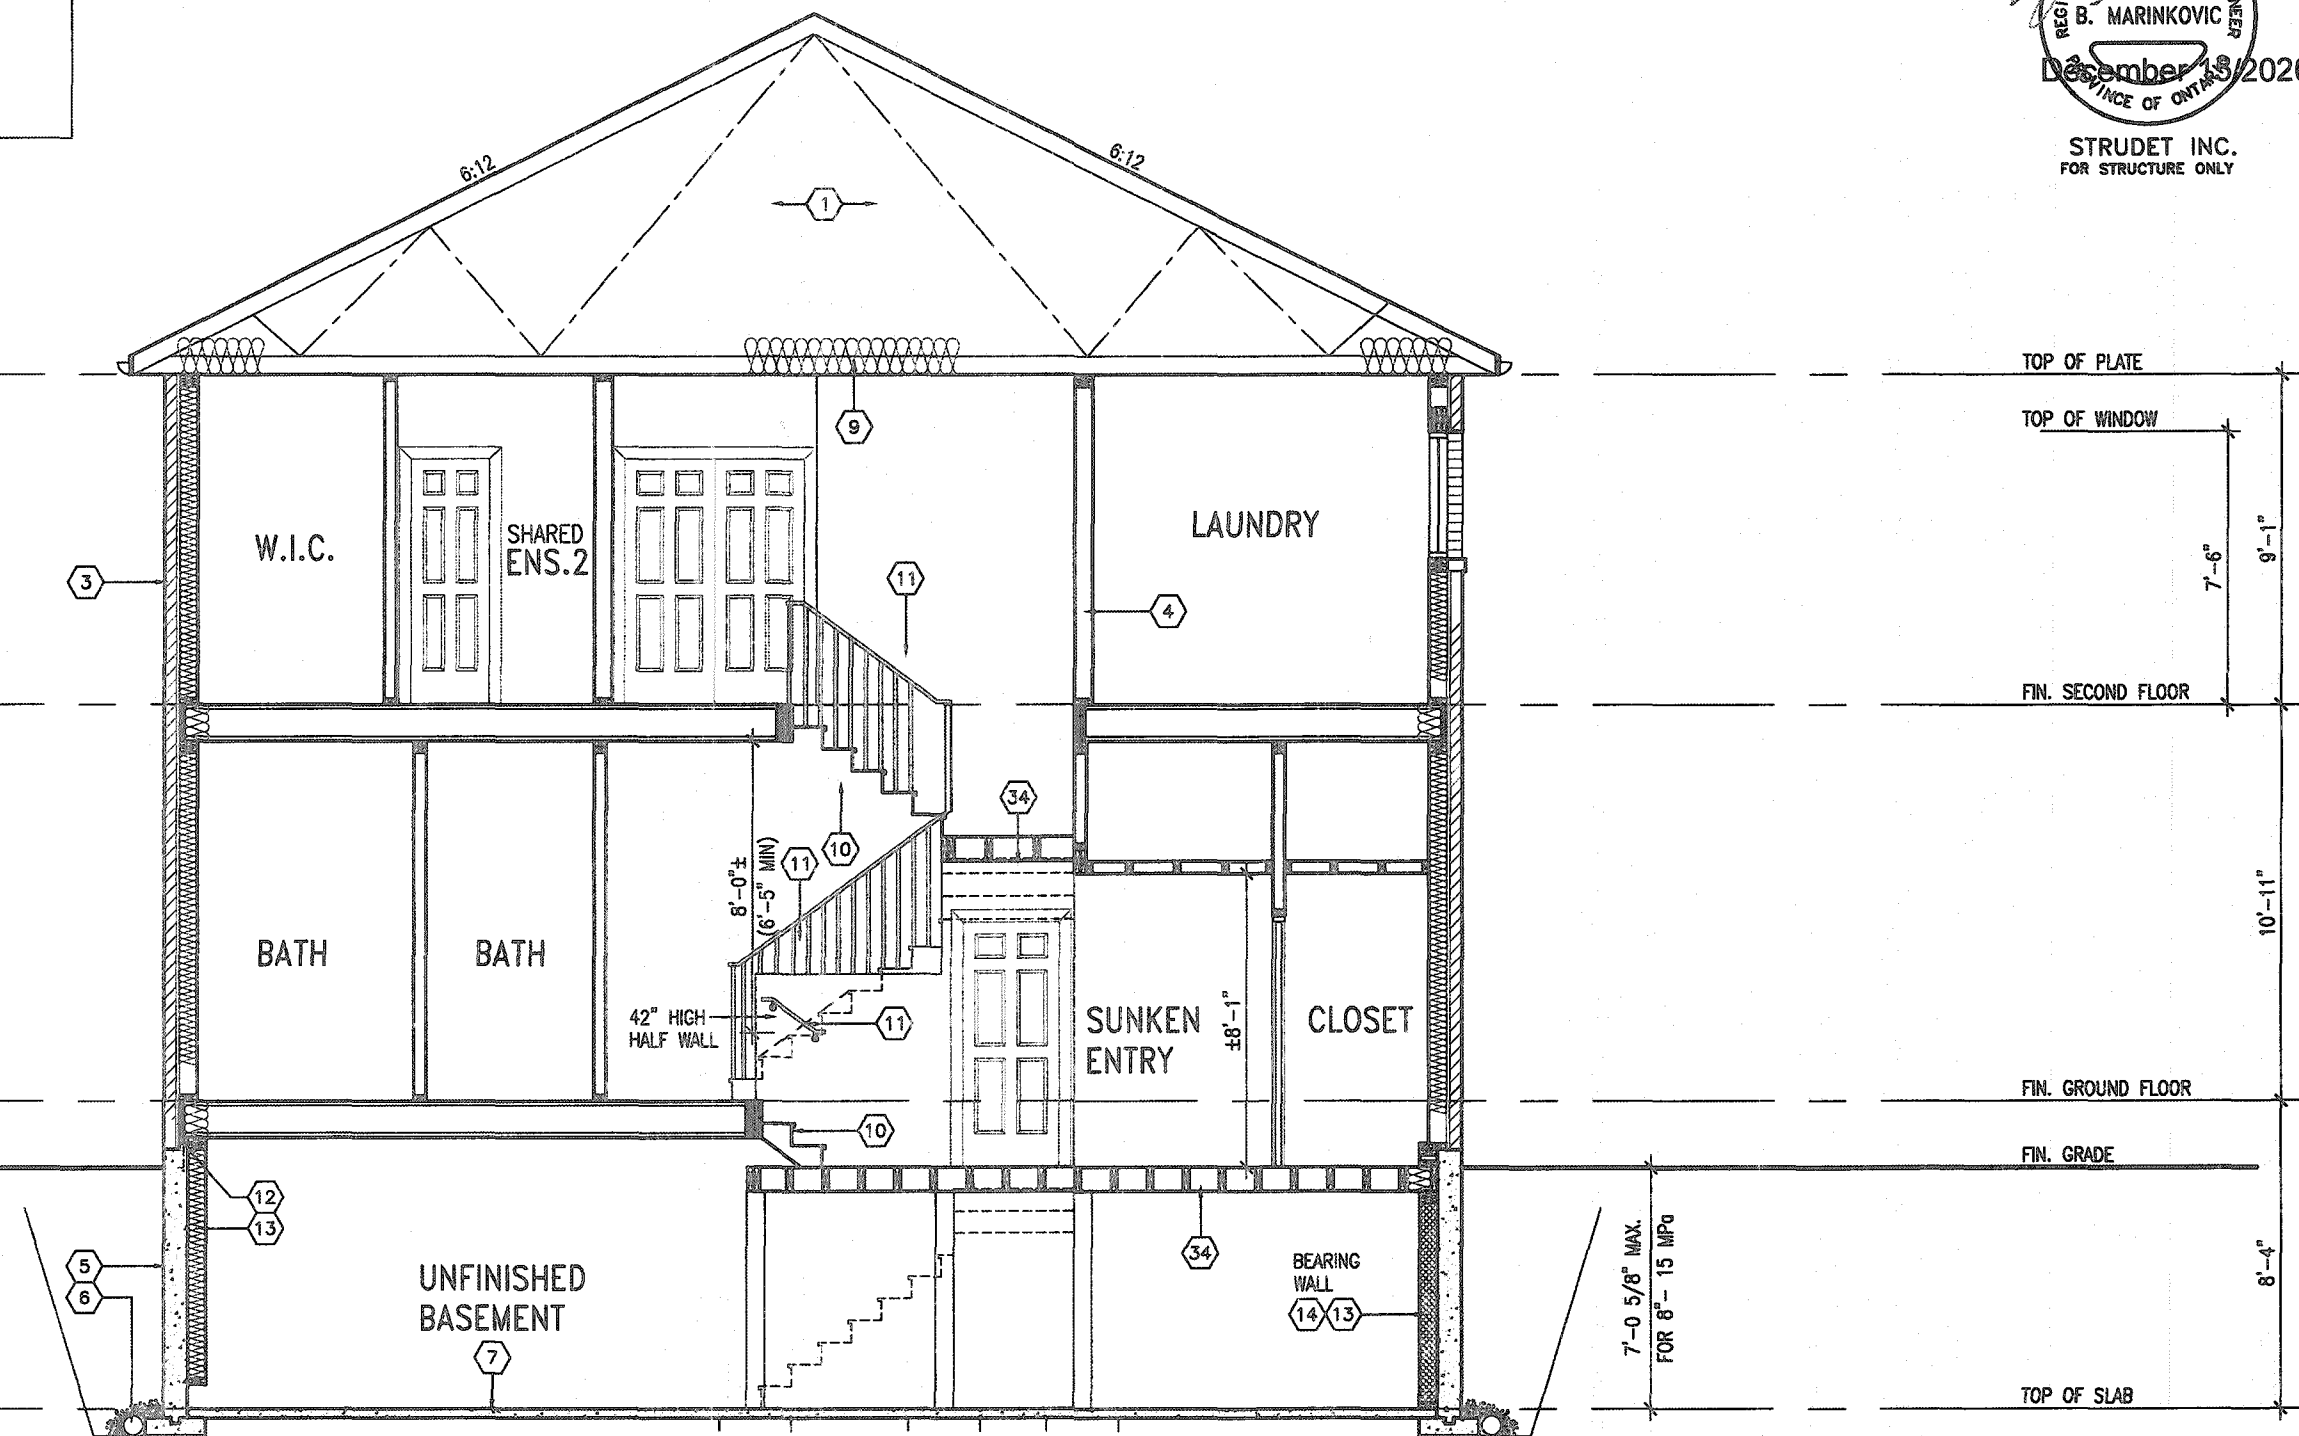

CROSS SECTION 'A-A'
(ELEV. '3')

MOUNTAINASH 6-316
COMPLIANCE PACKAGE 'A1'

It is the builder's complete responsibility to ensure that all plans submitted for approval fully comply with the Architectural Guidelines and all applicable regulations and requirements including zoning provisions and any provisions in the subdivision agreement. The Control Architect is not responsible in any way for examining or approving site (lotting) plans or working drawings with respect to any zoning or building code or permit matter or that any house can be properly built or located on its lot.

This is to certify that these plans comply
with the applicable Architectural Design
Guidelines approved by the City of
HAMILTON

18				9	.	.	The undersigned has reviewed and taken responsibility for this design and has the qualifications and meets the requirements set out in the Ontario Building Code to be a Designer.
17				8	.	.	
16				7	.	.	qualification information
15				6	REVISED REAR BOX BAY PER CLIENT.	DEC. 15/20 WT	Richard Vink 2448
14				5	CUSTOM DRAWING FOR PURCHASER REQUEST.	AUG. 27/20 DB	name BOI
13				4	STAIRWAY WIDTH CORRECTED.	AUG. 05/20 GW	signature VA3 Design Inc. 2655
12				3	ISSUED FOR PERMIT.	APR 13/20 GW	
11				2	UPDATED PER ENG & CLIENT COMMENTS	MAR 24/20 GW	Destructor must verify all dimensions on the job and report any discrepancy to the Designer before proceeding with the work. All drawings and specifications are instruments of service and the property of the Designer which must be returned at the completion of the work. Drawings are not to be copied.
10				1	PRELIMINARY, ISSUED FOR CLIENT REVIEW.	JAN. 28/20 GW	
no.	description	date	by	no.	description	date	by


VA3
DESIGN
255 Consumers Rd Suite 120
Toronto ON M2J 1R4
t 416.630.2255 f 416.630.478
va3design.com

Greenpark.

MOUNTAINASH 6
13.5m

project name RUSSELL GARDENS PH. 3	municipality HAMILTON, ONTARIO	project no. 19014
date JAN 2020		drawing no. A8b
cross section 'A-A'		
drawn by B.RIM	checked by -	scale 3/16" = 1'-0"
file name 19014-MOUNTAINASH-6-316		

All drawings specifications, related documents and design are the copyright property of VAS DESIGN. Reproduction of this property in whole or in part is strictly prohibited without VAS DESIGN's written permission.