LOT / PHASE

187/3



CONSTRUCTION SUMMARY

Mountainview Heights 3 (G) - Russell Gardens Building Ltd.

HOUSE TYPE

Mountainash Five (4 Bedroom) Elev 3

PURCHASERS: ADEL I AZIZIYEH and ASEEL WAJI ABDELRA?OUF ALNEMRI

1 - KITCHEN CABINETRY BASE - PULLOUT RECYCLE 4 BIN - PRICE IS EACH

1 - KITCHEN CABINETRY BASE - PULLOUT WIRE SPICE RACK - PRICE IS EACH

REG. PLAN#

62M-1266

TEL:

CABINETRY	
1 - KITCHEN - DELETE CABINETS ABOVE STOVE - VENDOR WILL SUPPLY 6 INCH VENT AS PER CONSTRUCTION SPECIFICATIONS AND VENT MAY NOT BE IN THE APPROPRIATE LOCATION FOR INSTALLATION OF PURCHASER SUPPLIED VENT - PURCHASER TO SUPPY OWN FAN AFTER CLOSING	
06Jul21 Note: TEMPORARY HOOD FAN MAY BE PROVIDED	s ⁻³
1 - CABINETRY - KITCHEN - LIGHT VALENCE - NO ELECTRICAL	
06Jul21 Note:	٤
1 - KITCHEN CABINETRY - TWO COLOUR KITCHEN - FLAT FEE	
06Jul21 Note:	
1 - CABINETRY PROVISION - PROVISION FOR PLUG ON ISLAND (PLUG EXTRA ORDERED SEPARATELY)	
06Jul21 Note:	
CABINETRY ACCESSORIES	<u> </u>
2 - KITCHEN CABINETRY UPPER - GLASS DOOR - CLEAR - FINISHED INTERIOR - FITS TALL UPPER CABINETS - STANDARD - TO BE INSTALLED AT WET BAR	1 , 1
	V.
New	W
1 - KITCHEN - DELETE 4 UPPER CABINETS ON WET BAR	
	公
13Jul21 Note:	
KITCHEN - DELETE UPPER CABINETRY ABOVE VET BAR - DO NOT INSTALL	
06Jul21 Note:	
1 - KITCHEN - DELETE PANTRY AND SHIFT FRIDGE TO WALL TO ACCOMMODATE BUILT-IN MICRO/OVEN	
06Jul21 Note:	
1 - KITCHEN CABINETRY UPPER - FULL DEPTH ABOVE FRIDGE - WITH GABLES - 600MM - PRICE IS EACH - STANDARD	
06Jul21 Note:	
1 - KITCHEN CABINETRY ACCESSORY - MAGIC CORNER MECHANISM - ADJUST CORNER CABINET TO ACCOMMODATE -	
STANDARD	
06Jul21 Note:	

CERAMIC TILE

06Jul21 Note:

06Jul21 Note:

06Jul21 Note:

06Jul21 Note:

1 - DELETE ALL CERAMIC BATHROOM ACCESSORIES - DELETE TOWEL BAR, PAPER HOLDER & SOAP DISH THROUGHOUT 06Jul21 Note:

1 - KITCHEN CABINETRY - BUILT-IN MICROWAVE/OVEN COMBO - REGULAR INSTALLATION - STANDARD

1 - KITCHEN CABINETRY BASE - COOKTOP CABINET WITH POT DRAWERS (2 DRAWERS) - STANDARD

Greenpark. **CONSTRUCTION SUMMARY** Mountainview Heights 3 (G) - Russell Gardens Building Ltd. PURCHASERS: ADEL I AZIZIYEH and ASEEL WAJI ABDELRA?OUF ALNEMRI TEL: LOT / PHASE REG. PLAN# HOUSE TYPE 187/3 Mountainash Five (4 Bedroom) Elev 3 62M-1266 1 - TILE - UPGRADE 3 FLOOR TILE - - MUD ROOM 06Jul21 Note: 1 - TILE - UPGRADE 3 FLOOR TILE - - POWDER ROOM 06Jul21 Note: 1 - TILE - UPGRADE 3 FLOOR TILE - - FOYER 06Jul21 Note: 1 - PRICE IS FOR LABOUR ONLY - INSTALL TILE IN A STAGGERED PATTERN - - ENSUITE WALL TILE - SHOWER 06Jul21 1 - TILE - UPGRADE 1 FLOOR TILE - - ENSUITE BATHROOM - FLOOR 06Jul21 1 - PRICE IS FOR LABOUR ONLY - INSTALL TILE IN A STAGGERED PATTERN - - BATHROOM 3/4 - TUB AREA 06Jul21 1 - PRICE IS FOR LABOUR ONLY - INSTALL TILE IN A STAGGERED PATTERN - - BATHROOM 2 - SHOWER 06Jul21 CONSTRUCTION 1 - PROVISION FOR SHAMPOO NICHE APPROX. 24" WIDE X 20" HIGH AS PER SKETCH - IF CONSTRUCTION PERMITS - MASTER **ENSUITE BATHROOM** 06Jul21 Note: 1 - SMOOTH CEILINGS ON FIRST FLOOR ONLY - DET 06Jul21 Note: 1 - KITCHEN - PROVISIONS FOR POT FILLER 06Jul21 Note: COUNTER TOP 1 - MASTER ENSUITE BATHROOM - SHOWER SEAT - UPGRADED QUARTZ 06Jul21 1 - SHAMPOO NICHE 24" WIDE X 20" HIGH AS PER SKETCH - MARBLE, GRANITE OR QUARTZ - IF CONSTRUCTION PERMITS -REQUIRES PROVISION FROM CONSTRUCTION - MASTER ENSUITE BATHROOM Note: SUPPLY & INSTALL DOORS AND TRIM 1 - TRIM - UPGRADE 1- 5-1/4" ONE STEP BASEBOARD AND ONE STEP CASING WITH BACKBEND 06Jul21 ELECTRICAL 1 - BUILT IN OVEN AND COOKTOP PROVISION - PROVISION ONLY - ELECTRICAL ONLY 06Jul21

ConstructionSummaryMS.rpt 08June20

06Jul21

06Jul21

Note:

1 - PLUG - ELECTRICAL PLUG WITH GFI AND SWITCH - FOR FESTIVE LIGHTING

1 - PLUG - ELECTRICAL PLUG - INSTALLED 5' FROM FLOOR - MASTER BEDROOM

CONSTRUCTION SUMMARY

PURCHA	ASERS: ADEL I	Mountainvie AZIZIYEH and ASEEL WA	ew Heights 3 (G) - Russell Gardens Building Ltd AJI ABDELRA?OUF ALNEMRI	l.	TEL:
L	OT/PHASE 187/3	REG. PLAN# 62M-1266	HOUSE TYPE Mountainash Five (4 Bedroom) Elev 3		
1 - PLUG 06Jul21	- ELECTRICAL Note:	PLUG - TO BE INSTALLE			
1 - PLUG 06Jul21	- ELECTRICAL Note:	PLUG - ADD TO ISLAND			
1 - RELOO 06Jul21	CATE STANDAF Note:	RD KITCHEN LIGHT TO B	BE CENTERED OVER ISLAND		
1 - POT L KITCHEN 06Jul21	IGHT - LED - FII WORKSPACE Note:	RST FLOOR INSTALLATI	ON - INSTALLED ON A SEPERATE SWITCH FROM ST	ANDARD LIGHTS -	
1 - POT LI KITCHEN 06Jul21	IGHT - LED - FII BREAKFAST Note:	RST FLOOR INSTALLATIO	ON - INSTALLED ON A SEPERATE SWITCH FROM ST.	ANDARD LIGHTS -	
1 - POT LI ROOM 06Jul21	GHT - LED - FIF	RST FLOOR INSTALLATIO	ON - INSTALLED ON A SEPERATE SWITCH FROM STA	ANDARD LIGHTS - FAMILY	(
1 - POT LI LIVING/D 06Jul21	GHT - LED - FIR INING ROOM Note:	ST FLOOR INSTALLATIO	ON - INSTALLED ON A SEPERATE SWITCH FROM STA	ANDARD LIGHTS -	
1 - STAND 06Jul21	OARD DINING R Note:	OOM LIGHT TO BE CENT	TERED BETWEEN LIVING AND DINING ROOM		
	CE AND ACC				
1 - MANTI 06Jul21		M6 - IN LIEU OF STANDA	ARD MANTEL		
HARDWO	OOD FLOORIN	NG			
1 - HARDV 06Jul21		B SERIES 5 INCH - IN LII	EU OF STANDARD TILE - KITCHEN & BREAKFAST		
1 - LAMIN 06Jul21		E TO PARKLANE SERIES	S IN LIEU OF STANDARD LAMINATE		
1 - HARDV 06Jul21		B SERIES 5 INCH - IN LIE	EU OF 2 1/4 INCH NATURAL RED OAK MAIN HALI		
1 - HARDV 06Jul21		B SERIES 5 INCH - IN LIE	EU OF 2 1/4 INCH NATURAL RED OAK - LIVING AN	D DINING ROOM	
1 - HARDV 06Jul21	VOOD - GROUP Note:	B SERIES 5 INCH - IN LIE	EU OF 2 1/4 INCH NATURAL RED OAK LIBRARY/D	EN	
1 - HARDW 06Jul21		B SERIES 5 INCH - IN LIE	EU OF 2 1/4 INCH NATURAL RED OAK FAMILY RO	OOM	
	S AND GLASS				
1 - POWDE 06Jul21	ER ROOM - DEL	ETE STANDARD MIRROF	R - DO NOT INSTALL		

	CO	NSTRUCTION SUMMARY		
		v Heights 3 (G) - Russell Gardens Building L	td.	
PURCHASERS: ADEL I	AZIZIYEH and ASEEL WA	JI ABDELRA?OUF ALNEMRI		TEL:
LOT / PHASE	REG. PLAN#	HOUSE TYPE		
187 / 3	62M-1266	Mountainash Five (4 Bedroom) Elev 3		
PLUMBING				
1 - POWDER ROOM - DE	ELETE PLATE FROM STAN	DARD FAUCET - INSTALL WITH SINGLE HOLE IN	STALLATION - IF	T
CONSTRUCTION PERM 06Jul21 Note:	ITS			
1.000				
1 - SINK - DROP-IN SINI	X - CONTRAC LOLAND - S	INGLE HOLE #4410BST - POWDER ROOM		
06Jul21 Note:	is a second to be a second to be	TODE HOLL #4410BS1 - 1 OWDER ROOM		
1 - KITCHEN – POT FILL	ER – DELTA CONTEMPOR	RARY STAINLESS POT FILLER #1165LF		
06Jul21 Note:				
1 - WATER LINE FOR FF	RIDGE - ROUGH-IN ONLY			
06Jul21 Note:				
PROMOTIONAL				
	PURCHASER EXTRA SHEI	ET IN OPEED		
06Jul21 Note:	I ORCHASER EATRA SHEI	ET IN OFFER		
STAIRS AND RAILING				
	TANDARD STAIRCASE - P	RICE IS PER SET		
06Jul21 Note:				e.
1 CTAIDCAGE WORLD				
1 - STAIRCASE - V GROO 06Jul21 Note:	OVE HANDRAIL			
oogui21 Note.				±.
1 STAIDCASE EUDOL	INE 0 IRON PICKETS - BLA	A CIV		
06Jul21 Note:	INE U IRON PICKETS - BLA	ACK.		
oodui21 Trote.				
		····		
	E	XTRAS AS PER OFFER		
(1) (2) (1)				
(1) The Vendor agrees the	at notwithstanding any other	er term or provision in this Agreement included in the	ne Purchase Price and in	
Worksheet Note:	etailed in Schedule GP to ti	ne Agreement of Purchase and Sale, the Purchaser is	s entitled to a credit of	
Purchase Price includes	Three enlarged basement w	indows, and the obligation to construct the house wi	ith the enlarged basement	
windows is subject to the <i>Worksheet</i> Note:	Vendor?s approval, in its	sole and unfettered discretion. The Purchaser acknowledge	wledges and agrees that	
or wheel 110te.				
200 AMP SERVICE LA	BELLED WITH CIRCUIT	BREAKER PANEL TO UTILITY AUTHORITY	STANDARDS.	
Worksheet Note:				
DUDCHACED(C) ACCO	OWI EDOES THAT THE	DUDGULAGE PRIOR IG PAGAMONIA OF ANY OR	EDITE AND	
	OWLEDGES THAT THE AGES AVAILABLE AT	PURCHASE PRICE IS INCLUSIVE OF ALL CRI	EDITS AND	
Worksheet Note:		or rendering.		

This Document is Extremely Time Sensitive - Printed $\underline{13 \text{ Jul } 21}$ at $\underline{15:47}$

INTERIOR COLOUR SCHEME

Purchasers:

ADEL I AZIZIYEH & ASEEL WAJI ABDELRA?OUProperty: 187

Telephone Res. / Bus: / Decor Advisor:

Candace Forza

Project: Russell Gardens Building Ltd. Model and Elevation: Mountainash Five (4 Bedroom) Elev 3

Lock Date:

6-.lul-21

6-.lul-21

Plan #: 62M-1266

. Cabinetry	Style and Colour		Hardware
itchen / Breakfast	SEE BELOW		447SA
aundry Room	ELISSE		Standard
owder Room	MONACO 350 PLATINUM SILVER		431SA
laster Ensuite Bathroom	DORAL K38 RIVERSIDE		410SA
nsuite Bath - Bedroom 2	MONACO 904 INK		410SA
insuite Bath - Bedroom 3/4	DORAL K44 TITAN GREY		431SA
[N/A		N/A
	N/A		N/A
	N/A		N/A
ppliances:	Built In Appliances Yes No	Slide In Stove	Yes No
ishwasher Cabinet	Closed Open 41" Upper Cabinet	•	
tove Opening	NOTE: If not specified, opening will be	e set to builder's standard opening of approximately 3	0" width
stove Opening			
ridge Opening PERIMETER - DORAL W-5	500 *** ISLAND AND WET BAR - MONACO 814	DARK CHOCOLATE	7" width x 74" heig

Initials:



k	INTERIOR COLO	UR SCHE	ME
	SEEL WAJI ABDFI RA?OU Pro r	perty: 187	
/			ell Gardens Ruilding Ltd
landace Forza			
	0-341-21	Pian	#: 62M-1266
-		At a 45	Threshold-If App.
	RRARA POLISHED-12X24		metal strip where applicable
TILE-VARENNA CAR	RRARA POLISHED-12X24		
TILE-AXIS BLACK-12	2X24		
TILE-CONCEPT GRE	EY-13X13		
	RRARA POLISHED-12X24		
Tillial y			
0.1			
		Describe	
	DOENII ANDIA 9V46***CTACOEDED	NIOUE 0 O	TAT OLIABITZ FUOION BLACK
	ROENLANDIA-6X16 STAGGERED	NICHE & SI	EAT-QUARTZ-FUSION BLACK
	POENI ANDIA 9Y16***STACCEDED	-	
I ILE-LUC BLAING G	ROENLANDIA-0X 10 STAGGERED		
N/A			
N/A N/A			
N/A N/A N/A		JLESS SPE	CIFIED
N/A N/A N/A	RD GROUT THROUGHOUT UN	ILESS SPE	CIFIED
	Candace Forza Candac	ADEL I AZIZIYEH & ASEEL WAJI ABDELRA?OUProper Procession Candace Forza	ADEL I AZIZIYEH & ASEEL WAJI ABDELRA?OUProperty: 187 Project: Russ: Candace Forza





Purchasers: Telephone Res. / B	۸۵							
Telephone Res. / B	AD	EL I AZIZIYEH &	ASEEL WAJI ABI	DELBASOLI D	snowby, 1	07		
	us: /		, IOLLE VV IOI ADI		-			a Name
Decor Advisor:		ndace Forza	n.				ardens Building Lt	
Lock Date:		ul-21		lodel and Elev			sh Five (4 Bedroo	om) Elev 3
7. Onler Floorii		ui-2 i	6-Jul-21		P	lan #:	62M-1266	
Main Hall		STRIP-VINTAGE-NO	SS-WIRE BRUSHED-	CHARACTER	LIDETHANI	- 011 - 050		
iving Room			SS-WIRE BRUSHED-					
Dining Room			SS-WIRE BRUSHED-					
amily Room			SS-WIRE BRUSHED-					
Den / Library / Study			SS-WIRE BRUSHED-					
Basement Landing(If Ap	pplies)	N/A						
ower Landing (If Applie	es)	STRIP-VINTAGE-NS	SS-WIRE BRUSHED-	CHARACTER-UV	URETHANE	OIL-RED	OAK-TITAN-5"	
Jpper Landing			SS-WIRE BRUSHED-0					
Jpper Hall			NE-VENICE OAK GF					
laster Bedroom		LAMINATE-PARK LA	NE-VENICE OAK GF	REY-TL-EL3906				
Bedroom #2		LAMINATE-PARK LA	NE-VENICE OAK GF	REY-TL-EL3906				
Bedroom #3		LAMINATE-PARK LA	NE-VENICE OAK GF	REY-TL-EL3906				
Bedroom #4		LAMINATE-PARK LA	NE-VENICE OAK GF	REY-TL-EL3906				20
Bedroom #5		N/A						
(ITCHEN & BREAKFAST	Γ	STRIP-VINTAGE-NS	S-WIRE BRUSHED-0	CHARACTER-UV I	URETHANE	OIL-RED	OAK-TITAN-5"	
		N/A						
		N/A			2			0
Inderpad		ype		Area				
	N	I/A		N/A				
* Refer to Construc								-
8. Railings and l				Colour	VINTAGE	TITAN R	ED OAK	
8. Railings and I	Pickets /-GROOV	/E		Colour		E TITAN R	ED OAK	
8. Railings and I Railing Type V Picket Type	Pickets /-GROOV	/E E 0	N SPECIFICATIO	Colour	BLACK			
8. Railings and I Railing Type M Picket Type E Stringer / Riser	Pickets /-GROOV EUROLINI AS PER (Æ E 0 CONSTRUCTION	N SPECIFICATIO	Colour Colour	BLACK VINTAGE	TITAN RI	ED OAK	
8. Railings and I Railing Type N Picket Type E Stringer / Riser	Pickets /-GROOV EUROLINI AS PER (/E E 0 CONSTRUCTION CONSTRUCTION	N SPECIFICATIO	Colour	BLACK VINTAGE VINTAGE	TITAN RI	ED OAK	
8. Railings and I Railing Type Picket Type Stringer / Riser Treads	Pickets V-GROOV EUROLINI AS PER (AS PER (Red Oak	E 0 CONSTRUCTION CONSTRUCTION Stairs with Sem	N SPECIFICATIO	Colour Colour Colour	BLACK VINTAGE VINTAGE Yes	ETITAN RI ETITAN RI O No	ED OAK ED OAK	PICKETS
8. Railings and I Railing Type Picket Type Stringer / Riser Treads	Pickets V-GROOV EUROLINI AS PER (AS PER (Red Oak	E 0 CONSTRUCTION CONSTRUCTION Stairs with Sem	N SPECIFICATION I Gloss Finish STAIN COLOUR	Colour Colour Colour S OR FINISH A	BLACK VINTAGE VINTAGE Yes	ETITAN RI ETITAN RI No	ED OAK ED OAK SERS. TREADS.	PICKETS TE
8. Railings and I Railing Type Picket Type Stringer / Riser Treads ** Refer to Constru AND RAILS (STAIR FLOORS.	Pickets V-GROOV EUROLINI AS PER (AS PER (Red Oak uction S RCASES	E 0 CONSTRUCTION CONSTRUCTION Stairs with Sem summary THE), WILL NOT BE	N SPECIFICATIO II Gloss Finish STAIN COLOUR AN EXACT MAT	Colour Colour Colour S OR FINISH A CH TO PREFIR	BLACK VINTAGE VINTAGE Yes	E TITAN RI	ED OAK ED 











** Refer to Construction Summary

7000										1
Gree	npa	rk.		IN	TERIOR CO	LOUR SCI	HEME			rs a s
Purchasers:		ADEL I AZIZIYEI	H & ASE	EL WAJI AE	BDELRA?OU P	roperty: 18	37			
Telephone R	es. / Bus:	1					ussell Garder	ns Build	dina Ltd	
Decor Advise	or:	Candace Forza			Model and Ele				•	Flev 3
Lock Date:		6-Jul-21		6-Jul-21				I-1266	ocaroom)	
10. Plaste	r Mouldir	ngs and Medall	ions				WII // 1 02 IV	1 1200		
Entrance Ve		N/A	N/A		Kitchen/Brea	kfast	N/A		N/A	
Main Hall		N/A	N/A		Den/Library		N/A		N/A	
Living Room	n	N/A	N/A		Lower Landir	ng	N/A		N/A	
Dining Room Family Room		N/A	N/A				N/A		N/A	
		N/A	N/A				2	J [9	
** Refer to	Construct	ion Summary							5 0	1 2
11. Firepla										
	Living Roo			Family Roo	m		Other Room	- Specif	y	
	Purchased	As Per Plan N/A		Purchased	As Per Plan N	N/A	Purchased	As Per P	lan N/A	
Fireplace Type	N/A			FLAT ON W	/ALL		N/A			
Mantle Type Colour / Stain	N/A N/A			MANTLE M		250151047101	N/A			
Surround	N/A			NERO	NSTRUCTION SI	PECIFICATION	N/A N/A			
Hearth	N/A			NO			N/A			
* Refer to Co	nstruction	Summary					I IV/V			
Gas Provis Comment * Refer to Co	•				Ga	s Provision	ns Barbecue	NO		
13. Electri	cal									
Plugs and Sw	itches	White	DI	ECOR		Above Ki	tchen Cabin	et Ligh	nt 🔘 Yes	No No
Hood Fan		STANDARD WHITE TEM		1P.			Kitchen Cabinet Light O Yes		No No	
Appliances		Built in Cookto	•	Built in	Oven	Gas S	stove		Microway	/e
		● Yes ○ N	0	Yes	O No	O Yes	No		Yes) No
Dishwasher F	_	Yes								
* Refer to Co	al Comme	ents								
* Refer to Cor	struction S	Summary								
Disclaimer	s and Not	tes								
	of all mate s in manu	erials are as close facturing.	e as pos	sible to bu	iilder's selecti	on, but not	necessarily	identi	cal due to)
	as listed a paid in ful	bove are null and l.	d void ur	nless acco	mpanied by a	separate ii	nvoice/amen	dment	t. Said inv	oice
3) The Purc by the Ve		ees that this colo	our selec	ction is fina	al and that no	changes w	vill be permit	ted, ui	nless requ	ıired
disclaim		nowledges readi			_	ich contain	s other misc			
Signature:_	MAR	694	_ Date:	June 6,200	<u>Ś</u> ignature:	MA	And the same of th	D	ate: <u>6-5</u> 4	1-2021

Page 4 of 4

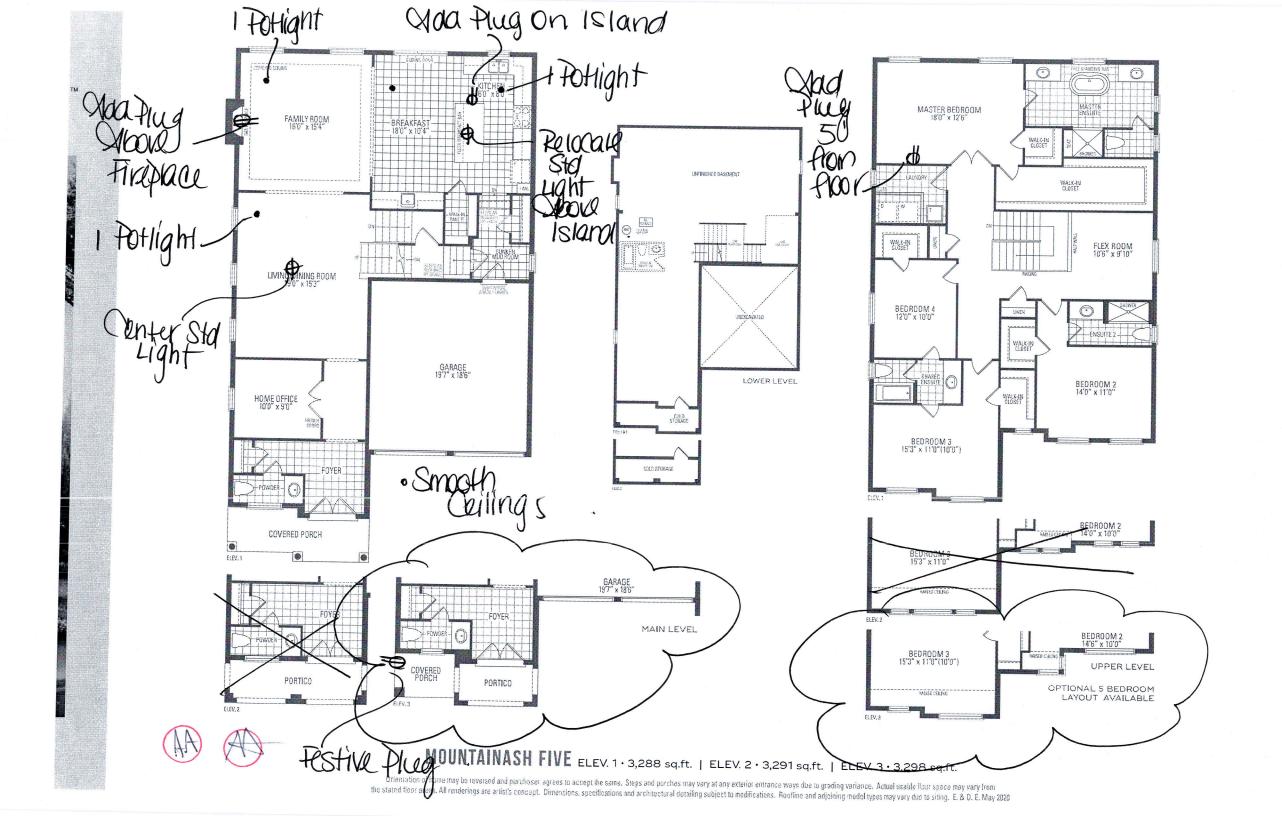

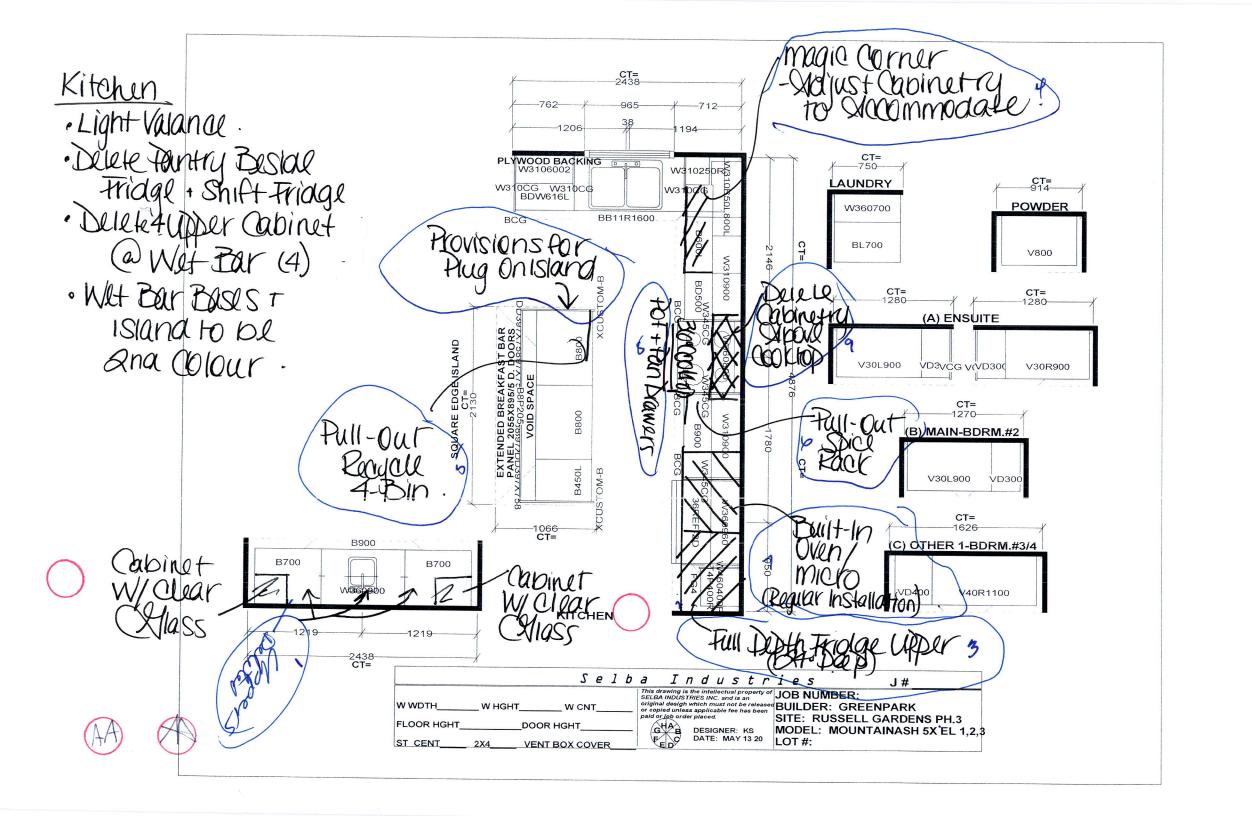

24" Pocket Handle Dishwasher

500 Series - Stainless Steel SHPM65Z55N





SHPM65Z55N Stainless Steel

Also available in:

White

SHPM65Z52N

Black

SHPM65Z56N

All-new AutoAir™ option automatically releases the door at the end of the cycle to let moisture escape and fresh air in for drier dishes.


Features & Benefits

44 dBA: dishwasher runs quietly so your kitchen conversations aren't interrupted.

The Flexible 3rd Rack with fold down sides adds 30% more* loading area, perfect for utensils and ramekins.


The AquaStop® leak protection system contains leaks through a precisely engineered system. If a leak occurs, the system contains it by shutting down operation and pumping out water. So you have the ultimate peace of mind whether you are away or at home.

Number of wash cycles	5
Number of options	5
dBA	44
Third rack	Flexible 3rd Rack
Rack adjustability	Rackmatic®
Tub material	Stainless Steel
Control type	Buttons
Concealed water heating element	Yes
Leak protection system	24/7 AquaStop®
Water softener	No
Five-level wash	Yes
ChildLock	No
Special features	InfoLight®, AutoAir™ Option
Efficiency	
Water usage per cycle	3.5
Energy efficiency class	Tier 1
ENERGY STAR® qualified	Yes
Total annual energy consumption (kWh)	269
Total annual water consumption (g)	623.5
Capacity	ond Milliance
Number of place settings	16

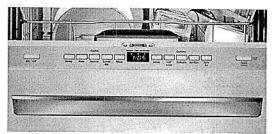



Technical Details	
Watts (W)	1440 W
Current (A)	12 Amps
Volts (V)	120 V
Frequency (Hz)	60 Hz
Power cord length	67"
- Install length from corner of unit	45"
Minimum water pressure (lb/sin)	14
Length outlet hose (in)	79"
Dimensions & Weight	
Overall appliance dimensions (HxWxD) (in)	33 7/8" x 23 9/16 x 23 3/4"
Required cutout size (HxWxD) (in)	33 7/8" x 23 5/8" x 24"
Adjustable feet	Yes
Net weight (lbs)	91 lbs
Accessories—Optional	· 如《整整制版图》
Junction Box	SMZPCJB1UC
Bosch Dishwasher Water Supply Hose	SMZSH002UC
Drain Hose Extension Kit	SGZ1010UC
Dishwasher Accessory Kit	SMZ5000
Anti-Tarnish Silverware Cassette	SMZ5002UC
Edge Protector	SMZEP001UC

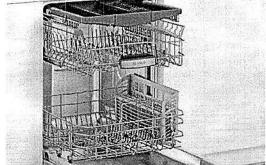

Accessories: To purchase Bosch accessories, cleaners & parts please visit www.bosch-home.com/us/store or call 1-800-944-2904 (Mon to Fri 5 am to 6 pm PST, Sat 6 am to 3 pm PST). Notes: All height, width and depth dimensions are shown in inches. BSH reserves the absolute and unrestricted right to change product materials and specifications, at any time, without notice. Consult the product's installation instructions for final dimensional data and other details prior to making cutout.

Warranties: Please see Use & Care manual or Bosch website for statement of limited warranty.

For more information on our entire line of products, go to www.bosch-home.com/us or call 1-800-944-2904 © BSH Home Appliances Corporation. All rights reserved. Bosch is a registered trademark of Robert Bosch GmbH.


^{*}Compared to a Bosch dishwasher with 2 racks.


24" Pocket Handle Dishwasher


500 Series - Stainless Steel SHPM65Z55N





Installation Details

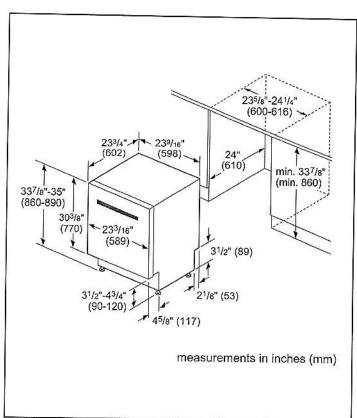

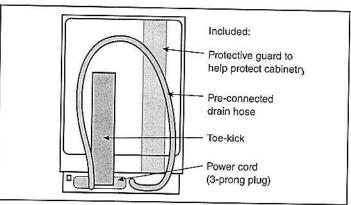

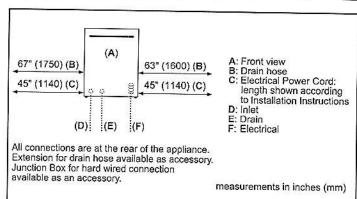

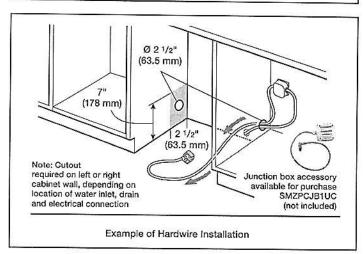

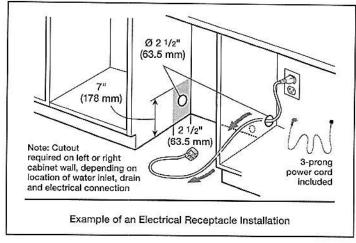

Accessories: To purchase Bosch accessories, cleaners & parts please visit www.bosch-home.com/us/store or call 1-800-944-2904 (Mon to Fri 5 am to 6 pm PST, Sat 6 am to 3 pm PST). Notes: All height, width and depth dimensions are shown in inches. BSH reserves the absolute and unrestricted right to change product materials and specifications, at any time, without notice. Consult the product's installation instructions for final dimensional data and other details prior to making cutout.

Warranties: Please see Use & Care manual or Bosch website for statement of limited warranty.


For more information on our entire line of products, go to www.bosch-home.com/us or call 1-800-944-2904 © BSH Home Appliances Corporation. All rights reserved. Bosch is a registered trademark of Robert Bosch GmbH.


24" Pocket Handle Dishwasher

500 Series - Stainless Steel SHPM65Z55N



Installation Details

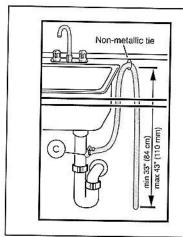

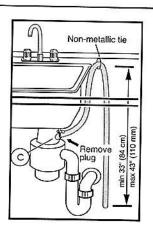

Note: Plumbing installations will vary - refer to local codes. Drain hose included is 79" (201 cm) and can be extended to a maximum of 155 3/4" (396 cm).

Always use the approved drain hose extension kit (SGZ1010UC).

Ensure a portion of the drain hose is raised between min. 33" (84 cm) and max. 43" (110 cm) above the cabinet floor.



Ventilation

HCB56651UC 36" Box Canopy Chimney Hood 500 Series - Stainless Steel



Wall Mounted Chimney Hoods Add Style and Sophistication to the Kitchen and Gives You Greater Freedom in Your Kitchen Planning

- Touch Controls with LCD Display
- 600 CFM Centrifugal Integrated Blower Included
- Four Speed Touch Controls with LCD Display
- · Dishwasher Safe Filters with Stainless Steel Covers
- Converts to Recirculation Mode with Accessory Kit (Separate Purchase Required)

Technical Data

Operating Mode:	Convertable: Ducted / Recirculating
Number of speed settings	197
Optional accessories :	4-stage HCBEXT5UC, HCIFILTUC, HCREC5UC
Number of lights :	
Type of lamps used :	2
Total power of the lamps	Halogen
Grease filter material :	(W): 40 Washable stainless steel
Grease filter type :	
UPC code :	Multilayer cassette 825225909057
Material :	Stainless steel
Watts (W):	530
Volts (V):	110
Frequency (Hz):	60
Approval certificates :	57.0
Power cord length (cm) :	CUL, UL
Plug type :	0
Overall appliance dimension	no plug
	1/16" - 45 13/16" x 36" x 19 11/16'
Overall appliance dimension	I/10 40 10/10 X 30 X 19 11/16
	687 - 1164 x 914 x 500
Product packaging dimensi	
	26.25 x 39.99 x 17.99
Height of the chimney (in):	25 1/2" - 40 9/16"/25 3/8" - 44 1/4"
Height of the chimney (mm	
Net weight (lbs) :	55
Net weight (kg):	25.0
Gross weight (lbs):	62
Gross weight (kg):	28.0
Motor location :	Integrated motor in hood chimney
Diameter of air duct (in) to	

Optional accessories

No-return airflow flap:

HCBEXT5UC : Box Chimney Extension

HCIFILTUC: Wall/Island Chimney Charcoal Filter

HCREC5UC : Wall Chimney Recirc. Kit

Yes



Ventilation

HCB56651UC

36" Box Canopy Chimney Hood 500 Series - Stainless Steel

Wall Mounted Chimney Hoods Add Style and Sophistication to the Kitchen and Gives You Greater Freedom in Your Kitchen Planning

Design

- Duct Extension Accessory Kit Available for 9' to 12' Ceilings

Performance

- 2 Halogen Lights 12 Volt, 20 Watt max., G-4 Base
- 8" round duct at discharge.

Efficiency

- Blower will automatically turn on at high speed if excessive heat is sensed in the control area.
- Absorb odors with charcoal replacement filters.


Convenience

- Convenient timer built into control from 1-60 minutes.
- Signal on LCD display will illuminate as a reminder to check filters for cleaning.
- Audible tone when select controls are pressed.



Ventilation

HCB56651UC 36" Box Canopy Chimney Hood 500 Series - Stainless Steel

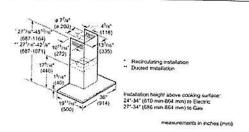

RF23M8070SR

SAMSUNG

23 cu. ft. Counter-Depth, 4-Door French Door Refrigerator



Signature Features

AutoFill Water Pitcher

 A built-in pitcher that refills with filtered water and the option to infuse with a flavor of your choice.

FlexZone™ Drawer

 A flexible storage drawer with four different temperature settings and an adjustable Smart Divider to stay organized.

Fingerprint Resistant Finish

A special finish to reduce smudges and minimize cleaning.

Available Colors




Fingerprint Resistant Stainless Steel (shown)




Fingerprint Resistant Black Stainless Steel



Fingerprint Resistant Tuscan Stainless Steel

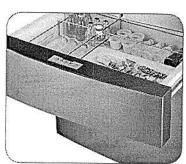

FlexZone™ Drawer

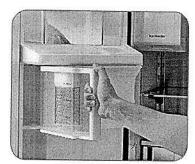

AutoFill Water Pitcher

Convenience

- AutoFill Water Pitcher
- FlexZone™ Drawer with 4 Temperature Settings and Smart Divider
- Wi-Fi Ready
- Adjustable Shelves for Tall Oversized Items
- Auto Pull-Out Upper Freezer Drawer
- Sabbath Mode
- Water Filter Indicator

Design

- Counter Depth
- Fingerprint Resistant Finish
- Modern External Filtered Water and Ice Dispenser
- High Efficiency LED Lighting
- EZ-Open Handle™ on Freezer Door and FlexZone™ Drawer
- Tempered Glass Spill-Proof Shelves
- Gallon Door Bins
- Dispenser Light

Performance

- Twin Cooling Plus®
- Ice Max Stores up to 2.7 lbs of ice
- ENERGY STAR® Compliant
- Power Freeze and Power Cool Options
- Two Humidity-Controlled Crispers
- CoolTight Door
- Door Alarm

Rating



ENERGY STAR® rated: CEE Tier 1 633 kWh/yr

RF23M8070SR

SAMSUNG


23 cu. ft. Counter-Depth, 4-Door French Door Refrigerator

Installation Specifications


- Measure the height, width and depth of the opening, making sure to include baseboards, molding tile, countertop overhang, etc. Check to be sure there is enough room to open the door (consider walls, islands or other obstacles when measuring).
- Refer to illustration below to determine dimensions.
- 3. Allow 2.5" of clearance on hinge side of refrigerator when installing next to a wall where handle may make contact.
- 4. Allow 1" minimum clearance at rear for proper air circulation and water/electrical connections. Allow a 3/8" minimum clearance at sides and top for ease of installation.
- 5. Ensure each door and entryway in the home is wide enough for the refrigerator to be moved through easily.

For optimal usage and to be able to open refrigerator doors completely, do not install next to a wall.

Please note: The following dimension and cutout information is for planning purposes only. For complete installation details, consult manual packed with product, or download manual online at samsung.com.

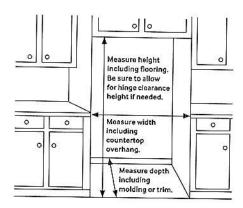

Dimensions

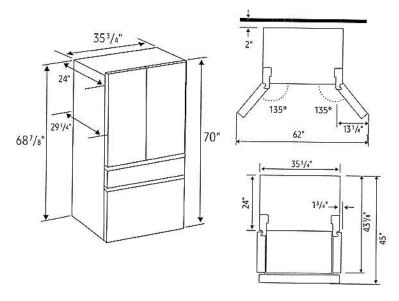

Total Capacity: 22.6 cu. ft.

Refrigerator: 12.9 cu. ft.

- 2 Humidity-Controlled Crispers
- 5 Tempered Glass Spill-Proof Shelves
- 1 Slide-In
- 1 Foldable Half
- 2 Fixed
- 1 Full-Width Glass Shelf on Crisper
- 7 Door Bins
- Right Door: 3 Gallon Bins
- Left Door: 4 Regular Bins
- High Efficiency LED Lighting

FlexZone™ Drawer: 3.1 cu. ft.

- 4 Temperature Zones with Smart Divider
- Meat/Fish (29°F)
- Cold Drinks (33°F)
- Deli/Snacks (37°F)
- Wine/Party Dishes (42°F)

Freezer: 6.6 cu. ft.

- 1 Drawer Divider
- High Efficiency LED Lighting

One (1) Year Parts and Labor on Refrigerator

Five (5) Years Parts and Labor on Sealed Refrigeration System Only*

Ten (10) Years Parts and Five (5) Years

Labor on Digital Inverter Compressor ator, condenser, drier and co

Product Dimensions & Weight

Dimensions (WxHxD with hinges, handles and doors):

35³/₄" x 70" x 29¹/₄'

Dimensions (WxHxD without hinges and door):

353/4" x 687/8" x 241

Dimensions (WxHxD with hinge and door, no handle):

353/4" x 70" x 291/4"

Weight: 342 lbs

Shipping Dimensions & Weight (WxHxD)

Dimensions: 381/4" x 753/4" x 311/4"

Weight: 366 lbs

Color	Model #	UPC Code
Fingerprint Resistant Stainless Steel	RF23M8070SR/AA	887276192604
Fingerprint Resistant Black Stainless Steel	RF23M8070SG/AA	887276192598
Fingerprint Resistant Tuscan Stainless Steel	RF23M8070DT/AA	887276355139



Regular Installation.

800 Series, Combination Oven, 30", Stainless steel HBL87M53UC







Included accessories

1 x oven racks /lower 1 x temperature probe /lower

Optional accessories

HEZTR301 : Telescopic Oven Rack 30"

Bosch microwave combination ovens create an all-in-one cooking center with an upper speed oven and a Genuine European Convection oven below

- With capacities of 1.6 cu. ft upper microwave and 4.6 cu. ft. lower oven allows enough space to cook everyday meals or for a crowd
- 10 convenient automatic sensor cooking programs to simplify cooking for great results every time
- 10 power levels with 950 watts of microwavable power provides quick and convenient cooking
- Lower oven's convection multi-rack mode gives uniform baking results even when using all 3 racks simultaneously
- Download Bosch Home Connect application and control the lower wall oven with your smart phone or tablet

Technical Data

Technical Data	
Cooking mode:	Microwave
Cooking method second cavity:	
3rd element convection, Convection Bake, Convection	i
Broil, Convection Roast, Dough proving setting, Pizza	
setting, Small area grill, Top/bottom heating, Top heat	ing
1/3 bottom heat., Variable small-area grill,	
Integrated Cleaning system :	No
Number of interior lights :	1
Included accessories :	1
· · · · · · · · · · · · · · · · · · ·	probe /lo
Bake Element Wattages cavity 1 (W):	600
Broil Element Wattages cavity 1 (W):	1750
Convection Element Wattages cavity 1 (W) :	1700
Microwave Wattages (W):	1000
LIDO	225960164
27 (47)	inless steel
Energy source :	Electric
Watts (W) :	7975
Current (A) :	40
Volts (V):	208-240
Frequency (Hz):	60
Approval certificates :	CSA
Power cord length (in):	50"
Power cord length (cm):	127
Appliance Dimensions (h x w x d) (cm): 124.4 x 7	75.5 x 62.2
Required cutout size (HxWxD) (in): 48 5/8" x 28 1/2" x	23 1/2"
Overall appliance dimensions (HxWxD) (in):	1609 9500
49" x 29 3/4"	x 24 1/2"
Overall appliance dimensions (HxWxD) (mm):	
	755 x 622
Product packaging dimensions (HxWxD) (in):	
55 3/4" x 34"	x 31 1/2"
Product packaging dimensions (HxWxD) (mm):	
1441 x	787 x 863
Net weight (lbs):	328
Net weight (kg):	148.768
Gross weight (lbs):	328
Gross weight (kg):	149.0



800 Series, Combination Oven, 30", Stainless steel HBL87M53UC

Bosch microwave combination ovens create an all-in-one cooking center with an upper speed oven and a Genuine European Convection oven below

Design

- Bosch wall ovens can be installed flush for a sleek timeless design, or proud for a more traditional look
- Touch control with SteelTouch™ buttons makes operating the oven easier
- Bosch wall ovens are compatible with most existing cutouts

Performance

- Lower oven's convection multi-rack mode gives uniform baking results even when using all 3 racks simultaneously
- Family or guests late to dinner? Keep food warm in the lower oven without overcooking until ready to serve by using the warm mode
- Lower oven's proof mode maintains a low temperature to proof yeast doughs for an even and faster rise compared to being left on the countertop
- Closed-door broiling prevents intense heat from escaping the lower oven - offering rich, even browning on tender cuts of meat and perfectly toasted casseroles
- Lower oven comes with 2 standard racks and 1 telescopic rack that gives easier accessibility for large or heavy dishes
- Dampened hinges softly guide the lower oven's QuietClose door shut. It's premium engineering that you'll appreciate each time you close your oven

Efficiency

 Download Bosch Home Connect application and control the lower wall oven with your smart phone or tablet

Convenience


- 1 light in the upper microwave and 2 lights in the lower oven gives visibility in the cavity so you can see the cooking progress
- Large oven window lets you monitor the cooking progress without opening the oven door to maintain a consistent oven temperature
- Keep your home safe by avoiding accidental or unsupervised use of your wall oven with the panel lock feature

Capacity


 With capacities of 1.6 cu. ft upper microwave and 4.6 cu. ft. lower oven allows enough space to cook everyday meals or for a crowd




800 Series, Combination Oven, 30", Stainless steel HBL87M53UC

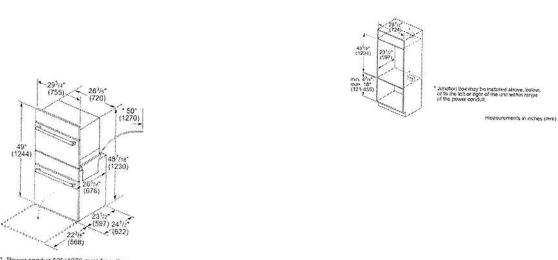

* Power conduit 50" (1270 mm) from the lower oven.

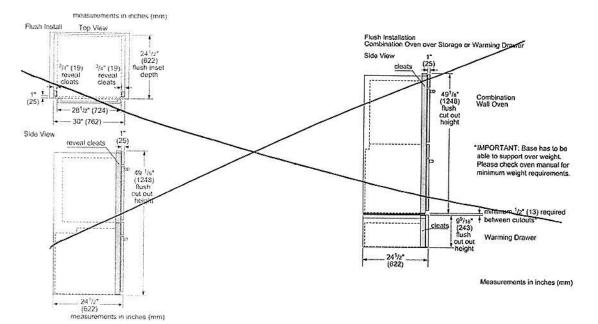

Standard Installation Combination Oven over Storage or Warming Drawer

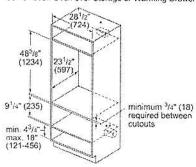

- *Wall oven junction box may be located above or right or left of the unit within reach of the power conduit.
- **Electrical hook up may be focated below (depending on space) or next to the drawer within the reach of the power cord.

FRIGIDAIRE GALLERY

FGIC3666TB

and books


AVAILABLE COLORS




SIGNATURE FEATURES




Amazingly Fast Get amazingly fast heat with induction that boils water 50% faster than an electric cooktop.¹

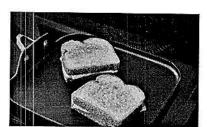

Even Heat
Whip up delicious meals with induction
that delivers incredibly even heat across the
surface of the pan so you get golden results
even time.

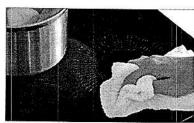

Easy To Clean
Don't stress over spills with induction's
easy-to-clean surface that generates heat
only to your pan, not your cooktop, meaning
spills can't burn onto the surface.

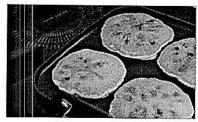

Auto Sizing™ Pan Detection
Make fluffy pancakes with ease using Auto
Sizing™ Pan Detection that automatically
senses the size of your pan to only send heat
to whatever small, medium, or large pan you
are using.

BUILT-IN COOKTOP 36" INDUCTION

PRODUCT DIMENSIONS

Width	36-3/4"
Depth	21-1/2"
Height	4-3/8"

MORE EASY-TO-USE FEATURES

True Temperature Melt & Hold Get perfectly melted goodness with True Temperature Melt & Hold that delivers low, precise heat for melting delicate ingredients or sauces without scorching or burning for up to one hour

Temperature Precision

Sear steaks, crisp sandwiches, melt chocolate, or simmer sauces with the precise temperature control of induction.

Safe Surface

The Safe Surface — Induction only heats pans and the food in them: the area around the pans stays cool to the touch.

Energy Efficiency

Since induction only heats your cookware and not your kitchen, less energy is lost throughout the cooking process.

Cooktop Timer

Use the built-in timer function to set a specified amount of time you want items to cook.

Cookware Compatibility

Most stainless steel and cast iron cookware is compatible with induction elements. An easy rule of thumb: if a magnet sticks to the bottom of the cookware, it's induction-friendly.

CERTIFICATIONS

A.D.A.-Compliant

When properly installed, this model is A.D.A.-qualified based on the United States Access Board's A.D.A./A.B.A. Accessibility Guidelines and the Department of Justice's 2010 A.D.A. Standards for Accessible Design.

110" induction center element, 6 qt/10" diameter Ali-Clad" pot, 1 qt. teoid water compared to Frigidaire" 9" (3000W) electric right-front element.

ELEMENTS	SIZE	WATTS
Right Front	Induction 8"	2,300/3,200
Right Rear	Induction 7"	1,800/2,600
Center	Induction 10"	2,500/3,800
Left Front	Induction 8"	2,300/3,200
Left Rear	Induction 7"	1,800/2,600

frigidaire.com / frigidaire.ca

FGIC3666TB **BUILT-IN COOKTOP**

36" INDUCTION


FRIGIDAIRE GALLERY.

EΑ			

FEATURES	
Controls	Glass-Touch
Surface Type	Black Ceramic Glass
Right Front Element (Watts)	8" - 2,300/3,200
Right Rear Element (Watts)	7" - 1,800/2,600
Center Element (Watts)	10" - 2,500/3,800
Left Front Element (Watts)	8" - 2,300/3,200
Left Rear Element (Watts)	7" - 1,800/2,600
Hot Surface Indicators	Yes
Control Location	Center Front
Knob Calor	
Knob Type	
CERTIFICATIONS	
A.D.A. Compliant ¹	Yes
SPECIFICATIONS	
Power Supply Connection Location	Right Rear
Voltage Rating	240V/208V/60Hz
Connected Load (kW Rating) @ 240/208 Volts²	9.6/8.3
Amps @ 240/208 Volts	45.0/45.2
Minimum Circuit Required (Amps)	40
Approved for Electric Single Wall Oven Combination Installation ³	Yes
Shipping Weight (Approx.)	54 Lbs.
1146	

When properly installed, this model is A.D.A. quelified based on the United States Access Board's A.D.A./A.B.A. Accessibility Guidelines and the Department of Justice's 2010 A.D.A. Standard's for Accessible Design "Single phase 3 or 4-wire cable, 120/240 or 120/208 Volt, 60 Hertz AC only electrical supply with ground required on separate circuit fused on both sides of line. "Cooktops are approved for installation above any of our Electric Single Wall Ovens.


A-Width	36-3/4"
B-Depth	21-1/2"
C-Height	4-3/8"
CUTOUT DIMENSIONS	
Width (Min, - Max.)	33-7/8"-36-1/8"
Depth (MinMax.)	19-1/8"-20-1/2"
Height	4-1/2"

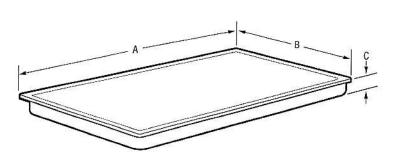



Note: For planning purposes only. Always consult local and national electric, gas and plumbing codes.

Refer to Product Installation Guide for detailed installation instructions on the web at frigidaire.com / frigidaire.ca Specifications subject to change. Accessories information available on the web at frigidaire.com / frigidaire.ca

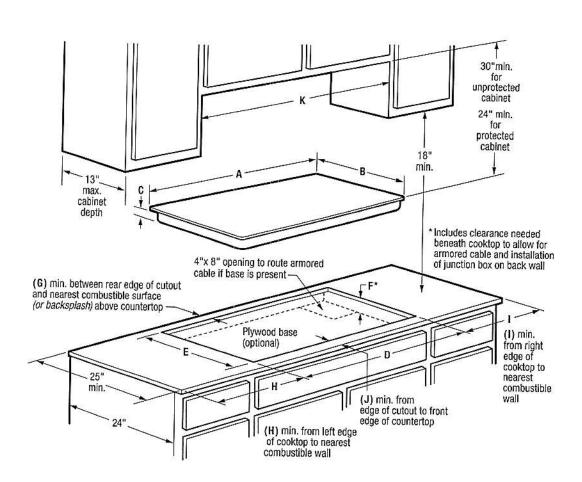

A-Width	36-3/4
B-Depth	21-1/2"
C-Height	4-3/8"
CUTOUT DIMENS	SIONS
D-Width (Min.) (Max.)	33-7/8" 36-1/8"
E-Depth (Min.) (Max.)	19 - 1/8" 20-1/2"
F-Height (Min.)*	4-1/2"
REQUIRED CLEA	RANCES
G-(Min.)	1-1/2"
H-(Min.)	2"
I-(Min.)	2"
J-(Min.)	2-1/2"
K-Cabinet Opening Width (Min.)	36"
UTILITY CONNEC	TION
Power Supply	Right Rear

INSTALLATION SPECIFICATIONS

- Product Shipping Weight (approx.) 54 Lbs.
- Single phase 3- or 4-wire cable, 120/240 or 120/208 Volt, 60 Hertz AC only electrical supply with ground required on separate circuit fused on both sides of line.
- Connected Load (kW Rating) @ 240/208 Volts = 9.6/8.3kW
- Amps @ 240/208 Volts = 45.0/45.2 Amps
 Recommended Circuit Breaker 40 Amps
- Always consult local and national electric codes.
- Cooktop cutout height includes clearance needed beneath cooktop to allow for armored cable and installation of junction box on back wall. Position center of junction box 10" inward from right side of cooktop cutout, and 12" down from underside of countertop.
- Overhead cabinetry should not exceed a 13" maximum depth.
- Absolute minimum horizontal distance between overhead cabinets installed to either side of appliance must be no less than 36".
- Allow 30" minimum clearance between top of cooktop platform and bottom Allow 30" minimum clearance between top of cooktop platform and bottom of unprotected wood or metal overhead cabinet; or 24" minimum clearance when bottom of wood or metal overhead cabinet is protected by not less than 1/8" flame-retardant millboard covered with not less than No. 28 MGS sheet steel, 0.015" stainless steel, 0.024" aluminum or 0.020" copper.

- Allow 2" minimum clearance between rear edge of cutout and nearest combustible surface (or backsplash) above countertop.
- Allow 2" minimum required clearance from left edge of cooktop to nearest combustible wall and 2" minimum from right edge of cooktop to nearest combustible wall.
- Installation of drawer not recommended beneath cooktop.
- To reduce risk of fire when using overhead cabinetry, install range hood that projects horizontally a recommended minimum of 5" beyond bottom of cabinets.
- Electric Built-In Cooktop model FGIC3666T is approved to be used over any Frigidaire* Electric Single Wall Oven. (Refer to Electric Cooktop Installation Over 30"/27" Electric Single Wall Oven Specifications page on web.)

OPTIONAL ACCESSORIES

· Granite Countertop Installation Kit - (PN # 903061-9010).



Note: For planning purposes only. Always consult local and national electric, gas and plumbing codes. Refer to Product Installation Guide for detailed installation instructions on the web at frigidaire.com / frigidaire.ca. ns subject to change. Accessories information available on the web at frigidaire.com / frigidaire.ca