



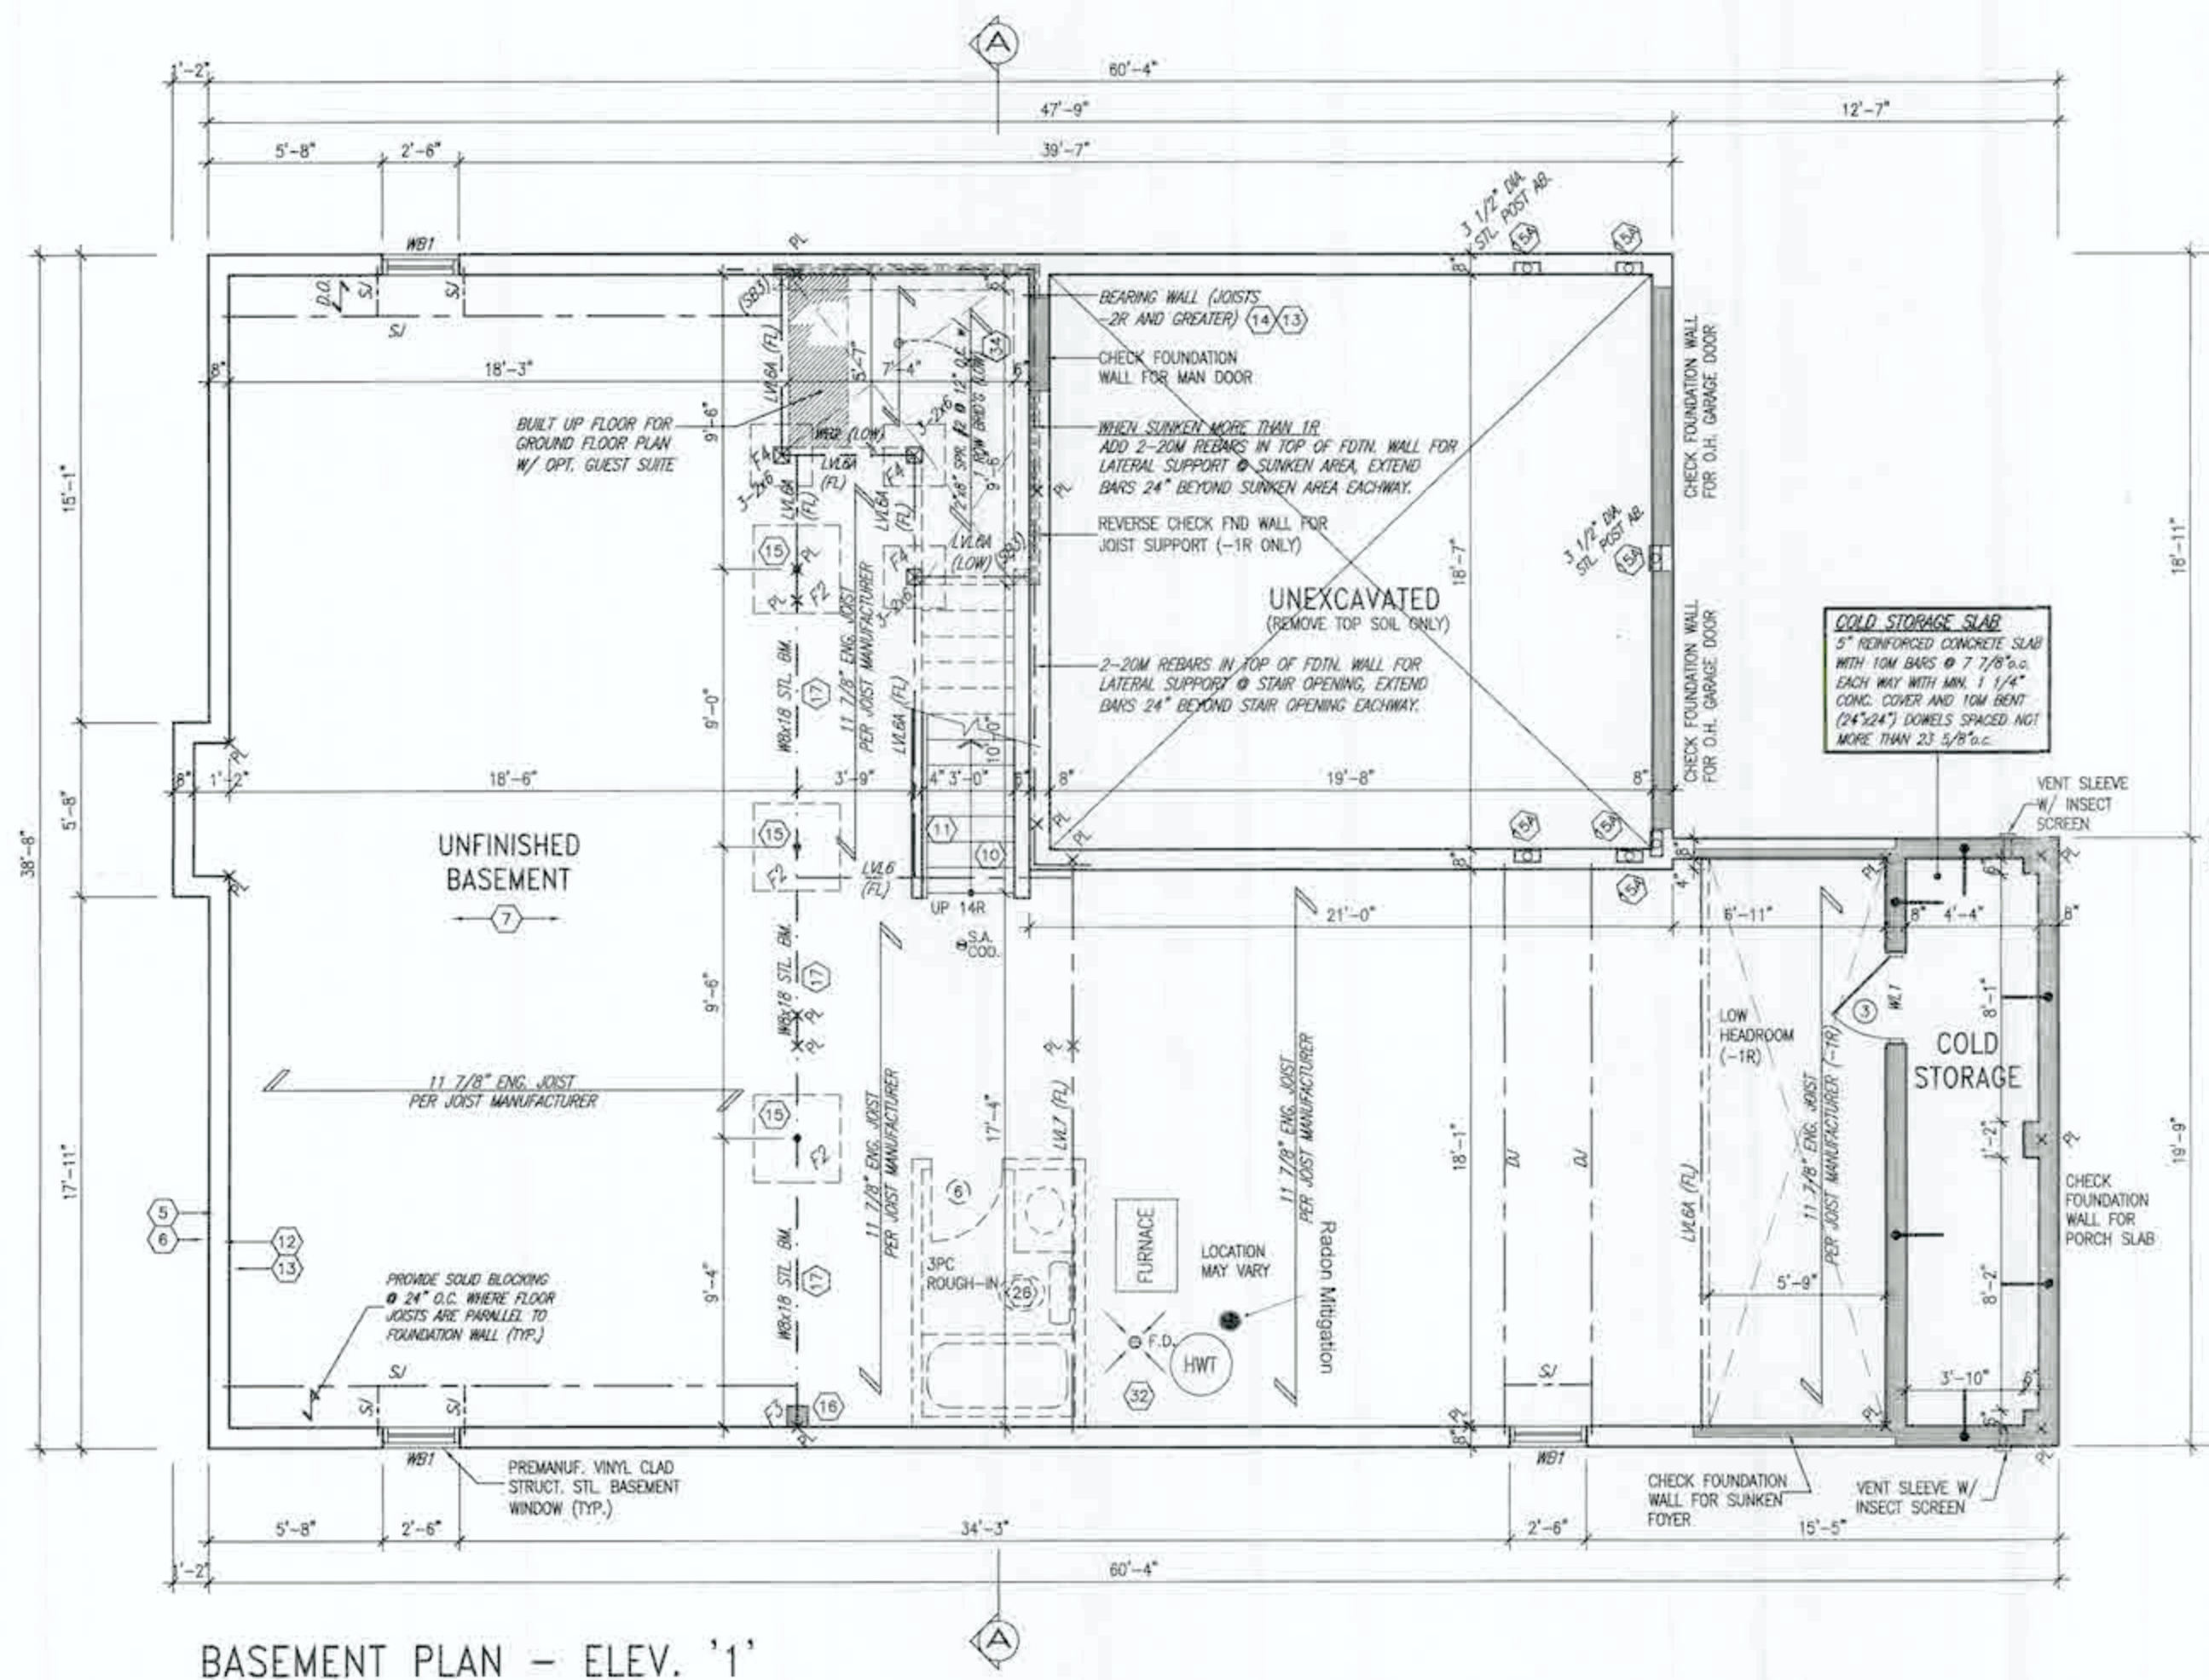

BASEMENT PLAN - ELEV. '1'

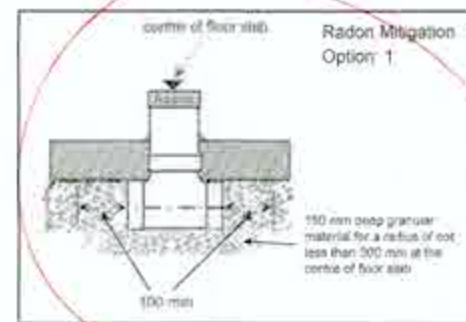

See Brochure

It is the builder's complete responsibility to ensure that all plans submitted for approval fully comply with the Architectural Guidelines and all applicable regulations and requirements including zoning provisions and any provisions in the subdivision agreement. The Control Architect is not responsible in any way for examining or approving site (lotting) plans or working drawings with respect to any zoning or building code or permit matter or that any house can be properly built or located on its lot.

This is to certify that these plans comply with the applicable Architectural Design Guidelines approved by the City of HAMILTON

KEVIN G. WILLIAMS LTD., ARCHITECTS
ARCHITECTURAL CONTROL, REVIEW
AND APPROVAL

APPROVED BY: 

DATE: AUG 27, 2021

Print date, owner's responsibility and the approval
Design Submittal only will require a further
signature and responsibility.



STRUDET INC.
FOR STRUCTURE ONLY

[illegible]

All drawings specifications, related documents and design are the copyright property of VAS DESIGN. Reproduction of this property in whole or in part is strictly prohibited without VAS DESIGN's written permission.

CITY OF HAMILTON
Building Division

Permit No. 21-150084

THESE STAMPED DRAWINGS SHALL BE AVAILABLE ON SITE
THE OWNER AND/OR CONTRACTOR SHALL COMPLY WITH
THE ONTARIO BUILDING CODE AND ALL OTHER APPLICABLE LAW


These drawings and/or specifications have been reviewed by

 OCT 4/21



SPRINGFIELD 2
COMPLIANCE PACKAGE 'A1'

 Greenpark.		SPRINGFIELD 2 14.30m	
project name RUSSELL GARDENS PH. 4	municipality HAMILTON, ON.	project no. 20027	
date FEB 2021	checked by 3/16" = 1'-0"		scale 20027-SPRINGFIELD-2
title 10.00M	drawing no. 20027-SPRINGFIELD-2		sheet no. A1

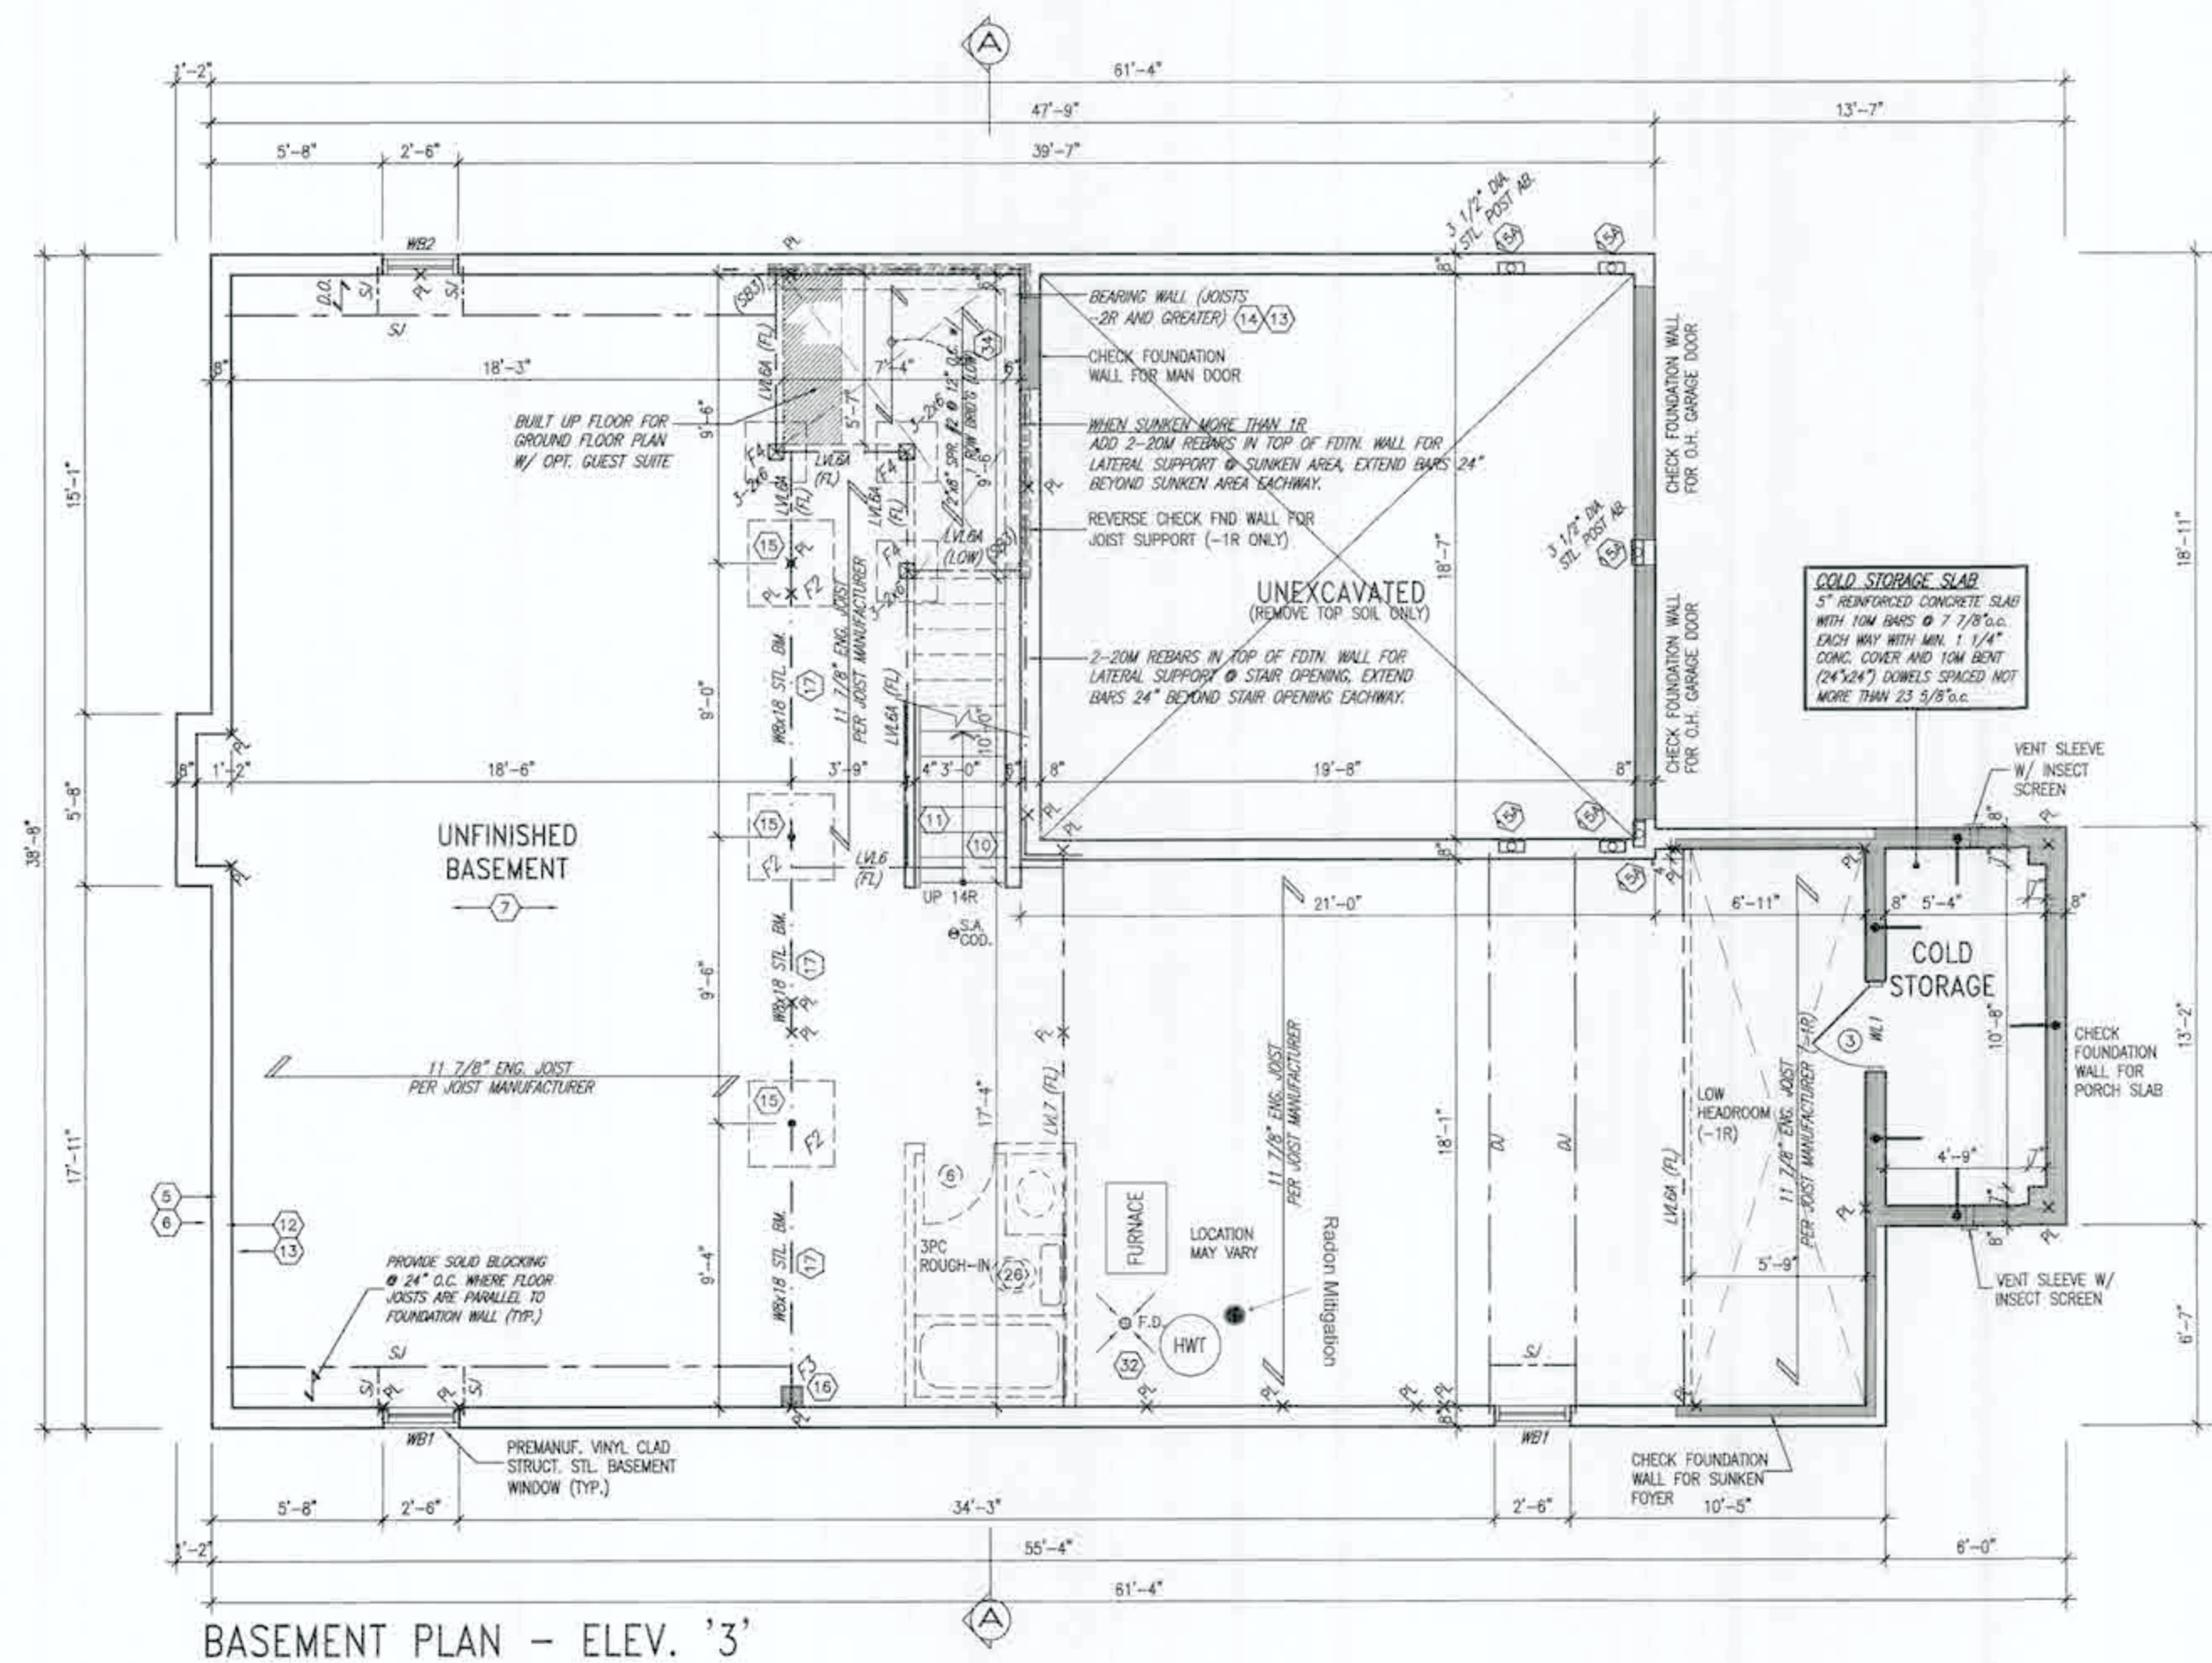

BASEMENT PLAN - ELEV. '3'

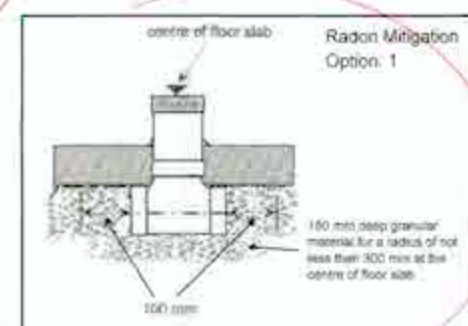

See Brochure

It is the builder's complete responsibility to ensure that all plans submitted for approval fully comply with the Architectural Guidelines and all applicable regulations and requirements including zoning provisions and any provisions in the subdivision agreement. The Control Architect is not responsible in any way for examining or approving site (lotting) plans or working drawings with respect to any zoning or building codes or permit matter or that any house can be properly built or located on its lot.

This is to certify that these plans comply with the applicable Architectural Design Guidelines approved by the City of Hamilton.

JOHN G. WILLIAMS LTD., ARCHITECT



CITY OF HAMILTON
Building Division
Permit No. 21-150554
THESE STAMPED DRAWINGS SHALL BE AVAILABLE ON SITE
THE OWNER AND/OR CONTRACTOR SHALL COMPLY WITH
THE ONTARIO BUILDING CODE AND ALL OTHER APPLICABLE LAW
These drawings and/or specifications have been reviewed by
[Signature] DATE: 5/2/21
FOR CHIEF BUILDING OFFICIAL

SPRINGFIELD 2
COMPLIANCE PACKAGE 'A1'

18	17	16	15	14	13	12	11	10	9	8	7	6	5	4	3	2	1	0	1	2	
																		The undersigned has prepared and takes responsibility for this design and has the qualifications and meets the requirements set out in the Ontario Building Code to be a Designer. qualification information Richard Vink 244805 name signature registration information VAS Design Inc. 42650 MAY 21/21 ON 2 REV. PER CLIENT/ROOF/PL/ENG. COMMENTS APR 22/21 ON 1 PRELIMINARY. ISSUED FOR CLIENT REVIEW FEB 19/21 ON description status by description status by																		VAS3 DESIGN 255 Consumers Rd Suite 120 Toronto, ON M2H 1A8 416-522-2222 / 416-522-4782 v3design.com																		Greenpark. 14.30m project name RUSSELL GARDENS PH. 4 municipality HAMILTON, ON. project no. 20027 date FEB 2021 drawing no. BASEMENT PLAN - ELEV. '3' drawn by BD checked by RV scale 3/16" = 1'-0" project 20027 - SPRINGFIELD-2 ISSUED FOR CLIENT REVIEW FEB 19/21 ON																		A1b	

[illegible]

FIREBLOCK BULKHEADS

16				9		
17				8		
16				7		
15				6		
14				5		
13				4		
12				3	ISSUED FOR PERMIT	MAY 21/21
11				2	REV PER CLIENT/ROOF FL/ENG COMMENTS	APR 27/21
10				1	PRELIMINARY ISSUED FOR CLIENT REVIEW	FEB 19/21
no	description	date	by	no	description	date

The undersigned has reviewed and takes responsibility for this design and has the qualifications and meets the requirements set out in the Ontario Building Code to be a Designer:	
Qualification Information:	
Richard Vink	244
Signature Information:	
VAS Design Inc.	426

VA3
DESIGN
255 Consumers Rd Suite
Toronto ON M2J 1R4
416.630.2255 f 416.630.4
va3design.com

 Greenpark.		SPRINGFIELD 2 14.30m	
project name RUSSELL GARDENS PH. 4		municipality HAMILTON, ON.	
date FEB 2021		project no. 20027	
drawn by SD 53M		drawing no. A2	
checked by 3/16" = 1'-0"		title GROUND FLOOR PLAN — ELEV. '1'	
scale 20027-SPRINGFIELD-2		date MAY 20 2021	

CITY OF HAMILTON
Building Division

Permit No. 21-15088 L

THESE STAMPED DRAWINGS SHALL BE AVAILABLE ON SITE


THE OWNER AND/OR CONTRACTOR SHALL COMPLY WITH
THE ONTARIO BUILDING CODE AND ALL OTHER APPLICABLE LAW

These drawings and/or specifications have been reviewed by


 OCT 04, 2021

FOR CHIEF BUILDING OFFICIAL DATE

SPRINGFIELD 2
COMPLIANCE PACKAGE 'A1'

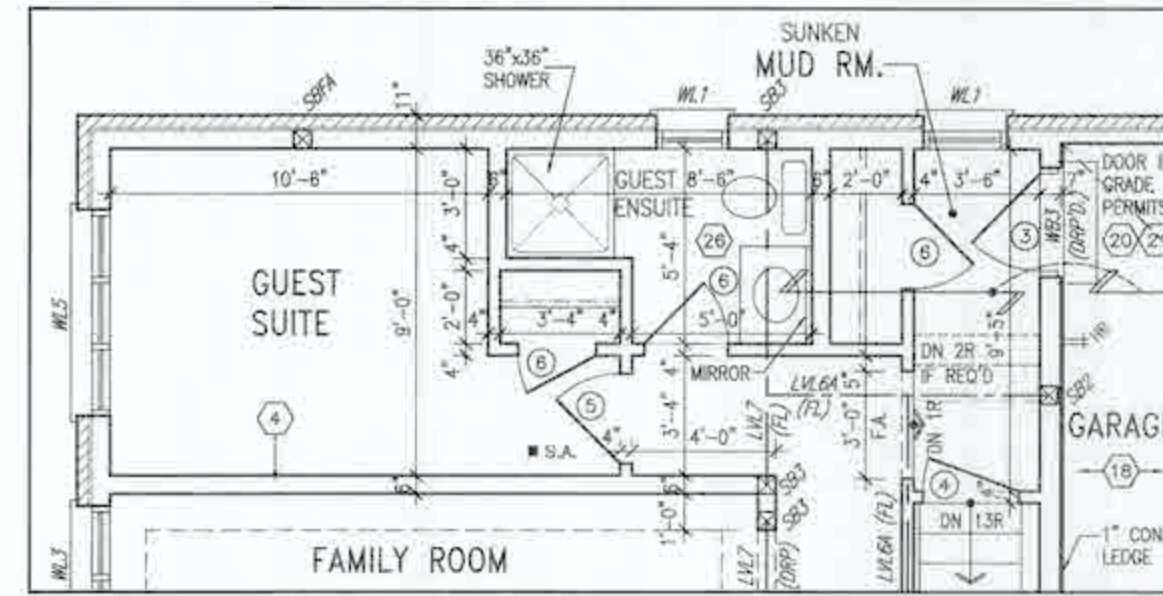

PART. GROUND FLOOR PLAN - ELEV. '2'
W/ OPT. GUEST SUITE

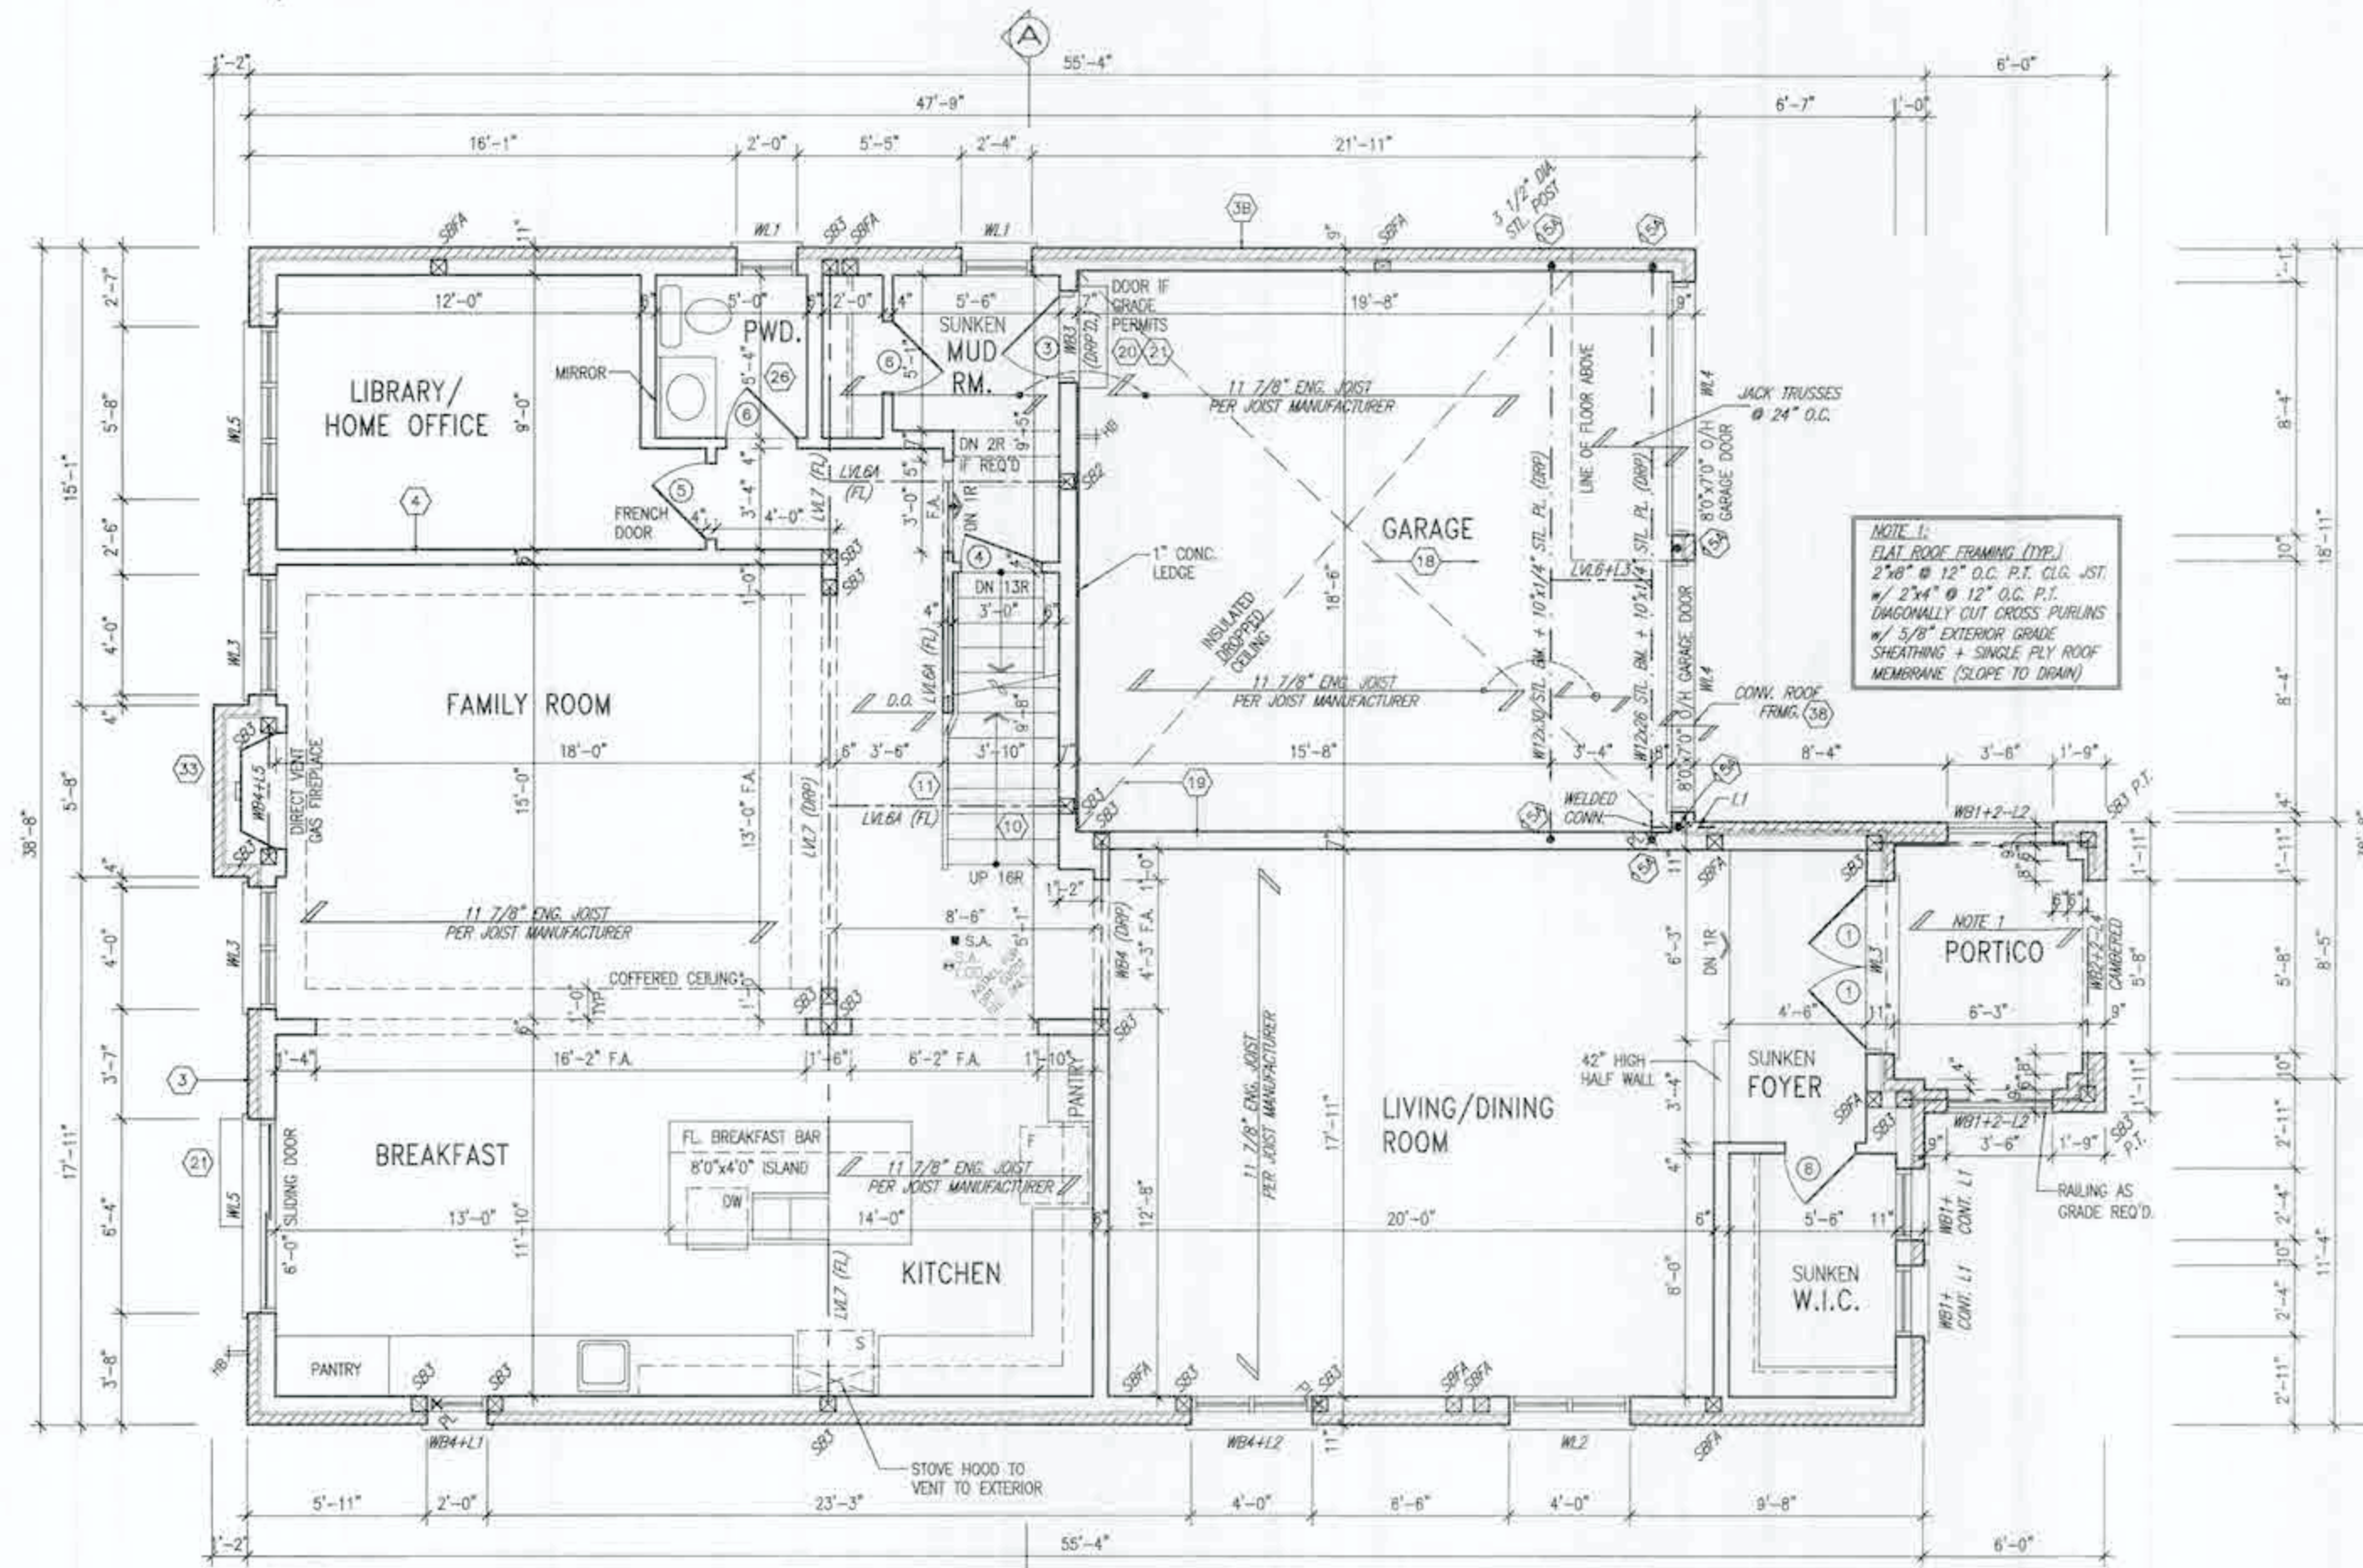

GROUND FLOOR PLAN - ELEV. '2'

**FIREBLOCK
BULKHEADS**

CITY OF HAMILTON
Building Division

Permit No. **21-150884**

THESE STAMPED DRAWINGS SHALL BE AVAILABLE ON SITE
THE OWNER AND/OR CONTRACTOR SHALL COMPLY WITH
THE ONTARIO BUILDING CODE AND ALL OTHER APPLICABLE LAW

These drawings and specifications have been reviewed by
OCT 04 2021
FOR CHIEF BUILDING OFFICIAL DATE

SPRINGFIELD 2
COMPLIANCE PACKAGE 'A1'

---	---	---	---	---	---

It is the builder's complete responsibility to ensure that all plans submitted for approval fully comply with the Architectural Guidelines and all applicable regulations and requirements including zoning provisions and any provisions in the subdivision agreement. The Control Architect is not responsible in any way for examining or approving site (lotting) plans or working drawings with respect to any zoning or building code or permit matter or that any house can be properly built or placed on its lot.

This is to certify that these plans comply with the applicable Architectural Design Guidelines approved by the City of HAMILTON.

WILLIAM C. WILLIAMS LTD., ARCHITECT
ARCHITECTURAL CONTROL OFFICE
480 EPPING RD.
SCARBOROUGH, ONTARIO M1V 4Y1
Tel: 416-291-1111
Fax: 416-291-1112
www.williamsdesign.com

REGISTERED PROFESSIONAL ENGINEER
B. MARINKOVIC
MAY 2021
STRUDET INC.
FOR STRUCTURE ONLY

VAS DESIGN


Greenpark.

SPRINGFIELD 2
14.30m

project name: **RUSSELL GARDENS PH. 4** location: **HAMILTON, ON.** project no: **20027**

date: **FEB 2021** checked by: **3/16" = 1'-0"** scale: **20027-SPRINGFIELD-2** drawing no: **A2a**

NOTE: 1- CANOPY FLAT ROOF CONSTRUCTION
ONE PLY WATERPROOF MEMBRANE (DURADEK) ADHERED
TO EXT. FLYE 5/8" X 8" PLYWOOD SHEATHING OVER
2"x6" FRAMING OVER ENGINEERED FLOOR JOISTS.
SLOPE TO EXTERIOR WITH WOOD SLEEPERS, PREFIN.
METAL CAP & FLASHING (WITH Drip EDGE), EXTERIOR
FINISH AND HEIGHT PER UNIT DWGS.

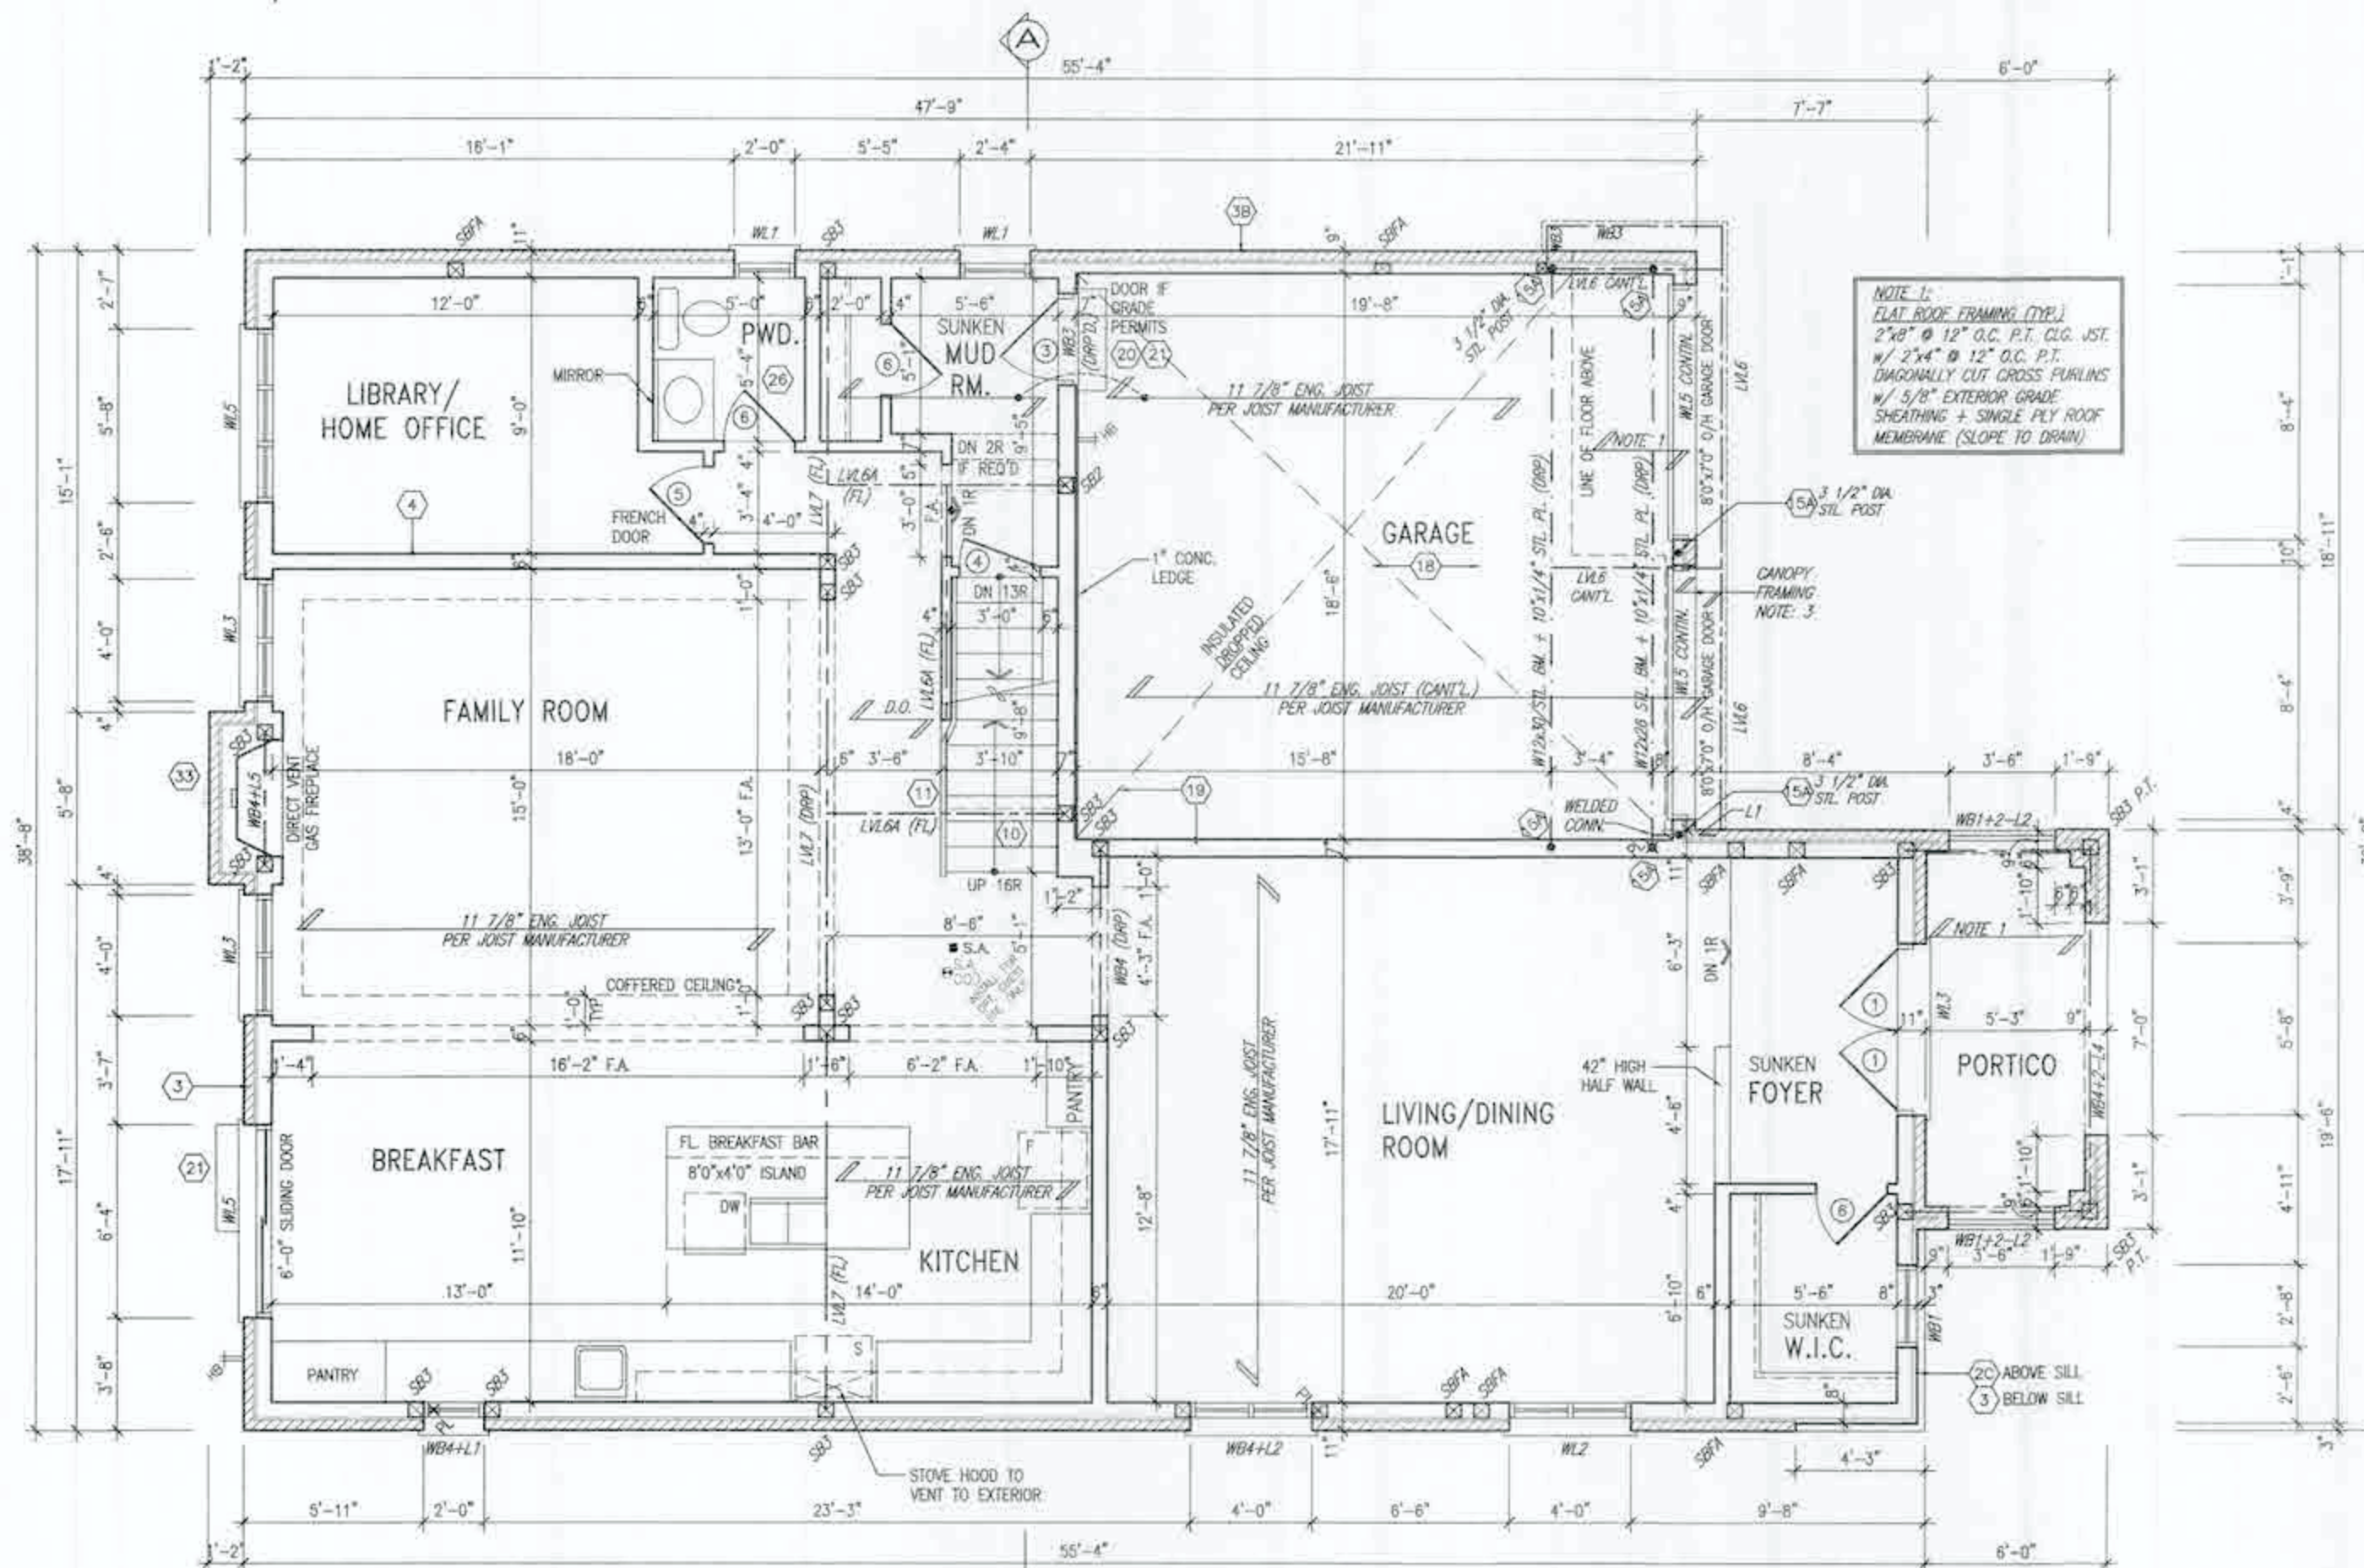


FIREBLACK BULKHEADS




 MAY 26 2021

STRUDET INC.
 FOR STRUCTURE ONLY

 Greenpark.		SPRINGFIELD 2 14.30m	
project name	RUSSELL GARDENS PH. 4	municipality	HAMILTON, ON.
year	FEB 2021	drawing title	GROUND FLOOR PLAN - ELEV. '3'
drawn by	BD SEM	checked by	BD SEM
scale	3/16" = 1'-0"	file name	20027-SPRINGFIELD-2
			A2b

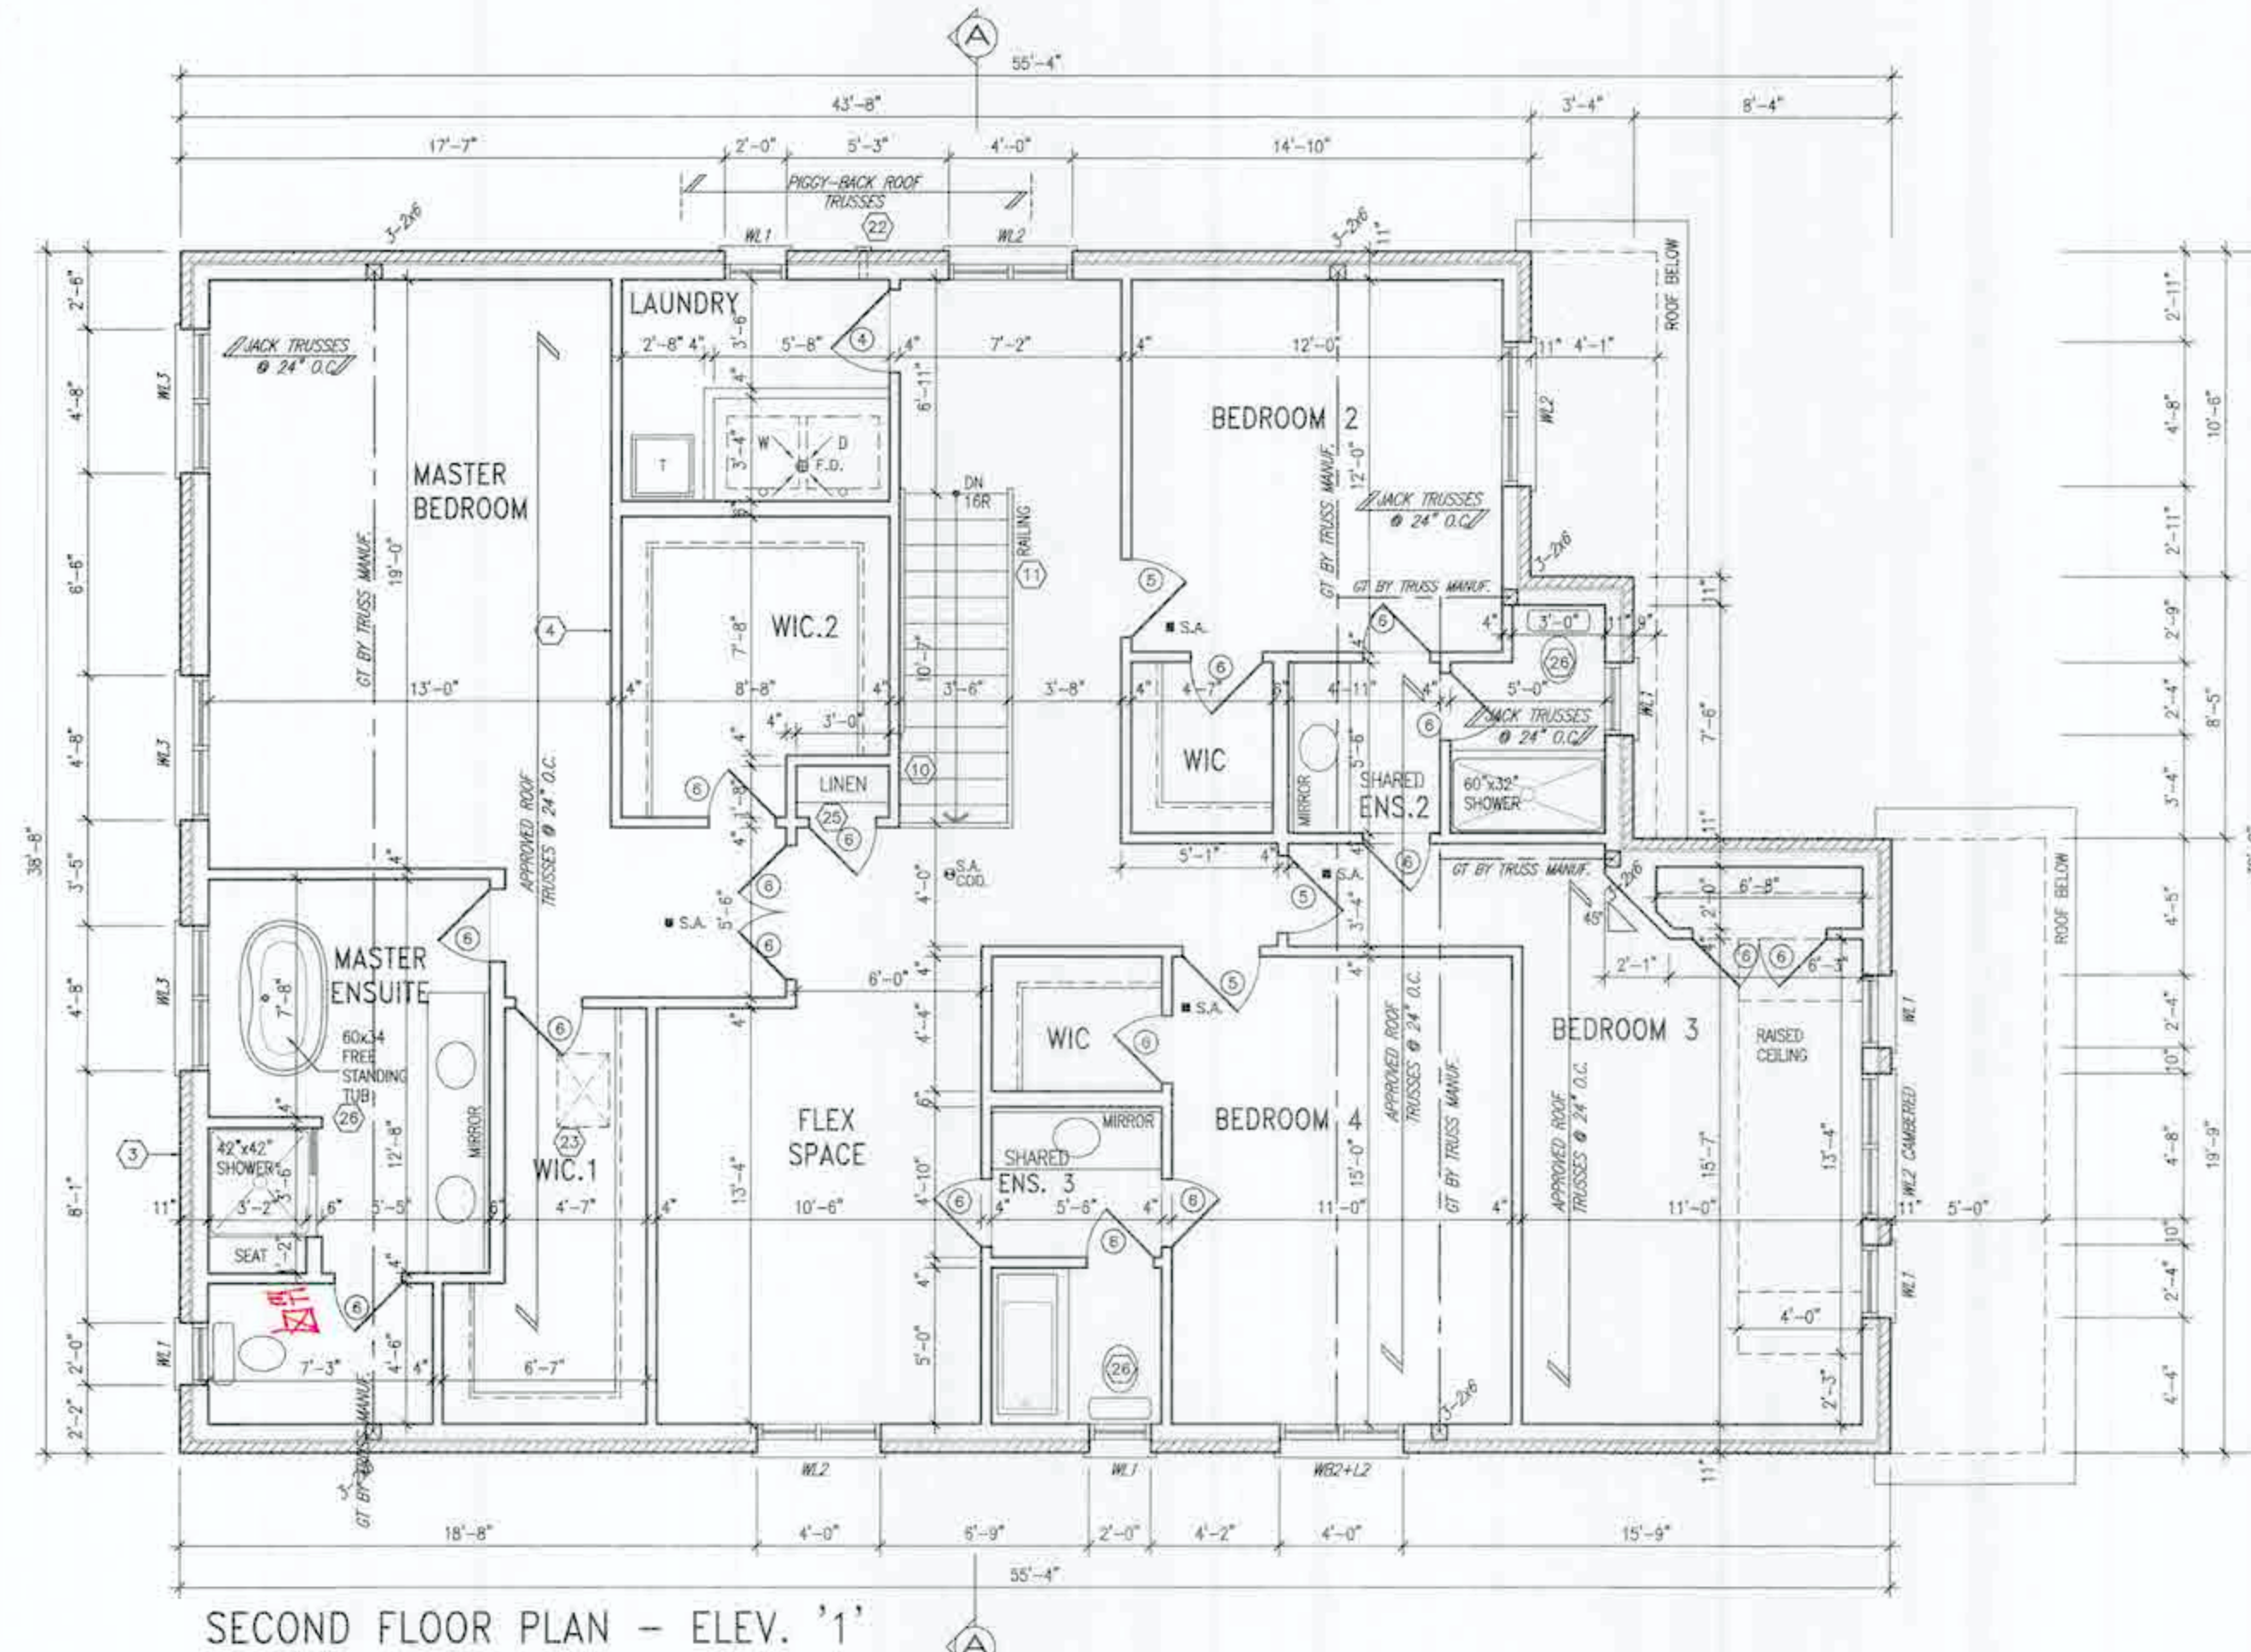

SECOND FLOOR PLAN - ELEV. '1'

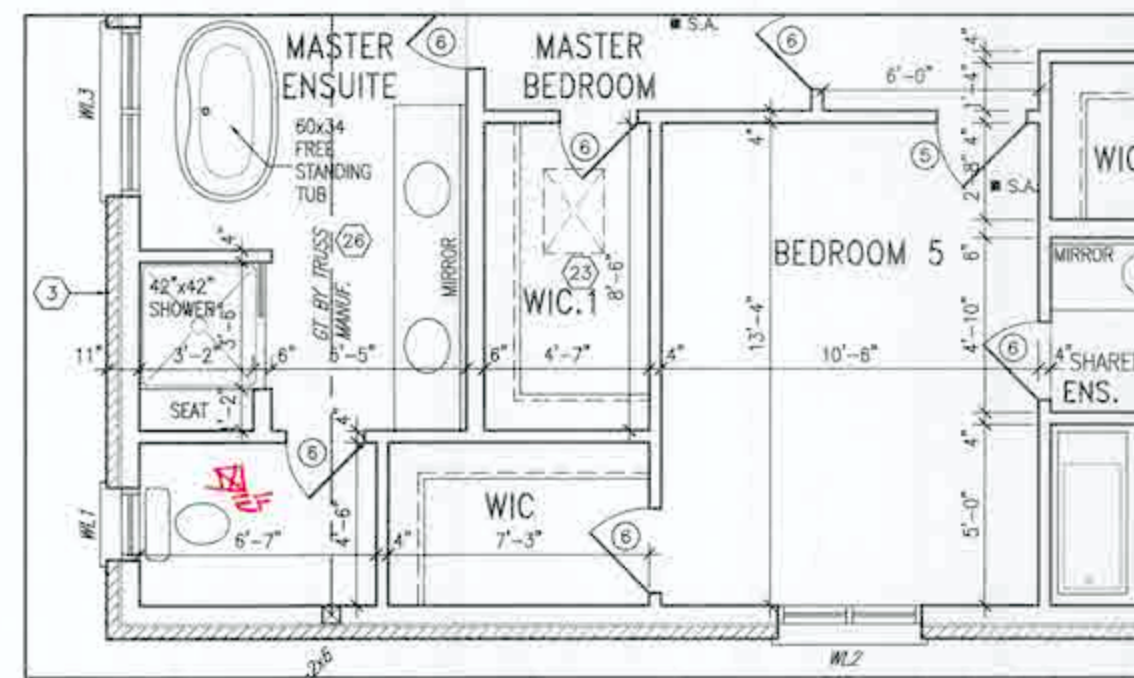PART. SECOND FLOOR PLAN - ELEV. '1'
W/ OPT. BEDROOM 5

GRAB BAR NOTE:
STUD WALL REINFORCEMENT FOR FUTURE GRAB BARS IN MAIN BATHROOM.
REINFORCEMENT OF STUD WALLS SHALL BE INSTALLED ADJACENT TO WATER CLOSETS AND SHOWER OR BATHTUB IN MAIN BATHROOM PER O.C. DIV. B-2.5.2.3. REFER TO FOLLOWING SECTIONS FOR THE FIXTURES LISTED: WATER CLOSET: 3.8.3.8(3)(c) & 3.8.3.8(3)(c); SHOWER: 3.8.3.13(2)(g); BATHTUB: 3.8.3.13(4)(g). FREE STANDING BATHTUB EXCLUDED. SEE DETAILS PROVIDED. (21-1017-1022) R.H.

It is the builder's complete responsibility to ensure that all plans submitted for approval fully comply with the Architectural Guidelines and all applicable regulations and requirements including zoning provisions and any provisions in the subdivision agreement. The Control Architect is not responsible in any way for examining or approving site (lotting) plans or working drawings with respect to any zoning or building code or permit matter or that any house can be properly built or located on its lot.

This is to certify that these plans comply with the applicable Architectural Design Guidelines approved by the City of Hamilton.



STRUDET INC.
FOR STRUCTURE ONLY

CITY OF HAMILTON
Building Division

Permit No. **21 150884**

THESE STAMPED DRAWINGS SHALL BE AVAILABLE ON SITE.
THE OWNER AND/OR CONTRACTOR SHALL COMPLY WITH THE ONTARIO BUILDING CODE AND ALL OTHER APPLICABLE LAW.

These drawings and/or specifications have been reviewed by:

OCT 04 2021
FOR CHIEF BUILDING OFFICIAL DATE

SPRINGFIELD 2
COMPLIANCE PACKAGE 'A1'


VAS
DESIGN

Greenpark

SPRINGFIELD 2
14.30m

Project name: **RUSSELL GARDENS PH. 4** Municipality: **HAMILTON, ON.** Project No: **20027**

Scale: **3/16" = 1'-0"** Date: **2022-SPRINGFIELD-2** Drawing No: **A3**

GRAB BAR NOTE:
STUD WALL REINFORCEMENT FOR FUTURE GRAB BARS IN MAIN BATHROOM
REINFORCEMENT OF STUD WALLS SHALL BE INSTALLED ADJACENT TO WATER CLOSETS AND SHOWER OR BATHTUB IN MAIN BATHROOM PER CBC, DIV. B-9.5.2.2. REFER TO FOLLOWING SECTIONS FOR THE FIXTURES LISTED: WATER CLOSET: 3.8.3.8.(3)(c) & 3.8.3.8.(3)(c); SHOWER 3.8.3.13.(2)(g); BATHTUB 3.8.3.13.(4)(g). FREE STANDING BATHTUB EXCLUDED. SEE DETAILS PROVIDED. (16-52161-1-2016)

This is to certify that these plans comply with the applicable Architectural Design Guidelines approved by the City of HAMM TON.

CITY OF HAMILTON
Building Division

Permit No. 21-150884

THESE STAMPED DRAWINGS SHALL BE AVAILABLE ON SITE
THE OWNER AND/OR CONTRACTOR SHALL COMPLY WITH
THE ONTARIO BUILDING CODE AND ALL OTHER APPLICABLE LAWS


These drawings and/or specifications have been reviewed by
THB **OCT 4 2021**




STRUDET INC.
FOR STRUCTURE ONLY

18				9	The undersigned has reviewed and takes responsibility for this design and has the qualifications and meets the requirements set out in the Ontario Building Code as a Designer.	 255 Consumers Rd Suite 120 Toronto, ON M2J 1L6 T 416.630.2265 / F 416.630.4782 va3design.com	 project name: RUSSELL GARDENS PH. 4	municipality: HAMILTON, ON.	project no.: 20027-SPRINGFIELD-2	drawing no.: A3a				
17			6	specification information	date: FEB 2021						revision by: BO RM	scale: 3/16" = 1'-0"	year: 20027-SPRINGFIELD-2	
16			5	Richard Vink										signature
15			4	24480										stamp
14			3	regulation information										VA3 Design Inc.
13			2	MAY 27/21										CW
12			1	ISSUED FOR PERMIT										
11			2	REV. PER CLIENT/HOOF/TL/CWG COMMENTS	APR 27/21	CW								
10			1	PRELIMINARY. ISSUED FOR CLIENT REVIEW	FEB 19/21	CW								
no.	description	date	by	no.	description	date	by							

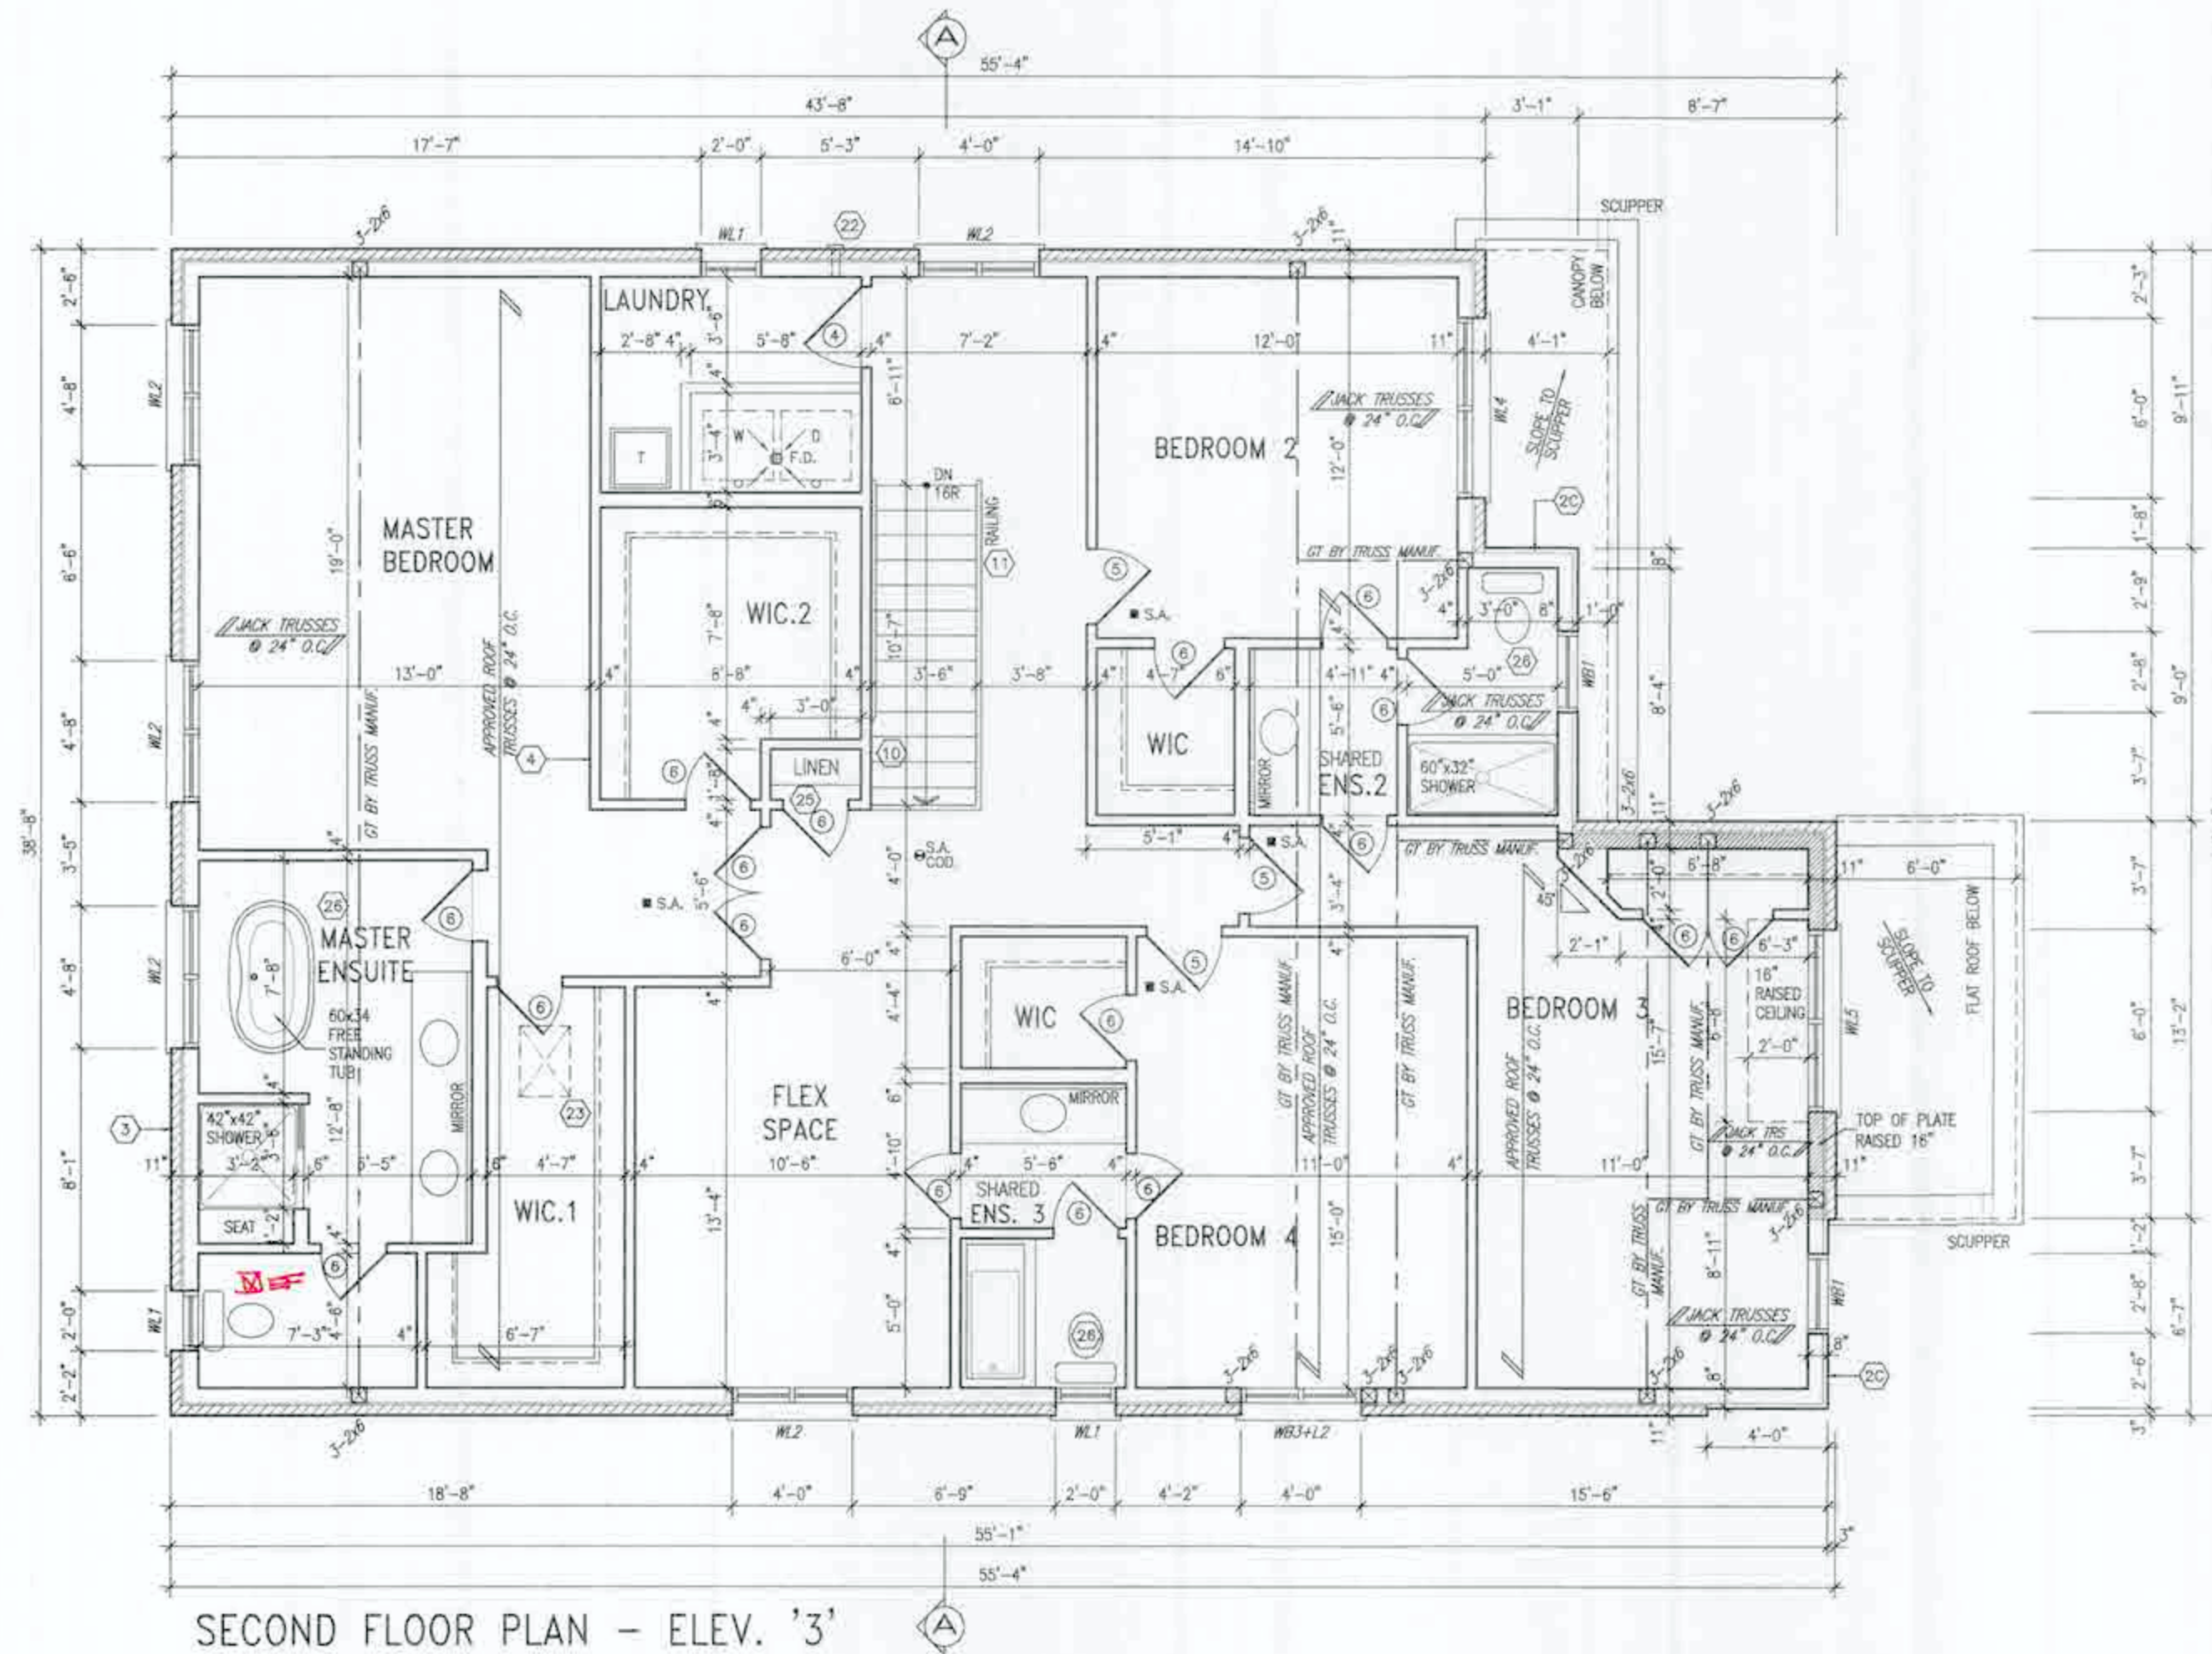

SECOND FLOOR PLAN - ELEV. '3'

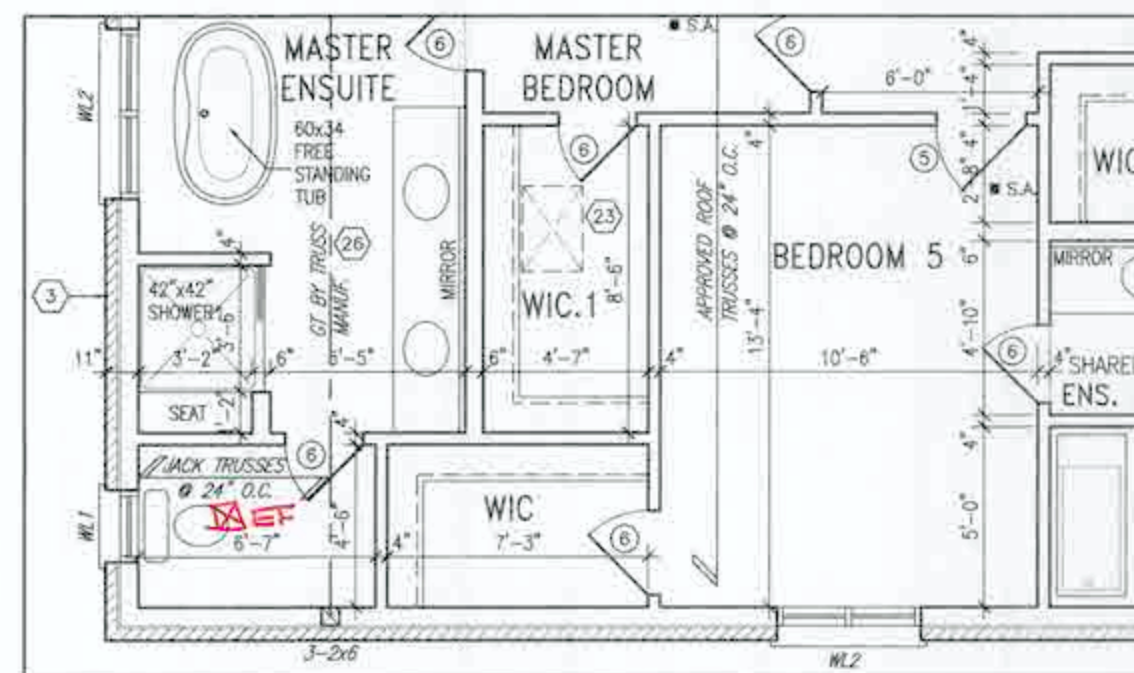

PART. SECOND FLOOR PLAN - ELEV. '3'
W/ OPT. BEDROOM 5

GRAB BAR NOTE:
STUD WALL REINFORCEMENT FOR FUTURE GRAB BARS IN MAIN BATHROOM.
REINFORCEMENT OF STUD WALLS SHALL BE INSTALLED ADJACENT TO WATER CLOSETS AND SHOWER OR BATHTUB IN MAIN BATHROOM PER OBC, DIV. 8-9.5.2.1 REFER TO FOLLOWING SECTIONS FOR THE FIXTURES LISTED: WATER CLOSET, J.B.3.8.3(3)(a) & J.B.3.8.3(3)(a) SHOWER, J.B.3.1.13(2)(a), BATHTUB, J.B.3.1.13(4)(a) FREE STANDING BATHTUB EXCLUDED. SEE DETAILS PROVIDED. (24-NOT-0000-004)

It is the builder's complete responsibility to ensure that all plans submitted for approval fully comply with the Architectural Guidelines and all applicable regulations and requirements including zoning provisions and any provisions in the subdivision agreement. The Control Architect is not responsible in any way for examining or approving site (setting) plans or working drawings with respect to any zoning or building code as permit holder or that any house can be properly built or located on its lot.

This is to certify that these plans comply with the applicable Architectural Design Guidelines approved by the City of Hamilton.



STRUDET INC.
FOR STRUCTURE ONLY

no.	description	date	by	no.	description	date	by
17				9			
16				8			
15				7			
14				6			
13				5			
12				4			
11				3	ISSUED FOR PERMIT	MAY 21/21	CM
10				2	REV. PER CLIENT/ROOF/PL/ENG. COMMENTS	APR 27/21	CM
9				1	PRELIMINARY ISSUED FOR CLIENT REVIEW	FEB 19/21	CM

The undersigned has reviewed and takes responsibility for this design and has the qualifications and meets the requirements set out in the Ontario Building Code to be a Designer.

qualification information
Richard Vink
signature
VAS Design Inc.
24488
42858

Contractor must verify all dimensions on the job and report any discrepancy to the Designer before proceeding with the work. All drawings and specifications are instruments of service and the property of the Designer which must be returned at the completion of the work. Drawings are not to be copied.

VAS DESIGN
250 Consumers Rd. Suite 120
Toronto, ON M2J 1R6
1-416-630-2255 / 416-630-4782
vasdesign.com

Greenpark. **SPRINGFIELD 2**
14.30m

project name: **RUSSELL GARDENS PH. 4** municipality: **HAMILTON, ON.** project no: **20027**

date: **FEB 2021** checked by: **3/16** scale: **1"=8'** SECOND FLOOR PLAN - ELEV. '3'
drawn by: **80.BM** 20027-SPRINGFIELD-2
drawing no: **A3b**

CITY OF HAMILTON
Building Division

Permit No. **21-150884**

THESE STAMPED DRAWINGS SHALL BE AVAILABLE ON SITE

THE OWNER AND/OR CONTRACTOR SHALL COMPLY WITH THE ONTARIO BUILDING CODE AND ALL OTHER APPLICABLE LAW




These drawings and/or specifications have been reviewed by

FOR CHIEF BUILDING OFFICIAL

OCT 04 2021
DATE

3550 SF.

ROOF PLAN - ELEV. '2'

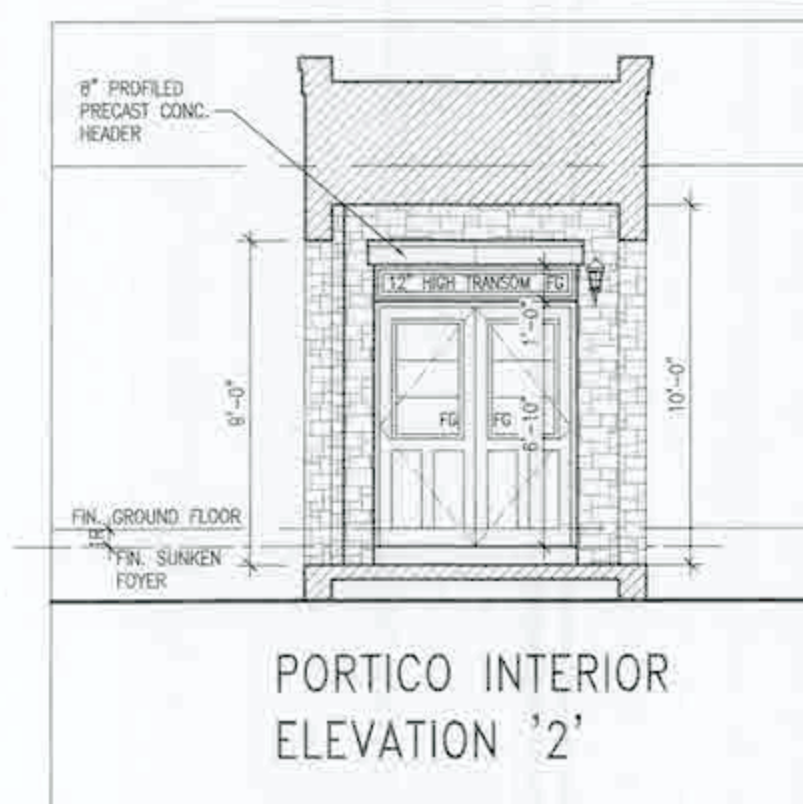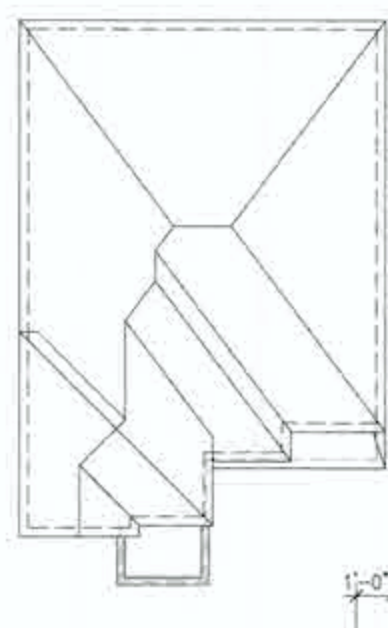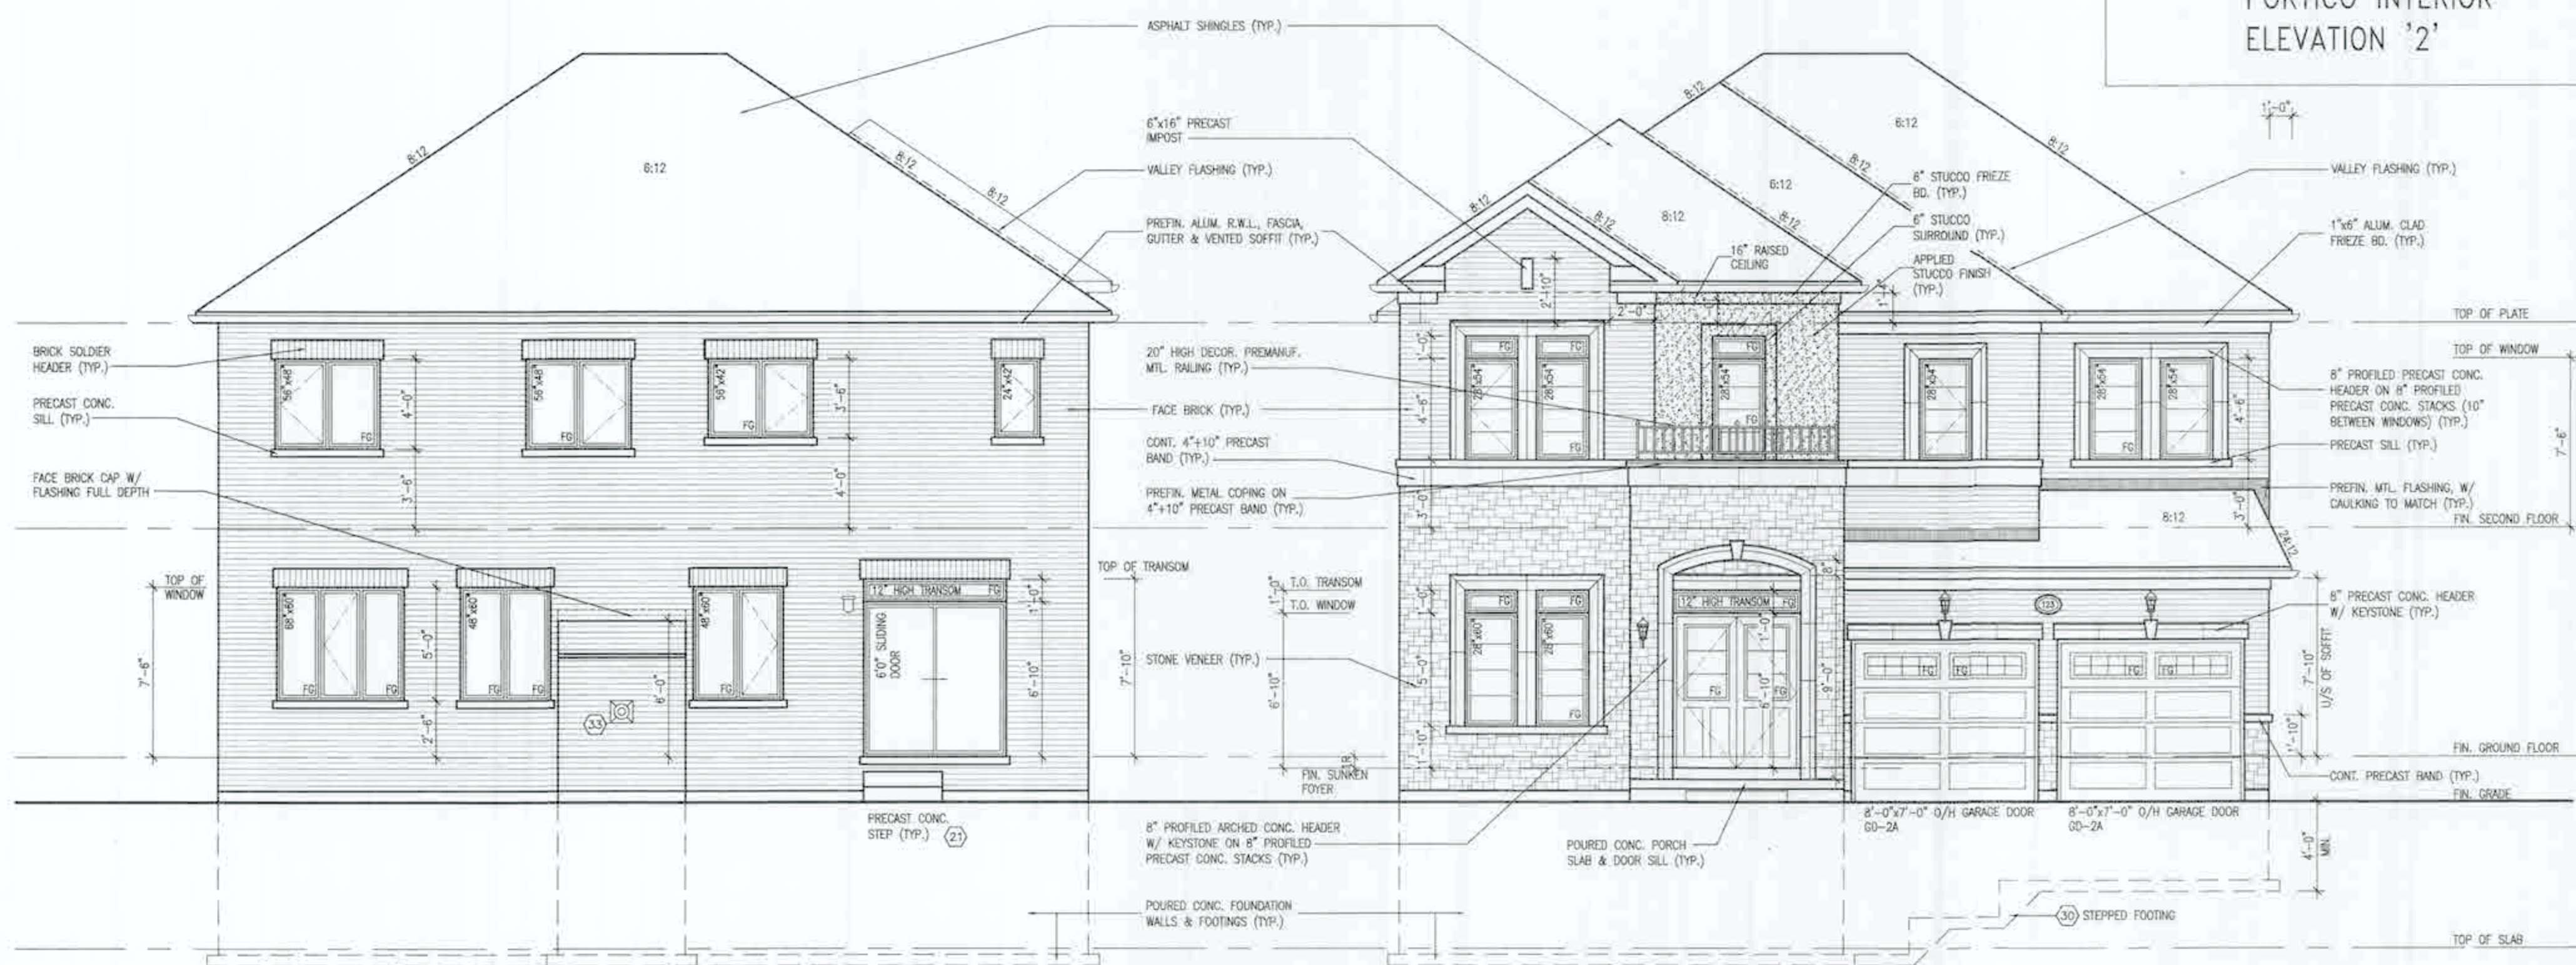PORTICO INTERIOR
ELEVATION '2'

REAR ELEVATION - ELEV. '2'

FRONT ELEVATION - ELEV. '2'

It is the builder's complete responsibility to ensure that all plans submitted for approval fully comply with the Architectural Guidelines and all applicable regulations and requirements including zoning provisions and any provisions in the subdivision agreement. The Control Architect is not responsible in any way for examining or approving site (lot) plans or working drawings with respect to any zoning or building code or permit matter or that any house can be properly built or located on its lot.

This is to certify that these plans comply with the applicable Architectural Design Guidelines approved by the City of Hamilton.

ARTHUR G. WILLIAMS LTD., ARCHITECT
ARCHITECTURAL CONTROL, HAMILTON
AND SURROUNDING
DATE: 2022.07.20

EXTERIOR RAILINGS:
3'-6" HIGH RAILING IF LANDING IS MORE THAN 5'-11" ABOVE FINISHED GRADE AND 3'-0" HIGH RAILING WHEN LANDING IS LESS THAN 5'-11" ABOVE ADJACENT FINISHED GRADE.

ELEVATIONS NOT DRAWN TO ACTUAL GRADE. REFER TO FINAL GRADING PLAN.

PORCH STEPS (TYP.)
PRECAST CONCRETE STEPS w/ MASONRY INSERTS WHERE GRADE REQUIRES.

18		9			
17		8			
16		7			
15		6			
14		5			
13		4			
12		3	ISSUED FOR PERMIT	MAY 21/21	GW
11		2	REV. PER CLIENT/ROOF/FL/ENG. COMMENTS	APR 27/21	GW
10		1	PRELIMINARY ISSUED FOR CLIENT REVIEW	FEB 16/21	GW
9					
8					
7					
6					
5					
4					
3					
2					
1					
0					
19					
20					
The undersigned has reviewed and takes responsibility for the design and has the qualifications and meets the requirements set out in the Ontario Building Code to be a Designer.
Signature: Richard Vink
Registration Number: 24488
Firm: VAS Design Inc.
Address: 255 Consumers Rd Suite 120, Toronto, ON M2J 1B4
Phone: 416.630.2255, 416.630.4782
Email: info@vasdesign.ca

VA3 DESIGN
255 Consumers Rd Suite 120
Toronto, ON M2J 1B4
416.630.2255 • 416.630.4782
info@vasdesign.ca

Greenpark **SPRINGFIELD 2**
14.30m
project name: RUSSELL GARDENS PH. 4
location: HAMILTON, ON.
date: FEB 2021
drawn by: BO.BIN
checked by: 3/16" = 1'-0"
scale: 20027-SPRINGFIELD-2
drawing no: A4a

CITY OF HAMILTON
Building Division

Permit No. 21-150884

THESE STAMPED DRAWINGS SHALL BE AVAILABLE ON SITE
THE OWNER AND/OR CONTRACTOR SHALL COMPLY WITH
THE ONTARIO BUILDING CODE AND ALL OTHER APPLICABLE LAWS

These drawings and/or specifications have been reviewed by
OCT 04 2021
FOR CHIEF BUILDING OFFICIAL

SPRINGFIELD 2
COMPLIANCE PACKAGE 'A1'

All drawings, specifications, related documents and design are the copyright property of VAS DESIGN. Reproduction of this property in whole or in part is strictly prohibited without VAS DESIGN's written permission.

3550 SF.

ROOF PLAN - ELEV. '3'



PORTICO INTERIOR ELEVATION '3'



REAR ELEVATION - ELEV. '3'

FRONT ELEVATION - ELEV. '3'

CITY OF HAMILTON
Building Division
Permit No. 21-150884
THESE STAMPED DRAWINGS SHALL BE AVAILABLE ON SITE
THE OWNER AND/OR CONTRACTOR SHALL COMPLY WITH
THE ONTARIO BUILDING CODE AND ALL OTHER APPLICABLE LAW
These drawings and/or specifications have been reviewed by
FOR CHIEF BUILDING OFFICIAL DATE
OCT 04 2021

SPRINGFIELD 2
COMPLIANCE PACKAGE 'A1'

It is the builder's complete responsibility to ensure that all plans submitted for approval fully comply with the Architectural Guidelines and all applicable regulations and requirements including zoning provisions and any provisions in the subdivision agreement. The Control Architect is not responsible in any way for examining or approving site (lot) plans or working drawings with respect to any zoning or building code or permit matter or that any house can be properly built or located on its lot.

This is to certify that these plans comply with the applicable Architectural Design Guidelines approved by the City of HAMILTON.

EXTERIOR RAILINGS:
3'-6" HIGH RAILING IF LANDING IS MORE THAN 5'-11" ABOVE FINISHED GRADE AND 3'-0" HIGH RAILING WHEN LANDING IS LESS THAN 5'-11" ABOVE ADJACENT FINISHED GRADE.

ELEVATIONS NOT DRAWN TO ACTUAL GRADE. REFER TO FINAL GRADING PLAN.

PORCH STEPS (TYP.)
PRECAST CONCRETE STEPS w/ MASONRY INSERTS WHERE GRADE REQUIRES.

18		9			
17		8			
16		7			
15		6			
14		5			
13		4			
12		3	ISSUED FOR PERMIT	MAY 21/21	GM
11		2	REV. PER CLIENT/BOF/PL/ENG COMMENTS	APR 27/21	GM
10		1	PRELIMINARY ISSUED FOR CLIENT REVIEW	FEB 19/21	GM
9					
8					
7					
6					
5					
4					
3					
2					
1					
0					


The undersigned has reviewed and takes responsibility for this design and has the qualifications and meets the requirements set out in the Ontario Building Code to be a Designer.

qualification information:
Richard Vink 24485
signature
registration information
VAS Design Inc. 42555

Contractor must verify all dimensions on the job and report any discrepancies to the Designer before proceeding with the work. All drawings and specifications are the property of the Designer and shall be returned at the completion of the work. Drawings are not to be scaled.



Greenpark	SPRINGFIELD 2 14.30m
Project Name: RUSSELL GARDENS PH. 4	Project No: 20027
Date: FEB 2021	Sheet No: 04
Drawn by: BO.BM	Checked by: 3/16" = 1'-0"
FRONT & REAR ELEVATIONS - ELEV. '3'	
20027-SPRINGFIELD-2	
A4b	

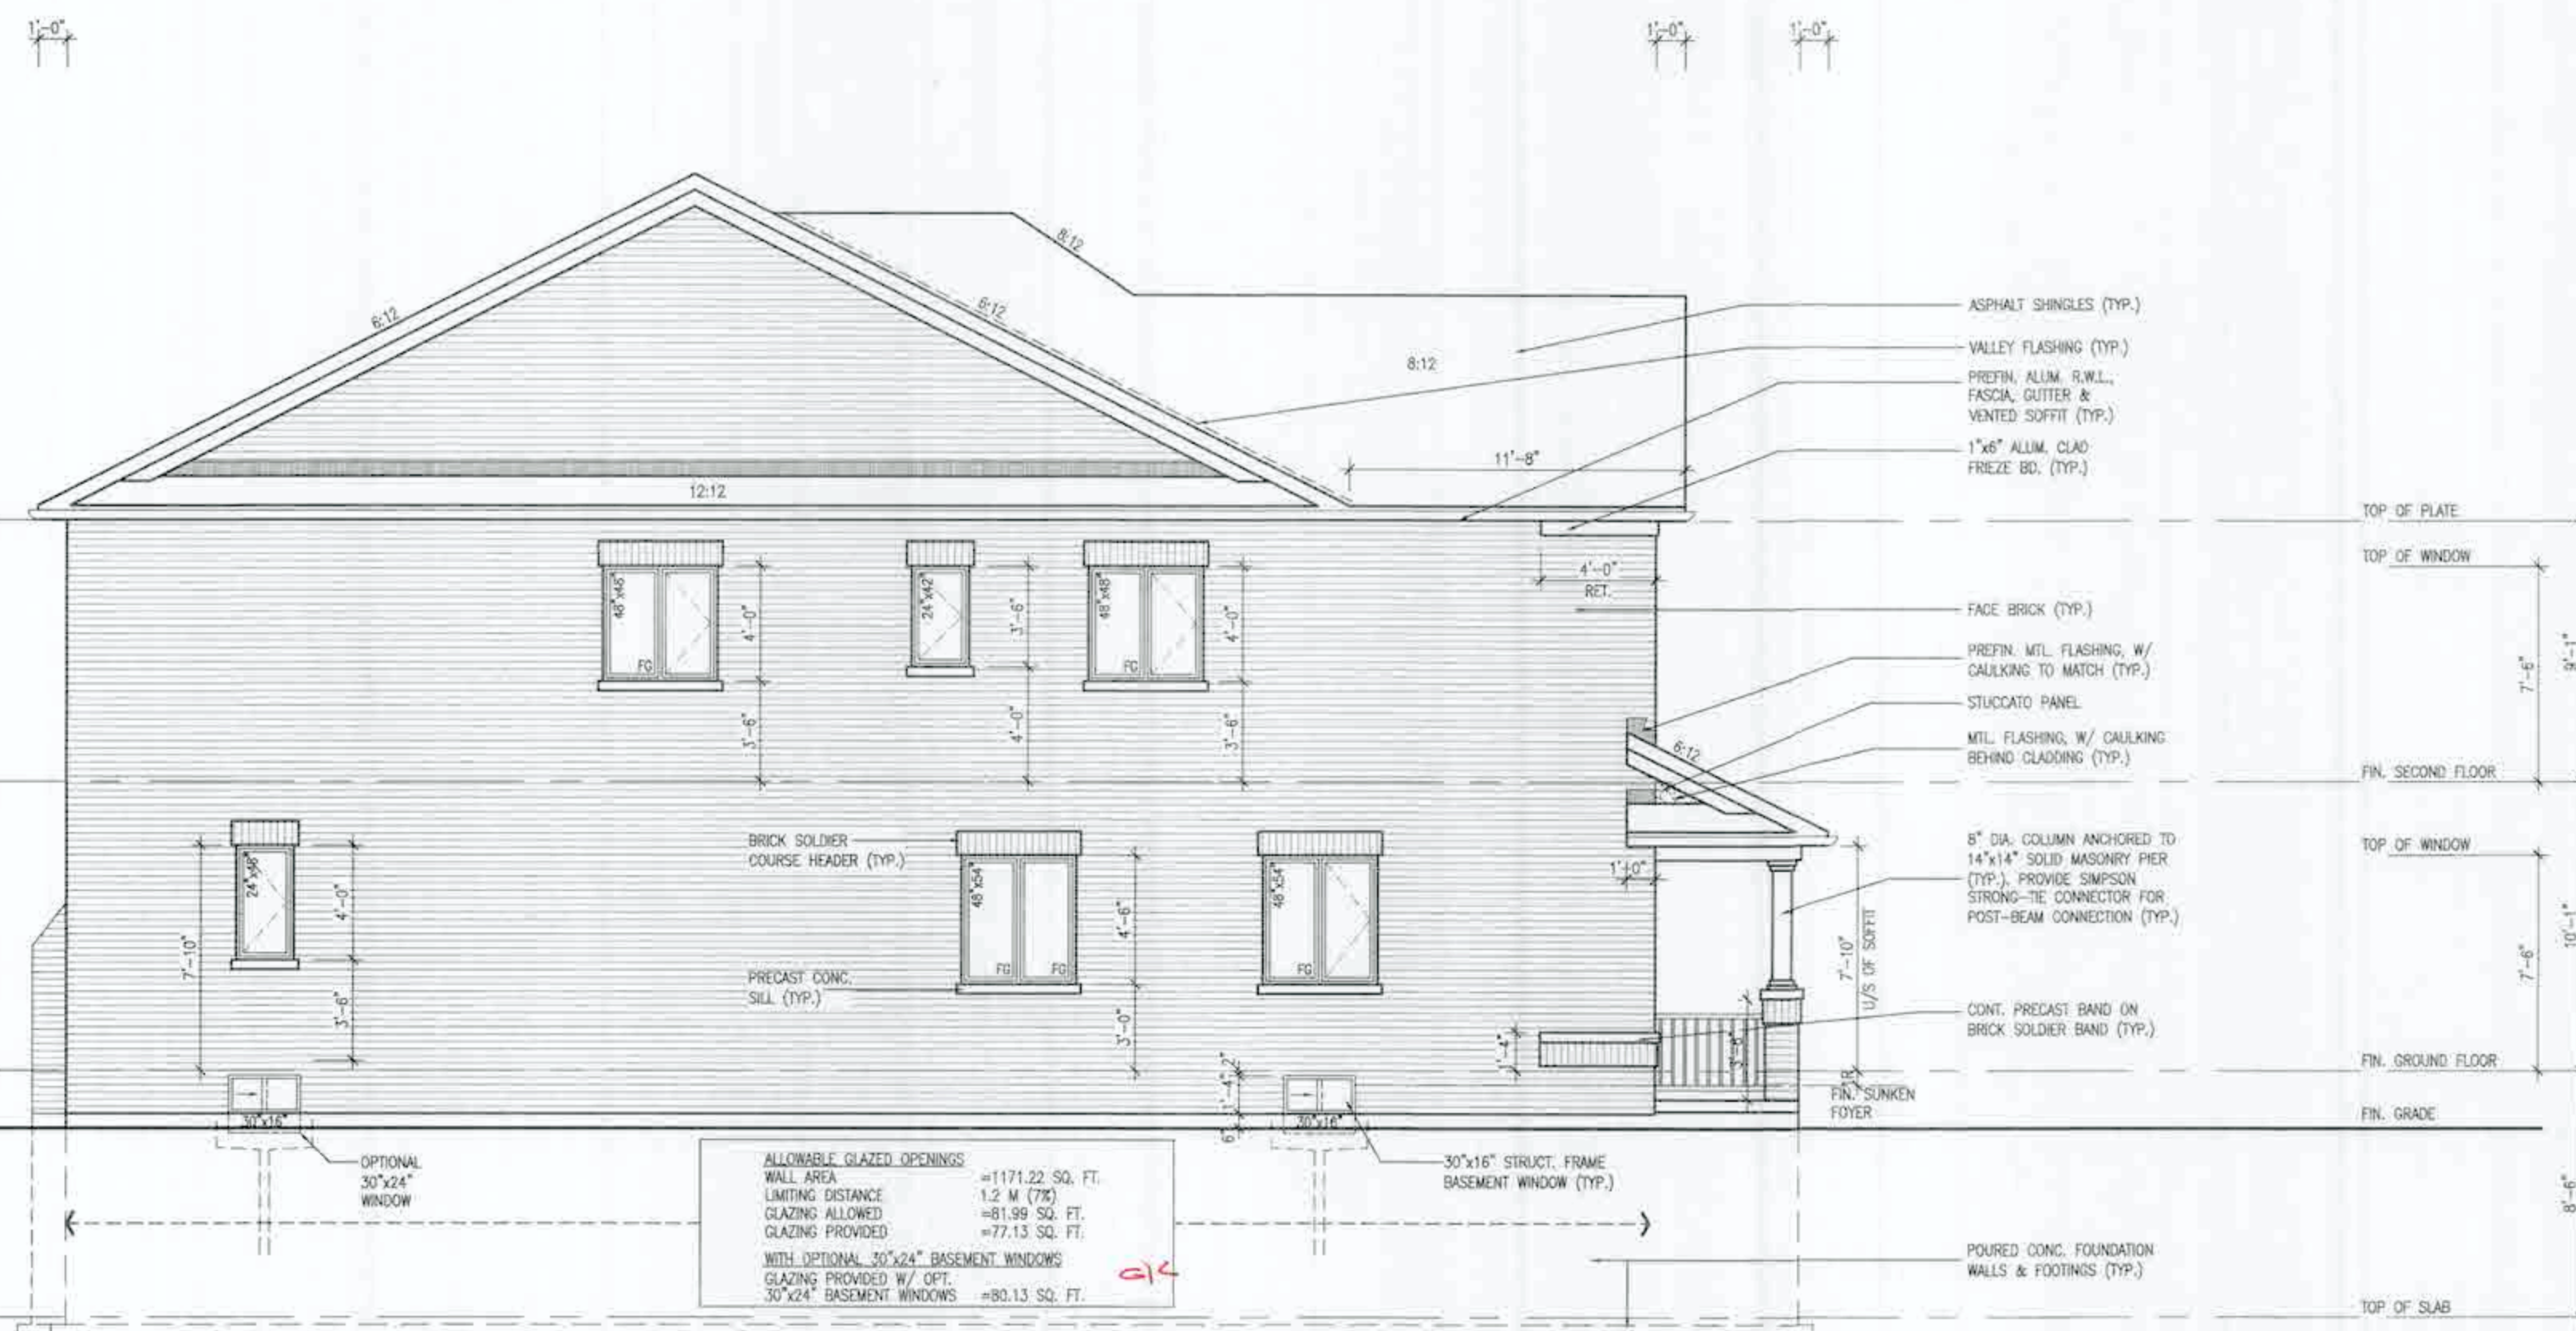

LEFT SIDE ELEVATION - ELEV. '1'

It is the builder's complete responsibility to ensure that all plans submitted for approval fully comply with this Architectural Guidelines and all applicable regulations and requirements including zoning provisions and any provisions in the subdivision agreement. The Control Architect is not responsible in any way for examining or approving site (lotting) plans or working drawings with respect to any zoning or building code or permit matter or that any house can be properly built or located on its lot.

This is to certify that these plans comply with the applicable Architectural Design Guidelines approved by the City of

EXTERIOR RAILINGS:
3'-6" HIGH RAILING IF LANDING IS MORE
THAN 5'-11" ABOVE FINISHED GRADE
AND 3'-0" HIGH RAILING WHEN LANDING
IS LESS THAN 5'-11" ABOVE ADJACENT
FINISHED GRADE

ELEVATIONS NOT DRAWN TO ACTUAL GRADE.
REFER TO FINAL GRADING PLAN.

BASEMENT WINDOWS
LARGER WINDOW MAY REQUIRE WINDOW WELL.
DEPENDING ON FINAL GRADE CONDITIONS.
DRAIN WELL TO FOOTING DRAIN


[illegible]

VA3
DESIGN
255 Consumers Rd. Suite
Toronto, ON M2J 1R4
t 416.630.2255 f 416.630.
va3design.com

 Greenpark.		SPRINGFIELD 2 14.50m	
project name RUSSELL GARDENS PH. 4	municipality HAMILTON, ON.	project no. 2002	
date 18/09/2021	LEFT SIDE ELEVATION - ELEV. '1'		drawing no. A5

CITY OF HAMILTON
Building Division
Permit No. 21-150884
THESE STAMPED DRAWINGS SHALL BE AVAILABLE ON SITE
THE OWNER AND/OR CONTRACTOR SHALL COMPLY WITH
THE ONTARIO BUILDING CODE AND ALL OTHER APPLICABLE LAWS
These drawings and the specifications have been reviewed by

SPRINGFIELD 2
COMPLIANCE PACKAGE 'A1'

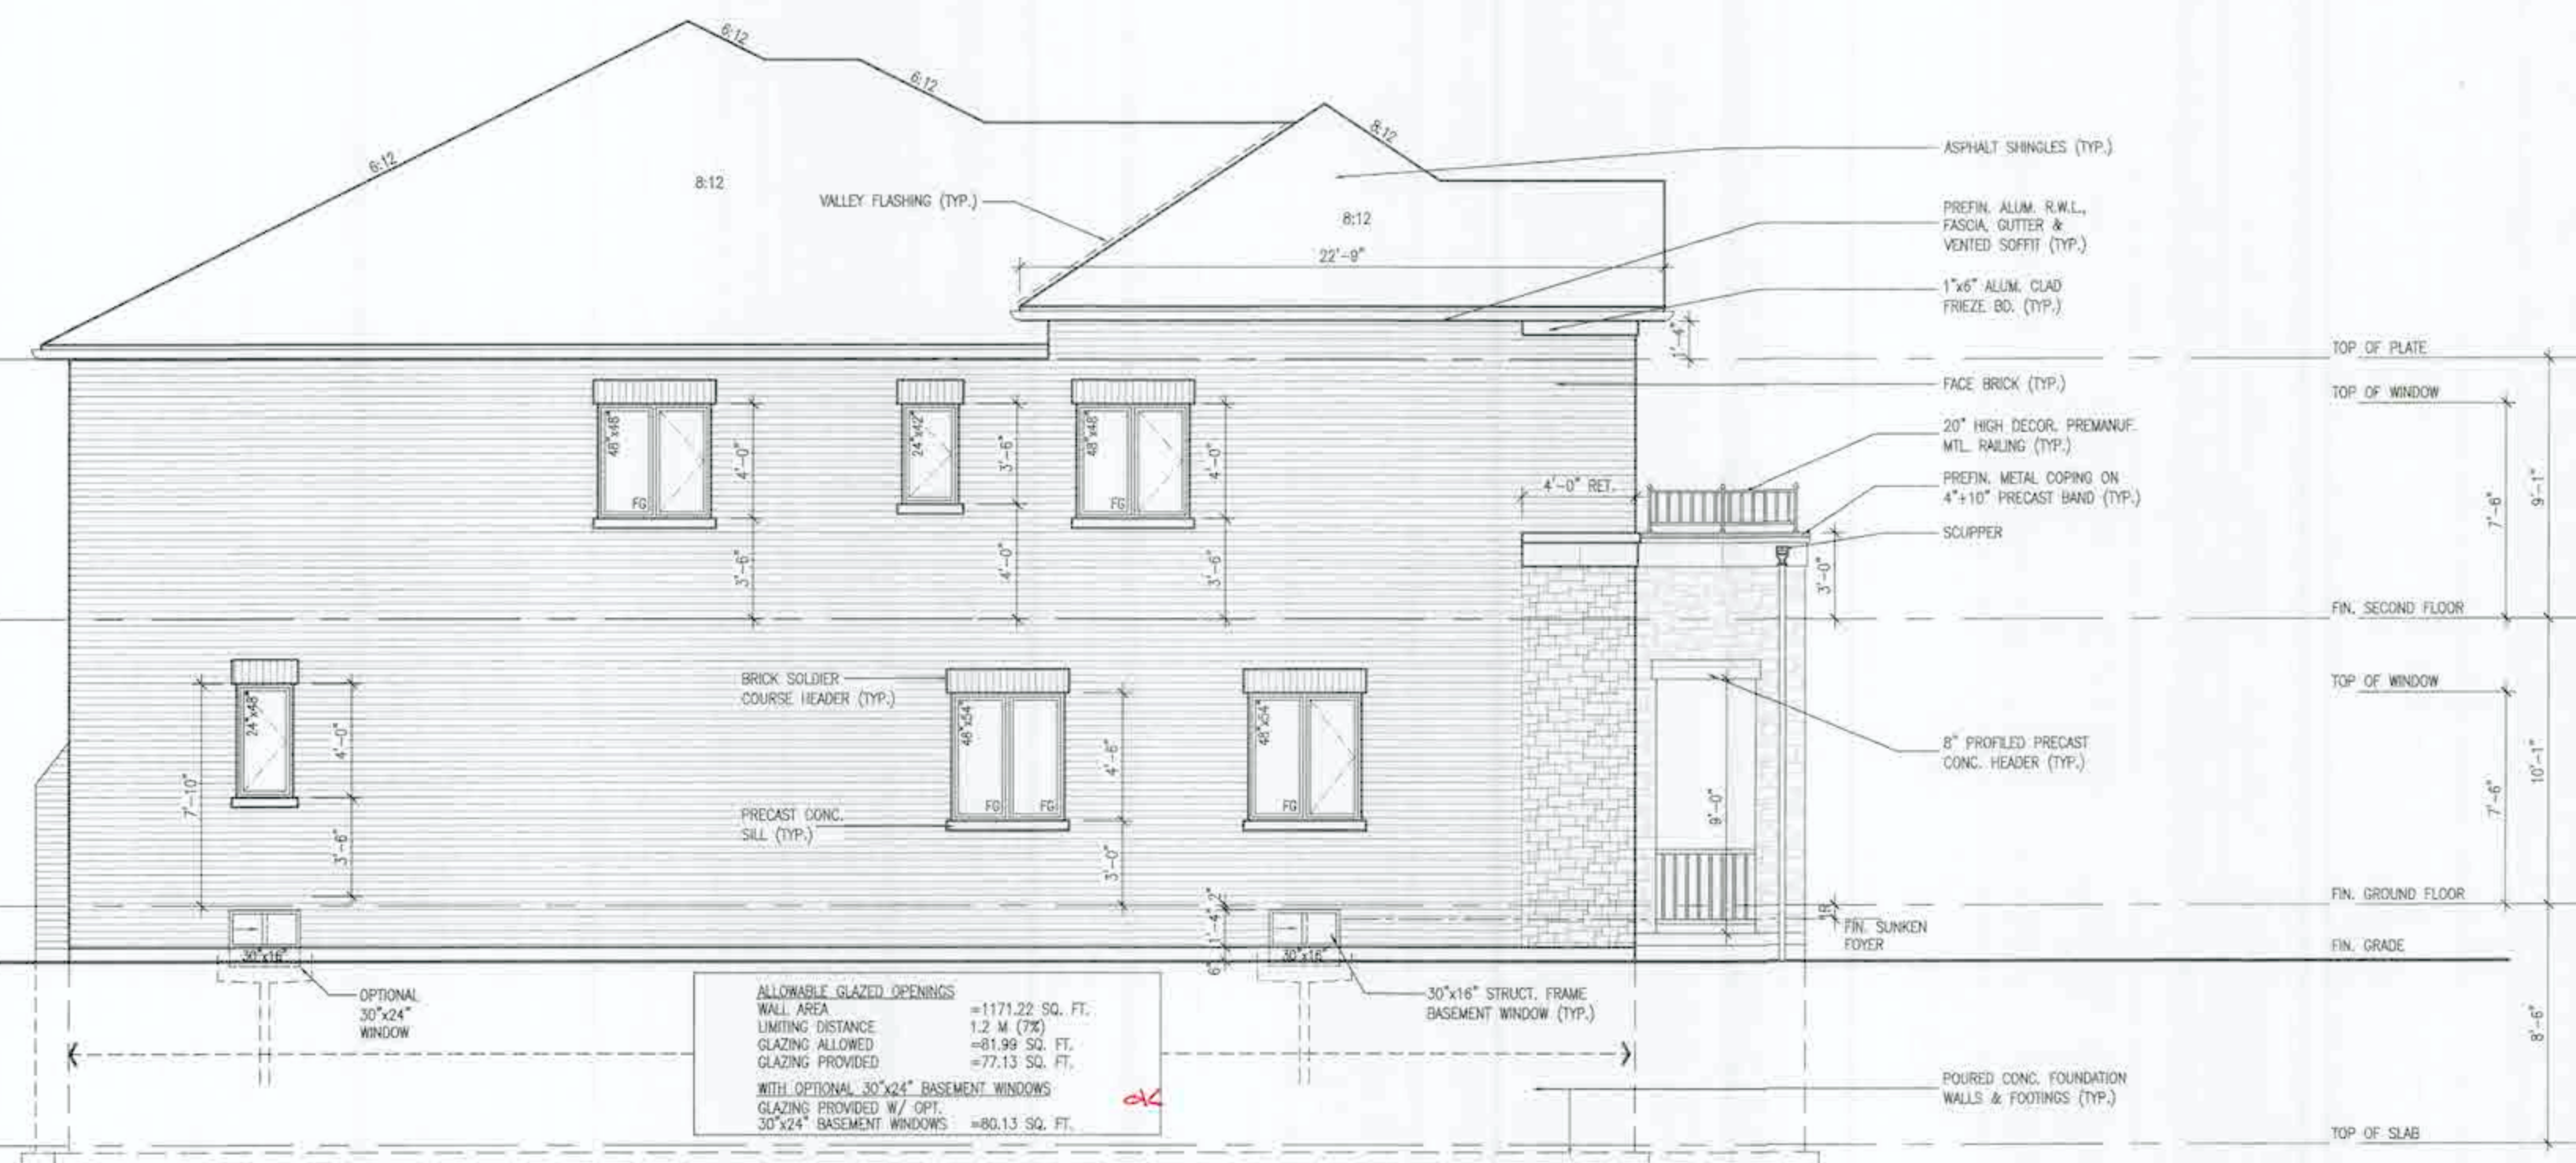

LEFT SIDE ELEVATION - ELEV. '2'

It is the builder's complete responsibility to ensure that all plans submitted for approval fully comply with the Architectural Guidelines and all applicable regulations and requirements including zoning provisions and any provisions in the subdivision agreement. The Control Architect is not responsible in any way for extending or approving site plotting plans or working drawings with respect to zoning or building code or permit matter or that any house can be properly built or located on its lot.

This is to certify that these plans comply with the applicable Architectural Design Guidelines approved by the City of

EXTERIOR RAILINGS:
3'-6" HIGH RAILING IF LANDING IS MORE
THAN 5'-11" ABOVE FINISHED GRADE
AND 3'-0" HIGH RAILING WHEN LANDING
IS LESS THAN 5'-11" ABOVE ADJACENT
FINISHED GRADE.

BASEMENT WINDOWS
LARGER WINDOW MAY REQUIRE WINDOW WELL
DEPENDING ON FINAL GRADE CONDITIONS.
DRAIN WELL TO FOOTING DRAIN.

ELEVATIONS NOT DRAWN TO ACTUAL GRADE.
REFER TO FINAL GRADING PLAN.

[illegible]

CITY OF HAMILTON
Building Division

Permit No. 21-15088

THESE STAMPED DRAWINGS SHALL BE AVAILABLE ON SITE

THE OWNER AND/OR CONTRACTOR SHALL COMPLY WITH
THE ONTARIO BUILDING CODE AND ALL OTHER APPLICABLE LAW

These drawings and/or specifications have been reviewed by:

TDS **OCT 04 2021**

FOR CHIEF BUILDING OFFICIAL DATE

SPRINGFIELD 2
COMPLIANCE PACKAGE 'A1'

Greenpark.

SPRINGFIELD 2
14.30m

project name	municipality	project
RUSSELL GARDENS PH. 4	HAMILTON, ON.	2002

DATE: FEB 2021 LEFT SIDE ELEVATION - ELEV. '2'
 DRAWN BY: BO.BIM CHECKED BY: 3/16" = 1'-0" FILE NAME: 20027-SPRINGFIELD-2

All drawings, specifications, related documents and design are the copyright property of V&J DESIGN. Reproduction of this property in whole or in part is strictly prohibited without V&J DESIGN's written permission.

Architectural elevation drawing of a building facade. The drawing includes a gabled roof with a pitch of 6:12. The facade features a combination of brick and stucco finishes. There are several windows: two large double windows on the upper level, two smaller double windows on the lower level, and a single window on the far left. A small entrance is located on the right side. The drawing is annotated with various materials and construction details.

Annotations:

- ASPHALT SHINGLES (TYP.)
- VALLEY FLASHING (TYP.)
- PREFIN. ALUM. R.W.L., FASCIA, GUTTER & VENTED SOFFIT (TYP.)
- 1"x6" ALUM. CLAD FRIEZE BD. (TYP.)
- 6" STUCCO FRIEZE BD. (TYP.)
- APPLIED STUCCO FINISH W/ REVEALS AS SHOWN
- PREFIN. METAL COPING ON 4"x10" PRECAST BAND (TYP.)
- SOUPPER
- 10" PRECAST CONC. HEADER (TYP.)
- CONTEMPORARY STONE PATTERN (TYP.)
- FIN. SUNKEN FOYER
- POURED CONC. FOUNDATION WALLS & FOOTINGS (TYP.)

Table of Glazed Openings:

ALLOWABLE GLAZED OPENINGS	
WALL AREA	=1171.22 SQ. FT.
LIMITING DISTANCE	1.2 M (7%)
GLAZING ALLOWED	=81.99 SQ. FT.
GLAZING PROVIDED	=77.13 SQ. FT.

WITH OPTIONAL 30"x24" BASEMENT WINDOWS

GLAZING PROVIDED W/ OPT. 30"x24" BASEMENT WINDOWS =80.13 SQ. FT.

CITY OF HAMILTON
Building Division

Permit No. 21-150884

THESE STAMPED DRAWINGS SHALL BE AVAILABLE ON SITE

THE OWNER AND/OR CONTRACTOR SHALL COMPLY WITH
THE ONTARIO BUILDING CODE AND ALL OTHER APPLICABLE LAWS


These drawings and/or specifications have been reviewed by
[Signature]

FOR CIVIL ENGINEERING OFFICIAL, DATE OCT 15 2021

greenpark™ SPRINGFIELD 2
14.30m

BASEMENT WINDOWS
LARGER WINDOW MAY REQUIRE WINDOW WELL
DEPENDING ON FINAL GRADE CONDITIONS.
DRAIN WELL TO FOOTING DRAIN.

18			6	The undersigned has reviewed and takes responsibility for this design and has the qualifications and meets the requirements set out at the Ontario Building Code to be a designer.				SPRINGFIELD 2 14.30m			
17			7	 Richard Vink 24485							
16			8	name Richard Vink 24485 business address 8288							
15			9	telephone information 42658 VA3 Design Inc.							
14			10								
13			11	ISSUED FOR PERMIT MAY 21/21 ON		project name RUSSELL GARDENS PH. 4	municipality HAMILTON, ON.	project no. 20027			
12			12	ISSUED FOR PERMIT MAY 21/21 ON							
11			13	REV. PER CLIENT/ROOF/ENG. COMMENTS APR 27/21 ON							
10			14	PRELIMINARY ISSUED FOR CLIENT REVIEW FEB 18/21 ON							
9			15								
no.	description	date	by	no.	description	date	by	no.	description	date	by
All drawings, modifications, notes, dimensions and design are the copyrighted property of VA3 DESIGN. Reproduction of this report in whole or in part is strictly prohibited without VA3 DESIGN's written approval.											

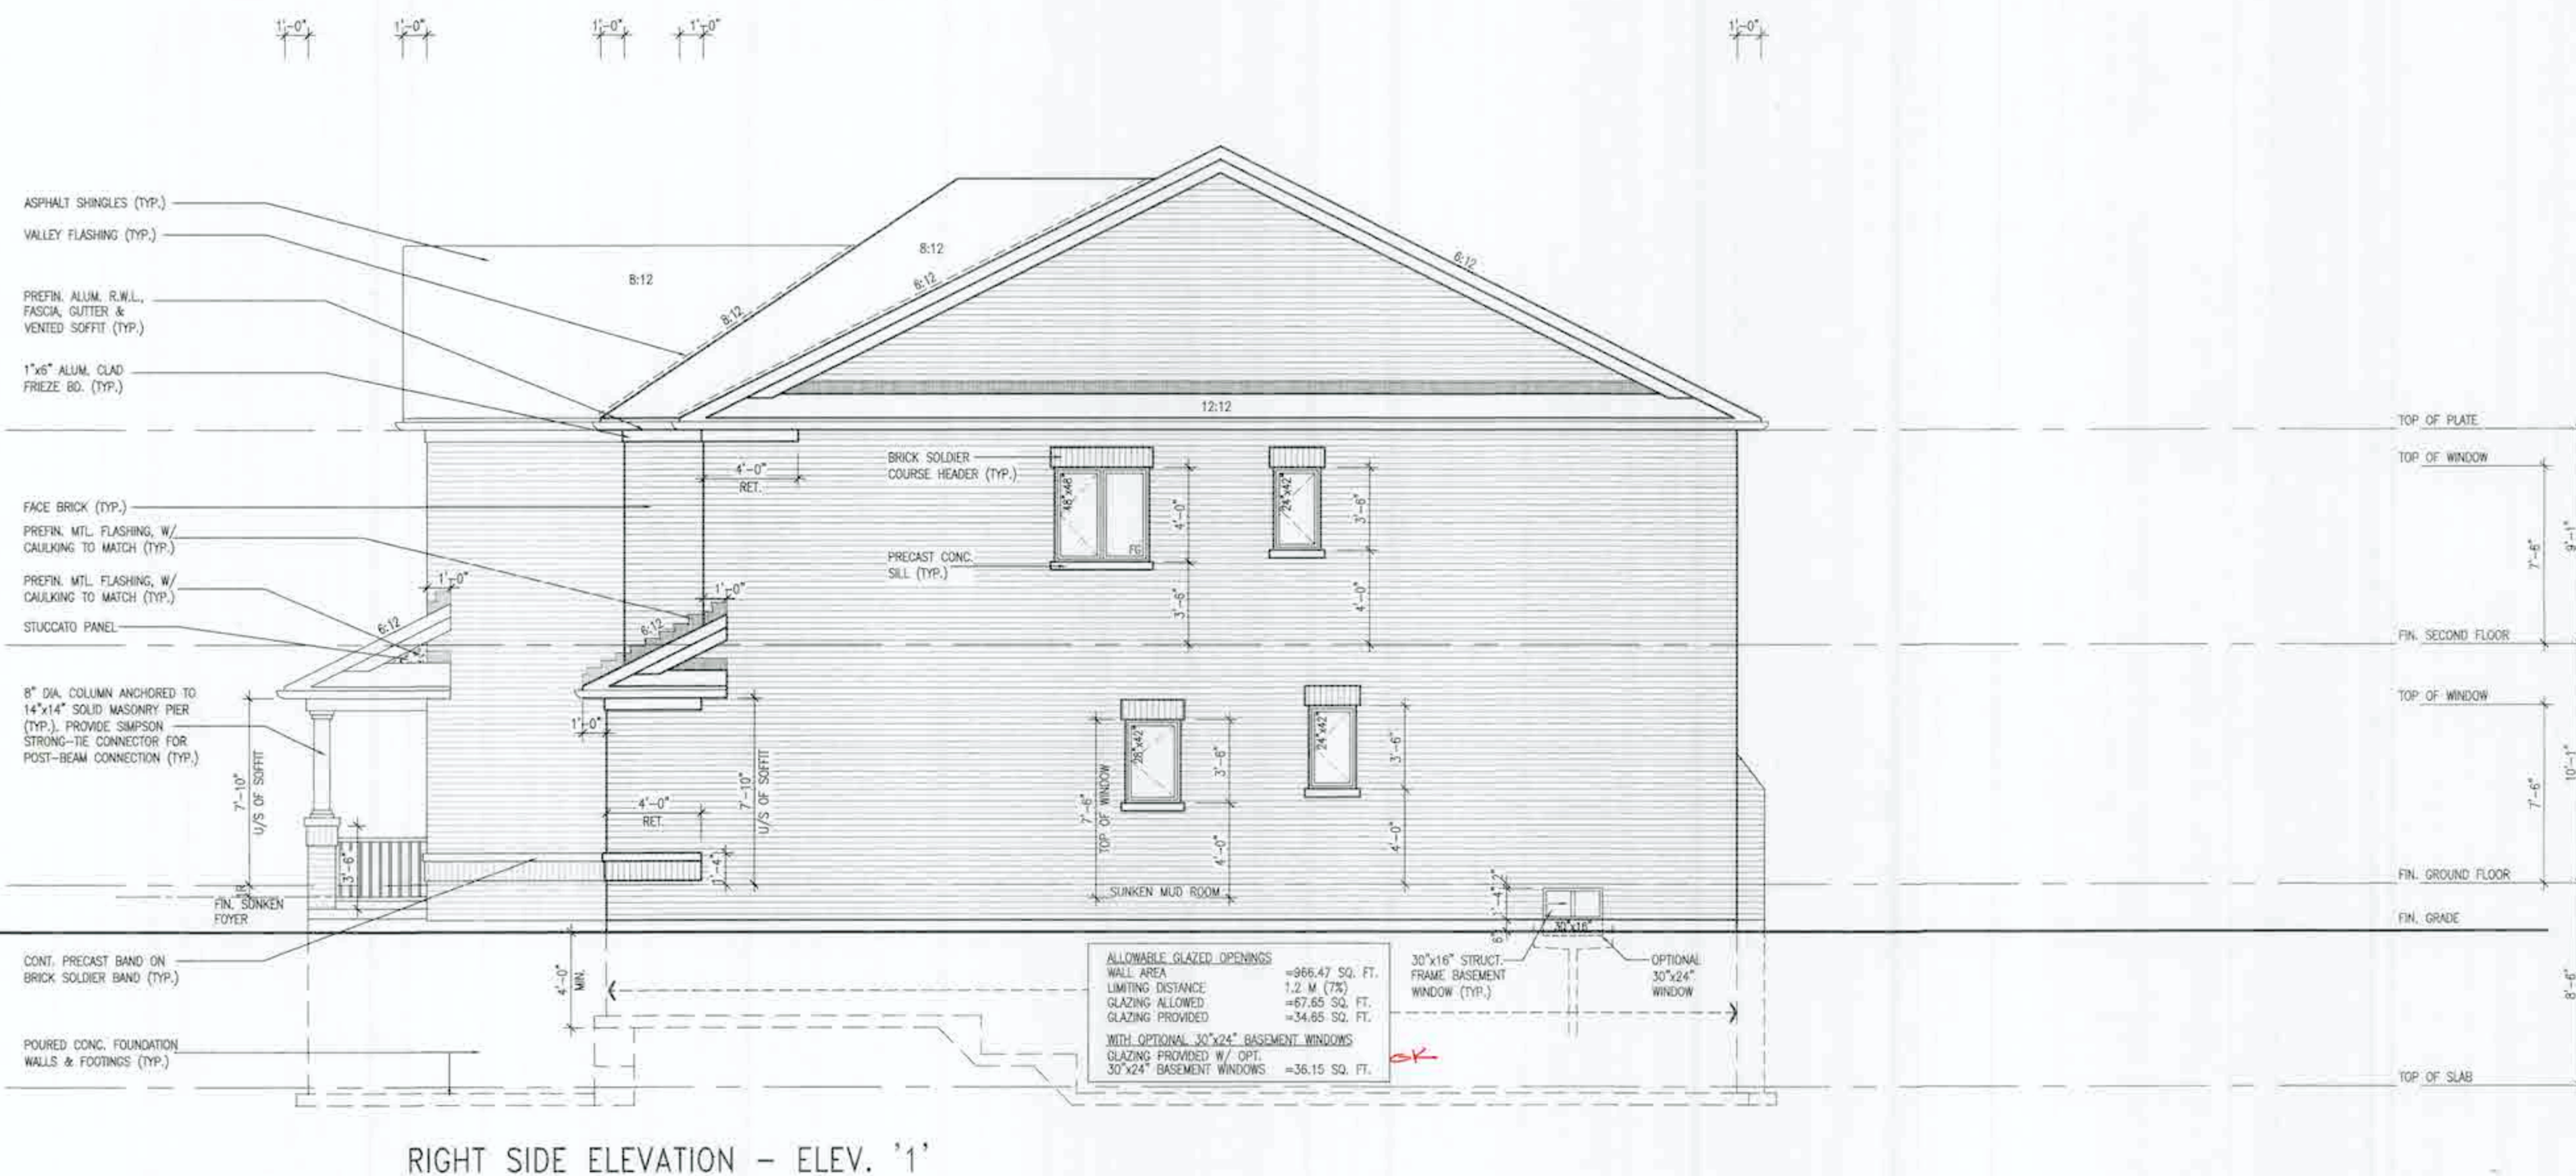

RIGHT SIDE ELEVATION - ELEV. '1'

It is the builder's complete responsibility to ensure that all plans submitted for approval fully comply with the Architectural Guidelines and all applicable regulations and requirements including zoning provisions and any provisions in the subdivision agreement. The Control Architect is not responsible in any way for examining or approving site (lotting) plans or working drawings with respect to any zoning or building code or permit matter or that any house can be properly built or located on any lot.

This is to certify that these plans comply with the applicable Architectural Design Guidelines approved by the City of HAMILTON

EXTERIOR RAILINGS:
3'-6" HIGH RAILING IF LANDING IS MORE
THAN 5'-11" ABOVE FINISHED GRADE
AND 3'-0" HIGH RAILING WHEN LANDING
IS LESS THAN 5'-11" ABOVE ADJACENT
FINISHED GRADE.

ELEVATIONS NOT DRAWN TO ACTUAL GRADE.
REFER TO FINAL GRADING PLAN.

BASEMENT WINDOWS:
LARGER WINDOW MAY REQUIRE WINDOW WELL
DEPENDING ON FINAL GRADE CONDITIONS.
DRAIN WELL TO FOOTING DRAIN.

[illegible]

The undersigned has reviewed and takes responsibility for this design and has the qualifications and meets the requirements set out in the Ontario Building Code to be a Designer:	
qualification information	<i>R. Vink</i>
name	signature
Registration Information	
VA3 Design Inc.	
Contractor must verify all dimensions on the job and report any discrepancy to the Designer before proceeding with the work. All drawings and specifications are instruments of service and the property of the Designer which will be returned at the completion of the project. Drawings are not to be copied.	

VAD
DESIGN
255 Consumers Rd. Suite 101
Toronto, ON M2J 1P1
+1 416.630.2255 • 416.630.2256
va3designer.com

		SPRINGFIELD 2
		14.30m
project name RUSSELL GARDENS PH. 4	municipality HAMILTON, ON.	project no. 20027
date FEB 2021	drawing title RIGHT SIDE ELEVATION - ELEV. '1'	
drawn by BOWEN	checked by —	scale 3/16" = 1'-0"
drawing no. 20027-SPRINGFIELD-2		sheet no. A6

CITY OF HAMILTON
Building Division

Permit No. 21-150884

THESE STAMPED DRAWINGS SHALL BE AVAILABLE ON SITE.
THE OWNER AND/OR CONTRACTOR SHALL COMPLY WITH
THE ONTARIO BUILDING CODE AND ALL OTHER APPLICABLE LAWS.


These drawings and/or specifications have been reviewed by
AB OCT 14 2021

DATE

FOR CHIEF BUILDING OFFICIAL

SPRINGFIELD 2
COMPLIANCE PACKAGE 'A1'

3550 SF.

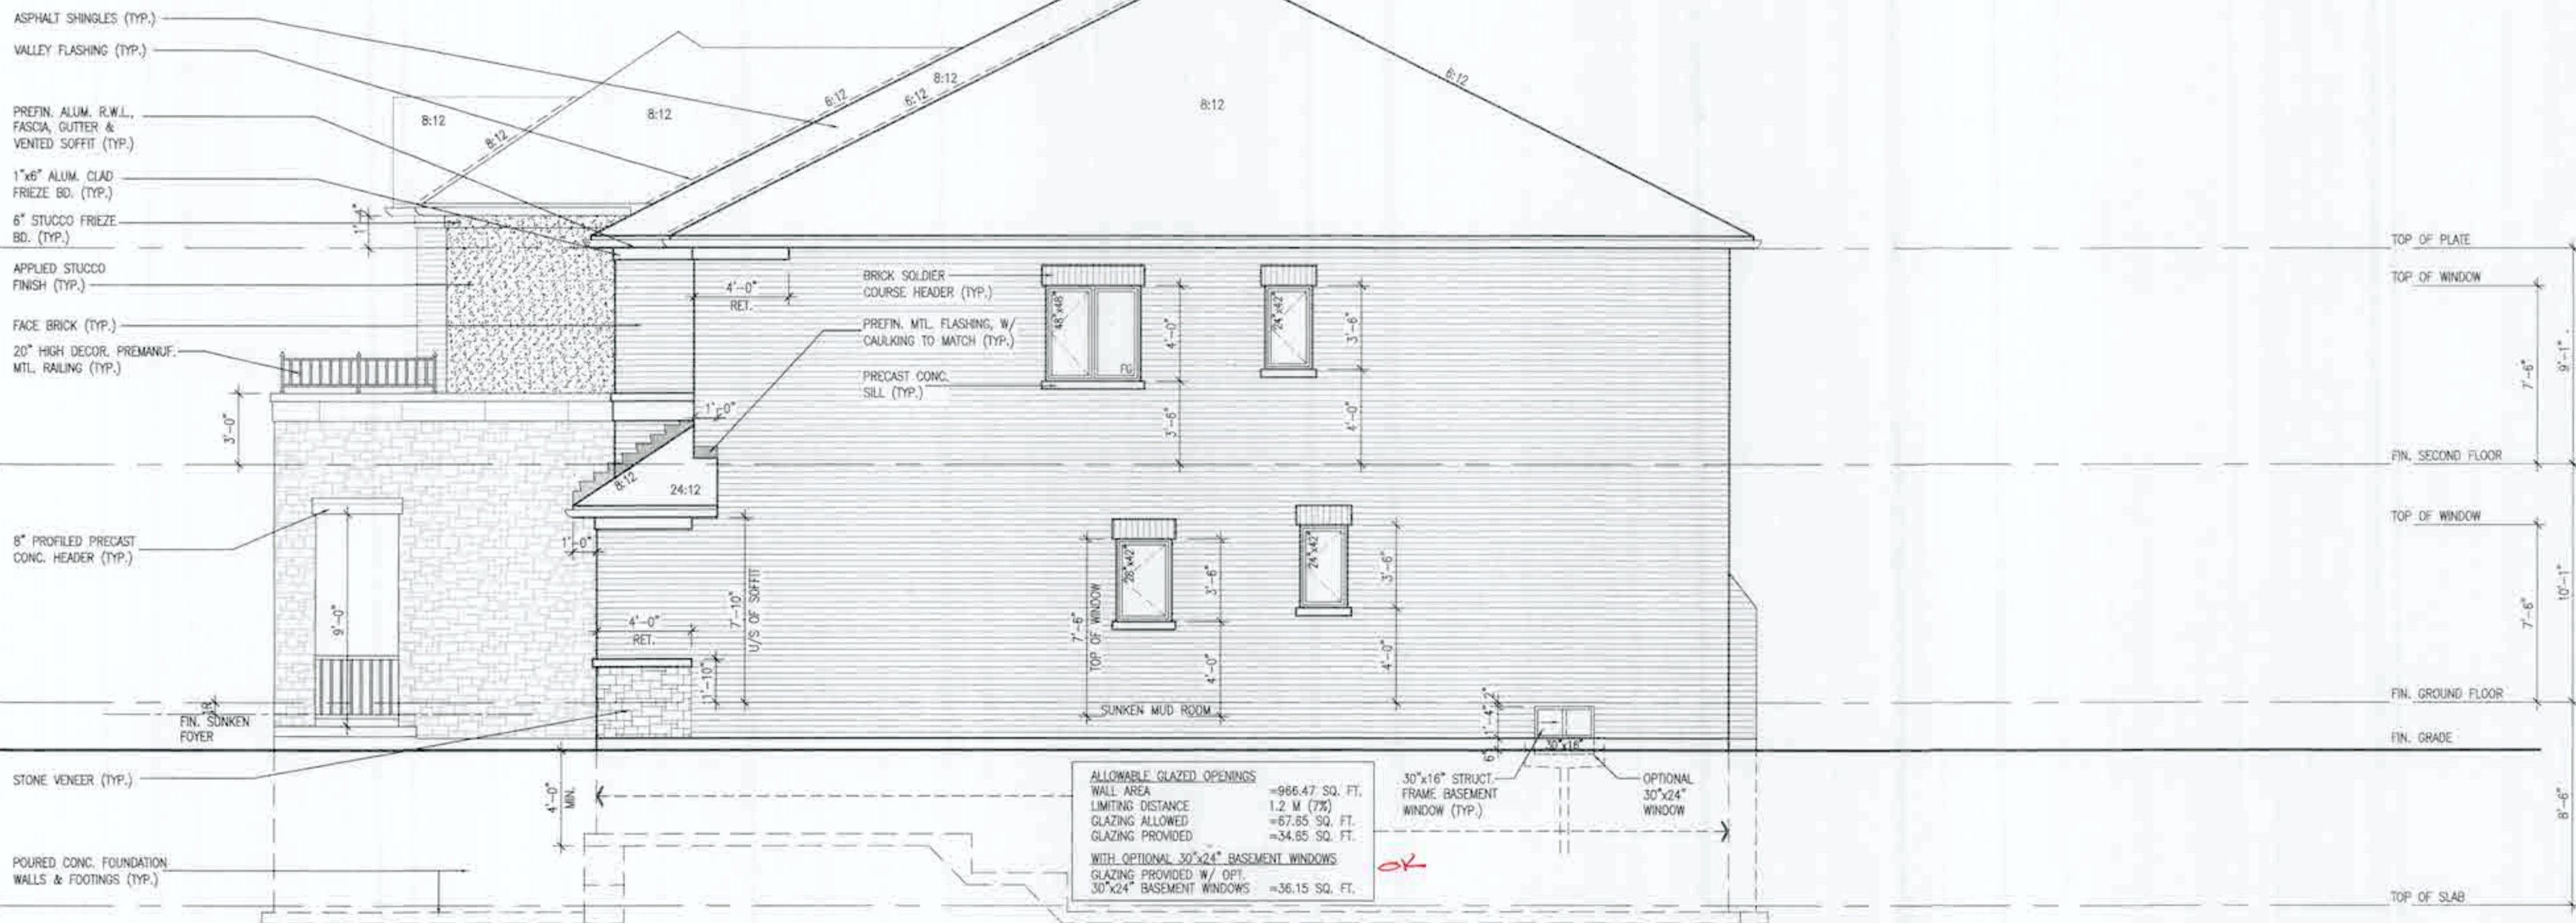

RIGHT SIDE ELEVATION - ELEV. '2'

It is the builder's complete responsibility to ascertain that all plans submitted for approval fully comply with the applicable Code, Ordinance and applicable regulations and requirements including zoning provisions and any provisions in the subdivision agreement. The Control Architect is not responsible in any way for examining or approving site (lotting) plans or working drawings with respect to any zoning or building code or permit matter or that any house can be properly built or located on its lot.

This is to certify that these plans comply with the applicable Architectural Design Guidelines approved by the City of HAMILTON.

EXTERIOR RAILINGS:
3'-6" HIGH RAILING IF LANDING IS MORE
THAN 5'-11" ABOVE FINISHED GRADE
AND 3'-0" HIGH RAILING WHEN LANDING
IS LESS THAN 5'-11" ABOVE ADJACENT
FINISHED GRADE.

BASEMENT WINDOWS
LARGER WINDOW MAY REQUIRE WINDOW WELL
DEPENDING ON FINAL GRADE CONDITIONS.
DRAIN WELL TO FOOTING DRAIN.

ELEVATIONS NOT DRAWN TO ACTUAL GRADE.
REFER TO FINAL GRADING PLAN.

18				9		
17				8		
16				7		
15				6		
14				5		
13				4		
12				3	ISSUED FOR PERMIT	MAY 21/21
11				2	REV. PER CLIENT/HOOF/TL/ENG. COMMENTS	APR 27/21
10				1	PRELIMINARY, ISSUED FOR CLIENT REVIEW	FEB 19/21
9	description	date	by	rev	description	date

The undersigned has reviewed and taken responsibility for this design and has the qualifications and meets the requirements set out in Ontario Building Code to be a Designer:				
qualification information	Richard Vink			2
non-qualifications information	VA3 Design Inc.			4
Contractor must verify all dimensions on the job and report any discrepancy to the Designer before proceeding with the work. All drawings and specifications are instruments of service and the price of the Contract which must be refused at the completion of the drawings and specifications is no longer in force.				

VA3
DESIGN
255 Consumers Rd Suite 1
Toronto ON M2J 1R4
1 416.630.2255 1 416.630.4
va3design.com

 Greenpark.		SPRINGFIELD 2 14.30m	
project name	RUSSELL GARDENS PH. 4	municipality	HAMILTON, ON.
date	FEB 2021	project no.	20027
drawn by	BOEM	drawing no.	A6a
RIGHT SIDE ELEVATION - ELEV. '2' drawn 3/16" = 1'-0"		20027-SPRINGFIELD-2 14.30m 14.30m 14.30m 14.30m	

CITY OF HAMILTON
Building Division

Permit No. 21 150884

THESE STAMPED DRAWINGS SHALL BE AVAILABLE ON SITE

THE OWNER AND/OR CONTRACTOR SHALL COMPLY WITH THE ONTARIO BUILDING CODE AND ALL OTHER APPLICABLE LAW

These drawings and other specifications have been reviewed by

[Signature]


DATE OCT 04 2021

FOR CHIEF BUILDING OFFICIAL

SPRINGFIELD 2
COMPLIANCE PACKAGE 'A1'


3550 SF.

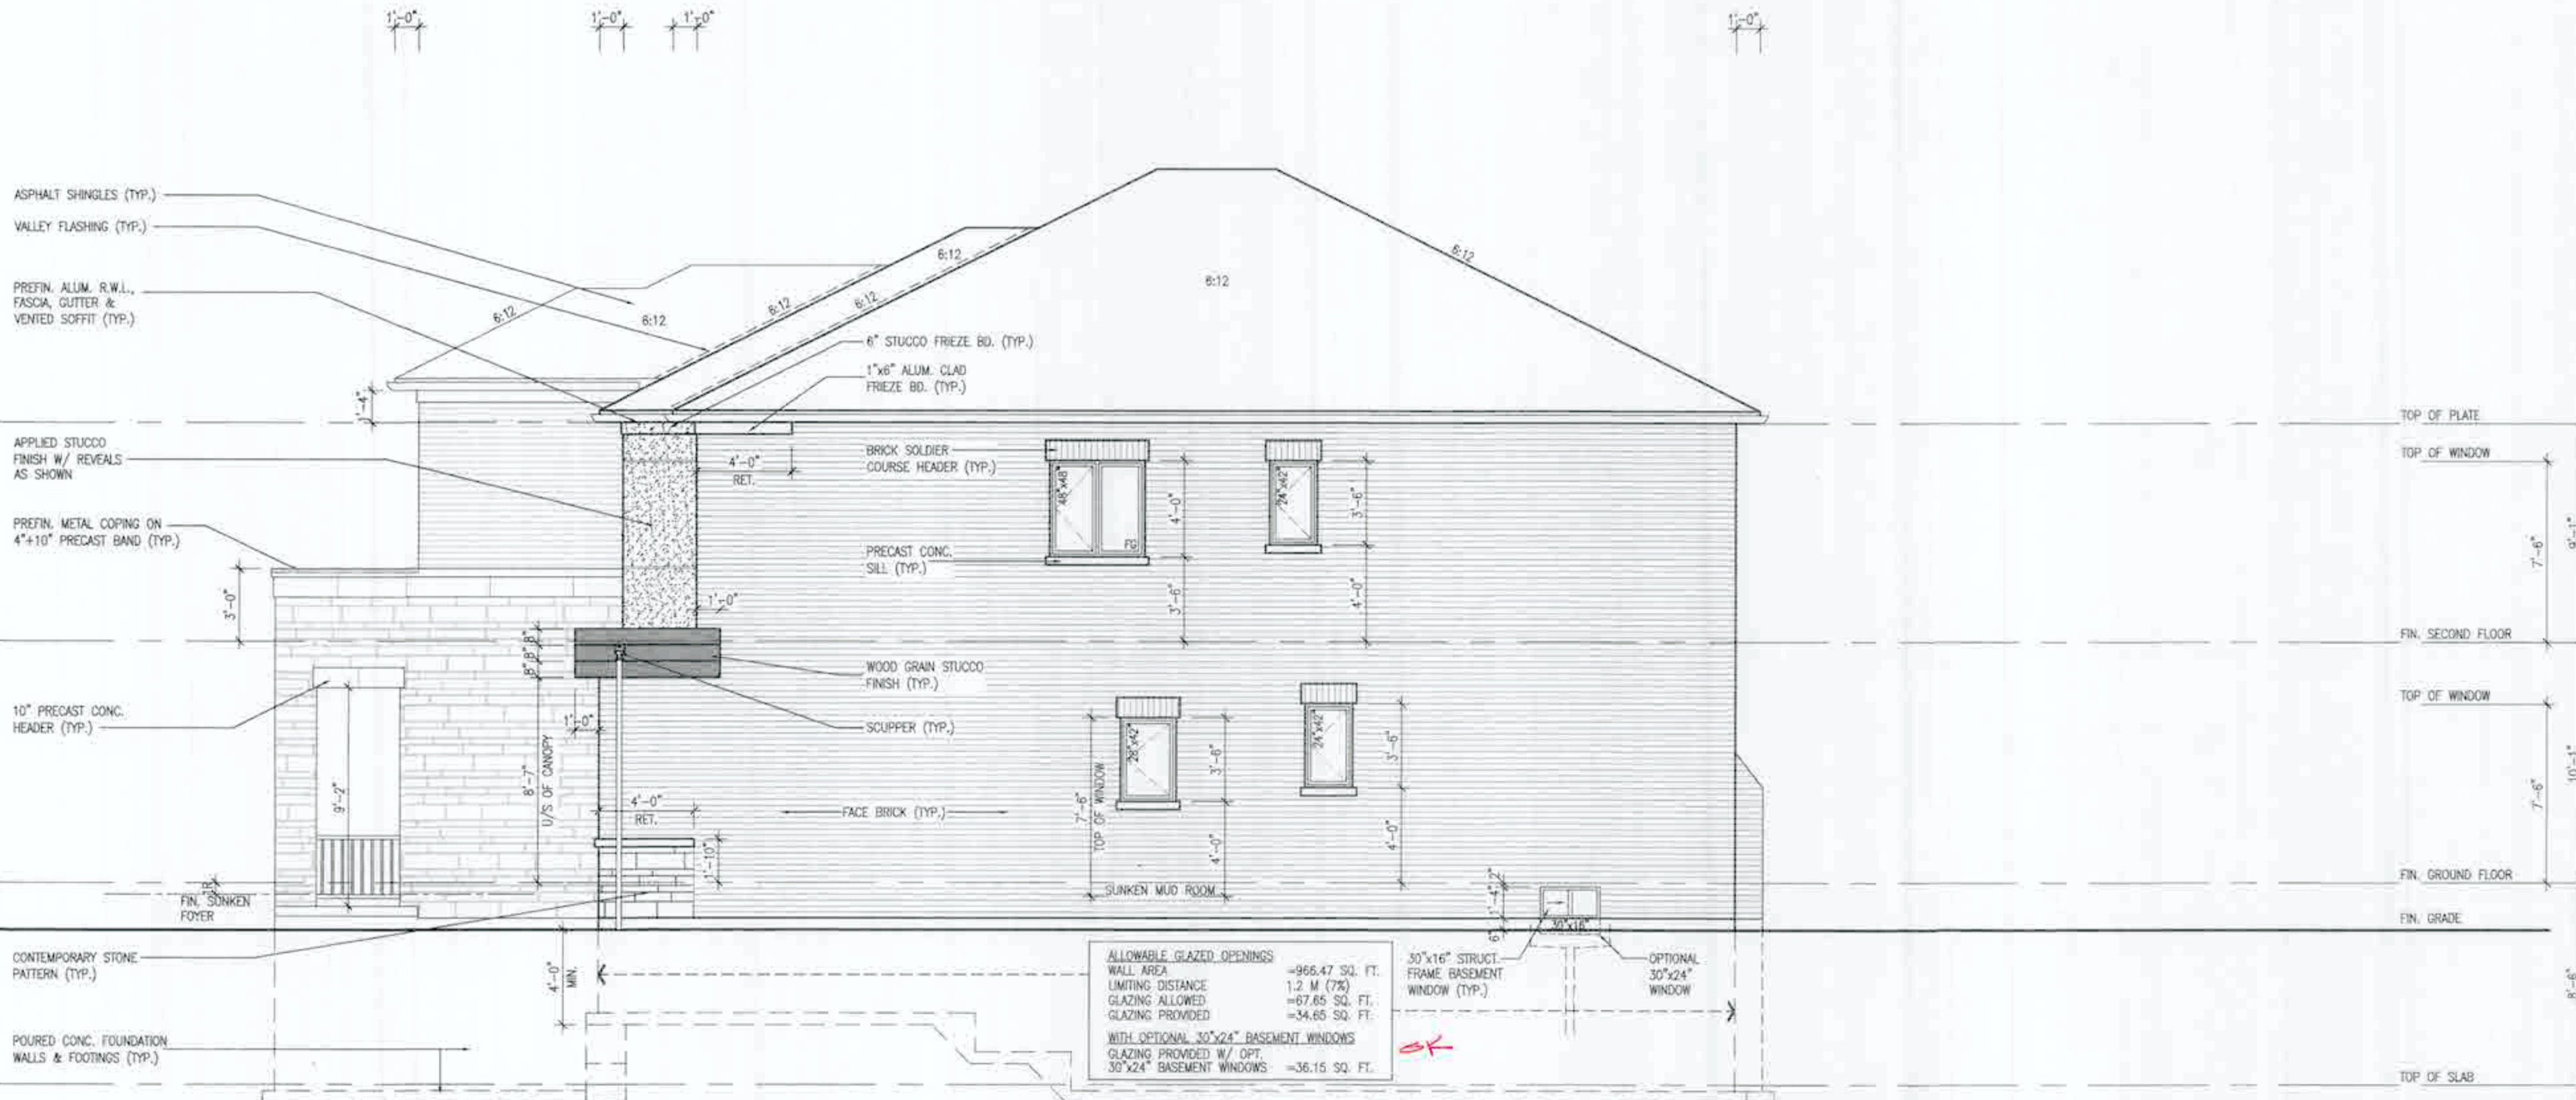

RIGHT SIDE ELEVATION - ELEV. '3'

It is the builder's complete responsibility to ensure that all plans submitted for approval fully comply with the Architectural Guidelines and all applicable regulations and requirements including zoning provisions and any provisions in the subdivision agreement. The Control Architect is not responsible in any way for examining or approving site clothing plans or working drawings with respect to any zoning or building code or permit matter or that any house can be properly built or located on its lot.

This is to certify that these plans comply with the applicable Architectural Design Guidelines approved by the City of HAMILTON.

EXTERIOR RAILINGS:
3'-6" HIGH RAILING IF LANDING IS MORE
THAN 5'-11" ABOVE FINISHED GRADE
AND 3'-0" HIGH RAILING WHEN LANDING
IS LESS THAN 5'-11" ABOVE ADJACENT
FINISHED GRADE

BASEMENT WINDOWS
LARGER WINDOW MAY REQUIRE WINDOW WELL
DEPENDING ON FINAL GRADE CONDITIONS.
DRAIN WELL TO FOOTING DRAIN.

ELEVATIONS NOT DRAWN TO ACTUAL GRADE.
REFER TO FINAL GRADING PLAN.

18	-	-	9		
17	-	-	8		
16	-	-	7		
15	-	-	6		
14	-	-	9		
13	-	-	4		
12	-	-	3		
11	-	-	2	ISSUED FOR PERMIT	MAY 21/21
10	-	-	2	REV. PER CLIENT/ROOF/FLOORING COMMENTS	APR 22/21
9	-	-	1	PROXYINARY ISSUED FOR CLIENT REVIEW	FEB 19/21
8	description	issue	in	month/year	

The undersigned has reviewed and takes responsibility for the design and lists the qualifications and meets the requirements set out in the Design Building Code to be a Designer. qualification information Richard Vink <i>R. Vink</i> 244 name <i>R. Vink</i> signature registration information VAS Design Inc. 628	
Contractor must verify all dimensions on the job and report any discrepancy to the Designer before proceeding with the work. All drawings and specifications are instruments of service and the property of the Designer which must be returned at the completion of the work. Drawings are not to be used for any other purpose.	

VA3
DESIGN
255 Consumers Rd. Suite
Toronto ON M2J 1R1
T 416.630.2255 F 416.833.
vo3design.com

 **Greenpark.**

Project Name: **RUSSELL GARDENS PH. 4** Municipality: **HAMILTON, ON.**





SPRINGFIELD 2 14.30m		project no. 20027
ON - ELEV. '3' 20027-SPRINGFIELD-2	drawing no. A6b	

CITY OF HAMILTON
Building Division
Permit No. **21-150884**
THESE STAMPED DRAWINGS SHALL BE AVAILABLE ON
THE OWNER AND/OR CONTRACTOR SHALL COMPLY W/
THE ONTARIO BUILDING CODE AND ALL OTHER APPLICABLE
These drawings and the specifications have been reviewed
OCT 4

SPRINGFIELD 2
COMPLIANCE PACKAGE 'A1'

All drawings, specifications, master documents and design are the copyright property of MVA DESIGN. Reproduction of this property in whole or in part is strictly prohibited without MVA DESIGN's written permission.

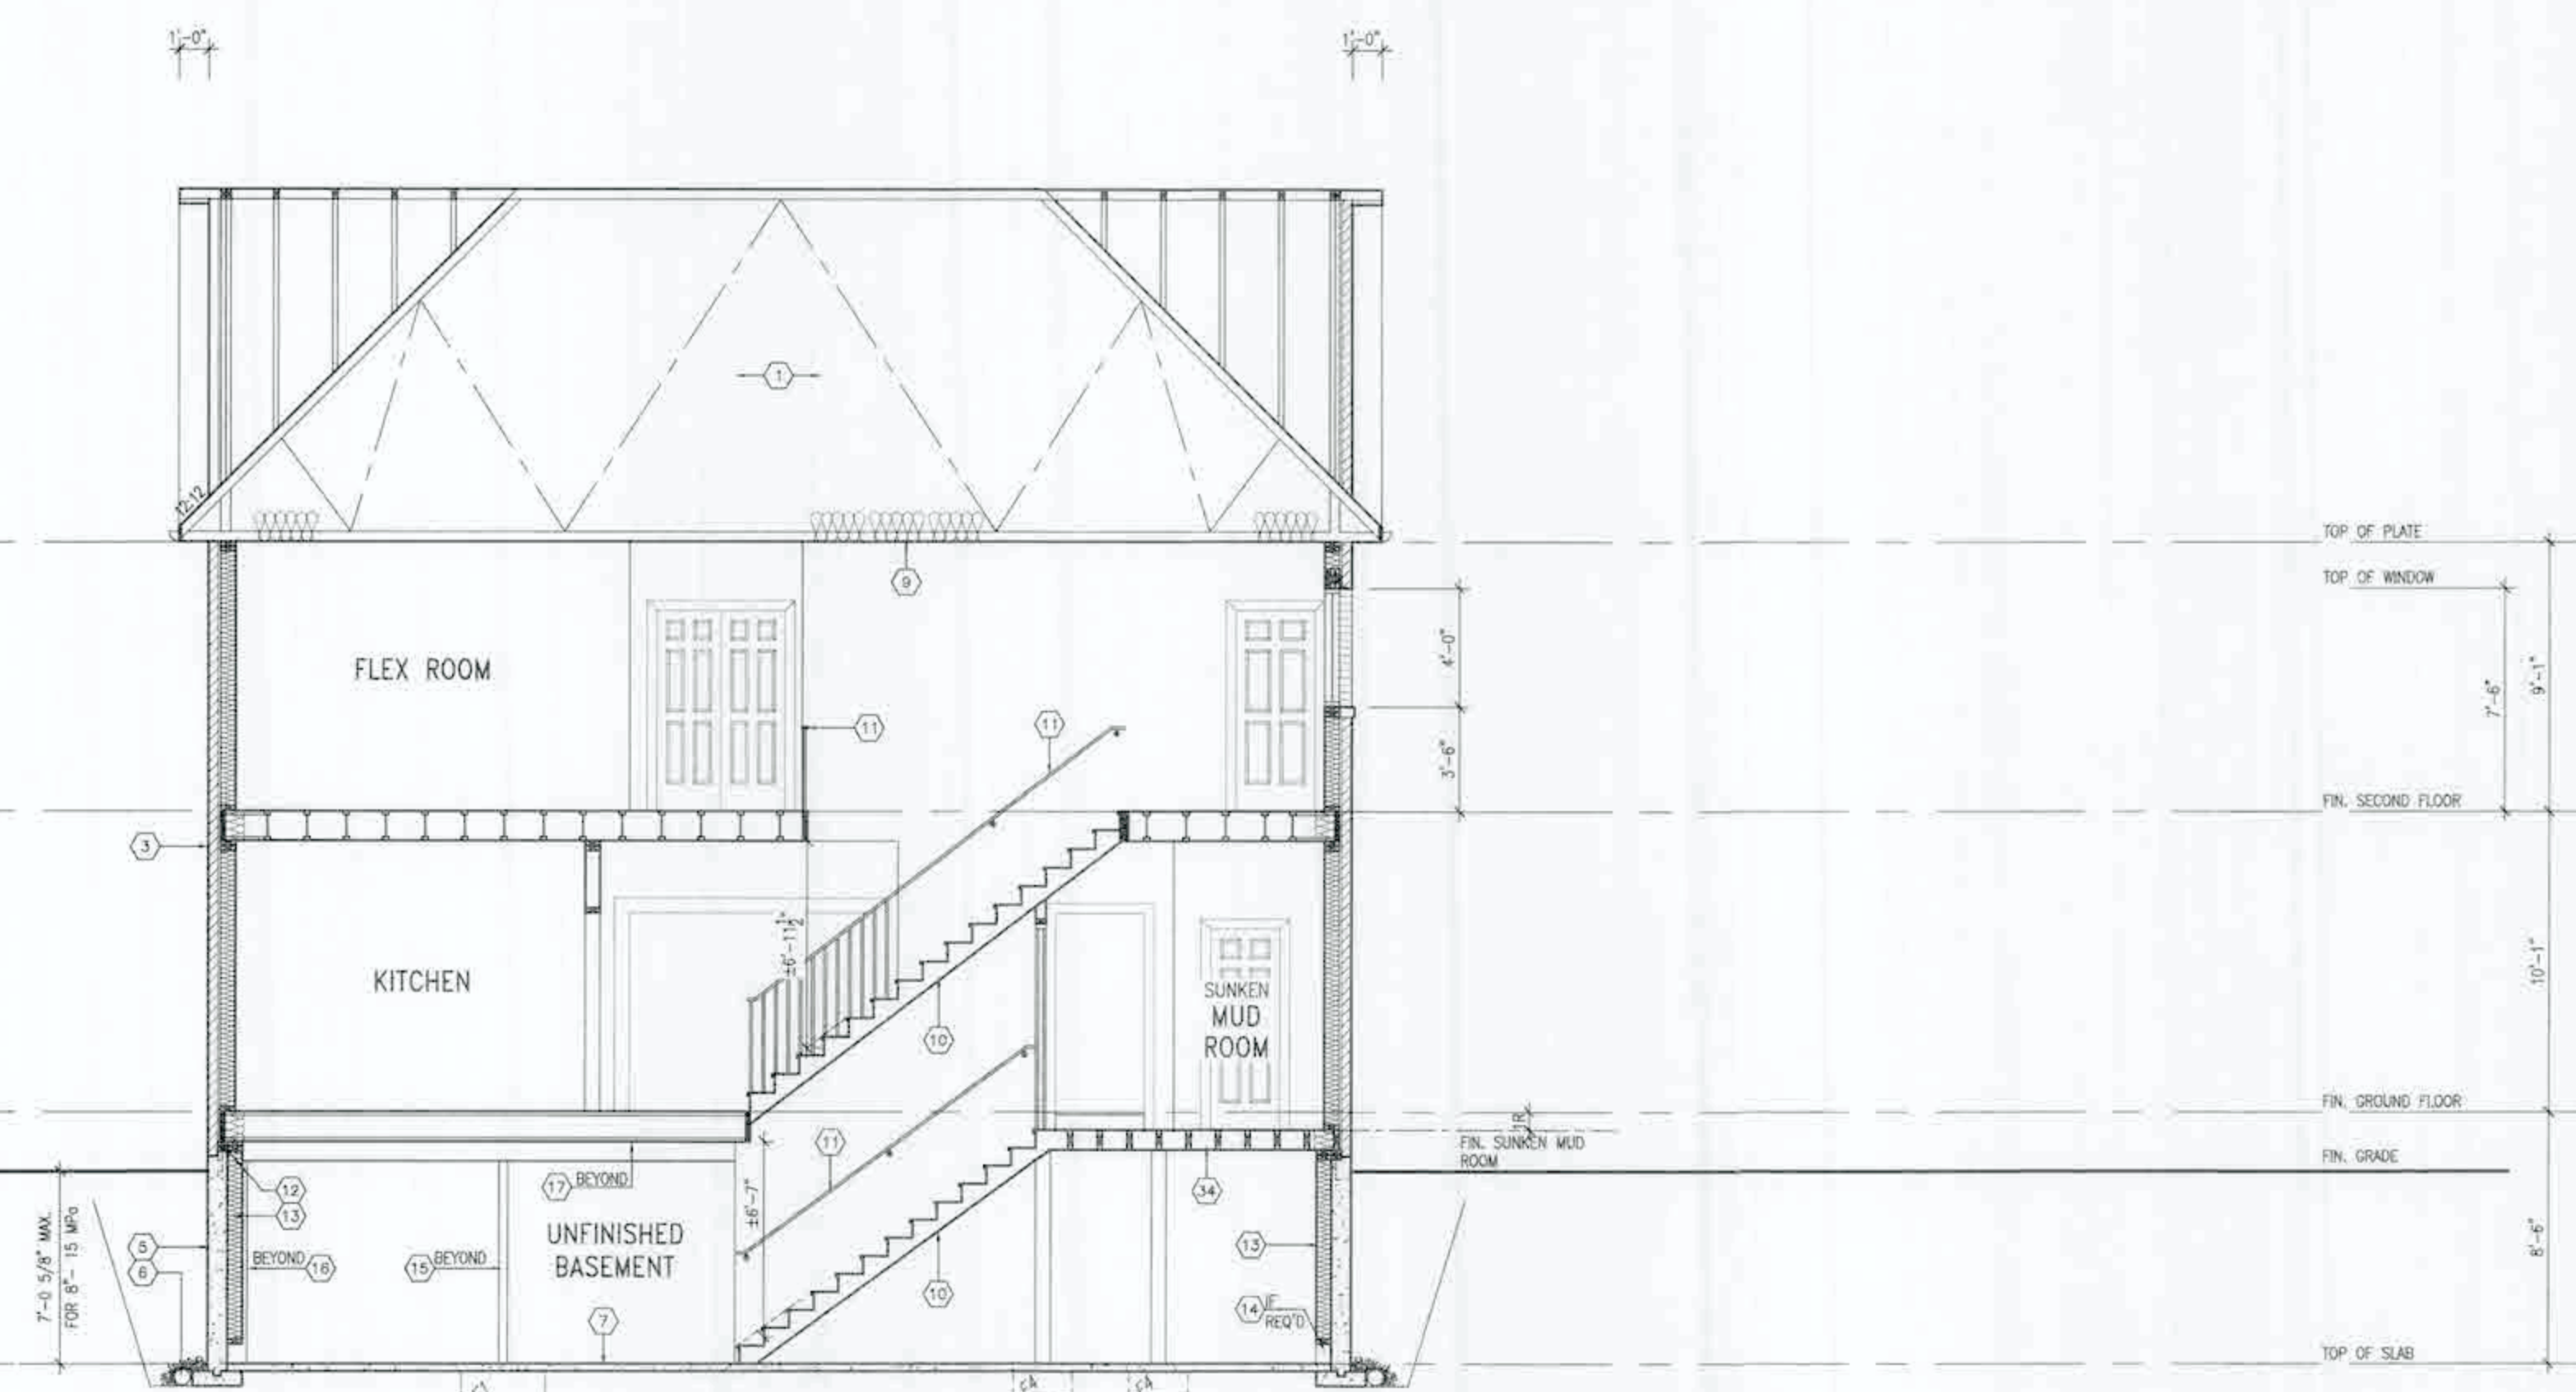

CROSS SECTION A-A - ELEV. '1'

CITY OF HAMILTON
Building Division
Permit No. **21-150884**
THESE STAMPED DRAWINGS SHALL BE AVAILABLE ON SITE
THE OWNER/ARCHITECT/CONTRACTOR SHALL COMPLY WITH
THE ONTARIO BUILDING CODE AND ALL OTHER APPLICABLE LAW
These drawings and/or specifications have been reviewed by
[Signature] **OCT 04 2021**
FOR CHIEF BUILDING OFFICIAL DATE

SPRINGFIELD 2
COMPLIANCE PACKAGE 'A1'


It is the owner's complete responsibility to ensure that all plans submitted for approval fully comply with the Architectural Guidelines and all applicable regulations and requirements including zoning provisions and any provisions in the subdivision agreement. The Contractor/Architect is not responsible in any way for examining or approving the (drawing) plans or working drawings with respect to any zoning or building code or permit matter or that any house can be properly built or located on its lot.

This is to certify that these plans comply with the applicable Architectural Design Guidelines approved by the City of HAMILTON



ELEVATIONS NOT DRAWN TO ACTUAL GRADE.
REFER TO FINAL GRADING PLAN.

18				9	
----	--	--	--	---	--	--	

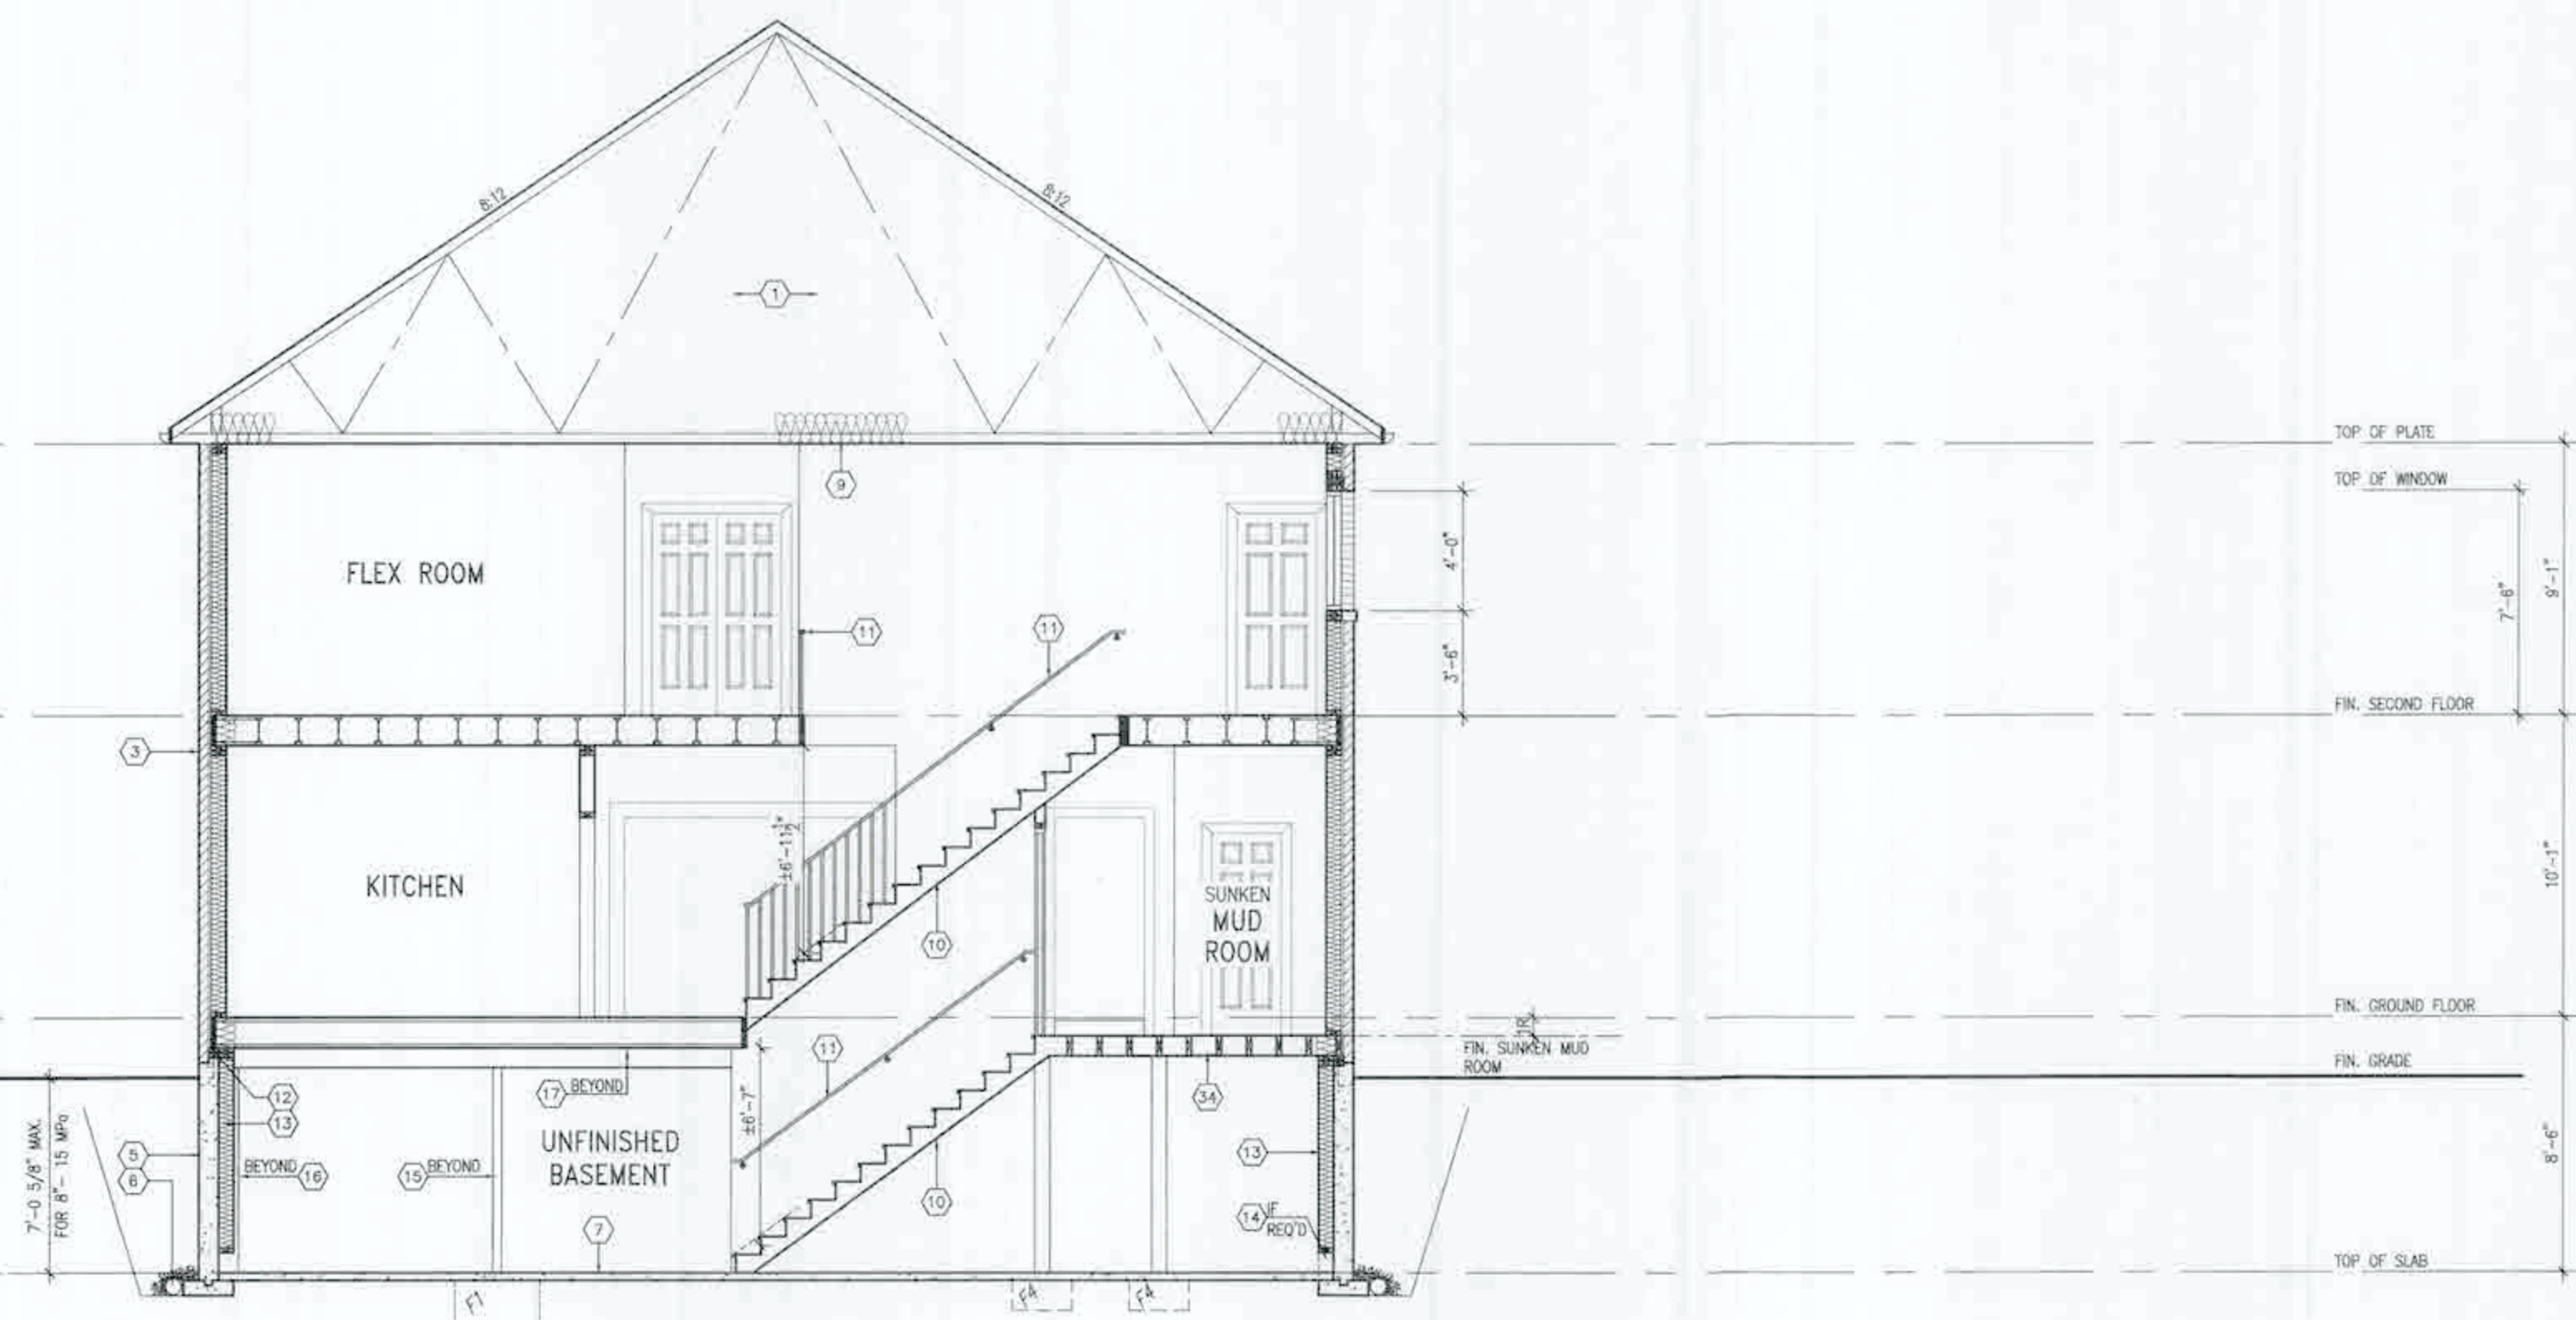

CROSS SECTION A-A - ELEV. '2'

This is to certify that these plans comply with the applicable Architectural Design Guidelines approved by the City of HAMILTON



ELEVATIONS NOT DRAWN TO ACTUAL GRADE.
REFER TO FINAL GRADING PLAN.

16		15		the undersigned has reviewed said items responsibility for this design and has the qualifications and meets the requirements and will be the Designing Building Owner to be a Designer.
17		14		qualification information
18		13		Richard Vink <i>R. Vink</i> 2
19		12		signature
20		11		registration information
21		10		V&J Design Inc. 4
22		9	MAY 21/21	
23		8	APR 27/21	Contractor must verify all dimensions on the job and report any
24		7		discrepancies to the Designer before proceeding, with the necessary drawings and specifications are submitted to service and the
25		6	FEB 19/21	of the Designer which must be returned at the completion of the
26	description	date	by	disclosure
27				




Greenpark.

SPRINGFIELD 2
14.30m

project name RUSSELL GARDENS PH. 4	city HAMILTON, ON.	project no. 20027
date FEB 2021	drawing title CROSS SECTION A-A - ELEV. '2'	
drawn by BO.BM	checked by 3/16" = 1'-0"	file name 20027-SPRINGFIELD-2
drawing no. A7a		

All drawings specifications related documents and design are the copyright property of WKS DESIGN. Reproduction of this property in whole or in part is strictly prohibited without WKS DESIGN's written permission.

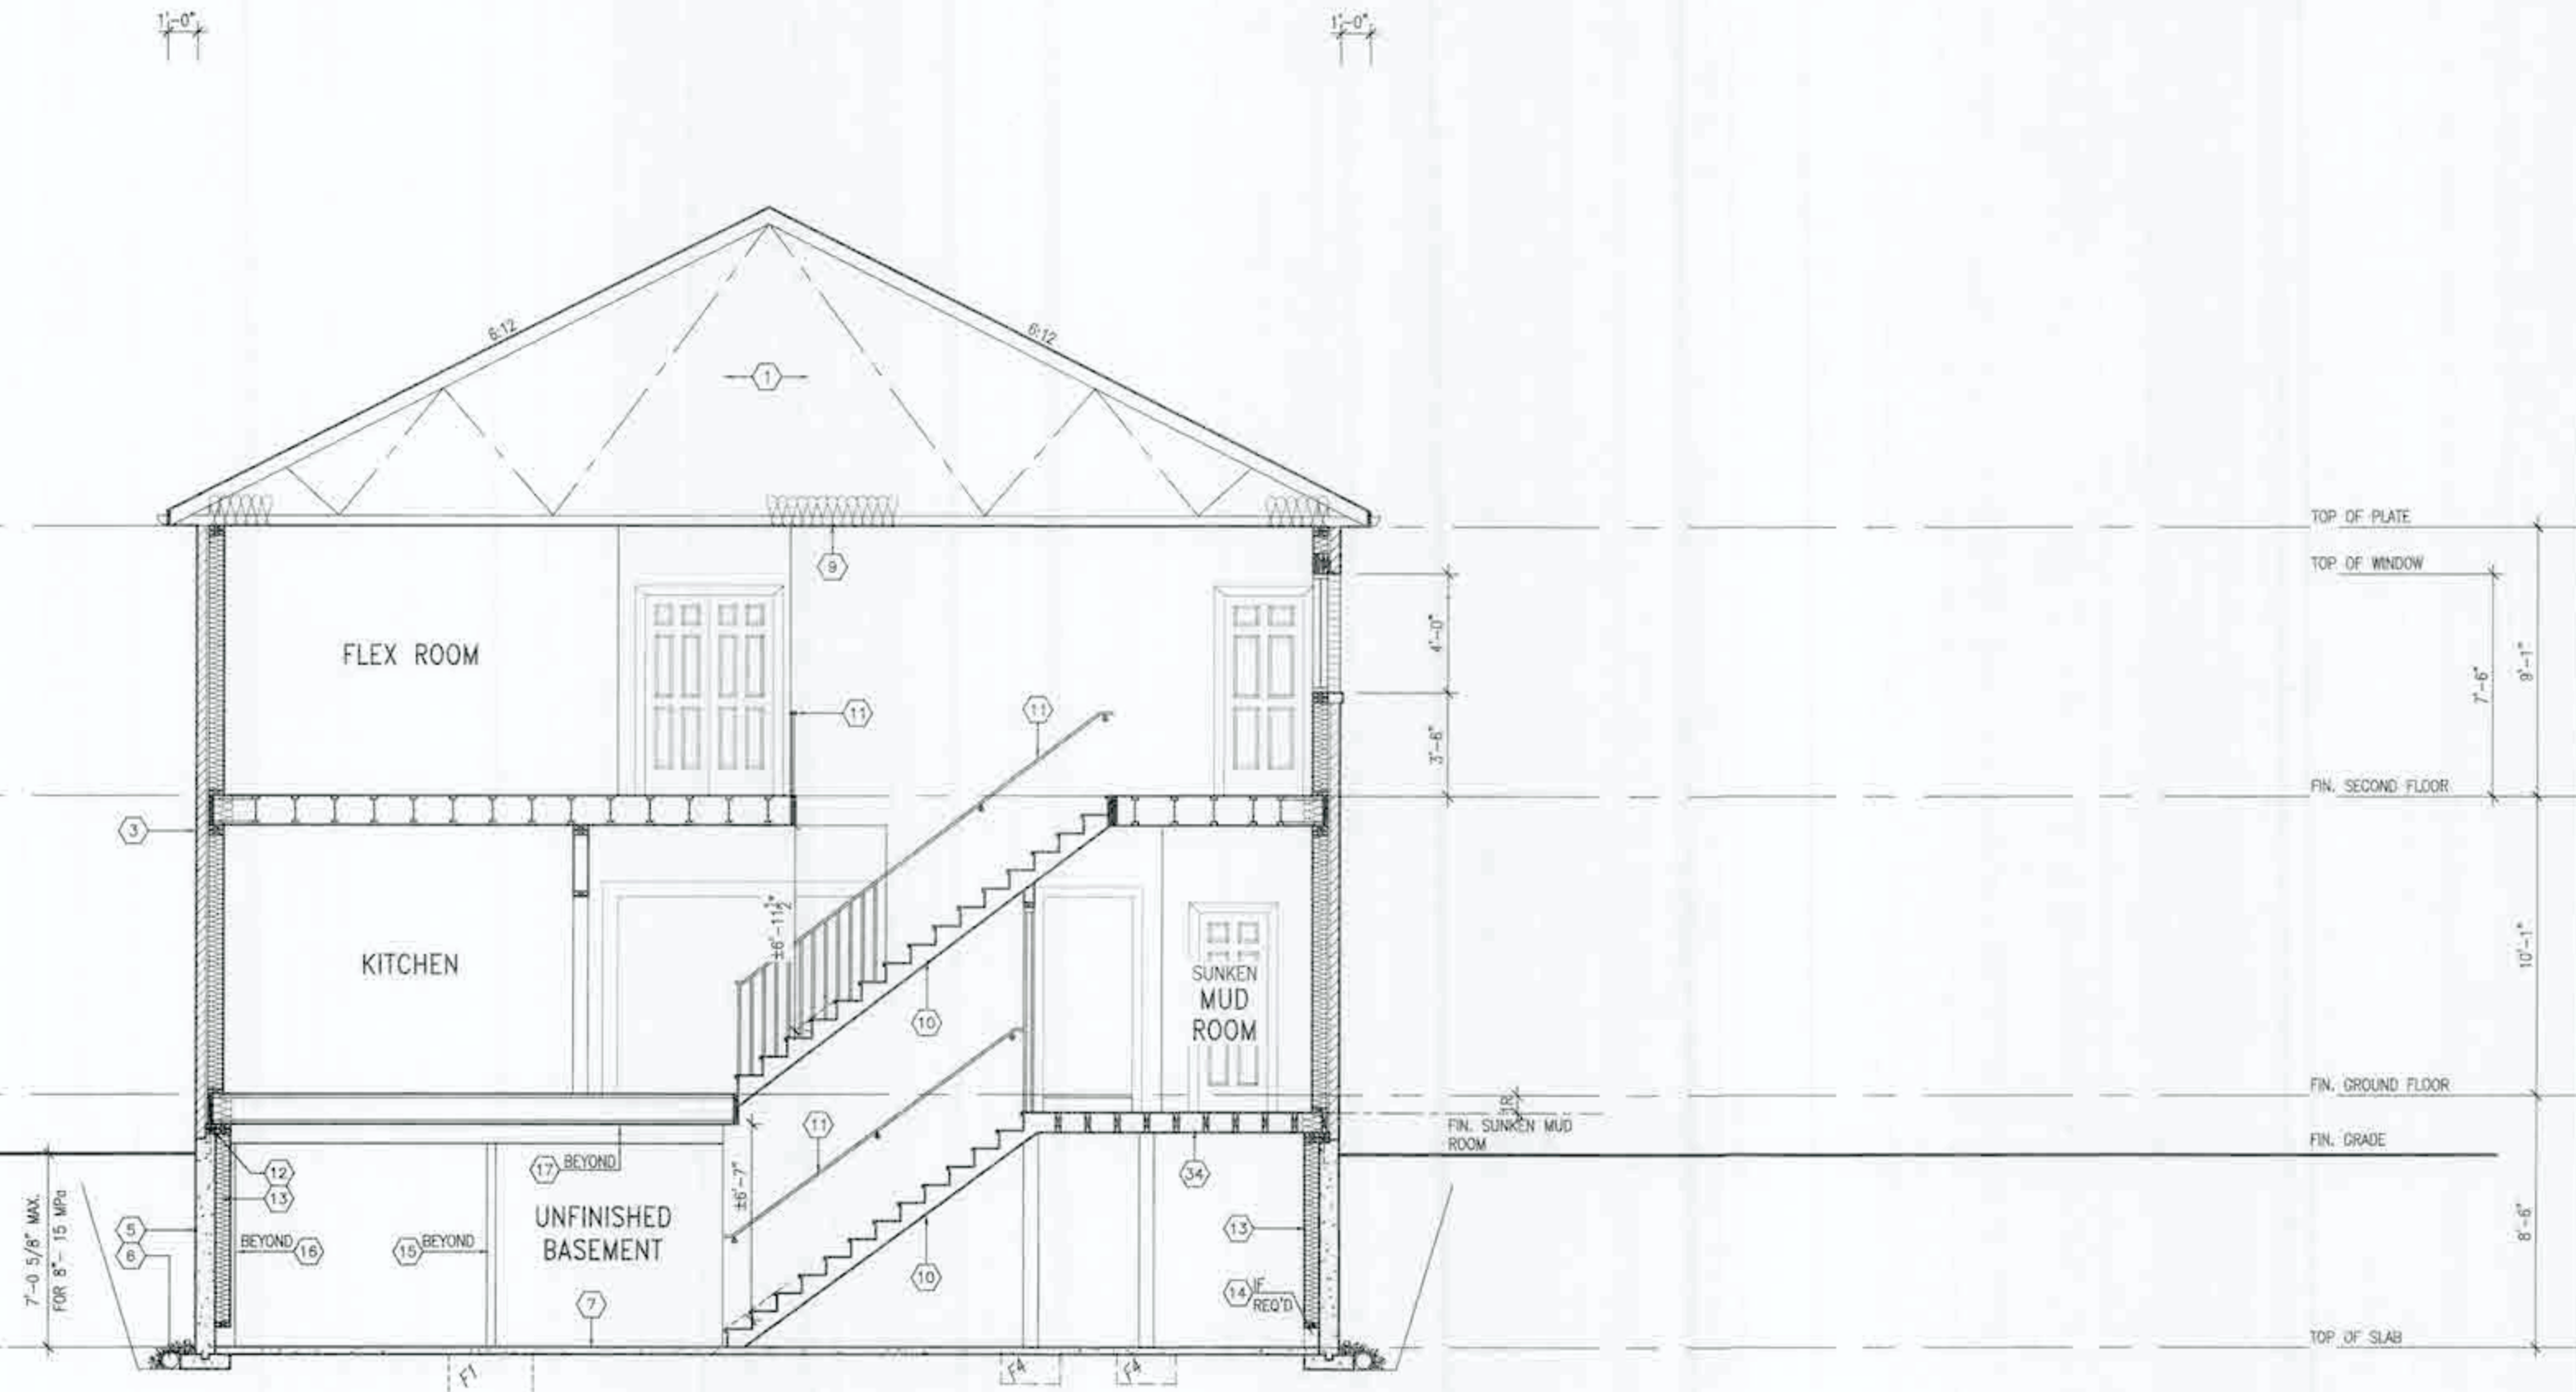

CROSS SECTION A-A - ELEV. '3'

CITY OF HAMILTON
Building Division
Permit No. 21-150884
THESE STAMPED DRAWINGS SHALL BE AVAILABLE ON SITE
THE OWNER AND/OR CONTRACTOR SHALL COMPLY WITH
THE ONTARIO BUILDING CODE AND ALL OTHER APPLICABLE LAW
These drawings and/or specifications have been reviewed by
FOR CHIEF BUILDING OFFICIAL DATE

SPRINGFIELD 2
COMPLIANCE PACKAGE 'A1'



ELEVATIONS NOT DRAWN TO ACTUAL GRADE.
REFER TO FINAL GRADING PLAN.

18		9			
17		8			
16		7			
15		6			
14		5			
13		4			
12		3	ISSUED FOR PERMIT	MAY 21/21	CW
11		2	REV. PER CLIENT/ROOF/FL/ENG. COMMENTS	APR 27/21	CW
10		1	PRELIMINARY. ISSUED FOR CLIENT REVIEW	FEB 19/21	CW
9	description	date	by	date	by

The undersigned has reviewed and taken responsibility for this design and has the qualifications and meets the requirements set out in the Ontario Building Code to be a Designer.
Richard Vink
signature
24485
V3 Design Inc.
42858



Greenpark. **SPRINGFIELD 2**
14.30m
project name: RUSSELL GARDENS PH. 4
location: HAMILTON, ON.
project no.: 20027
date: FEB 2021
drawn by: RD.BM
checked by: 3/16" = 1'-0"
scale: 20027-SPRINGFIELD-2
sheet no.: A7b

It is the builder's complete responsibility to ensure that all plans submitted for approval fully comply with the Architectural Guidelines and all applicable regulations and requirements including zoning provisions and any provisions in the subdivision agreement. The Control Architect is not responsible in any way for examining or approving site (lotting) plans or working drawings with respect to any zoning or building code or permit matter or that any house can be properly built or located on its lot.
This is to certify that these plans comply with the applicable Architectural Design Guidelines approved by the City of HAMILTON



REAR ELEVATION - ELEV. '1'
DECK CONDITION

EXTERIOR RAILINGS:
3'-6" HIGH RAILING IF LANDING IS MORE
THAN 5'-11" ABOVE FINISHED GRADE
AND 3'-0" HIGH RAILING WHEN LANDING
IS LESS THAN 5'-11" ABOVE ADJACENT
FINISHED GRADE.

ELEVATIONS NOT DRAWN TO ACTUAL GRADE.
REFER TO FINAL GRADING PLAN.

CITY OF HAMILTON
Building Division
150884
Permit No. 21-
THERE STAMPED DRAWINGS SHALL BE AVAILABLE ON SITE
THE OWNER AND/OR CONTRACTOR SHALL COMPLY WITH
THE ONTARIO BUILDING CODE AND ALL OTHER APPLICABLE LAW
These drawings and/or specifications have been reviewed by
OCT 04 2021
FOR CHIEF BUILDING OFFICIAL

SPRINGFIELD 2
COMPLIANCE PACKAGE 'A1'

It is the builder's complete responsibility to ensure that all plans submitted for approval fully comply with the Architectural Guidelines and all applicable regulations and requirements including zoning provisions and any provisions in the subdivision agreement. The Control Architect is not responsible in any way for examining or approving site (lotting) plans or working drawings with respect to any zoning or building code or permit matter or that any house can be properly built or located on its lot.

This is to certify that these plans comply with the applicable Architectural Design Guidelines approved by the City of HAMILTON.

KIRIN C. WILLIAMS LTD., ARCHITECT
ARCHITECTURAL CONSULTING
AND APPROVAL
DATE: AUG 10, 2021

18 17 16 15 14 13 12 11 10 9 8 7 6 5 4 3 2 1	ISSUED FOR PERMIT REV. PER CLIENT/ROOF/FL/ENG. COMMENTS PRELIMINARY, ISSUED FOR CLIENT REVIEW DATE BY	24488 42858 255 Consumers Rd. Suite 120 Toronto, ON M2J 1R4 T: 416.630.2255 F: 416.630.4782 va3design.com	VA3 DESIGN	Greenpark. SPRINGFIELD 2 14.50m project no. 20027 project name RUSSELL GARDENS PH. 4 HAMILTON, ON. date FEB 2021 checked by BO.BM scale 3/16" = 1'-0" 20027-SPRINGFIELD-2 sheet no. A9
--	--	---	--	---

3550 SF.



REAR ELEVATION - ELEV. '2'
DECK CONDITION

It is the builder's complete responsibility to insure that all plans submitted for approval fully comply with the Architectural Guidelines and all applicable regulations and requirements including zoning provisions and any provisions in the subdivision agreement. The Control Architect is not responsible in any way for examining or approving site (lotting) plans or working drawings with respect to any zoning or building code or permit matter or that any house can be properly built or located on its lot.

This is to certify that these plans comply with the applicable Architectural Design Guidelines approved by the City of HAMILTON

IRWIN C. WILLIAMS LTD., ARCHITECTS

EXTERIOR RAILINGS:
3'-6" HIGH RAILING IF LANDING IS MORE
THAN 5'-11" ABOVE FINISHED GRADE
AND 3'-0" HIGH RAILING WHEN LANDING
IS LESS THAN 5'-11" ABOVE ADJACENT
FINISHED GRADE.

ELEVATIONS NOT DRAWN TO ACTUAL GRADE.
REFER TO FINAL GRADING PLAN.

VA2
DESIGN

DESIGN
255 Consumers Rd Suite 120
Toronto ON M2J 1R4
T 416.630.2255 F 416.630.4782
v3design.com

Greenpark

Project Name	Municipality	Project Year
RUSSELL GARDENS PH. 4	HAMILTON, ON.	2002

DATE: FEB 2021	REAR ELEVATION - ELEV. '2' - DECK CONDITION		drawing no.
drawn by: J. B. B.	checked by: J. B. B.	scale: 3/16" = 1'-0"	A9a
0.25M		20027-SPRINGFIELD-2	

CITY OF HAMILTON
Building Division
Permit No. 21-150884

THESE STAMPED DRAWINGS SHALL BE AVAILABLE ON SITE
THE OWNER AND/OR CONTRACTOR SHALL COMPLY WITH
THE ONTARIO BUILDING CODE AND ALL OTHER APPLICABLE LAW

These drawings and/or specifications have been reviewed by
[Signature] **07/10/2021**
FOR CHIEF BUILDING OFFICIAL DATE

SPRINGFIELD 2
COMPLIANCE PACKAGE 'A1'

SPRINGFIELD 2
14.30m

2002

DECK CONDITION	drawing no.
file name	A9a
20027-SPRINGFIELD-2	


3550 SF.



REAR ELEVATION - ELEV. '3'
DECK CONDITION


If is the builder's complete responsibility to ensure that all plans submitted for approval fully comply with the Architectural Guidelines and all applicable regulations and requirements including zoning provisions and any provisions in the subdivision agreement. 

This is to certify that these plans comply with the applicable Architectural Design Guidelines approved by the City of HAMILTON.

EXTERIOR RAILINGS:
3'-6" HIGH RAILING IF LANDING IS MORE
THAN 5'-11" ABOVE FINISHED GRADE
AND 3'-0" HIGH RAILING WHEN LANDING
IS LESS THAN 5'-11" ABOVE ADJACENT
FINISHED GRADE.

ELEVATIONS NOT DRAWN TO ACTUAL GRADE.
REFER TO FINAL GRADING PLAN.

[illegible]

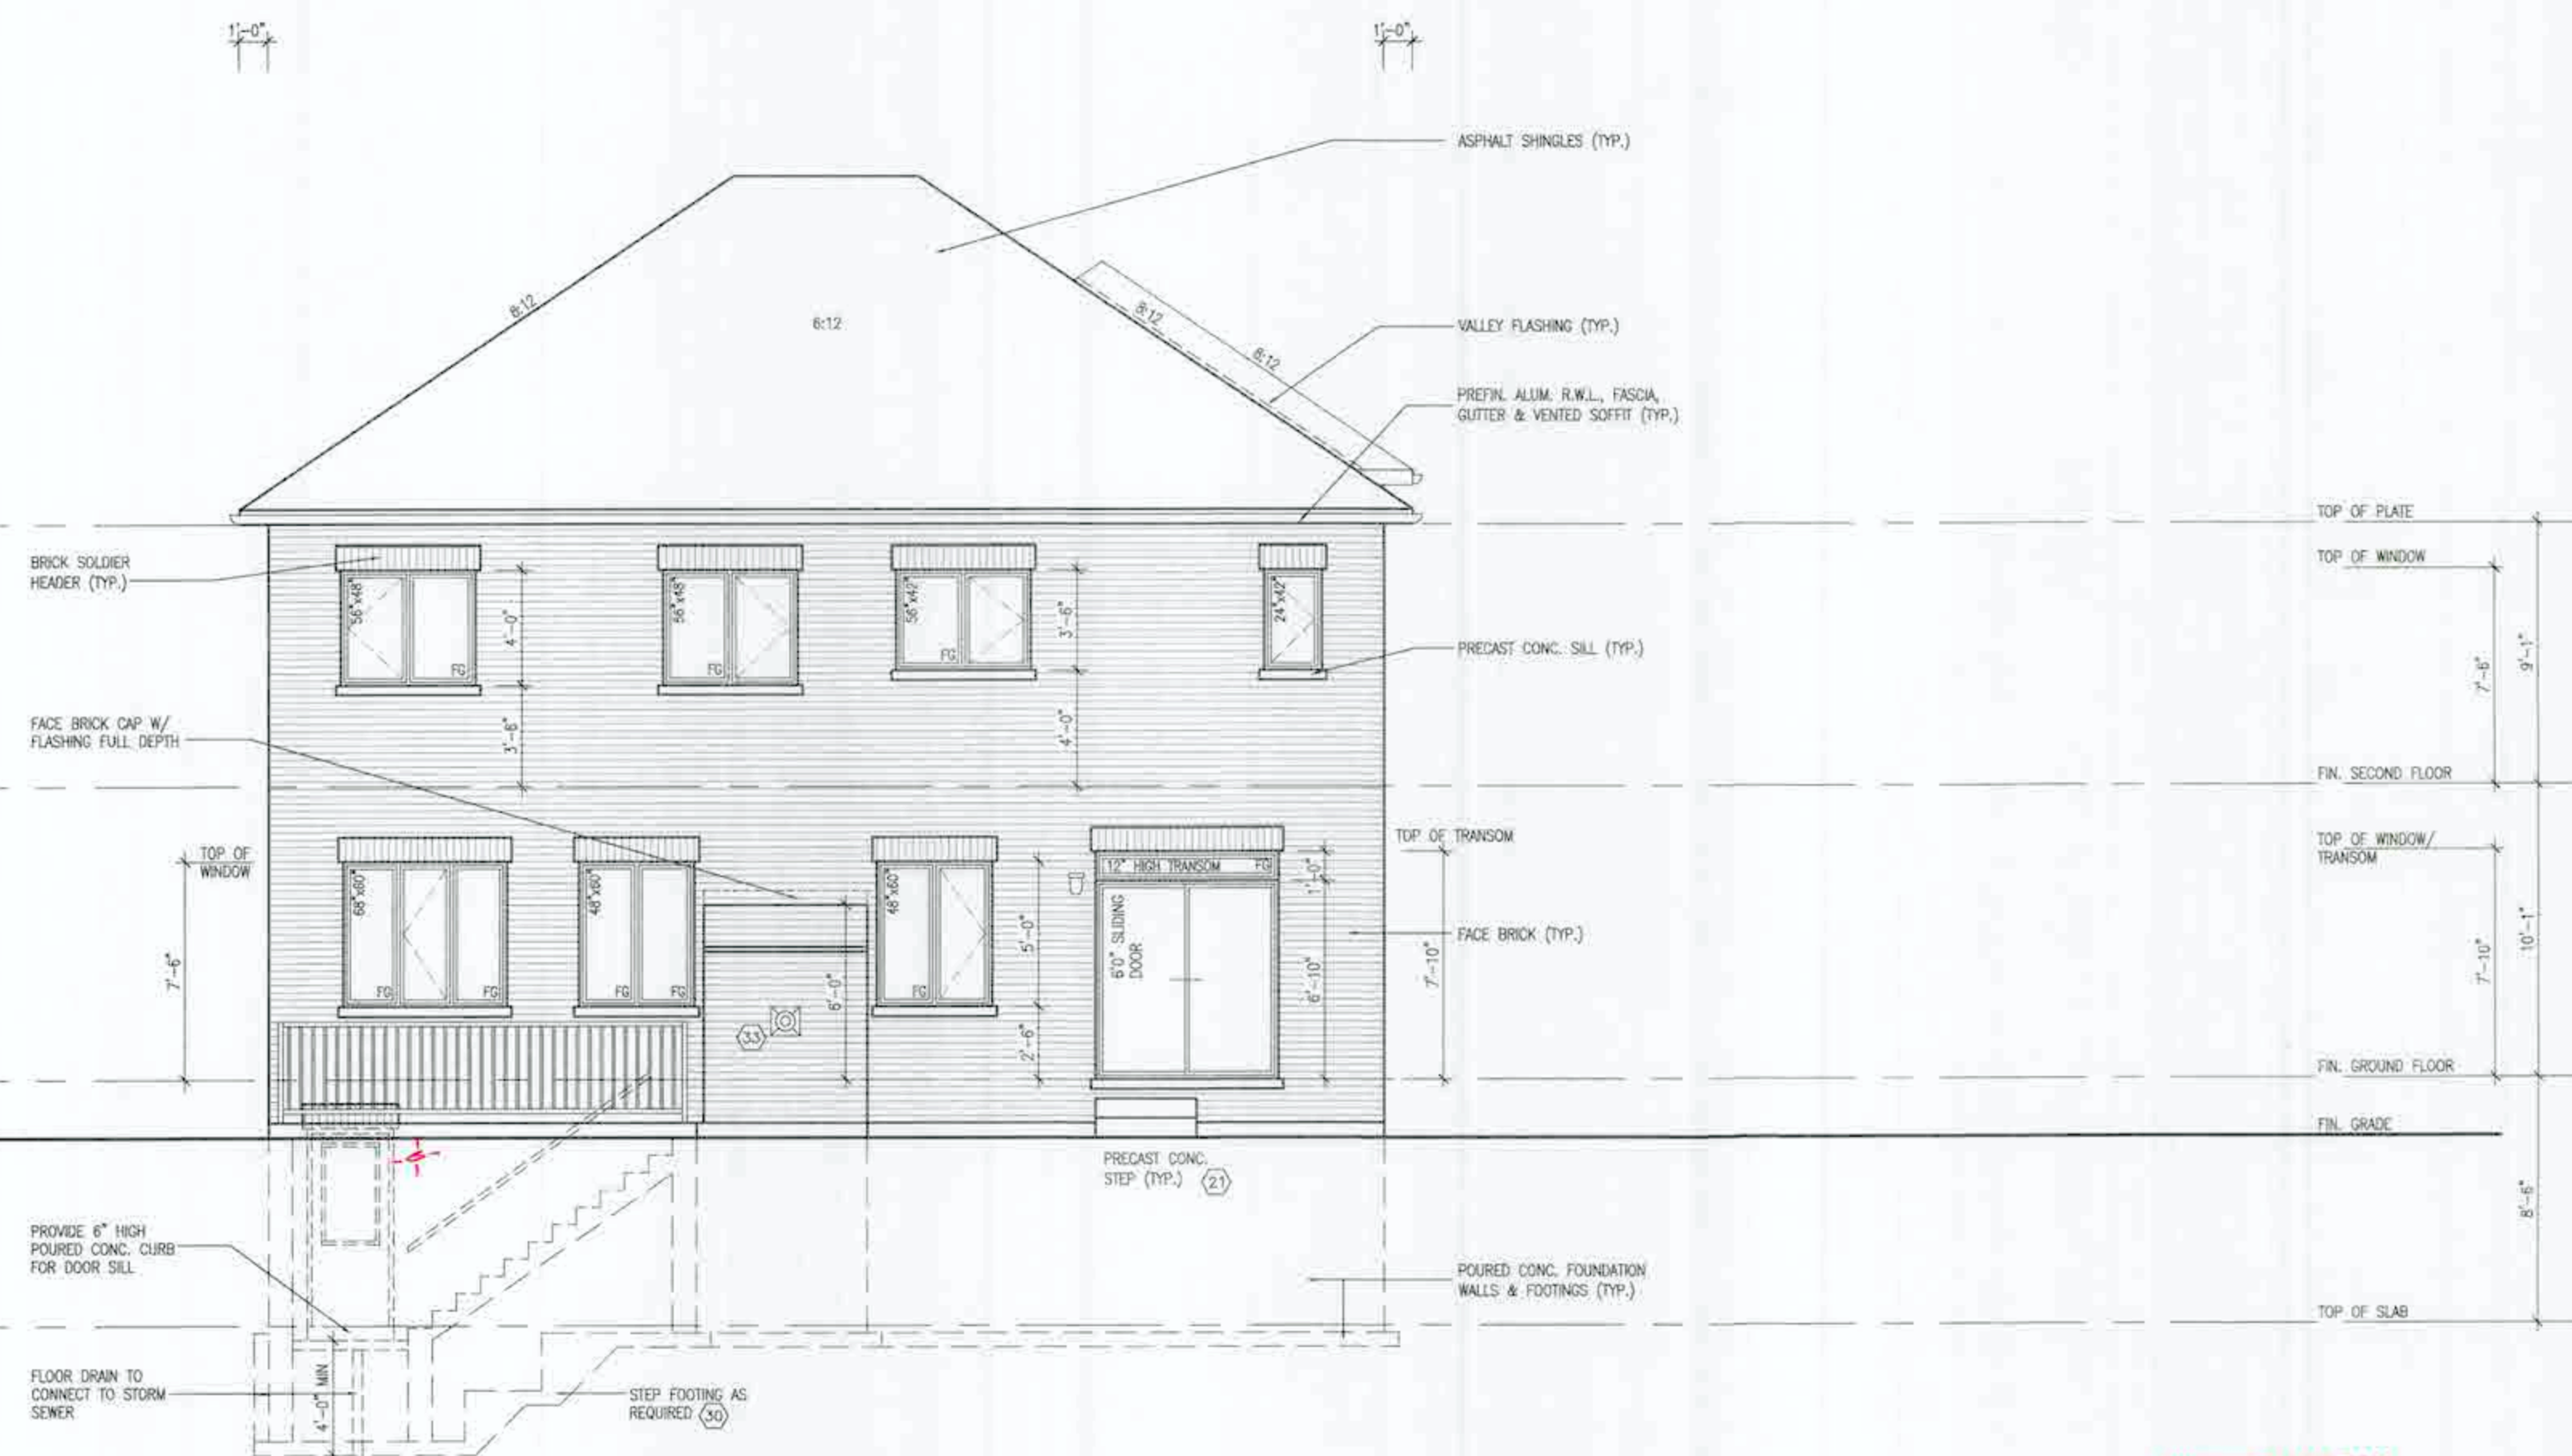

REAR ELEVATION - ELEV. '2'
w/ OPT. WALK-UP STAIRS

It is the builder's complete responsibility to ensure that all plans submitted for approval fully comply with the Architectural Guidelines and all applicable regulations and requirements including zoning provisions and any provisions in the subdivision agreement. The Control Architect is not responsible in any way for examining or approving site (lotting) plans or working drawings with respect to any zoning or building code or permit matter or that any house can be properly built or located on its lot.

This is to certify that these plans comply with the applicable Architectural Design Guidelines approved by the City of HAMILTON



ELEVATIONS NOT DRAWN TO ACTUAL GRADE.
REFER TO FINAL GRADING PLAN.

[illegible]

All database specifications, related documents and forms are the confidential property of VAI (ESON). Reproduction of this property in whole or in part is strictly prohibited without VAI (ESON)'s written permission.

三

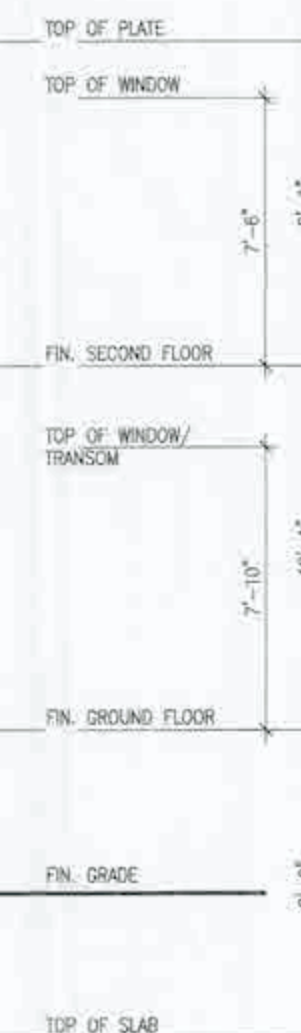

EXTERIOR RAILINGS:
3'-6" HIGH RAILING IF LANDING IS MORE
THAN 5'-11" ABOVE FINISHED GRADE
AND 3'-0" HIGH RAILING WHEN LANDING
IS LESS THAN 5'-11" ABOVE ADJACENT
FINISHED GRADE.

It is the builder's complete responsibility to ensure that all plans submitted for approval fully comply with the Architectural Guidelines and all applicable regulations and requirements including zoning provisions and any provisions in the subdivision agreement. The Control Architect is not responsible in any way for examining or approving site (lotting) plans or working drawings with respect to any zoning or building code or permit matter or that any house can be properly built or located on the lot.




18		9			The undersigned has reviewed and takes responsibility for this design and has the qualifications and meets the requirements set out in the Ontario Building Code to be a Designer.
17		8			qualification information:
16		7			Richards Vink
15		6			signature
14		5			Richards Vink 244
13		4			regulation information
12		3			ISSUED FOR PERMIT MAY 21/21 CN 625
11		2			REV. PER CLIENT/ROOF/F/L/ENG. COMMENTS APR 27/21 CN
10		1			PRELIMINARY ISSUED FOR CLIENT REVIEW FEB 18/21 CN
9	description	date	by no	description	date by

VA3
DESIGN

255 Consumers Rd. Suite
Toronto ON M2J 1R4

416.530.2255 | 416.630.4444
www.v3design.com

Greenpark.

SPRINGFIELD 2
14.30m

project name	municipality	project no.
RUSSELL GARDENS PH. 4	HAMILTON, ON.	20027
date	location	revision no.

UPGRADED REAR ELEV. 3 - DECK CONDITION

32 BD.BW = 3/16" = 1'-0" 20027-SPRINGFIELD-2

All database specifications, related documents and data are the copyright property of V&J DESIGN. Reproduction of this property in whole or in part is strictly prohibited without V&J DESIGN's written permission.