


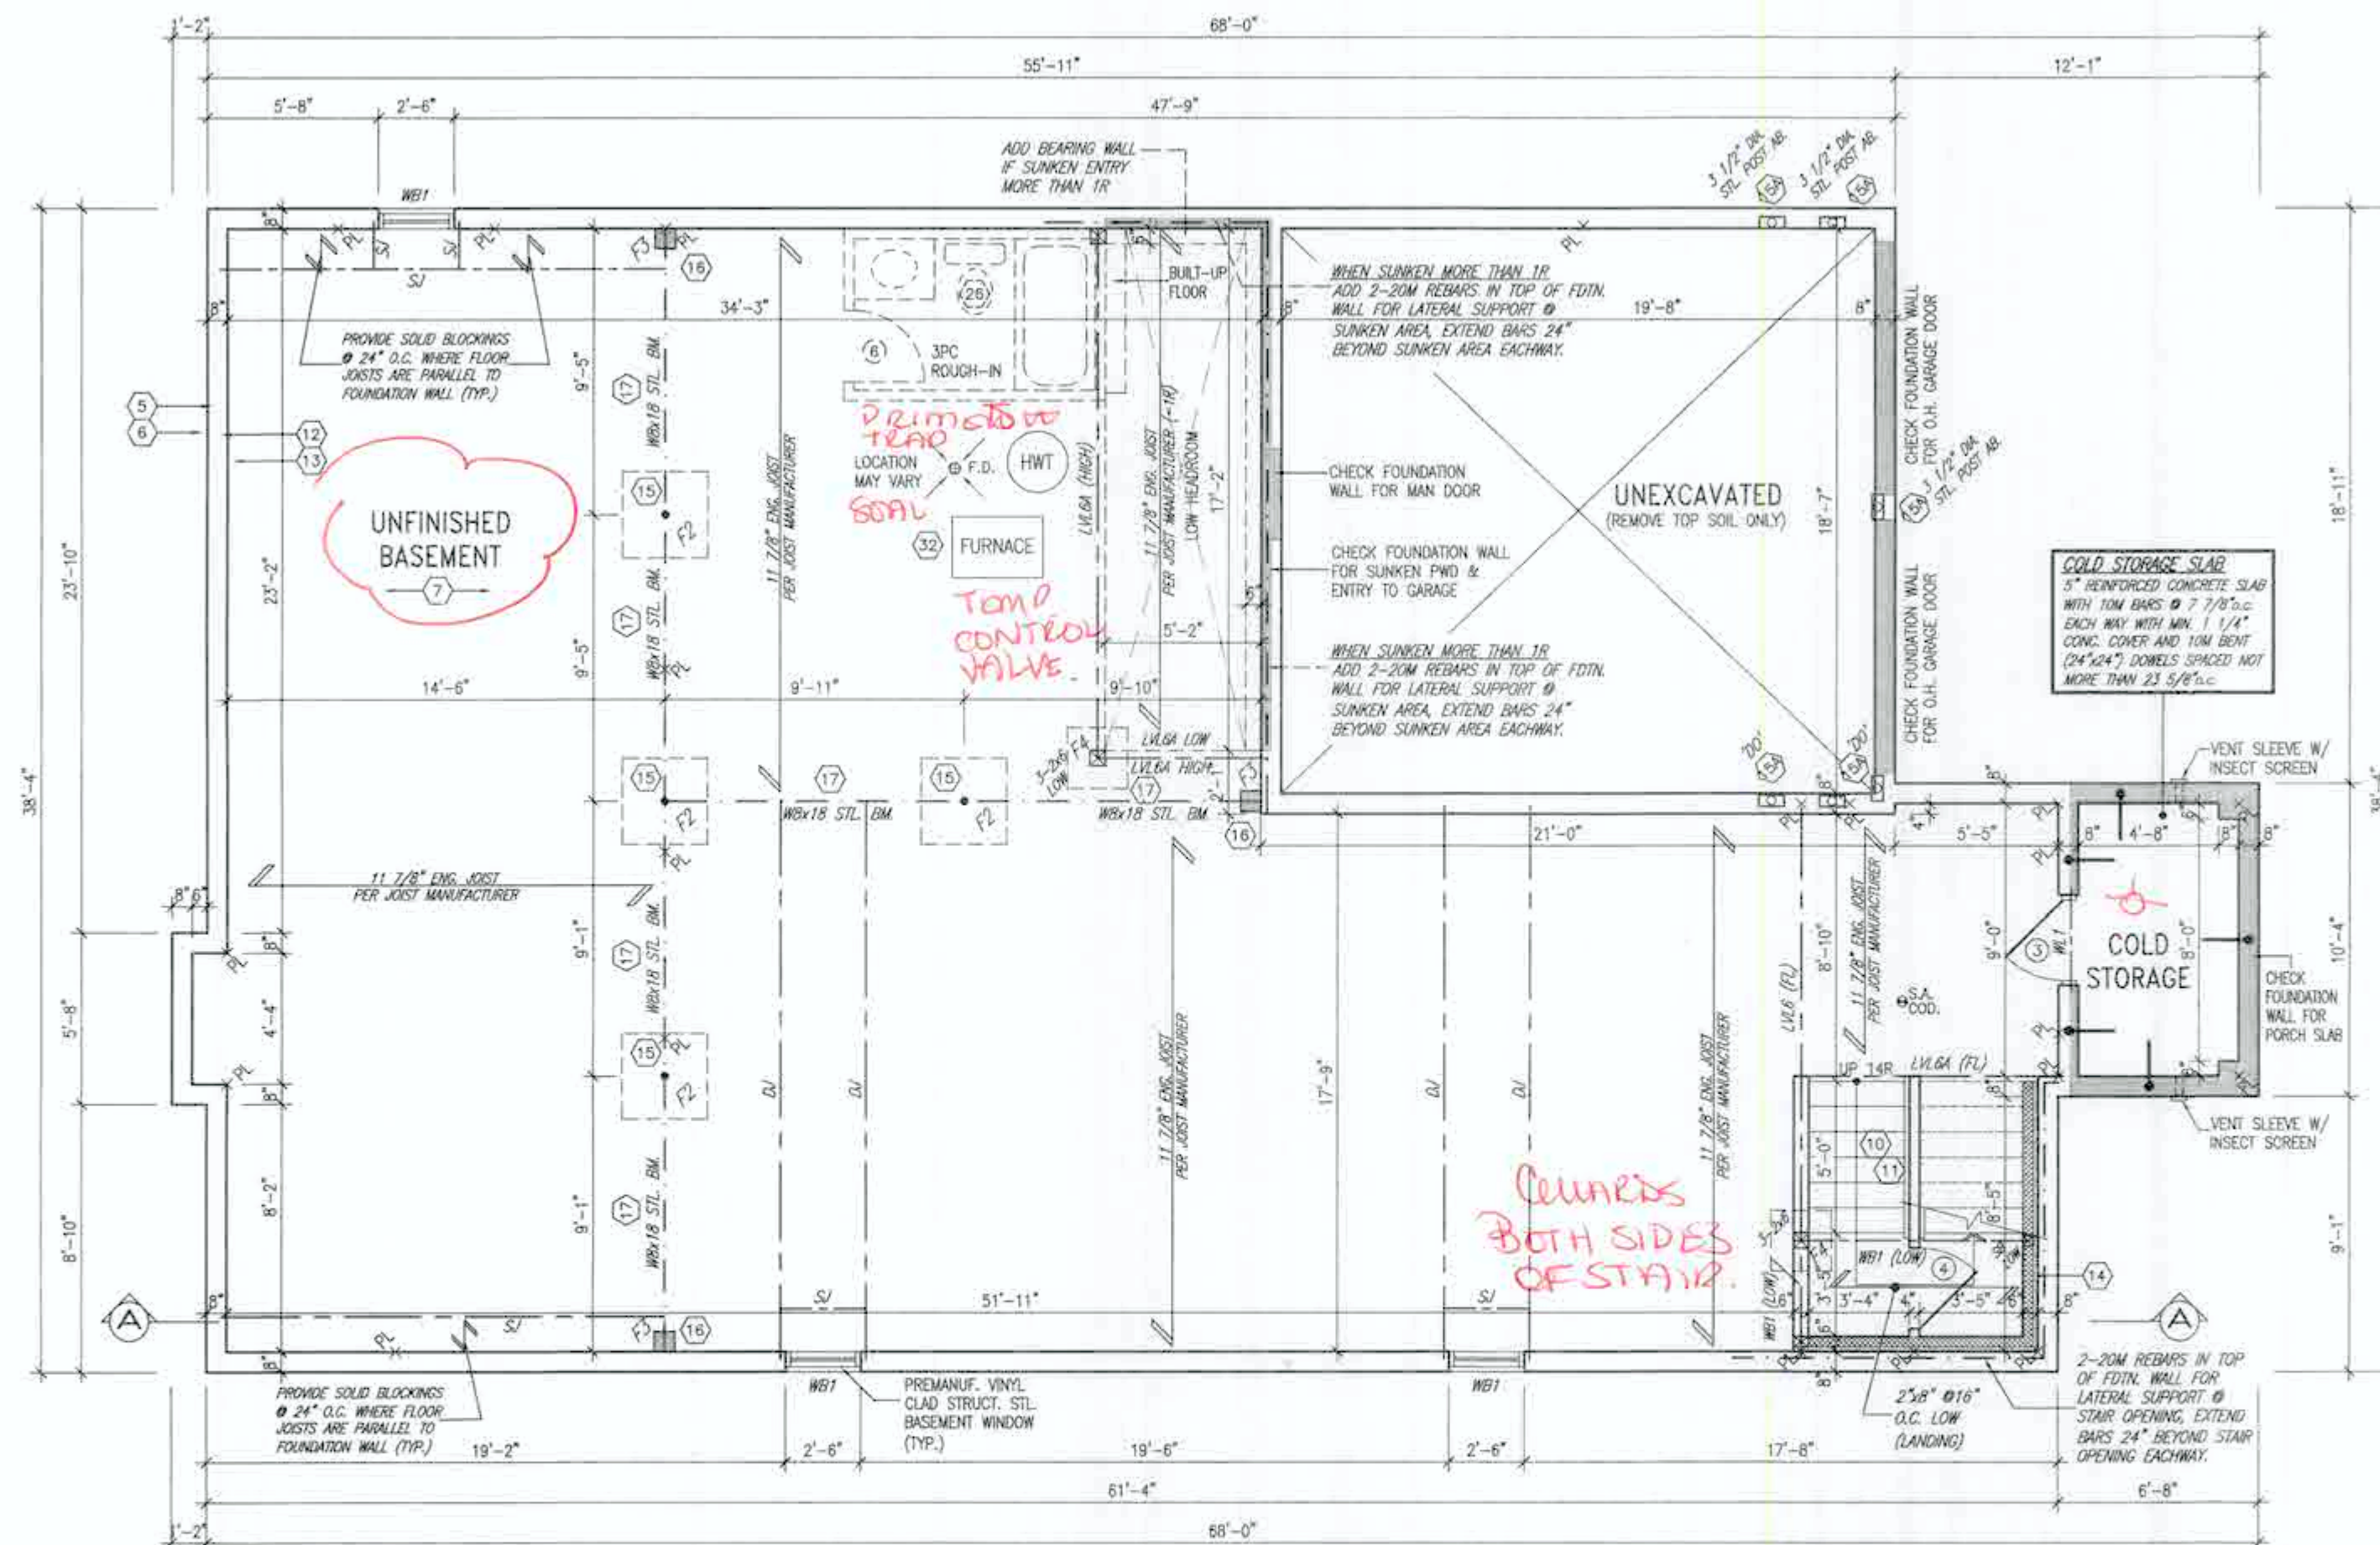

BASEMENT PLAN - ELEV. '1'

BASEMENT WALL INSULATION
(TYP) (13)
-6" (R20) CONTINUOUS BLANKET
INSULATION. INSULATION
UNINTERRUPTED BY FRAMING.

**BASEMENT INSULATION AT
STAIR/SUNKEN AREAS**
-2" (R10) CONTINUOUS INSULATION
(RIGID or SPRAY FOAM).
-2"x4" @ 16" o.c. w/ R12 BATT
INSULATION & 1/2" DRYWALL FINISH
-EXTEND EXTERIOR WALL FOOTING TO
SUPPORT 2"x4" WALL WHERE LOAD
BEARING.

It is the builder's complete responsibility to
ensure that all plans submitted for approval
fully comply with the Architectural Guidelines
and all applicable regulations and requirements
including zoning provisions and any provisions
in the subdivision agreement. The Control
Architect is not responsible in any way for
examining or approving site (lotting) plans or
working drawings with respect to any zoning or
building code or permit matter or that any
house can be properly built or located on its lot.

This is to certify that these plans comply
with the applicable Architectural Design
Guidelines approved by the City of
Hamilton.



STRUDET INC.
FOR STRUCTURE ONLY

no.	description	date	by	no.	description	date	by
18				1			
17				2			
16				3			
15				4			
14				5			
13				6			
12				7			
11				8			
10				9			
9				10			
8				11			
7				12			
6				13			
5				14			
4				15			
3				16			
2				17			
1				18			

The undersigned has reviewed and takes responsibility for this design
and has the qualifications and meets the requirements set out in the
Ontario Building Code to be a Designer.
signature information
Richard Vink
name
registration information
VAS Design Inc.
DCN
24488
42658

**VAS
DESIGN**
255 Consumers Rd Suite 120
Toronto, ON M2J 1R4
T 416.630.2255 F 416.630.4782
vasdesign.com

Greenpark.

project name
RUSSELL GARDENS PH. 4
Hamilton, ON.
drawing no.
BASEMENT PLAN - ELEV. 1
file name
20027-SPRINGFIELD-4
drawing scale
3/16" = 1'-0"
drawing date
2022-07-14

SPRINGFIELD 4
14.30m


project no.
20027
drawing no.
A1



120	 Greenpark™	SPRINGFIELD 4 14.30m	4
4700	project name RUSSELL GARDENS PH. 4	municipality HAMILTON, ON.	project no. 20027
	date FEB 2021	drawing title GROUND FLOOR PLAN - ELEV. 1	drawing no. A2
	drawn by TP	scale 3/16" = 1'-0"	drawing title 20027-SPRINGFIELD-4



 Greenpark.		SPRINGFIELD 4 14.30m	
project name	RUSSELL GARDENS PH. 4	municipality	HAMILTON, ON.
date	FEB 2021	project no.	20027
drawn by	checkboxed by	GROUND FLOOR PLAN - ELEV. 2 3/16" = 1'-0"	
1" = 1'-0"		20027-SPRINGFIELD-4 NEW LOT 1, 2, 3 & 4	
A2a		A2a	

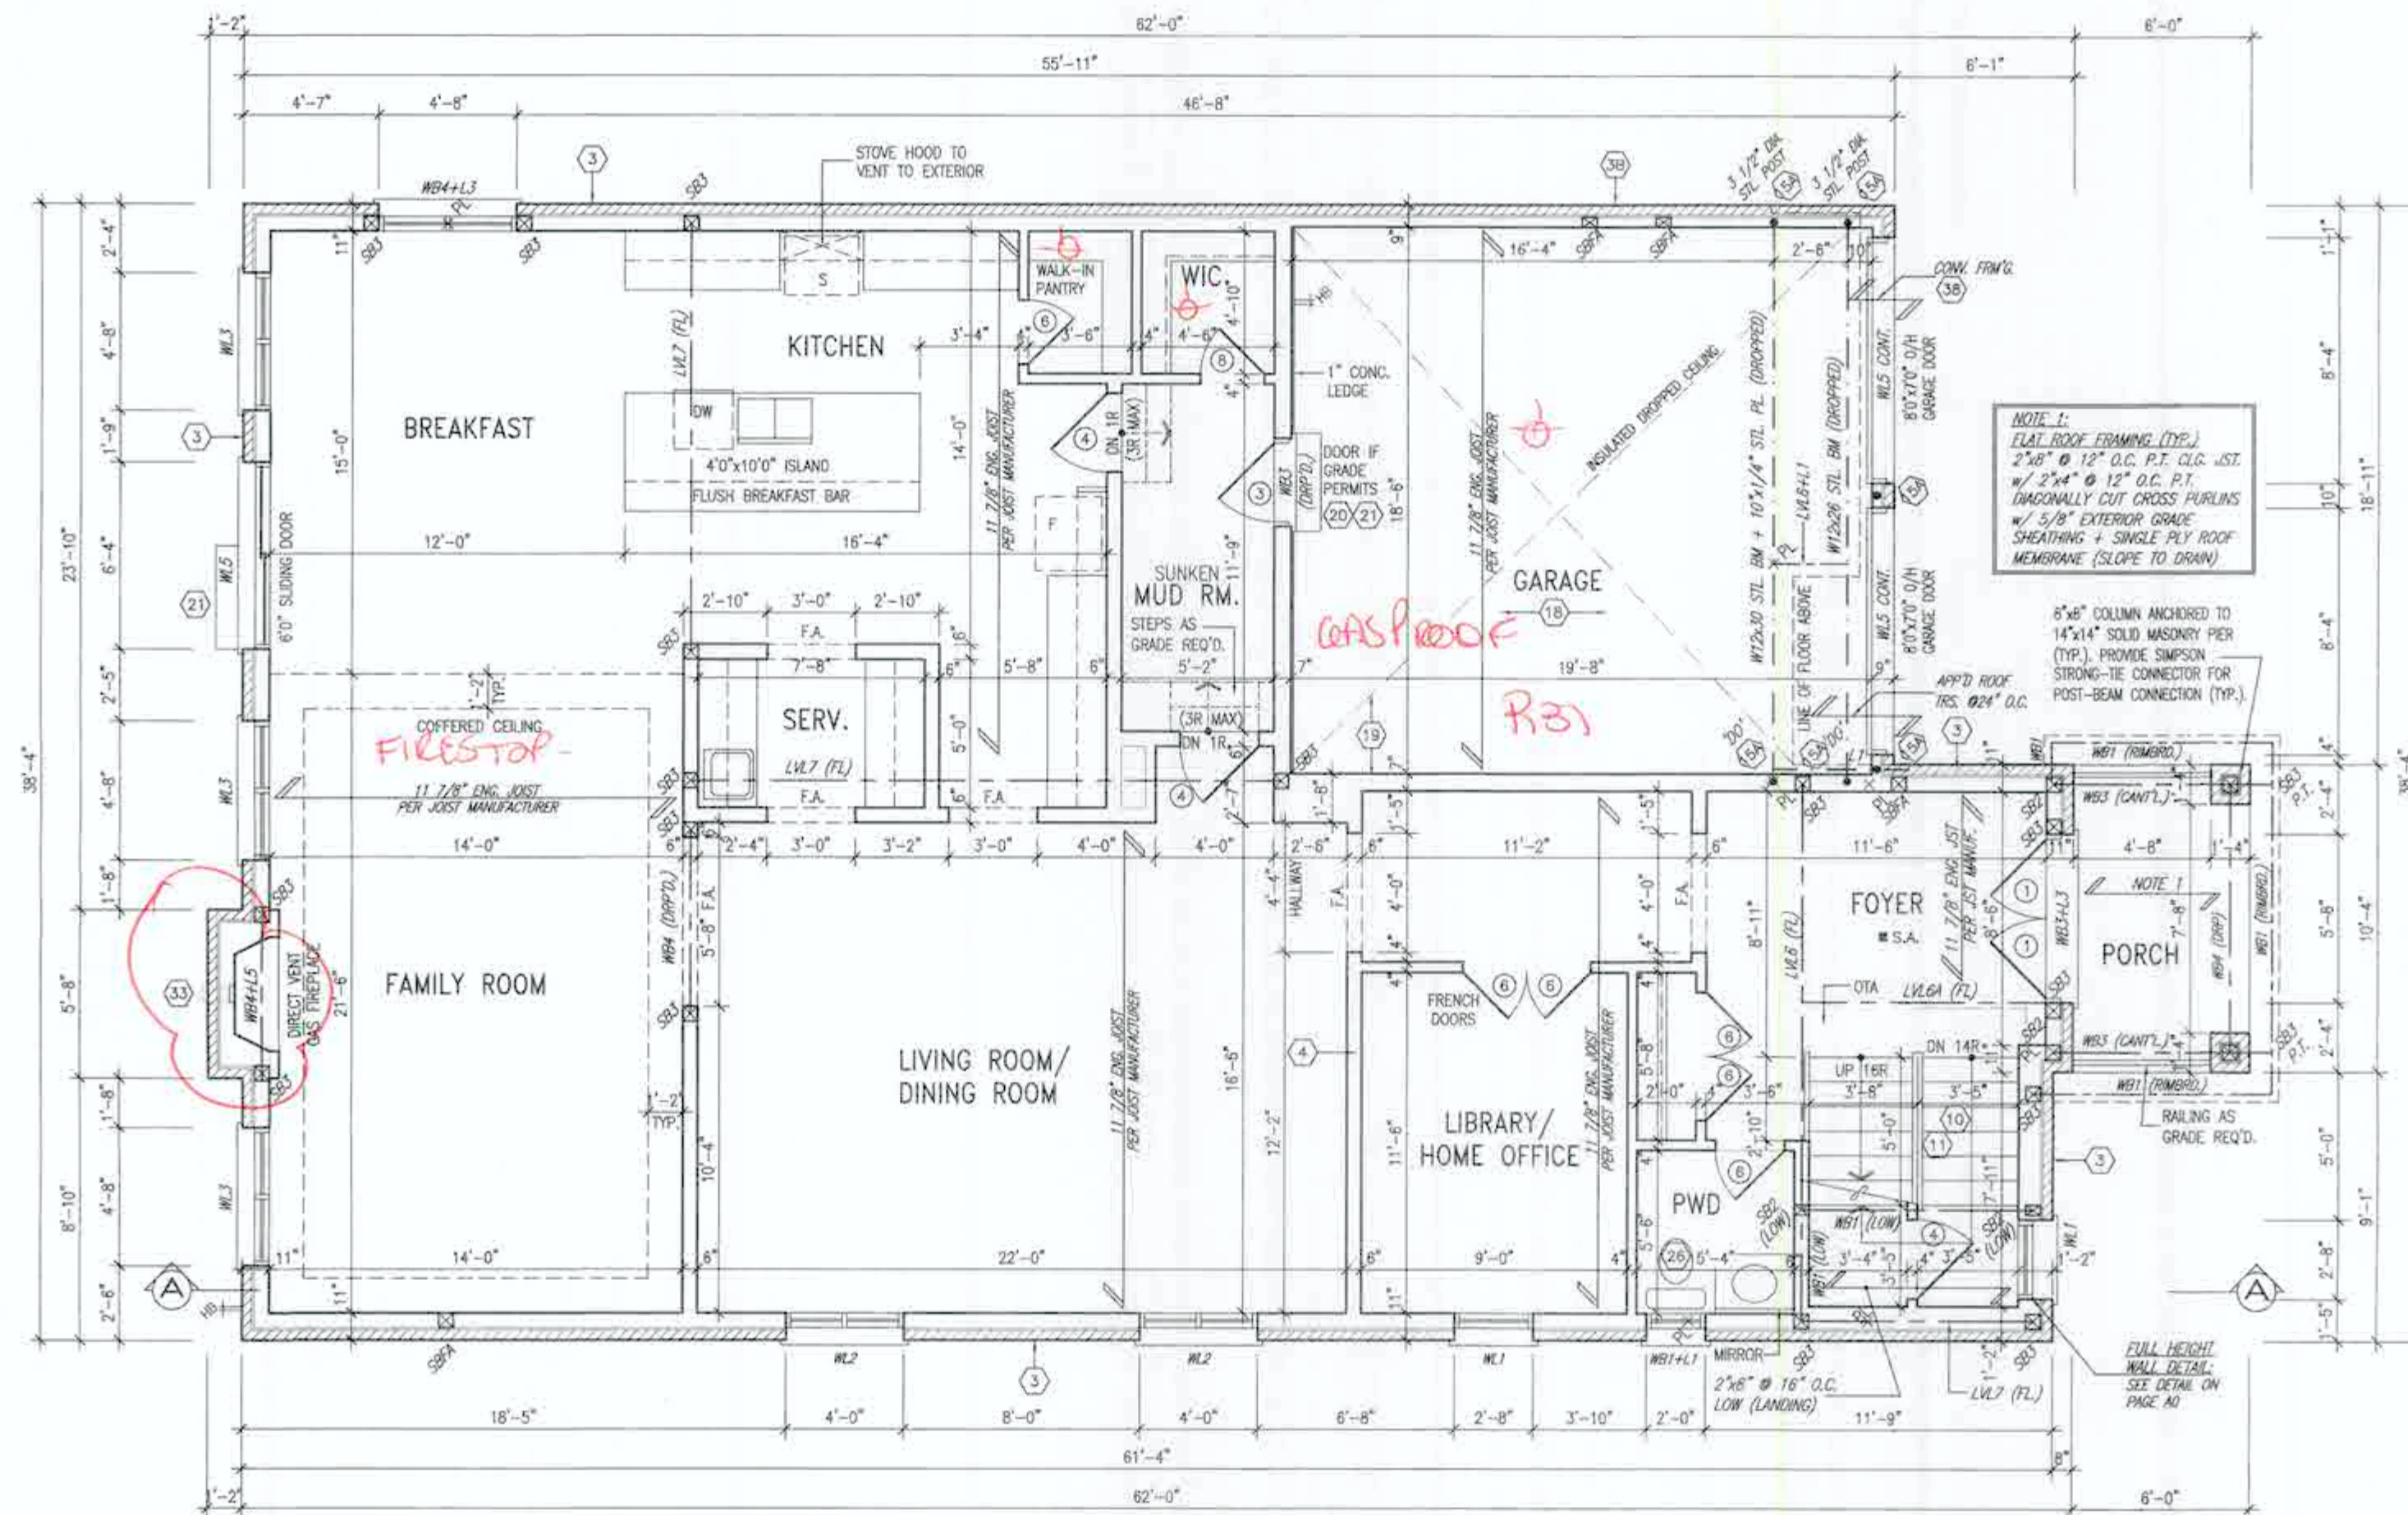

21 149940

Jim Oct. 30/24

SPRINGFIELD 4
COMPLIANCE PACKAGE 'A1'

Greenpark™ SPRINGFIELD 4

14.30m	
SELL GARDENS PH. 4	HAMILTON, ON.
project no.	20027

021 GROUND FLOOR PLAN - ELEV. 3 drawing no. A2b

WAZ DESIGN. Reproduction of this property in whole or in part is strictly prohibited without WAZ DESIGN's written permission.

It is the builder's complete responsibility to ensure that all plans submitted for approval fully comply with the Architectural Guidelines and all applicable regulations and requirements including zoning provisions and any provisions in the subdivision agreement. The Control Architect is not responsible in any way for examining or approving any (existing) plans or working drawings with respect to any zoning or building code or permit matter or that any house can be properly built or located on its lot.

This is to certify that these plans comply with the applicable Architectural Design Guidelines approved by the City of HAMILTON.


STRUDET INC
FOR STRUCTURE ONLY

[illegible]

VA3
DESIGN

230 Consumers Rd Suite 1
Toronto ON M2J 1R6
1 416.630.2255 / 416.630.4
va3design.com

Greenpark.

project name
RUSSELL GARDENS PH. 4

date FEB 2021
 drawn by checked by scale

PROPERTY OF VAZ TEXCO. Reproduction of this property in whole or in part is strictly prohibited.

SPRINGFIELD 4

14.50m	project no.
	20027

LAN - ELEV. 3	drawing no.
file name	A2b

20027-SPRINGFIELD-4
1 - May 11, 2021 - 1:43 PM
3 DESIGN's written permission.

All drawings, specifications, related documents and design are the copyright property of V&J DESIGN. Reproduction of this property in whole or in part is strictly prohibited without V&J DESIGN's written permission.



SPRINGFIELD 4
14.30m

SPRINGFIELD 4
COMPLIANCE PACKAGE 'A1'

Greenpark™	SPRINGFIELD 4 14.30m
------------	-------------------------

ENS PH. 4	HAMILTON, ON.	project no. 20027
-----------	---------------	----------------------

SECOND FLOOR PLAN - ELEV. 1


checked by _____ scale _____ file name _____
 3/10" = 1'-0" 20027-SPRINGFIELD-4 A3

All drawings, specifications, related documents and design are the copyright property of V&J DESIGN. Reproduction of this security in whole or in part is strictly prohibited without V&J DESIGN's written permission.


All drawing specifications, related documents and design are the copyright property of VAS DESIGN. Reproduction of this property in whole or in part is strictly prohibited without VAS DESIGN's written permission.

GRAB BAR NOTE:**STUD WALL REINFORCEMENT FOR FUTURE GRAB BARS IN MAIN BATHROOM**


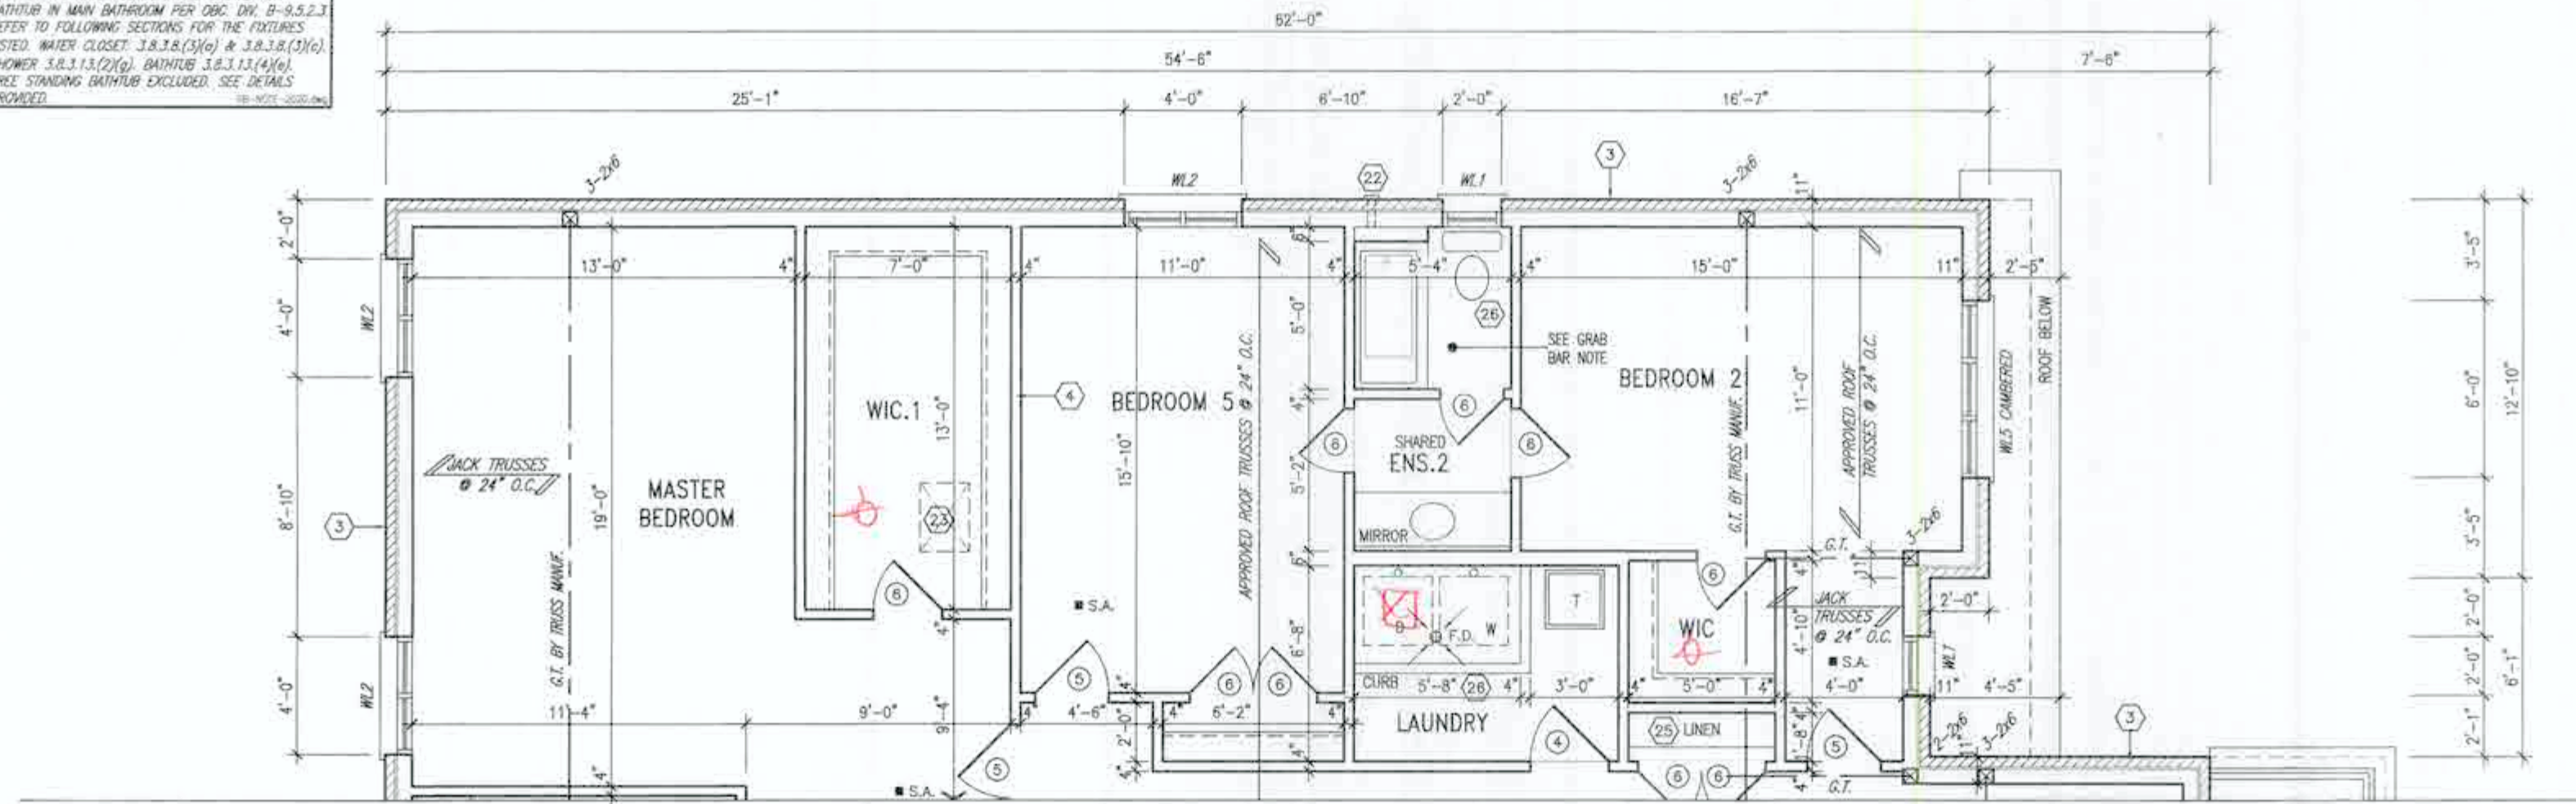

PARTIAL OPT. SECOND FLOOR PLAN W/ BEDROOM 5 - ELEV. '1'

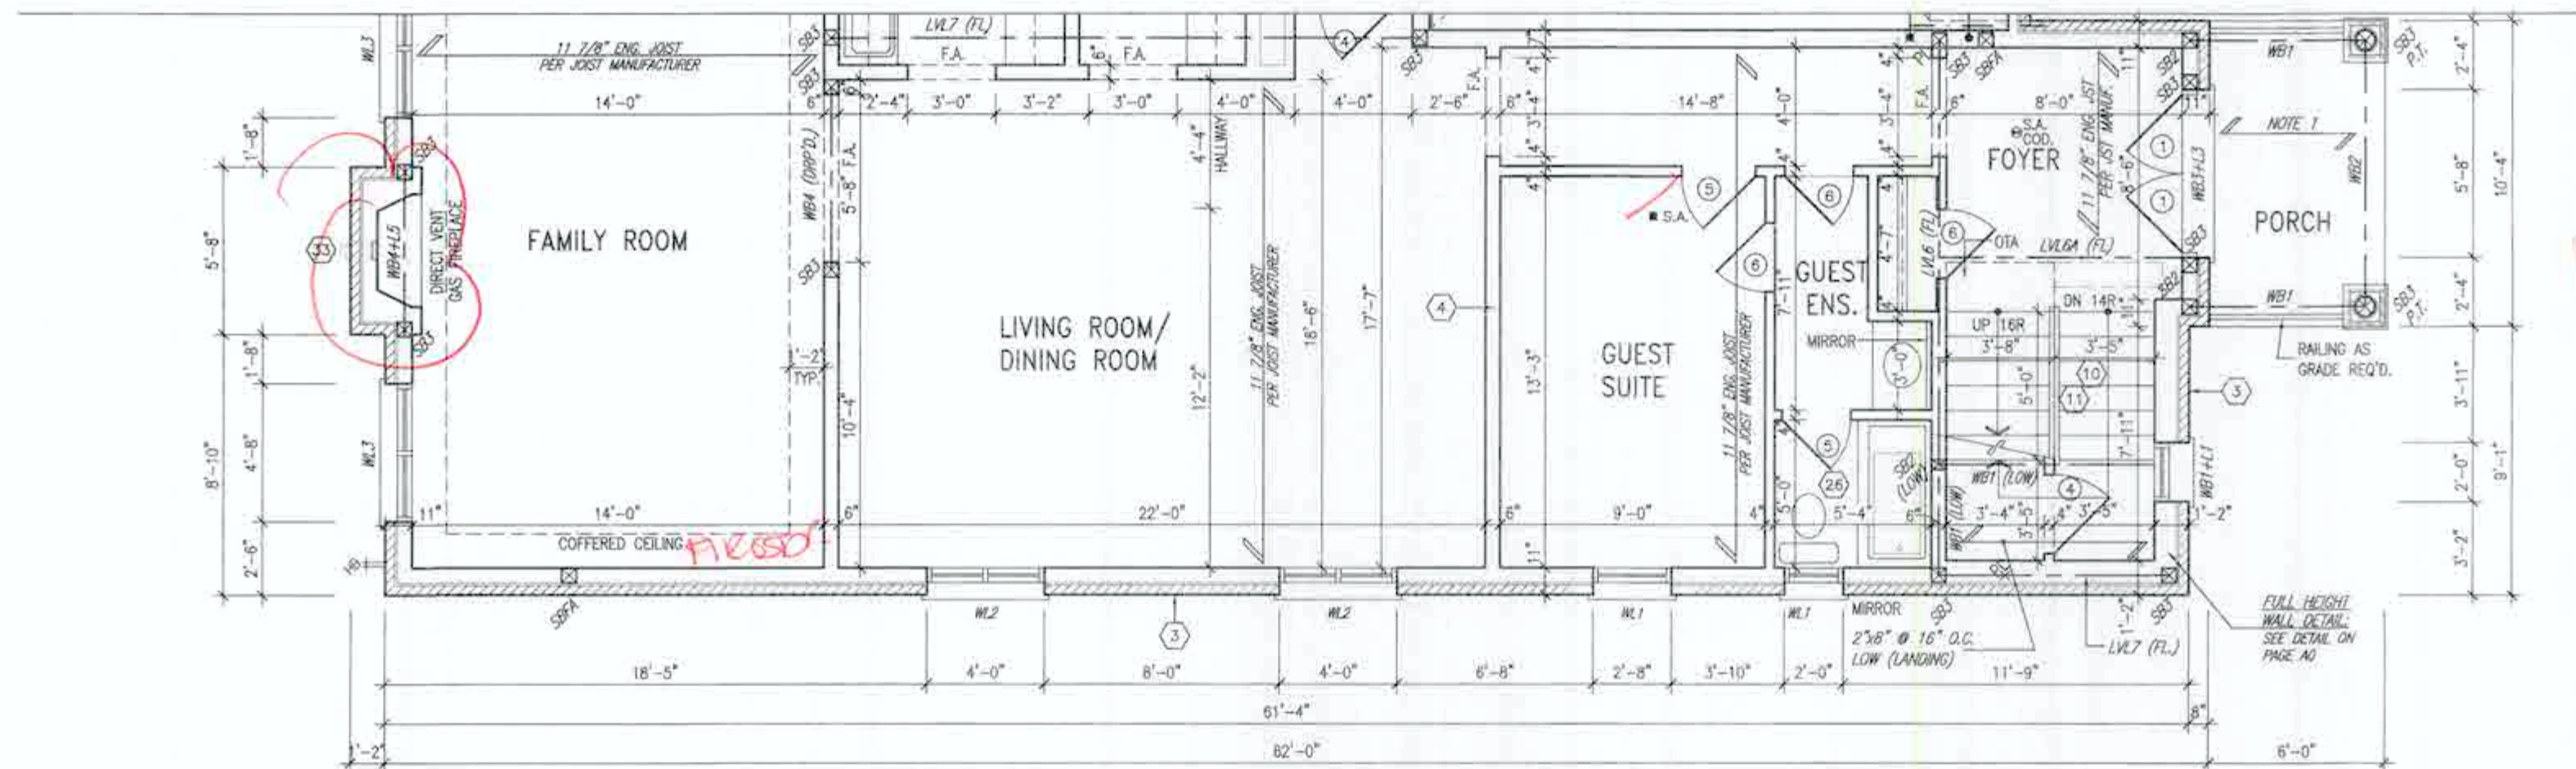

PARTIAL OPT. GROUND FLOOR PLAN W/ GUEST SUITE - ELEV. '1'

NOTE 1:
 FLAT ROOF FRAMING (TYP.)
 2"x8" @ 12" O.C. P.T. CLG. JOIST
 w/ 2"x4" @ 12" O.C. P.T.
 DIAGONALLY CUT CROSS PURLINS
 w/ 5/8" EXTERIOR GRADE
 SHEATHING + SINGLE PLY ROOF
 MEMBRANE (SLOPE TO DRAIN)

OUTDOOR AIR INTAKE SEPARATION
 ALL OUTDOOR AIR INTAKE VENTS TO BE SEPARATED A MINIMUM DISTANCE FROM SOURCES OF CONTAMINATION PER CBC, DIV. 9- TABLE 6.2.3.12.
 • KITCHEN EXHAUST: 3.0m
 • DRIVEWAY, PARKING SPACE, ROAD: 1.5m
 • SOLID FUEL APPLIANCE EXHAUST: 3.0m
 (18-101-2000-000)

It is the builder's complete responsibility to ensure that all plans submitted for approval fully comply with the Architectural Guidelines and all applicable regulations and requirements including zoning provisions and any provisions in the subdivision agreement. The Contractor/Architect is not responsible in any way for engineering or approving any (existing) plans or working drawings with respect to any zoning or building code or permit matter or that any holder can or properly built or located on its lot.

This is to certify that these plans comply with the applicable Architectural Design Guidelines approved by the City of Hamilton.

JOHN G. WILLIAMS LTD., ARCHITECT
 ARCHITECTURAL CONTROL REVIEW
 AND APPROVAL
 DATE: AUG 27, 2024



STRUDET INC.
 FOR STRUCTURE ONLY

no.	description	date	by	no.	description	date	by
18				9			
17				8			
16				7			
15				6			
14				5			
13				4			
12				3	ISSUED FOR PERMIT	MAY 21/21	CW
11				2	REV. PER CLIENT/ROOF/TL/ENG. COMMENTS	MAY 05/21	CW
10				1	PRELIMINARY. ISSUED FOR CLIENT REVIEW	FEB 19/21	CW

The undersigned has reviewed and takes responsibility for this design and has the qualifications and meets the requirements set out in the Ontario Building Code to be a Designer.

signature: Richard Vink
 name: Richard Vink
 registration information: VAS Design Inc.
 number: 24455
 date: 2024

VAS DESIGN
 255 Consumers Rd. Suite 170
 Toronto, ON M2H 1R4
 T: 416.630.2255 F: 416.630.4762
 vasdesign.com

Greenpark **SPRINGFIELD 4**
 14.30m
 project name: RUSSELL GARDENS PH. 4
 location: HAMILTON, ON.
 project no: 20027
 date: FEB 2023
 drawn by: [signature]
 checked by: [signature]
 scale: 3/16" = 1'-0"
 title: PARTIAL FLOOR PLANS - ELEV. 1
 file name: 20027-SPRINGFIELD-4
 sheet: A4




CITY OF HAMILTON
 Building Division
 21-14-97-40
 2024-08-27
 Jm Oct 30/24


SPRINGFIELD 4
 COMPLIANCE PACKAGE 'A1'

GRAB BAR NOTE:

STUD WALL REINFORCEMENT FOR FUTURE GRAB BARS IN MAIN BATHROOM
 REINFORCEMENT OF STUD WALLS SHALL BE INSTALLED ADJACENT TO WATER CLOSETS AND SHOWER ON BATHING IN MAIN BATHROOM PER O.C. DIV. 8.2.3.1. REFER TO FOLLOWING SECTIONS FOR THE FUTURES LISTED: WATER CLOSET, 3.8.3.8.3(4) & 3.8.3.8.3(5); SHOWER 3.8.3.13.2(4) & 3.8.3.13.2(5); FREE STANDING BATHTUB EXCLUDED. SEE DETAILS PROVIDED.
 (16-NOT-2020-000)

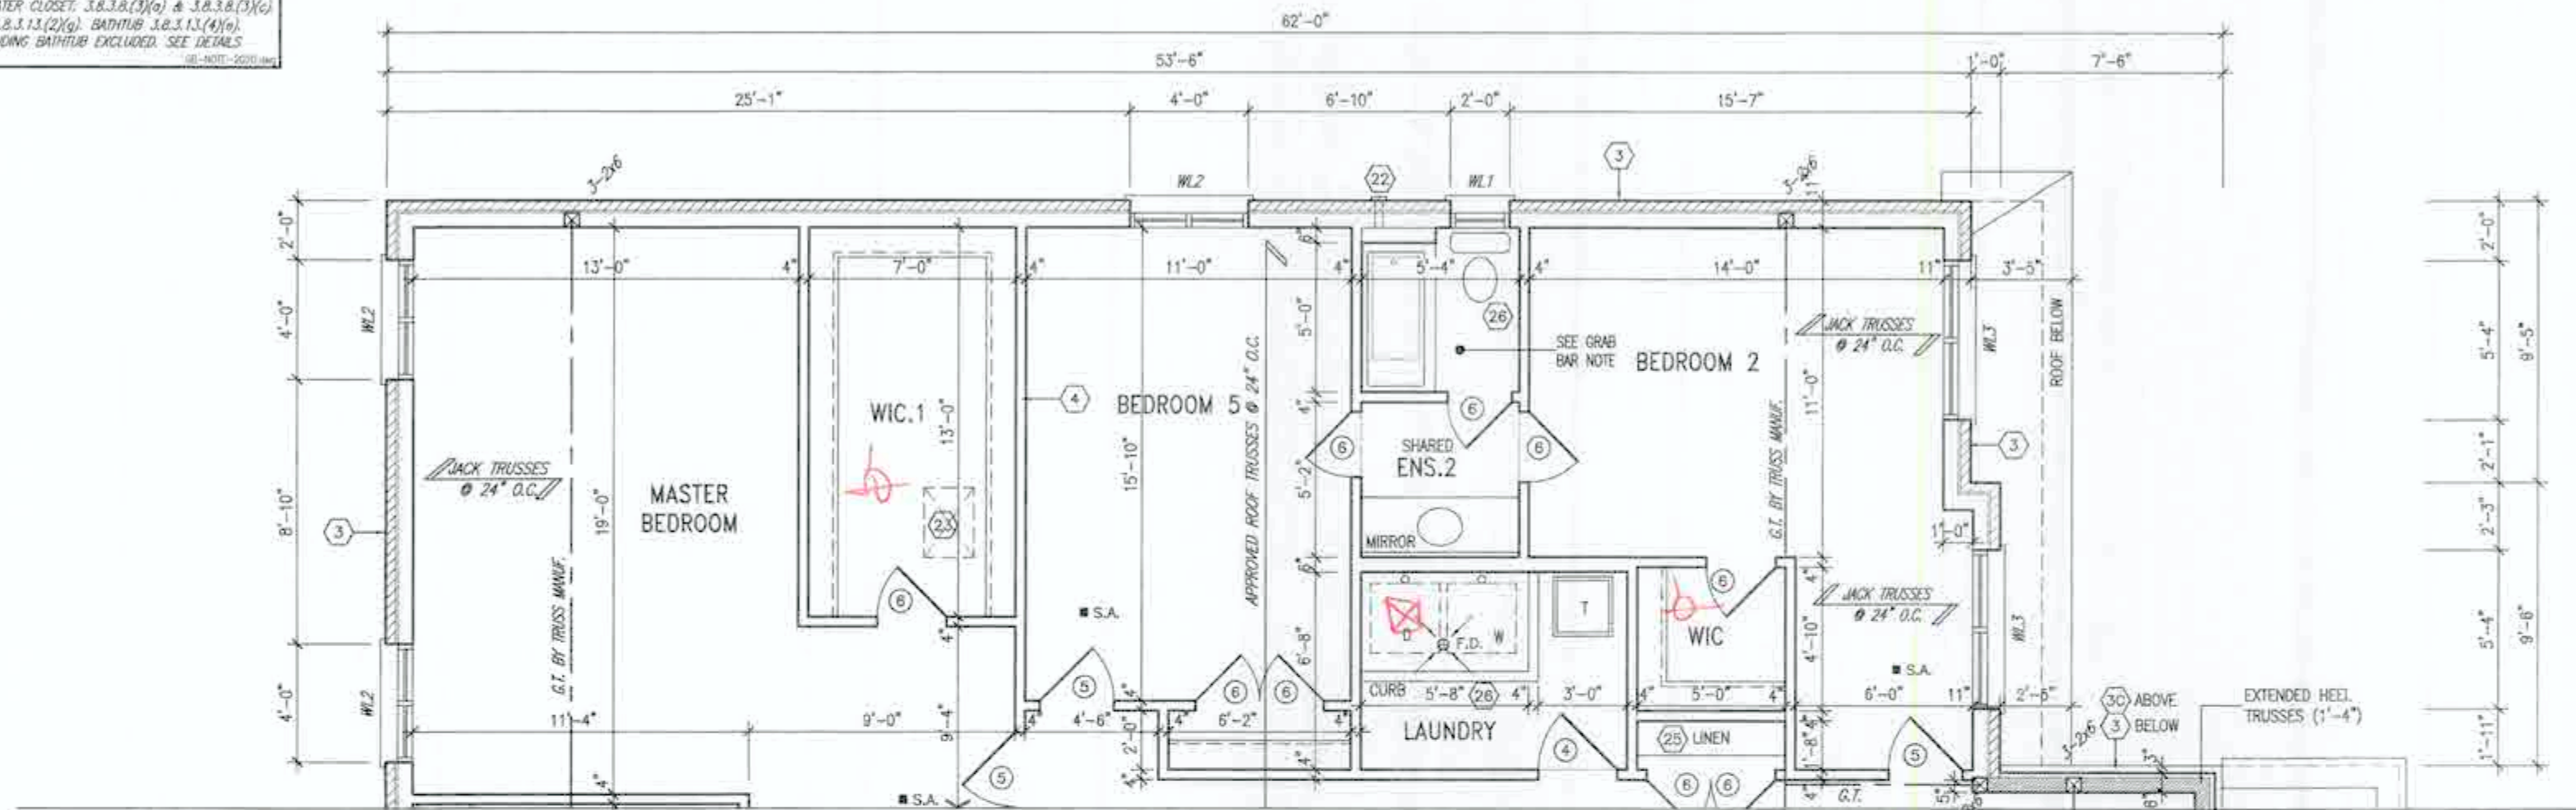


PARTIAL OPT. SECOND FLOOR PLAN W/ BEDROOM 5 - ELEV. '2'

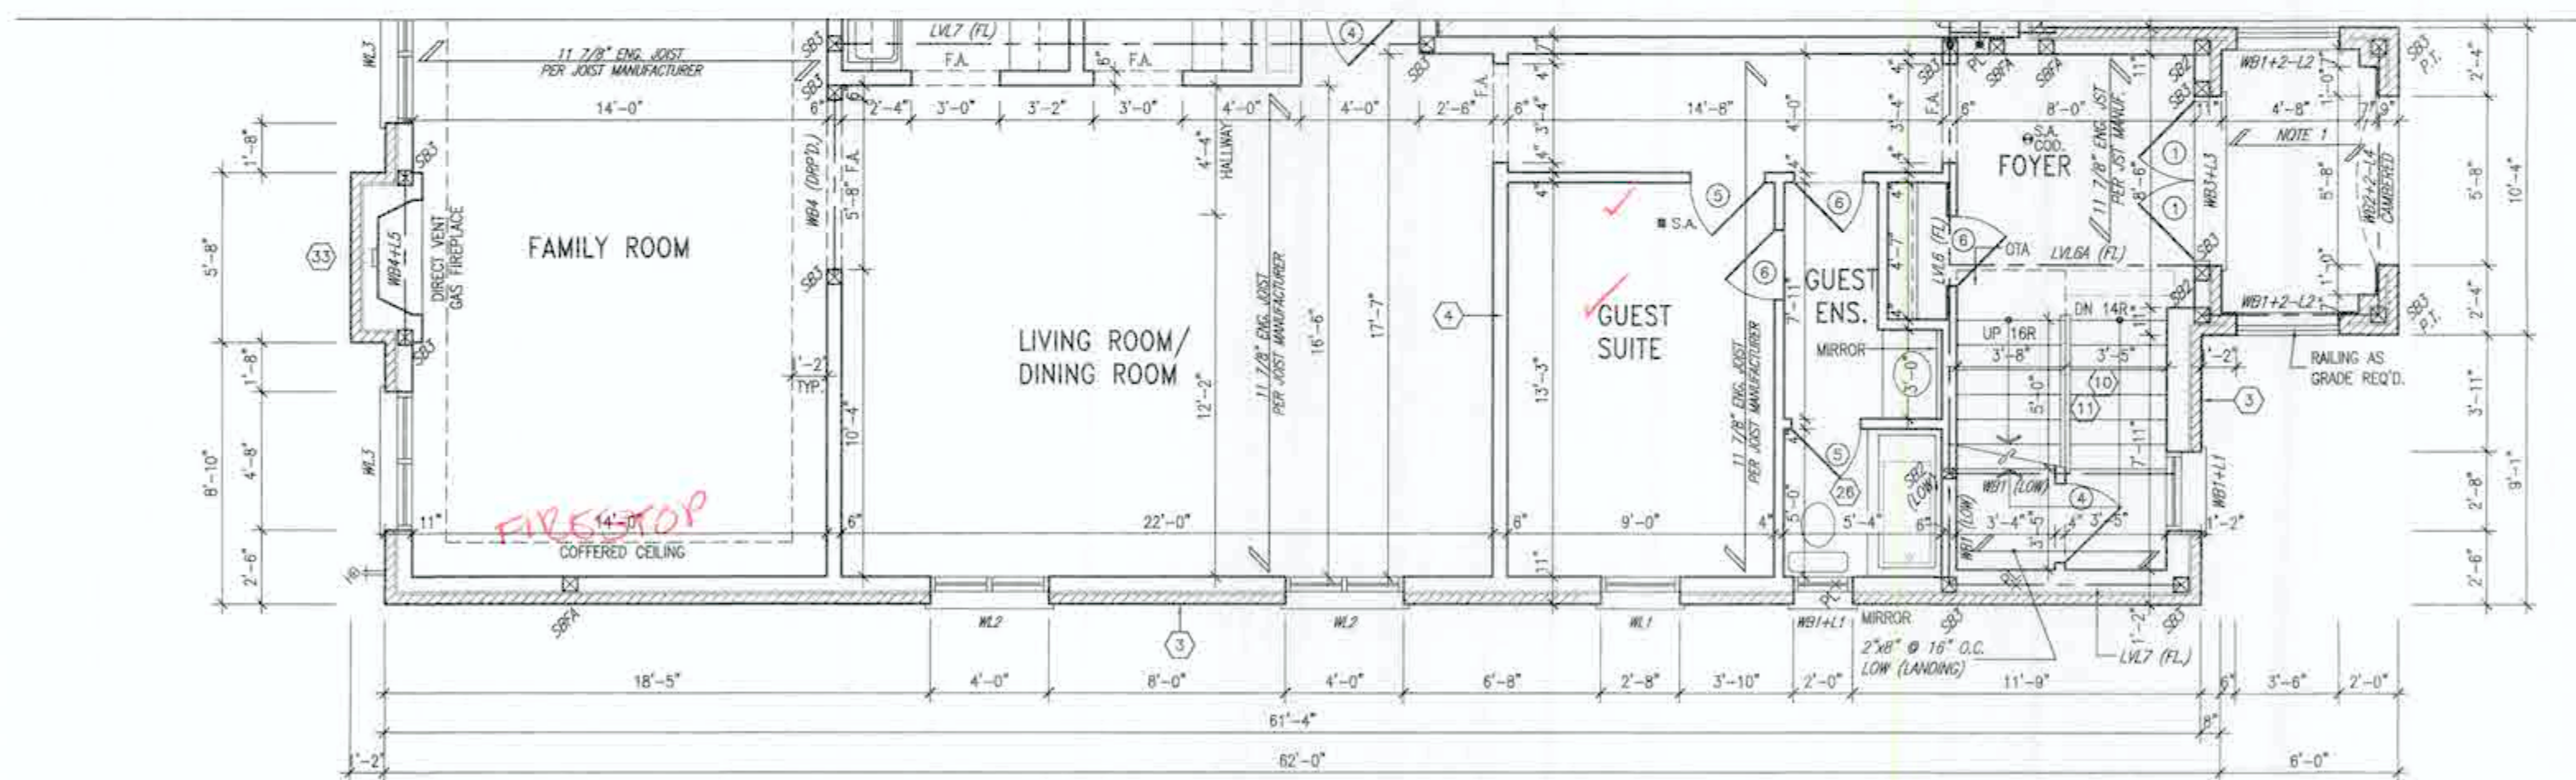

PARTIAL OPT. GROUND FLOOR PLAN W/ GUEST SUITE - ELEV. '2'

NOTE 1:
 FLAT ROOF FRAMING (TYP.)
 2"x8" @ 12" O.C. P.T. OLG. JST.
 w/ 2"x4" @ 12" O.C. P.T.
 DIAGONALLY CUT CROSS PURLINS
 w/ 5/8" EXTERIOR GRADE
 SHEATHING + SINGLE PLY ROOF
 MEMBRANE (SLOPE TO DRAIN)

OUTDOOR AIR INTAKE SEPARATION
 ALL OUTDOOR AIR INTAKE VENTS TO BE SEPARATED A MINIMUM DISTANCE FROM SOURCES OF CONTAMINATION PER O.C. DIV. 8- TABLE 8.2.3.12.
 • KITCHEN EXHAUST: 3.0m
 • DRIVEWAY, PARKING SPACE, ROAD: 1.5m
 • SOLID FUEL APPLIANCE EXHAUST: 3.0m
 (16-NOT-2020-000)

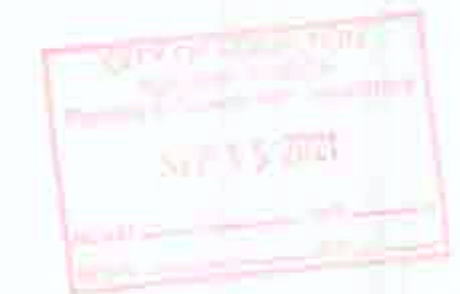

CITY OF HAMILTON
 Building Department
 2) 149740

Sm Oct 30 21

SPRINGFIELD 4
 COMPLIANCE PACKAGE 'A1'

It is the builder's complete responsibility to ensure that all plans submitted for approval fully comply with the Architectural Guidelines and all applicable regulations and requirements including zoning provisions and any provisions in the subdivision agreement. The Control Architect is not responsible in any way for examining or approving site (lotting) plans or working drawings with respect to any zoning or building code or permit matter or that any house can be properly built or located on its lot.

THIS IS TO CERTIFY THAT THESE PLANS COMPLY WITH THE APPLICABLE ARCHITECTURAL DESIGN GUIDELINES APPROVED BY THE CITY OF HAMILTON.

DATE: AUG 27, 2021

By: [Signature]



STRUDET INC.
 FOR STRUCTURE ONLY

no.	description	date	by
17			
16			
15			
14			
13			
12	3 ISSUED FOR PERMIT	MAY 21/21	CW
11	2 REV. PER CLIENT/ROOF/PL/ENG. COMMENTS	MAY 05/21	CW
10	1 PRELIMINARY ISSUED FOR CLIENT REVIEW	FEB 19/21	CW

The undersigned has reviewed and taken responsibility for this design and has the qualifications and power the requirements set out in the Ontario Building Code to be a Designer.

qualification information
 Richard Vink
 VAS Design Inc.
 signature
 24488
 42658

VA3 DESIGN
 255 Consumers Rd Suite 120
 Toronto, ON M2J 1R4
 416.630.2255 / 416.630.4762
 va3design.com

Greenpark. **SPRINGFIELD 4**
 14.30m
 project name
 RUSSELL GARDENS PH. 4 HAMILTON, ON.
 project no.
 20027
 date
 FEB 2021
 created by
 3/16" = 1'-0"
 20027-SPRINGFIELD-4
 A4a

[illegible]

PORCH STEPS (TYP.)
PRECAST CONCRETE STEPS
w/ MASONRY INSERTS WHERE
GRADE REQUIRES

It is the builder's complete responsibility to ensure that all plans submitted for approval fully comply with the Architectural Guidelines and all applicable regulations and requirements including zoning provisions and any provisions in the subdivision agreement. The Control Architect is not responsible in any way for extending or approving site (lotting) plans or working drawings with respect to any zoning or building code or permit matter or that any

This is to certify that these plans comply with the applicable Architectural Design Guidelines approved by the City of: **HAMILTON**

JOHN C. WILLIAMS, LTD., ARCHITECTS



EXTERIOR RAILINGS:
3'-6" HIGH RAILING IF LANDING IS MORE
THAN 5'-11" ABOVE FINISHED GRADE
AND 3'-0" HIGH RAILING WHEN LANDING
IS LESS THAN 5'-11" ABOVE ADJACENT
FINISHED GRADE.

ELEVATIONS NOT DRAWN TO ACTUAL GRADE.
REFER TO FINAL GRADING PLAN.

17			8			
18			7			qualification information
19			6			Richard Vink
20			5			signature
21			4			registration information
22			3			VAS Design inc.
23			2			
24			1			
25						
26						

qualification information

Richard Vink 24

signature

registration identifier

VAS Design, Inc. 62

Contractor must verify all dimensions on the job and report any discrepancy to the Designer before proceeding with the work. All drawings and specifications are instruments of service and the professional Designer will not be returned at the completion of the project.

VA3
DESIGN

255 Consumers Rd Suite
Toronto ON M2J 1R8
t 416.631.2255 f 416.631.2255
vo3design.com


Greenpark

RUSSELL GARDENS PH. 4 HAMILTON
FRONT


Drawn by _____ checked by _____ scale _____
 1P - 3/16" = 1'-0"

SPRINGFIELD 4
14.30m


project no.	2002
drawing no.	

20027-SPRINGFIELD-4 **A5**


All drawings, specifications, related documents and design are the copyright property of VAS DESIGN. Reproduction of this property in whole or in part is strictly prohibited without VAS DESIGN's written permission.

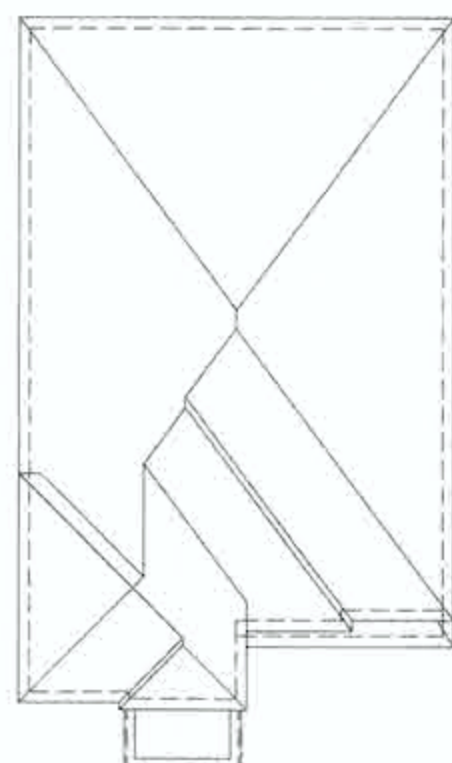

ROOF PLAN-2
N.T.S.

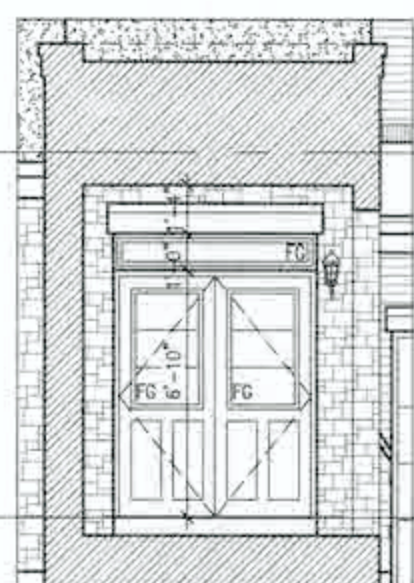

INSIDE PORTICO
ELEVATION '2'

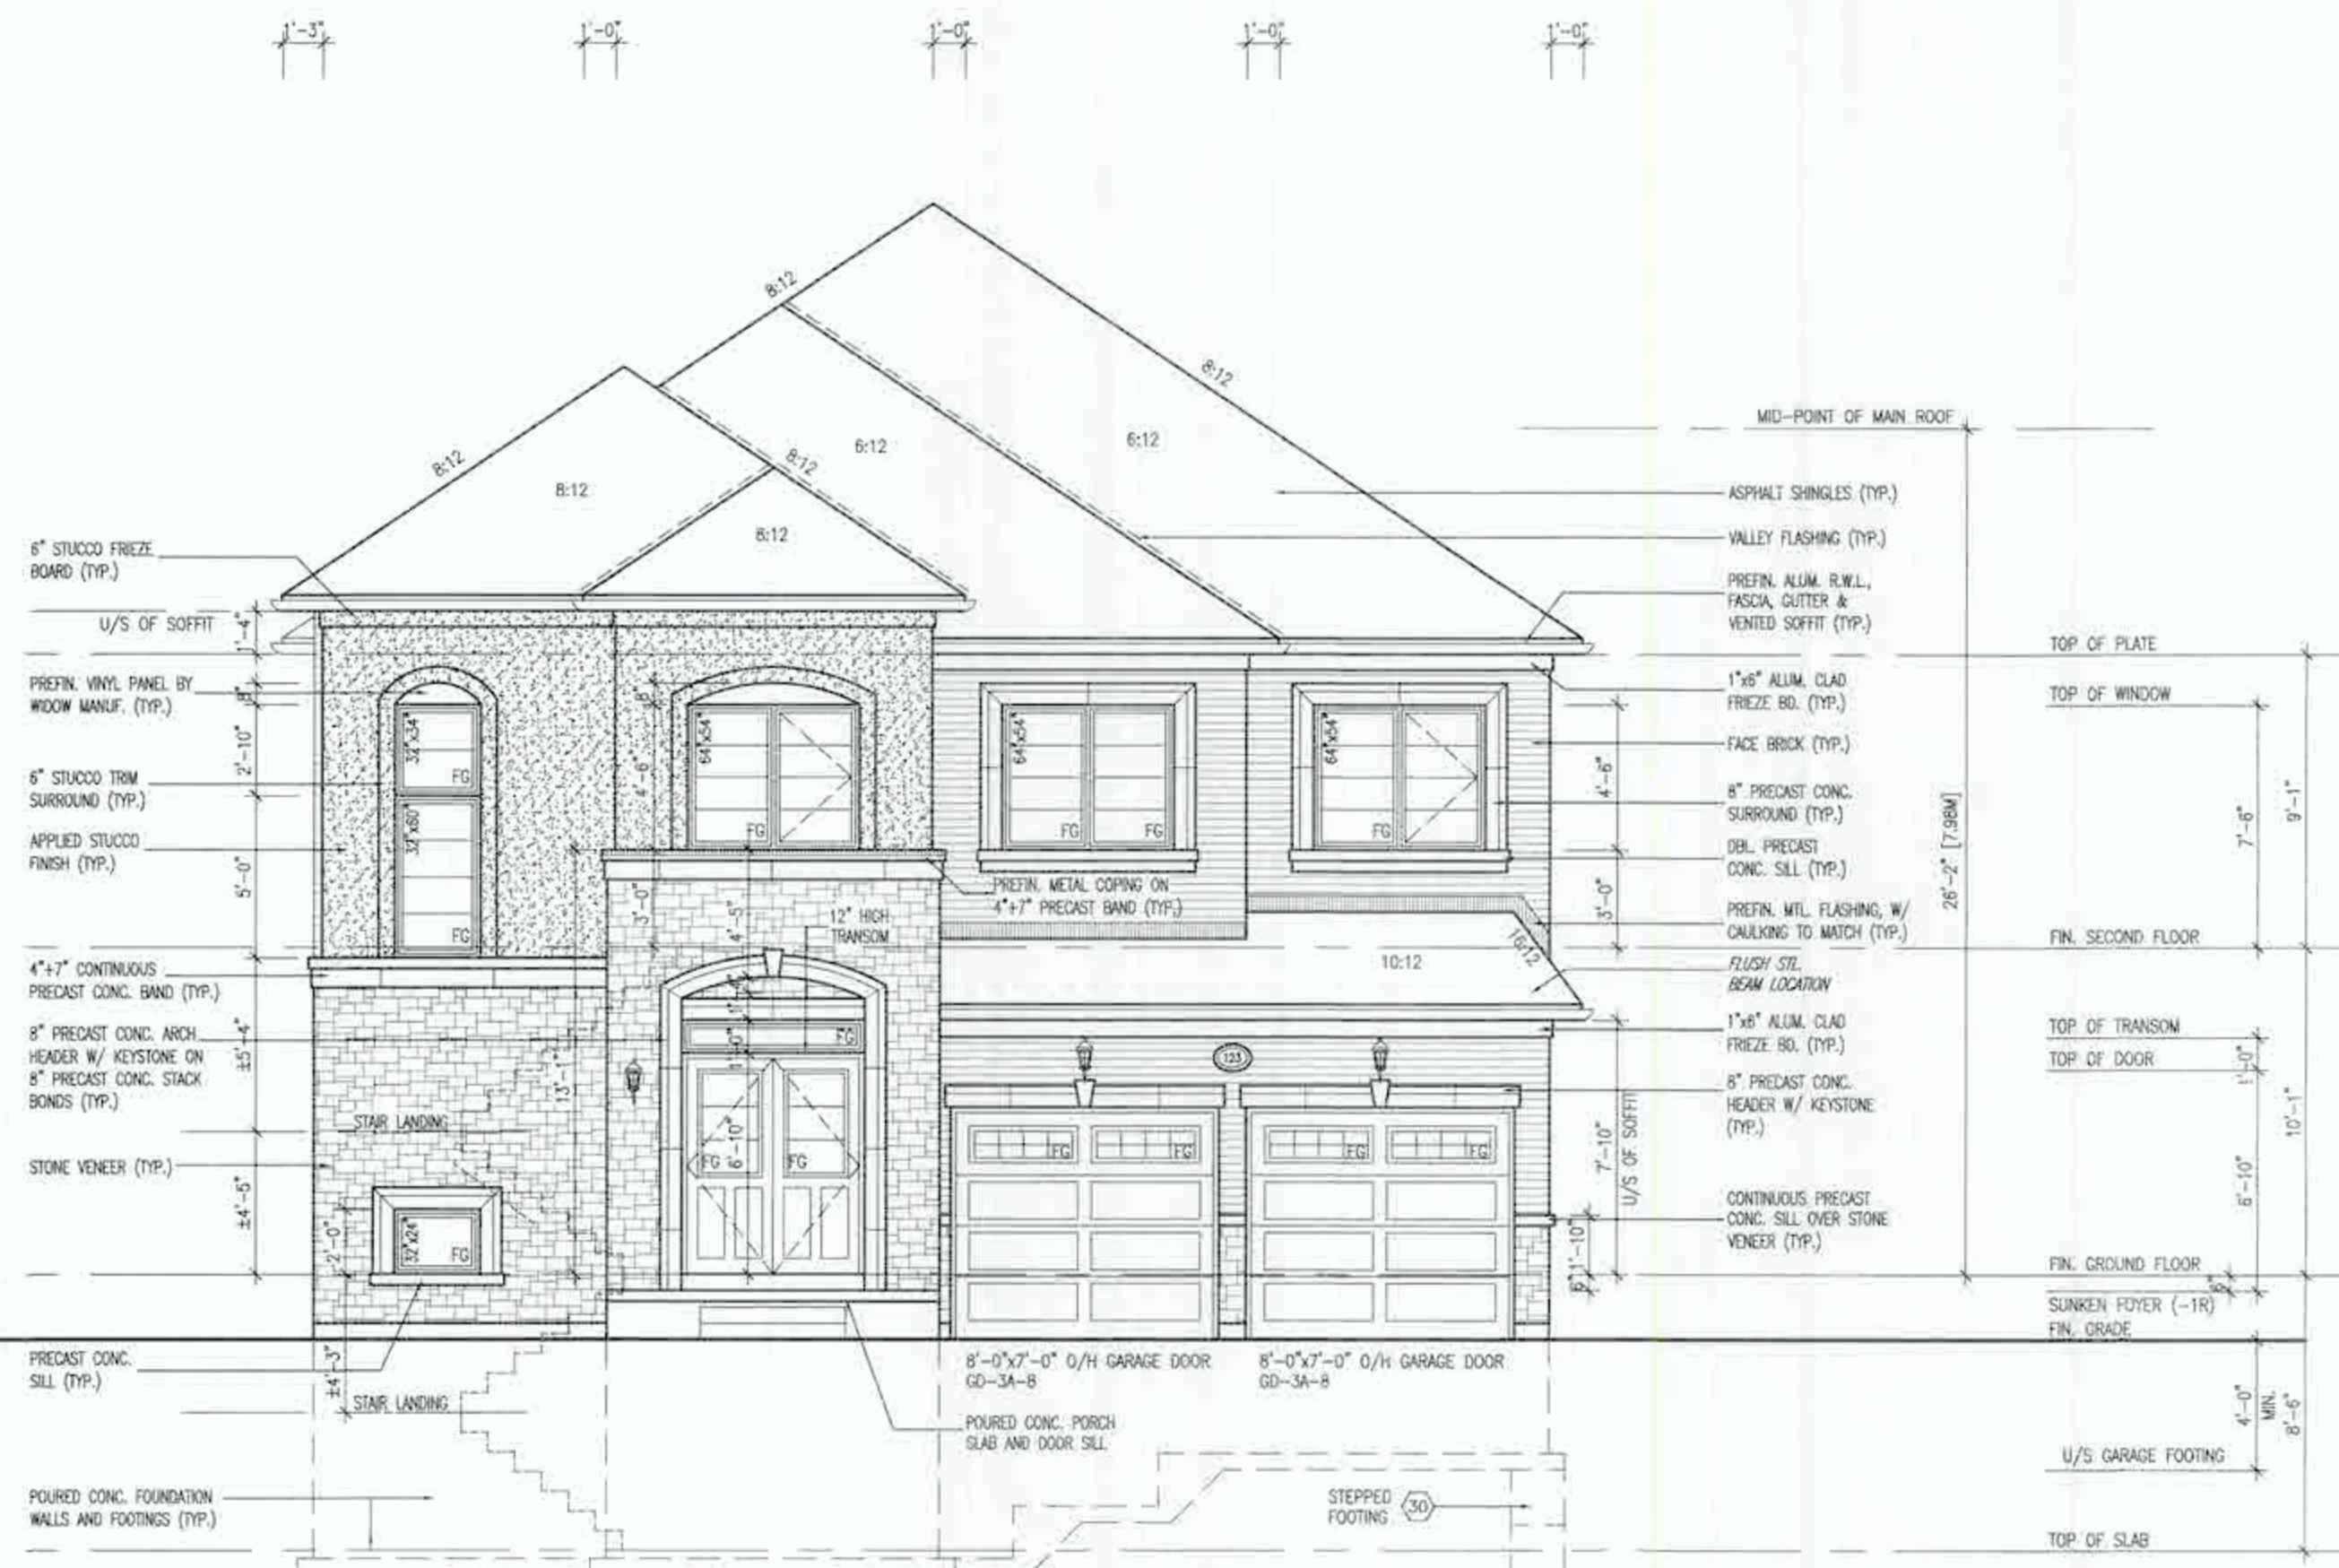

FRONT ELEVATION '2'

PORCH STEPS (TYP.)
PRECAST CONCRETE STEPS
W/ MASONRY INSERTS WHERE
GRADE REQUIRES.

EXTERIOR RAILINGS:
3'-6" HIGH RAILING IF LANDING IS MORE
THAN 5'-11" ABOVE FINISHED GRADE
AND 3'-0" HIGH RAILING WHEN LANDING
IS LESS THAN 5'-11" ABOVE ADJACENT
FINISHED GRADE.

ELEVATIONS NOT DRAWN TO ACTUAL GRADE.
REFER TO FINAL GRADING PLAN.

18		9			
17		8			
16		7			
15		6			
14		5			
13		4			
12		3	ISSUED FOR PERMIT	MAY 21/21	OW
11		2	REV. PER CLIENT/ROOF/EL/ENG. COMMENTS	MAY 06/21	OW
10		1	PRELIMINARY, ISSUED FOR CLIENT REVIEW	FEB 15/21	OW
9					
8					
7					
6					
5					
4					
3					
2					
1					
0					

The undersigned has reviewed and taken responsibility for this design and has the qualifications and license requirements set out in the Ontario Building Code to be a Designer.
Qualification Information:
Richard Vink
signature
VAS Design Inc.
42855

VAS
DESIGN

250 Consumers Rd Suite 120
Toronto, ON M2J 1R4
416.630.2295 | 416.630.4782
vasdesign.com

SPRINGFIELD 4
COMPLIANCE PACKAGE 'A1'

SPRINGFIELD 4
14.30m

project name
RUSSELL GARDENS PH. 4
HAMILTON, ON.
project no.
20027

date
FEB 2021
drawn by
TP
checked by
3/16" = 1'-0"
scale
20027-SPRINGFIELD-4
sheet no.
A5a

CITY OF HAMILTON
Building Department
21 149740
Jm oct 2021

It is the builder's complete responsibility to ensure that all plans submitted for approval fully comply with the Architectural Guidelines and all applicable regulations and requirements including zoning provisions and any provisions in the subdivision agreement. The Contractor/Architect is not responsible in any way for engineering or engineering site (setting) plans or working drawings with respect to any zoning or building code or permit matter or that any house can be properly built or located on the lot.

This is to certify that these plans comply with the applicable Architectural Design Guidelines approved by the City of Hamilton.

JOHN L. WELLMAN LTD., ARCHITECT
COMMERCIAL CONSULTING
AND ARCHITECTURE
1000 SHEPPARD AVE. E. SUITE 100
SCARBOROUGH, ONTARIO M1S 1T5
416.291.2000
www.jlw.com



LEFT SIDE ELEVATION '1'

ELEVATIONS NOT DRAWN TO ACTUAL GRADE.
REFER TO FINAL GRADING PLAN.

SPRINGFIELD 4
COMPLIANCE PACKAGE 'A1'

It is the builder's complete responsibility to ensure that all plans submitted for approval fully comply with the Architectural Guidelines and all applicable regulations and requirements including zoning provisions and any provisions in the subdivision agreement. The Control Architect is not responsible in any way for examining or approving site (lotting) plans or working drawings with respect to any zoning or building code or permit matter or that any house can be properly built or located on its lot.

This is to certify that these plans comply with the applicable Architectural Design Guidelines approved by the City of HAMILTON.




18				9		
17				8		
16				7		
15				6		
14				5		
13				4		
12				3	ISSUED FOR PERMIT.	MAY 21/21
11				2	REV. PER CLIENT/HOF/FL/DMC COMMENTS	MAY 05/21
10				1	PRELIMINARY ISSUED FOR CLIENT REVIEW	FEB 18/21
9	description	date	by	no.	description	date

The undersigned has reviewed and takes responsibility for this design and has the qualifications and meets the requirements set out in the Ontario Building Code to be a Designer.

Qualification information: *R. Vink* 244

Signature: *Richard Vink*


Registration information: VAS Design Inc. 426

Contractor must verify all dimensions on the job and report any discrepancy to the Designer before proceeding with the work. All drawings and specifications are instruments of service and the proper use of the Designer's work must be confirmed at the completion of the project. Drawings are not to be copied.

VA3
DESIGN
255 Consumers Rd Suite
Toronto ON M2J 1R4
t 416.630.2255 f 416.630.4
va3design.com

[illegible]

All drawings, specifications, related documents and design are the copyright property of V&J DESIGN. Reproduction of this property in whole or in part is strictly prohibited without V&J DESIGN's written permission.

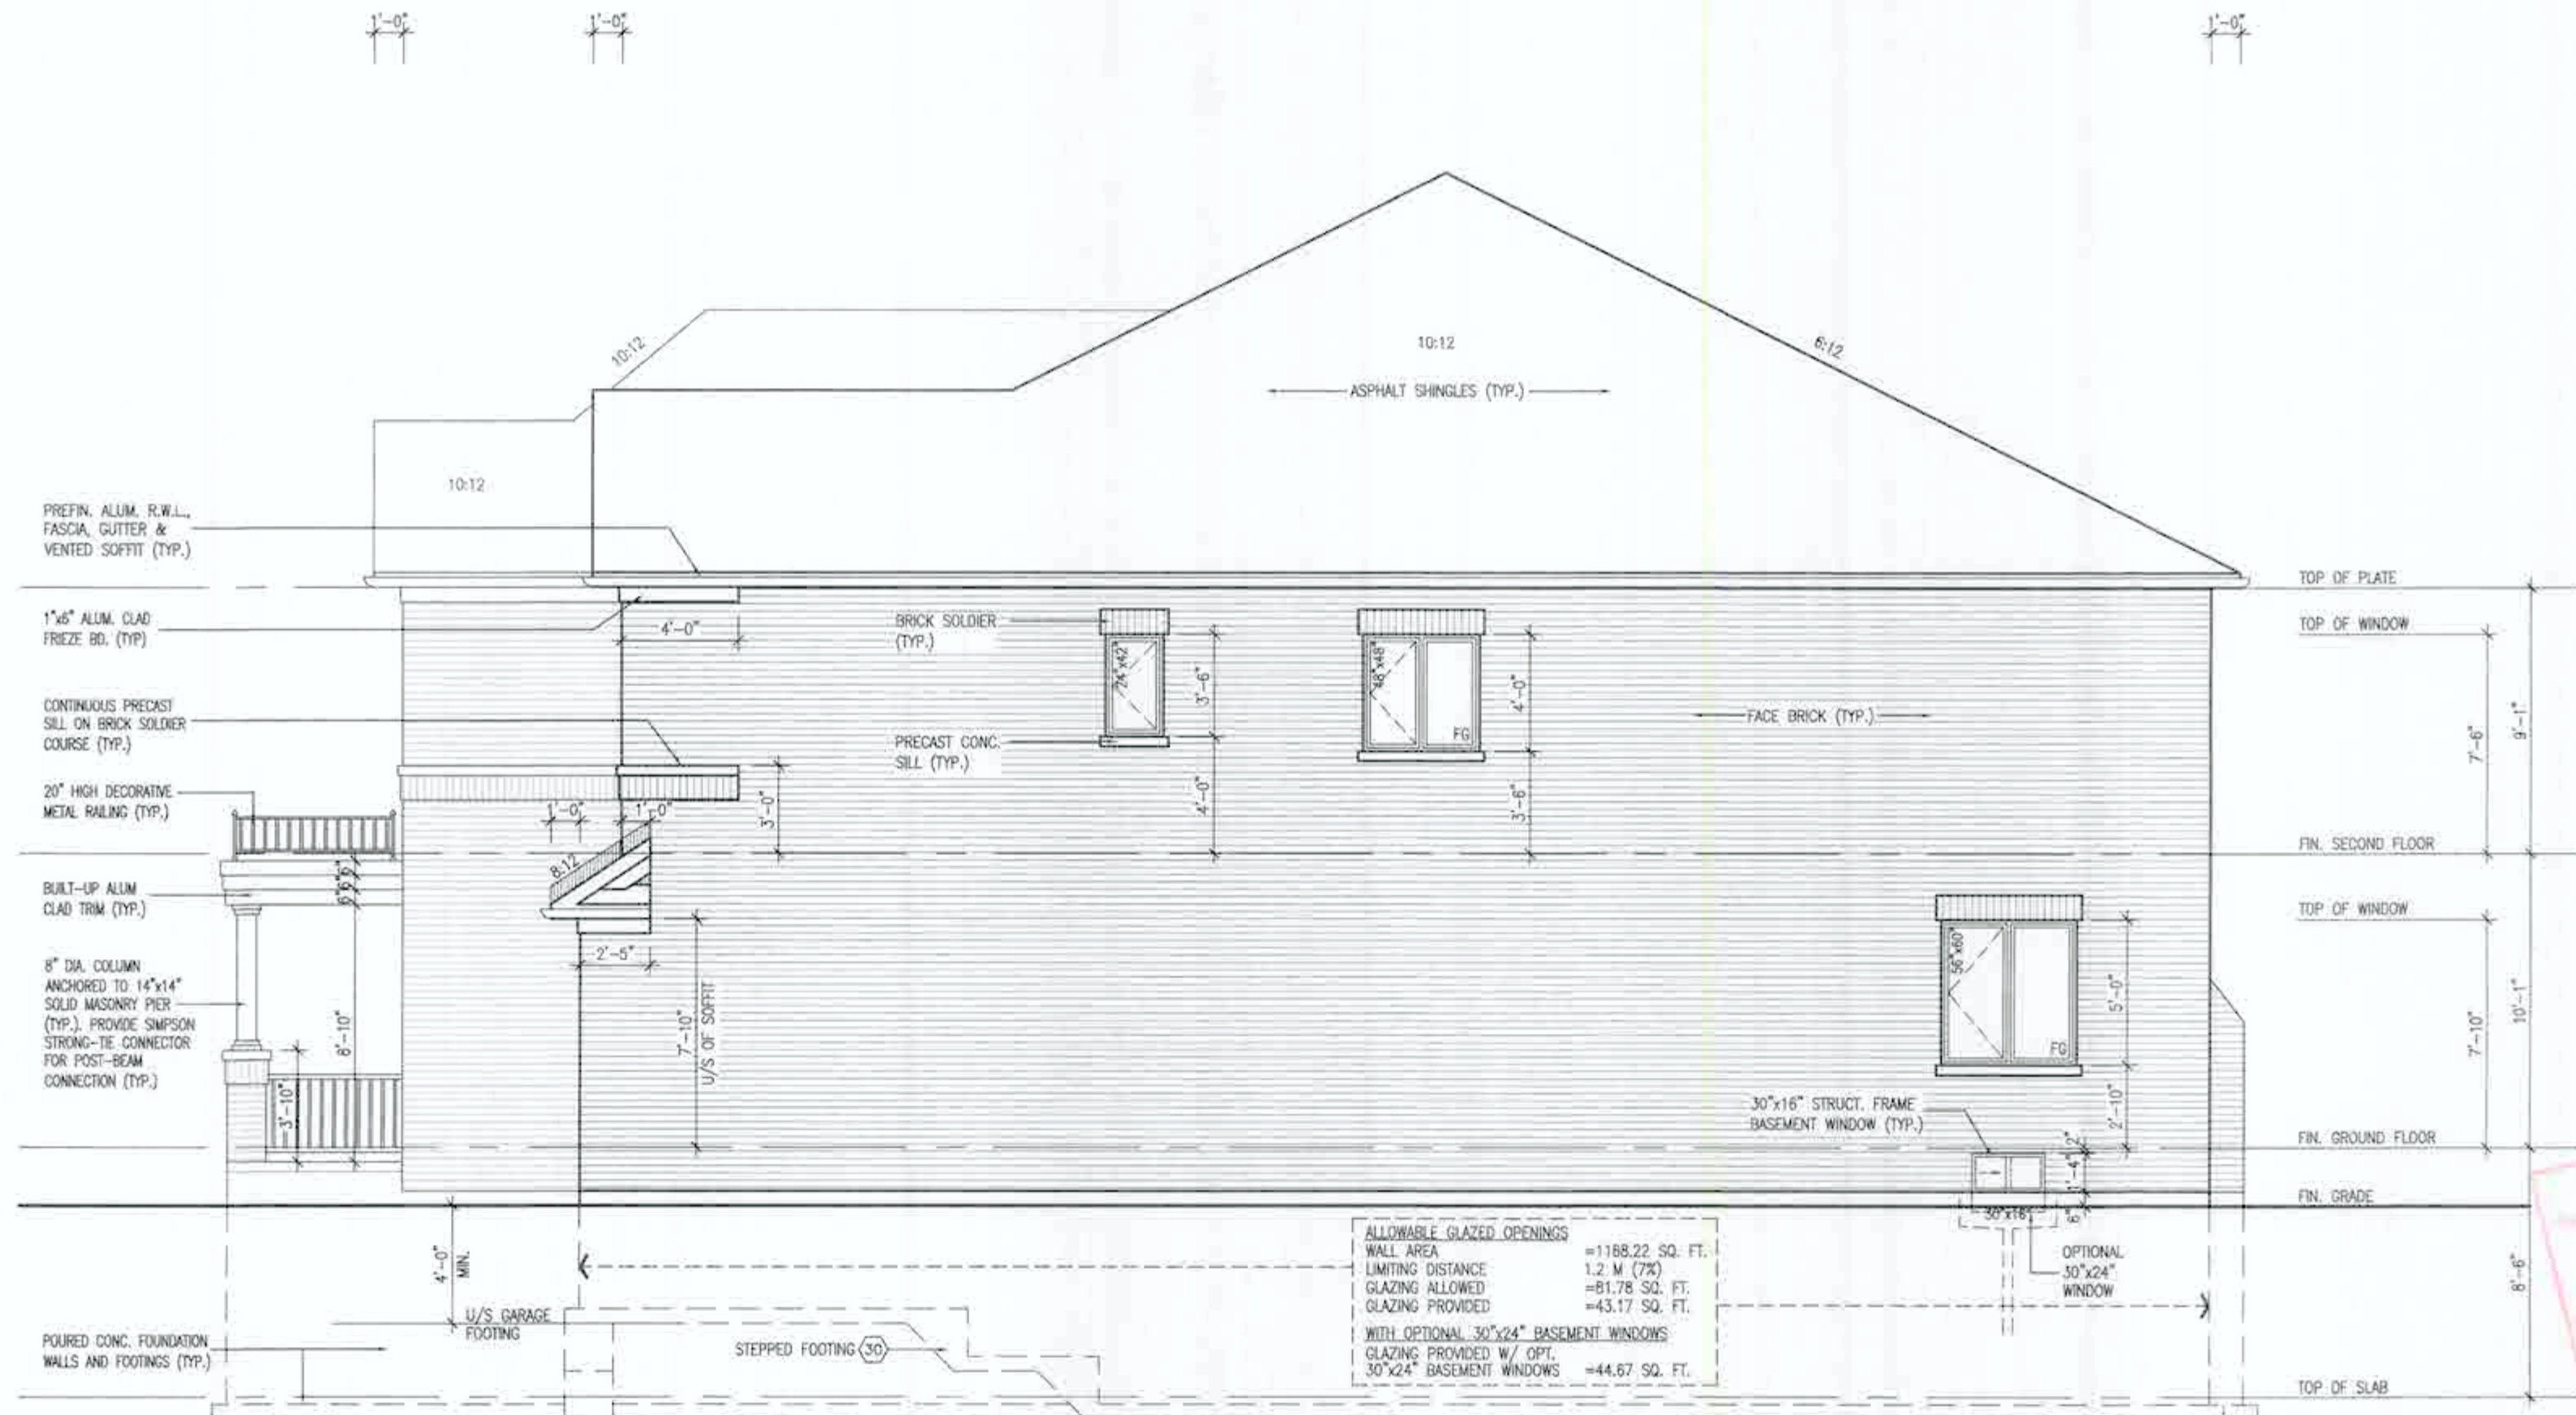

RIGHT SIDE ELEVATION '1'

ELEVATIONS NOT DRAWN TO ACTUAL GRADE.
REFER TO FINAL GRADING PLAN.

18		9			
17		8			
16		7			
15		6			
14		5			
13		4			
12		3	ISSUED FOR PERMIT	MAY 21/21	CW
11		2	REV. PER CLIENT/ROOF/PL/ENG. COMMENTS	MAY 05/21	CW
10		1	PRELIMINARY. ISSUED FOR CLIENT REVIEW	FEB 19/21	CW
9					
8					
7					
6					
5					
4					
3					
2					
1					
0					

The undersigned firm reviewed and takes responsibility for this design and the qualifications and meets the requirements set out in the Ontario Building Code for a Designer.

Signature: *R. Vink* 24488
 Name: Richard Vink
 Registration Number: 42858
 Firm: VAS Design Inc.

VAS DESIGN
 255 Consumers Rd. Suite 120
 Toronto, ON M2J 1R4
 1 416.630.2255 / 416.630.4782
 vasdesign.com

Greenpark. **SPRINGFIELD 4**
 14.30m

Project Name: **RUSSELL GARDENS PH. 4** Location: **HAMILTON, ON.** Project No: **20027**


Date: **FEB 2021** Drawn by: **3/16" = 1'-0"** Scale: **RIGHT SIDE ELEVATION - ELEV. 1**

Sheet: **A7**

It is the client's complete responsibility to ensure that all plans submitted for approval fully comply with the Architectural Guidelines and all applicable regulations and requirements including zoning provisions and any provisions in the subdivision agreement. The Client/Architect is not responsible in any way for examining or approving site (lotting) plans or working drawings with respect to any zoning or building code or permit matter for that any house can be properly built or located on its lot.

This is to certify that these plans comply with the applicable Architectural Design Guidelines approved by the City of Hamilton.

JOHN L. WILLIAMS, JTD, ARCHITECT
 4400 SHEPPARD AVE. E. SUITE 100
 SCARBOROUGH, ONTARIO M1S 1T6
 (416) 291-1111
 www.jlwarchitect.com

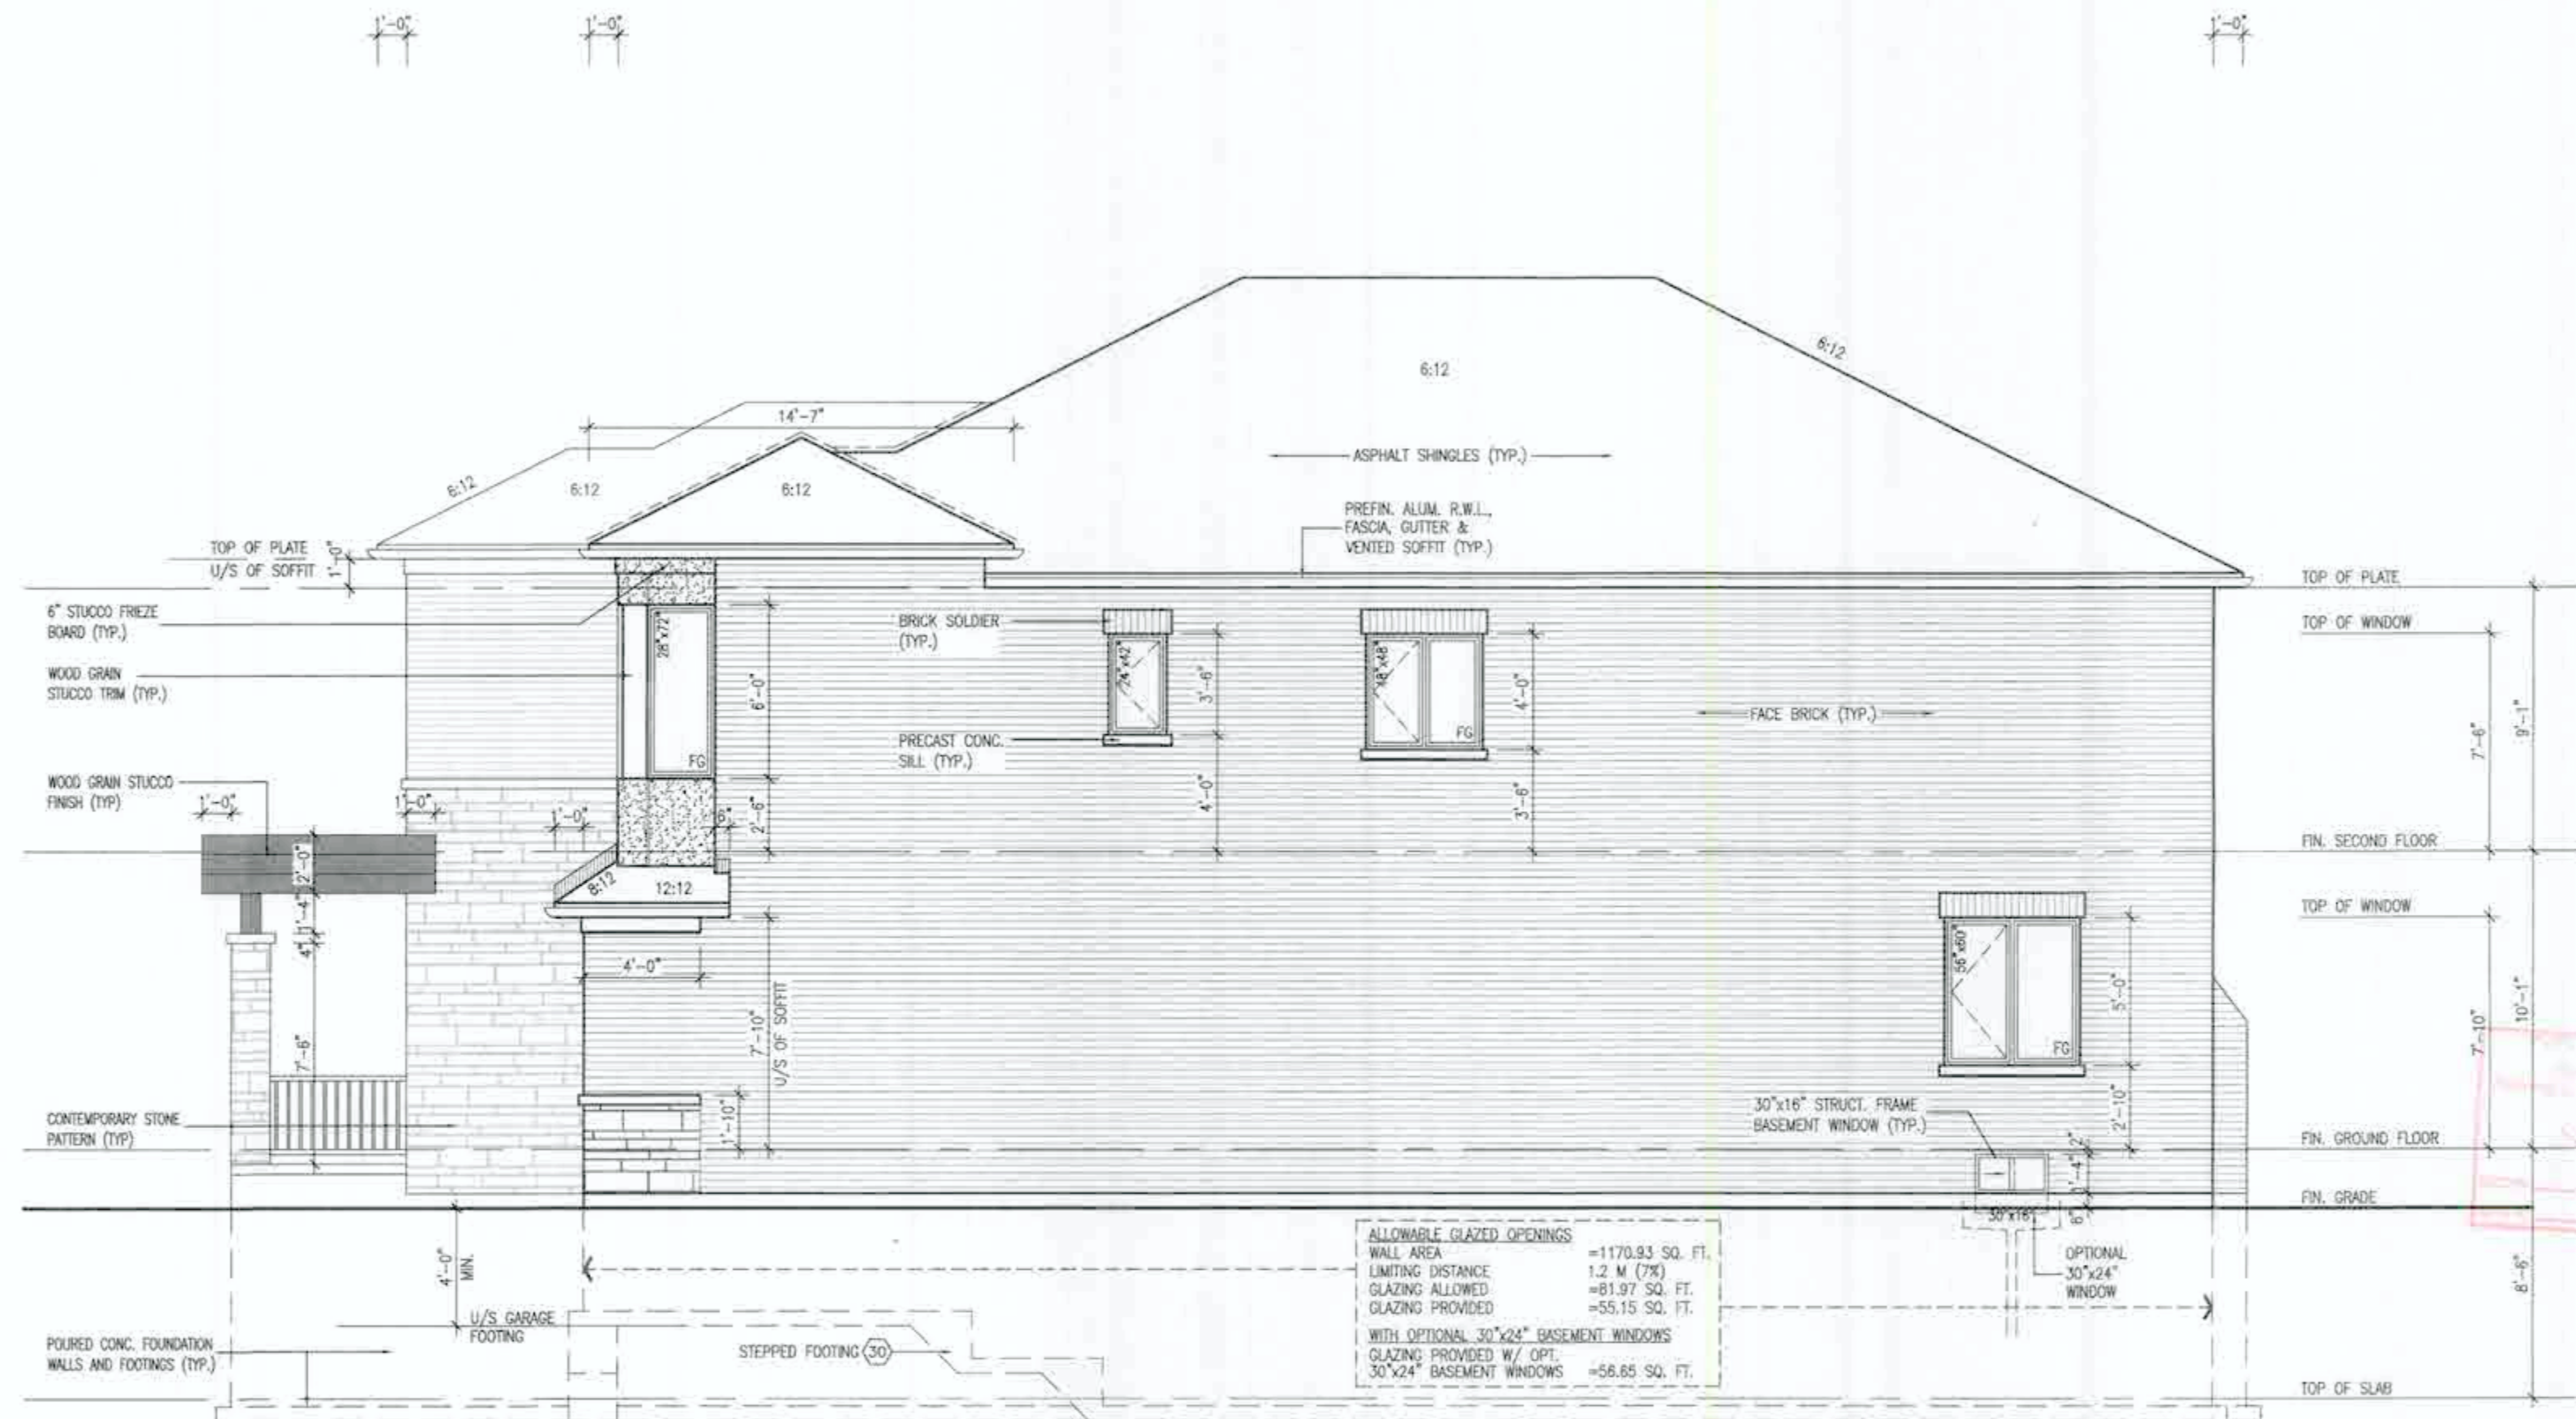

RIGHT SIDE ELEVATION '3'

ON 149740

8m Oct 30/21

It is the builder's complete responsibility to ensure that all plans submitted for approval fully comply with the Architectural Guidelines and all applicable regulations and requirements including zoning provisions and any provisions in the subdivision agreement. The Control Architect is not responsible in any way for examining or approving site (lotting) plans or working drawings with respect to any zoning or building code or permit matter or that any house can be properly built or located on its lot.

This is to certify that these plans comply with the applicable Architectural Design Guidelines approved by the City of HAMILTON.

JOHN C. WILLIAMS III, ARCHITECT
ARCHITECTURAL CONCEPTS, DESIGN
AND CONSTRUCTION
APPROVED BY: 

ELEVATIONS NOT DRAWN TO ACTUAL GRADE.
REFER TO FINAL GRADING PLAN.

[illegible]

All drawings, specifications, related documents and design are the copyright property of VA3 DESIGN. Reproduction of this property in whole or in part is strictly prohibited without VA3 DESIGN's written permission.







18				9		
17				8		
16				7		
15				6		
14				5		
13				4		
12				3	ISSUED FOR PERMIT.	MAY 21/21
11				2	REV. PER CLIENT/ROOF/TL/DWG. COMMENTS	MAY 05/21
10				1	PRELIMINARY, ISSUED FOR CLIENT REVIEW.	FEB 19/21
9	description	date	by	no	description	date

The undersigned has reviewed and takes responsibility for this design and lists the qualifications and meets the requirements set out in the Ontario Building Code to be a Designer:	qualification information	Richard Vink	24
name	registration information	VAS Design Inc.	42
Contractor must verify all dimensions on the job and report any discrepancy to the Designer before proceeding with the work. All drawings and specifications are instruments of service and the property of the Designer which must be returned at the completion of the project.			

VA3
DESIGN
255 Consumers Rd Suite
Toronto ON M2J 1P
t 416.630.2255 f 416.630.2255
va3design.com

 Greenpark.		SPRINGFIELD 4 14.30m	
project name RUSSELL GARDENS PH. 4		municipality HAMILTON, ON.	
date FEB 2021		project 2002	
drawn by TP		drawing no. A8a	

All dimensions specifications omitted documents and design are the copyright property of V&I DESIGN. Reproduction of this property in whole or in part is strictly prohibited without V&I DESIGN's written permission.

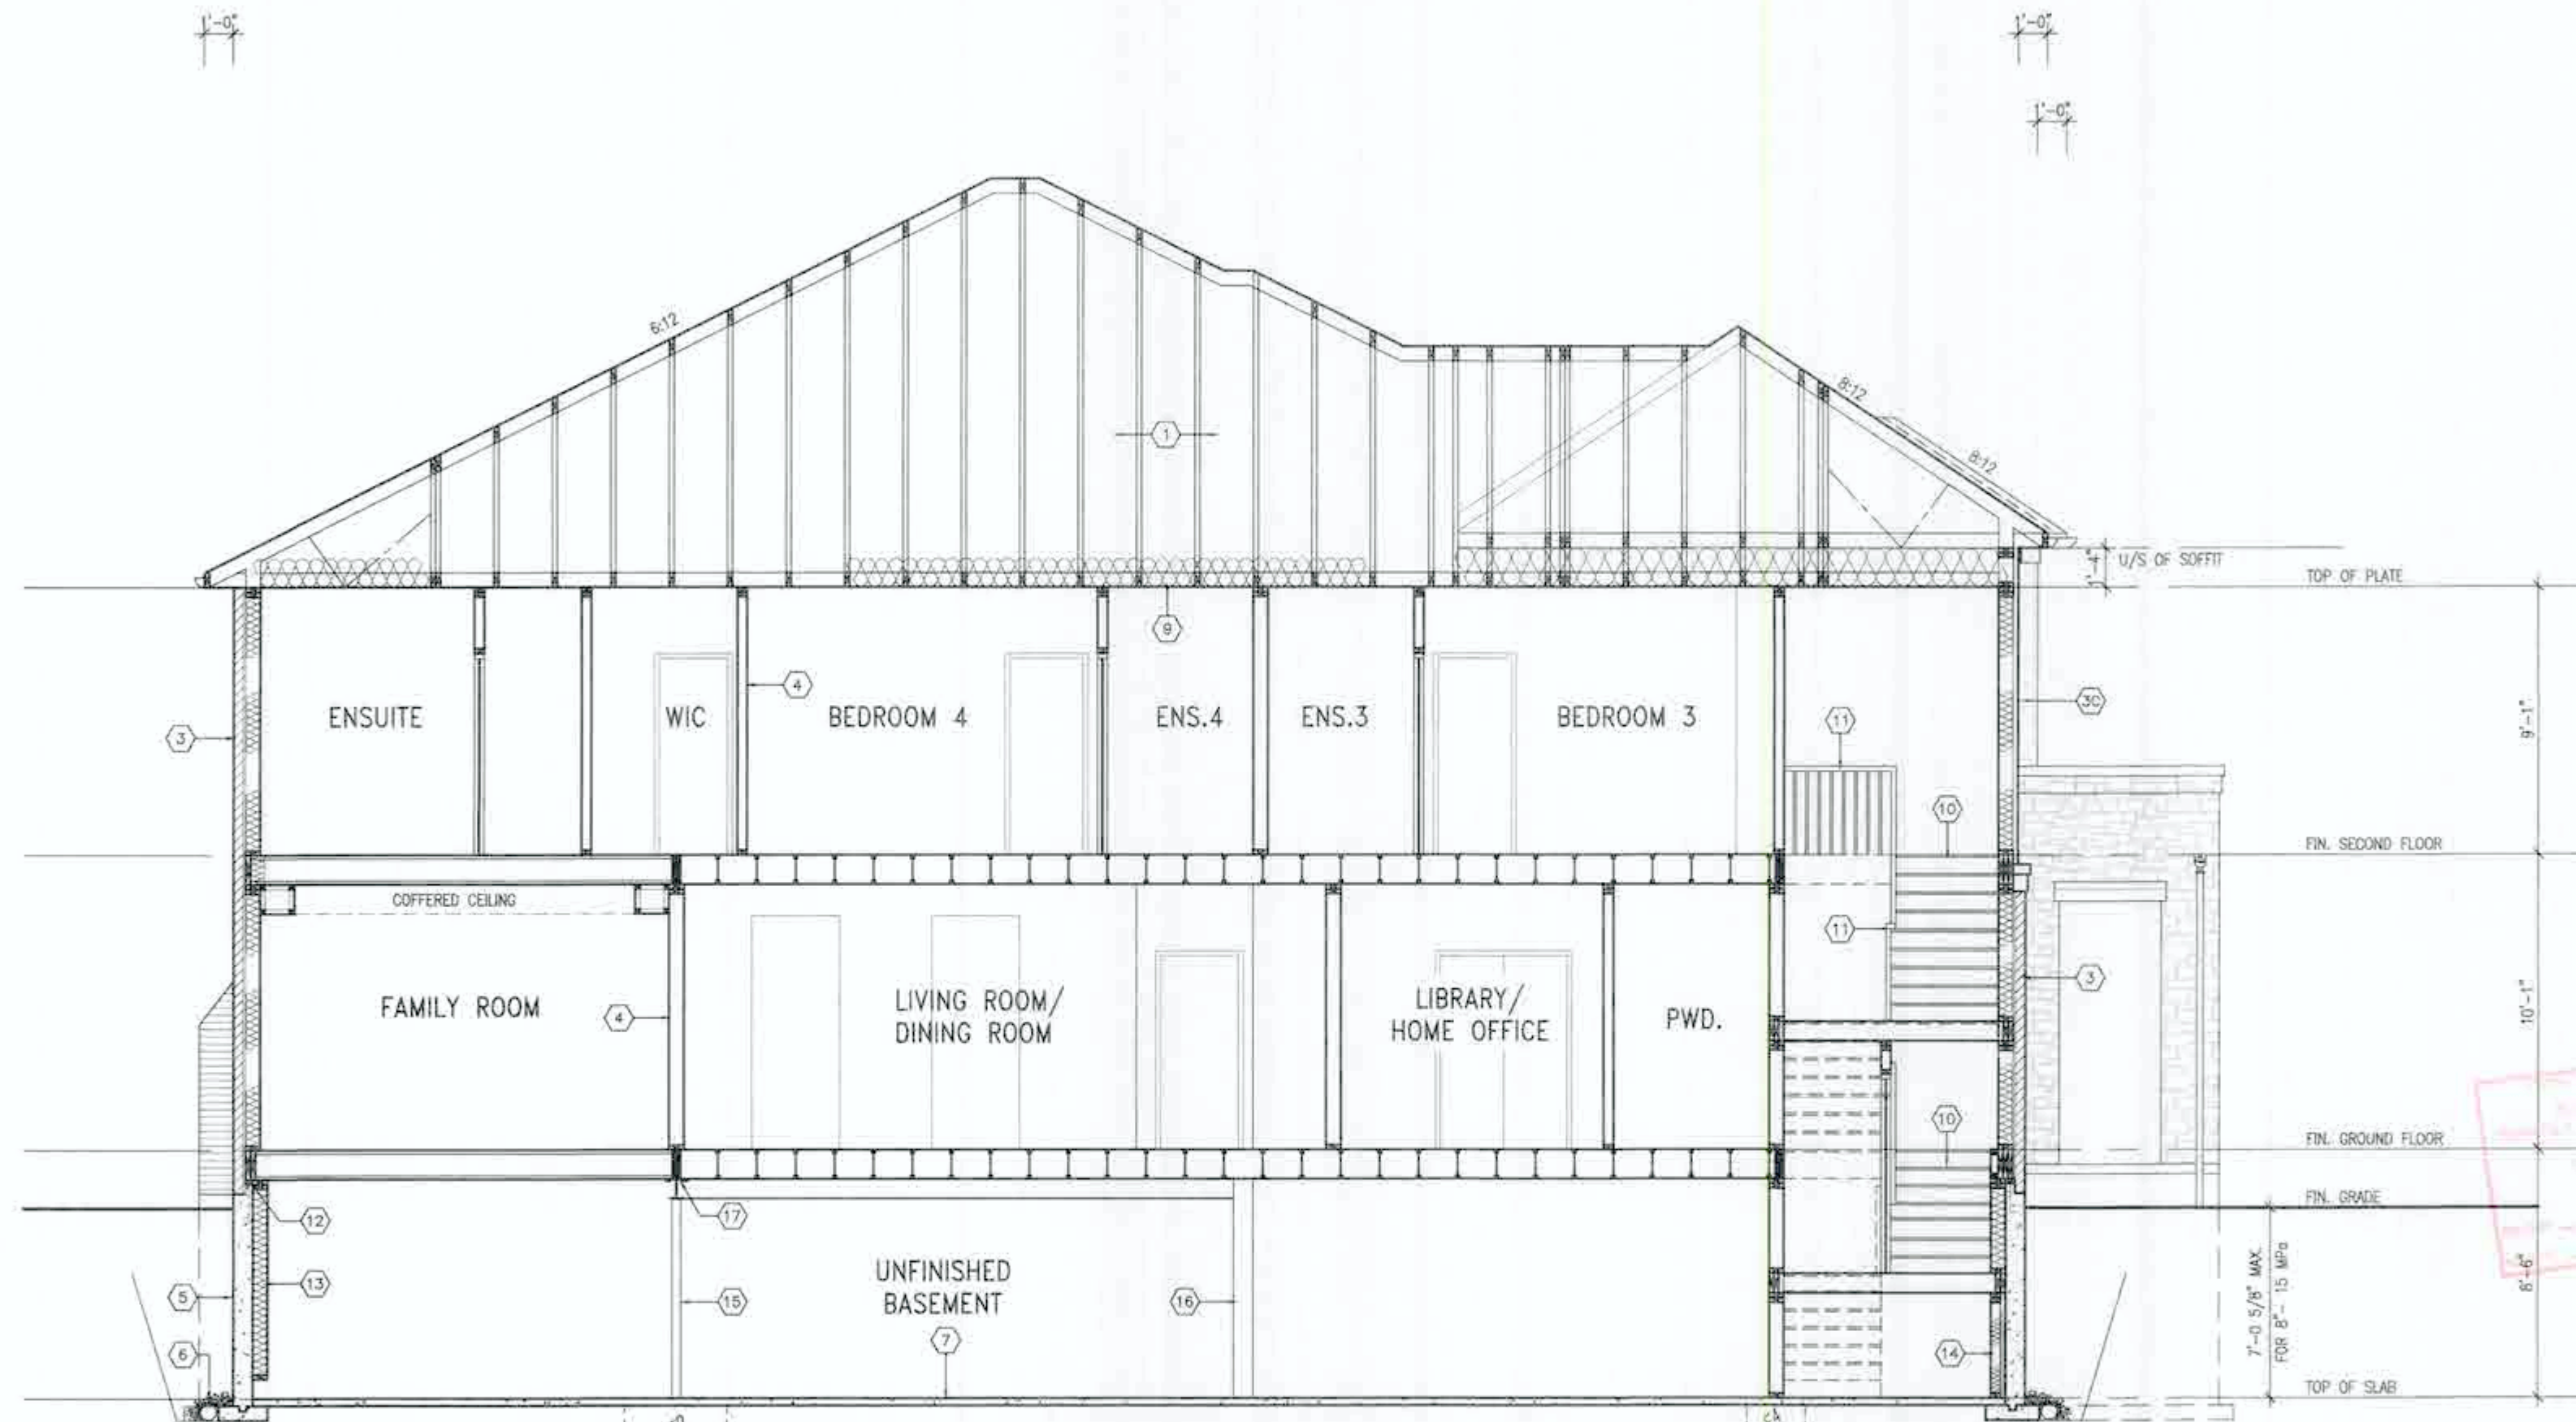

SECTION 'A-A' ELEVATION '2'

CITY OF HAMILTON
Building Department
24 149740

Oct 20/24

It is the builder's complete responsibility to ensure that all plans submitted for approval fully comply with the Architectural Guidelines and all applicable regulations and requirements including zoning provisions and any provisions in the subdivision agreement. The Control Architect is not responsible in any way for examining or approving site (topo) plans or working drawings with respect to any zoning or building code or permit matter or that any house can be properly built or located on its lot.



STRUDET INC.
FOR STRUCTURE ONLY

ELEVATIONS NOT DRAWN TO ACTUAL GRADE.
REFER TO FINAL GRADING PLAN.

SPRINGFIELD 4
COMPLIANCE PACKAGE 'A1'

--	--	--	--	--	--


VAS
DESIGN

Greenpark.

SPRINGFIELD 4
14.30m

project name: RUSSELL GARDENS PH. 4
location: HAMILTON, ON.
drawing no.: 20027

date: FEB 2023
drawn by: [signature]
checked by: [signature]
scale: 3/16" = 1'-0"
title: CROSS SECTION A-A - ELEV. 2
sheet: 20027-SPRINGFIELD-4
drawing no.: A9a

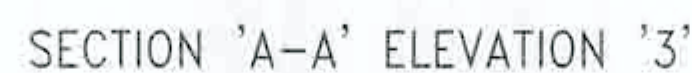

REGISTERED PROFESSIONAL ENGINEER
B. MARINKOVIC
MAY 26 2024
STRUETURE INC.
FOR STRUCTURE ONLY

18			9		
17		V	8		
16			7		
15			6		
14			5		
13			4		
12			3	ISSUED FOR PERMIT	MAY 21/21
11			2	REV. PER CLIENT/PROG./FL/ENG. COMMENTS	MAY 06/21
10			1	PRELIMINARY, ISSUED FOR CLIENT REVIEW	FEB 19/21
no.	description	date	by	no.	description

The undersigned has reviewed and takes responsibility for this design and has the qualifications and meets the requirements set out in the Ontario Building Code to be a Designer.

qualification information

Richard Vink 24

name

signature

registration information

VAS Design Inc. 42

Contractor must verify all dimensions on the job and report any discrepancy to the Designer before proceeding with the work. All drawings and specifications are instruments of service and the property of the Designer which must be returned at the completion of the project. Drawings are not to be copied.

**VA3
DESIGN**
255 Consumers Rd Suite
Toronto ON M2J 1R6
t: 416.830.2255 f: 416.830.2255
va3design.com

 Greenpark.		SPRINGFIELD 4 14.30m
project name RUSSELL GARDENS PH. 4	municipality HAMILTON, ON.	project no. 2002
date FEB 2021	CROSS SECTION A-A - ELEV. 3	drawing no. A9b
drawn by T.P.	checked by 3/16" = 1'-0"	notes 2002-SPRINGFIELD

All drawings, specifications, related documents and design are the intellectual property of VAS DESIGN. Reproduction of this property in whole or in part is strictly prohibited without VAS DESIGN's written permission.



REAR ELEVATION '1'
-DECK CONDITION

EXTERIOR RAILINGS:
3'-6" HIGH RAILING IF LANDING IS MORE
THAN 5'-11" ABOVE FINISHED GRADE
AND 3'-0" HIGH RAILING WHEN LANDING
IS LESS THAN 5'-11" ABOVE ADJACENT
FINISHED GRADE.

ELEVATIONS NOT DRAWN TO ACTUAL GRADE.
REFER TO FINAL GRADING PLAN.

It is the builder's complete responsibility to ensure that all plans submitted for approval fully comply with the Architectural Guidelines and all applicable regulations and requirements including zoning provisions and any provisions in the subdivision agreement. The Control Architect is not responsible in any way for examining or approving site (lotting) plans or working drawings with respect to any zoning or building code or permit matter or that any house can be properly built or located on its lot.



JOHN C. WILLIAMS LTD., ARCHITECT
ARCHITECTURAL CONSULTING, DESIGN
AND CONSTRUCTION

DESIGNED BY: 


18		9		The undersigned has reviewed and takes responsibility for this plan and has the qualifications and meets the requirements set out in the Ontario Building Code to be a Designer.
17		8		qualification information:
16		7		qualification information:
15		6		name
14		5		Richard Vink
13		4		signature
12		3		signature
11		2		VAS Design Inc.
10		1		ISSUED FOR PERMIT MAY 21/21 GWS
9				REV. PER CLIENT/ROOF/L/ENG. COMMENTS MAY 05/21 GWS
8				PRELIMINARY ISSUED FOR CLIENT REVIEW FEB 19/21 GWS
7	DESCRIPTION	DATE	BY	CONTRACTOR MUST VERIFY ALL DIMENSIONS ON THE JOB AND REPORT ANY DISCREPANCY TO THE DESIGNER BEFORE PROCEEDING WITH THE WORK. ALL PREVIOUS CONDITIONS AND DETAILS SHALL REMAIN UNLESS SPECIFICALLY NOTED BY THE DESIGNER WHICH MUST BE NOTED AT THE COMPLETION OF THE WORK.

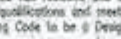GN GN GN The undersigned has reviewed and takes responsibility for this design and meets the qualifications and meets the requirements set out in Ontario Building Code to be a Designer. qualification information: Richard Vink signature some registration information VAS Design Inc.		2 4
Contractor must verify all dimensions on the job and report any discrepancy to the Designer before proceeding with the work. All drawings and specifications are instructions of service and the product of the Designer which must be retained of the completion of the		



255 Containers Rd Suite 12
Toronto ON M2J 1R4
t 416.630.2255 / 416.630.4777
vo3design.com



project name	project no.
RUSSELL GARDENS PH. 4	20027
municipality	
HAMILTON, ON.	
date	
FEB 2021	
REAR ELEVATION "1" - DECK CONDITION	
drawn by	checked by
TP	3/16" = 1'-0"
file name	drawing no.
20027 - SPRINGFIELD-4	A11

SPRINGFIELD 4
COMPLIANCE PACKAGE 'A1'

21 149740

Qm Oct 30/21

All drawings, specifications, related documents and design are the copyright property of VAS DESIGN. Reproduction of this property in whole or in part is strictly prohibited without VAS DESIGN's written permission.



REAR ELEVATION '2'
-DECK CONDITION

EXTERIOR RAILINGS:
3'-6" HIGH RAILING IF LANDING IS MORE
THAN 5'-11" ABOVE FINISHED GRADE
AND 3'-0" HIGH RAILING WHEN LANDING
IS LESS THAN 5'-11" ABOVE ADJACENT
FINISHED GRADE.

ELEVATIONS NOT DRAWN TO ACTUAL GRADE.
REFER TO FINAL GRADING PLAN.

It is the Builders complete responsibility to ensure that all plans submitted for approval fully comply with the Architectural Guidelines and all applicable regulatory and requirements including zoning provisions and any provisions in the subdivision agreement. The Control Architect is not responsible in any way for examining or approving site (lotting) plans or working drawings with respect to any zoning or building code or permit matter or that any house can be properly built or located on its lot.

This is to certify that these plans comply with the applicable Architectural Design Guidelines approved by the City of HAMILTON

JOHN C. WILLIAMS III, ARCHITECT
ARCHITECTURAL CONCEPTS

CITY OF HAMILTON
Building Division
21 149740
o/m oct 30/3

SPRINGFIELD 4
COMPLIANCE PACKAGE 'A1'

SPRINGFIELD 4
14.30m


Greenpark

project name	municipality	project no.
RUSSELL GARDENS PH. 4	HAMILTON, ON.	2002
date	DEAR ELEVATION '0'	DECK CONDITION
		drawing no.

drawn by TP checked by 3/16" = 1'-0" file name 20027-SPRINGFIELD-4

[illegible]

⁴ All *Atropis* maniplines, related documents and design are the copyright property of VAS DESIGN. Reproduction of this property in whole or in part is strictly prohibited without VAS DESIGN's written permission.



EXTERIOR RAILINGS:
3'-6" HIGH RAILING IF LANDING IS MORE
THAN 5'-11" ABOVE FINISHED GRADE
AND 3'-0" HIGH RAILING WHEN LANDING
IS LESS THAN 5'-11" ABOVE ADJACENT
FINISHED GRADE.

ELEVATIONS NOT DRAWN TO ACTUAL GRADE
REFER TO FINAL GRADING PLAN.

It is the builder's complete responsibility to ensure that all plans submitted for approval fully comply with the Architectural Guidelines and all applicable regulations and requirements including zoning provisions and any provisions in the subdivision agreement. The Control Architect is not responsible in any way for examining or approving site (dotting) plans or working drawings with respect to any zoning or building code or permit matter or that any house can be properly built or located on its lot.

This is to certify that these plans comply with the applicable Architectural Design Guidelines approved by the City of HAMILTON.

JCHIN C. WILLIAMS LTD., ARCHITECTS
ARCHITECTURAL CONSULTANTS
AND ENGINEERS

SIGNATURE OF _____
DATE AUG 19, 2021


[illegible]



REAR ELEVATION '1'
-WALK-UP CONDITION

ELEVATIONS NOT DRAWN TO ACTUAL GRADE.
REFER TO FINAL GRADING PLAN.

It is the builder's complete responsibility to ensure that all plans submitted for approval fully comply with the Architectural Guidelines and all applicable regulations and requirements including zoning provisions and any provisions in the subdivision agreement. The Control Architect is not responsible in any way for examining or approving site (lotting) plans or working drawings with respect to any zoning or building code or permit matter or that any house can be properly built or located on its lot.

This is to certify that these plans comply with the applicable Architectural Design Guidelines approved by the City of HAMILTON

JOHN L. WILLIAMS LTD., ARCHITECT
ARCHITECTURAL CONTROL SOCIETY
JULY 1991

SPRINGFIELD 4
COMPLIANCE PACKAGE 'A1'

		SPRINGFIELD 4 14.30m	
project name	RUSSELL GARDENS PH. 4	municipality	HAMILTON, ON.
date	FEB 2021	drawing no.	2002
checked by	3/14"	year	2002
		file name	A13

All drawings, specifications, related documents and design are the copyright property of VKS DESIGN. Reproduction of this property in whole or in part is strictly prohibited without VKS DESIGN's written permission.



ELEVATIONS NOT DRAWN TO ACTUAL GRADE.
REFER TO FINAL GRADING PLAN.

18		5			
17		6			
16		7			
15		8			
14		9			
13		10			
12		11			
11		12			
10		13			
9		14			
8		15			
7		16			
6		17			
5		18			
4		19			
3		20			
2		21			
1		22			
no	description	date	by	no	description

1	ISSUED FOR PERMIT	MAY 21/21	GW
2	REV. PER CLIENT/ROOF/TL/ENG. COMMENTS	MAY 05/21	GW
3	PRELIMINARY ISSUED FOR CLIENT REVIEW	FEB 19/21	GW
4			
5			
It is the builder's complete responsibility to ensure that all plans submitted for approval fully comply with the Architectural Guidelines and all applicable regulations and requirements including zoning provisions and any provisions in the subdivision agreement. The Control Architect is not responsible in any way for examining or approving any (existing) plans or working drawings with respect to any zoning or building code or permit matter or that any house can be properly built or located on its lot.

This is to certify that these plans comply with the applicable Architectural Design Guidelines approved by the City of Hamilton.

JOHN K. WILLIAMS LTD., ARCHITECT
ARCHITECTURAL CONTROL BOARD
AND ENGINEER
DATE: AUG 23, 2021

SPRINGFIELD 4
COMPLIANCE PACKAGE 'A1'

101			
102			
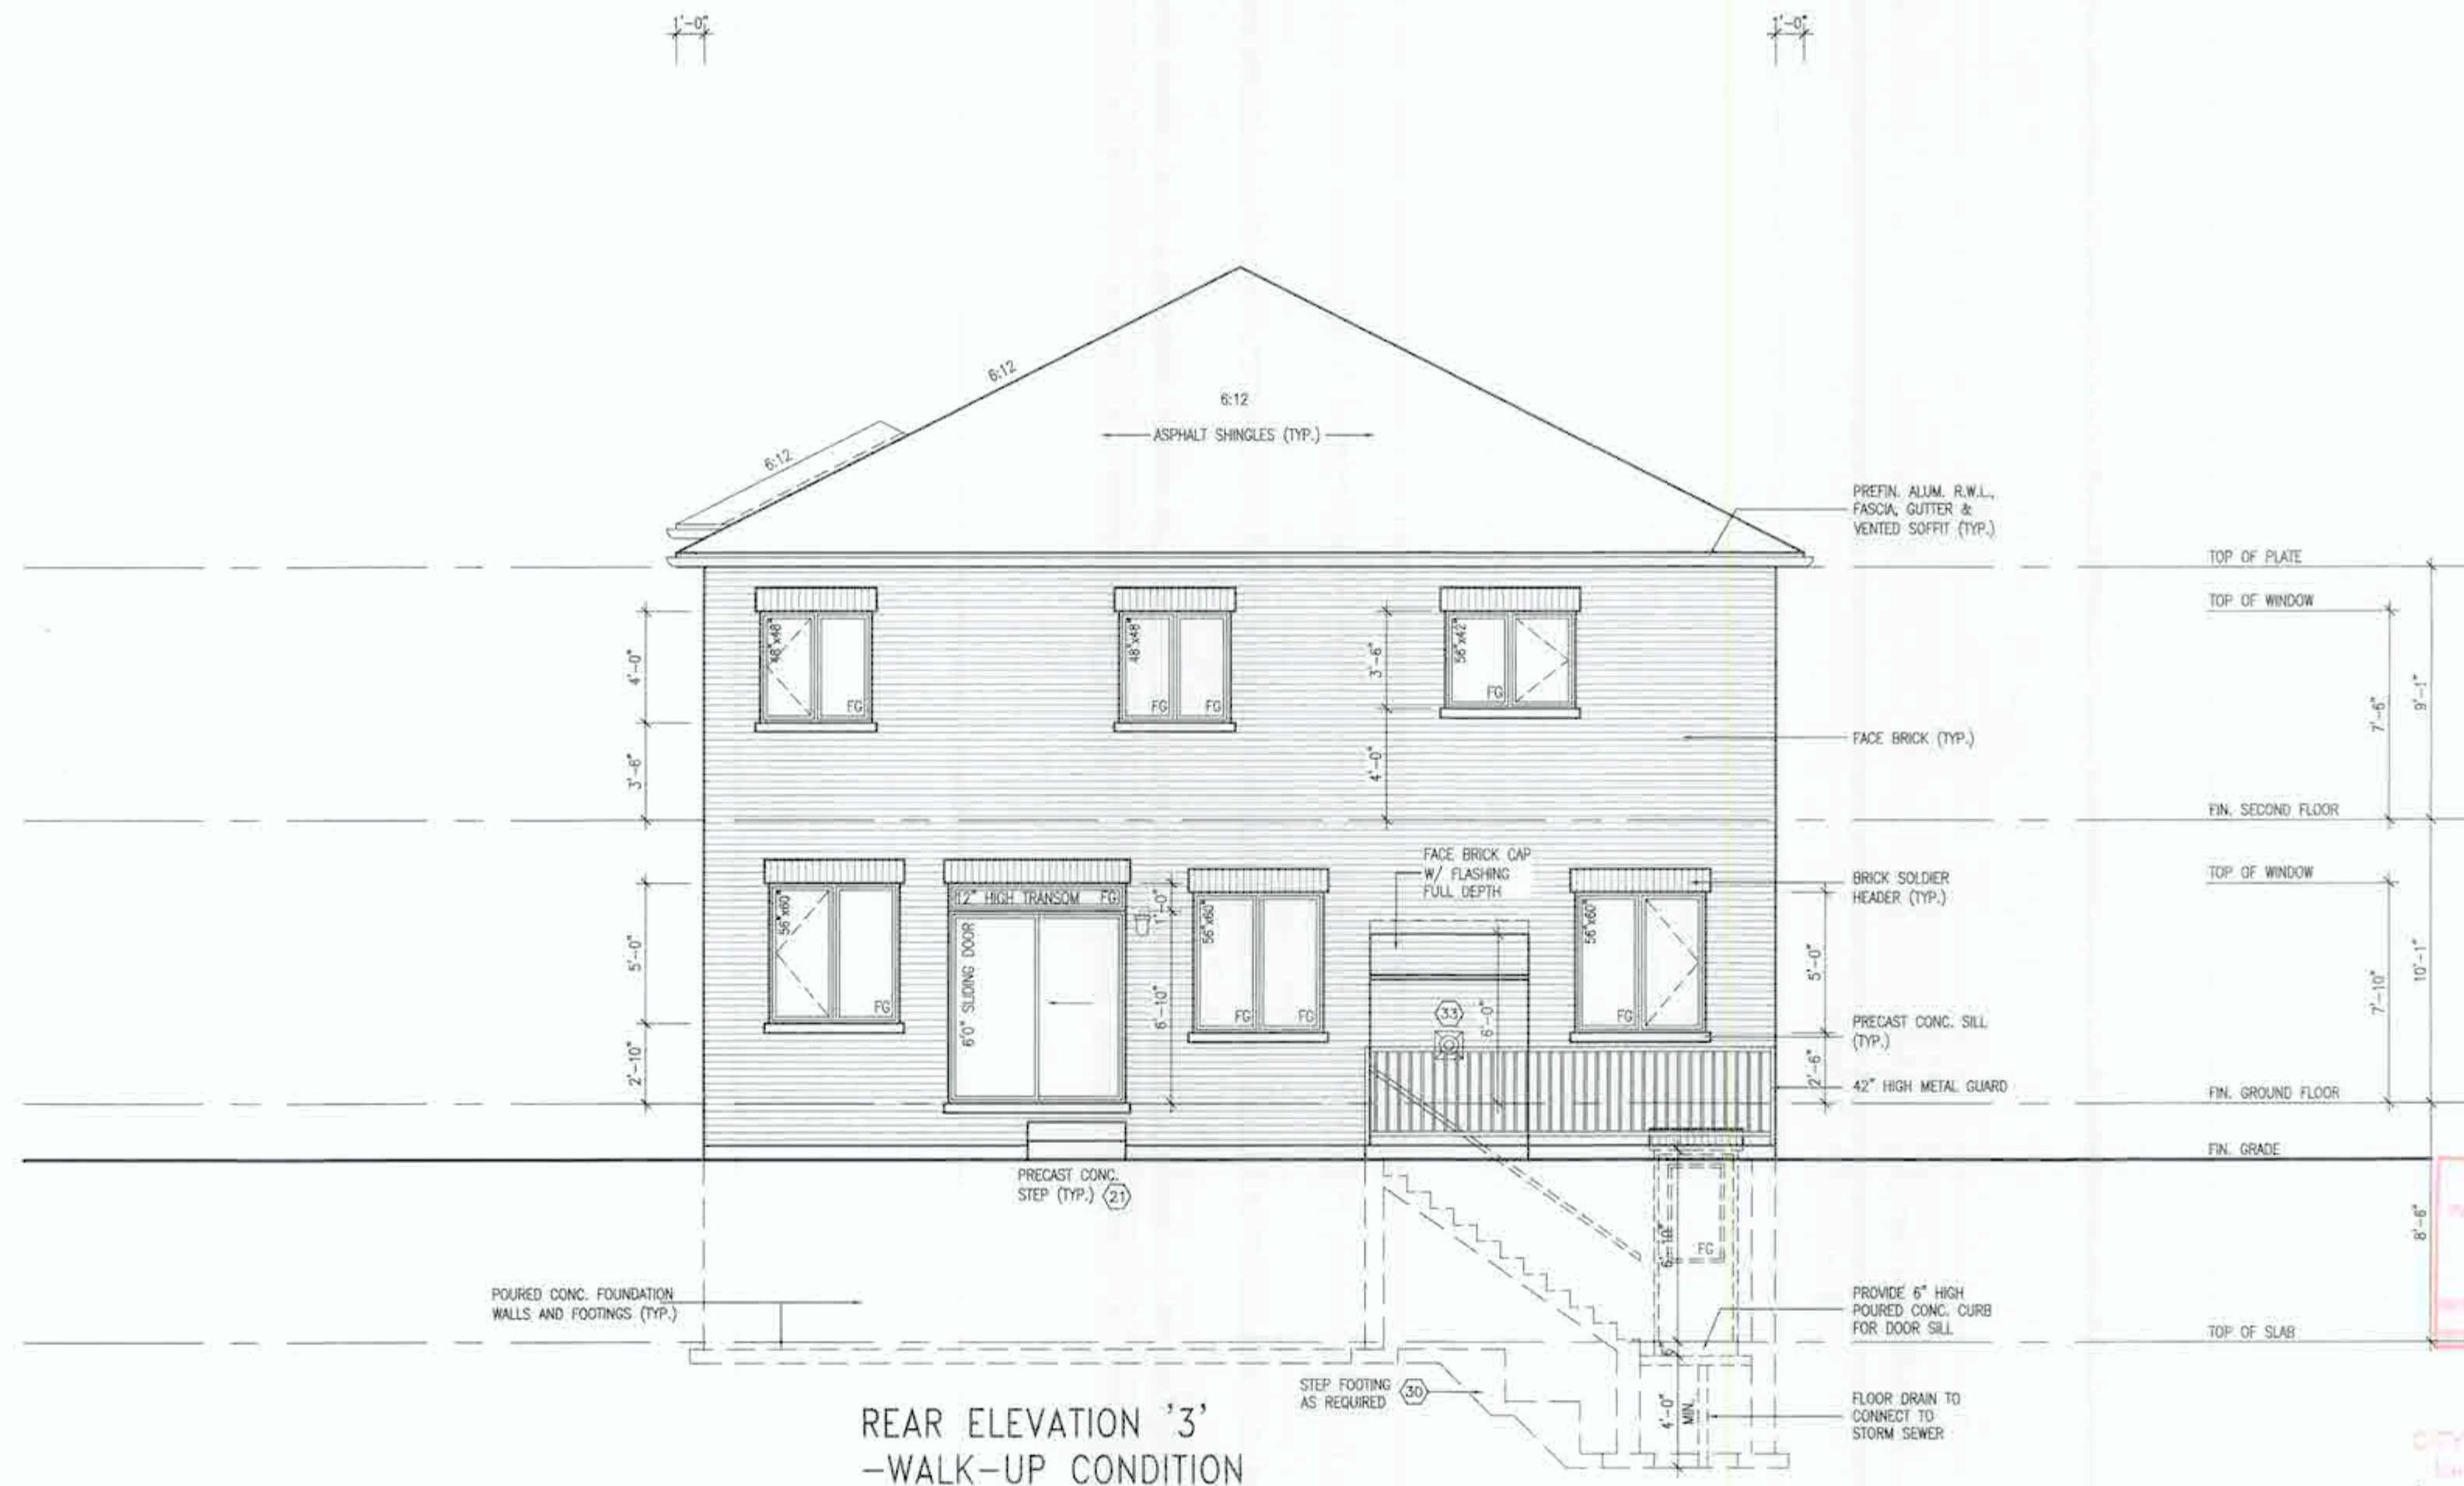

REAR ELEVATION '3'
-WALK-UP CONDITION

It is the builder's complete responsibility to ensure that all plans submitted for approval fully comply with the Architectural Guidelines and all applicable regulations and requirements including zoning provisions and any provisions in the subdivision agreement. The Control Architect is not responsible in any way for examining or approving site (lotting) plans or working drawings with respect to any zoning or building code or permit matter or that any house can be properly built or located on its lot.

This is to certify that these plans comply with the applicable Architectural Design Guidelines approved by the City of HAMILTON.

JOHN C. WILLIAMS LTD. ARCHITECTS
ARCHITECTURAL, INTERIOR DESIGN
AND APPROVAL

APPROVED BY: 

DATE: AUG 15 2001


ELEVATIONS NOT DRAWN TO ACTUAL GRADE.
REFER TO FINAL GRADING PLAN.

[illegible]

All drawings, specifications, related documents and designs are the research property of V&T DESIGN. Reproduction of this property in whole or in part is strictly prohibited without V&T DESIGN's written permission.



REAR ELEVATION '2'
-WALK-OUT CONDITION

ELEVATIONS NOT DRAWN TO ACTUAL GRADE.
REFER TO FINAL GRADING PLAN.

It is the builder's complete responsibility to ensure that all plans submitted for approval fully comply with the Architectural Guidelines and all applicable regulations and requirements including zoning provisions and any provisions in the subdivision agreement. The Control Architect is not responsible in any way for examining or approving site (lotting) plans or working drawings with respect to any zoning or building code or permit matter or that any house can be properly built or located on its lot.

This is to certify that these plans comply with the applicable Architectural Design Guidelines approved by the City of HAMILTON.

JOHN C. WILLIAMS LTD., ARCHITECT
ARCHITECTURAL CONTROL SYSTEMS
330 SPRING
DATE: AUG 25 2022
BY: [Signature]

SPRINGFIELD 4
COMPLIANCE PACKAGE 'A1'

21 149740

8m Oct 30/2

SPRINGFIELD 4
COMPLIANCE PACKAGE 'A1'

Greenpark™ SPRINGFIELD 4
14.30m


Greenpark™ SPRINGFIELD 4
14.30m

Project Name	Municipality	Project No.
RUSSELL GARDENS PH. 4	HAMILTON, ON.	20027

REAR ELEVATION '2'- WALK-OUT CONDITION

3/16" = 1'-0" 20027-SPRINGFIELD-4

© 2003 VLSI DESIGN. Reproduction of this property in whole or in part is strictly prohibited without VLSI DESIGN's written permission.

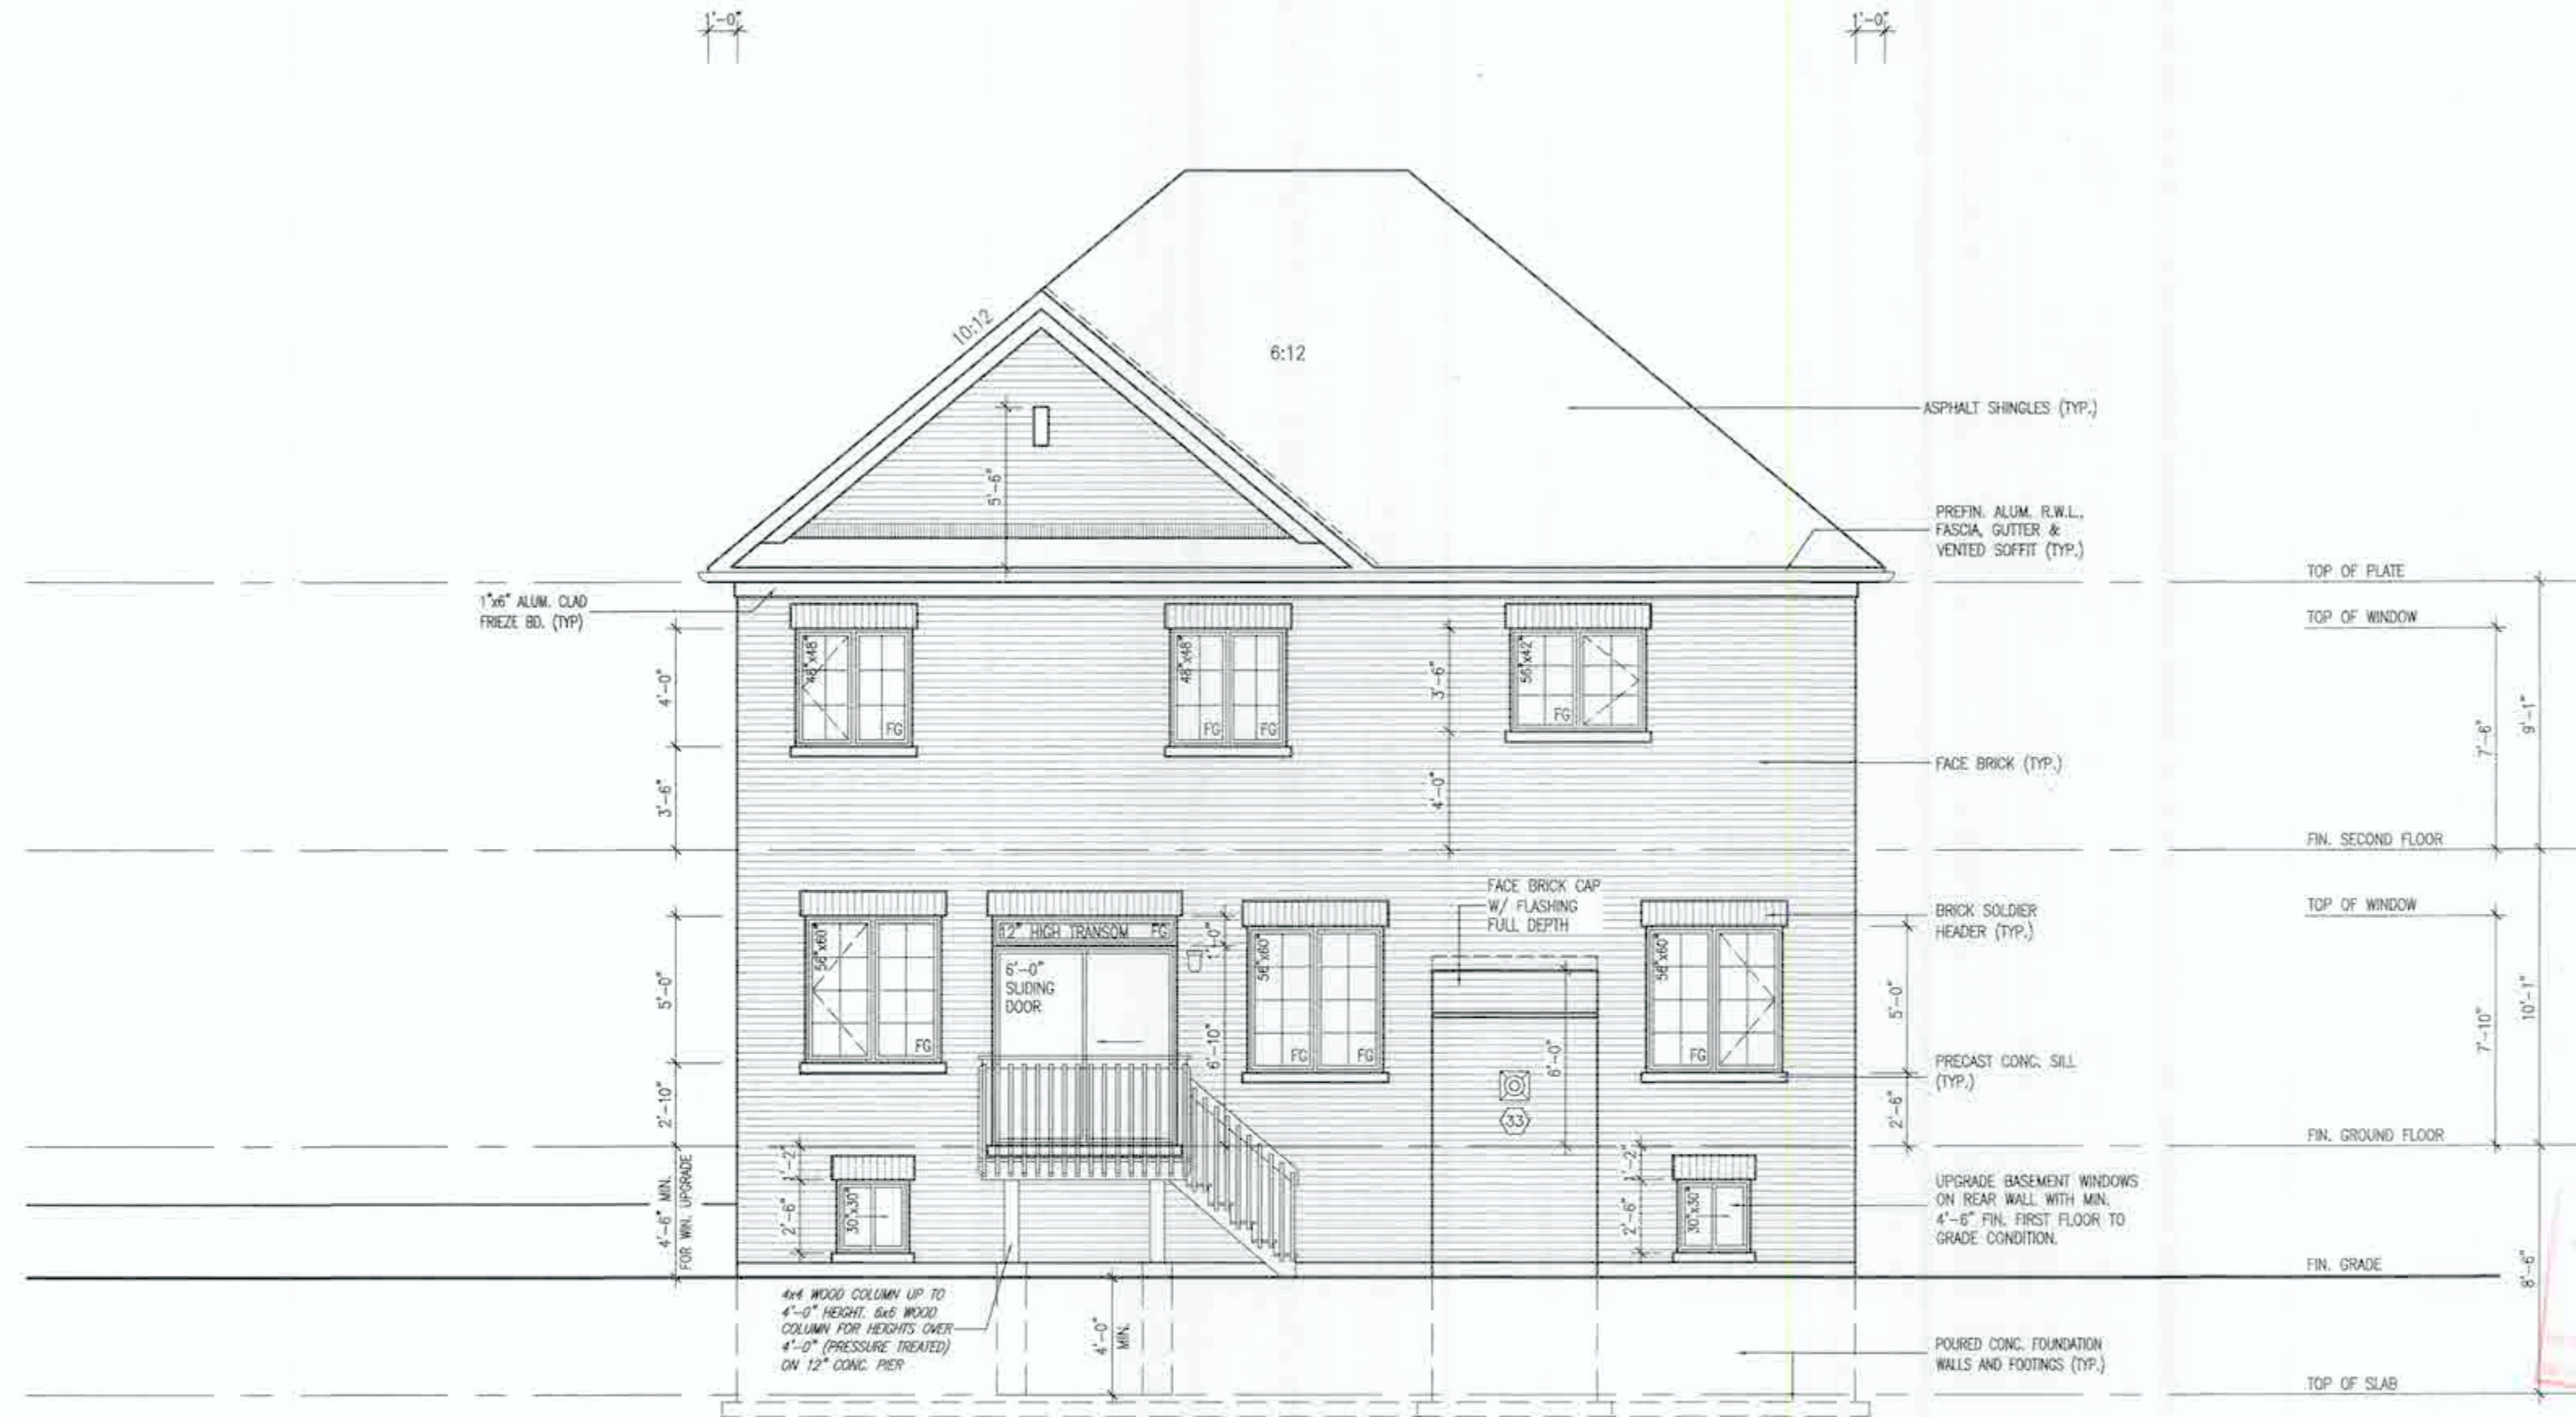

UPGRADED REAR ELEVATION '1'
-DECK CONDITION

EXTERIOR RAILINGS:
3'-6" HIGH RAILING IF LANDING IS MORE
THAN 5'-11" ABOVE FINISHED GRADE
AND 3'-0" HIGH RAILING WHEN LANDING
IS LESS THAN 5'-11" ABOVE ADJACENT
FINISHED GRADE.

ELEVATIONS NOT DRAWN TO ACTUAL GRADE.
REFER TO FINAL GRADING PLAN.

It is the builder's complete responsibility to ensure that all plans submitted for approval fully comply with the Architectural Guidelines and all applicable regulations and requirements including zoning provisions and any provisions in the subdivision agreement. The Control Architect is not responsible in any way for examining or approving site (lotting) plans or working drawings with respect to any zoning or building code or permit matter or that any house can be properly built or located on its lot.

This is to certify that these plans comply with the applicable Architectural Design Guidelines approved by the City of HAMILTON.

JOHN C. WILLIAMS LTD. ARCHITECT
ARCHITECTURAL CONSULTING SERVICE
5400 SPRINGDALE
APPROVED BY: 
DATE: 2/25/2022

16				9					The undersigned has reviewed and bears responsibility for this design, and has the qualifications and meets the requirements set out in the Ontario Building Code to be a Designer.
17				8					Consultant Information
18				7					Richard Vink
19				6					<i>R. Vink</i>
20				5					signature 2448
21				4	ADD WALK-OUT CONDITION	JUN 03/21	WT		seals 90
22				3	ISSUED FOR PERMIT	MAY 21/21	OW		KAS Design Inc. 4265
23				2	REV. PER CLIENT/ROOF/PL/ENG COMMENTS	MAY 05/21	OW		Contractor must verify all dimensions on the job and report any discrepancy to the Designer before proceeding with the work, all drawings and specifications on instruments of service are the property of the Designer which must be returned at the completion of the project.
24				1	PRELIMINARY, ISSUED FOR CLIENT REVIEW	FEB 19/21	OW		date
25	description		date	by	description		date	by	

WT	name	signature	2448
CW	registration information		90
CW	VAS Design Inc.		4265

**VA3
DESIGN**
255 Consumers Rd Suite 112
Toronto ON M2J 1R4
t 416.630.2255 • f 416.630.4711
vo3design.com

		SPRINGFIELD 4 14.30m	
project name RUSSELL GARDENS PH. 4	city HAMILTON, ON.	project no. 20027	
date FEB 2021	UPGRADED REAR ELEV. '1'- DECK CONDITION		drawing no. A16
drawn by JP	checked by 3/16" = 1'-0"	date 20027-SPRINGFIELD-4	

All drawings, specifications, related documents and design are the copyright property of VAS DESIGN. Reproduction of this property in whole or in part is strictly prohibited without VAS DESIGN's written permission.



UPGRADED REAR ELEVATION '3'
-DECK CONDITION

EXTERIOR RAILINGS:
3'-6" HIGH RAILING IF LANDING IS MORE
THAN 5'-11" ABOVE FINISHED GRADE
AND 3'-0" HIGH RAILING WHEN LANDING
IS LESS THAN 5'-11" ABOVE ADJACENT
FINISHED GRADE.

ELEVATIONS NOT DRAWN TO ACTUAL GRADE.
REFER TO FINAL GRADING PLAN.

It is the builder's complete responsibility to ensure that all plans submitted for approval fully comply with the Architectural Guidelines and all applicable regulations and requirements including zoning provisions and any provisions in the subdivision agreement. The Control Architect is not responsible in any way for examining or approving site (lotting) plans or working drawings with respect to any zoning or building code or permit matter or that any house can be properly built or located on its lot.

This is to certify that these plans comply with the applicable Architectural Design Guidelines approved by the City of HAMILTON.


JOHN C. WILLIAMS LTD., ARCHITECTS
ARCHITECTURAL CONSULTANTS
AND ENGINEERS

APPROVED BY _____
DATE AUG 12, 2013


[illegible]

All drawings, specifications, related documents and design are the copyright property of V&J DESIGN. Reproduction of this property in whole or in part is strictly prohibited without V&J DESIGN's written permission.

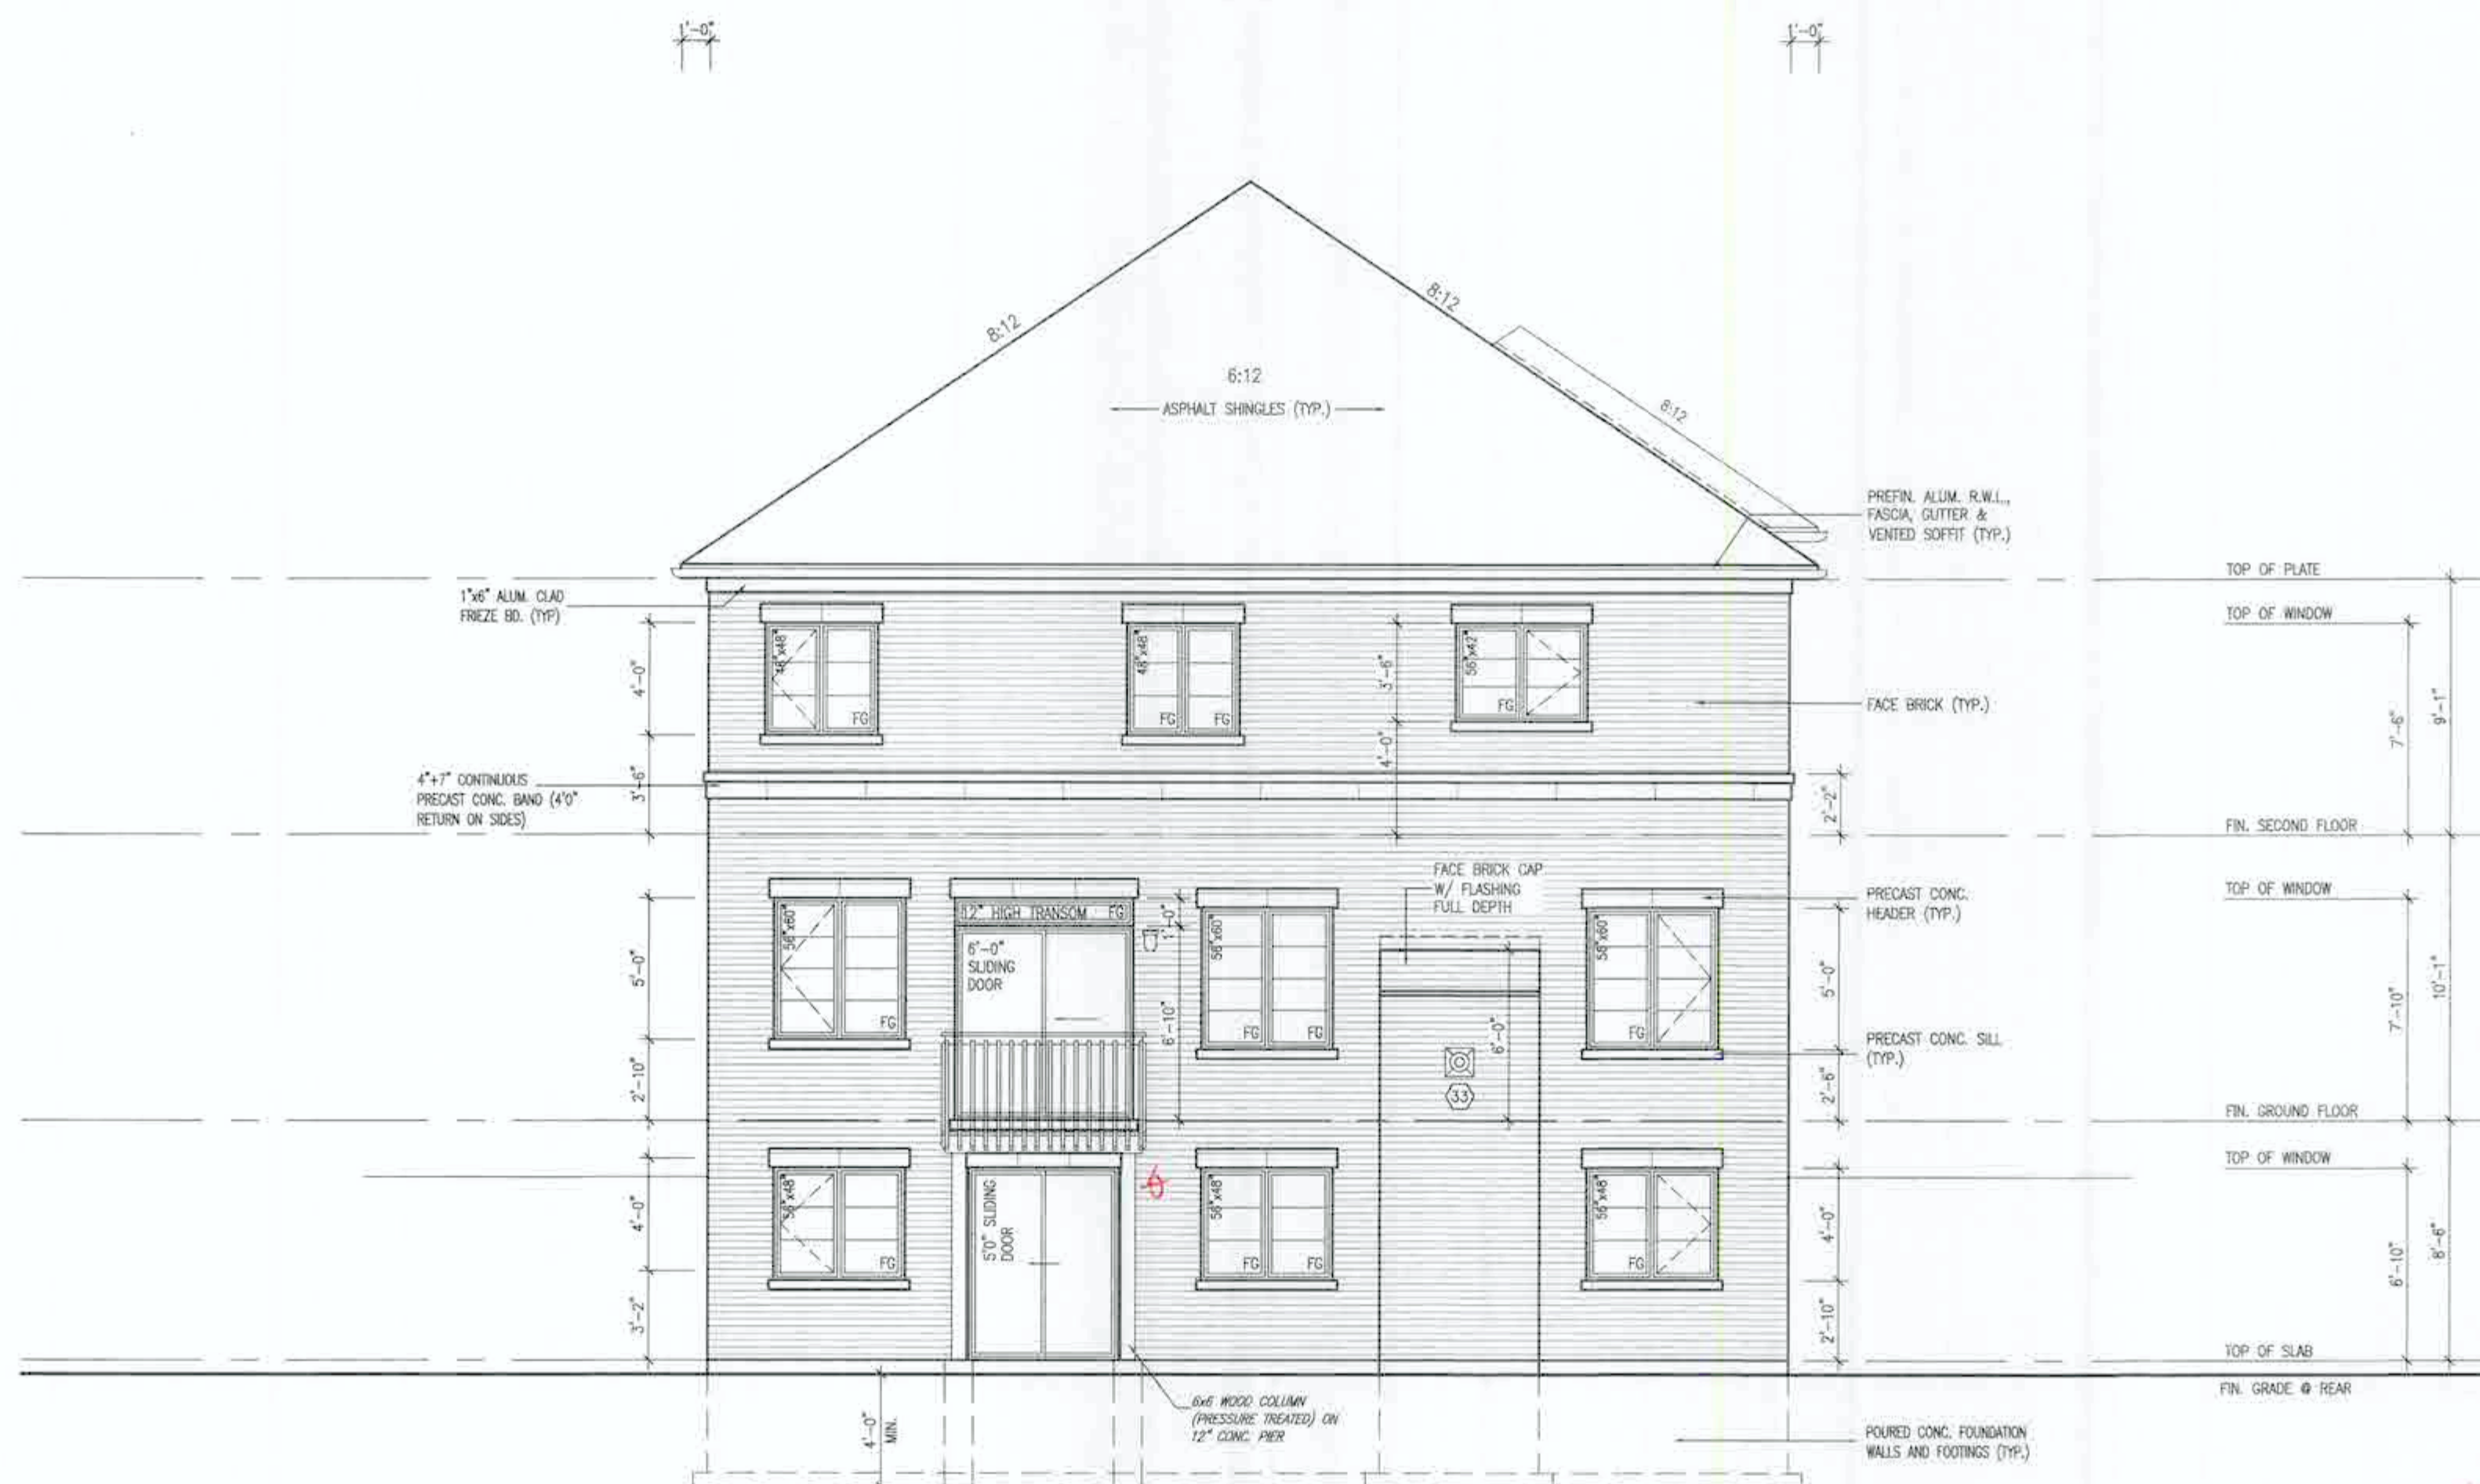

UPGRADED REAR ELEVATION '2'
-WALKOUT CONDITION

ELEVATIONS NOT DRAWN TO ACTUAL GRADE.
REFER TO FINAL GRADING PLAN.

It is the owner's complete responsibility to ensure that all plans submitted for approval fully comply with the Architectural Guidelines and all applicable regulations and requirements including zoning provisions and any provisions in the subdivision agreement. The Control Architect is not responsible in any way for examining or approving site (lotting) plans or working drawings with respect to any zoning or building code or permit matter or that any house can be properly built or located on its lot.

This is to certify that these plans comply with the applicable Architectural Design Guidelines approved by the City of HAMILTON.

JOHN B. WILLIAMS LTD., ARCHITECT

18			9	The undersigned has reviewed and takes responsibility for this design and how the specifications and details meet requirements set in the Ontario Building Code to be a Designer.	
17			6	professional information	
16			7	Richard Vink	2440
15			8	signature	
14			5	name	
13			4	professional information	
12			3	VAS Design Inc.	4267
11			2	JUN 03/21	WT
10			1	MAY 21/21	OW
9				MAY 05/21	OW
8				FEB 19/21	GW
7					
6					
5					
4					
3					
2					
1					
no	description	date	by	description	

WT	The undersigned has reviewed and takes responsibility for this design and how the qualifications and reveals the requirements set out in the Ontario Building Code to be a Designer:	
DN	Qualification information	
WT	Richard Vink	2446
DN	Name	signature
WT	V&S Design Inc.	4262
DN	Contractor must verify all dimensions on the job and report any discrepancy to the Designer before proceeding with the work. All drawings and specifications are instruments of service and the property of the Designer which must be returned at the completion of the work. Drawings are not to be copied.	

**VA3
DESIGN**
255 Consumers Rd Suite 1
Toronto, ON M2J 1R4
t 416.830.2255 f 416.630.4
va3design.com

 **Greenpark.**

Project name: **MUSSELL GARDENS PH. 4** Town: **HAMILTON,**

Date: **FEB 2021** Description: **UPGRADED REAR ELEV. '2**

Drawn by: _____ Checked by: _____ Scale: **3/16" = 1'-0"**


SPRINGFIELD 4
COMPLIANCE PACKAGE 'A1'

Greenpark.		SPRINGFIELD 4
		14.30m
PH. 4	HAMILTON, ON.	project 2002
UPGRADED REAR ELEV. '2" - WALKOUT COND.		drawing no.
checked by 3/16" = 1'-0"		20027-SPRINGFIELD-4
scale 3/16" = 1'-0"		A176

