

CONSTRUCTION SUMMARY

Hazel Glenn - Barlassina Construction Inc.

PURCHASER: KOMAL SINGH

TEL: RES.: 647-804-9571

LOT / PHASE Block 119 TH30 / 1	REG. PLAN #	HOUSE TYPE Cherry 3E Elev 2		
-----------------------------------	-------------	--------------------------------	--	--

ELECTRICAL

1 - PLUG - ELECTRICAL PLUG - 5 FEET FROM FINISHED FLOOR FOR FUTURE WALL MOUNTED TV - SEE SKETCH 16Mar23 Note:	
1 - LIGHT AND SWITCH - NO FIXTURE INCLUDED - LIVING ROOM 16Mar23 Note:	
1 - ABOVE KITCHEN ISLAND - ADD LIGHT AND SWITCH - NO FIXTURE INCLUDED 16Mar23 Note:	
1 - PLUG - ELECTRICAL PLUG WITH GFI AND SWITCH - FOR FESTIVE LIGHTING 16Mar23 Note:	

FIREPLACE AND ACCESSORIES

1 - GAS LINE ROUGH-IN FOR STOVE (INCLUDES ELECTRICAL OUTLET) - FIRST FLOOR 16Mar23 Note:	
---	--

PLUMBING

2 - TOE TESTER - ADD TOE TESTER TO SHOWER - MASTER ENSUITE AND MAIN BATHROOM SHOWERS 16Mar23 Note:	
1 - WATER LINE FOR FRIDGE - ROUGH-IN ONLY 16Mar23 Note:	
1 - WASHROOM - 3 PIECE ROUGH-IN IN BASEMENT 16Mar23 Note:	
1 - TUB TO SHOWER CONVERSION - 5 FOOT SHOWER WITH SLIDING GLASS CHROME DOORS IN LIEU OF TUB INCLUDES SHOWER POT LIGHT 16Mar23 Note:	

PROMOTIONAL

1 - PARTIAL REDEMPTION OF PROMOTIONAL PACKAGE \$7,530 BALANCE FORWARD \$2,470 TO BE USED AT A LATER DATE. ORIGINAL PROMOTIONAL PACKAGE OF \$10,000 AS PER SCHEDULE PE DATED MMMDDYYYY. 16Mar23 Note:	
--	--

This Document is Extremely Time Sensitive - Printed 16 Mar 23 at 15:56

BLK 119 TH30

HAZEL
GLENN
ALLEN

Cherry 3E

ELEVATION 1 & 2 - 2,154 sq.ft.
Includes 14 sq.ft. of open area

add light




plug 5ft from floor

add light

add R.H.

Tub to shower

Main Level
festive plug

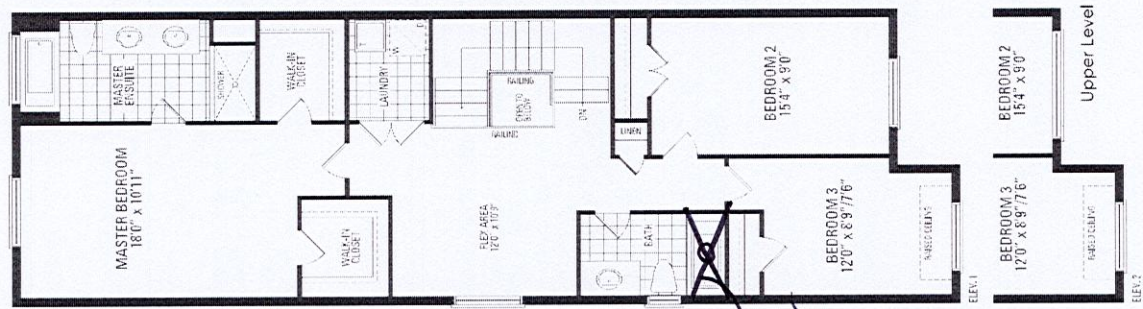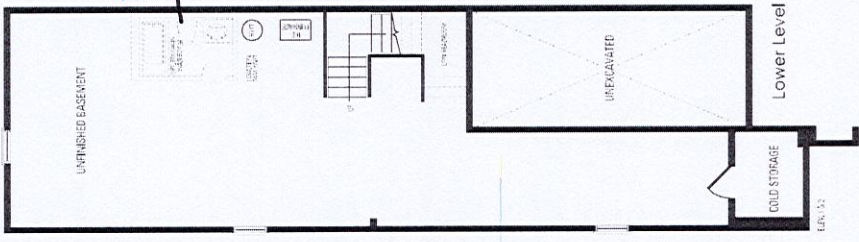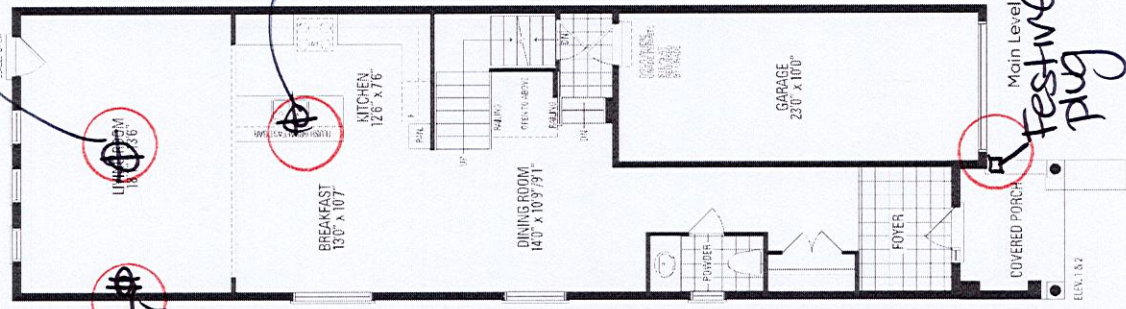

Orientation of home may be reversed and purchaser agrees to accept the same. Steps and porches may vary at any exterior entrance ways due to grading variance. Actual usable floor space may vary from the stated floor areas. All renderings are artist's concept. Dimensions, specifications and architectural detailing subject to modifications. Roofline and adjoining model types may vary due to siting. E. & O.E. October 2022