

|                                                     |             |                                     |  |  |
|-----------------------------------------------------|-------------|-------------------------------------|--|--|
| CONSTRUCTION SUMMARY                                |             |                                     |  |  |
| Hazel Glenn - Barlassina Construction Inc. RECEIVED |             |                                     |  |  |
| PURCHASER: Anne M. STEWART                          |             | APR 10 2023 TEL: RES.: 647-482-7887 |  |  |
| LOT / PHASE                                         | REG. PLAN # | HOUSE TYPE                          |  |  |
| Block 121 TH9 / 1                                   |             | Cherry 2 Elev 1                     |  |  |

CONSTRUCTION

|                                                       |  |
|-------------------------------------------------------|--|
| 1 - SMOOTH CEILINGS FIRST FLOOR ONLY<br>10Apr23 Note: |  |
|-------------------------------------------------------|--|

ELECTRICAL

|   |  |
|---|--|
| 1 - STANDARD DINING ROOM LIGHT TO BE CENTERED BETWEEN LIVING AND DINING ROOM<br>10Apr23 Note:                                                                       |  |
| 1 - PLUG - ELECTRICAL PLUG - 5 FEET FROM FINISHED FLOOR FOR FUTURE WALL MOUNTED TV - SEE SKETCH - LIVING/DINING ROOM<br>10Apr23 Note:                               |  |
| 1 - ABOVE KITCHEN ISLAND - ADD LIGHT AND SWITCH - NO FIXTURE INCLUDED<br>10Apr23 Note:                                                                              |  |
| 1 - ELECTRIC VEHICLE ROUGH-IN PROVISION ONLY FOR FUTURE ELECTRIC CAR (CONDUIT FROM BASEMENT INTO JUNCTION BOX IN GARAGE WITH PULL STRING, NO WIRE)<br>10Apr23 Note: |  |

MISCELLANEOUS

|   |  |
|---|--|
| 1 - GARAGE DOOR OPENER – LIFEMASTER 8155 WITH BELT DRIVE – INLCUDES 1 KEYPAD & 2 HANDHELD CONTROLS - PRICE IS PER GARAGE DOOR<br>10Apr23 Note: |  |
|---|--|

PLUMBING

|   |  |
|---|--|
| 1 - DELTA MULTIFUNCTION HAND HELD ON SLIDE BAR WITH DIVERTER TO ADD TO STANDARD FAUCET TRIM CHROME # R11000 / T11800 / 57014 / 50560 - MASTER ENSUITE SHOWER<br>10Apr23 Note: |  |
| 1 - HOSE BIB - EXTERIOR FROST FREE - ADDED TO BACKYARD<br>10Apr23 Note:   |  |
| 1 - WASHROOM - 3 PIECE ROUGH-IN IN BASEMENT<br>10Apr23 Note:   |  |

PROMOTIONAL

|   |  |
|---|--|
| 1 - PARTIAL REDEMPTION OF PROMOTIONAL PACKAGE \$8,390 BALANCE FORWARD \$6,610 TO BE USED AT A LATER DATE. ORIGINAL PROMOTIONAL PACKAGE OF \$15,000 AS PER SCHEDULE PE.<br>10Apr23 Note: |  |
|---|--|

This Document is Extremely Time Sensitive - Printed 10 Apr 23 at 11:39

# Cherry 2

ELEVATION 1 & 2 - 2,030 sq.ft.




Center  
std light

add plug  
5ft from  
F100r

add light  
over island

★ ADD  
D.I

electric  
cabin

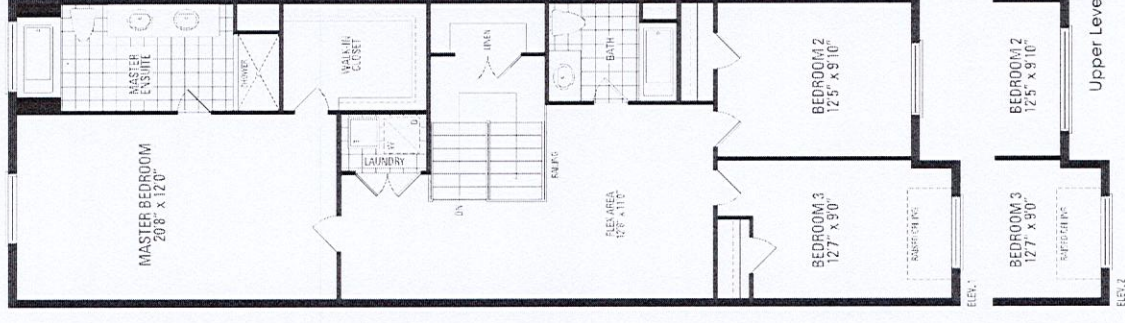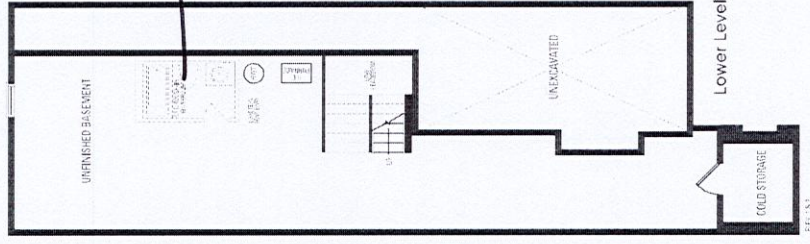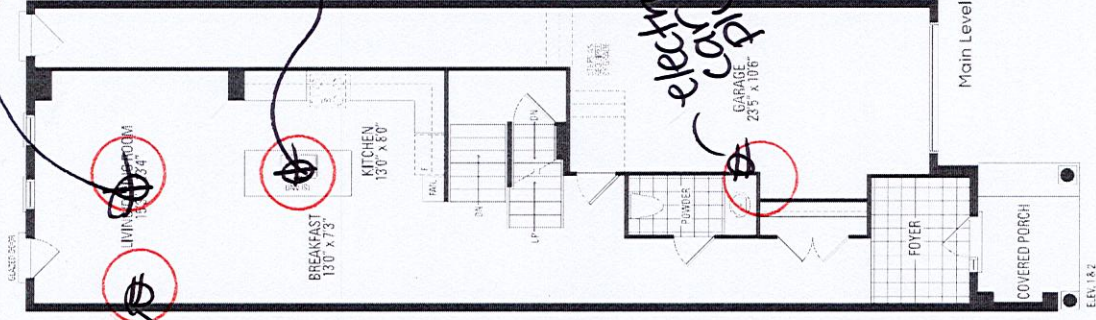

Orientation of home may be reversed and purchaser agrees to accept the same. Steps and porches may vary at any exterior entrance ways due to grading variance. Actual usable floor space may vary from the stated floor areas. All renderings are artist's concept. Dimensions, specifications and architectural detailing subject to modifications. Roofline and adjoining model types may vary due to siting. E. & O.E. October 2022