

CONSTRUCTION SUMMARY
Hazel Glenn - Barlassina Construction Inc.
PURCHASERS: ARAVIND SASIDHARAN NAIR and SHEEBA BALAKRISHNAN PILLAI TEL: RES.: 416-802-5396 BUS.: 437-326-1990

LOT / PHASE Block 122 TH55 / 1	REG. PLAN #	HOUSE TYPE Willow 3E Elev 3		
-----------------------------------	-------------	--------------------------------	--	--

ELECTRICAL

1 - LIGHT AND SWITCH - NO FIXTURE INCLUDED - LIVING ROOM 11Apr23 Note:	
1 - ABOVE KITCHEN ISLAND - ADD LIGHT AND SWITCH - NO FIXTURE INCLUDED 11Apr23 Note:	
1 - ELECTRIC VEHICLE ROUGH-IN PROVISION ONLY FOR FUTURE ELECTRIC CAR (CONDUIT FROM BASEMENT INTO JUNCTION BOX IN GARAGE WITH PULL STRING, NO WIRE) 11Apr23 Note:	

FIREPLACE AND ACCESSORIES

1 - GAS LINE ROUGH-IN FOR STOVE (INCLUDES ELECTRICAL OUTLET) - FIRST FLOOR 11Apr23 Note:	
--	--

MISCELLANEOUS

1 - GARAGE DOOR OPENER – LIFEMASTER 8155 WITH BELT DRIVE – INLCUDES 1 KEYPAD & 2 HANDHELD CONTROLS - PRICE IS PER GARAGE DOOR 11Apr23 Note:	
---	--

PLUMBING

2 - TOE TESTER - ADD TOE TESTER TO SHOWER 11Apr23 Note: MASTER ENSUITE MAIN BATHROOM	
1 - WATER LINE FOR FRIDGE - ROUGH-IN ONLY 11Apr23 Note:	
1 - WASHROOM - 3 PIECE ROUGH-IN IN BASEMENT 11Apr23 Note:	
1 - TUB TO SHOWER CONVERSION - 5 FOOT SHOWER WITH SLIDING GLASS CHROME DOORS IN LIEU OF TUB INCLUDES SHOWER POT LIGHT 11Apr23 Note: MAIN BATHROOM	

PROMOTIONAL




1 - PARTIAL REDEMPTION OF PROMOTIONAL PACKAGE \$8,485.00. BALANCE FORWARD \$1,515.00 TO BE USED AT A LATER DATE. ORIGINAL PROMOTIONAL PACKAGE OF \$10,000.00 AS PER SCHEDULE PE. 11Apr23 Note:	
--	--

This Document is Extremely Time Sensitive - Printed 12 Apr 23 at 13:24

BLK 122 TH55

Willow 3E

ELEVATION 1,775 sq.ft. • ELEVATION 2 & 3 - 1,765 sq.ft.

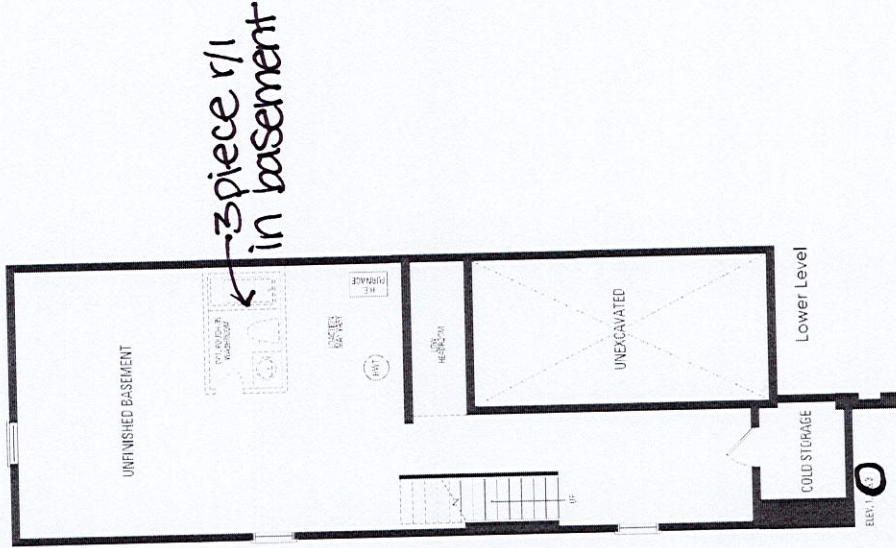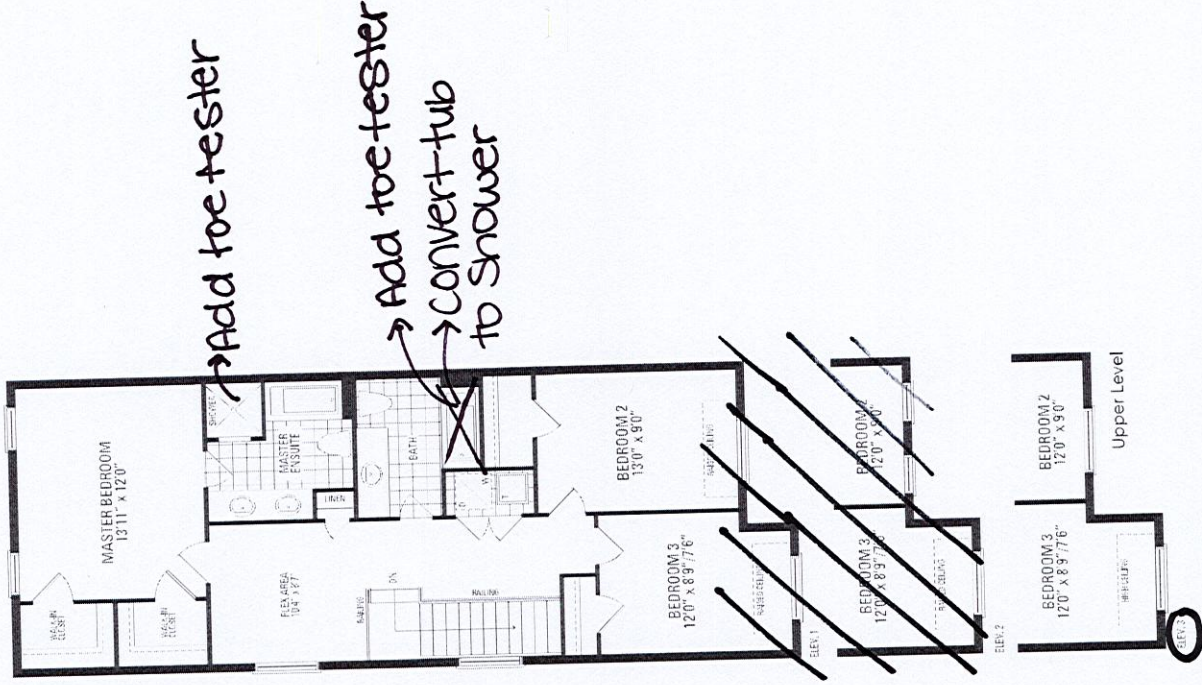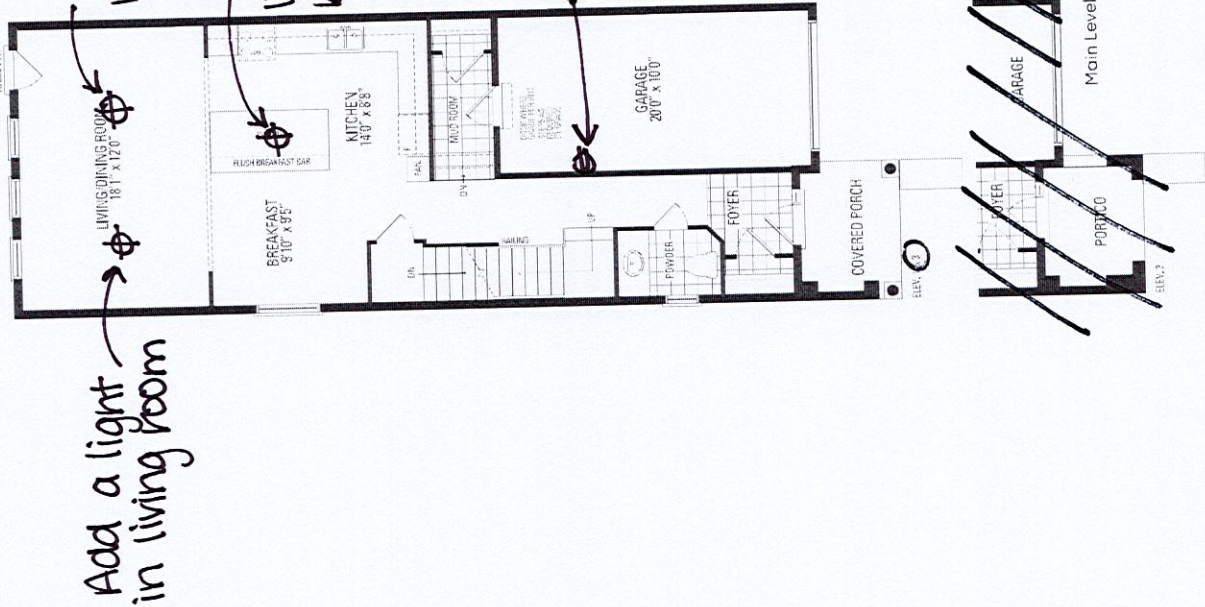

*gasline r/i for stove
*water line r/i for fridge

Orientation of home may be reversed and purchaser agrees to accept the same. Steps and porches may vary at any exterior entrance ways due to grading variance. Actual usable floor space may vary from the stated floor areas. All renderings are artist's concept. Dimensions, specifications and architectural detailing subject to modifications. Roofline and adjoining model types may vary due to siting. E. & O.E. October 2022