

CONSTRUCTION SUMMARY

Palmetto - Zadorra Estates Corp.

RECEIVED

PURCHASERS: Ashwin Chandra PENDYALA and Haarika MADIREDDI

JUN 19 2023

TEL: RES.: 289-387-9173

|                        |             |                               |  |  |
|------------------------|-------------|-------------------------------|--|--|
| LOT / PHASE<br>135 / 1 | REG. PLAN # | HOUSE TYPE<br>Villa 12 Elev 2 |  |  |
|------------------------|-------------|-------------------------------|--|--|

CONSTRUCTION

|   |  |
|---|--|
| 4 - ENLARGED BASEMENT WINDOWS (MAY REQUIRE WINDOW WELLS) - WINDOW IS 30 INCHES X 24 INCHES<br>09Jun23 Note: |  |
|---|--|


PROMOTIONAL

|   |  |
|---|--|
| 1 - PARTIAL REDEMPTION OF PROMOTIONAL PACKAGE \$2,600.00 BALANCE FORWARD \$12,400.00 TO BE USED AT A LATER DATE. ORIGINAL PROMOTIONAL PACKAGE OF \$15,000.00 AS PER SCHEDULE PE.<br>09Jun23 Note: |  |
|---|--|

This Document is Extremely Time Sensitive - Printed 9 Jun 23 at 13:28

Villa 12 36' LOT

ELEVATION 1 2,811 sq.ft. • ELEVATION 2 2,811 sq.ft. • ELEVATION 3 2,784 sq.ft.

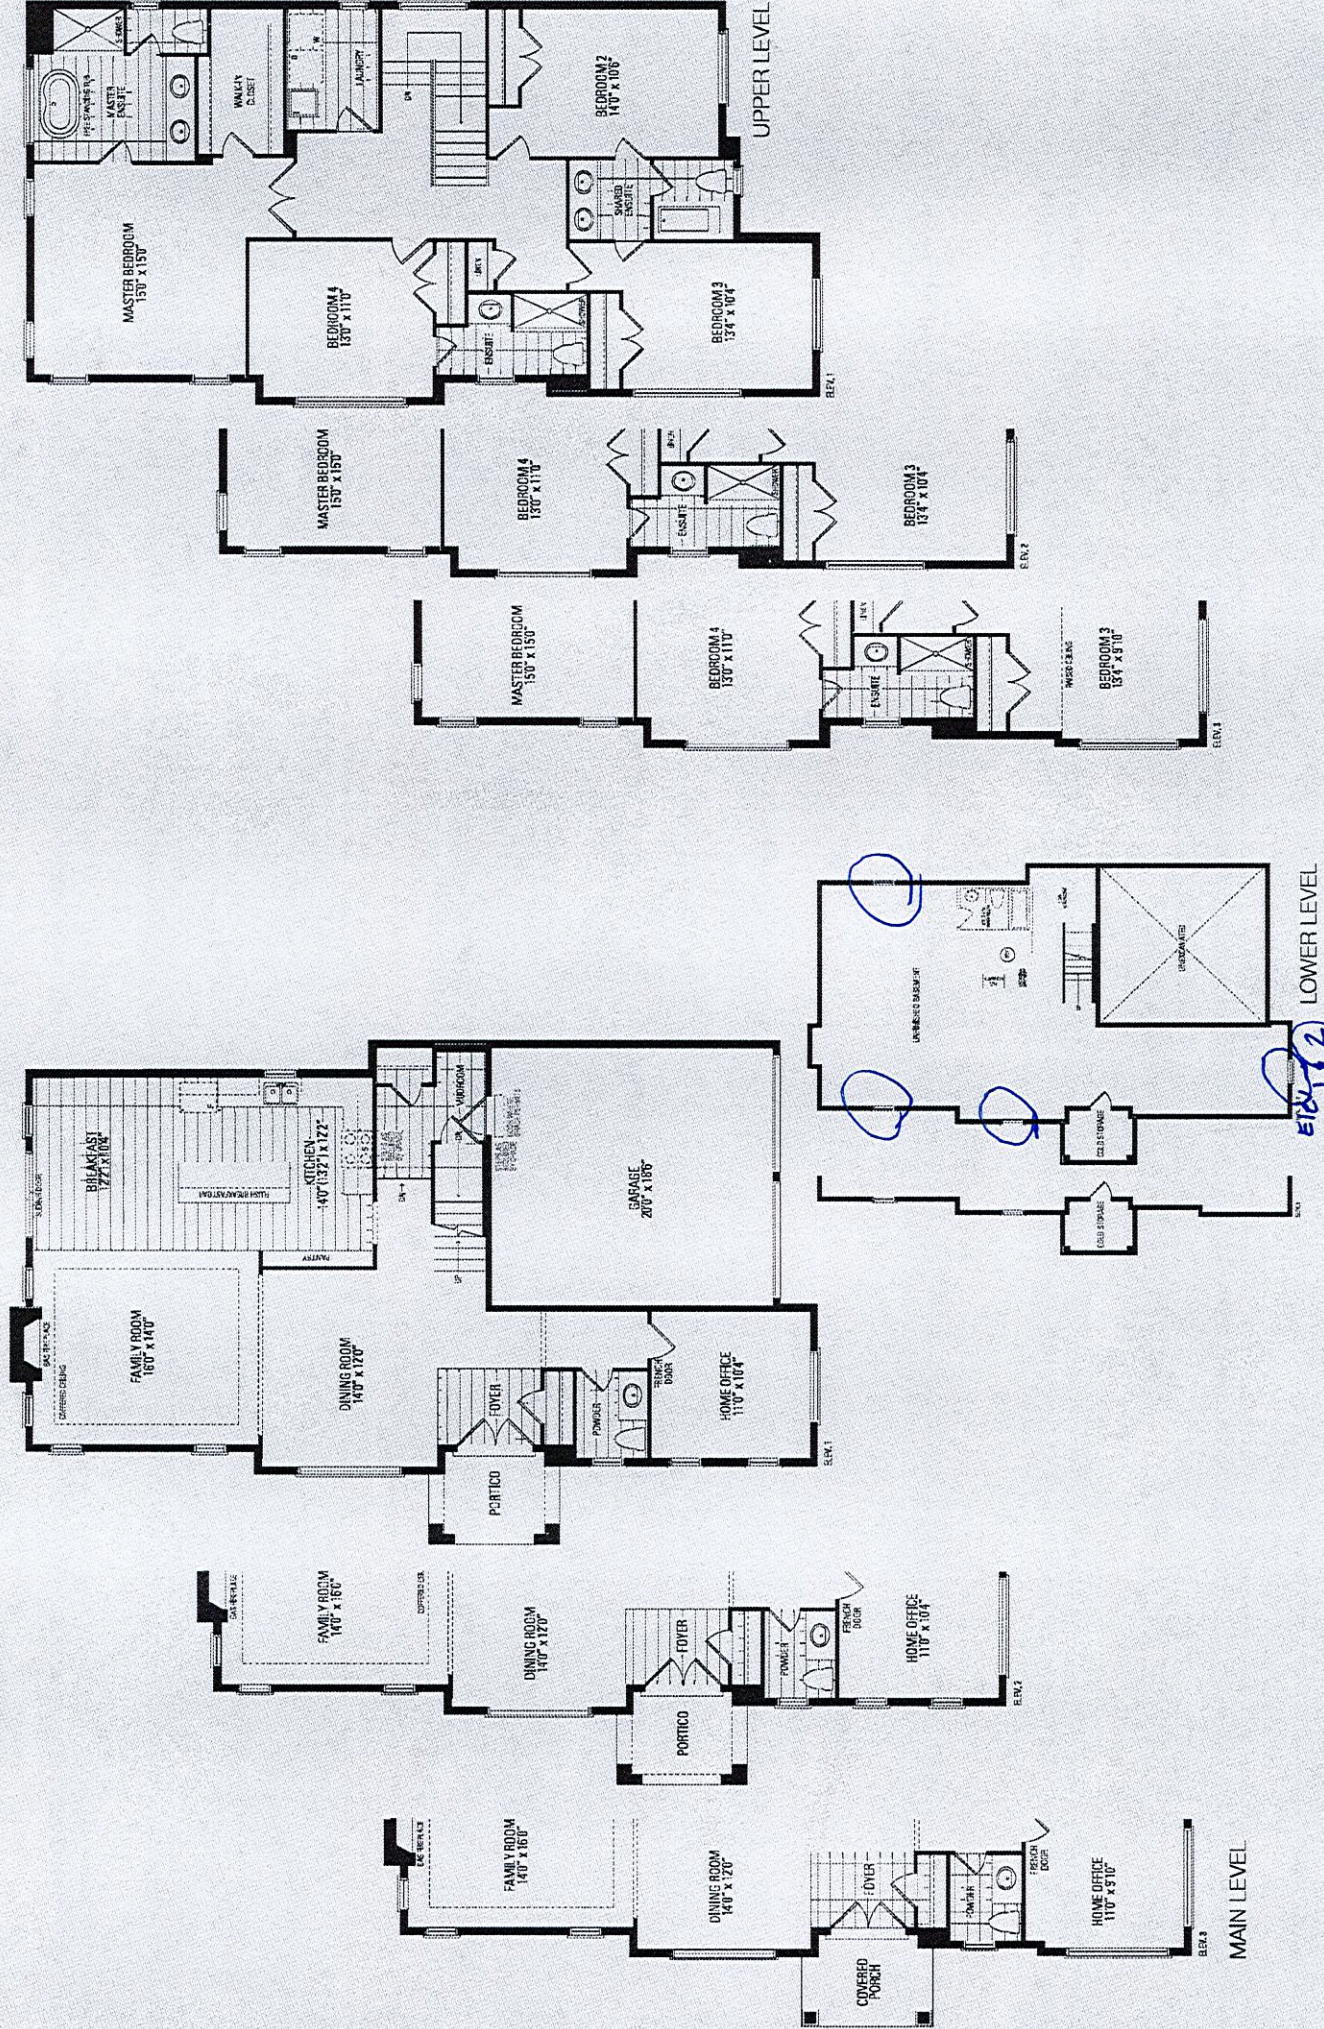

Orientation of home may be reversed and purchaser agrees to accept the same. Steps and porches may vary at any exterior entrance ways due to grading variance. Actual usable floor space may vary from the stated floor areas. All renderings are artist's concept. Dimensions, specifications and architectural detailing subject to modifications. Roofline and adjoining model types may vary due to siting. E. & O. E. May 2023