

RECEIVED

JUN 2 7 2023


Palmetto - Zadorra Estates Corp.

PURCHASERS: Nithin Kumar Reddy KONDRU and Thejaswi CHAVANA

TEL: RES.: 236-998-5272

LOT / PHASE	REG. PLAN #	HOUSE TYPE	
18 / 1		Villa 3 Elev 3	

## CONSTRUCTION

3 - ENLARGED BASEMENT WINDOWS (MAY REQUIRE WINDOW WELLS) - WINDOW IS 30 INCHES X 24 INCHES

20Jun23 Note:

## **PROMOTIONAL**

1 - PARTIAL REDEMTION OF PROMOTIONAL PACKAGE \$1,950.00. BALANCE FORWARD \$13,050.00 TO BE USED AT A LATER DATE. ORIGINAL PROMOTIONAL PACKAGE OF \$15,000.00 AS PER SCHEDULE PE. 20Jun23 Note:

## **EXTRAS AS PER OFFER**


The Vendor agrees that notwithstanding any other term or provision in this Agreement included in the Purchase Price and in addition to those items detailed in Schedule GP to the Agreement of Purchase and Sale, the Purchaser is entitled to a credit of Fif Worksheet Note:

This Document is Extremely Time Sensitive - Printed 23 Jun 23 at 14:40

## Villa 3 36' LOT ELEVATION 1 2,662 sq.ft. • ELEVATION 2 2,662 sq.ft. • ELEVATION 3 2,647 sq.ft.

MASTER BEDROOM

CLUSE

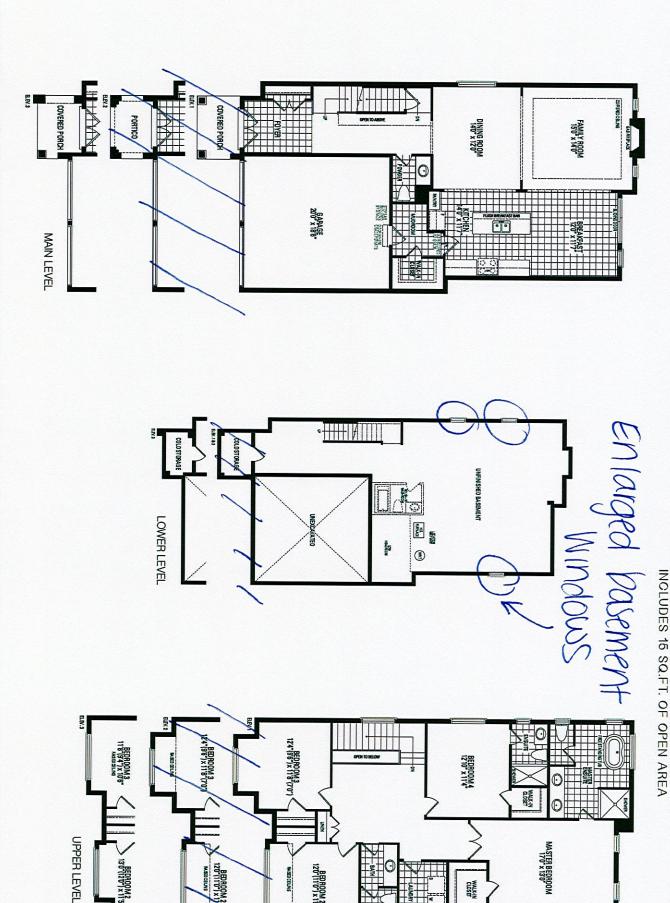

120"(11'0") × 115

Orientation of home may be reversed and purchaser agrees to accept the same. Steps and porches may vary at any exterior entrance ways due to grading variance. Actual usable floor space may vary from the stated floor areas. All renderings are artist's concept. Dimensions, specifications and architectural detailing subject to modifications. Roofline and adjoining model types may vary due to siting. E. & O. E. May 2023