Greenpark

PRELIMINARY

CONSTRUCTION SUMMARY

RECEIVED

Palmetto - Zadorra Estates Corp.

PURCHASERS: Saritha Reddy TOOM and Ravinder Reddy TOOM

JUL 12 2023

TEL: RES.: 647-449-3224

LOT / PHASE	REG. PLAN #	HOUSE TYPE		
93 / 1		Penrose 2 Elev 1		

CONSTRUCTION

3 - ENLARGED BASEMENT WINDOWS (MAY REQUIRE WINDOW WELLS) - WINDOW IS 30 INCHES X 24 INCHES

11Jul23 Note:

PROMOTIONAL

1 - PARTIAL REDEMTION OF PROMOTIONAL PACKAGE $1,950.00 BALANCE FORWARD $13,050.00 TO BE USED AT A LATER DATE. ORIGINAL PROMOTIONAL PACKAGE OF $ 15,000.00 AS PER SCHEDULE PE.

11Jul23 Note:

This Document is Extremely Time Sensitive - Printed 11 Jul 23 at 14:50

Lot 93 Zadorra

Penrose 2 40' LOT

ELEVATION 1 **3,045** sq.ft. • ELEVATION 2 **3,045** sq.ft. • ELEVATION 3 **3,042** sq.ft.

enlarged Basement Windows

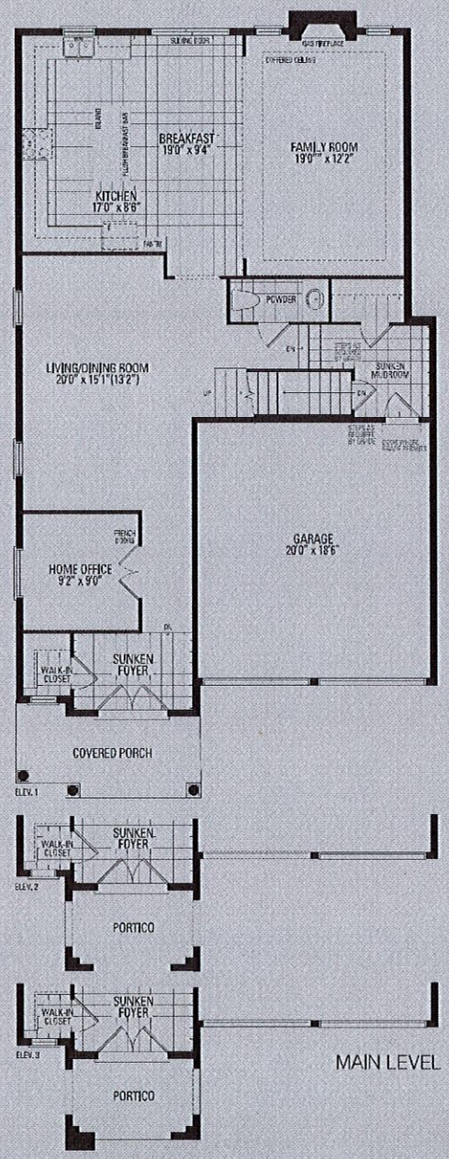

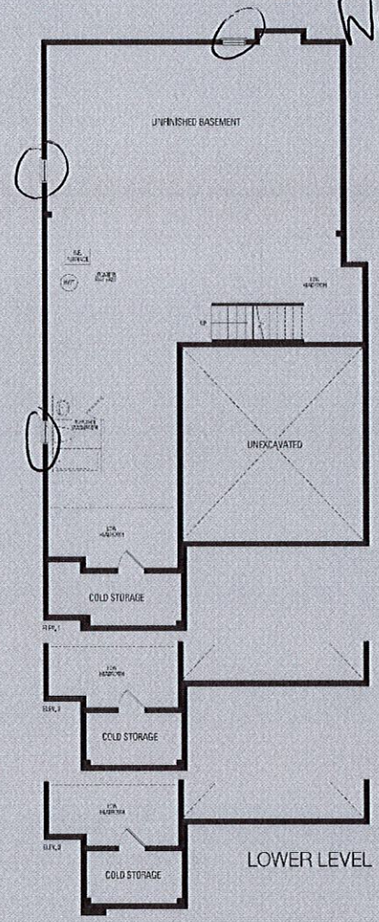

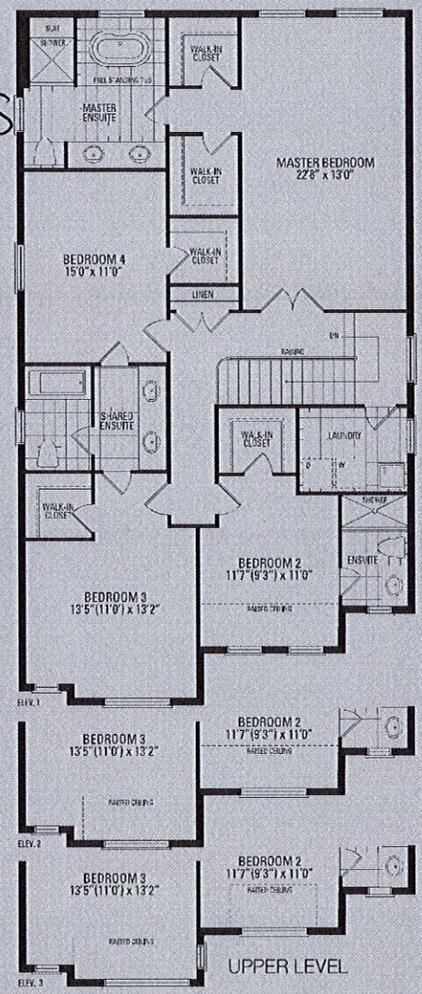

Orientation of home may be reversed and purchaser agrees to accept the same. Steps and porches may vary at any exterior entrance ways due to grading variance. Actual usable floor space may vary from the stated floor areas. All renderings are artist's concept. Dimensions, specifications and architectural detailing subject to modifications. Roofline and adjoining model types may vary due to siting. E. & O. E. May 2023