

CONSTRUCTION SUMMARY

Palmetto - Zadorra Estates Corp. **RECEIVED**

PURCHASER: Vithusayni PARAMANATHAN **JUL 17 2023** TEL: RES.: 647-677-8367

LOT / PHASE 44 / 1	REG. PLAN #	HOUSE TYPE Rose 6 Elev 2 (4 Bedroom)		
-----------------------	-------------	---	--	--

CONSTRUCTION

1 - FIRST FLOOR INCREASE CEILING HEIGHT FROM 9 FEET TO 10 FEET 14Jul23 Note:	
2 - ENLARGED BASEMENT WINDOWS (MAY REQUIRE WINDOW WELLS) - WINDOW IS 30 INCHES X 24 INCHES 14Jul23 Note:	
1 - LOWER LEVEL - BASEMENT 8 FOOT 6 INCH CONCRETE POUR - MEASURED FROM TOP OF FOOTING TO TOP OF FOUNDATION WALL 14Jul23 Note:	


PROMOTIONAL

1 - LESS CREDIT FROM PURCHASER EXTRA SHEET IN OFFER 14Jul23 Note:	
--	--

This Document is Extremely Time Sensitive - Printed 17 Jul 23 at 11:35

Rose 6 40' LOT

ELEVATION 1 3,215 sq.ft. • ELEVATION 2 3,197 sq.ft. • ELEVATION 3 3,197 sq.ft.
INCLUDES 11 SQ.F.T. OF OPEN AREA.

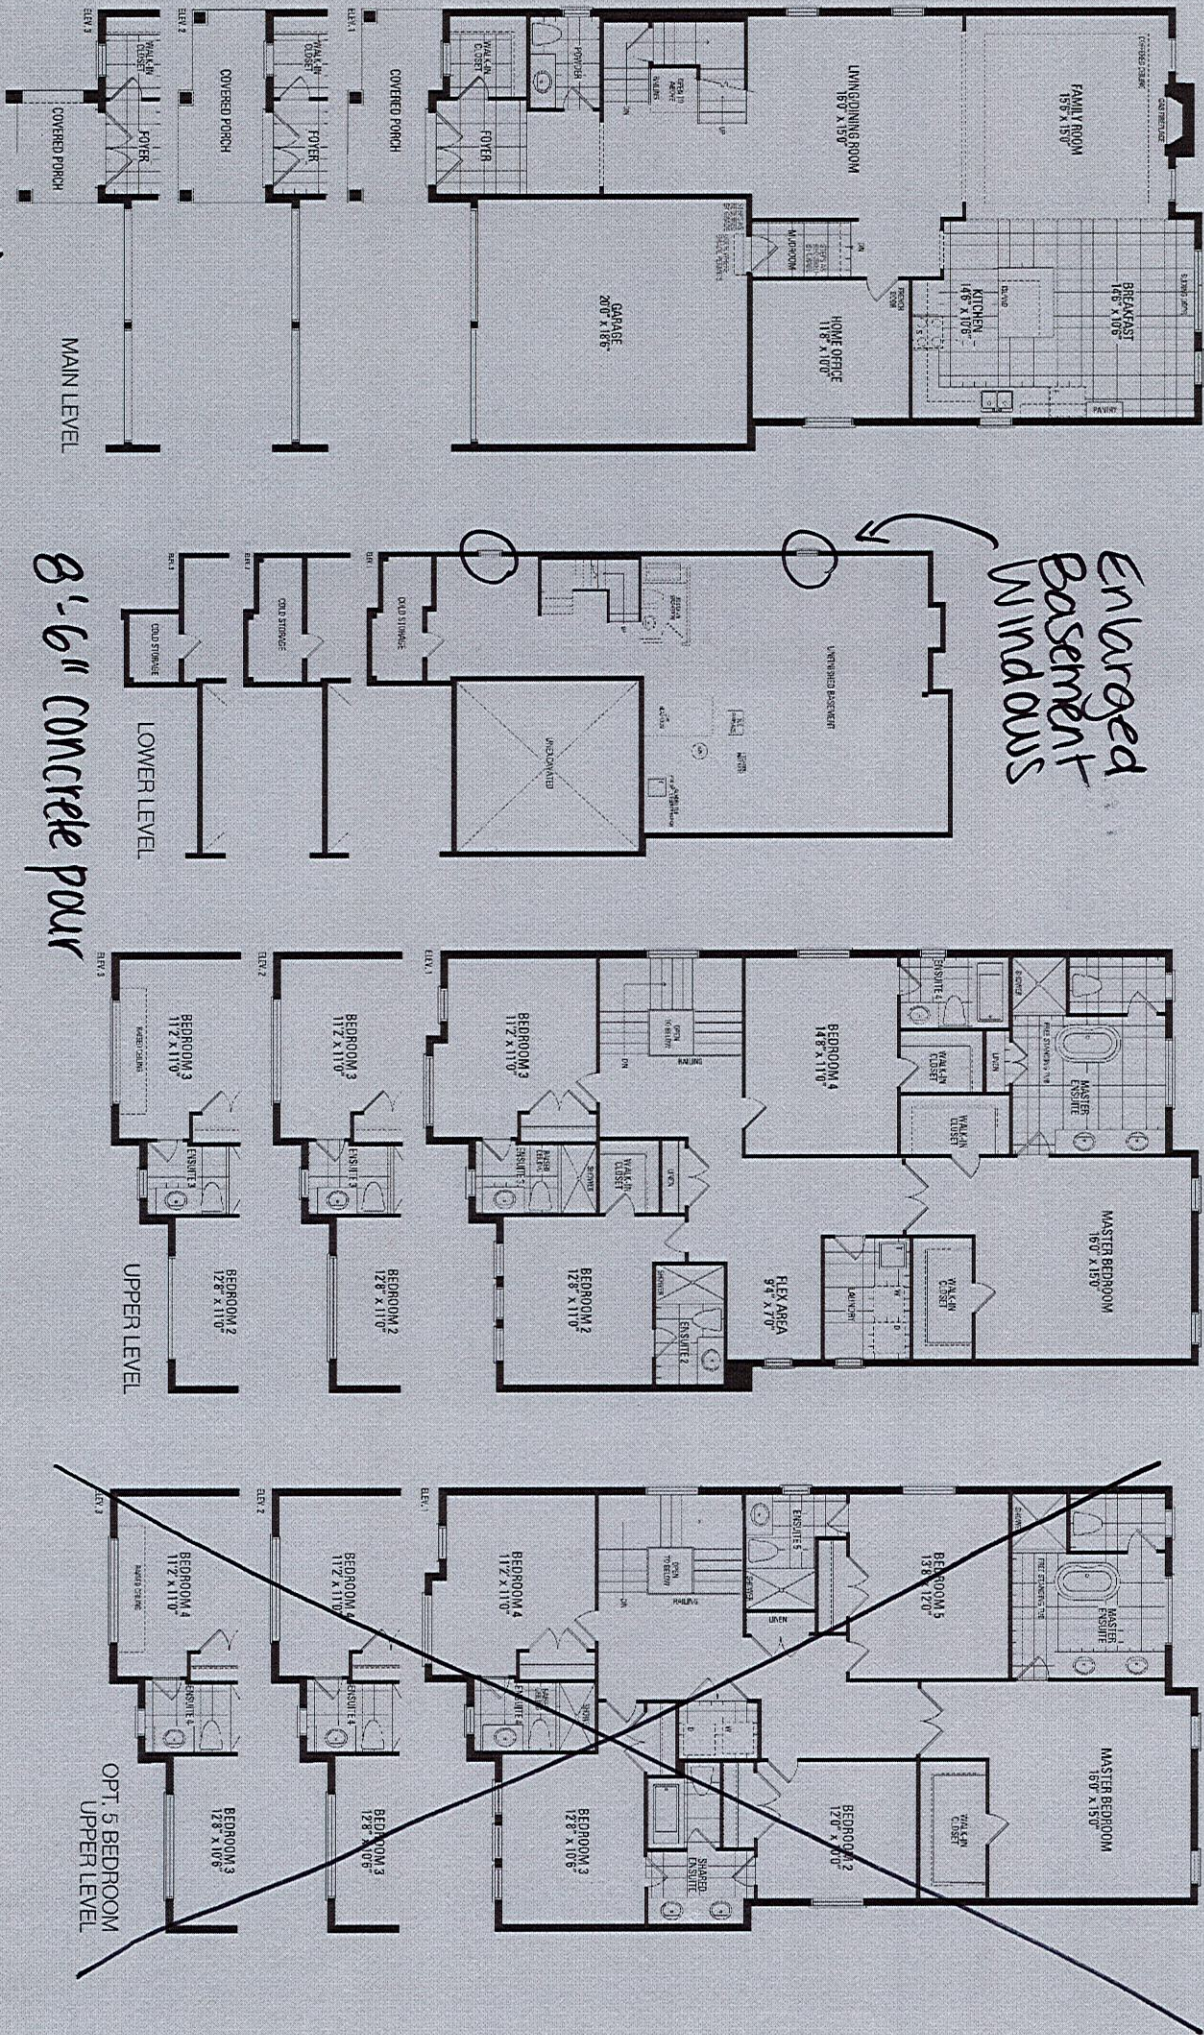

Orientation of home may be reversed and purchaser agrees to accept the same. Steps and porches may vary at any exterior entrance ways due to grading variance. Actual usable floor space may vary from the stated floor areas. All renderings are artist's concept. Dimensions, specifications and architectural detailing subject to modifications. Rodline and adjoining model types may vary due to siting. E. & O. E. May 2023