Greenpark.

PRELIMINARY

CONSTRUCTION SUMMARY RECEIVED

Palmetto - Zadorra Estates Corp. OCT 0 2 2023 TEL: RES.: 647-274-4542 PURCHASERS: Kam KAVEH and Cristina Assunta KAVEH LOT / PHASE REG. PLAN # HOUSE TYPE Penrose 2 Elev 2 42 / 1 **CABINETRY** 1 - CABINETRY PROVISION - PROVISION FOR PLUG ON ISLAND (PLUG EXTRA ORDERED SEPARATELY) 28Sep23 Note: ELECTRICAL 1 - PLUG - ELECTRICAL PLUG - ADD TO ISLAND 28Sep23 Note: 1 - PLUG - ELECTRICAL PLUG - TO BE INSTALLED OVER FIREPLACE 28Sep23 Note: 1 - LIGHT AND SWITCH - NO FIXTURE INCLUDED - LIVING ROOM 28Sep23 Note: 1 - ABOVE KITCHEN ISLAND - ADD LIGHT AND SWITCH - NO FIXTURE INCLUDED 28Sep23. Note: **PLUMBING** 1 - WATER LINE FOR FRIDGE - ROUGH-IN ONLY 28Sep23 Note: **PROMOTIONAL** 1 - PARTIAL REDEMTION OF PROMOTIONAL PACKAGE \$ 1,615.00. BALANCE FORWARD \$13,385.00 TO BE USED AT A LATER

1 - PARTIAL REDEMTION OF PROMOTIONAL PACKAGE \$ 1,615.00. BALANCE FORWARD \$13,385.00 TO BE USED AT A LATER DATE. ORIGINAL PROMOTIONAL PACKAGE OF \$15,000.00 AS PER SCHEDULE PE. 28Sep23 Note:

EXTRAS AS PER OFFER


The Vendor agrees that notwithstanding any other term or provision in this Agreement included in the Purchase Price and in addition to those items detailed in Schedule GP to the Agreement of Purchase and Sale, the Purchaser is entitled to a credit of Fif Worksheet Note:

This Document is Extremely Time Sensitive - Printed 2 Oct 23 at 10:33

7.7 # 4.7

Penrose 2 40' LOT

ELEVATION 1 3,045 sq.ft. • ELEVATION 2 3,045 sq.ft. • ELEVATION 3 3,042 sq.ft.

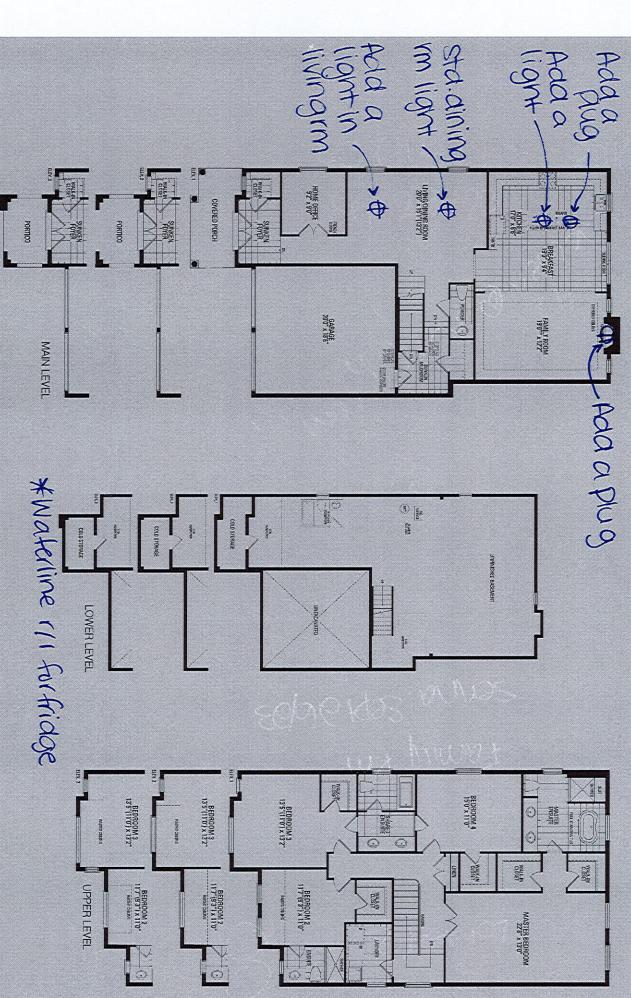

Orientation of home may be reversed and purchaser agrees to accept the same. Steps and porches may vary at any exterior entrance ways due to grading variance. Actual usable floor space may vary from the stated floor areas. All renderings are artist's concept. Dimensions, specifications and architectural detailing subject to modifications. Roofline and adjoining model types may vary due to siting. E. & O. E. May 2023