

CONSTRUCTION SUMMARY

RECEIVED

Palmetto - Zadorra Estates Corp.

OCT 20 2023

PURCHASERS: Madhu PAGILLA and Vanateja VADRANAPU

TEL: RES.: 437-227-2769

LOT / PHASE 157 / 1	REG. PLAN #	HOUSE TYPE Villa 2 Elev 2		
------------------------	-------------	------------------------------	--	--

ELECTRICAL

1 - PLUG - ELECTRICAL PLUG - TO BE INSTALLED OVER FIREPLACE 17Oct23 Note:	
1 - ABOVE KITCHEN ISLAND - ADD LIGHT AND SWITCH - NO FIXTURE INCLUDED 17Oct23 Note:	

PLUMBING

1 - WATER LINE FOR FRIDGE - ROUGH-IN ONLY 17Oct23 Note:	
--	--

PROMOTIONAL

1 - PARTIAL REDEMPTION OF PROMOTIONAL PACKAGE \$905.00 BALANCE FORWARD \$14,095.00 TO BE USED AT A LATER DATE. ORIGINAL PROMOTIONAL PACKAGE OF \$15,000.00 AS PER SCHEDULE PE. 17Oct23 Note:	
---	--


EXTRAS AS PER OFFER

The Vendor agrees that notwithstanding any other term or provision in this Agreement included in the Purchase Price and in addition to those items detailed in Schedule GP to the Agreement of Purchase and Sale, the Purchaser is entitled to a credit of Fif Worksheet Note:	
---	--

This Document is Extremely Time Sensitive - Printed 17 Oct 23 at 13:58

Villa 2 36' LOT

INCLUDES 10 SQ.FT. OF OPEN AREA

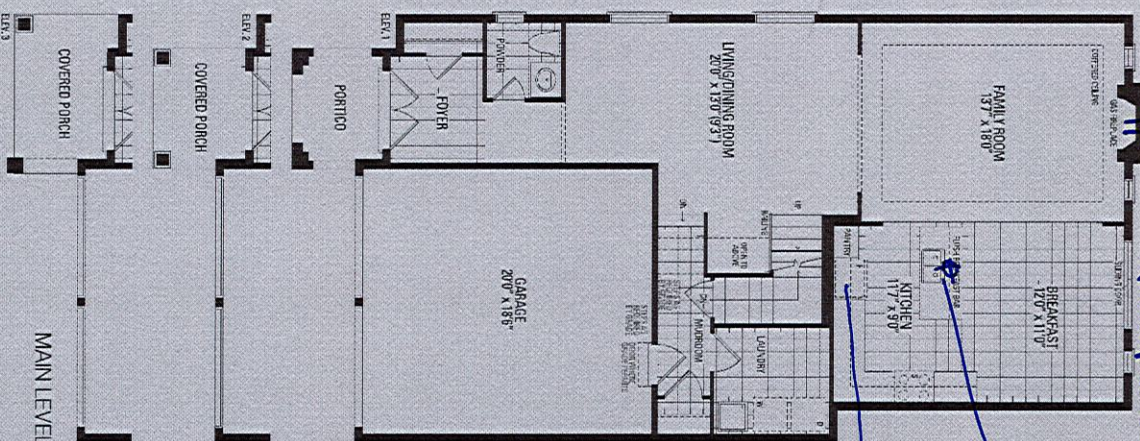

26