

CONSTRUCTION SUMMARY

RECEIVED

Legacy Hill - Trinigroup Development Inc.

OCT 24 2023

PURCHASER: Hui Fang DAI

TEL: RES.: 514-513-8666

LOT / PHASE 93 / 1	REG. PLAN #	HOUSE TYPE Villa 7 Elev 3		
-----------------------	-------------	------------------------------	--	--

CONSTRUCTION

1 - LOWER LEVEL - BASEMENT 8 FOOT 6 INCH CONCRETE POUR - MEASURED FROM TOP OF FOOTING TO TOP OF FOUNDATION WALL 23Oct23 Note:	
1 - FIRST FLOOR INCREASE CEILING HEIGHT FROM 9 FEET TO 10 FEET 23Oct23 Note:	
1 - ENLARGED BASEMENT WINDOWS (MAY REQUIRE WINDOW WELLS) - WINDOW IS 30 INCHES X 24 INCHES 23Oct23 Note:	

PROMOTIONAL

1 - LESS CREDIT FROM PURCHASER EXTRA SHEET IN OFFER 23Oct23 Note:	
--	--

EXTRAS AS PER OFFER

The Vendor agrees that notwithstanding any other term or provision in this Agreement included in the Purchase Price and in addition to those items detailed in Schedule GP to the Agreement of Purchase and Sale, the Purchaser is entitled to a credit of Ten Worksheet Note:	
---	--


This Document is Extremely Time Sensitive - Printed 23 Oct 23 at 13:46

Elev. 1: 2,783 sq.ft. Elev. 2: 2,783 sq.ft. Elev. 3: 2,783 sq.ft.
Includes 20 sq.ft. of Open Area

Includes 20 sq ft of Open Area

1

Enlarged Basement
(windmill)

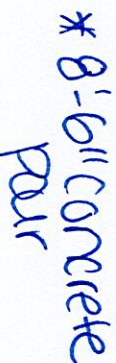

18

from the stated
september 2023