

PRELIMINARY UPGRADE

CONSTRUCTION SUMMARY

RECEIVED

Palmetto - Zadorra Estates Corp.

OCT 31 2023

TEL: RES.: 647-780-0446

PURCHASERS: Syed Mudassar H. QUADRI and PADIJARE VEETHIL BINDU

LOT / PHASE 160 / 1	REG. PLAN #	HOUSE TYPE Villa 2 Elev 1		
------------------------	-------------	------------------------------	--	--

ELECTRICAL

1 - PLUG - ELECTRICAL PLUG - TO BE INSTALLED OVER FIREPLACE 19Oct23 Note:	
1 - ABOVE KITCHEN ISLAND - ADD LIGHT AND SWITCH - NO FIXTURE INCLUDED 19Oct23 Note:	

PLUMBING

1 - WATER LINE FOR FRIDGE - ROUGH-IN ONLY 19Oct23 Note:	
--	--

PROMOTIONAL

1 - PARTIAL REDEMPTION OF PROMOTIONAL PACKAGE \$905.00 BALANCE FORWARD \$14,095.00 TO BE USED AT A LATER DATE. ORIGINAL PROMOTIONAL PACKAGE OF \$15,000.00 AS PER SCHEDULE PE. 19Oct23 Note:	
---	--

EXTRAS AS PER OFFER


The Vendor agrees that notwithstanding any other term or provision in this Agreement included in the Purchase Price and in addition to those items detailed in Schedule GP to the Agreement of Purchase and Sale, the Purchaser is entitled to a credit of Fif Worksheet Note:	
---	--

This Document is Extremely Time Sensitive - Printed 19 Oct 23 at 9:38

Lot 160 Zadora

Villa 2 36' LOT

ELEVATION 1 2,527 sq.ft. • ELEVATION 2 2,527 sq.ft. • ELEVATION 3 2,523 sq.ft.
INCLUDES 10 SQ.FT. OF OPEN AREA

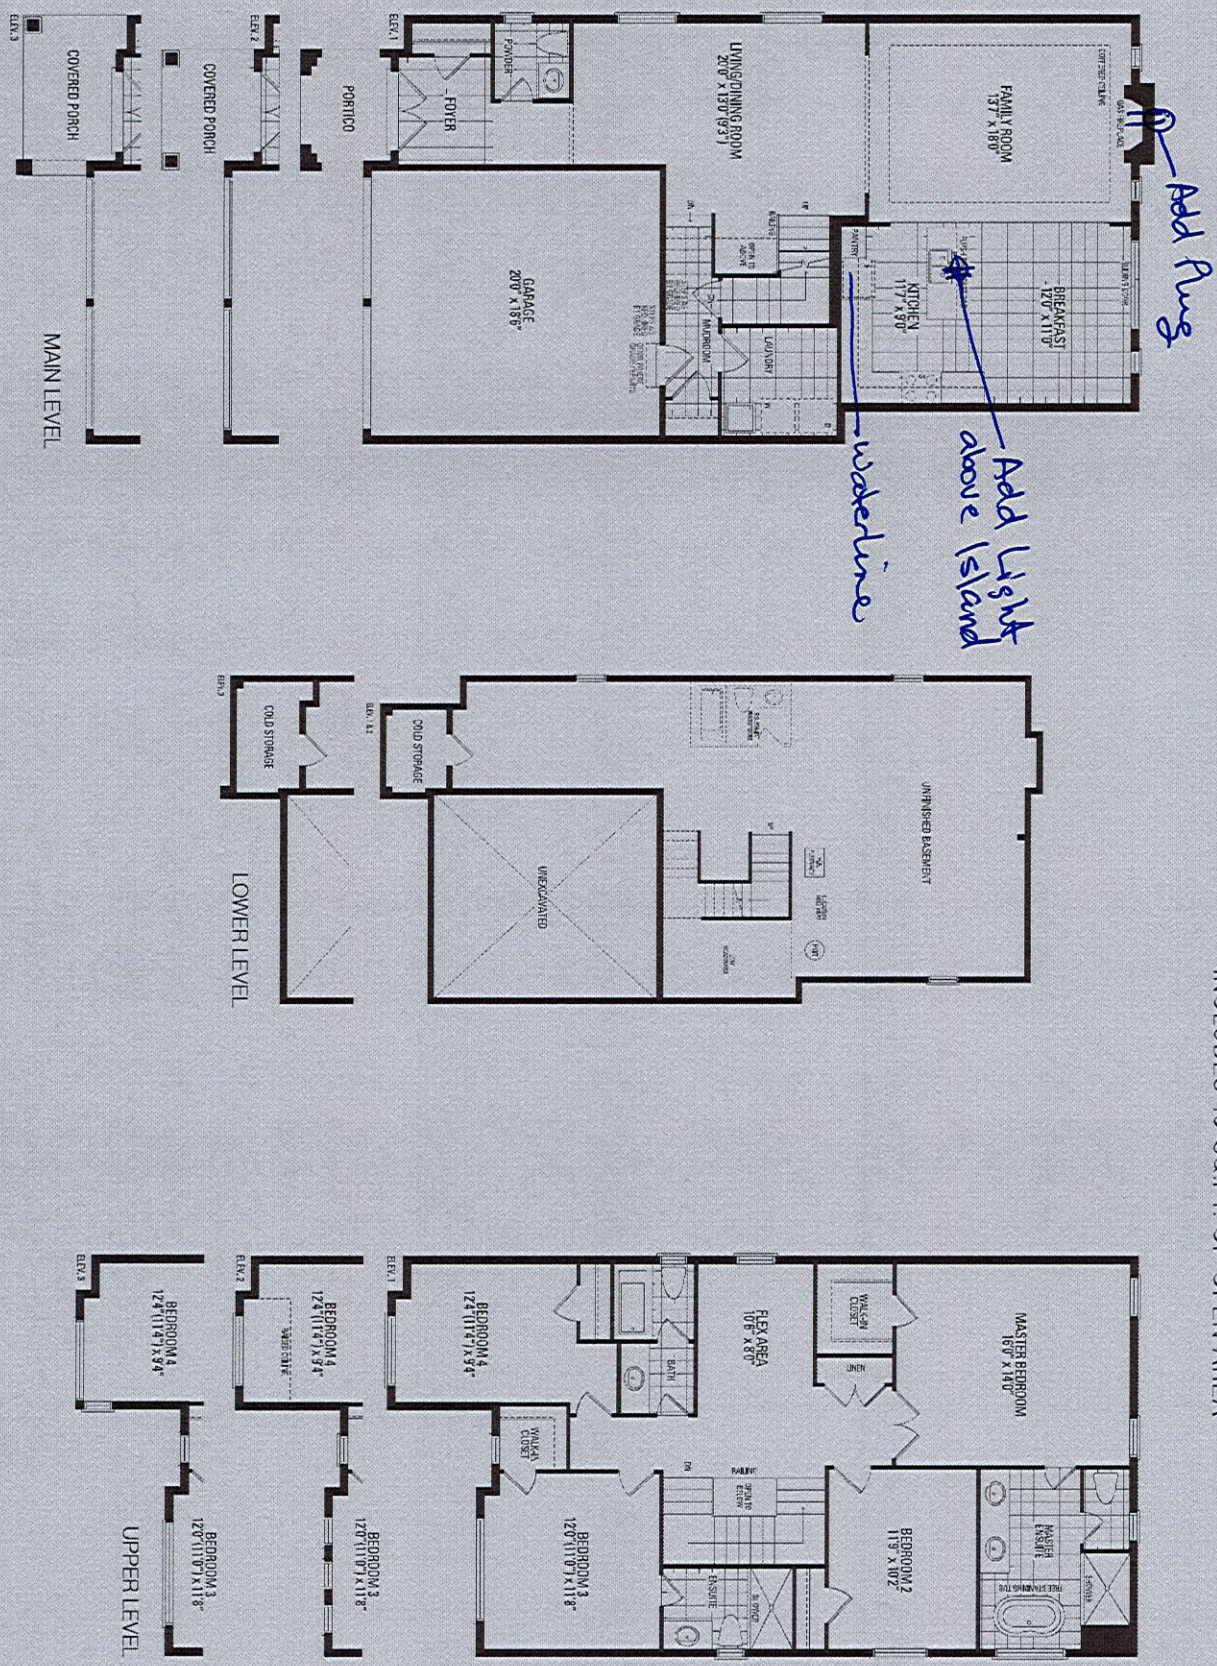

Orientation of home may be reversed and purchaser agrees to accept the same. Steps and porches may vary at any exterior entrance ways due to grading variance. Actual usable floor space may vary from the stated floor areas. All renderings are artist's concept. Dimensions, specifications and architectural detailing subject to modifications. Roofline and adjoining model types may vary due to siting. E. & O. E. May 2023