


STRUCTURAL PRELIMINARY


CONSTRUCTION SUMMARY Legacy Hill - Trinigroup Development Inc. PURCHASER: Mohsen GOUDARZIZADEH			NOV 0 1 2023	TEL:
LOT / PHASE 92 / 1	REG. PLAN#	HOUSE TYPE Villa 5 Elev 3		
1 - FIRST FLOOR INCREAS 27Oct23 Note:	SE CEILING HEIGHT F	ROM 9 FEET TO 10 FEET		
PROMOTIONAL  1 - LESS CREDIT FROM PU  27 Oct 23 Note:	JRCHASER EXTRA SH	EET IN OFFER		


EXTRAS AS PER OFFER

The Vendor agrees that notwithstanding any other term or provision in this Agreement included in the Purchase Price and in addition to those items detailed in Schedule GP to the Agreement of Purchase and Sale, the Purchaser is entitled to a credit of Ten *Worksheet* Note:

This Document is Extremely Time Sensitive - Printed 1 Nov 23 at 9:25

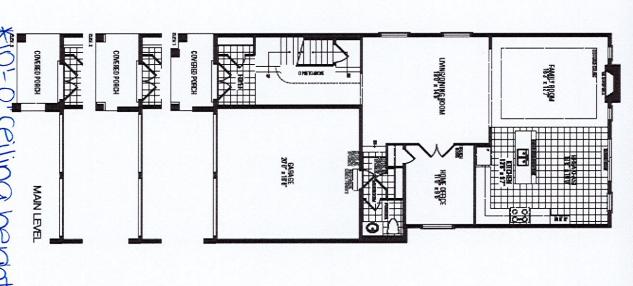

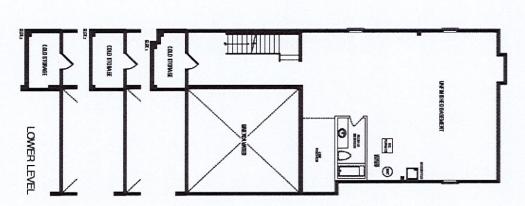

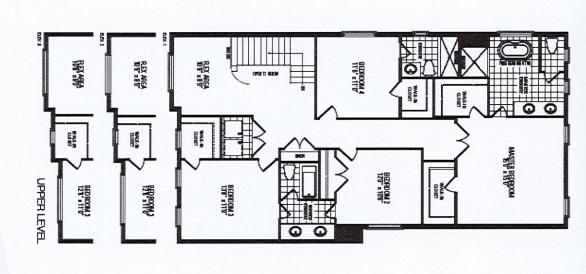

Orientation of home may be reversed and purchasel agrees to accept the same. Steps and porches may vary at any exterior entrance ways due to grading variance. Actual usable floor space may vary from the stated floor areas. All renderings are artist's concept. Dimensions, specifications and architectural detailing subject to modifications. Roofline and adjoining model types may vary due to siting. E. & O. E. September 2023