Gre	eenpa	rk.		Pri	elir	M M AV	U
		C	ONSTRUCTION SUMN			2600	OC.
PURCHA	SER: Surya AHLU	JWALIA	Palmetto - Zadorra Estates C	orp.	ED	TEL: RE	S.: 647-708-8548
LC	OT / PHASE 165 / 1	REG. PLAN #	HOUSE TYPE Villa 2 Elev 1	NOV 13	2023		
CONSTR	UCTION						
3 - ENLAF 12Jun23		T WINDOWS (MAY RI	EQUIRE WINDOW WELLS) - WINDO	OW IS 30 INC	HES X 2	24 INCHES	
ELECTR	ICAL						
1 - PLUG	- ELECTRICAL PI	LUG - TO BE INSTALI	LED OVER FIREPLACE				
08Nov23	Note:						
1 - RELOC	CATE STANDARD	KITCHEN LIGHT TO	BE CENTERED OVER ISLAND				
08Nov23							
1 - STANI	DARD DINING RC	OOM LIGHT TO BE CE	ENTERED BETWEEN LIVING AND D	INING ROO	M		
08Nov23							
1 - ELECT	RIC VEHICLE RO	OUGH-IN PROVISION	ONLY FOR FUTURE ELECTRIC CAL	R (CONDUIT	FROM	BASEMENT INTO	

PLUMBING

08Nov23 Note:

2 - TOE TESTER - ADD TOE TESTER TO SHOWER

JUNCTION BOX IN GARAGE WITH PULL STRING, NO WIRE)

PRIMARY ENSUITE & MAIN

08Nov23 Note:

TOE TESTER- ADD TOE TESTER TO SHOWER- PRIMARY ENSUITE AND ENSUITE BED 3

PROMOTIONAL

1 - PARTIAL REDEMTION OF PROMOTIONAL PACKAGE \$2,950.00 BALANCE FORWARD \$12,050.00 TO BE USED AT A LATER DATE. ORIGINAL PROMOTIONAL PACKAGE OF \$15,000.00 AS PER SCHEDULE PE.

08Nov23 Note:


1 - PARTIAL REDEMTION OF PROMOTIONAL PACKAGE \$1,950.00 BALANCE FORWARD \$13,050.00 TO BE USED AT A LATER DATE. ORIGINAL PROMOTIONAL PACKAGE OF \$15,000.00 AS PER SCHEDULE PE.

12Jun23 Note:

EXTRAS AS PER OFFER

The Vendor agrees that notwithstanding any other term or provision in this Agreement included in the Purchase Price and in addition to those items detailed in Schedule GP to the Agreement of Purchase and Sale, the Purchaser is entitled to a credit of Fif Worksheet Note:

This Document is Extremely Time Sensitive - Printed 13 Nov 23 at 11:00

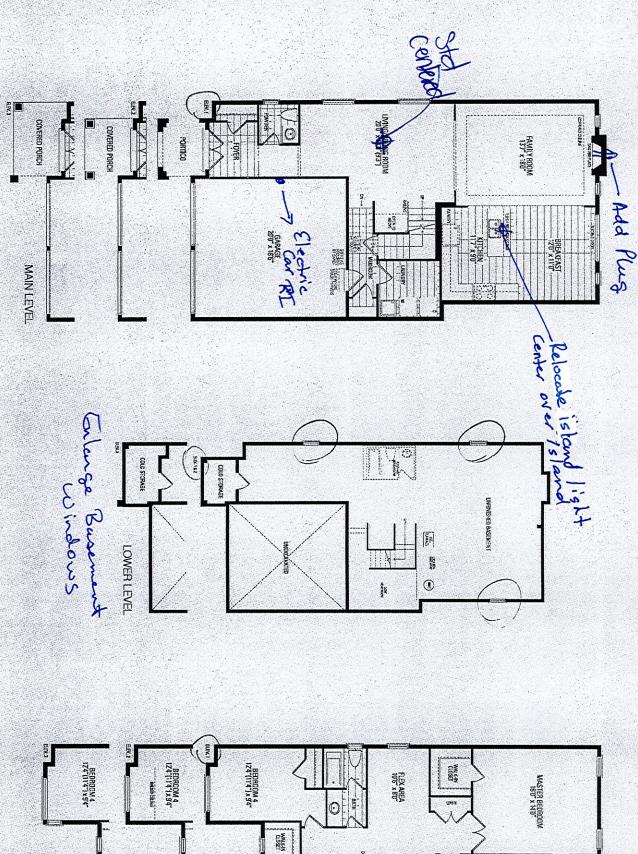

120 (110) x 118

BEDROOM 2

Orientation of home may be reversed and purchaser agrees to accept the same. Steps and porches may vary at any exterior entrance ways due to grading variance. Actual usable floor space may vary from the stated floor areas. All renderings are artist's concept. Dimensions, specifications and architectural detailing subject to modifications. Roofline and adjoining model types may vary due to siting. E. & O. E. May 2023

G

BEDROOM3

UPPER LEVEL