

CONSTRUCTION SUMMARY

Palmetto - Zadorra Estates Corp.

RECEIVED

JAN 30 2024

TEL: RES.: 647-708-8548

PURCHASER: Surya AHLUWALIA

LOT / PHASE 165 / 1	REG. PLAN #	HOUSE TYPE Villa 2 Elev 1		
------------------------	-------------	------------------------------	--	--

CABINETRY ACCESSORIES

1 - KITCHEN CABINETRY - PANTRY UNIT UPGRADE - TO GO FROM 300MM TO 600MM DEEP - PRICE IS PER FOOT - STANDARD LEVEL 29Jan24 Note:	
1 - KITCHEN CABINETRY UPPER - FULL DEPTH ABOVE FRIDGE UPPER WITH GABLES - 650MM DEEP - PRICE IS EACH 29Jan24 Note:	

CONSTRUCTION

3 - ENLARGED BASEMENT WINDOWS (MAY REQUIRE WINDOW WELLS) - WINDOW IS 30 INCHES X 24 INCHES 12Jun23 Note:	
---	--

COUNTER TOP

1 - KITCHEN COUNTER TOP - UPGRADE STONE COUNTER TOP 29Jan24 Note:	
--	--

ELECTRICAL

1 - PLUG - ELECTRICAL PLUG - TO BE INSTALLED OVER FIREPLACE 08Nov23 Note:	
1 - RELOCATE STANDARD KITCHEN LIGHT TO BE CENTERED OVER ISLAND 08Nov23 Note:	
1 - STANDARD DINING ROOM LIGHT TO BE CENTERED BETWEEN LIVING AND DINING ROOM 08Nov23 Note:	
1 - ELECTRIC VEHICLE ROUGH-IN PROVISION ONLY FOR FUTURE ELECTRIC CAR (CONDUIT FROM BASEMENT INTO JUNCTION BOX IN GARAGE WITH PULL STRING, NO WIRE) 08Nov23 Note:	

FIREPLACE AND ACCESSORIES

1 - GAS LINE ROUGH-IN FOR BARBECUE - FIRST FLOOR 29Jan24 Note:	
1 - GAS LINE ROUGH-IN FOR STOVE (INCLUDES ELECTRICAL OUTLET) - FIRST FLOOR 29Jan24 Note:	

PLUMBING

1 - SINK - UNDERMOUNT - BLANCO PRECIS SILGRANIT U SUPER SINGLE #402884 SOFT WHITE 29Jan24 Note:	
2 - TOE TESTER - ADD TOE TESTER TO SHOWER PRIMARY ENSUITE & MAIN 08Nov23 Note:	
TOE TESTER- ADD TOE TESTER TO SHOWER- PRIMARY ENSUITE AND ENSUITE BED 3	

PROMOTIONAL

1 - LESS BALANCE OF CREDIT FROM PURCHASER EXTRA SHEET IN OFFER 29Jan24 Note:	
1 - PARTIAL REDEMPTION OF PROMOTIONAL PACKAGE \$2,950.00 BALANCE FORWARD \$12,050.00 TO BE USED AT A LATER DATE. ORIGINAL PROMOTIONAL PACKAGE OF \$15,000.00 AS PER SCHEDULE PE. 08Nov23 Note:	

CONSTRUCTION SUMMARY				
Palmetto - Zadorra Estates Corp.				
PURCHASER: Surya AHLUWALIA			TEL: RES.: 647-708-8548	
LOT / PHASE	REG. PLAN #	HOUSE TYPE		
165 / 1		Villa 2 Elev 1		
1 - PARTIAL REDEMPTION OF PROMOTIONAL PACKAGE \$1,950.00 BALANCE FORWARD \$13,050.00 TO BE USED AT A LATER DATE. ORIGINAL PROMOTIONAL PACKAGE OF \$15,000.00 AS PER SCHEDULE PE. 12Jun23 Note:				

STAIRS AND RAILINGS

1 - PICKETS - EUROLINE 1 - BLACK PICKETS 29Jan24 Note:	
1 - STAINED STAIRS - STANDARD STAIRCASE 29Jan24 Note: INCLUDING STEPS TO LOWER LANDING	

EXTRAS AS PER OFFER

The Vendor agrees that notwithstanding any other term or provision in this Agreement included in the Purchase Price and in addition to those items detailed in Schedule GP to the Agreement of Purchase and Sale, the Purchaser is entitled to a credit of Fif Worksheet Note:	
---	--

This Document is Extremely Time Sensitive - Printed 29 Jan 24 at 13:26

1. Cabinetry

	Style and Colour	Hardware
Kitchen / Breakfast	MONACO 823 DRIFTWOOD	464SA
Laundry Room	ELISSE	Standard
Powder Room	MONACO 350 PLATINUM SILVER	464SA
Master Ensuite Bathroom	MONACO 350 PLATINUM SILVER	464SA
Main Bathroom	MONACO 350 PLATINUM SILVER	464SA
Ensuite Bath - Bedroom 3	MONACO 350 PLATINUM SILVER	464SA
Stove Opening	STANDARD	NOTE: If not specified, opening will be set to builder's standard opening of approximately 30" width
Fridge Opening	STANDARD	NOTE: If not specified, opening will be set to builder's standard opening of approximately 37" width x 74" height

** Refer to Construction Summary

2. Counters

	Counter	Edge	Niche
Kitchen / Breakfast	QUARTZ-MISTRAL	#360 EDGE	
Laundry Room	N/A		
Powder Room	LAMINATE-WHITE CARRARA 4924-38		
Master Ensuite Bathroom	LAMINATE-CARRARA BIANCO 6696-46		
Main Bathroom	LAMINATE-WHITE CARRARA 4924-38		
Ensuite Bath - Bedroom 3	LAMINATE-WHITE CARRARA 4924-38		
Kitchen Backsplash	N/A		

** Refer to Construction Summary

Purchaser: Surya AHLUWALIA

Telephone Res. / Bus: (647) 708-8548 /

Decor Advisor: Ida Viola

Lock Date: 29-Jan-24

Property: 165

Project: Zadorra Estates Corp.

Model and Elevation: Villa 2 Elev 1

29-Jan-24

Plan #:

7. Other Flooring

Main Hall	LAMINATAE-LEXINGTON ROCHEFORT OAK TL LW1317 PEFC
Living Room	LAMINATAE-LEXINGTON ROCHEFORT OAK TL LW1317 PEFC
Dining Room	LAMINATAE-LEXINGTON ROCHEFORT OAK TL LW1317 PEFC
Family Room	LAMINATAE-LEXINGTON ROCHEFORT OAK TL LW1317 PEFC
Den / Library / Study	N/A
Basement Landing(If Applies)	N/A
Lower Landing (If Applies)	N/A
Upper Landing	LAMINATAE-LEXINGTON ROCHEFORT OAK TL LW1317 PEFC
Upper Hall	LAMINATAE-LEXINGTON ROCHEFORT OAK TL LW1317 PEFC
Master Bedroom	LAMINATAE-LEXINGTON ROCHEFORT OAK TL LW1317 PEFC
Bedroom #2	LAMINATAE-LEXINGTON ROCHEFORT OAK TL LW1317 PEFC
Bedroom #3	LAMINATAE-LEXINGTON ROCHEFORT OAK TL LW1317 PEFC
Bedroom #4	LAMINATAE-LEXINGTON ROCHEFORT OAK TL LW1317 PEFC
Bedroom #5	N/A
Flex	LAMINATAE-LEXINGTON ROCHEFORT OAK TL LW1317 PEFC

Underpad

Standard☐

Upgrade

** Refer to Construction Summary

8. Railings and Pickets

Railing Type	AS PER CONSTRUCTION SPECIFICATIONS	Colour	TORLYS ROCHEFORT OAK TL LW1317
Picket Type	AS PER CONSTRUCTION SPECIFICATIONS	Colour	TORLYS ROCHEFORT OAK TL LW1317
Stringer / Riser	AS PER CONSTRUCTION SPECIFICATIONS	Colour	TORLYS ROCHEFORT OAK TL LW1317
Treads	AS PER CONSTRUCTION SPECIFICATIONS	Colour	TORLYS ROCHEFORT OAK TL LW1317

Red Oak Stairs as Per Vendor's Standard

** Refer to Construction Summary THE STAIN COLOURS OR FINISH AVAILABLE ON RISERS, TREADS, PICKETS AND RAILS (STAIRCASES), WILL NOT BE AN EXACT MATCH TO PREFINISHED HARDWOOD OR LAMINATE FLOORS.

9. Wall Paint Flat Finish

Main & Upper Hall	22 WARM GREY	Master Bedroom	22 WARM GREY
Living Room	22 WARM GREY	Bedroom #2	22 WARM GREY
Dining Room	22 WARM GREY	Bedroom #3	22 WARM GREY
Kitchen / Breakfast	22 WARM GREY	Bedroom #4	22 WARM GREY
Family Room	22 WARM GREY	Bedroom #5	N/A
Powder Room	22 WARM GREY	Master Ensuite	22 WARM GREY
Laundry Room	22 WARM GREY	Main Bathroom	22 WARM GREY
Den/Library	N/A	Ensuite Bath - Bedroom 3	22 WARM GREY
Trim & Door Paint-Semi Gloss	BIRCH WHITE	Mud Room	22 WARM GREY
		Flex	22 WARM GREY

** Refer to Construction Summary

Purchaser:

Surya AHLUWALIA

Telephone Res. / Bus:

(647) 708-8548 /

Decor Advisor:

Ida Viola

Lock Date:

29-Jan-24

Property: 165

Project: Zadorra Estates Corp.

Model and Elevation: Villa 2 Elev 1

Plan #:

7. Other Flooring

Main Hall	LAMINATAE-LEXINGTON ROCHEFORT OAK TL LW1317 PEFC
Living Room	LAMINATAE-LEXINGTON ROCHEFORT OAK TL LW1317 PEFC
Dining Room	LAMINATAE-LEXINGTON ROCHEFORT OAK TL LW1317 PEFC
Family Room	LAMINATAE-LEXINGTON ROCHEFORT OAK TL LW1317 PEFC
Den / Library / Study	N/A
Basement Landing(If Applies)	N/A
Lower Landing (If Applies)	N/A
Upper Landing	LAMINATAE-LEXINGTON ROCHEFORT OAK TL LW1317 PEFC
Upper Hall	LAMINATAE-LEXINGTON ROCHEFORT OAK TL LW1317 PEFC
Master Bedroom	LAMINATAE-LEXINGTON ROCHEFORT OAK TL LW1317 PEFC
Bedroom #2	LAMINATAE-LEXINGTON ROCHEFORT OAK TL LW1317 PEFC
Bedroom #3	LAMINATAE-LEXINGTON ROCHEFORT OAK TL LW1317 PEFC
Bedroom #4	LAMINATAE-LEXINGTON ROCHEFORT OAK TL LW1317 PEFC
Bedroom #5	N/A
Flex	LAMINATAE-LEXINGTON ROCHEFORT OAK TL LW1317 PEFC

Underpad

Standard ☐

Upgrade

** Refer to Construction Summary

8. Railings and Pickets

Railing Type	AS PER CONSTRUCTION SPECIFICATIONS	Colour	TORLYS ROCHEFORT OAK TL LW1317
Picket Type	EUROLINE 1	Colour	BLACK
Stringer / Riser	AS PER CONSTRUCTION SPECIFICATIONS	Colour	TORLYS ROCHEFORT OAK TL LW1317
Treads	AS PER CONSTRUCTION SPECIFICATIONS	Colour	TORLYS ROCHEFORT OAK TL LW1317

Red Oak Stairs as Per Vendor's Standard

** Refer to Construction Summary THE STAIN COLOURS OR FINISH AVAILABLE ON RISERS, TREADS, PICKETS AND RAILS (STAIRCASES), WILL NOT BE AN EXACT MATCH TO PREFINISHED HARDWOOD OR LAMINATE FLOORS.

9. Wall Paint Flat Finish

Main & Upper Hall	22 WARM GREY	Master Bedroom	22 WARM GREY
Living Room	22 WARM GREY	Bedroom #2	22 WARM GREY
Dining Room	22 WARM GREY	Bedroom #3	22 WARM GREY
Kitchen / Breakfast	22 WARM GREY	Bedroom #4	22 WARM GREY
Family Room	22 WARM GREY	Bedroom #5	N/A
Powder Room	22 WARM GREY	Master Ensuite	22 WARM GREY
Laundry Room	22 WARM GREY	Main Bathroom	22 WARM GREY
Den/Library	N/A	Ensuite Bath - Bedroom 3	22 WARM GREY
Trim & Door Paint-Semi Gloss	BIRCH WHITE	Mud Room	22 WARM GREY
		Flex	22 WARM GREY

** Refer to Construction Summary

Purchaser: Surya AHLUWALIA

Telephone Res. / Bus: (647) 708-8548 /

Decor Advisor: Ida Viola

Lock Date: 29-Jan-24

Property: 165

Project: Zadorra Estates Corp.

Model and Elevation: Villa 2 Elev 1

29-Jan-24

Plan #:

10. Fireplace

	Living Room			Family Room			Other Room - Specify		
	Purchased	As Per Plan	N/A	Purchased	As Per Plan	N/A	Purchased	As Per Plan	N/A
	☐	☐	☐	☐	☒	☐	☐	☐	☐
Fireplace Type				As Per Construction Specifications					
Mantle Type				MANTLE M1-STANDARD					
Colour / Stain				AS PER CONSTRUCTION SPECIFICATIONS					
Surround				NERO					
Hearth				NO					

** Refer to Construction Summary

11. Air Conditioning

Air Conditioning NO

Comment


** Refer to Construction Summary

12. General Comments

** Refer to Construction Summary


Disclaimers and Notes

- 1) Colours of all materials are as close as possible to builder's selection, but not necessarily identical due to variances in manufacturing.
- 2) Any extras listed above are null and void unless accompanied by a separate invoice/amendment. Said invoice must be paid in full.
- 3) The Purchaser agrees that this colour selection is final and that no changes will be permitted, unless required by the Vendor.
- 4) The Purchaser acknowledges reading and accepting document which contains other miscellaneous disclaimers.
- 5) In the event of a conflict between the Standard Features schedule of the Agreement of Purchase and Sale and the Interior Colour Scheme, the Interior Colour Scheme shall prevail.

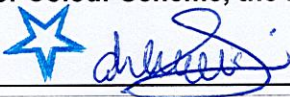
Signature: 

Date: Jan 29/24


$C_T =$

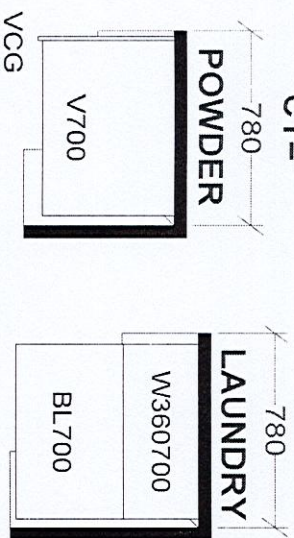

5-11

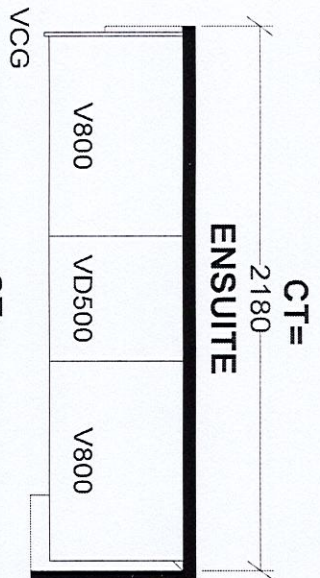


CT=

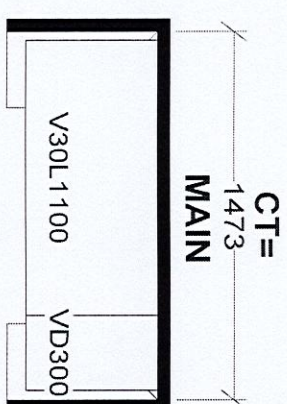


CT=



CT

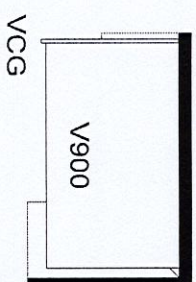

VCG

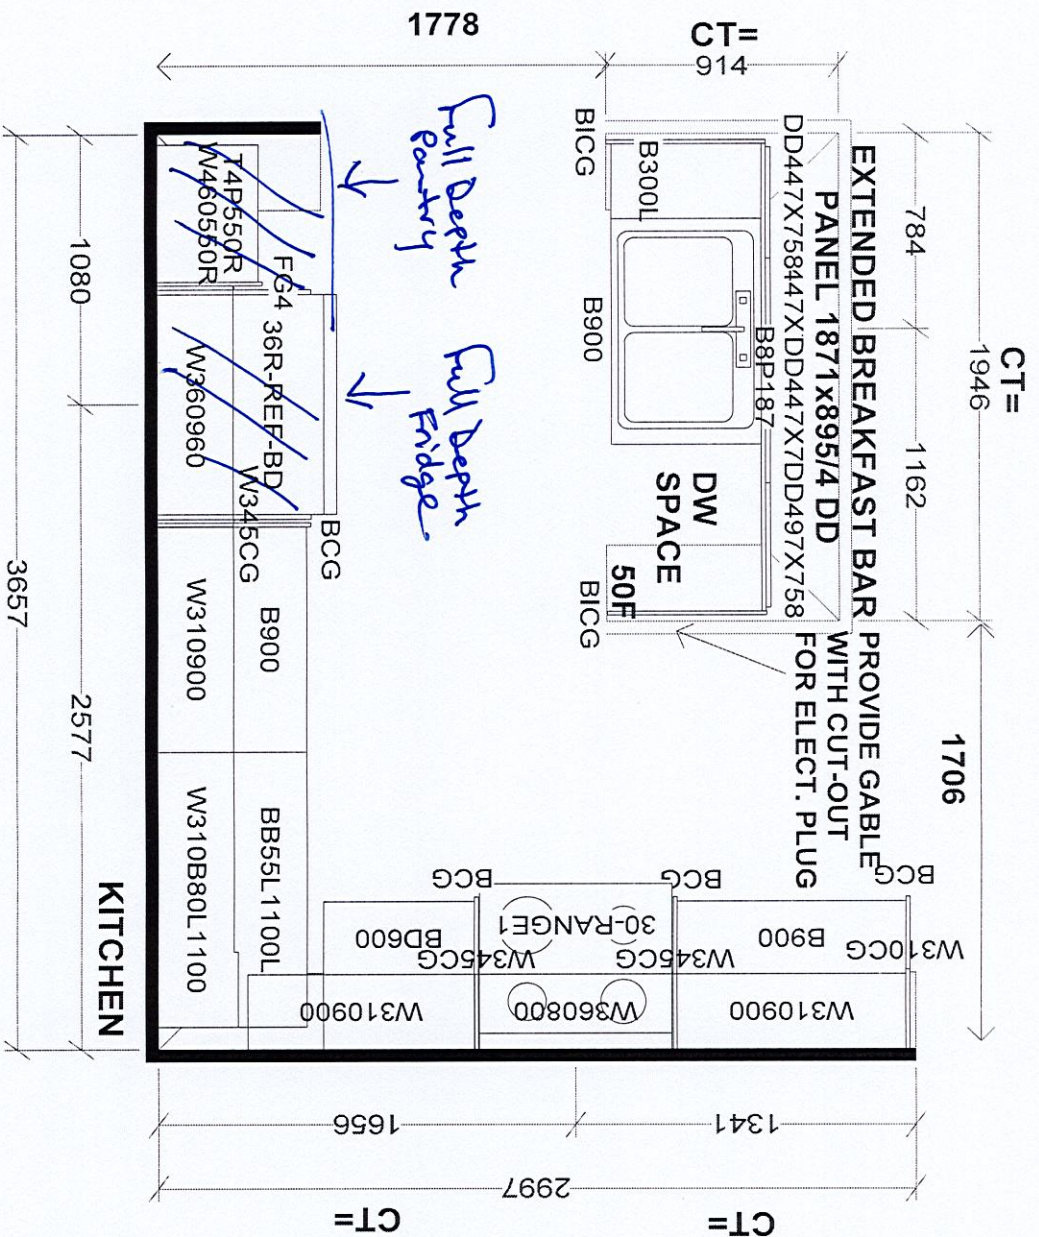

Selba Industries

⌋
#

W W DTH	W H GHT	W CNT

This drawing is the intellectual property of
SELBA INDUSTRIES INC. and is an

JOB NUMBER:

SEB BUILDER: GREENPARK HOMES

FLOOR HGT	DOOR HGT	or Ra

original design which must not be altered or copied unless applicable fee has been paid or job order placed.

710-202-1111

ST CENT _____ 2X4 _____ VENT BOX COVER _____

DESIGNER: BM
DATE: AUG 4 23

LOT#:

MODEL: VILLA 2X EL 1,2,3

Lot 165 Zadoria

Villa 2 36' LOT

ELEVATION 1 2,527 sq.ft. • ELEVATION 2 2,527 sq.ft. • ELEVATION 3 2,523 sq.ft.

INCLUDES 10 SQ.FT. OF OPEN AREA

