


CORPORATION OF THE CITY OF OSHAWA
TRUE COPY
OF PERMIT PLANS
Nov 23 2023
PER: 
CHIEF BUILDING OFFICIAL

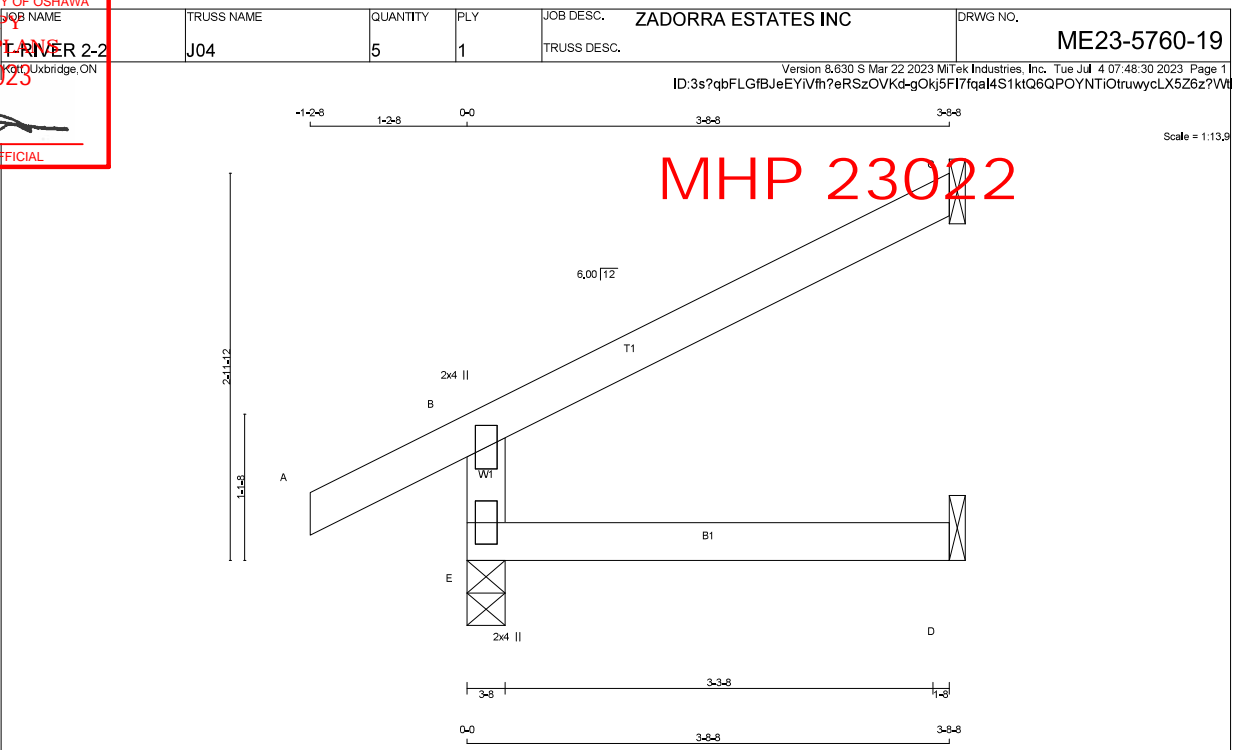

LUMBER
N. L. G. A. RULES
CHORDS SIZE LUMBER DESCR. SPF
E - B 2x4 DRY No.2 SPF
A - C 2x4 DRY No.2 SPF
E - D 2x4 DRY No.2 SPF

DRY: SEASONED LUMBER.

PLATES (table is in inches)

JT	TYPE	PLATES	W	LEN	Y	X
B	TMV+p	MT20	2.0	4.0		
E	BMV1+p	MT20	2.0	4.0		

DIMENSIONS, SUPPORTS AND LOADINGS SPECIFIED BY FABRICATOR TO BE VERIFIED BY BUILDING DESIGNER

BEARINGS

JT	FACTORED GROSS REACTION VERT	MAXIMUM FACTORED GROSS REACTION DOWN	FACTORED GROSS REACTION UP	INPUT BRG IN-SX	REQD BRG IN-SX
E	468	0	0	3-8	1-8
C	166	0	0	1-8	1-8
D	29	0	0	1-8	1-8

SEE MITEK STANDARD DETAIL MSD2015-H FOR CONNECTION TO JOINT(S) C, D

UNFACTORED REACTIONS

JT	COMBINED	SNOW	LIVE	PERM.LIVE	WIND	DEAD	SOIL
E	324	250 / 0	0 / 0	0 / 0	0 / 0	74 / 0	0 / 0
C	114	57 / 0	0 / 0	0 / 0	0 / 0	17 / 0	0 / 0
D	23	0 / 0	0 / 0	0 / 0	0 / 0	23 / 0	0 / 0

BEARING MATERIAL TO BE SPF NO.2 OR BETTER AT JOINT(S) E, C

BRACING
TOP CHORD TO BE SHEATHED OR MAX. PURLIN SPACING = 6.25 FT.
MAX. UNBRACED BOTTOM CHORD LENGTH = 10.00 FT. OR RIGID CEILING DIRECTLY APPLIED.

ALL PITCH BREAKS AND PERIMETER CORNER JOINTS MUST BE Laterally RESTRAINED.

LOADING
TOTAL LOAD CASES: (7)

CHORDS				WEBS			
MEMB.	MAX. FACTORED FORCE (LBS)	FACTORED VERT. LOAD (PLF)	MAX. UNBRACED LENGTH (FT)	MEMB.	MAX. FACTORED FORCE (LBS)	MAX. UNBRACED LENGTH (FT)	
FR-TO		FROM TO		FR-TO			
E-B	-429 / 0	0.0 0.0	0.04 (4)	7.81			
A-B	0 / 34	-119.4 -119.4	0.14 (5)	10.00			
B-C	-25 / 0	-119.4 -119.4	0.28 (6)	6.25			
E-D	0 / 0	-18.2 -18.2	0.05 (4)	10.00			

CANTILEVER ANALYSIS HAS BEEN CONSIDERED IN THIS DESIGN

PATTERN-LOADING CHECK APPLIED TO THIS TRUSS.

DESIGN CRITERIA

SPECIFIED LOADS:
TOP CH. LL = 34.8 PSF
DL = 6.0 PSF
BOT CH. LL = 0.0 PSF
DL = 7.3 PSF
TOTAL LOAD = 48.1 PSF

SPACING = 24.0 IN. G/C

THIS TRUSS IS DESIGNED FOR RESIDENTIAL OR SMALL BUILDING REQUIREMENTS OF PART 9, NBCC 2015

THIS DESIGN COMPLIES WITH:
- PART 9 OF BCBC 2018, NBC-2019AE
- PART 9 OF OBC 2012 (2019 AMENDMENT)
- CSA 086-14
- TPIC 2014

DESIGN ASSUMPTIONS
- OVERHANG NOT TO BE ALTERED OR CUT OFF.

(55 % OF 48.1 P.S.F. G.S.L. PLUS 8.4 P.S.F. RAIN LOAD) EQUALS 34.8 P.S.F. SPECIFIED ROOF LIVE LOAD

ALLOWABLE DEFL.(LL)= L/360 (0.19")
CALCULATED VERT. DEFL.(LL) = L/999 (0.00")
ALLOWABLE DEFL.(TL)= L/360 (0.19")
CALCULATED VERT. DEFL.(TL) = L/999 (0.01")

CSI TC=0.28/1.00 (B-C-6) BC=0.05/1.00 (D-E-4) ,
WB=0.00/1.00 (n/a.0) , SSI=0.19/1.00 (B-C-6)

DOL LUMBER=1.00 NAIL=1.00 LS BEND=1.10
COMP=1.10 SHEAR=1.10 TENS=1.10

COMPANION LIVE LOAD FACTOR = 1.00

TRUSS PLATE MANUFACTURER IS NOT RESPONSIBLE FOR QUALITY CONTROL IN THE TRUSS MANUFACTURING PLANT.

NAIL VALUES
PLATE GRIP(DRY) SHEAR SECTION (PSI) (PLI) (PLI)
MAX MIN MAX MIN MAX MIN
MT20 650 371 1747 788 1987 1873

PLATE PLACEMENT TOL. = 0.250 inches

PLATE ROTATION TOL. = 5.0 Deg.

JSI GRIP= 0.24 (B) (INPUT = 0.90)
JSI METAL= 0.18 (B) (INPUT = 1.00)


MODULUS ENGINEERING LTD.



REVIEW FOR TRUSS COMPONENT ONLY

NOTE: ALTERING THIS DOCUMENT
VOIDS THE ENGINEER'S SEAL

CORPORATION OF THE CITY OF OSHAWA
TRUE COPY
OF PERMIT PLANS
Nov 23 2023
PER: 
CHIEF BUILDING OFFICIAL

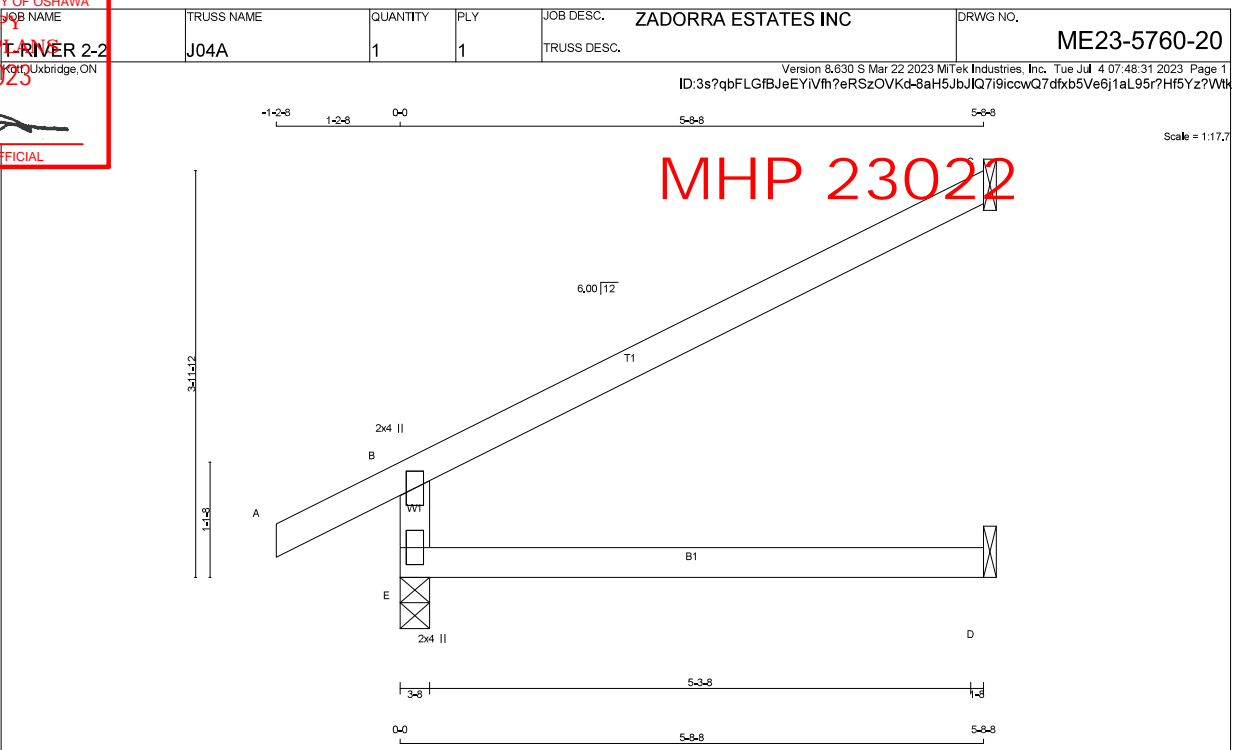

LUMBER

N. L. G. A. RULES	CHORDS	SIZE	DRY	LUMBER	DESCR.
E - B	2x4	DRY	No.2	SPF	
A - C	2x4	DRY	No.2	SPF	
E - D	2x4	DRY	No.2	SPF	

DRY: SEASONED LUMBER.

PLATES (table is in inches)

JT	TYPE	PLATES	W	LEN	Y	X
B	TMV+p	MT20	2.0	4.0		
E	BMV1+p	MT20	2.0	4.0		

DIMENSIONS, SUPPORTS AND LOADINGS SPECIFIED BY FABRICATOR TO BE VERIFIED BY BUILDING DESIGNER

BEARINGS

JT	FACTORED GROSS REACTION	MAXIMUM FACTORED GROSS REACTION	INPUT BRG IN-SX	REQRD BRG IN-SX
E	639 0	639 0	3-8	1-8
C	256 0	256 0	1-8	1-8
D	43 0	48 0	1-8	1-8

SEE MITEK STANDARD DETAIL MSD2015-H FOR CONNECTION TO JOINT(S) C, D

UNFACTORED REACTIONS

JT	COMBINED	SNOW	LIVE	PERM.LIVE	WIND	DEAD	SOIL
E	444	337 / 0	0 / 0	0 / 0	0 / 0	107 / 0	0 / 0
C	175	149 / 0	0 / 0	0 / 0	0 / 0	26 / 0	0 / 0
D	34	0 / 0	0 / 0	0 / 0	0 / 0	34 / 0	0 / 0

BRACING
TOP CHORD TO BE SHEATHED OR MAX. PURLIN SPACING = 6.25 FT.
MAX. UNBRACED BOTTOM CHORD LENGTH = 10.00 FT. OR RIGID CEILING DIRECTLY APPLIED.
ALL PITCH BREAKS AND PERIMETER CORNER JOINTS MUST BE Laterally RESTRAINED.

LOADING
TOTAL LOAD CASES: (4)

CHORDS				WEBS			
MEMB.	MAX. FACTORED FORCE (LBS)	FACTORED VERT. LOAD (PLF)	MAX. UNBRACED LENGTH (LC)	MEMB.	MAX. FACTORED FORCE (LBS)	FACTORED VERT. LOAD (PLF)	MAX. UNBRACED LENGTH (LC)
FR-TO		FROM	TO	FR-TO		FROM	TO
E-B	-578 / 0	0.0	0.0 0.10 (4)	7.81			
A-B	0 / 34	-119.4	-119.4 0.14 (1)	10.00			
B-C	-38 / 0	-119.4	-119.4 0.51 (1)	6.25			
E-D	0 / 0	-18.2	-18.2 0.12 (4)	10.00			

DESIGN CRITERIA

SPECIFIED LOADS:
TOP CH. LL = 34.8 PSF
DL = 6.0 PSF
BOT CH. LL = 0.0 PSF
DL = 7.3 PSF
TOTAL LOAD = 48.1 PSF

SPACING = 24.0 IN. G/C
THIS TRUSS IS DESIGNED FOR RESIDENTIAL OR SMALL BUILDING REQUIREMENTS OF PART 9, NBCC 2015

THIS DESIGN COMPLIES WITH:
- PART 9 OF CBC 2018, NBC-2019AE
- PART 9 OF OBC 2021 (2019 AMENDMENT)
- CSA 086-14
- TPIC 2014

DESIGN ASSUMPTIONS
- OVERHANG NOT TO BE ALTERED OR CUT OFF.
(55 % OF 48.1 P.S.F. G.S.L. PLUS 8.4 P.S.F. RAIN LOAD) EQUALS 34.8 P.S.F. SPECIFIED ROOF LIVE LOAD

ALLOWABLE DEFL.(LL)= L/360 (0.19")
CALCULATED VERT. DEFL.(LL) = L/999 (0.00")
ALLOWABLE DEFL.(TL)= L/360 (0.19")
CALCULATED VERT. DEFL.(TL) = L/999 (0.03")

CSI: TC=0.51/1.00 (B-C:1) BC=0.12/1.00 (D-E:4) ,
WB=0.00/1.00 (n/a:0) , SSI=0.30/1.00 (B-C:1)

DOL LUMBER=1.00 NAIL=1.00 LS BEND=1.10
COMP=1.10 SHEAR=1.10 TENS=1.10

COMPANION LIVE LOAD FACTOR = 1.00

TRUSS PLATE MANUFACTURER IS NOT RESPONSIBLE FOR QUALITY CONTROL IN THE TRUSS MANUFACTURING PLANT.

NAIL VALUES
PLATE GRIP(DRY) SHEAR SECTION (PSI) (PLI) (PU)
MAX MIN MAX MIN MAX MIN
MT20 650 371 1747 788 1987 1873

PLATE PLACEMENT TOL. = 0.250 inches
PLATE ROTATION TOL. = 5.0 Deg.

JSI GRIP= 0.32 (B) (INPUT = 0.90)
JSI METAL= 0.24 (B) (INPUT = 1.00)

MODULUS ENGINEERING LTD.




REVIEW FOR TRUSS COMPONENT ONLY
NOTE: ALTERING THIS DOCUMENT
VOIDS THE ENGINEER'S SEAL

WARNING - Verify design parameters and READ NOTES ON THIS AND INCLUDED IN MODULUS ENGINEERING LTD. NOTES ME-TC001 (VER 06/2017) BEFORE USE.
Design valid for use only with Mitek connectors. This design is based only upon parameters shown, and is for individual building components. Applicability of design parameters and proper incorporation of component is responsibility of building designer - not truss designer. Bracing shown is for lateral support of individual web members only. Additional temporary bracing to ensure stability during construction is the responsibility of the erector. Additional permanent bracing of the overall structure is the responsibility of the building designer. For general guidance regarding fabrication, quality control, storage, delivery, erection and bracing, consult
TPIC Appendix G - Minimum quality Manufacturing Criteria available from www.tpica.ca and BCSI-CANADA (Building Component Safety Information) available from TPI, 781 N. Lee Street, Suite 312, Alexandria, VA 22314 or www.sbindustry.com



CORPORATION OF THE CITY OF OSHAWA
TRUE COPY
OF PERMIT PLANS
Nov 23 2023
PER: 
CHIEF BUILDING OFFICIAL

PROJECT NAME RIVER 2-2	TRUSS NAME J05	QUANTITY 1	PLY 1	JOB DESC. ZADORRA ESTATES INC	DRWG NO. ME23-5760-21
Version 8.630 S Mar 22 2023 MiTek Industries, Inc. Tue Jul 4 07:48:32 2023 Page 1 ID:3s?qbFLGfBJeEYIvfh?eRSzOVkd-cmrTWwJNBRq0JmB6_r8uIpelW4WUoPF4f0Ce_z?Wj					

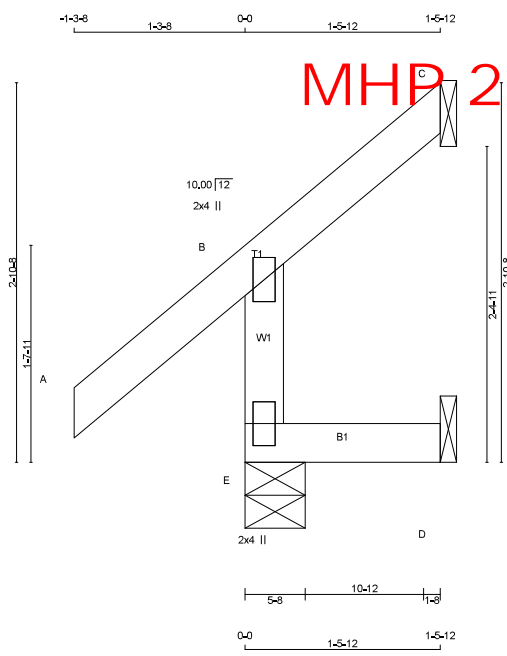

LUMBER
N. L. G. A. RULES
CHORDS SIZE LUMBER DESCR. SPF

E - B	2x4	DRY	No.2	SPF
A - C	2x4	DRY	No.2	SPF
E - D	2x4	DRY	No.2	SPF

DRY: SEASONED LUMBER.

PLATES (table is in inches)

JT	TYPE	PLATES	W	LEN	Y	X
B	TMV+p	MT20	2.0	4.0		
E	BMV1+p	MT20	2.0	4.0		

DIMENSIONS, SUPPORTS AND LOADINGS SPECIFIED BY FABRICATOR TO BE VERIFIED BY BUILDING DESIGNER

BEARINGS		FACTORED GROSS REACTION		MAXIMUM FACTORED GROSS REACTION		INPUT BRG		REQRD BRG	
JT	VERT	HORZ	DOWN	HORZ	UPLIFT	IN-SX	IN-SX	IN-SX	IN-SX
E	345	0	345	0	0	5-8	1-8	1-8	1-8
C	27	0	27	0	-49	1-8	1-8	1-8	1-8
D	-2	0	12	0	-11	1-8	1-8	1-8	1-8

SEE MITEK STANDARD DETAIL MSD2015-H FOR CONNECTION TO JOINT(S) C, D
PROVIDE ANCHORAGE AT BEARING JOINT C FOR 150 LBS. FACTORED UPLIFT
PROVIDE ANCHORAGE AT BEARING JOINT D FOR 150 LBS. FACTORED UPLIFT

UNFACTORED REACTIONS

JT	1ST CASE	SNOW	LIVE	PERM. LIVE	WIND	DEAD	SOIL
E	237	193 / 0	0 / 0	0 / 0	0 / 0	44 / 0	0 / 0
C	18	15 / -33	0 / 0	0 / 0	0 / 0	3 / 0	0 / 0
D	-0	0 / -12	0 / 0	0 / 0	0 / 0	9 / 0	0 / 0

BEARING MATERIAL TO BE SPF NO.2 OR BETTER AT JOINT(S) E
BRACING
TOP CHORD TO BE SHEATHED OR MAX. PURLIN SPACING = 6.25 FT.
MAX. UNBRACED BOTTOM CHORD LENGTH = 10.00 FT OR RIGID CEILING DIRECTLY APPLIED.
ALL PITCH BREAKS AND PERIMETER CORNER JOINTS MUST BE Laterally RESTRAINED.

LOADING
TOTAL LOAD CASES: (5)

CHORDS		FACTORED		WEBS	
MEMB.	FORCE (LBS)	VERT. LOAD (LBS)	MAX. (PLF) (LC)	MEMB.	MAX. FORCE (LBS) (LC)
FR-TO		FROM	TO	FR-TO	
E-B	-315 / 0	0.0	0.0 0.04 (5)	7.81	
A-B	0 / 53	-119.4	-119.4 0.16 (1)	10.00	
B-C	-39 / 0	-119.4	-119.4 0.12 (1)	6.25	
E-D	0 / 0	-18.2	-18.2 0.04 (5)	10.00	

CANTILEVER ANALYSIS HAS BEEN CONSIDERED IN THIS DESIGN

PATTERN LOADING CHECK APPLIED TO THIS TRUSS.

DESIGN CRITERIA

SPECIFIED LOADS:

TOP CH. LL	=	34.8	PSF
DL	=	6.0	PSF
BOT CH. LL	=	0.0	PSF
DL	=	7.3	PSF
TOTAL LOAD	=	48.1	PSF

SPACING = 24.0 IN. GIG
THIS TRUSS IS DESIGNED FOR RESIDENTIAL OR SMALL BUILDING REQUIREMENTS OF PART 9, NBC 2015

THIS DESIGN COMPLIES WITH:
- PART 9 OF BCBC 2018, NBC-2019AE
- PART 9 OF OBC 2012 (2019 AMENDMENT)
- CSA 086-14
- TPIC 2014

DESIGN ASSUMPTIONS
- OVERHANG NOT TO BE ALTERED OR CUT OFF.
(55 % OF 48.1 P.S.F. G.S.L. PLUS 8.4 P.S.F. RAIN LOAD) EQUALS 34.8 P.S.F. SPECIFIED ROOF LIVE LOAD

ALLOWABLE DEFL.(LL) = L/360 (0.19")
CALCULATED VERT. DEFL.(LL) = L/999 (0.00")
ALLOWABLE DEFL.(TL) = L/360 (0.19")
CALCULATED VERT. DEFL.(TL) = L/999 (0.00")

CSI: TC=0.16/1.00 (A-B 1), BC=0.04/1.00 (D-E 5),
WB=0.00/1.00 (n/a 0), SSI=0.10/1.00 (A-B 1)

DOL LUMBER=1.00 NAIL=1.00 LS BEND=1.10
COMP=1.10 SHEAR=1.10 TENS=1.10

COMPANION LIVE LOAD FACTOR = 1.00

TRUSS PLATE MANUFACTURER IS NOT RESPONSIBLE FOR QUALITY CONTROL IN THE TRUSS MANUFACTURING PLANT.

NAIL VALUES

PLATE	GRIP (DRY)	SHEAR (PSI)	SECTION (PLI)
MT20	650	371	1747

PLATE PLACEMENT TOL. = 0.250 inches

PLATE ROTATION TOL. = 5.0 Deg.

JSI GRIP= 0.22 (B) (INPUT = 0.90)
JSI METAL= 0.17 (B) (INPUT = 1.00)

MODULUS ENGINEERING LTD.




REVIEW FOR TRUSS COMPONENT ONLY
NOTE: ALTERING THIS DOCUMENT
VOIDS THE ENGINEER'S SEAL

WARNING - Verify design parameters and READ NOTES ON THIS AND INCLUDED IN MODULUS ENGINEERING LTD. NOTES ME-TC001 (VER 06/2017) BEFORE USE.
Design valid for use only with MiTek connectors. This design is based only upon parameters shown, and is for individual building components. Applicability of design parameters and proper incorporation of component is responsibility of building designer - not truss designer. Bracing shown is for lateral support of individual web members only. Additional temporary bracing to ensure stability during construction is the responsibility of the erector. Additional permanent bracing of the overall structure is the responsibility of the building designer. For general guidance regarding fabrication, quality control, storage, delivery, erection and bracing, consult
TPIC Appendix G - Minimum quality Manufacturing Criteria available from www.tpica.ca and BCSI-CANADA (Building Component Safety Information) available from TPI, 781 N. Lee Street, Suite 312, Alexandria, VA 22314 or www.sbindustry.com



CORPORATION OF THE CITY OF OSHAWA
TRUE COPY
OF PERMIT PLANS
Nov 23 2023
PER: 
CHIEF BUILDING OFFICIAL

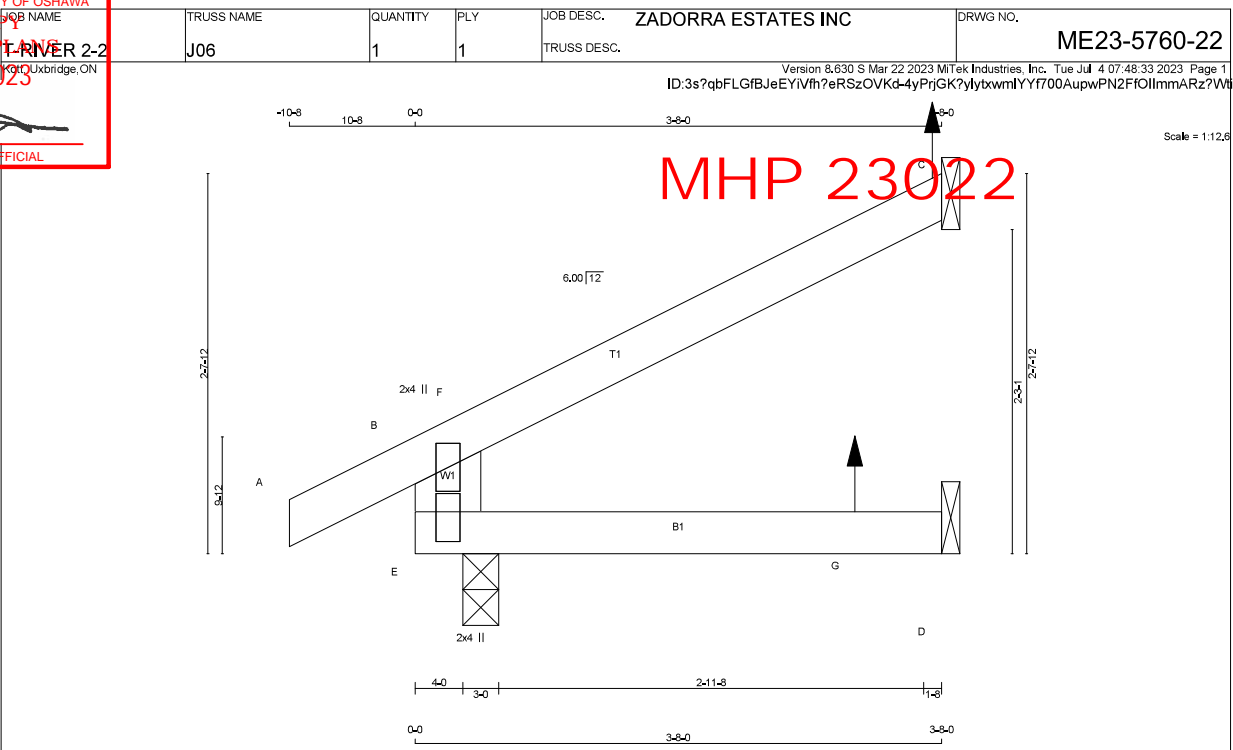

LUMBER

N, L, G, A, RULES	CHORDS	SIZE	DRY	NUMBER	DESCR.	SPF
E - B	2x6	DRY	No.2			
A - C	2x4	DRY	No.2			
E - D	2x4	DRY	No.2			

DRY: SEASONED LUMBER.

PLATES (table is in inches)

JT	TYPE	PLATES	W	LEN	Y	X
B	TMV+p	MT20	2.0	4.0		
E	BMV1+p	MT20	2.0	4.0	2.50	1.00

DIMENSIONS, SUPPORTS AND LOADINGS SPECIFIED BY FABRICATOR TO BE VERIFIED BY BUILDING DESIGNER

BEARINGS

	FACTORED GROSS REACTION	MAXIMUM FACTORED GROSS REACTION	INPUT BRG IN-SX	REQRD BRG IN-SX
JT	VERT	DOWN	UP	
E	424	0	424	0
C	132	0	132	0
D	17	0	29	0

SEE MITEK STANDARD DETAIL, MSD2015-H FOR CONNECTION TO JOINT(S) C, D

PROVIDE ANCHORAGE AT BEARING JOINT C FOR 150 LBS. FACTORED UPLIFT

UNFACTORED REACTIONS

JT	1ST CASE	MAX./MIN. COMPONENT REACTIONS	WIND	DEAD	SOIL
	COMBINED	SNOW	LIVE	PERM. LIVE	
E	295	223 / 0	0 / 0	0 / 0	72 / 0
C	86	96 / 0	0 / 0	0 / 0	0 / 9
D	15	0 / -6	0 / 0	0 / 0	21 / 0

BEARING MATERIAL TO BE SPF NO.2 OR BETTER AT JOINT(S) E

BRACING

TOP CHORD TO BE SHEATHED OR MAX. PURLIN SPACING = 6.25 FT.
MAX. UNBRACED BOTTOM CHORD LENGTH = 10.00 FT. OR RIGID CEILING DIRECTLY APPLIED.

ALL PITCH BREAKS AND PERIMETER CORNER JOINTS MUST BE LATERALLY RESTRAINED.

LOADING

TOTAL LOAD CASES: (7)

CHORDS	MEMB.	MAX. FACTORED FORCE (LBS)	VERT. LOAD (LBS)	FACTORED (PLF)	MAX. CSI (LC)	UNBRAC LENGTH	FR-TO	WEBS	MEMB.	MAX. FACTORED FORCE (LBS)	MAX. CSI (LC)
E-B	-386 / 0	0.0	0.0	0.03	(4)	7.81					
A-B	0 / 25	-119.4	-119.4	0.09	(7)	10.00					
B-F	-24 / 0	-119.4	-119.4	0.27	(1)	6.25					
F-C	-24 / 0	-119.4	-119.4	0.27	(1)	6.25					
E-G	0 / 0	-18.2	-18.2	0.07	(4)	10.00					
G-D	0 / 0	-18.2	-18.2	0.07	(4)	10.00					

FACTORED CONCENTRATED LOADS (LBS)

JT	LOC.	LC1	MAX.	MAX+	FACE	DIR.	TYPE	HEEL	CONN.
C	3-0-0	32	1	32	BACK	VERT	TOTAL	---	C1
G	3-0-12	12	1	12	BACK	VERT	TOTAL	---	C1

CONNECTION REQUIREMENTS

1) C1: A SUITABLE HANGER/MECHANICAL CONNECTION IS REQUIRED.

CANTILEVER ANALYSIS HAS BEEN CONSIDERED IN THIS DESIGN

PATTERN LOADING CHECK APPLIED TO THIS TRUSS.

DESIGN CRITERIA

*** SPECIAL LOADS ANALYSIS ***
GEOMETRY AND/OR BASIC LOADS CHANGED BY USER.
LOADS WERE DERIVED FROM USER INPUT
NO FURTHER MODIFICATIONS WERE MADE

SPECIFIED LOADS:

TOP CH.	LL	=	34.8	PSF
DL	=	6.0	PSF	
BOT CH.	LL	=	0.0	PSF
DL	=	7.3	PSF	
TOTAL LOAD	=	48.1	PSF	

SPACING = 24.0 IN. G/C

*** NON STANDARD GIRDER ***
ADDT'L USER-DEFINED LOADS APPLIED TO ALL LOAD CASES.

THIS TRUSS IS DESIGNED FOR RESIDENTIAL OR SMALL BUILDING REQUIREMENTS OF PART 9, NBC 2015

THIS DESIGN COMPLIES WITH:

- PART 9 OF BCBC 2018 - NBC-2019AE
- PART 9 OF OBC 2012 (2019 AMENDMENT)
- CSA 086-14
- TPIC 2014

DESIGN ASSUMPTIONS

- OVERHANG NOT TO BE ALTERED OR CUT OFF.

(55 % OF 48.1 P.S.F. G.S.L. PLUS 8.4 P.S.F. RAIN LOAD) EQUALS 34.8 P.S.F. SPECIFIED ROOF LIVE LOAD

ALLOWABLE DEFL.(LL) = L/360 (0.19")
CALCULATED VERT. DEFL.(LL) = L/999 (0.00")
ALLOWABLE DEFL.(TL) = L/360 (0.19")
CALCULATED VERT. DEFL.(TL) = L/999 (0.00")

CSI TC=0.27/1.00 (B-C:1), BC=0.07/1.00 (D-E:4), WB=0.00/1.00 (n/a:0), SSI=0.19/1.00 (B-C:1)

DOL LUMBER=1.00 NAIL=1.00 LS BEND=1.10
COMP=1.10 SHEAR=1.10 TENS=1.10

COMPANION LIVE LOAD FACTOR = 1.00

TRUSS PLATE MANUFACTURER IS NOT RESPONSIBLE FOR QUALITY CONTROL IN THE TRUSS MANUFACTURING PLANT.

NAIL VALUES

PLATE	GRIP (DRY)	SHEAR (PSI)	SECTION (PLI)
MT20	650	371	1747
	788	1987	1873

PLATE PLACEMENT TOL. = 0.250 inches

PLATE ROTATION TOL. = 5.0 Deg.

JSI GRIP= 0.22 (E) (INPUT = 0.90)
JSI METAL= 0.16 (B) (INPUT = 1.00)

MODULUS ENGINEERING LTD.



REVIEW FOR TRUSS COMPONENT ONLY

NOTE: ALTERING THIS DOCUMENT
VOIDS THE ENGINEER'S SEAL


CORPORATION OF THE CITY OF OSHAWA

TRUE COPY OF PERMIT PLANS

Nov 23 2025

PER:  CHIEF BUILDING OFFICIAL

PROJECT NAME RIVER 2-2	TRUSS NAME J06A	QUANTITY 1	PLY 1	JOB DESC. ZADORRA ESTATES INC	DRWG NO. ME23-5760-23
Version 8.630 S Mar 22 2023 MiTek Industries, Inc. Tue Jul 4 07:48:35 2023 Page 1					
ID:3s?qbFLGfBJeEYIVfh?eRSzOVkd-1LXcByMFUMCbAEvhfzhb5RGHFj6MW99hmcFsEjz?Wg					

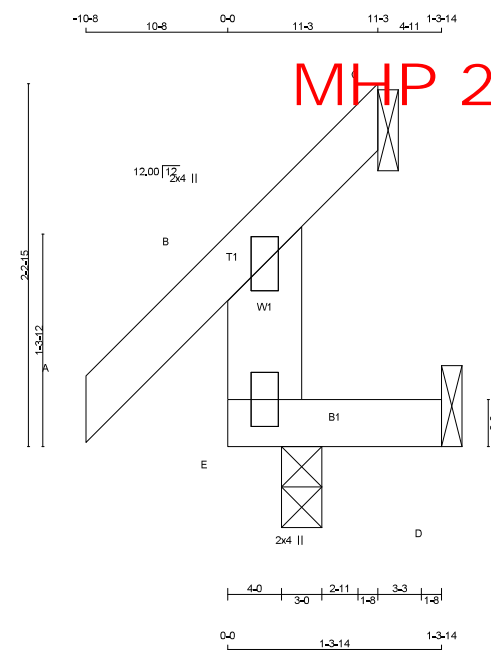


<div>LUMBER</div> <div>N. L. G. A. RULES</div> <div>CHORDS SIZE LUMBER</div> <div>E - B 2x6 DRY No.2</div> <div>A - C 2x4 DRY No.2</div> <div>E - D 2x4 DRY No.2</div> <div>DESCR. SPF</div> <div>SPF</div> <div>SPF</div> <div>DRY: SEASONED LUMBER.</div>										<div>DIMENSIONS, SUPPORTS AND LOADINGS SPECIFIED BY FABRICATOR TO BE VERIFIED BY BUILDING DESIGNER</div> <div>BEARINGS</div> <table><tr><td></td><td></td><td></td><td></td><td></td><td></td><td></td><td></td><td></td><td></td><td></td></tr>Nov 23 2023
PER: 
CHIEF BUILDING OFFICIAL

JOBB NAME T-RIVER 2-2	TRUSS NAME J07	QUANTITY 1	PLY 1	JOB DESC. ZADORRA ESTATES INC	DRWNG NO. ME23-5760-24
TRUSS DESC. Version 8,630 S Mar 22 2023 Mitek Industries, Inc. Tue Jul 4 07:48:36 2023 Page 1 ID:3s?qbFLGfBJeEYIVfh?eRSzOVkd-VX5_MINuFgKRnUIDhDqefoMD7Q9FcPq_G_Qnmz?W					

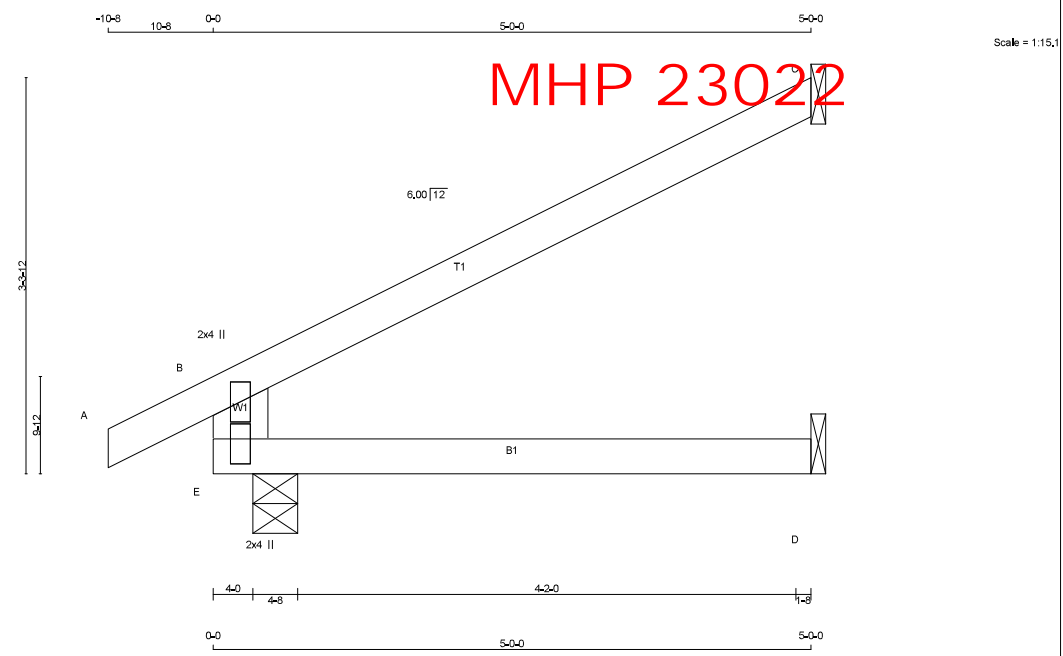

LUMBER
N. L. G. A. RULES
CHORDS SIZE LUMBER DESCR. SPF

E - B	2x6	DRY	No.2	SPF
A - C	2x4	DRY	No.2	SPF
E - D	2x4	DRY	No.2	SPF

DRY: SEASONED LUMBER.

PLATES (table is in inches)

JT	TYPE	PLATES	W	LEN	Y	X
B	TMV+p	MT20	2.0	4.0		
E	BMV+1+p	MT20	2.0	4.0	2.50	1.00

DIMENSIONS, SUPPORTS AND LOADINGS SPECIFIED BY FABRICATOR TO BE VERIFIED BY BUILDING DESIGNER

BEARINGS

JT	FACTORED GROSS REACTION	MAXIMUM FACTORED GROSS REACTION	INPUT BRG	REQRD BRG
E	542 0	542 0	4-8	2-8
C	224 0	224 0	1-8	1-8
D	35 0	39 0	1-8	1-8

SEE MITEK STANDARD DETAIL MSD2015-H FOR CONNECTION TO JOINT(S) C, D

UNFACTORED REACTIONS

JT	COMBINED	SNOW	LIVE	PERM.LIVE	WIND	DEAD	SOIL
E	377	283 / 0	0 / 0	0 / 0	0 / 0	94 / 0	0 / 0
C	153	131 / 0	0 / 0	0 / 0	0 / 0	23 / 0	0 / 0
D	28	0 / 0	0 / 0	0 / 0	0 / 0	28 / 0	0 / 0

BRACING
TOP CHORD TO BE SHEATHED OR MAX. PURLIN SPACING = 6.25 FT.
MAX. UNBRACED BOTTOM CHORD LENGTH = 10.00 FT. OR RIGID CEILING DIRECTLY APPLIED.
ALL PITCH BREAKS AND PERIMETER CORNER JOINTS MUST BE Laterally RESTRAINED.

LOADING
TOTAL LOAD CASES: (4)

CHORDS				WEBS			
MEMB.	MAX. FACTORED FORCE (LBS)	FACTORED VERT. LOAD (PLF)	MAX. UNBRACED LENGTH (FT)	MEMB.	MAX. FACTORED FORCE (LBS)	MAX. UNBRACED LENGTH (FT)	
FR-TO		FROM TO		FR-TO			
E-B	-485 / 0	0.0 0.0 0.05 (4)	7.81				
A-B	0 / 25	-119.4 -119.4 0.08 (1)	10.00				
B-C	-33 / 0	-119.4 -119.4 0.39 (1)	6.25				
E-D	0 / 0	-18.2 -18.2 0.12 (4)	10.00				

DESIGN CRITERIA

SPECIFIED LOADS:
TOP CH. LL = 34.8 PSF
DL = 6.0 PSF
BOT CH. LL = 0.0 PSF
DL = 7.3 PSF
TOTAL LOAD = 48.1 PSF

SPACING = 24.0 IN. G/C
THIS TRUSS IS DESIGNED FOR RESIDENTIAL OR SMALL BUILDING REQUIREMENTS OF PART 9, NBCC 2015

THIS DESIGN COMPLIES WITH:
- PART 9 OF CBC 2018, NBC-2019AE
- PART 9 OF OBC 2012 (2019 AMENDMENT)
- CSA 086-14
- TPIC 2014

DESIGN ASSUMPTIONS
- OVERHANG NOT TO BE ALTERED OR CUT OFF.
(55 % OF 48.1 P.S.F. G.S.L. PLUS 8.4 P.S.F. RAIN LOAD) EQUALS 34.8 P.S.F. SPECIFIED ROOF LIVE LOAD

ALLOWABLE DEFL.(LL)= L/360 (0.19")
CALCULATED VERT. DEFL.(LL) = L/999 (0.00")
ALLOWABLE DEFL.(TL)= L/360 (0.19")
CALCULATED VERT. DEFL.(TL) = L/999 (0.01")

CSI TC=0.39/1.00 (B-C:1) BC=0.12/1.00 (D-E:4) ,
WB=0.00/1.00 (n/a:0) , SSI=0.26/1.00 (B-C:1)

DOL LUMBER=1.00 NAIL=1.00 LS BEND=1.10
COMP=1.10 SHEAR=1.10 TENS=1.10

COMPANION LIVE LOAD FACTOR = 1.00
AUTOSOLVE RIGHT HEEL ONLY

TRUSS PLATE MANUFACTURER IS NOT RESPONSIBLE FOR QUALITY CONTROL IN THE TRUSS MANUFACTURING PLANT.

NAIL VALUES


PLATE	GRIP(DRY)	SHEAR	SECTION
	(PSI)	(PLI)	(PLI)
MT20	MAX 550	MIN 371	MAX 1747
	MIN 650	MIN 788	MIN 1987


PLATE PLACEMENT TOL. = 0.250 inches
PLATE ROTATION TOL. = 5.0 Deg.
JSI GRIP= 0.28 (E) (INPUT = 0.90)
JSI METAL= 0.20 (B) (INPUT = 1.00)

MODULUS ENGINEERING LTD.



REVIEW FOR TRUSS COMPONENT ONLY
NOTE: ALTERING THIS DOCUMENT
VOIDS THE ENGINEER'S SEAL

CORPORATION OF THE CITY OF OSHAWA
TRUE COPY
OF PERMIT PLANS
Nov 23 2023
PER: 
CHIEF BUILDING OFFICIAL

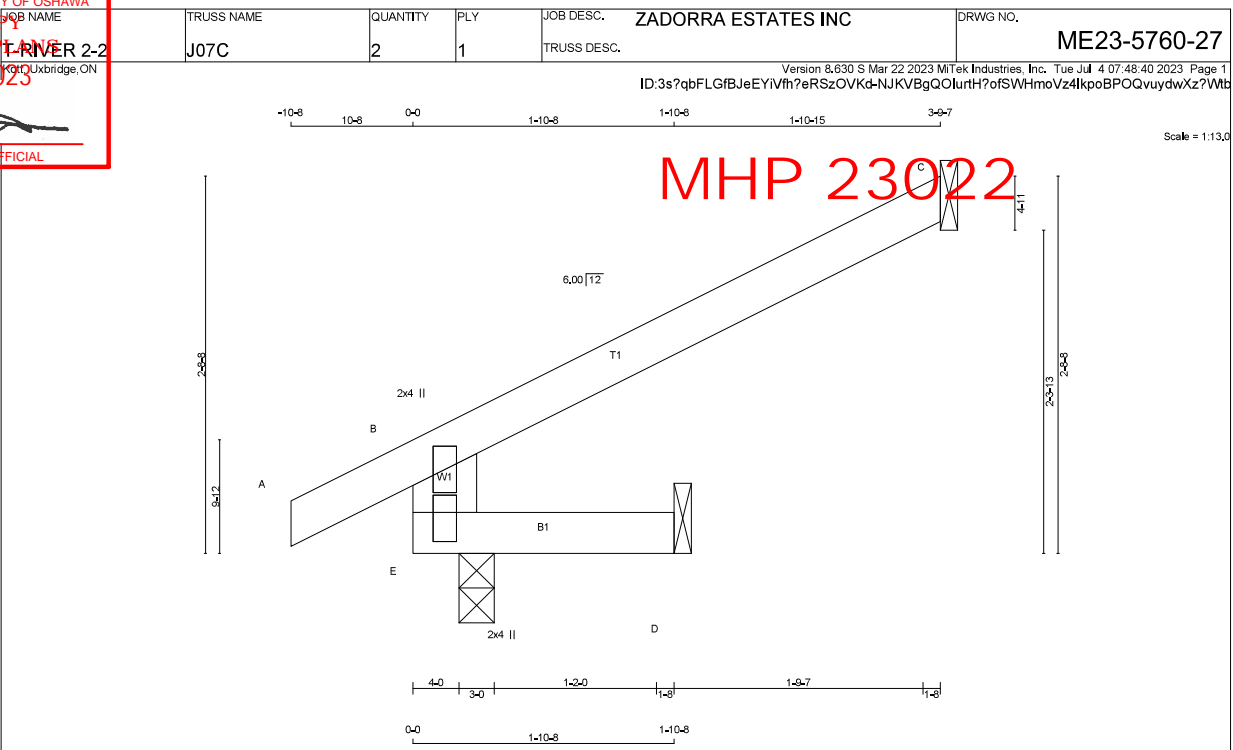

LUMBER

N, L, G, A, RULES	CHORDS	SIZE	DRY	LUMBER	DESCR.
E - B	2x6	DRY	No.2	SPF	
A - C	2x4	DRY	No.2	SPF	
E - D	2x4	DRY	No.2	SPF	

DRY: SEASONED LUMBER.

PLATES (table is in inches)

JT	TYPE	PLATES	W	LEN	Y	X
B	TMV+p	MT20	2.0	4.0		
E	BMV1+p	MT20	2.0	4.0	2.50	1.00

DIMENSIONS, SUPPORTS AND LOADINGS SPECIFIED BY FABRICATOR TO BE VERIFIED BY BUILDING DESIGNER

BEARINGS		FACTORED GROSS REACTION		MAXIMUM FACTORED GROSS REACTION		INPUT BRG IN-SX		REQRD BRG IN-SX	
JT	VERT	HORZ	DOWN	HORZ	UPLIFT	JT	VERT	HORZ	UPLIFT
E	416	0	416	0	0	3-0	1-8		
C	170	0	170	0	0	1-8	1-8		
D	14	0	15	0	0	1-8	1-8		

SEE MITEK STANDARD DETAIL MSD2015-H FOR CONNECTION TO JOINT(S) C, D

UNFACTORED REACTIONS

JT	COMBINED	SNOW	LIVE	PERM.LIVE	WIND	DEAD	SOIL
E	286	230 / 0	0 / 0	0 / 0	0 / 0	56 / 0	0 / 0
C	116	99 / 0	0 / 0	0 / 0	0 / 0	17 / 0	0 / 0
D	11	0 / 0	0 / 0	0 / 0	0 / 0	11 / 0	0 / 0

BEARING MATERIAL TO BE SPF NO.2 OR BETTER AT JOINT(S) E

BRACING

TOP CHORD TO BE SHEATHED OR MAX. PURLIN SPACING = 6.25 FT.
MAX. UNBRACED BOTTOM CHORD LENGTH = 10.00 FT. OR RIGID CEILING DIRECTLY APPLIED.

ALL PITCH BREAKS AND PERIMETER CORNER JOINTS MUST BE Laterally RESTRAINED.

LOADING

TOTAL LOAD CASES: (5)

CHORDS		FACTORED		W E B S	
MEMB.	FORCE (LBS)	VERT.	LOAD LC1 MAX (PLF)	MEMB.	FORCE (LBS)
FR-TO		FROM	TO	UNBRAC	LENGTH FR-TO
E-B	-395 / 0	0.0	0.0	0.01 (4)	7.81
A-B	0 / 25	-119.4	-119.4	0.08 (5)	10.00
B-C	-25 / 0	-119.4	-119.4	0.29 (1)	6.25
E-D	0 / 0	-18.2	-18.2	0.02 (4)	10.00

CANTILEVER ANALYSIS HAS BEEN CONSIDERED IN THIS DESIGN

PATTERN-LOADING CHECK APPLIED TO THIS TRUSS.

DESIGN CRITERIA

SPECIFIED LOADS:

TOP CH.	LL	=	34.8	PSF
DL	=	6.0	PSF	
BOT CH.	LL	=	0.0	PSF
DL	=	7.3	PSF	
TOTAL LOAD	=	48.1	PSF	

SPACING = 24.0 IN. G/C

THIS TRUSS IS DESIGNED FOR RESIDENTIAL OR SMALL BUILDING REQUIREMENTS OF PART 9, NBCC 2015

THIS DESIGN COMPLIES WITH:

- PART 9 OF CBC 2018, NBC-2019AE
- PART 9 OF OBC 2012 (2019 AMENDMENT)
- CSA 086-14
- TPIC 2014

DESIGN ASSUMPTIONS

-OVERHANG NOT TO BE ALTERED OR CUT OFF.

(55 % OF 48.1 P.S.F. G.S.L. PLUS 8.4 P.S.F. RAIN LOAD) EQUALS 34.8 P.S.F. SPECIFIED ROOF LIVE LOAD

ALLOWABLE DEFL.(LL)= L/360 (0.19")
CALCULATED VERT. DEFL.(LL) = L/ 999 (0.00")
ALLOWABLE DEFL.(TL)= L/360 (0.19")
CALCULATED VERT. DEFL.(TL) = L/ 999 (0.00")

CSI TC=0.29/1.00 (B-C:1) BC=0.02/1.00 (D-E:4) ,
WB=0.00/1.00 (n/a:0) , SSI=0.20/1.00 (B-C:1)

DOL LUMBER=1.00 NAIL=1.00 LS BEND=1.10
COMP=1.10 SHEAR=1.10 TENS=1.10

COMPANION LIVE LOAD FACTOR = 1.00

TRUSS PLATE MANUFACTURER IS NOT RESPONSIBLE FOR QUALITY CONTROL IN THE TRUSS MANUFACTURING PLANT .

NAIL VALUES

PLATE	GRIP(DRY)	SHEAR	SECTION
	(PSI)	(PLI)	(PLI)
	MAX MIN	MAX MIN	MAX MIN
MT20	650 371	1747 788	1987 1873

PLATE PLACEMENT TOL. = 0.250 inches

PLATE ROTATION TOL. = 5.0 Deg.

JSI GRIP= 0.23 (E) (INPUT = 0.90)
JSI METAL= 0.16 (B) (INPUT = 1.00)

MODULUS ENGINEERING LTD.




REVIEW FOR TRUSS COMPONENT ONLY

NOTE: ALTERING THIS DOCUMENT
VOIDS THE ENGINEER'S SEAL

WARNING - Verify design parameters and READ NOTES ON THIS AND INCLUDED IN MODULUS ENGINEERING LTD. NOTES ME-TCD01 (VER 06/2017) BEFORE USE.
Design valid for use only with Mitek connectors. This design is based only upon parameters shown, and is for individual building components. Applicability of design parameters and proper incorporation of component is responsibility of building designer - not truss designer. Bracing shown is for lateral support of individual web members only. Additional temporary bracing to ensure stability during construction is the responsibility of the erector. Additional permanent bracing of the overall structure is the responsibility of the building designer. For general guidance regarding fabrication, quality control, storage, delivery, erection and bracing, consult
TPIC Appendix G - Minimum quality Manufacturing Criteria available from www.tpica.ca and BCSI-CANADA (Building Component Safety Information) available from TPI, 781 N. Lee Street, Suite 312, Alexandria, VA 22314 or www.sbindustry.com



CORPORATION OF THE CITY OF OSHAWA
TRUE COPY
OF PERMIT PLANS
Nov 23 2023
PER: *C. Morris*
CHIEF BUILDING OFFICIAL

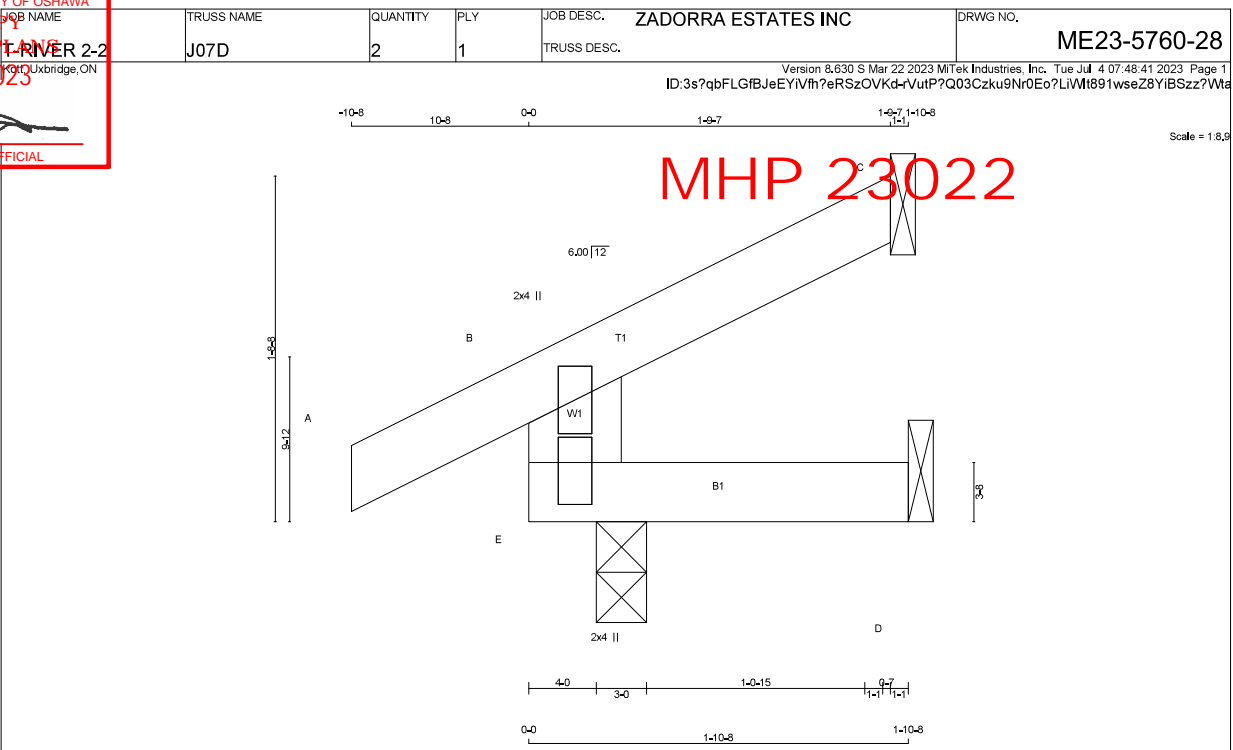

LUMBER
N. L. G. A. RULES
CHORDS SIZE LUMBER DESCR. SPF

E - B	2x6	DRY	No.2	SPF
A - C	2x4	DRY	No.2	SPF
E - D	2x4	DRY	No.2	SPF

DRY: SEASONED LUMBER.

PLATES (table is in inches)

JT	TYPE	PLATES	W	LEN	Y	X
B	TMV+p	MT20	2.0	4.0		
E	BMV1+p	MT20	2.0	4.0	2.50	1.00

DIMENSIONS, SUPPORTS AND LOADINGS SPECIFIED BY FABRICATOR TO BE VERIFIED BY BUILDING DESIGNER

BEARINGS

JT	FACTORED GROSS REACTION	MAXIMUM FACTORED GROSS REACTION	INPUT BRG IN-SX	REQRD BRG IN-SX
E	265 0	265 0	3-0	1-8
C	80 0	80 0	1-8	1-8
D	14 0	15 0	1-8	1-8

SEE MITEK STANDARD DETAIL MSD2015-H FOR CONNECTION TO JOINT(S) C, D

UNFACTORED REACTIONS

JT	COMBINED	SNOW	LIVE	PERM.LIVE	WIND	DEAD	SOIL
E	184	143 / 0	0 / 0	0 / 0	0 / 0	41 / 0	0 / 0
C	55	47 / 0	0 / 0	0 / 0	0 / 0	8 / 0	0 / 0
D	11	0 / 0	0 / 0	0 / 0	0 / 0	11 / 0	0 / 0

BEARING MATERIAL TO BE SPF NO.2 OR BETTER AT JOINT(S) E, C

BRACING
TOP CHORD TO BE SHEATHED OR MAX. PURLIN SPACING = 6.25 FT.
MAX. UNBRACED BOTTOM CHORD LENGTH = 10.00 FT. OR RIGID CEILING DIRECTLY APPLIED.
ALL PITCH BREAKS AND PERIMETER CORNER JOINTS MUST BE Laterally RESTRAINED.

LOADING
TOTAL LOAD CASES: (5)

CHORDS				WEBS			
MEMB.	FACTORED FORCE (LBS)	FACTORED VERT. LOAD (PLF)	MAX. UNBRACED LENGTH (LC)	MEMB.	FACTORED FORCE (LBS)	MAX. UNBRACED LENGTH (LC)	
FR-TO		FROM	TO	FR-TO			
E-B	-245 / 0	0.0	0.0 (4)	7.81			
A-B	0 / 25	-119.4	-119.4 (1)	10.00			
B-C	-12 / 0	-119.4	-119.4 (1)	6.25			
E-D	0 / 0	-18.2	-18.2 (2)	10.00			

CANTILEVER ANALYSIS HAS BEEN CONSIDERED IN THIS DESIGN

PATTERN-LOADING CHECK APPLIED TO THIS TRUSS.

DESIGN CRITERIA

SPECIFIED LOADS:
TOP CH. LL = 34.8 PSF
DL = 6.0 PSF
BOT CH. LL = 0.0 PSF
DL = 7.3 PSF
TOTAL LOAD = 48.1 PSF

SPACING = 24.0 IN. G/C

THIS TRUSS IS DESIGNED FOR RESIDENTIAL OR SMALL BUILDING REQUIREMENTS OF PART 9, NBCC 2015

THIS DESIGN COMPLIES WITH:
- PART 9 OF CBC 2018, NBC-2019AE
- PART 9 OF OBC 2012 (2019 AMENDMENT)
- CSA 086-14
- TPIC 2014

DESIGN ASSUMPTIONS
- OVERHANG NOT TO BE ALTERED OR CUT OFF.
(55 % OF 48.1 P.S.F. G.S.L. PLUS 8.4 P.S.F. RAIN LOAD) EQUALS 34.8 P.S.F. SPECIFIED ROOF LIVE LOAD

ALLOWABLE DEFL.(LL)= L/360 (0.19")
CALCULATED VERT. DEFL.(LL) = L/999 (0.00")
ALLOWABLE DEFL.(TL)= L/360 (0.19")
CALCULATED VERT. DEFL.(TL) = L/999 (0.00")

CSI: TC=0.08/1.00 (A-B 1), BC=0.02/1.00 (D-E 4),
WB=0.00/1.00 (n/a 0), SSI=0.09/1.00 (B-C 1)

DOL LUMBER=1.00 NAIL=1.00 LBS BEND=1.10
COMP=1.10 SHEAR=1.10 TENS=1.10

COMPANION LIVE LOAD FACTOR = 1.00

TRUSS PLATE MANUFACTURER IS NOT RESPONSIBLE FOR QUALITY CONTROL IN THE TRUSS MANUFACTURING PLANT.

NAIL VALUES

PLATE	GRIP (DRY)	SHEAR (PSI)	SECTION (PLI)	(PU)
MT20	650	371	1747	788 1987 1873

PLATE PLACEMENT TOL. = 0.250 inches

PLATE ROTATION TOL. = 5.0 Deg.

JSI GRIP= 0.14 (E) (INPUT = 0.90)
JSI METAL= 0.10 (B) (INPUT = 1.00)

MODULUS ENGINEERING LTD.

REVIEW FOR TRUSS COMPONENT ONLY


NOTE: ALTERING THIS DOCUMENT
VOIDS THE ENGINEER'S SEAL

WARNING - Verify design parameters and READ NOTES ON THIS AND INCLUDED IN MODULUS ENGINEERING LTD. NOTES ME-TCD01 (VER 06/2017) BEFORE USE.
Design valid for use only with Mitek connectors. This design is based only upon parameters shown, and is for individual building components. Applicability of design parameters and proper incorporation of component is responsibility of building designer - not truss designer. Bracing shown is for lateral support of individual web members only. Additional temporary bracing to ensure stability during construction is the responsibility of the erector. Additional permanent bracing of the overall structure is the responsibility of the building designer. For general guidance regarding fabrication, quality control, storage, delivery, erection and bracing, consult
TPIC Appendix G - Minimum quality Manufacturing Criteria available from www.tpica.ca and BCSI-CANADA (Building Component Safety Information) available from TPI, 781 N. Lee Street, Suite 312, Alexandria, VA 22314 or www.sbindustry.com





CORPORATION OF THE CITY OF OSHAWA
TRUE COPY
OF PERMIT PLANS
Nov 23 2023
PER: *C. Monte*
CHIEF BUILDING OFFICIAL

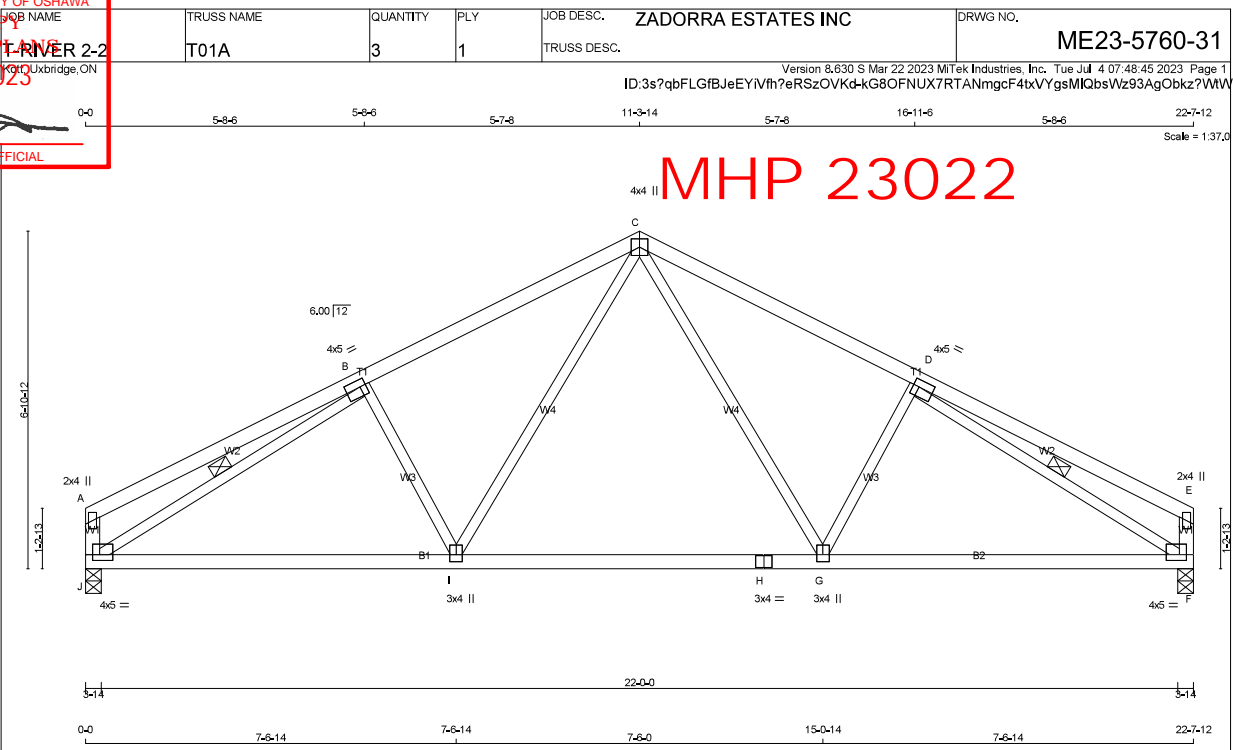

LUMBER
N. L. G. A. RULES

CHORDS	SIZE	LUMBER	DESCR.
A - C	2x4	DRY No.2	SPF
C - E	2x4	DRY No.2	SPF
F - H	2x4	DRY No.2	SPF
H - F	2x4	DRY No.2	SPF

ALL WEBS 2x3 DRY No.2 SPF
EXCEPT
DRY: SEASONED LUMBER.

PLATES (table is in inches)

JT	TYPE	PLATES	W	LEN	Y	X
A	TMV+p	MT20	2.0	4.0		
B	TMWW+4	MT20	4.0	5.0	1.75	1.50
C	TMWW+p	MT20	4.0	4.0		
D	TMWW+4	MT20	4.0	5.0	1.75	1.50
E	TMV+p	MT20	2.0	4.0		
F	BMVW+1	MT20	4.0	5.0	1.50	1.75
G	BMVW+1	MT20	3.0	4.0	1.75	1.50
H	BS4	MT20	3.0	4.0		
I	BMVW+1	MT20	3.0	4.0	1.75	1.50
J	BMVW+1	MT20	4.0	5.0	1.50	1.75

DIMENSIONS, SUPPORTS AND LOADINGS SPECIFIED BY FABRICATOR TO BE VERIFIED BY BUILDING DESIGNER

BEARINGS		FACTORED		MAXIMUM FACTORED		INPUT		REQRD	
JT	VERT	GROSS REACTION	DOWN	GROSS REACTION	DOWN	BRG	IN-SX	BRG	IN-SX
J	1559	0	1559	0	0	3-14	1-11		
F	1559	0	1559	0	0	3-14	1-11		

UNFACTORED REACTIONS							
	1ST LCASE	MAX./MIN. COMPONENT REACTIONS					
JT	COMBINED	SNOW	LIVE	PERM.LIVE	WIND	DEAD	SOIL
J	1089	788 / 0	0 / 0	0 / 0	0 / 0	301 / 0	0 / 0
F	1089	788 / 0	0 / 0	0 / 0	0 / 0	301 / 0	0 / 0

BEARING MATERIAL TO BE SPF NO.2 OR BETTER AT JOINT(S) J, F

BRACING
TOP CHORD TO BE SHEATHED OR MAX. PURLIN SPACING = 4.27 FT.
MAX. UNBRACED BOTTOM CHORD LENGTH = 10.00 FT. OR RIGID CEILING DIRECTLY APPLIED.

ALL PITCH BREAKS AND PERIMETER CORNER JOINTS MUST BE LATERALLY RESTRAINED.

1 LATERAL BRACE(S) AT 1/2 LENGTH OF B-J, D-F.

END VERTICAL(S) MUST BE SHEATHED OR HAVE BRACES AS INDICATED IN THE MAX. UNBRACED LENGTH COLUMN OF THE TABLE BELOW

LOADING

TOTAL LOAD CASES: (4)

C H O R D S				W E B S			
MEMB.	MAX. FACTORED FORCE (LBS)	FACTORED VERT. LOAD (PLF)	MAX. LOAD LC1 CSI (LC)	MAX. UNBRACED LENGTH	MEMB.	MAX. FACTORED FORCE (LBS)	MAX. FACTORED CSI (LC)
FR-TO		FROM TO			FR-TO		
A-B	0 / 36	-119.4 -119.4	0.62 (1)	10.00	C-G	0 / 650	0.15 (1)
B-C	-1888 / 0	-119.4 -119.4	0.54 (1)	4.27	G-D	-470 / 0	0.14 (1)
C-D	-1888 / 0	-119.4 -119.4	0.54 (1)	4.27	I-C	0 / 650	0.15 (1)
D-E	0 / 36	-119.4 -119.4	0.62 (1)	10.00	B-I	-470 / 0	0.14 (1)
J-A	-253 / 0	0.0 0.0	0.03 (1)	7.81	J-B	-2253 / 0	0.68 (1)
F-E	-253 / 0	0.0 0.0	0.03 (1)	7.81	D-F	-2253 / 0	0.68 (1)
J-I	0 / 1876	-18.2 -18.2	0.42 (1)	10.00			
I-H	0 / 1334	-18.2 -18.2	0.34 (1)	10.00			
H-G	0 / 1334	-18.2 -18.2	0.34 (1)	10.00			
G-F	0 / 1876	-18.2 -18.2	0.42 (1)	10.00			

DESIGN CRITERIA

SPECIFIED LOADS:
TOP CH. LL = 34.8 PSF
DL = 8.0 PSF
BOT CH. LL = 0.0 PSF
DL = 7.3 PSF
TOTAL LOAD = 48.1 PSF

SPACING = 24.0 IN. G/C

THIS TRUSS IS DESIGNED FOR RESIDENTIAL OR SMALL BUILDING REQUIREMENTS OF PART 9, NBC 2015

THIS DESIGN COMPLIES WITH:
- PART 9 OF CBC 2018, NBC-2019AE
- PART 9 OF OBC 2012 (2019 AMENDMENT)
- CSA 086-14
- TPIC 2014

(55 % OF 48.1 P.S.F. G.S.L. PLUS 8.4 P.S.F. RAIN LOAD) EQUALS 34.8 P.S.F. SPECIFIED ROOF LIVE LOAD

ALLOWABLE DEFL.(LL) = L/360 (0.75")
CALCULATED VERT. DEFL.(LL) = L/999 (0.09")
ALLOWABLE DEFL.(TL) = L/360 (0.75")
CALCULATED VERT. DEFL.(TL) = L/999 (0.16")

CSI: TC=0.62/1.00 (A-B:1), BC=0.42/1.00 (I-J:1), WB=0.68/1.00 (B-J:1), SS=0.29/1.00 (B-C:1)

DOL LUMBER=1.00 NAIL=1.00 LS BEND=1.10 COMP=1.10 SHEAR=1.10 TENS=1.10

COMPANION LIVE LOAD FACTOR = 1.00

TRUSS PLATE MANUFACTURER IS NOT RESPONSIBLE FOR QUALITY CONTROL IN THE TRUSS MANUFACTURING PLANT.

NAIL VALUES

PLATE	GRIP(DRY)	SHEAR	SECTION
(PSI)	(PL)	(PL)	(PSI)
MAX	MIN	MAX	MIN
MT20	650	371	1747
	788	1987	1873

PLATE PLACEMENT TOL. = 0.250 inches

PLATE ROTATION TOL. = 5.0 Deg.

JSI GRIP= 0.88 (B) (INPUT = 0.90)
JSI METAL= 0.61 (B) (INPUT = 1.00)


MODULUS ENGINEERING LTD.

REVIEW FOR TRUSS COMPONENT ONLY
NOTE: ALTERING THIS DOCUMENT
VOIDS THE ENGINEERS SEAL

WARNING - Verify design parameters and READ NOTES ON THIS AND INCLUDED IN MODULUS ENGINEERING LTD. NOTES ME-TC001 (VER 06/2017) BEFORE USE.
Design valid for use only with Mitek connectors. This design is based only upon parameters shown, and is for individual building components. Applicability of design parameters and proper incorporation of component is responsibility of building designer - not truss designer. Bracing shown is for lateral support of individual web members only. Additional temporary bracing to ensure stability during construction is the responsibility of the erector. Additional permanent bracing of the overall structure is the responsibility of the building designer. For general guidance regarding fabrication, quality control, storage, delivery, erection and bracing, consult
TPIC Appendix G - Minimum quality Manufacturing Criteria available from www.tpica.ca and BCSI-CANADA (Building Component Safety Information) available from TPI, 781 N. Lee Street, Suite 312, Alexandria, VA 22314 or www.sbindustry.com




CORPORATION OF THE CITY OF OSHAWA
TRUE COPY
OF PERMIT PLANS
Nov 23 2023
PER: *C. Morris*
CHIEF BUILDING OFFICIAL

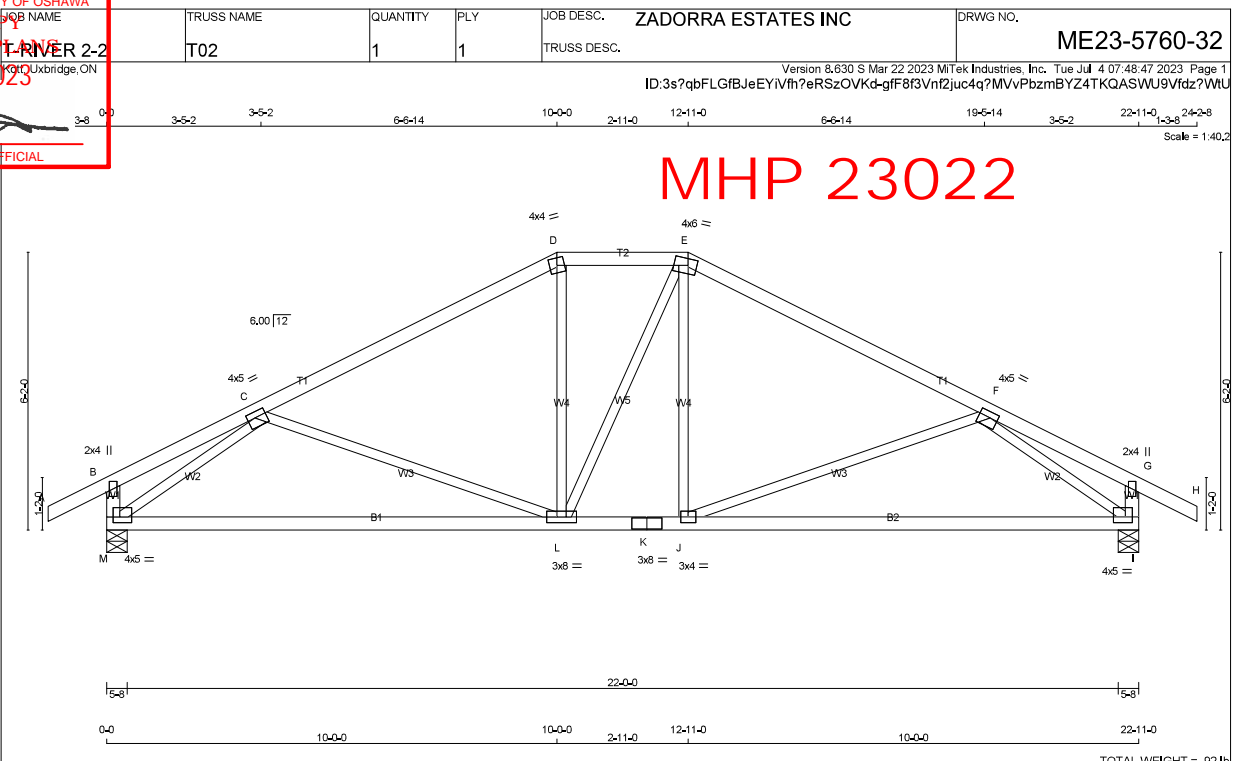

LUMBER N. L. G. A. RULES CHORDS SIZE LUMBER DESCR. A - D 2x4 DRY No.2 SPF D - E 2x4 DRY No.2 SPF E - H 2x4 DRY No.2 SPF M - B 2x4 DRY No.2 SPF I - G 2x4 DRY No.2 SPF M - K 2x4 DRY No.2 SPF K - I 2x4 DRY No.2 SPF ALL WEBS 2x3 DRY No.2 SPF EXCEPT DRY, SEASONED LUMBER.		DIMENSIONS, SUPPORTS AND LOADINGS SPECIFIED BY FABRICATOR TO BE VERIFIED BY BUILDING DESIGNER BEARINGS FACTORED GROSS REACTION MAXIMUM FACTORED INPUT REQD JT VERT HORZ DOWN HORZ UPLIFT IN-SX IN-SX M 1740 0 1740 0 0 5-8 1-14 I 1740 0 1740 0 0 5-8 1-14 UNFACTORED REACTIONS 1ST CASE MAX./MIN. COMPONENT REACTIONS JT COMBINED SNOW LIVE PERM.LIVE WIND DEAD SOIL M 1213 892 / 0 0 / 0 0 / 0 321 / 0 0 / 0 I 1213 892 / 0 0 / 0 0 / 0 321 / 0 0 / 0 BEARING MATERIAL TO BE SPF NO.2 OR BETTER AT JOINT(S) M, I BRACING TOP CHORD TO BE SHEATHED OR MAX. PURLIN SPACING = 4.10 FT. MAX. UNBRACED BOTTOM CHORD LENGTH = 10.00 FT. OR RIGID CEILING DIRECTLY APPLIED. ALL PITCH BREAKS AND PERIMETER CORNER JOINTS MUST BE Laterally RESTRAINED. LOADING TOTAL LOAD CASES: (4) C H O R D S W E B S MEMB. MAX. FACTORED VERT. LOAD (LBS) (PLF) MAX. UNBRACED LENGTH (FT) MEMB. MAX. FACTORED VERT. LOAD (LBS) (PLF) MAX. UNBRACED LENGTH (FT) FR-TO FROM TO FR-TO FROM TO A-B 0 / 36 -119.4 -119.4 0.16 (1) 10.00 C-L -390 / 0 0.42 (1) B-C 0 / 62 -119.4 -119.4 0.64 (1) 10.00 L-D 0 / 269 0.06 (1) C-D -1752 / 0 -119.4 -119.4 0.70 (1) 4.10 L-E 0 / 1 0.00 (1) D-E -1543 / 0 -119.4 -119.4 0.16 (1) 5.16 J-E 0 / 268 0.06 (1) E-F -1752 / 0 -119.4 -119.4 0.70 (1) 4.10 J-F -390 / 0 0.42 (1) F-G 0 / 62 -119.4 -119.4 0.64 (1) 10.00 M-C -2386 / 0 0.70 (1) G-H 0 / 36 -119.4 -119.4 0.16 (1) 10.00 F-I -2386 / 0 0.70 (1) M-B -223 / 0 0.0 0.0 0.02 (1) 7.81 I-G -223 / 0 0.0 0.0 0.02 (1) 7.81 M-L 0 / 1903 -18.2 -18.2 0.52 (1) 10.00 L-K 0 / 1543 -18.2 -18.2 0.50 (4) 10.00 K-J 0 / 1543 -18.2 -18.2 0.50 (4) 10.00 J-I 0 / 1903 -18.2 -18.2 0.53 (1) 10.00		DESIGN CRITERIA SPECIFIED LOADS: TOP CH. LL = 34.8 PSF DL = 6.0 PSF BOT CH. LL = 0.0 PSF DL = 7.3 PSF TOTAL LOAD = 48.1 PSF SPACING = 24.0 IN. GIG LOADING IN FLAT SECTION BASED ON A SLOPE OF 2.00/12 MINIMUM THIS TRUSS IS DESIGNED FOR RESIDENTIAL OR SMALL BUILDING REQUIREMENTS OF PART 9, NBC 2015 THIS DESIGN COMPLIES WITH: - PART 9 OF CBC 2018 - NBC-2019AE - PART 9 OF OBC 2012 (2019 AMENDMENT) - CSA 086-14 - TPIC 2014 (55 % OF 48.1 P.S.F. G.S.L. PLUS 8.4 P.S.F. RAIN LOAD) EQUALS 34.8 P.S.F. SPECIFIED ROOF LIVE LOAD ALLOWABLE DEFL.(LL)= L/360 (0.76") CALCULATED VERT. DEFL.(LL) = L/999 (0.07") ALLOWABLE DEFL.(TL)= L/360 (0.76") CALCULATED VERT. DEFL.(TL) = L/813 (0.34") CSI-TC=0.70/1.00 (C-D-1), BC=0.53/1.00 (I-J-1), WB=0.70/1.00 (C-M-1), SSI=0.33/1.00 (E-F-1) DOL LUMBER=1.00 NAIL=1.00 LS BEND=1.10 COMP=1.10 SHEAR=1.10 TENS=1.10 COMPANION LIVE LOAD FACTOR = 1.00 TRUSS PLATE MANUFACTURER IS NOT RESPONSIBLE FOR QUALITY CONTROL IN THE TRUSS MANUFACTURING PLANT. NAIL VALUES PLATE GRIP(DRY) SHEAR SECTION (PSI) (PLI) (PLI) MAX MIN MAX MIN MAX MIN MT20 650 371 1747 788 1987 1873 PLATE PLACEMENT TOL. = 0.250 inches PLATE ROTATION TOL. = 5.0 Deg. JSI GRIP= 0.88 (K) (INPUT = 0.90) JSI METAL= 0.89 (K) (INPUT = 1.00)	
---	--	--	--	---	--

CORPORATION OF THE CITY OF OSHAWA
TRUE COPY
OF PERMIT PLANS
Nov 23 2023
PER: *C. Monte*
CHIEF BUILDING OFFICIAL

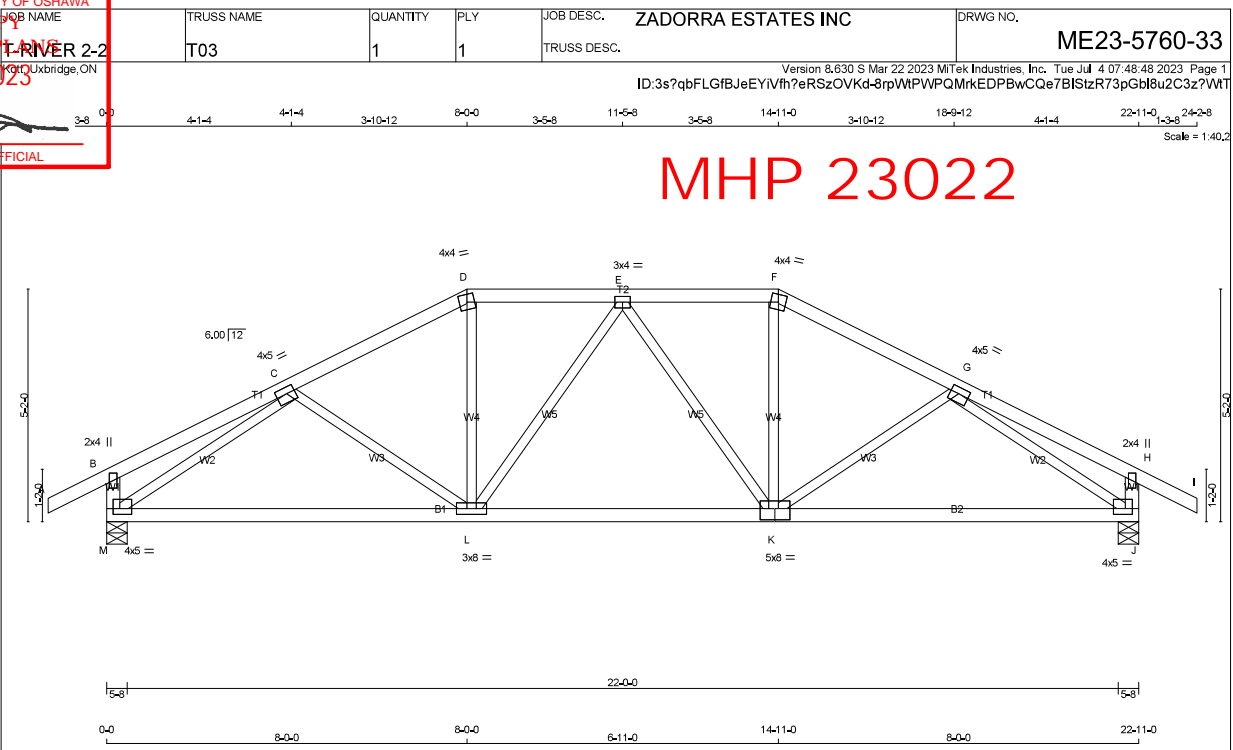

LUMBER
N. L. G. A. RULES
CHORDS SIZE LUMBER DESCR.

A - D	2x4	DRY	No.2	SPF
D - F	2x4	DRY	No.2	SPF
F - I	2x4	DRY	No.2	SPF
M - B	2x4	DRY	No.2	SPF
J - H	2x4	DRY	No.2	SPF
M - K	2x4	DRY	No.2	SPF
K - J	2x4	DRY	No.2	SPF
ALL WEBS EXCEPT	2x3	DRY	No.2	SPF

DRY, SEASONED LUMBER.

PLATES (table is in inches)

JT	TYPE	PLATES	W	LEN	Y	X
B	TMV+p	MT20	2.0	4.0		
C	TMVW-4	MT20	4.0	5.0	1.75	2.25
D	TTVW-m	MT20	4.0	4.0		
E	TMVW-4	MT20	3.0	4.0		
F	TTVW-m	MT20	4.0	4.0		
G	TMVW-4	MT20	4.0	5.0	1.75	2.25
H	TMV+p	MT20	2.0	4.0		
J	BMVW-4	MT20	4.0	5.0	1.50	1.75
K	BSVW-4	MT20	5.0	8.0	3.00	4.00
L	BMVW-4	MT20	3.0	8.0		
M	BMVW-4	MT20	4.0	5.0	1.50	1.75

DIMENSIONS, SUPPORTS AND LOADINGS SPECIFIED BY FABRICATOR TO BE VERIFIED BY BUILDING DESIGNER

FACTORED		MAXIMUM FACTORED		INPUT		REQD	
GROSS REACTION	DOWN	GROSS REACTION	DOWN	BRG	BRG	IN-SX	IN-SX
JT	VERT	JT	VERT	JT	VERT	JT	VERT
M	1740	0	1740	0	0	5-8	1-14
J	1740	0	1740	0	0	5-8	1-14

UNFACTORED REACTIONS

JT	COMBINED	SNOW	LIVE	PERM.LIVE	WIND	DEAD	SOIL
M	1213	892 / 0	0 / 0	0 / 0	0 / 0	321 / 0	0 / 0
J	1213	892 / 0	0 / 0	0 / 0	0 / 0	321 / 0	0 / 0

BEARING MATERIAL TO BE SPF NO.2 OR BETTER AT JOINT(S) M, J

BRACING
TOP CHORD TO BE SHEATHED OR MAX. PURLIN SPACING = 4.60 FT.
MAX. UNBRACED BOTTOM CHORD LENGTH = 10.00 FT. OR RIGID CEILING DIRECTLY APPLIED.
ALL PITCH BREAKS AND PERIMETER CORNER JOINTS MUST BE LATERALLY RESTRAINED.

LOADING

TOTAL LOAD CASES: (4)

CHORDS				WEBS			
MEMB.	MAX. FACTORED FORCE (LBS)	FACTORED VERT. LOAD (PLF)	MAX CSI (LC)	MAX. UNBRAC	MEMB.	MAX. FACTORED FORCE (LBS)	MAX CSI (LC)
FR-TO		FROM TO		LENGTH	FR-TO		
A-B	0 / 36	-119.4 -119.4	0.16 (1)	10.00	C-L	-189 / 19	0.08 (1)
B-C	0 / 23	-119.4 -119.4	0.28 (1)	10.00	L-D	0 / 506	0.11 (1)
C-D	-1933 / 0	-119.4 -119.4	0.26 (1)	4.60	L-E	-281 / 0	0.17 (1)
D-E	-1718 / 0	-119.4 -119.4	0.20 (1)	4.90	E-K	-323 / 0	0.20 (1)
E-F	-1693 / 0	-119.4 -119.4	0.20 (1)	4.93	K-F	0 / 495	0.11 (1)
F-G	-1909 / 0	-119.4 -119.4	0.26 (1)	4.63	K-G	-193 / 14	0.08 (1)
G-H	0 / 23	-119.4 -119.4	0.28 (1)	10.00	M-C	-2288 / 0	0.90 (1)
H-I	0 / 36	-119.4 -119.4	0.16 (1)	10.00	G-J	-2264 / 0	0.89 (1)
M-B	-351 / 0	0.0 0.0	0.04 (1)	7.81			
J-H	-351 / 0	0.0 0.0	0.04 (1)	7.81			
M-L	0 / 1862	-18.2 -18.2	0.45 (1)	10.00			
L-K	0 / 1877	-18.2 -18.2	0.46 (1)	10.00			
K-J	0 / 1843	-18.2 -18.2	0.50 (1)	10.00			

DESIGN CRITERIA

SPECIFIED LOADS:
TOP CH. LL = 34.8 PSF
DL = 6.0 PSF
BOT CH. LL = 0.0 PSF
DL = 7.3 PSF
TOTAL LOAD = 48.1 PSF

SPACING = 24.0 IN. GIG

LOADING IN FLAT SECTION BASED ON A SLOPE OF 2.00/12 MINIMUM

THIS TRUSS IS DESIGNED FOR RESIDENTIAL OR SMALL BUILDING REQUIREMENTS OF PART 9, NBC2015

THIS DESIGN COMPLIES WITH:
- PART 9 OF BCBC 2018, NBC-2019AE
- PART 9 OF OBC 2012 (2019 AMENDMENT)
- CSA 086-14
- TPIC 2014

(55 % OF 48.1 P.S.F. G.S.L. PLUS 8.4 P.S.F. RAIN LOAD) EQUALS 34.8 P.S.F. SPECIFIED ROOF LIVE LOAD

ALLOWABLE DEFL.(LL) = L/360 (0.76")
CALCULATED VERT. DEFL.(LL) = L/999 (0.08")
ALLOWABLE DEFL.(TL) = L/360 (0.76")
CALCULATED VERT. DEFL.(TL) = L/999 (0.26")
CSI: TC=0.28/1.00 (G-H), BC=0.50/1.00 (J-K), WB=0.90/1.00 (C-M), SI=0.20/1.00 (G-H)
DOL LUMBER=1.00 NAIL=1.00 LS BEND=1.10
COMP=1.10 SHEAR=1.10 TENS=1.10
COMPANION LIVE LOAD FACTOR = 1.00

TRUSS PLATE MANUFACTURER IS NOT RESPONSIBLE FOR QUALITY CONTROL IN THE TRUSS MANUFACTURING PLANT.

NAIL VALUES

PLATE	GRIP(DRY)	SHEAR	SECTION
	(PSI)	(PLI)	(PLI)
MT20	MAX MIN	MAX MIN	MAX MIN
	650 371	1747 788	1987 1873


PLATE PLACEMENT TOL. = 0.250 inches
PLATE ROTATION TOL. = 5.0 Deg.
JSI GRIP= 0.88 (K) (INPUT = 0.90)
JSI METAL= 0.59 (C) (INPUT = 1.00)

MODULUS ENGINEERING LTD.

REVIEW FOR TRUSS COMPONENT ONLY
NOTE: ALTERING THIS DOCUMENT
VOIDS THE ENGINEER'S SEAL


WARNING - Verify design parameters and READ NOTES ON THIS AND INCLUDED IN MODULUS ENGINEERING LTD. NOTES ME-TC001 (VER 06/2017) BEFORE USE.
Design valid for use only with Mitek connectors. This design is based only upon parameters shown, and is for individual building components. Applicability of design parameters and proper incorporation of component is responsibility of building designer - not truss designer. Bracing shown is for lateral support of individual web members only. Additional temporary bracing to ensure stability during construction is the responsibility of the erector. Additional permanent bracing of the overall structure is the responsibility of the building designer. For general guidance regarding fabrication, quality control, storage, delivery, erection and bracing, consult
TPIC Appendix G - Minimum quality Manufacturing Criteria available from www.tpica.ca and BCSI-CANADA (Building Component Safety Information) available from TPI, 781 N. Lee Street, Suite 312, Alexandria, VA 22314 or www.sbindustry.com



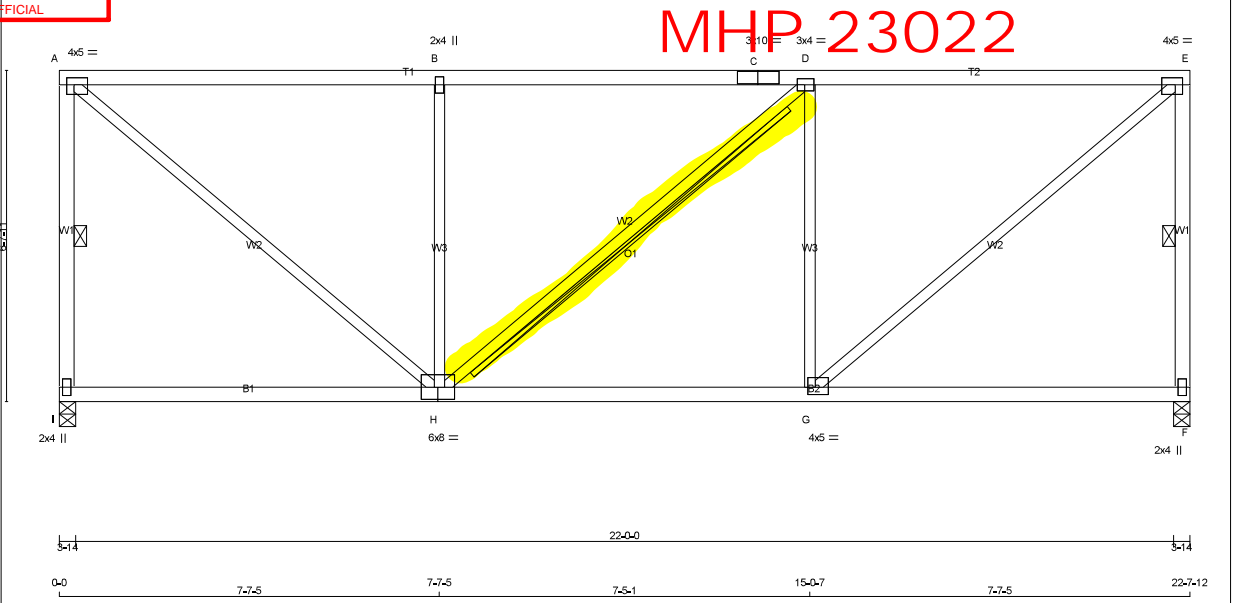

LUMBER N, L, G, A, RULES CHORDS SIZE LUMBER DESCR. SPF					DIMENSIONS, SUPPORTS & LOADINGS SPECIFIED BY FABRICATOR TO BE VERIFIED BY BUILDING DESIGNER					DESIGN CRITERIA				
I - A	2x4	DRY	No.2	SPF	BEARINGS					SPECIFIED LOADS:				
A - C	2x4	DRY	2100F 1,8E	SPF	FACTORED					TOP CH. LL = 34.8 PSF				
C - E	2x4	DRY	2100F 1,8E	SPF	GROSS REACTION					DL = 6.0 PSF				
F - E	2x4	DRY	No.2	SPF	DOWN					BOT CH. LL = 0.0 PSF				
I - H	2x4	DRY	No.2	SPF	UP					DL = 7.3 PSF				
H - F	2x4	DRY	No.2	SPF	REACT					TOTAL LOAD = 48.1 PSF				
ALL WEBS 2x3 DRY SEASONED LUMBER.					SPF					SPACING = 24.0 IN. C/C				
					UNFACTORED REACTIONS					LOADING IN FLAT SECTION BASED ON A SLOPE OF 2.00/12 MINIMUM				
					1ST CASE MAX./MIN. COMPONENT REACTIONS					THIS TRUSS IS DESIGNED FOR RESIDENTIAL OR SMALL BUILDING REQUIREMENTS OF PART 9, NBC2015				
					JT COMBINED SNOW LIVE PERM.LIVE WIND DEAD SOIL					THIS DESIGN COMPLIES WITH:				
					I 1089 788 / 0 0 / 0 0 / 0 301 / 0 0 / 0					- PART 9 OF CBC2018 - NBC-2019AE				
					F 1089 788 / 0 0 / 0 0 / 0 301 / 0 0 / 0					- PART 9 OF OBC 2012 (2019 AMENDMENT)				
										- CSA 086-14				
										- TPIC 2014				
										(55 % OF 48.1 P.S.F. G.S.L. PLUS 8.4 P.S.F. RAIN LOAD) EQUALS 34.8 P.S.F. SPECIFIED ROOF LIVE LOAD				
										ALLOWABLE DEFL.(LL)= L/360 (0.75")				
										CALCULATED VERT. DEFL.(LL) = L/999 (0.06")				
										ALLOWABLE DEFL.(TL)= L/360 (0.75")				
										CALCULATED VERT. DEFL.(TL) = L/999 (0.20")				
										CSI: TC=0.68/1.00 (D-E 1), BC=0.39/1.00 (G-H 4), WB=0.72/1.00 (B-H 1), SSI=0.42/1.00 (D-E 1)				
										DOL LUMBER=1.00 NAIL=1.00 LS BEND=1.10 COMP=1.10 SHEAR=1.10 TENS= 1.10				
										COMPANION LIVE LOAD FACTOR = 1.00				
										TRUSS PLATE MANUFACTURER IS NOT RESPONSIBLE FOR QUALITY CONTROL IN THE TRUSS MANUFACTURING PLANT.				
										NAIL VALUES				
										PLATE GRIP(DRY) SHEAR SECTION				
										(PSI) (PLI) (PLI)				
										MAX MIN MAX MIN MAX MIN				
										MT20 650 371 1747 788 1987 1873				
										PLATE PLACEMENT TOL. = 0.250 inches				
										PLATE ROTATION TOL. = 5.0 Deg.				
										JSI GRIP= 0.88 (D) (INPUT = 0.90)				
										JSI METAL= 0.39 (H) (INPUT = 1.00)				

CORPORATION OF THE CITY OF OSHAWA
TRUE COPY
OF PERMIT PLANS
Nov 23 2023
PER: *C. Monte*
CHIEF BUILDING OFFICIAL

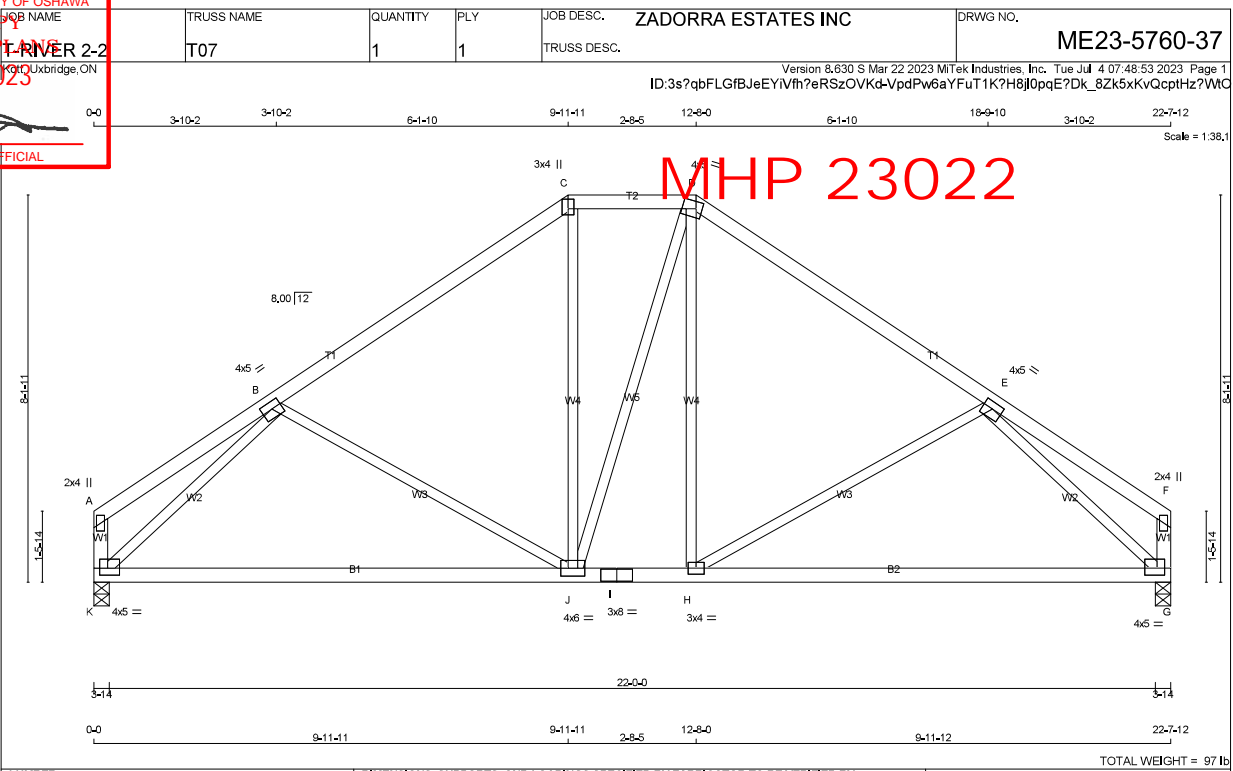

LUMBER
N. L. G. A. RULES
CHORDS SIZE LUMBER DESCR.

A - C	2x4	DRY	No.2	SPF
C - D	2x4	DRY	No.2	SPF
D - F	2x4	DRY	No.2	SPF
K - A	2x4	DRY	No.2	SPF
G - F	2x4	DRY	No.2	SPF
K - I	2x4	DRY	No.2	SPF
I - G	2x4	DRY	No.2	SPF
ALL WEBS EXCEPT	2x3	DRY	No.2	SPF

DRY, SEASONED LUMBER.

PLATES (table is in inches)

JT	TYPE	PLATES	W	LEN	Y	X
A	TMV+p	MT20	2.0	4.0		
B	TMVW+4	MT20	4.0	5.0	1.75	2.50
C	TTW+p	MT20	3.0	4.0	2.50	1.50
D	TTWVW+m	MT20	4.0	5.0	1.75	1.50
E	TMVW+4	MT20	4.0	5.0	1.75	2.50
F	TMV+p	MT20	2.0	4.0		
G	BMVW+4	MT20	4.0	5.0	1.75	2.00
H	BMVW+4	MT20	3.0	4.0		
I	BS+4	MT20	3.0	8.0		
J	BMVWVW+4	MT20	4.0	6.0		
K	BMVW+4	MT20	4.0	5.0	1.75	2.00

DIMENSIONS, SUPPORTS AND LOADINGS SPECIFIED BY FABRICATOR TO BE VERIFIED BY BUILDING DESIGNER

BEARINGS

	FACTORED GROSS REACTION	MAXIMUM FACTORED GROSS REACTION	INPUT BRG	REQRD BRG
JT	VERT	HORZ	DOWN	HORZ
K	1559	0	1559	0
G	1559	0	1559	0

UNFACTORED REACTIONS

JT	1ST CASE	MAX./MIN.	COMPONENT REACTIONS
K	1089	788 / 0	0 / 0
G	1089	788 / 0	0 / 0

BEARING MATERIAL TO BE SPF NO.2 OR BETTER AT JOINT(S) K, G

BRACING
TOP CHORD TO BE SHEATHED OR MAX. PURLIN SPACING = 4.72 FT.
MAX. UNBRACED BOTTOM CHORD LENGTH = 10.00 FT. OR RIGID CEILING DIRECTLY APPLIED.
ALL PITCH BREAKS AND PERIMETER CORNER JOINTS MUST BE LATERALLY RESTRAINED.

LOADING
TOTAL LOAD CASES: (4)

CHORDS	MEMB.	MAX. FACTORED FORCE (LBS)	VERT. LOAD (PLF)	LC1	MAX. FACTORED FORCE (LBS)	VERT. LOAD (PLF)	LC1
FR-TO	FROM	TO	FROM	TO	FROM	TO	FROM
A-B	0 / 62	-119.4	-119.4	0.58 (1)	10.00	B-J	-315 / 0
B-C	-1395 / 0	-119.4	-119.4	0.59 (1)	4.72	J-C	0 / 289
C-D	-1132 / 0	-119.4	-119.4	0.12 (1)	5.84	D-D	0 / 2
D-E	-1394 / 0	-119.4	-119.4	0.59 (1)	4.72	H-D	0 / 287
E-F	0 / 62	-119.4	-119.4	0.58 (1)	10.00	H-E	-316 / 0
K-A	-110 / 0	0.0	0.0	0.01 (1)	7.81	K-B	-1962 / 0
G-F	-111 / 0	0.0	0.0	0.01 (1)	7.81	E-G	-1961 / 0
K-J	0 / 1401	-18.2	-18.2	0.48 (4)	10.00		
J-I	0 / 1131	-18.2	-18.2	0.48 (4)	10.00		
I-H	0 / 1131	-18.2	-18.2	0.48 (4)	10.00		
H-G	0 / 1401	-18.2	-18.2	0.48 (4)	10.00		

DESIGN CRITERIA

SPECIFIED LOADS:
TOP CH. LL = 34.8 PSF
DL = 6.0 PSF
BOT CH. LL = 0.0 PSF
DL = 7.3 PSF
TOTAL LOAD = 48.1 PSF

SPACING = 24.0 IN. G/G

LOADING IN FLAT SECTION BASED ON A SLOPE OF 2.00/12 MINIMUM

THIS TRUSS IS DESIGNED FOR RESIDENTIAL OR SMALL BUILDING REQUIREMENTS OF PART 9, NBC 2015

THIS DESIGN COMPLIES WITH:
- PART 9 OF CBC 2018 - NBC-2019AE
- PART 9 OF OBC 2012 (2019 AMENDMENT)
- CSA 086-14
- TPIC 2014

(55 % OF 48.1 P.S.F. G.S.L. PLUS 8.4 P.S.F. RAIN LOAD) EQUALS 34.8 P.S.F. SPECIFIED ROOF LIVE LOAD

ALLOWABLE DEFL.(LL) = L/360 (0.75")
CALCULATED VERT. DEFL.(LL) = L/999 (0.05")
ALLOWABLE DEFL.(TL) = L/360 (0.75")
CALCULATED VERT. DEFL.(TL) = L/873 (0.31")

CSI: TC=0.59/1.00 (D-E-1), BC=0.48/1.00 (L-K-4), WB=0.88/1.00 (E-G-1), SS=0.29/1.00 (D-E-1)

DOL LUMBER=1.00 NAIL=1.00 LS BEND=1.10 COMP=1.10 SHEAR=1.10 TENS=1.10

COMPANION LIVE LOAD FACTOR = 1.00

TRUSS PLATE MANUFACTURER IS NOT RESPONSIBLE FOR QUALITY CONTROL IN THE TRUSS MANUFACTURING PLANT.

NAIL VALUES
PLATE GRIP(DRY) SHEAR SECTION (PSI) (PLI) (PLI)
MAX MIN MAX MIN MAX MIN
MT20 650 371 1747 788 1987 1873

PLATE PLACEMENT TOL. = 0.250 inches

PLATE ROTATION TOL. = 5.0 Deg.


JSI GRIP= 0.89 (I) (INPUT = 0.90)
JSI METAL= 0.86 (I) (INPUT = 1.00)

MODULUS ENGINEERING LTD.

REVIEW FOR TRUSS COMPONENT ONLY

NOTE: ALTERING THIS DOCUMENT VOIDS THE ENGINEER'S SEAL

CORPORATION OF THE CITY OF OSHAWA
TRUE COPY OF PERMIT PLANS
Nov 23 2023
PER: 
CHIEF BUILDING OFFICIAL

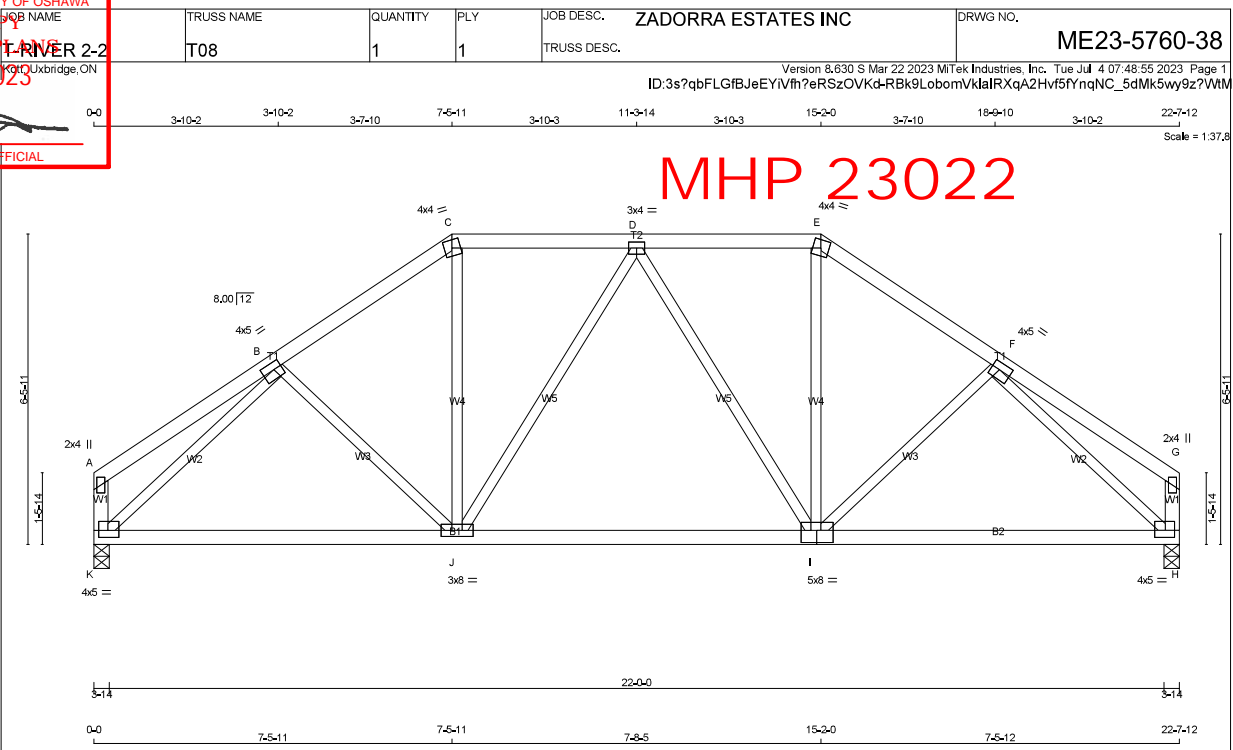

LUMBER

N, L, G, A, RULES	CHORDS	SIZE	LUMBER	DESCR.
A - C	2x4	DRY	No.2	SPF
C - E	2x4	DRY	No.2	SPF
E - G	2x4	DRY	No.2	SPF
K - A	2x4	DRY	No.2	SPF
H - G	2x4	DRY	No.2	SPF
K - I	2x4	DRY	No.2	SPF
I - H	2x4	DRY	No.2	SPF
ALL WEBS EXCEPT	2x3	DRY	No.2	SPF

DRY, SEASONED LUMBER.

PLATES (table is in inches)

JT	TYPE	PLATES	W	LEN	Y	X
A	TMV+p	MT20	2.0	4.0		
B	TMVW-4	MT20	4.0	5.0	1.75	2.00
C	TTVW-m	MT20	4.0	4.0		
D	TMVW-4	MT20	3.0	4.0		
E	TTVW-m	MT20	4.0	4.0		
F	TMVW-4	MT20	4.0	5.0	1.75	2.00
G	TMV+p	MT20	2.0	4.0		
H	BMVW-4	MT20	4.0	5.0	1.75	2.25
I	BSVW-4	MT20	5.0	8.0	3.00	4.00
J	BMVW-4	MT20	3.0	8.0		
K	BMVW-4	MT20	4.0	5.0	1.75	2.25

DIMENSIONS, SUPPORTS AND LOADINGS SPECIFIED BY FABRICATOR TO BE VERIFIED BY BUILDING DESIGNER

BEARINGS

	FACTORED GROSS REACTION	MAXIMUM FACTORED GROSS REACTION	INPUT BRG	REQRD BRG
JT	VERT	DOWN	HORZ	UPLIFT
K	1559	0	1559	0
H	1559	0	1559	0

UNFACTORED REACTIONS

JT	1ST CASE	MAX./MIN.	COMPONENT REACTIONS
K	1089	788 / 0	0 / 0
H	1089	788 / 0	0 / 0

BEARING MATERIAL TO BE SPF NO.2 OR BETTER AT JOINT(S) K, H

BRACING

TOP CHORD TO BE SHEATHED OR MAX. PURLIN SPACING = 5.05 FT.
MAX. UNBRACED BOTTOM CHORD LENGTH = 10.00 FT. OR RIGID CEILING DIRECTLY APPLIED.

ALL PITCH BREAKS AND PERIMETER CORNER JOINTS MUST BE LATERALLY RESTRAINED.

LOADING

TOTAL LOAD CASES: (4)

C H O R D S				W E B S			
MEMB.	FORCE (LBS)	FACTORED VERT. LOAD (PLF)	MAX. CSI (LC)	MEMB.	FORCE (LBS)	FACTORED MAX. CSI (LC)	
FR-TO		FROM	TO	FR-TO		FROM	TO
A-B	0 / 27	-119.4	-119.4	0.25 (1)	10.00	B-J	-105 / 27
B-C	-1571 / 0	-119.4	-119.4	0.22 (1)	5.05	J-C	0 / 504
C-D	-1291 / 0	-119.4	-119.4	0.23 (1)	5.43	J-D	-306 / 0
D-E	-1270 / 0	-119.4	-119.4	0.23 (1)	5.46	D-I	-344 / 0
E-F	-1549 / 0	-119.4	-119.4	0.22 (1)	5.07	I-E	0 / 491
F-G	0 / 27	-119.4	-119.4	0.25 (1)	10.00	I-F	-110 / 22
K-A	-173 / 0	0.0	0.0	0.02 (1)	7.81	K-B	-1903 / 0
H-G	-173 / 0	0.0	0.0	0.02 (1)	7.81	F-H	-1881 / 0
K-J	0 / 1358	-18.2	-18.2	0.38 (4)	10.00		
J-I	0 / 1449	-18.2	-18.2	0.40 (1)	10.00		
I-H	0 / 1343	-18.2	-18.2	0.39 (1)	10.00		

DESIGN CRITERIA

SPECIFIED LOADS:

TOP CH.	LL	=	34.8	PSF
	DL	=	6.0	PSF
BOT CH.	LL	=	0.0	PSF
	DL	=	7.3	PSF
TOTAL LOAD		=	48.1	PSF

SPACING = 24.0 IN. GIG

LOADING IN FLAT SECTION BASED ON A SLOPE OF 2.00/12 MINIMUM

THIS TRUSS IS DESIGNED FOR RESIDENTIAL OR SMALL BUILDING REQUIREMENTS OF PART 9, NBC 2015

THIS DESIGN COMPLIES WITH:
- PART 9 OF BCBC 2018, NBC-2019AE
- PART 9 OF OBC 2012 (2019 AMENDMENT)
- CSA 086-14
- TPIC 2014

(55 % OF 48.1 P.S.F., G.S.L. PLUS 8.4 P.S.F., RAIN LOAD) EQUALS 34.8 P.S.F., SPECIFIED ROOF LIVE LOAD

ALLOWABLE DEFL.(LL)= L/360 (0.75")
CALCULATED VERT. DEFL.(LL) = L/999 (0.05")
ALLOWABLE DEFL.(TL)= L/360 (0.75")
CALCULATED VERT. DEFL.(TL) = L/999 (0.19")

CSI: TC=0.25/1.00 (F-G:1), BC=0.40/1.00 (I-J:1), WB=0.83/1.00 (B-K:1), SSI=0.22/1.00 (D-E:1)

DOL LUMBER=1.00 NAIL=1.00 LS BEND=1.10
COMP=1.10 SHEAR=1.10 TENS=1.10

COMPANION LIVE LOAD FACTOR = 1.00

TRUSS PLATE MANUFACTURER IS NOT RESPONSIBLE FOR QUALITY CONTROL IN THE TRUSS MANUFACTURING PLANT.

NAIL VALUES

PLATE	GRIP(DRY)	SHEAR	SECTION
	(PSI)	(PLI)	(PLI)
MAX	MIN	MAX	MIN
MT20	650	371	1747

PLATE PLACEMENT TOL. = 0.250 inches

PLATE ROTATION TOL. = 5.0 Deg.

JSI GRIP= 0.90 (H) (INPUT = 0.90)
JSI METAL= 0.50 (F) (INPUT = 1.00)

MODULUS ENGINEERING LTD.



REVIEW FOR TRUSS COMPONENT ONLY

NOTE: ALTERING THIS DOCUMENT
VOIDS THE ENGINEER'S SEAL

WARNING - Verify design parameters and READ NOTES ON THIS AND INCLUDED IN MODULUS ENGINEERING LTD. NOTES ME-TC001 (VER 06/2017) BEFORE USE.

Design valid for use only with Mitek connectors. This design is based only upon parameters shown, and is for individual building components. Applicability of design parameters and proper incorporation of component is responsibility of building designer - not truss designer. Bracing shown is for lateral support of individual web members only. Additional temporary bracing to ensure stability during construction is the responsibility of the erector. Additional permanent bracing of the overall structure is the responsibility of the building designer. For general guidance regarding fabrication, quality control, storage, delivery, erection and bracing, consult

TPIC Appendix G - Minimum quality Manufacturing Criteria available from www.tpica.ca and BCSI-CANADA (Building Component Safety Information) available from TPI, 781 N. Lee Street, Suite 312, Alexandria, VA 22314 or www.sbindustry.com



