

SITE NAME: TRINIGROUP										DATE: Jun-23										WINTER NATURAL AIR CHANGE RATE 0.352										HEAT LOSS ΔT °F. 78										CSA-F280-12	
BUILDER: GREENPARK HOMES										TYPE: ROSE 9										GFA: 3466										LO# 101702										SUMMER NATURAL AIR CHANGE RATE 0.110										HEAT GAIN ΔT °F. 13										SB-12 PACKAGE A1	
ROOM USE				MBR				ENS				WIC				BED-2				BED-3				BED-4				ENS-2				ENS-3				WIC-3				ENS-4				ENS-WC	
EXP. WALL				47				8				0				14				26				34				5				22				5				17				8	
CLG. HT.				9				9				9				9				9				9				9				9				9				9				9	
FACTORS	
GRS.WALL AREA		LOSS GAIN		423				72				0				126				234				306				45				198				45				153				72	
GLAZING				LOSS GAIN				LOSS GAIN				LOSS GAIN				LOSS GAIN				LOSS GAIN				LOSS GAIN				LOSS GAIN				LOSS GAIN				LOSS GAIN				LOSS GAIN				LOSS GAIN	
NORTH		21.8	16.0	0	0	0	0	0	0	0	0	0	0	0	0	18	392	288	0	0	0	0	0	0	0	0	0	8	174	128	0	0	ROOM USE		HOME		LIV/DIN		KIT		FAM		LAUN		FOY		MUD		WOD		BAS	
EXP. WALL		21		35		47		33		34		9		24		60		184	
CLG. HT.		10		10		10		10		10		10		10		9		9	
FACTORS																			
GRS.WALL AREA	LOSS GAIN	210		350		470		330		340		90		240		540		1284	
GLAZING																			
NORTH	21.8 16.0	0 0 0		28 610 447		0 0 0		0 0 0		0 0 0		0 0 0		0 0 0		0 0 0		0 0 0	
EAST	21.8 41.6	28 610 1163		45 980 1870		0 0 0		0 0 0		0 0 0		45 980 1870		0 0 0		0 0 0		0 0 0	
SOUTH	21.8 24.9	0 0 0		0 0 0		0 0 0		0 0 0		0 0 0		0 0 0		0 0 0		0 0 0		0 0 0	
WEST	21.8 41.6	0 0 0		0 0 0		62 1351 2576		40 871 1662		11 240 457		0 0 0		0 0 0		14 305 582		0 0 0	
SKYLT.	38.1 101.5	0 0 0		0 0 0		0 0 0		0 0 0		0 0 0		0 0 0		0 0 0		0 0 0		0 0 0	
DOORS	20.5 3.4	0 0 0		0 0 0		0 0 0		0 0 0		0 0 0		0 0 0		0 0 0		0 0 0		0 0 0	
NET EXPOSED WALL	4.6 0.8	182 831 137		277 1265 208		408 1864 307		290 1325 218		329 1503 247		45 206 34		240 1096 180		0 0 0		0 0 0	
NET EXPOSED BSMT WALL ABOVE GR	3.7 0.6	0 0 0		0 0 0		0 0 0		0 0 0		0 0 0		0 0 0		0 0 0		0 0 0		0 0 0	
EXPOSED CLG	1.3 0.6	0 0 0		0 0 0		0 0 0		0 0 0		0 0 0		0 0 0		0 0 0		0 0 0		0 0 0	
NO ATTIC EXPOSED CLG	2.8 1.3	0 0 0		0 0 0		0 0 0		0 0 0		0 0 0		0 0 0		0 0 0		0 0 0		0 0 0	
EXPOSED FLOOR	2.6 0.4	0 0 0		0 0 0		0 0 0		0 0 0		0 0 0		0 0 0		0 0 0		0 0 0		0 0 0	
BASEMENT/CRAWL HEAT LOSS		0		0		0		0		0		0		0		0		0	
SLAB ON GRADE HEAT LOSS		0		0		0		0		0		0		0		0		0	
SUBTOTAL HT LOSS		1441		2856		3215		2196		1743		1186		1096		0		5330	
SUB TOTAL HT GAIN		1300		2525		2883		1880		704		1904		180		1580		7796	
LEVEL FACTOR / MULTIPLIER	0.30 0.51			0.30 0.51		0.30 0.51		0.30 0.51		0.30 0.51		0.30 0.51		0.30 0.51		0.50 1.23		289	
AIR CHANGE HEAT LOSS		729		1444		1625		1110		881		600		554		0		11572	
AIR CHANGE HEAT GAIN		75		147		167		109		41		110		10		0		63	
DUCT LOSS		0		0		0		0		0		0		0		0		0	
DUCT GAIN		0		0		0		0		0		0		0		0		0	
HEAT GAIN PEOPLE	240	0		0		0		0		0		0		0		0		0	
HEAT GAIN APPLIANCES/LIGHTS		644		644		644		644		644		0		0		0		644	
TOTAL HT LOSS BTU/H		2170		4300		4840		3307		2624		1785		1651		1580		19368	
TOTAL HT GAIN x 1.3 BTU/H		2626		4311		4803		3423		1806		2618		248		1029		1295	


TOTAL HEAT GAIN BTU/H: 45450

TONS: 3.79

LOSS DUE TO VENTILATION LOAD BTU/H: 1670

STRUCTURAL HEAT LOSS: 62332

TOTAL COMBINED HEAT LOSS BTU/H: 64002

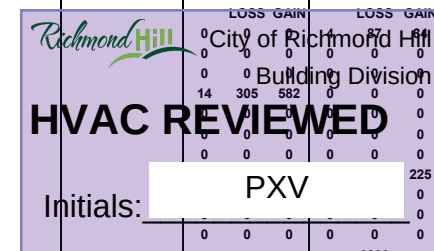
CITY OF RICHMOND HILL
BUILDING DIVISION

05/01/2024

SITE NAME: TRINIGROUP

BUILDER: GREENPARK HOMES

TYPE: ROSE 9

DATE: Jun-23

GFA: 3466

LO# 101702

HEATING CFM 1504 COOLING CFM 1504
TOTAL HEAT LOSS 62,332 TOTAL HEAT GAIN 45,175
AIR FLOW RATE CFM 24.13 AIR FLOW RATE CFM 33.29

furnace pressure 0.6
furnace filter 0.05
a/c coil pressure 0.2
available pressure
for s/a & r/a 0.35

#*GOODMAN

AFUE = 96 %

GMEC960804CNA

80

INPUT (BTU/H) = 80,000

FAN SPEED

OUTPUT (BTU/H) = 76,800

LOW

868

MEDLOW

978

MEDIUM

1112

MEDIUM HIGH

1504

HIGH

1615

DESIGN CFM = 1504
CFM @ .6" E.S.P.

TEMPERATURE RISE 47 °F


RUN COUNT	4th	3rd	2nd	1st	Bas
S/A	0	0	15	10	5
R/A	0	0	5	2	1

All S/A diffusers 4"x10" unless noted otherwise on layout.

All S/A runs 5"Ø unless noted otherwise on layout.

RUN #	1	2	3	4	5	6	7	8	9	10	11	12	13	14	15	16	17	18	19	20	21	22	23	24
ROOM NAME	MBR	ENS	WIC	BED-2	BED-3	BED-4	ENS-2	ENS-3	WIC-3	MBR	ENS-4	HOME	LIV/DIN	KIT	KIT	FAM	LAUN	LIV/DIN	FOY	MUD	BAS	BAS	BAS	BAS
RM LOSS MBH.	2.24	1.08	0.13	1.61	1.36	1.63	0.54	2.51	0.86	2.24	1.23	2.17	2.15	2.42	2.42	1.65	2.62	2.15	1.79	1.65	4.19	4.19	4.19	4.19
CFM PER RUN HEAT	54	26	3	39	33	39	13	60	21	54	30	52	52	58	58	40	63	52	43	40	101	101	101	101
RM GAIN MBH.	2.69	1.21	0.06	1.87	1.88	1.84	0.26	3.07	0.87	2.69	0.49	2.63	2.16	2.40	2.40	1.71	1.81	2.16	2.62	0.25	0.46	0.46	0.46	0.46
CFM PER RUN COOLING	90	40	2	62	63	61	9	102	29	90	16	87	72	80	80	57	60	72	87	8	15	15	15	15
ADJUSTED PRESSURE	0.16	0.17	0.17	0.17	0.17	0.17	0.17	0.16	0.17	0.16	0.17	0.16	0.17	0.17	0.17	0.17	0.17	0.17	0.16	0.17	0.16	0.16	0.16	0.16
ACTUAL DUCT LGH.	38	53	43	36	61	56	18	48	50	48	69	43	23	22	32	38	51	11	30	42	41	24	14	10
EQUIVALENT LENGTH	110	140	160	170	180	130	120	160	130	150	170	150	100	130	170	190	150	120	120	110	160	120	140	130
TOTAL EFFECTIVE LENGTH	148	193	203	206	241	186	138	208	180	198	239	193	123	152	202	228	201	131	150	152	201	144	154	140
ADJUSTED PRESSURE	0.11	0.09	0.08	0.08	0.07	0.09	0.12	0.08	0.1	0.08	0.07	0.08	0.14	0.11	0.09	0.08	0.09	0.13	0.11	0.11	0.08	0.11	0.11	0.12
ROUND DUCT SIZE	6	4	4	5	6	6	4	6	4	6	4	6	5	5	5	5	5	5	6	4	6	6	6	6
HEATING VELOCITY (ft/min)	275	298	34	286	168	199	149	306	241	275	344	265	382	426	426	294	463	382	219	459	515	515	515	515
COOLING VELOCITY (ft/min)	459	459	23	455	321	311	103	520	333	459	184	444	582	587	587	419	441	529	444	92	76	76	76	76
OUTLET GRILL SIZE	4X10	3X10	3X10	3X10	4X10	4X10	3X10	4X10	3X10	4X10	3X10	4X10	3X10	3X10	3X10	3X10	3X10	3X10	4X10	3X10	4X10	4X10	4X10	4X10
TRUNK	C	B	B	E	D	B	E	D	B	C	A	D	D	C	B	B	A	E	D	A	B	C	C	E

RUN #	25	26	27	28	29	30
ROOM NAME	ENS-WC	BED-3	BED-4	FAM	BED-4	BAS
RM LOSS MBH.	0.65	1.36	1.63	1.65	1.63	4.19
CFM PER RUN HEAT	16	33	39	40	39	101
RM GAIN MBH.	0.55	1.88	1.84	1.71	1.84	0.46
CFM PER RUN COOLING	18	63	61	57	61	15
ADJUSTED PRESSURE	0.17	0.17	0.17	0.17	0.17	0.16
ACTUAL DUCT LGH.	59	62	60	48	43	8
EQUIVALENT LENGTH	170	210	190	140	120	130
TOTAL EFFECTIVE LENGTH	229	272	250	188	163	138
ADJUSTED PRESSURE	0.08	0.06	0.07	0.09	0.11	0.12
ROUND DUCT SIZE	4	6	5	5	5	6
HEATING VELOCITY (ft/min)	184	168	286	294	286	515
COOLING VELOCITY (ft/min)	207	321	448	419	448	76
OUTLET GRILL SIZE	3X10	4X10	3X10	3X10	3X10	4X10
TRUNK	A	D	A	A	E	E

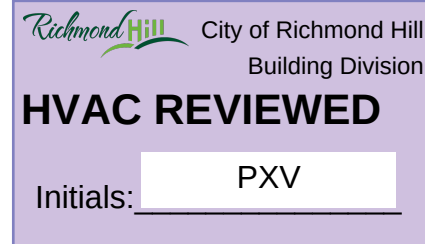

SUPPLY AIR TRUNK SIZE							RETURN AIR TRUNK SIZE						
TRUNK	STATIC	ROUND	RECT	VELOCITY			TRUNK	STATIC	ROUND	RECT	VELOCITY		
CFM	PRESS.	DUCT	DUCT	(ft/min)			CFM	PRESS.	DUCT	DUCT	(ft/min)		
TRUNK A	269	0.07	8.9	10	x	8	484	0	0.00	0	0	x	8
TRUNK B	640	0.07	12.3	18	x	8	640	0	0.00	0	0	x	8
TRUNK C	1102	0.07	15	26	x	8	763	0	0.00	0	0	x	8
TRUNK D	474	0.06	11.4	16	x	8	533	0	0.00	0	0	x	8
TRUNK E	884	0.06	14.4	24	x	8	663	0	0.00	0	0	x	8
TRUNK F	0	0.00	0	0	x	8	0	0.00	0	0	0	x	8

RETURN AIR #	1	2	3	4	5	6	7	8	9	10	11	12	13	14	15	16	17	18	19	20	21	22	23	24
AIR VOLUME	140	140	140	120	125	300	300	0	0	0	0	0	0	0	0	0	0	0	0	0	0	0	0	0
PLENUM PRESSURE	0.15	0.15	0.15	0.15	0.15	0.15	0.15	0.15	0.15	0.15	0.15	0.15	0.15	0.15	0.15	0.15	0.15	0.15	0.15	0.15	0.15	0.15	0.15	0.15
ACTUAL DUCT LGH.	47	44	48	59	53	21	57	1	1	1	1	1	1	1	1	1	1	1	1	1	1	1	1	1
EQUIVALENT LENGTH	165	155	145	175	195	145	150	0	0	0	0	0	0	0	0	0	0	0	0	0	0	0	0	0
TOTAL EFFECTIVE LH	212	199	193	234	248	166	207	1	1	1	1	1	1	1	1	1	1	1	1	1	1	1	1	1
ADJUSTED PRESSURE	0.07	0.07	0.08	0.06	0.06	0.09	0.07	14.80	14.80	14.80	14.80	14.80	14.80	14.80	14.80	14.80	14.80	14.80	14.80	14.80	14.80	14.80	14.80	14.80
ROUND DUCT SIZE	6.9	6.9	6.7	6.8	6.9	8.7	9.2	0	0	0	0	0	0	0	0	0	0	0	0	0	0	0	0	0
INLET GRILL SIZE	8	8	8	8	8	8	8	0	0	0	0	0	0	0	0	0	0	0	0	0	0	0	0	0
INLET GRILL SIZE	X	X	X	X	X	X	X	X	X	X	X	X	X	X	X	X	X	X	X	X	X	X	X	X
INLET GRILL SIZE	14	14	14	14	14	30	30	0	0	0	0	0	0	0	0	0	0	0	0	0	0	0	0	0

CITY OF RICHMOND HILL
BUILDING DIVISION

05/01/2024

RECEIVED
Per: joshua.nabua

TYPE: ROSE 9
SITE NAME: TRINIGROUP

LO # 101702

RESIDENTIAL MECHANICAL VENTILATION DESIGN SUMMARY

COMBUSTION APPLIANCES	9.32.3.1(1)
a) ☒ Direct vent (sealed combustion) only	
b) ☐ Positive venting induced draft (except fireplaces)	
c) ☐ Natural draft, B-vent or induced draft gas fireplace	
d) ☐ Solid Fuel (including fireplaces)	
e) ☐ No Combustion Appliances	

HEATING SYSTEM
☒ Forced Air ☐ Non Forced Air
☐ Electric Space Heat

HOUSE TYPE	9.32.1(2)
☒ I Type a) or b) appliance only, no solid fuel	
☐ II Type I except with solid fuel (including fireplaces)	
☐ III Any Type c) appliance	
☐ IV Type I, or II with electric space heat	
☐ Other: Type I, II or IV no forced air	

SYSTEM DESIGN OPTIONS	O.N.H.W.P.
☐ 1 Exhaust only/Forced Air System	
☐ 2 HRV with Ducting/Forced Air System	
☒ 3 HRV Simplified/connected to forced air system	
☐ 4 HRV with Ducting/non forced air system	
☐ Part 6 Design	

TOTAL VENTILATION CAPACITY	9.32.3.3(1)
Basement + Master Bedroom	<u>2</u> @ 21.2 cfm <u>42.4</u> cfm
Other Bedrooms	<u>3</u> @ 10.6 cfm <u>31.8</u> cfm
Kitchen & Bathrooms	<u>6</u> @ 10.6 cfm <u>63.6</u> cfm
Other Rooms	<u>6</u> @ 10.6 cfm <u>63.6</u> cfm
Table 9.32.3.A.	TOTAL <u>201.4</u> cfm

PRINCIPAL VENTILATION CAPACITY REQUIRED	9.32.3.4.(1)
1 Bedroom	31.8 cfm
2 Bedroom	47.7 cfm
3 Bedroom	63.6 cfm
4 Bedroom	79.5 cfm
5 Bedroom	95.4 cfm
TOTAL	79.5 cfm

SUPPLEMENTAL VENTILATION CAPACITY	9.32.3.5.
Total Ventilation Capacity	<u>201.4</u> cfm
Less Principal Ventil. Capacity	<u>79.5</u> cfm
Required Supplemental Capacity	<u>121.9</u> cfm

PRINCIPAL EXHAUST FAN CAPACITY
Model: VANEE V150H Location: BSMT
<u>79.5</u> cfm ☒ HVI Approved

PRINCIPAL EXHAUST HEAT LOSS CALCULATION
CFM ΔT °F FACTOR % LOSS
79.5 CFM X 78 F X 1.08 X 0.25

SUPPLEMENTAL FANS	BY INSTALLING CONTRACTOR
Location Model cfm HVI Sones	
ENS BY INSTALLING CONTRACTOR 50 ☒ 3.5	
ENS-2 BY INSTALLING CONTRACTOR 50 ☒ 3.5	
ENS-4 BY INSTALLING CONTRACTOR 50 ☒ 3.5	

HEAT RECOVERY VENTILATOR	9.32.3.11.
Model: VANEE V150H	
<u>150</u> cfm high <u>35</u> cfm low	
<u>75</u> % Sensible Efficiency ☒ HVI Approved	
@ 32 deg F (0 deg C)	

LOCATION OF INSTALLATION
Lot: Concession
Township Plan:
Address
Roll # Building Permit #


BUILDER:	GREENPARK HOMES
Name:	
Address:	
City:	
Telephone #: Fax #:	

INSTALLING CONTRACTOR	
Name:	
Address:	
City:	
Telephone #: Fax #:	

DESIGNER CERTIFICATION
I hereby certify that this ventilation system has been designed in accordance with the Ontario Building Code.
Name: HVAC Designs Ltd.
Signature: <i>Michael O'Rourke</i>
HRAI # 001820
Date: June-23

I REVIEW AND TAKE RESPONSIBILITY FOR THE DESIGN WORK AND AM QUALIFIED IN THE APPROPRIATE CATEGORY AS AN "OTHER DESIGNER" UNDER DIVISION C, 3.2.5 OF THE BUILDING CODE.
INDIVIDUAL BCIN: 19669 *Michael O'Rourke* MICHAEL O'ROURKECITY OF RICHMOND HILL
BUILDING DIVISION
05/01/2024
RECEIVED
Per: joshua.nabua

CSA F280-12 Residential Heat Loss and Heat Gain Calculations	
Formula Sheet (For Air Leakage / Ventilation Calculation)	
LO#: 101702		Model: ROSE 9		Builder: GREENPARK HOMES	
				Date: 6/28/2023	
Volume Calculation			Air Change & Delta T Data	
House Volume <table border="1" style="width:100%; border-collapse: collapse;"> <thead> <tr> <th>Level</th> <th>Floor Area (ft²)</th> <th>Floor Height (ft)</th> <th>Volume (ft³)</th> </tr> </thead> <tbody> <tr><td>Bsmt</td><td>1606</td><td>9</td><td>14454</td></tr> <tr><td>First</td><td>1606</td><td>10</td><td>16060</td></tr> <tr><td>Second</td><td>1860</td><td>9</td><td>16740</td></tr> <tr><td>Third</td><td>0</td><td>9</td><td>0</td></tr> <tr><td>Fourth</td><td>0</td><td>9</td><td>0</td></tr> <tr><td colspan="3" style="text-align: right;">Total:</td><td>47,254.0 ft³</td></tr> <tr><td colspan="3" style="text-align: right;">Total:</td><td>1338.1 m³</td></tr> </tbody> </table>			Level	Floor Area (ft²)	Floor Height (ft)	Volume (ft³)	Bsmt	1606	9	14454	First	1606	10	16060	Second	1860	9	16740	Third	0	9	0	Fourth	0	9	0	Total:			47,254.0 ft³	Total:			1338.1 m³	<table border="1" style="width:100%; border-collapse: collapse;"> <tr> <td style="width: 80%;">WINTER NATURAL AIR CHANGE RATE</td> <td style="width: 20%;">0.352</td> </tr> <tr> <td>SUMMER NATURAL AIR CHANGE RATE</td> <td>0.110</td> </tr> </table> <table border="1" style="width:100%; border-collapse: collapse;"> <tr> <th colspan="5" style="text-align: center;">Design Temperature Difference</th> </tr> <tr> <th></th> <th>Tin °C</th> <th>Tout °C</th> <th>ΔT °C</th> <th>ΔT °F</th> </tr> <tr> <td>Winter DTDh</td> <td>22</td> <td>-21</td> <td>43</td> <td>78</td> </tr> <tr> <td>Summer DTDc</td> <td>24</td> <td>31</td> <td>7</td> <td>13</td> </tr> </table>		WINTER NATURAL AIR CHANGE RATE	0.352	SUMMER NATURAL AIR CHANGE RATE	0.110	Design Temperature Difference						Tin °C	Tout °C	ΔT °C	ΔT °F	Winter DTDh	22	-21	43	78	Summer DTDc	24	31	7	13
Level	Floor Area (ft²)	Floor Height (ft)	Volume (ft³)	
Bsmt	1606	9	14454	
First	1606	10	16060	
Second	1860	9	16740	
Third	0	9	0	
Fourth	0	9	0	
Total:			47,254.0 ft³	
Total:			1338.1 m³	
WINTER NATURAL AIR CHANGE RATE	0.352	
SUMMER NATURAL AIR CHANGE RATE	0.110	
Design Temperature Difference	
	Tin °C	Tout °C	ΔT °C	ΔT °F	
Winter DTDh	22	-21	43	78	
Summer DTDc	24	31	7	13	
5.2.3.1 Heat Loss due to Air Leakage			6.2.6 Sensible Gain due to Air Leakage	
$HL_{airb} = LR_{airh} \times \frac{V_b}{3.6} \times DTD_h \times 1.2$ 0.352 x 371.69 x 43 °C x 1.2 = 6783 W = 23144 Btu/h			$HG_{salb} = LR_{airc} \times \frac{V_b}{3.6} \times DTD_c \times 1.2$ = 0.110 x 371.69 x 7 °C x 1.2 = 348 W = 1188 Btu/h	
5.2.3.2 Heat Loss due to Mechanical Ventilation			6.2.7 Sensible heat Gain due to Ventilation	
$HL_{vairb} = PVC \times DTD_h \times 1.08 \times (1 - E)$ 80 CFM x 78 °F x 1.08 x 0.25 = 1670 Btu/h			$HL_{vairb} = PVC \times DTD_h \times 1.08 \times (1 - E)$ 80 CFM x 13 °F x 1.08 x 0.25 = 275 Btu/h	
5.2.3.3 Calculation of Air Change Heat Loss for Each Room (Floor Multiplier Section)	
$HL_{airr} = Level\ Factor \times HL_{airbv} \times \{(HL_{agcr} + HL_{bgcr}) \div (HL_{agclevel} + HL_{bgclevel})\}$ <table border="1" style="width:100%; border-collapse: collapse;"> <thead> <tr> <th>Level</th> <th>Level Factor (LF)</th> <th>HLairve Air Leakage + Ventilation Heat Loss (Btu/h)</th> <th>Level Conductive Heat Loss: (HL_{clevel})</th> <th>Air Leakage Heat Loss Multiplier (LF x HLairbv / HLlevel)</th> </tr> </thead> <tbody> <tr><td>1</td><td>0.5</td><td rowspan="5" style="text-align: center; vertical-align: middle;">23,144</td><td>9,376</td><td>1.234</td></tr> <tr><td>2</td><td>0.3</td><td>13,733</td><td>0.506</td></tr> <tr><td>3</td><td>0.2</td><td>15,556</td><td>0.298</td></tr> <tr><td>4</td><td>0</td><td>0</td><td>0.000</td></tr> <tr><td>5</td><td>0</td><td>0</td><td>0.000</td></tr> </tbody> </table>					Level	Level Factor (LF)	HLairve Air Leakage + Ventilation Heat Loss (Btu/h)	Level Conductive Heat Loss: (HL _{clevel})	Air Leakage Heat Loss Multiplier (LF x HLairbv / HLlevel)	1	0.5	23,144	9,376	1.234	2	0.3	13,733	0.506	3	0.2	15,556	0.298	4	0	0	0.000	5	0	0	0.000																														
Level	Level Factor (LF)	HLairve Air Leakage + Ventilation Heat Loss (Btu/h)	Level Conductive Heat Loss: (HL _{clevel})	Air Leakage Heat Loss Multiplier (LF x HLairbv / HLlevel)	
1	0.5	23,144	9,376	1.234	
2	0.3		13,733	0.506	
3	0.2		15,556	0.298	
4	0		0	0.000	
5	0		0	0.000	
*HLairbv = Air leakage heat loss + ventilation heat loss *For a balanced or supply only ventilation system HLairve = 0	

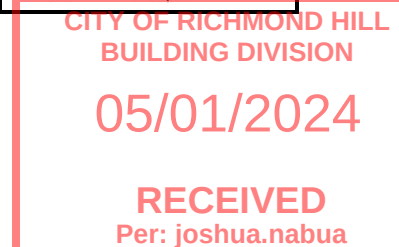Michael O'Rourke
BCIN# 19669


HEAT LOSS AND GAIN SUMMARY SHEET**MODEL:** ROSE 9**BUILDER:** GREENPARK HOMES**SFQT:** 3466**LO#** 101702**SITE:** TRINIGROUP**DESIGN ASSUMPTIONS**

HEATING	°F	COOLING	°F
OUTDOOR DESIGN TEMP.	-6	OUTDOOR DESIGN TEMP.	88
INDOOR DESIGN TEMP.	72	INDOOR DESIGN TEMP. (MAX 75°F)	75
		WINDOW SHGC	0.50

BUILDING DATA

ATTACHMENT:	DETACHED	# OF STORIES (+BASEMENT):	3
FRONT FACES:	EAST	ASSUMED (Y/N):	Y
AIR CHANGES PER HOUR:	3.57	ASSUMED (Y/N):	Y
AIR TIGHTNESS CATEGORY:	AVERAGE	ASSUMED (Y/N):	Y
WIND EXPOSURE:	SHELTERED	ASSUMED (Y/N):	Y
HOUSE VOLUME (ft ³):	47254.0	ASSUMED (Y/N):	Y
INTERNAL SHADING:	BLINDS/CURTAINS	ASSUMED OCCUPANTS:	5
INTERIOR LIGHTING LOAD (Btu/h/ft ²):	1.27	DC BRUSHLESS MOTOR (Y/N):	Y
FOUNDATION CONFIGURATION	BCIN_1	DEPTH BELOW GRADE:	6.0 ft
LENGTH: 42.0 ft	WIDTH: 50.0 ft	EXPOSED PERIMETER:	184.0 ft

2012 OBC - COMPLIANCE PACKAGE**Component****Compliance Package
A1****Nominal Min. Eff.**

Ceiling with Attic Space Minimum RSI (R)-Value	60	59.22
Ceiling Without Attic Space Minimum RSI (R)-Value	31	27.65
Exposed Floor Minimum RSI (R)-Value	31	29.80
Walls Above Grade Minimum RSI (R)-Value	22	17.03
Basement Walls Minimum RSI (R)-Value	20 ci	21.12
Below Grade Slab Entire surface > 600 mm below grade Minimum RSI (R)-Value	-	-
Edge of Below Grade Slab ≤ 600 mm Below Grade Minimum RSI (R)-Value	10	10
Heated Slab or Slab ≤ 600 mm below grade Minimum RSI (R)-Value	10	11.13
Windows and Sliding Glass Doors Maximum U-Value	0.28	-
Skylights Maximum U-Value	0.49	-
Space Heating Equipment Minimum AFUE	96%	-
HRV/ERV Minimum Efficiency	75%	-
Domestic Hot Water Heater Minimum EF	0.8	-

INDIVIDUAL BCIN: 19669

MICHAEL O'ROURKE


CITY OF RICHMOND HILL
BUILDING DIVISION

05/01/2024

RECEIVED
Per: joshua.nabua

Residential Foundation Thermal Load Calculator

Supplemental tool for CAN/CSA-F280

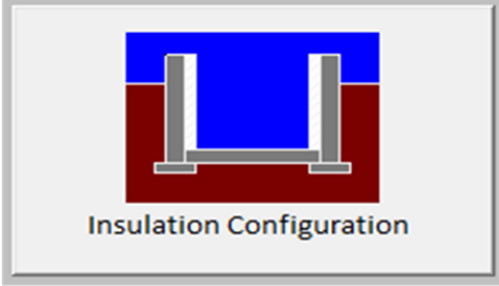Weather Station Description		
Province:	Ontario	
Region:	Richmond Hill	
Site Description		
Soil Conductivity:	Normal conductivity: dry sand, loam, clay	
Water Table:	Normal (7-10 m, 23-33 ft)	
Foundation Dimensions		
Floor Length (m):	12.8	 Insulation Configuration
Floor Width (m):	15.2	
Exposed Perimeter (m):	0.0	
Wall Height (m):	2.7	
Depth Below Grade (m):	1.83	
Window Area (m ²):	1.7	
Door Area (m ²):	0.0	
Radiant Slab		
Heated Fraction of the Slab:	0	
Fluid Temperature (°C):	33	
Design Months		
Heating Month	1	
Foundation Loads		
Heating Load (Watts):		1857

TYPE: ROSE 9
LO# 101702

Michael O'Rourke BCIN #19669

CITY OF RICHMOND HILL
BUILDING DIVISION

05/01/2024


RECEIVED
Per: joshua.nabua

Air Infiltration Residential Load Calculator

Supplemental tool for CAN/CSA-F280

Weather Station Description				
Province:	Ontario			
Region:	Richmond Hill			
Weather Station Location:	Open flat terrain, grass			
Anemometer height (m):	10			
Local Shielding				
Building Site:	Suburban, forest			
Walls:	Heavy			
Flue:	Heavy			
Highest Ceiling Height (m):	7.62			
Building Configuration				
Type:	Detached			
Number of Stories:	Two			
Foundation:	Full			
House Volume (m ³):	1338.1			
Air Leakage/Ventilation				
Air Tightness Type:	Present (1961-) (3.57 ACH)			
Custom BDT Data:	ELA @ 10 Pa.	1783.7 cm ²		
	3.57	ACH @ 50 Pa		
Mechanical Ventilation (L/s):	Total Supply	Total Exhaust		
	37.5	37.5		
Flue Size				
Flue #:	#1	#2	#3	#4
Diameter (mm):	0	0	0	0
Natural Infiltration Rates				
Heating Air Leakage Rate (ACH/H):	0.352			
Cooling Air Leakage Rate (ACH/H):	0.110			


TYPE: ROSE 9
LO# 101702

Michael O'Rourke BCIN# 19669

CITY OF RICHMOND HILL
BUILDING DIVISION


05/01/2024

RECEIVED
Per: joshua.nabua

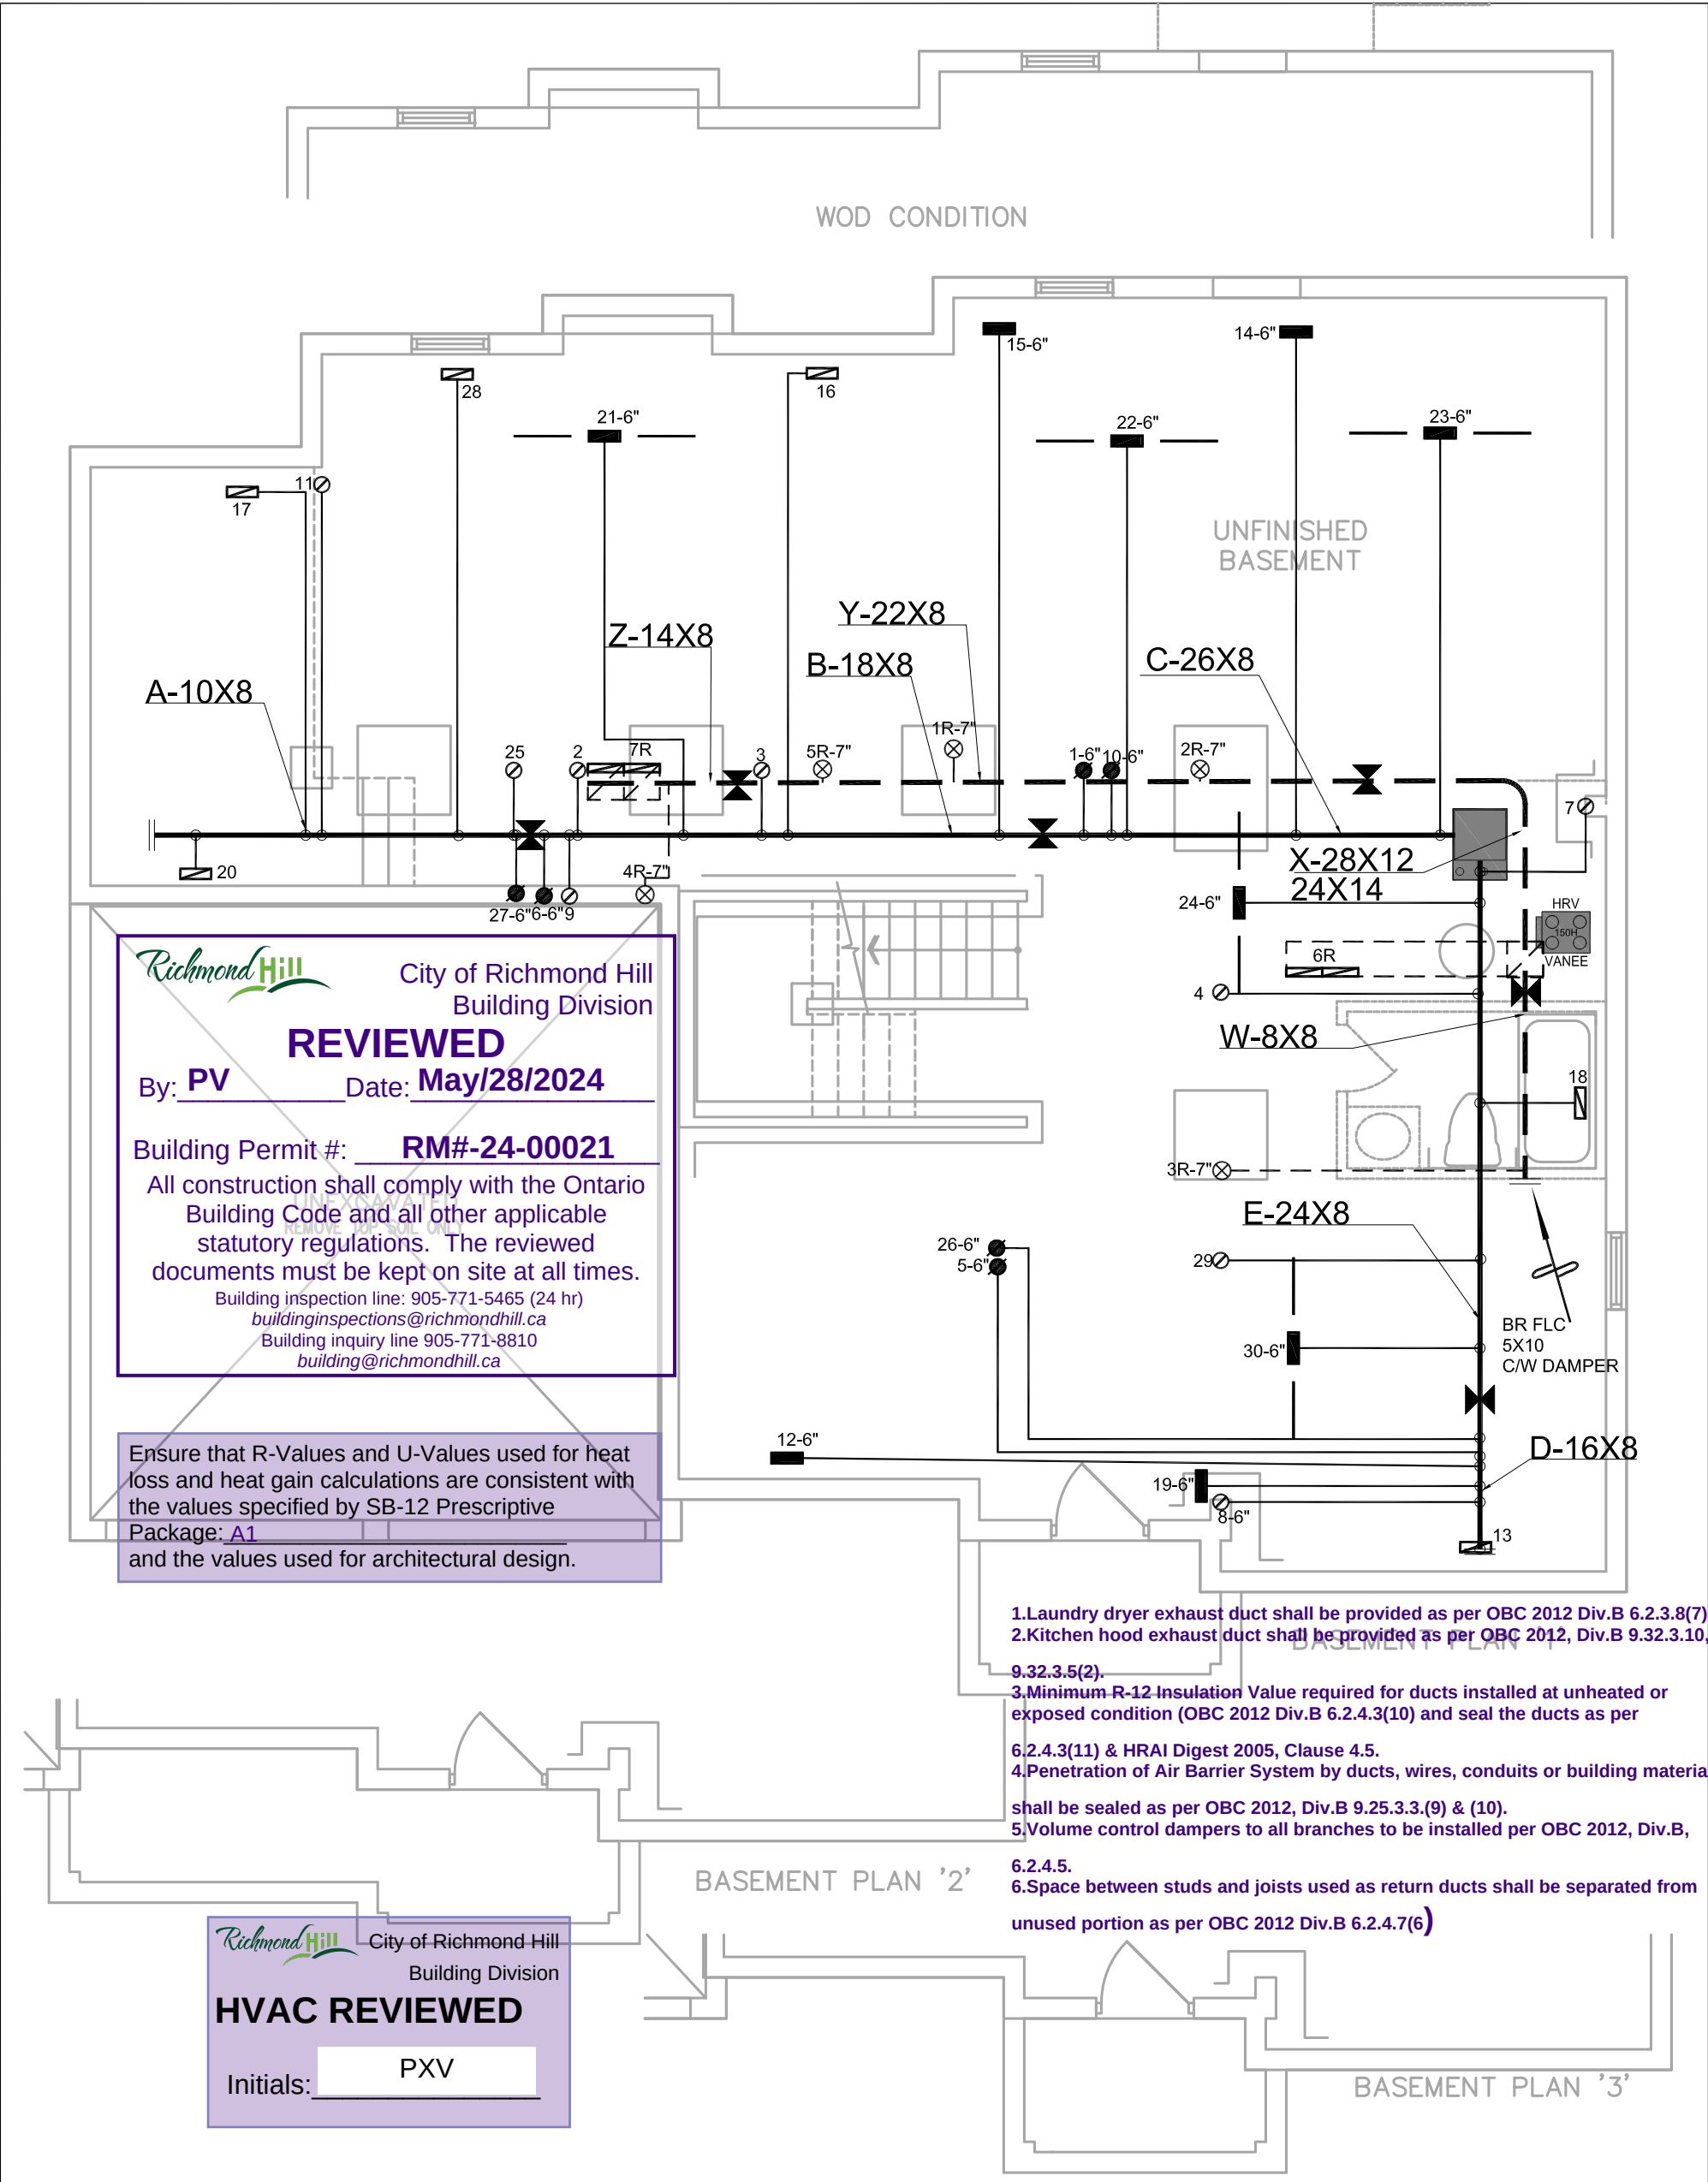

HVAC LEGEND								3.		
SYMBOL	DESCRIPTION	SYMBOL	DESCRIPTION	SYMBOL	DESCRIPTION	SYMBOL	DESCRIPTION	2.		
	SUPPLY AIR GRILLE		6" SUPPLY AIR BOOT ABOVE		14"x8" RETURN AIR GRILLE		RETURN AIR STACK ABOVE	1.		
	SUPPLY AIR GRILLE 6" BOOT		SUPPLY AIR STACK FROM 2nd FLOOR		30"x8" RETURN AIR GRILLE		RETURN AIR STACK 2nd FLOOR	No.	Description	Date
	SUPPLY AIR BOOT ABOVE		6" SUPPLY AIR STACK 2nd FLOOR		FRA- FLOOR RETURN AIR GRILLE		REDUCER	REVISIONS		
ALL DRAWINGS, CALCULATIONS AND SPECIFICATIONS ARE THE PROPERTY OF HVAC DESIGNS LTD.© AND MAY NOT BE REPRODUCED, MODIFIED OR ALTERED WITHOUT EXPRESSED WRITTEN CONSENT. THE DRAWINGS ARE DATED AND USE OF THESE DRAWINGS AFTER ONE YEAR FROM THE DATED NOTED IS NOT AUTHORIZED. CONTRACTOR SHALL CHECK ALL CONDITIONS BEFORE PROCEEDING WITH WORK. LATEST MUNICIPAL APPROVED DRAWINGS ONLY TO BE USED DURING INSTALLATION OF HEATING SYSTEM. HVAC DESIGNS LTD. IS NOT LIABLE FOR ANY CLAIMS ARISING FROM UNAUTHORIZED USE OF THE DRAWINGS OR FROM ANY CHANGES TO ACCEPTED STANDARDS AND/OR THE ONTARIO BUILDING CODE.								I Michael O'Rourke have reviewed and take responsibility for the design work and am qualified under division C.3.2.5 of the building code. Michael O'Rourke BCIN # 19669 HVAC Designs Ltd.		
Client		375 Finley Ave. Suite 202 - Ajax, Ontario L1S 2E2 Tel. 905.619.2300 - 905.420.5300 Fax 905.619.2375 Email: info@hvacdsgns.ca Web: www.hvacdsgns.ca Specializing in Residential Mechanical Design Services		HEAT LOSS 64002 BTU/H UNIT DATA		# OF RUNS S/A R/A FANS		Sheet Title		
GREEN PARK HOMES				MAKE GOODMAN		3RD FLOOR		BASEMENT HEATING LAYOUT		
Project Name		L1S 2E2 Tel. 905.619.2300 - 905.420.5300 Fax 905.619.2375		MODEL GMEC960804CNA		2ND FLOOR 15 5 5		CITY OF RICHMOND HILL BUILDING DIVISION		
TRINIGROUP		Email: info@hvacdsgns.ca		INPUT 80 MBTU/H		1ST FLOOR 10 2 2		Date JUNE/2023		
RICHMOND HILL, ONTARIO		Web: www.hvacdsgns.ca		OUTPUT 76.8 MBTU/H		BASEMENT 5 1 0		Scale 3/16" = 1'-0"		
ROSE 9		3466 sqft		COOLING 3.5 TONS		ALL S/A DIFFUSERS 4" x10" UNLESS NOTED OTHERWISE ON LAYOUT. ALL S/A RUNS 5"Ø UNLESS NOTED OTHERWISE ON LAYOUT. UNDERCUT DOORS 1" min. FOR R/A		BCIN# 19669		
		Installation to comply with the latest Ontario Building Code. All supply branch outlets shall be equipped with a manual balancing damper. Ductwork which passes through the garage or unheated spaces shall be adequately insulated and be gas-proofed.		FAN SPEED 1504 cfm @ 0.6" w.c.				LO# 101702		
								Per: joshua.nabua		

7. Combustion air supply shall be provided to the furnace and hot water tank.
- 8.HRV installation, testing, startup and commissioning shall be in compliance with OBC 2012, Div.B 9.32.3.11, 9.32.3.11(7)&(10)
9. HRV duct connection shall be in compliance with OBC 2012 Div.B 9.32.3.6(3) & 9.32.3.4(7).
10. Supply air grill at finished basement shall be at low level. Return air grill for finished or unfinished basement shall be at low level. HRAI digest 2005, clause 7.7(3).

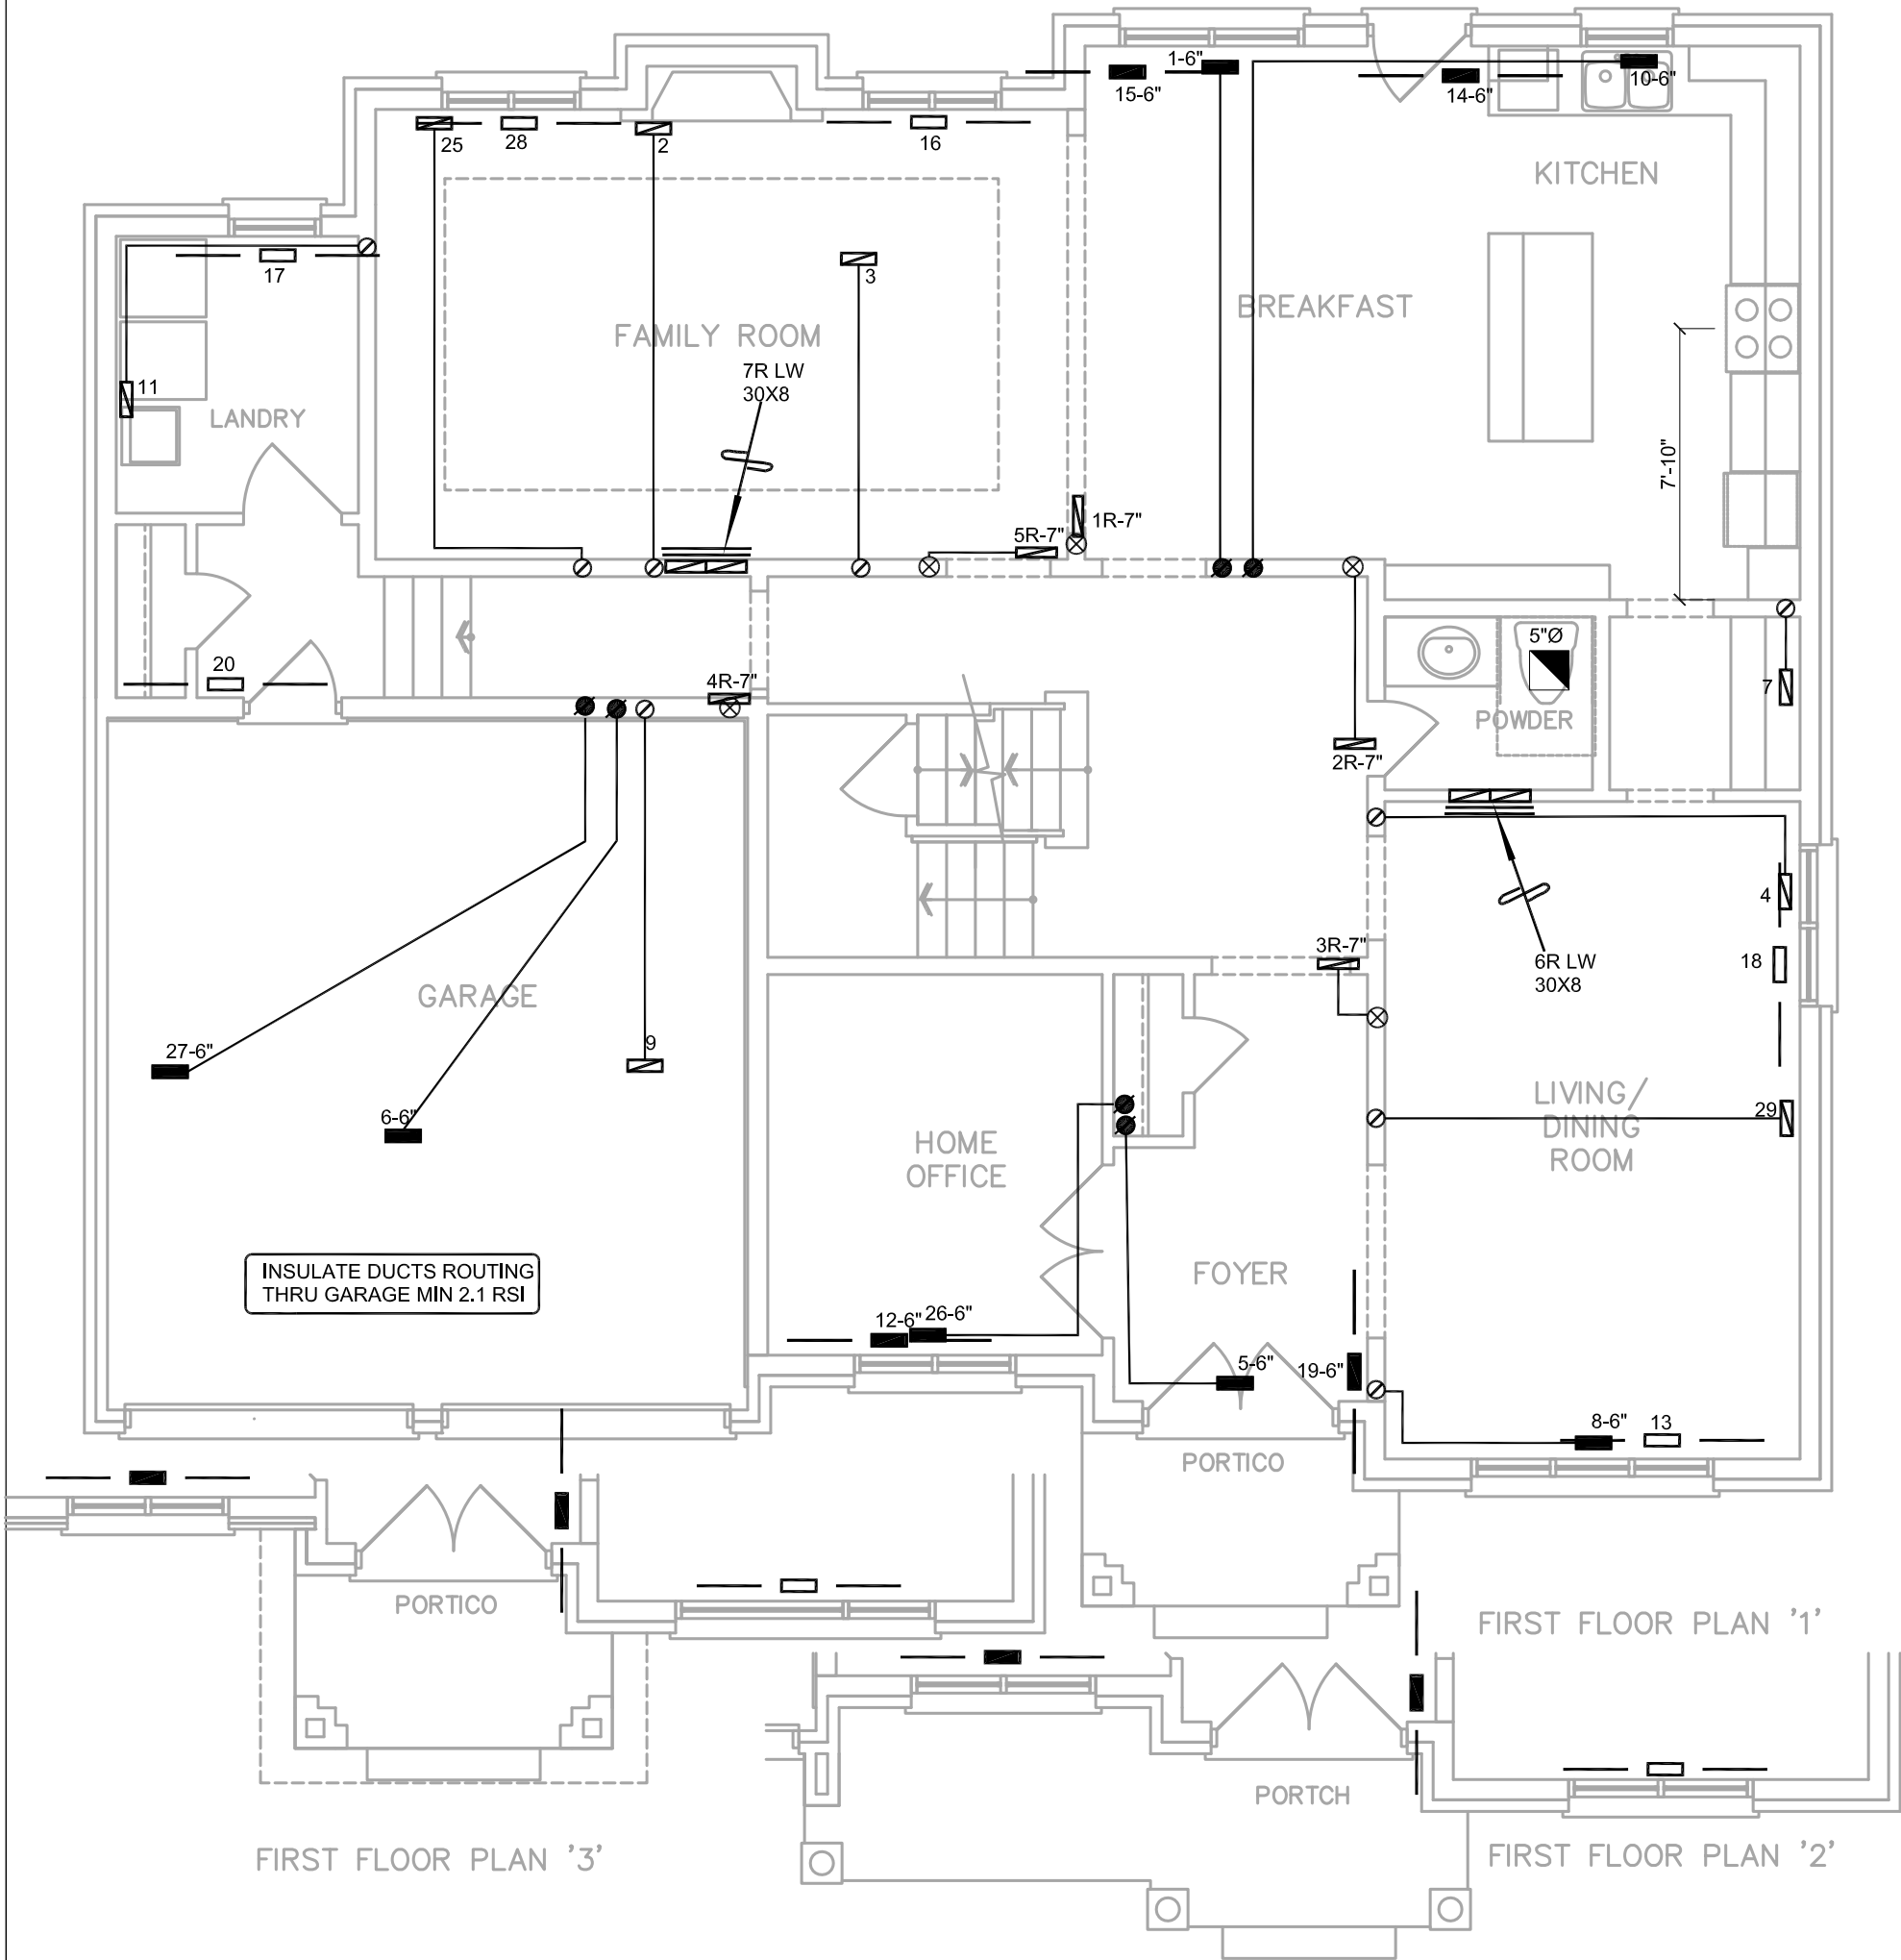

HVAC LEGEND								3.		
SYMBOL	DESCRIPTION	SYMBOL	DESCRIPTION	SYMBOL	DESCRIPTION	SYMBOL	DESCRIPTION	2.		
	SUPPLY AIR GRILLE		6" SUPPLY AIR BOOT ABOVE		14"x8" RETURN AIR GRILLE		RETURN AIR STACK ABOVE	1.		
	SUPPLY AIR GRILLE 6" BOOT		SUPPLY AIR STACK FROM 2nd FLOOR		30"x8" RETURN AIR GRILLE		RETURN AIR STACK 2nd FLOOR	No.	Description	Date
	SUPPLY AIR BOOT ABOVE		6" SUPPLY AIR STACK 2nd FLOOR		FRA- FLOOR RETURN AIR GRILLE		REDUCER	REVISIONS		

ALL DRAWINGS, CALCULATIONS AND SPECIFICATIONS ARE THE PROPERTY OF HVAC DESIGNS LTD.© AND MAY NOT BE REPRODUCED, MODIFIED OR ALTERED WITHOUT EXPRESSED WRITTEN CONSENT. THE DRAWINGS ARE DATED AND USE OF THESE DRAWINGS AFTER ONE YEAR FROM THE DATED NOTED IS NOT AUTHORIZED. CONTRACTOR SHALL CHECK ALL CONDITIONS BEFORE PROCEEDING WITH WORK. LATEST MUNICIPAL APPROVED DRAWINGS ONLY TO BE USED DURING INSTALLATION OF HEATING SYSTEM. HVAC DESIGNS LTD. IS NOT LIABLE FOR ANY CLAIMS ARISING FROM UNAUTHORIZED USE OF THE DRAWINGS OR FROM ANY CHANGES TO ACCEPTED STANDARDS AND/OR THE ONTARIO BUILDING CODE.

I Michael O'Rourke have reviewed and take responsibility for the design work and am qualified under division C.3.2.5 of the building code.

Michael O'Rourke
Michael O'Rourke BCIN # 19669
HVAC Designs Ltd.

PACKAGE A1

Sheet Title
FIRST FLOOR HEATING LAYOUT

CITY OF RICHMOND HILL BUILDING DIVISION
Date **JUNE 2023**
Scale **3/16" = 1'-0"**
05/01/2024
BCIN# 19669

LO# 101702
Per: **joshua.nabua**

Client
GREEN PARK HOMES


Project Name
TRINIGROUP RICHMOND HILL, ONTARIO

ROSE 9 **3466 sqft**

HVAC DESIGNS LTD.
375 Finley Ave. Suite 202 - Ajax, Ontario
L1S 2E2 Tel. 905.619.2300 - 905.420.5300 Fax 905.619.2375
Email: info@hvacdsgns.ca
Web: www.hvacdsgns.ca
Specializing in Residential Mechanical Design Services

Installation to comply with the latest Ontario Building Code. All supply branch outlets shall be equipped with a manual balancing damper. Ductwork which passes through the garage or unheated spaces shall be adequately insulated and be gas-proofed.

- 13.Exterior insulation effective R-Value for wall, roof or exposed floor shall be maintained at the respective location where duct or sanitary pipes are routed inside exterior envelope.
14. Return air intake shall be provided as recommended in HRAI Digest 2005 Section 4.7 Return air inlet should be positioned so that short circuiting of supply air is avoided. A high and low wall return air combination shall be provided when a combined cooling & heating system is installed.
15. For simplified HRV/ERV installation, with stale air and fresh air connected to return air plenum, stale air intake and fresh air supply shall be separated minimum 3' or as recommended by HRV/ERV Manufacturer.

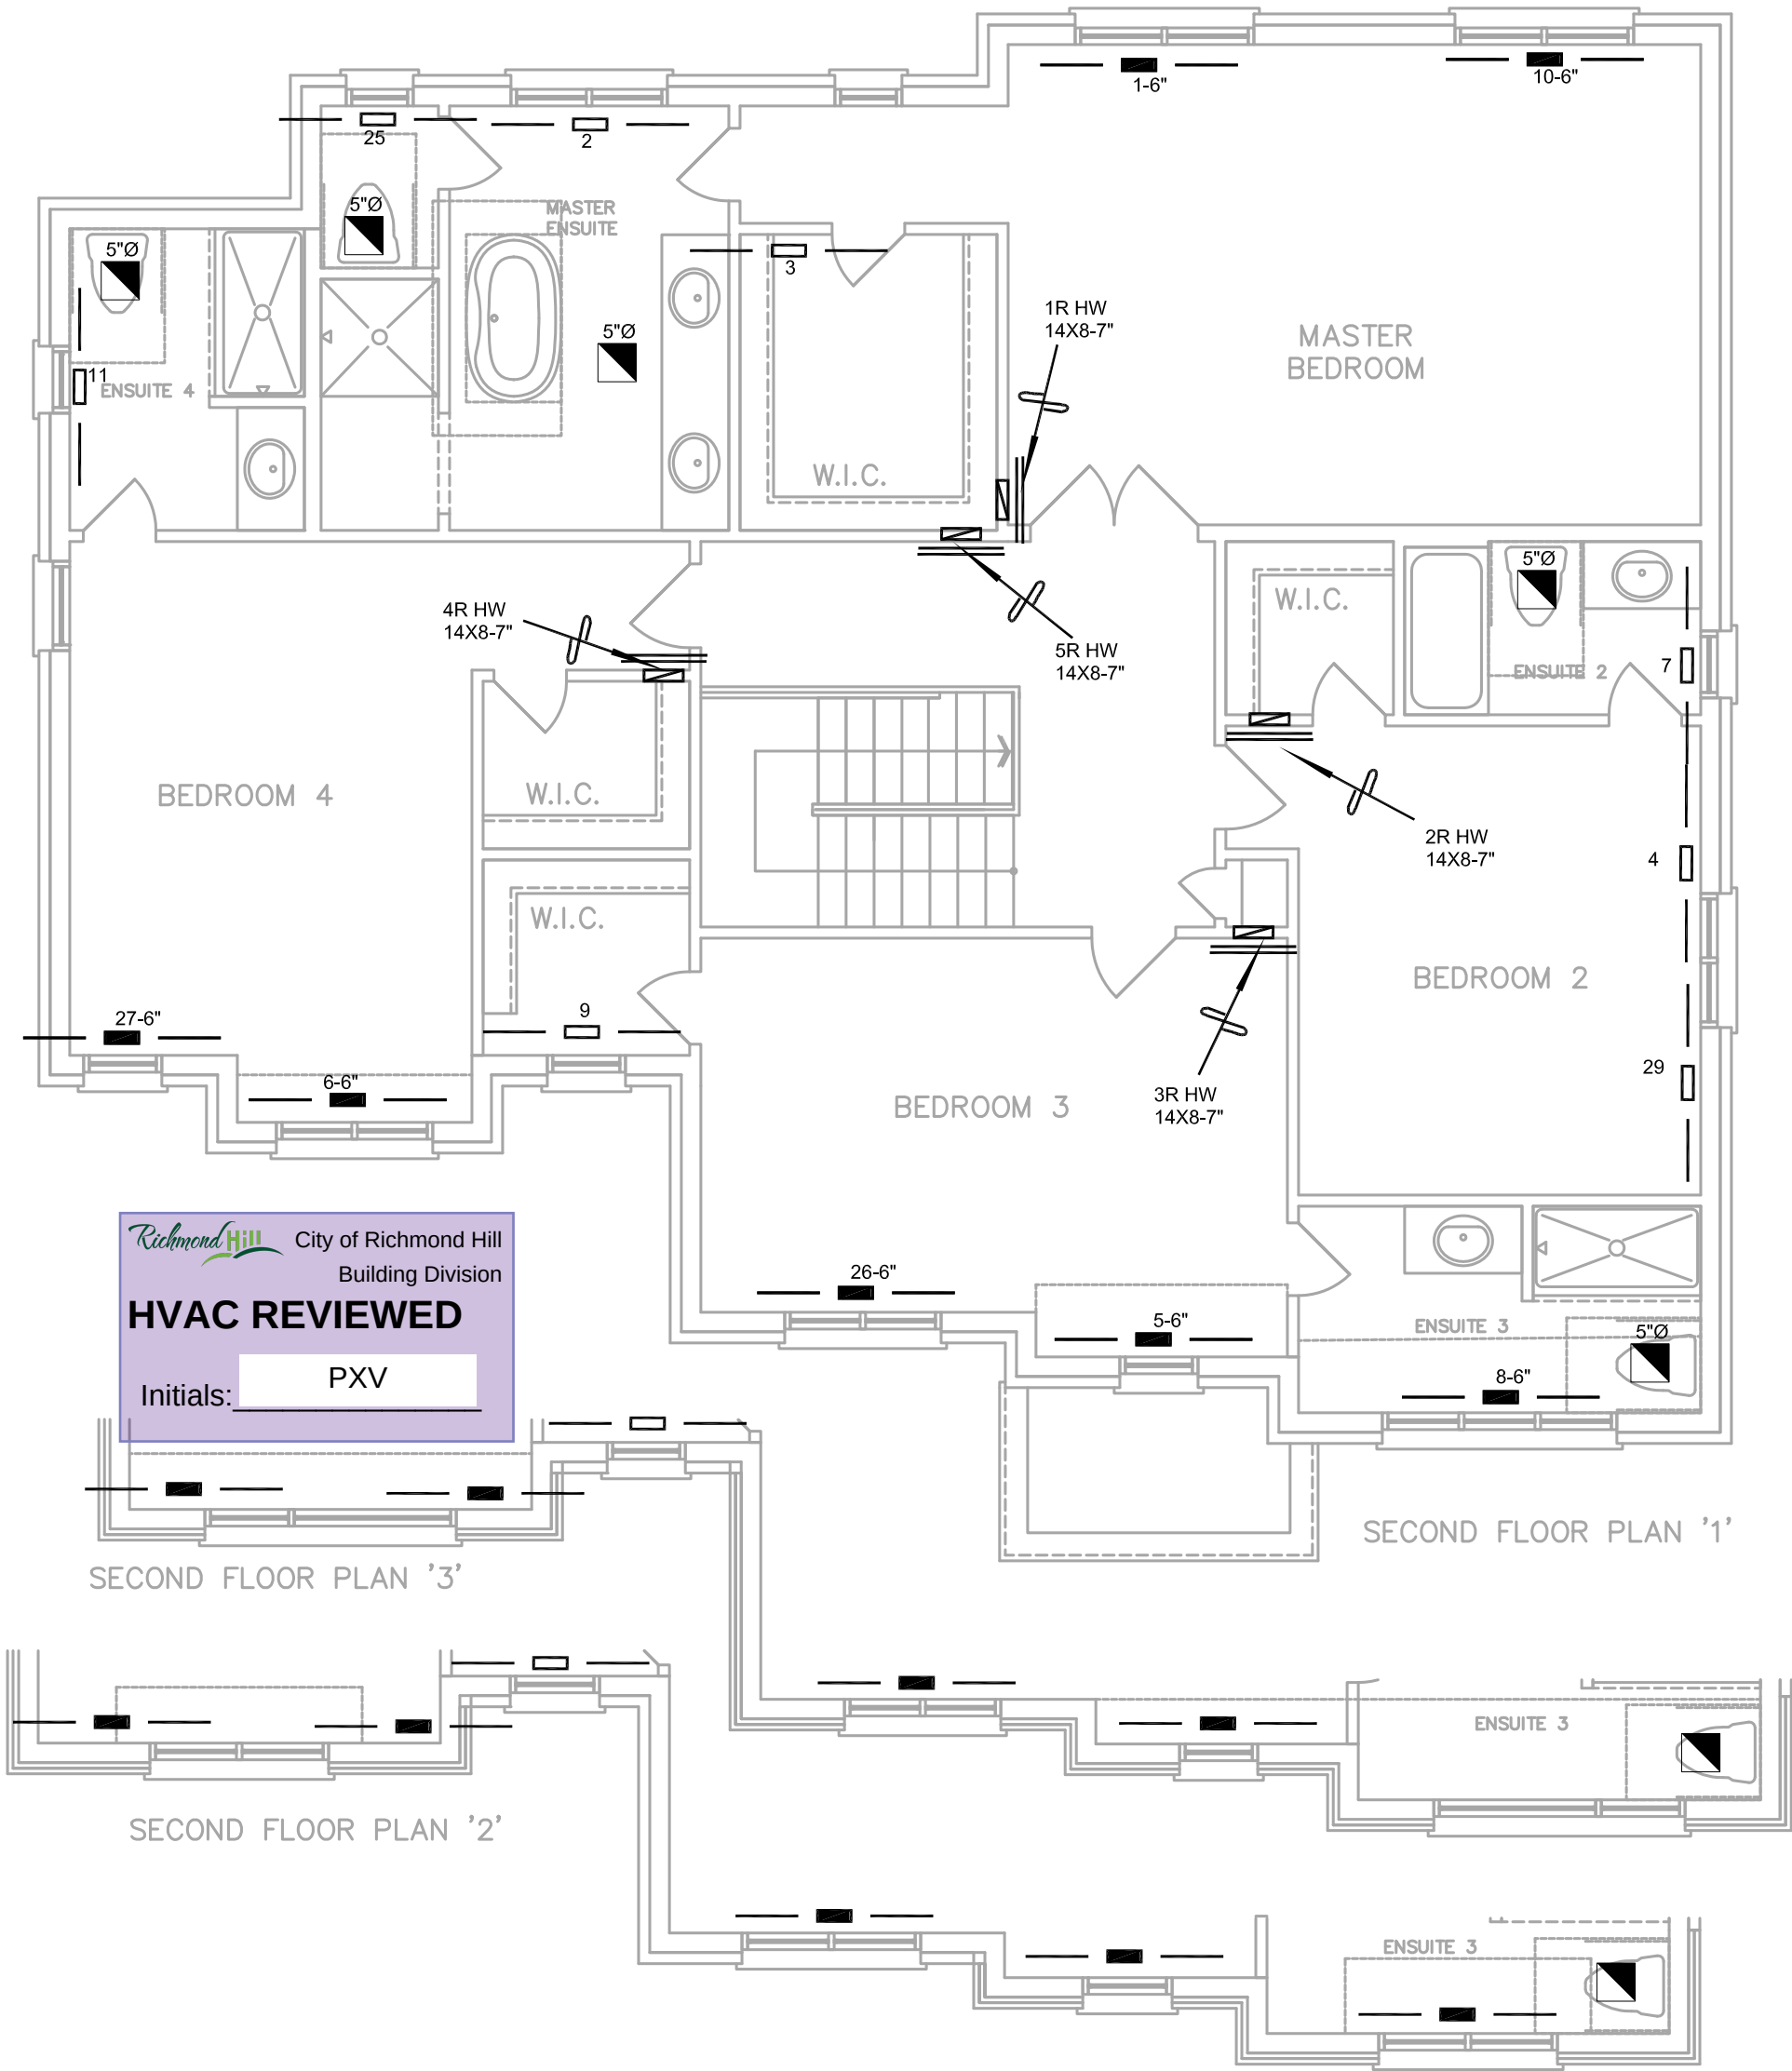

HVAC LEGEND								3.		
SYMBOL	DESCRIPTION	SYMBOL	DESCRIPTION	SYMBOL	DESCRIPTION	SYMBOL	DESCRIPTION	2.		
	SUPPLY AIR GRILLE		6" SUPPLY AIR BOOT ABOVE		14"x8" RETURN AIR GRILLE		RETURN AIR STACK ABOVE	1.		
	SUPPLY AIR GRILLE 6" BOOT		SUPPLY AIR STACK FROM 2nd FLOOR		30"x8" RETURN AIR GRILLE		RETURN AIR STACK 2nd FLOOR	No.	Description	Date
	SUPPLY AIR BOOT ABOVE		6" SUPPLY AIR STACK 2nd FLOOR		FRA- FLOOR RETURN AIR GRILLE		REDUCER	REVISIONS		
ALL DRAWINGS, CALCULATIONS AND SPECIFICATIONS ARE THE PROPERTY OF HVAC DESIGNS LTD.© AND MAY NOT BE REPRODUCED, MODIFIED OR ALTERED WITHOUT EXPRESSED WRITTEN CONSENT. THE DRAWINGS ARE DATED AND USE OF THESE DRAWINGS AFTER ONE YEAR FROM THE DATED NOTED IS NOT AUTHORIZED. CONTRACTOR SHALL CHECK ALL CONDITIONS BEFORE PROCEEDING WITH WORK. LATEST MUNICIPAL APPROVED DRAWINGS ONLY TO BE USED DURING INSTALLATION OF HEATING SYSTEM. HVAC DESIGNS LTD. IS NOT LIABLE FOR ANY CLAIMS ARISING FROM UNAUTHORIZED USE OF THE DRAWINGS OR FROM ANY CHANGES TO ACCEPTED STANDARDS AND/OR THE ONTARIO BUILDING CODE.						I Michael O'Rourke have reviewed and take responsibility for the design work and am qualified under division C.3.2.5 of the building code.		Michael O'Rourke BCIN # 19669 HVAC Designs Ltd.		
Client		GREEN PARK HOMES		Project Name		TRINIGROUP RICHMOND HILL, ONTARIO		ROSE 9		3466 sqft
375 Finley Ave. Suite 202 - Ajax, Ontario L1S 2E2 Tel. 905.619.2300 - 905.420.5300 Fax 905.619.2375 Email: info@hvacdsgns.ca Web: www.hvacdesigns.ca Specializing in Residential Mechanical Design Services		Installation to comply with the latest Ontario Building Code. All supply branch outlets shall be equipped with a manual balancing damper. Ductwork which passes through the garage or unheated spaces shall be adequately insulated and be gas-proofed.		Sheet Title		SECOND FLOOR HEATING LAYOUT		CITY OF RICHMOND HILL BUILDING DIVISION		Date JUNE/2023
								Scale 3/16" = 1'-0"		BCIN# 19669
								LO# 101702		Per: joshua.nabua