

### Benchmark Information


## Reference Documents

## Notes

## Revisions

It is the builder's complete responsibility to ensure that all plans submitted for approval fully comply with the Architectural Guidelines and all applicable regulations and requirements including zoning provisions and any provisions in the subdivision agreement. The Control Architect is not responsible in any way for examining or approving site (lotting) plans or working drawings with respect to any zoning or building code or permit matter or that any house can be properly built or located on its lot.

## City of Richmond Hill Design Review

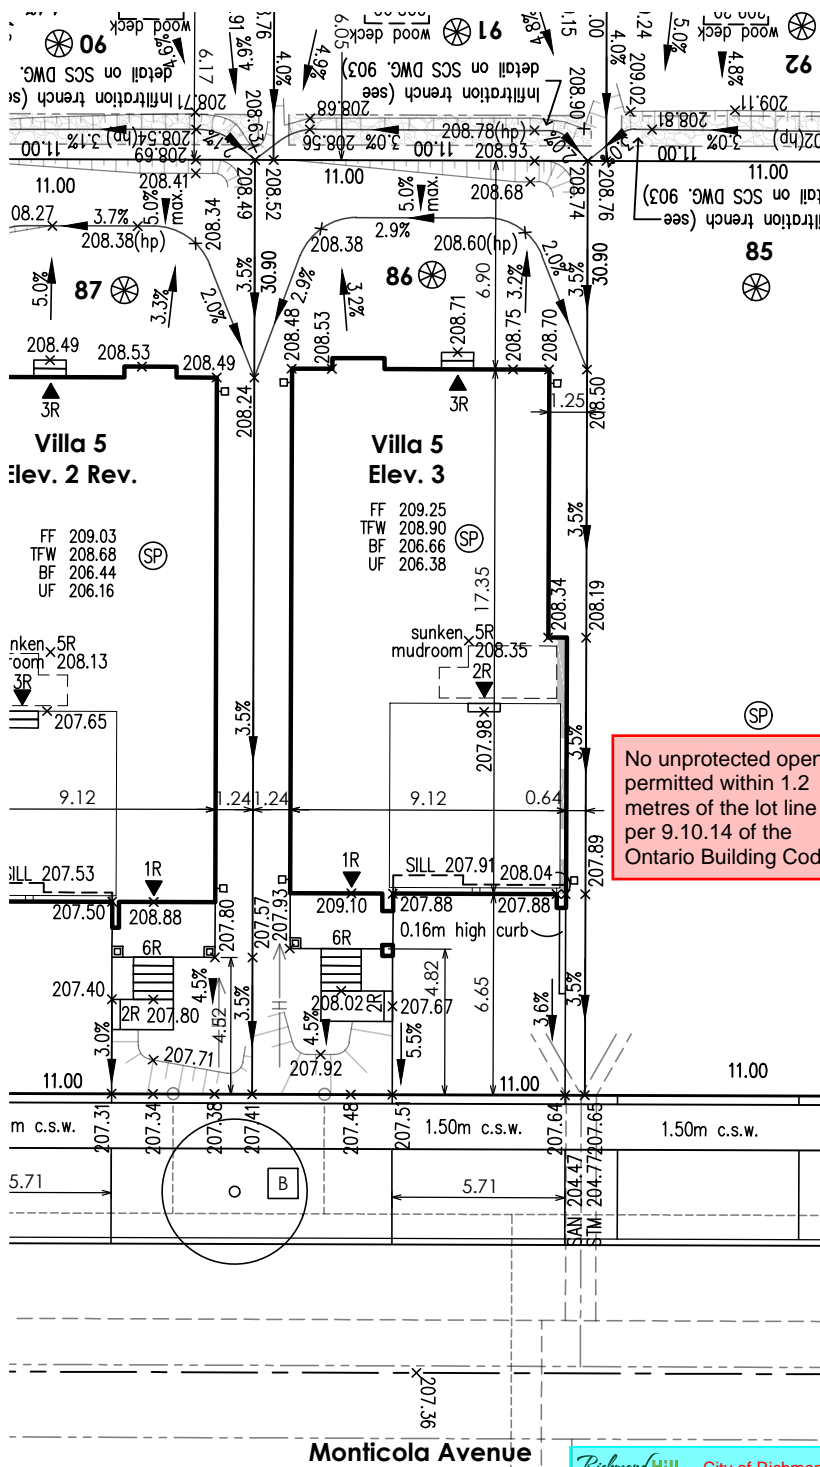

## Site Plan Statistics




## Consultants Declaration

Date: 2024-04-12

C.J.C.

### Legend

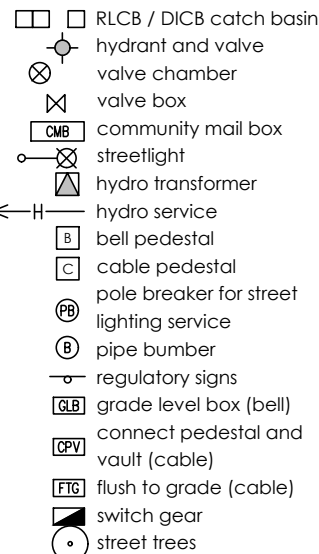

**CITY OF RICHMOND HILL  
BUILDING DIVISION**

09/13/2024 lot and  
lot 84 45M-

**Lot 86. 65M-**

drawing no

004

036

## Introduction

Drawing created with Mackitector v.1.0 (build 2759), File P:\2022\22-016-GREENPARK-TRINIGROUP-RICHMOND HILL\SITE\22-016-SITE-GRADING-077-098.DWG plotted on 2024-04-11 at 10:57:54 AM by JMACK