



LIBERTY
CUSTOM CABINETRY

131B CARLAUREN RD., WOODBRIDGE, ONTARIO L4L 8A0
TEL: (905) 856-7678 • FAX: (905) 856-7379
www.libertycustomcabinetry.com

QUOTATION

DATE:
JOB NO.

TO: LOPME

SHIP TO: BRADFORD

TYPE OF CABINETS:

FINISH OF CABINETS:

HARDWARE:

COUNTERTOP:

INSTALLATION:


☐ WITH
☐ WITHOUT

HOUSE TYPE:

REMARKS:

LOT # 2

REVISED w Pmtry

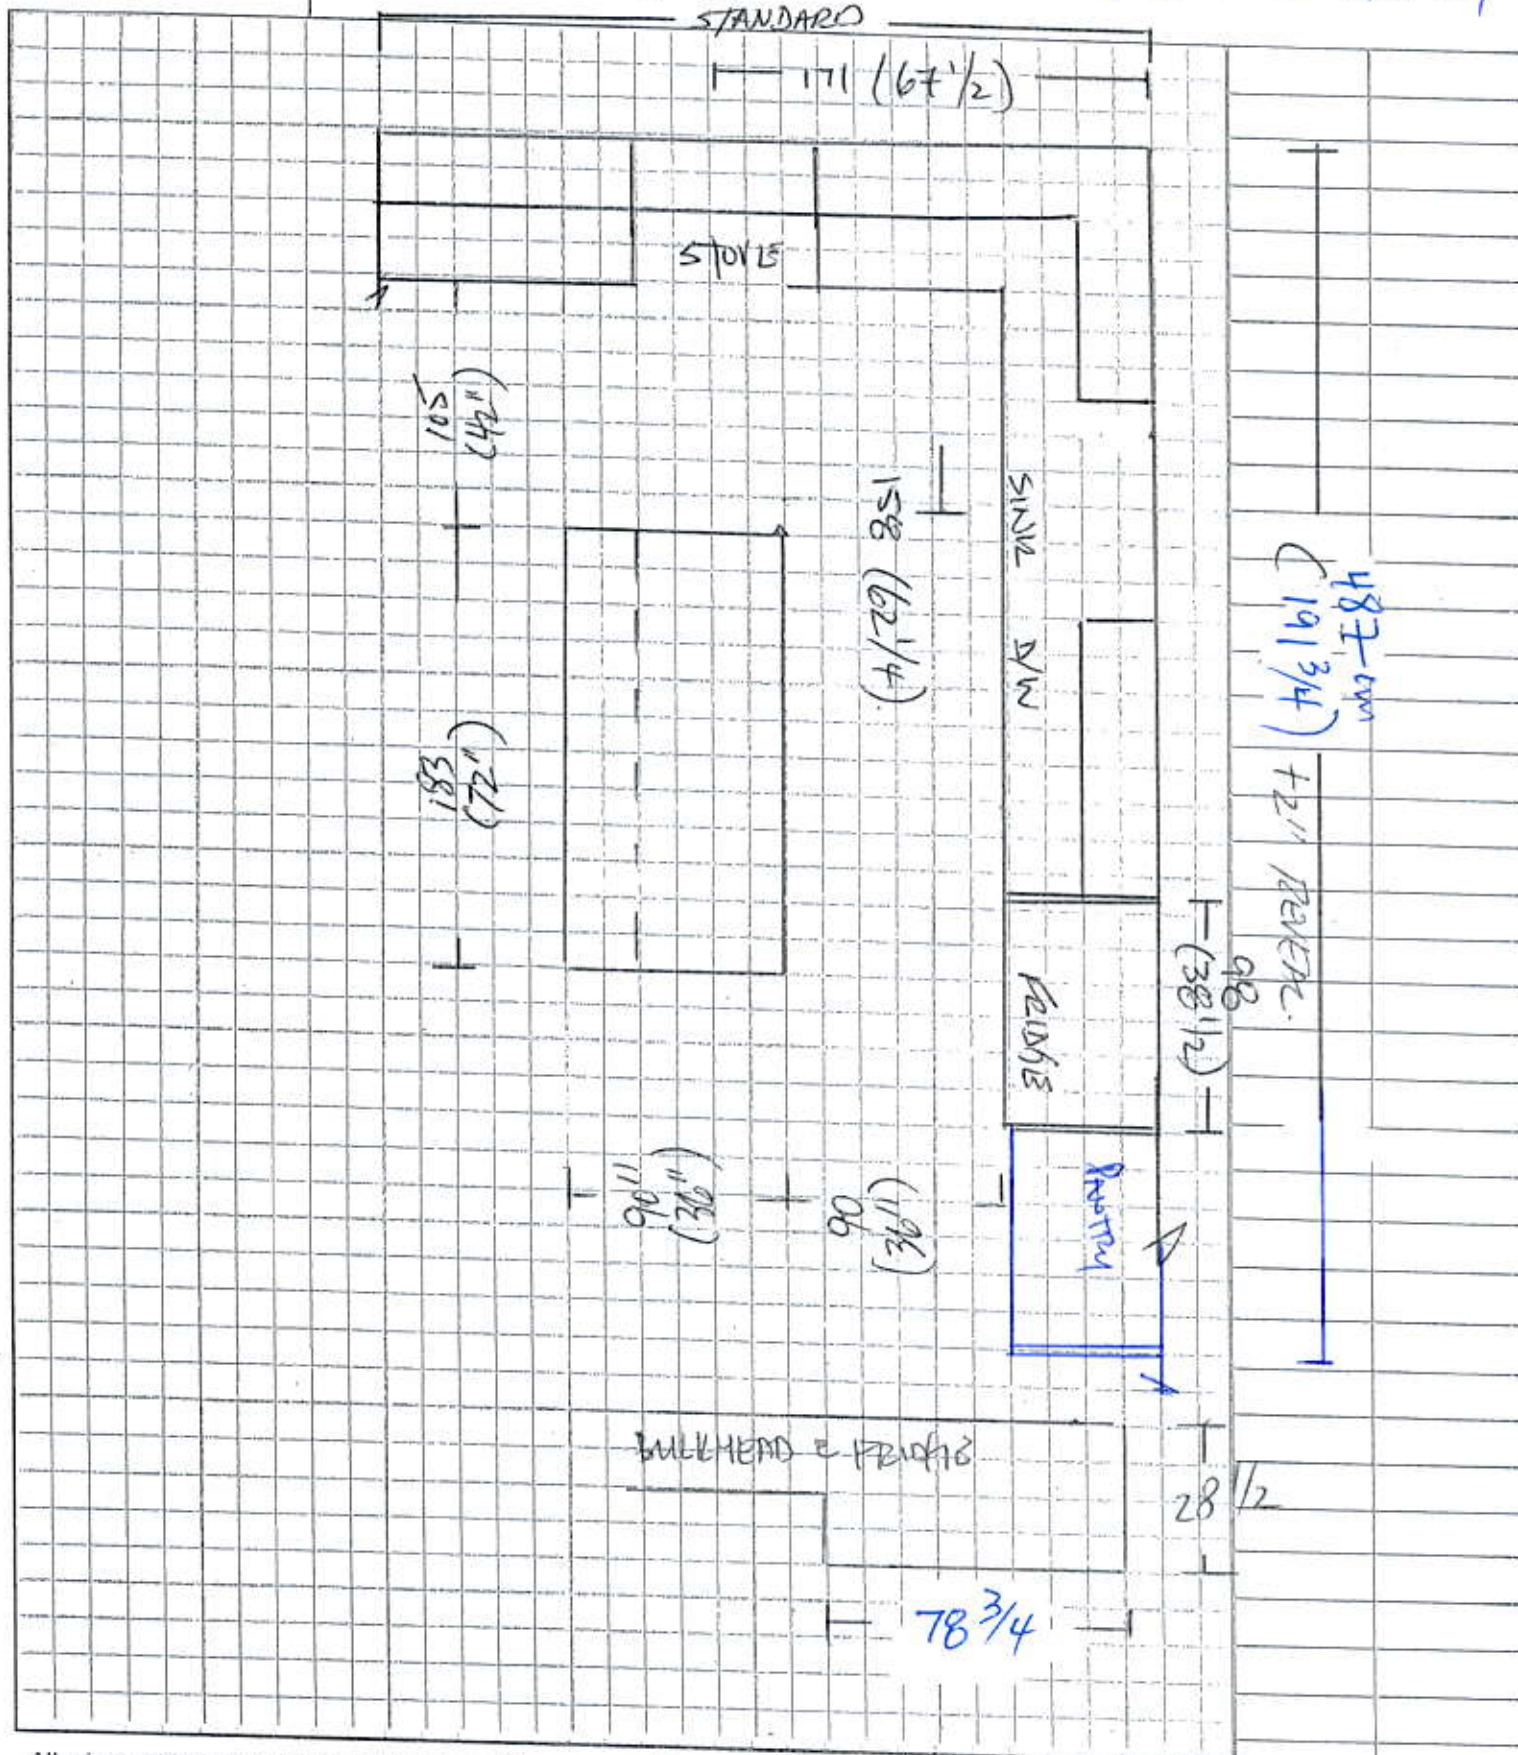

All prices subject to confirmation from head office.
Goods delivered shall be checked and inspected on
delivery. We shall not be responsible for any claims or
complaints after this inspection.

All agreements are contingent upon strikes, accidents, and
delays beyond our control.

Please provide our installer with template for sinkholes or
\$100.00 will be charged for callback.

ACCEPTED DATE:

TERMS:

LAYOUT THOROUGHLY EXPLAINED AND FULLY UNDERSTOOD

TOTAL \$

CUSTOMER SIGNATURE

SALESMAN'S SIGNATURE