
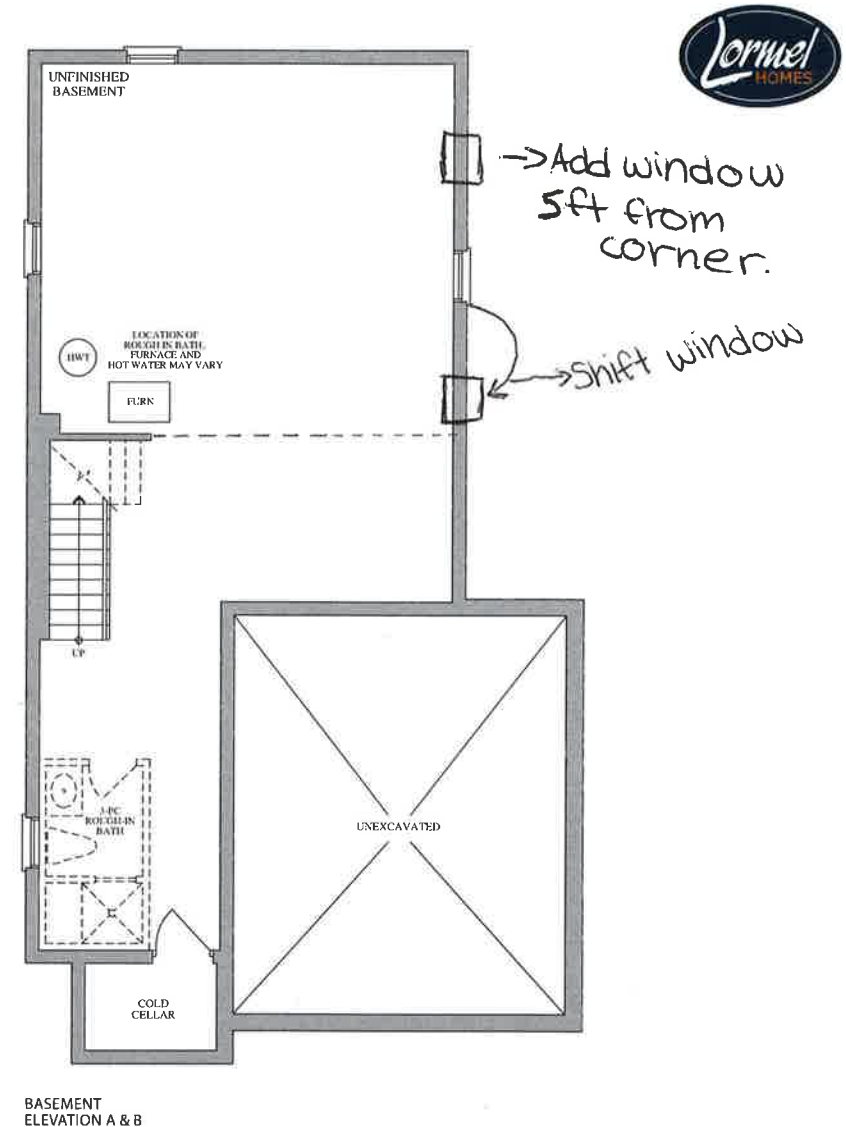
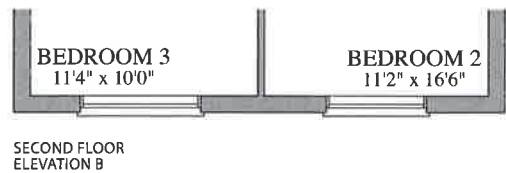
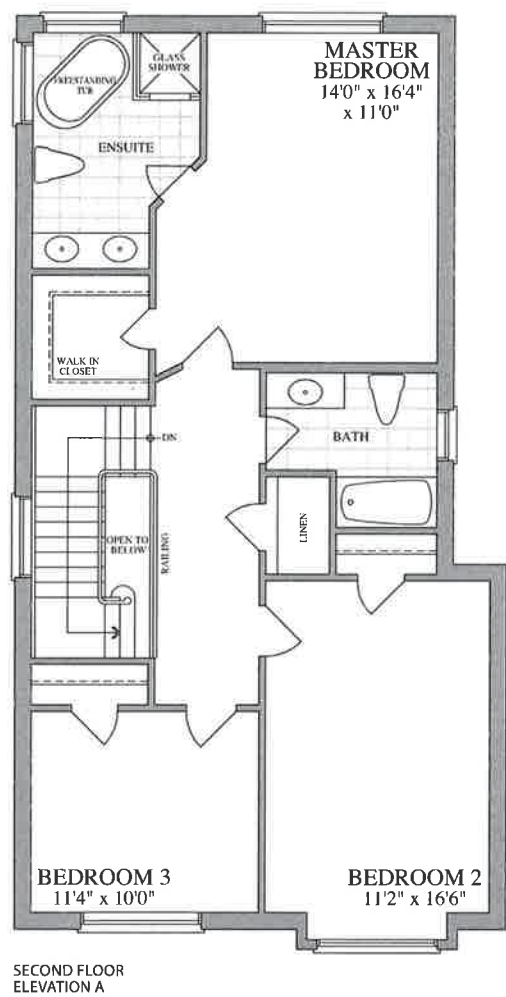


38'
DESIGNS

The Buckhorn / Elev. A & B
1800 sq.ft.

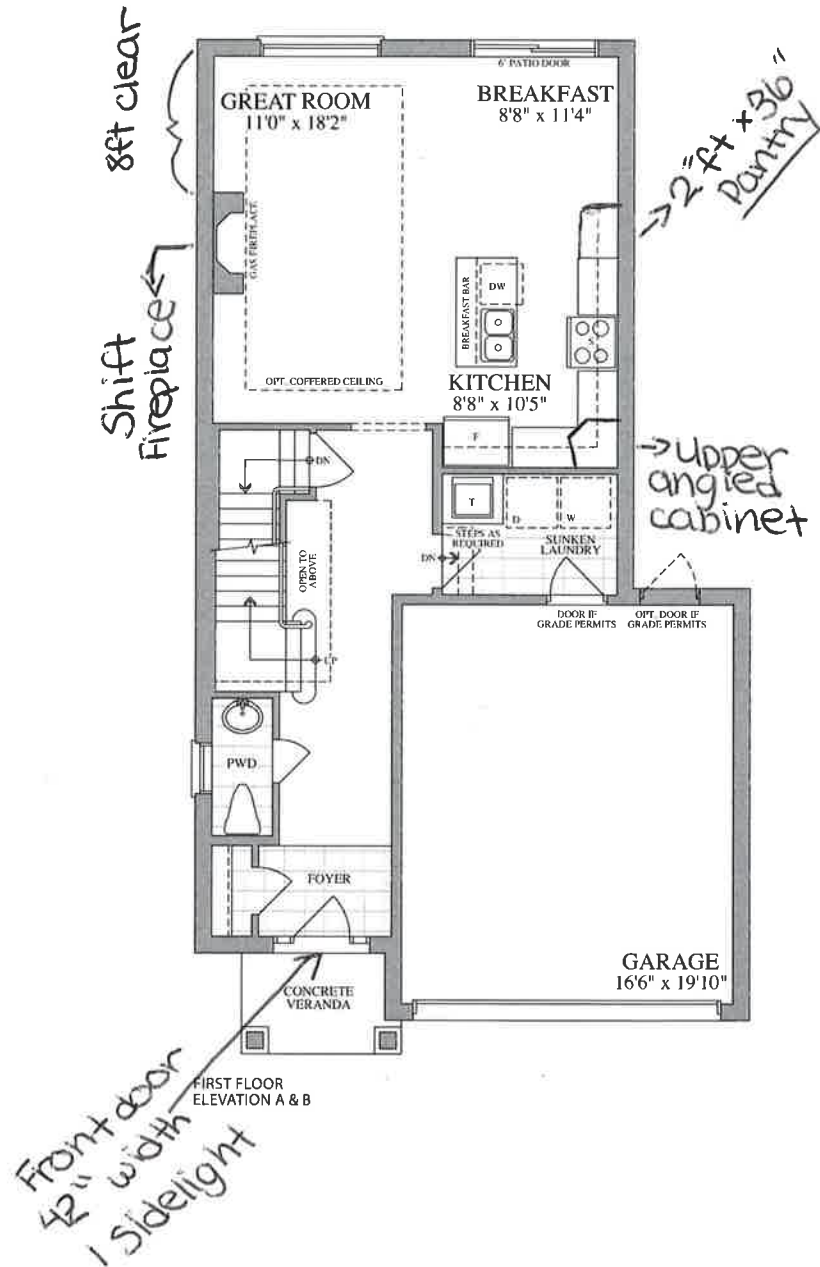

Plans and specifications are subject to change without notice. E. & O. E. Actual usable floor spaces may vary from the stated floor area. All renderings are artist's concept.