

38'
DESIGNS

The manitou / Elev. A & B
2480 sq.ft.

Add
Rough-in
valance




FIRST FLOOR
ELEVATION A & B



SECOND FLOOR
ELEVATION A



SECOND FLOOR
ELEVATION B

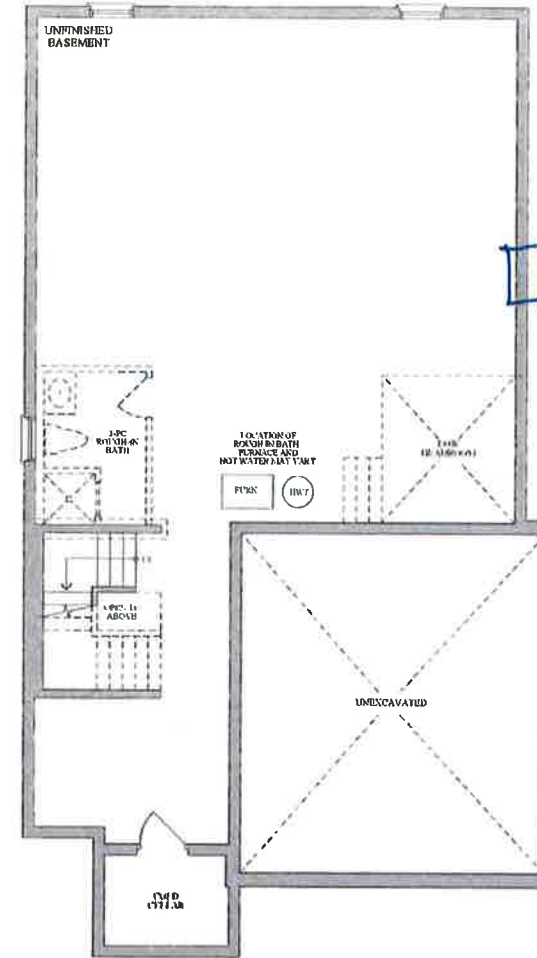

BASEMENT
ELEVATION A & B



LOT 5-88, PE002, SKETCH

kenneth egede

PURCHASER kenneth egede (Nov 2, 2021 12:13 EDT)

PURCHASER _____



Plans and specifications are subject to change without notice. E. & G. E. Actual usable floor space may vary from the stated floor area. All renderings are artist's concept.