


38'
DESIGNS

The Manitou / Elev. A & B
2480 sq.ft.

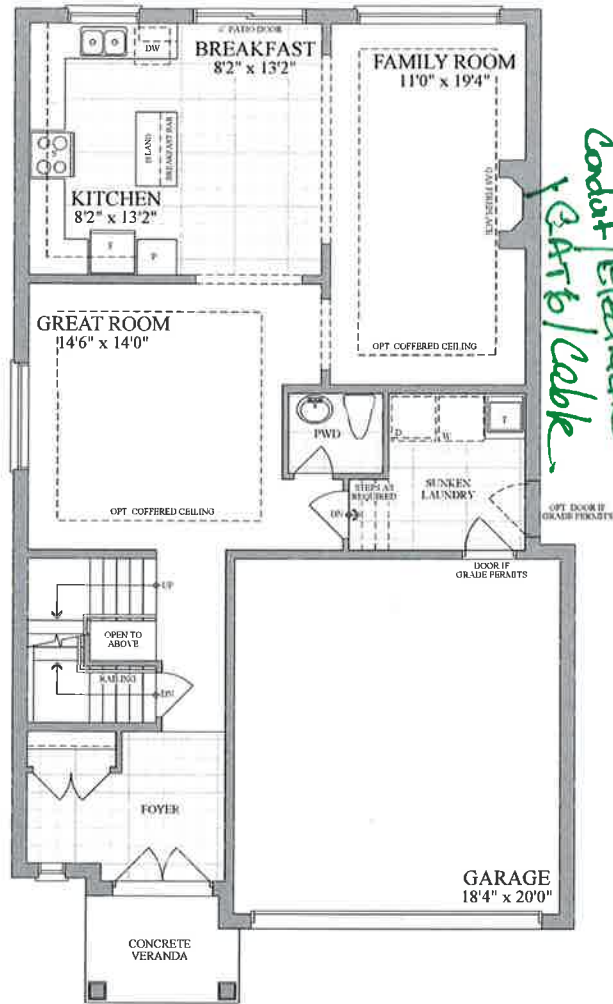


FIRST FLOOR
ELEVATION A & B


*Cordat/Electrical
1-3-4-5-6/Cable*



SECOND FLOOR
ELEVATION A

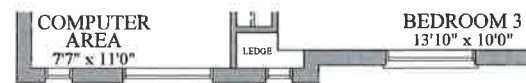

SECOND FLOOR
ELEVATION B

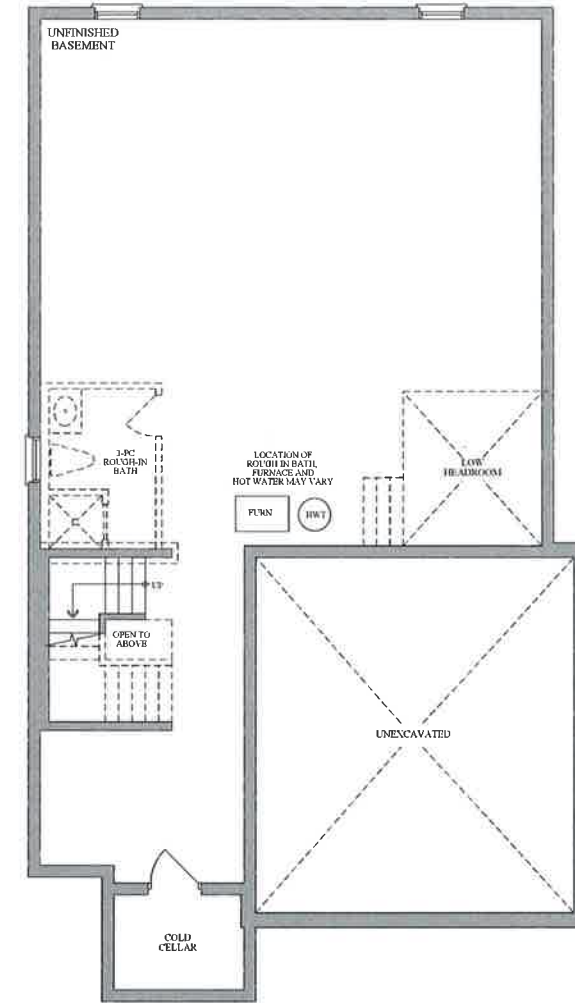

BASEMENT
ELEVATION A & B



Lot 1-183, Phil, R/i Locations

Purchaser's

MAKSIM REMEROVSKY



Plans and specifications are subject to change without notice, E. & O. E. Actual usable floor space may vary from the stated floor area. All renderings are artist's concept.