


The Kahshe / Elev. A & B
3000 sq.ft.

WINDOW TO
BE SHIFTED
→ (NOT CENTERED)

✓ FUTURE
CHIMNEY HOOD FAN
CENTER VENT AS
MUCH AS POSSIBLE

PEOU5

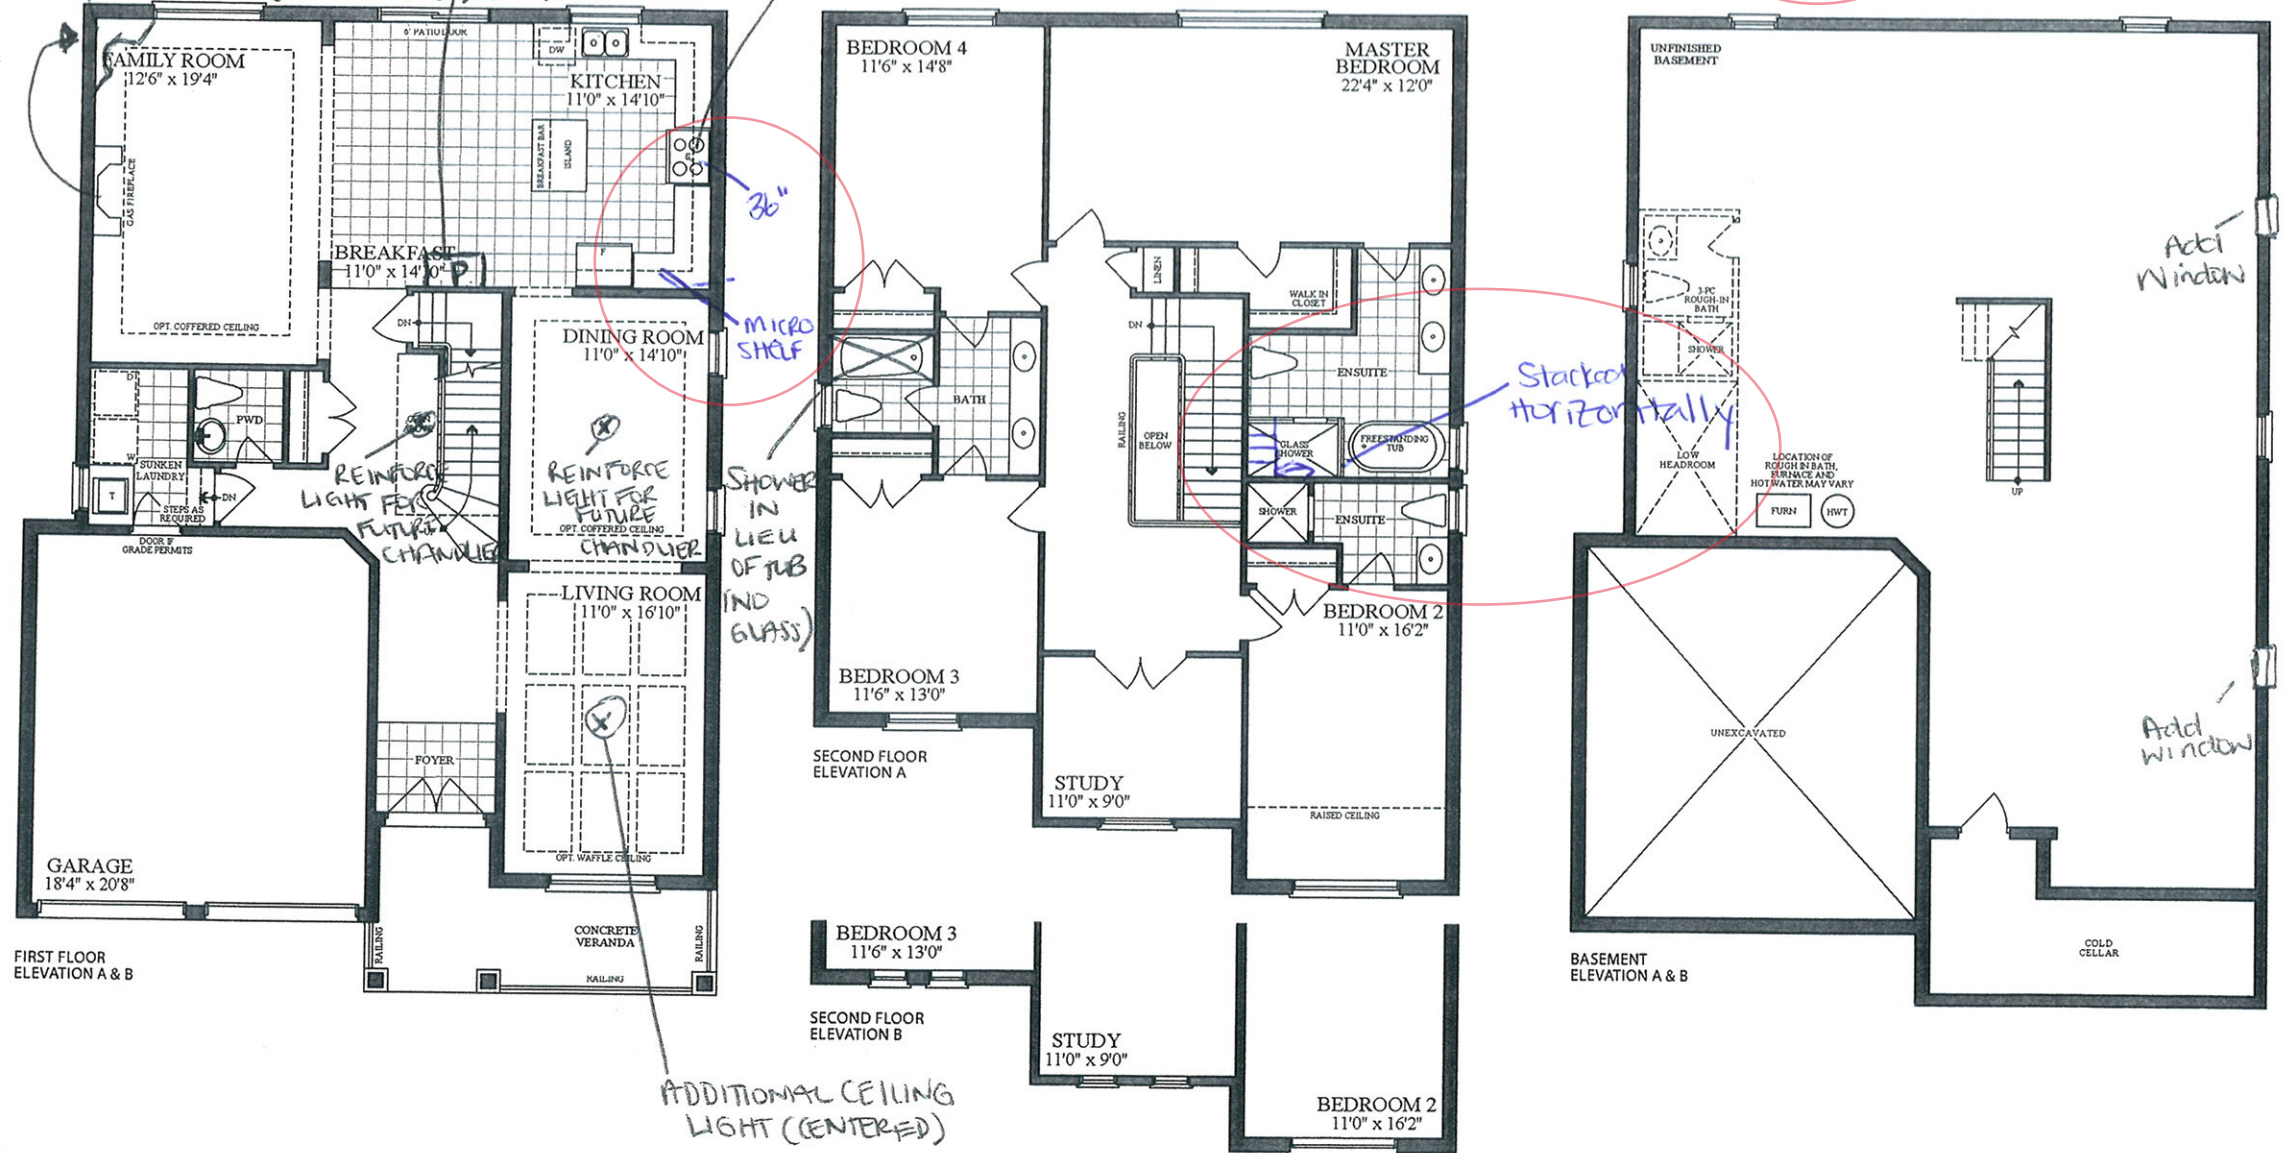

Plans and specifications are subject to change without notice. E. & O. E. Actual usable floor space may vary from the stated floor area. All renderings are artist's concept.