


47'
DESIGNS

The Kahshe / Elev. A & B
3000 sq.ft.

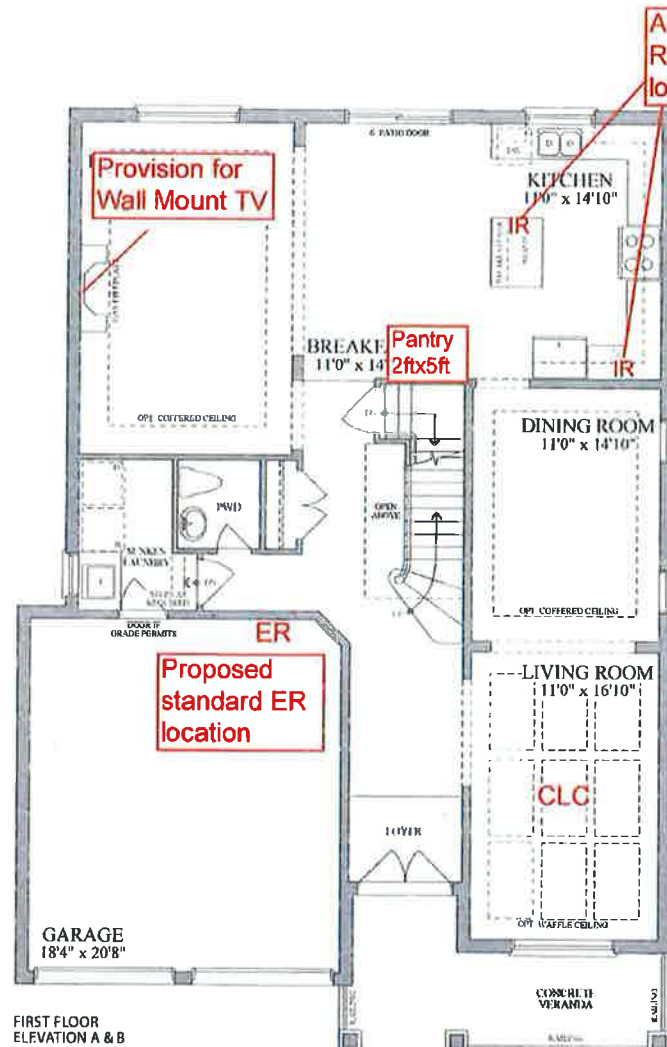

Shaukat Khan
Shaukat Khan (Mar 9, 2022 14:10 EST)

Nasreen Nasir
Nasreen Nasir (Mar 10, 2022 00:43 EST)



Plans and specifications are subject to change without notice. E & O E. Actual usable floor space may vary from the stated floor area. All renderings are artist's concept.



Additional Interior
Receptacle
locations.

Provision for
Wall Mount TV

Pantry
2ftx5ft

Proposed
standard ER
location

Additional entrance
to bathroom, with
split sinks.

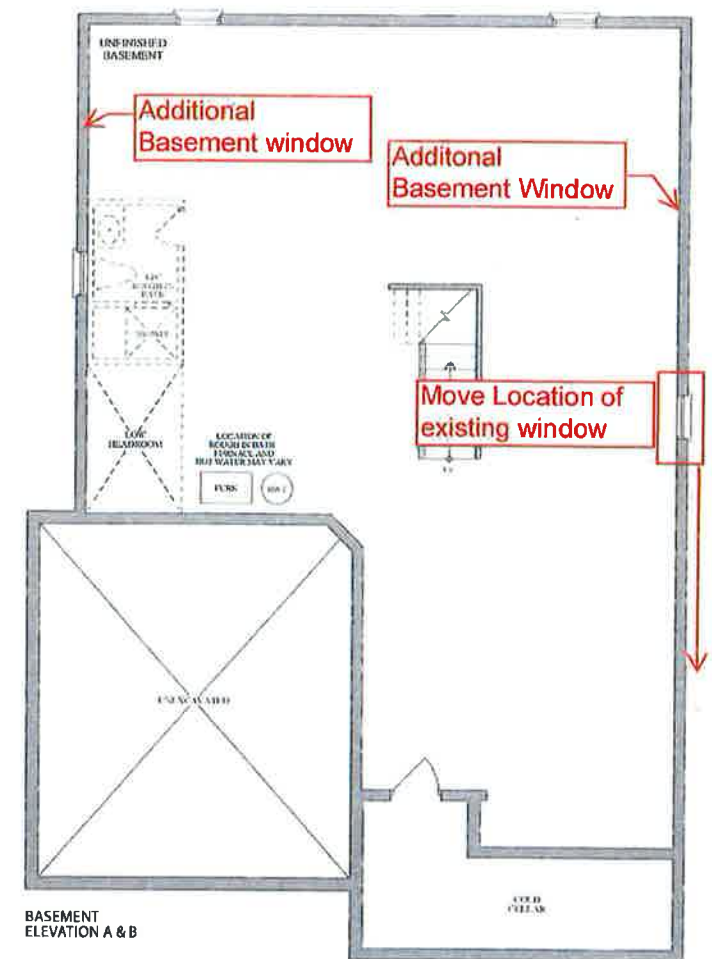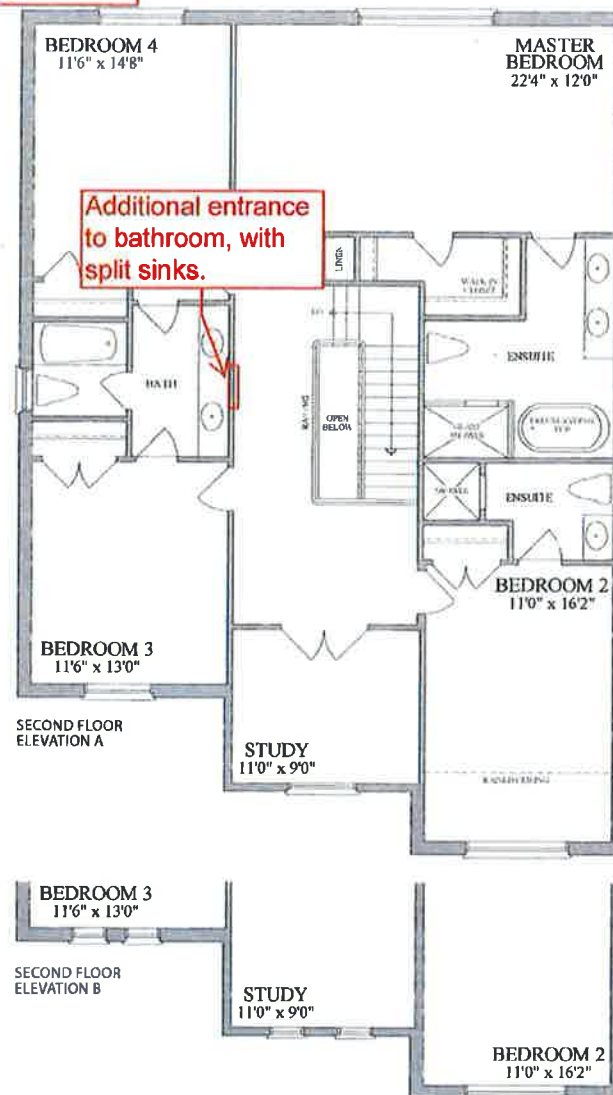

LOT 5-64, PH5, PE002