



The **Madawaska /** Elev. **3190** Sq.ft.

№

 \Box

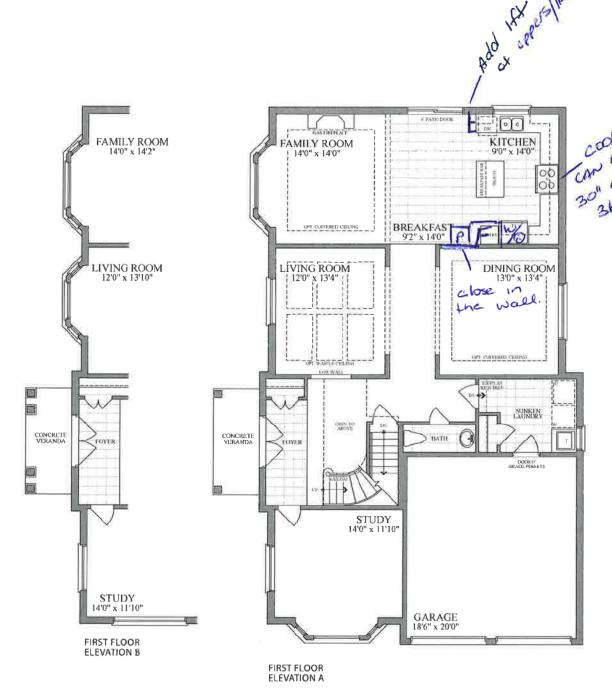

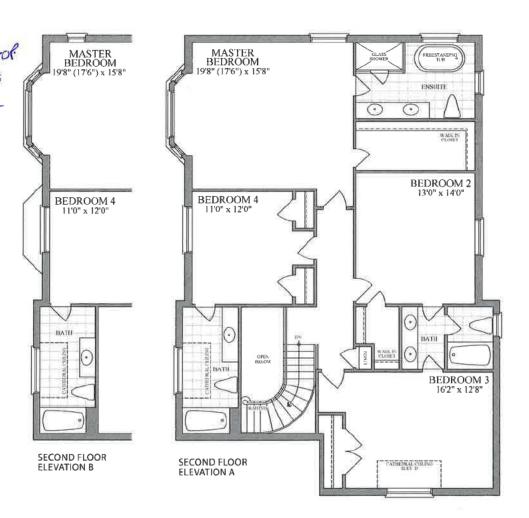

In order to accommodate Built-in Appliances

- 1. Close the opening into the Dining Room from the Kitchen.
- 2. Shift the Pantry and Fridge over.
- 3. Add 1 1/2ft kitchen extension to accommodate wall oven.
- 4. Provide specs for 30" or 36" cooktop
- 5. To balance kitchen, add an additional foot of upper/lowers on the sink wall
 - a) Built-in appliances provision -
 - b) 1 1/2 ft kitchen extension, (no granite required)
 - c) add 1ft on sink wall \$ (includes granite)

The above reflects what needs to be done in order to accommodate Built-in appliances properly.



