


38⁺
DESIGNS

The Superior / Elev. A & B
3 Car Tandem 3400 sq.ft. - includes 530 sq. ft. of finished area in lower level
2 Car Garage 3615 sq.ft. - includes 748 sq. ft. of finished area in lower level

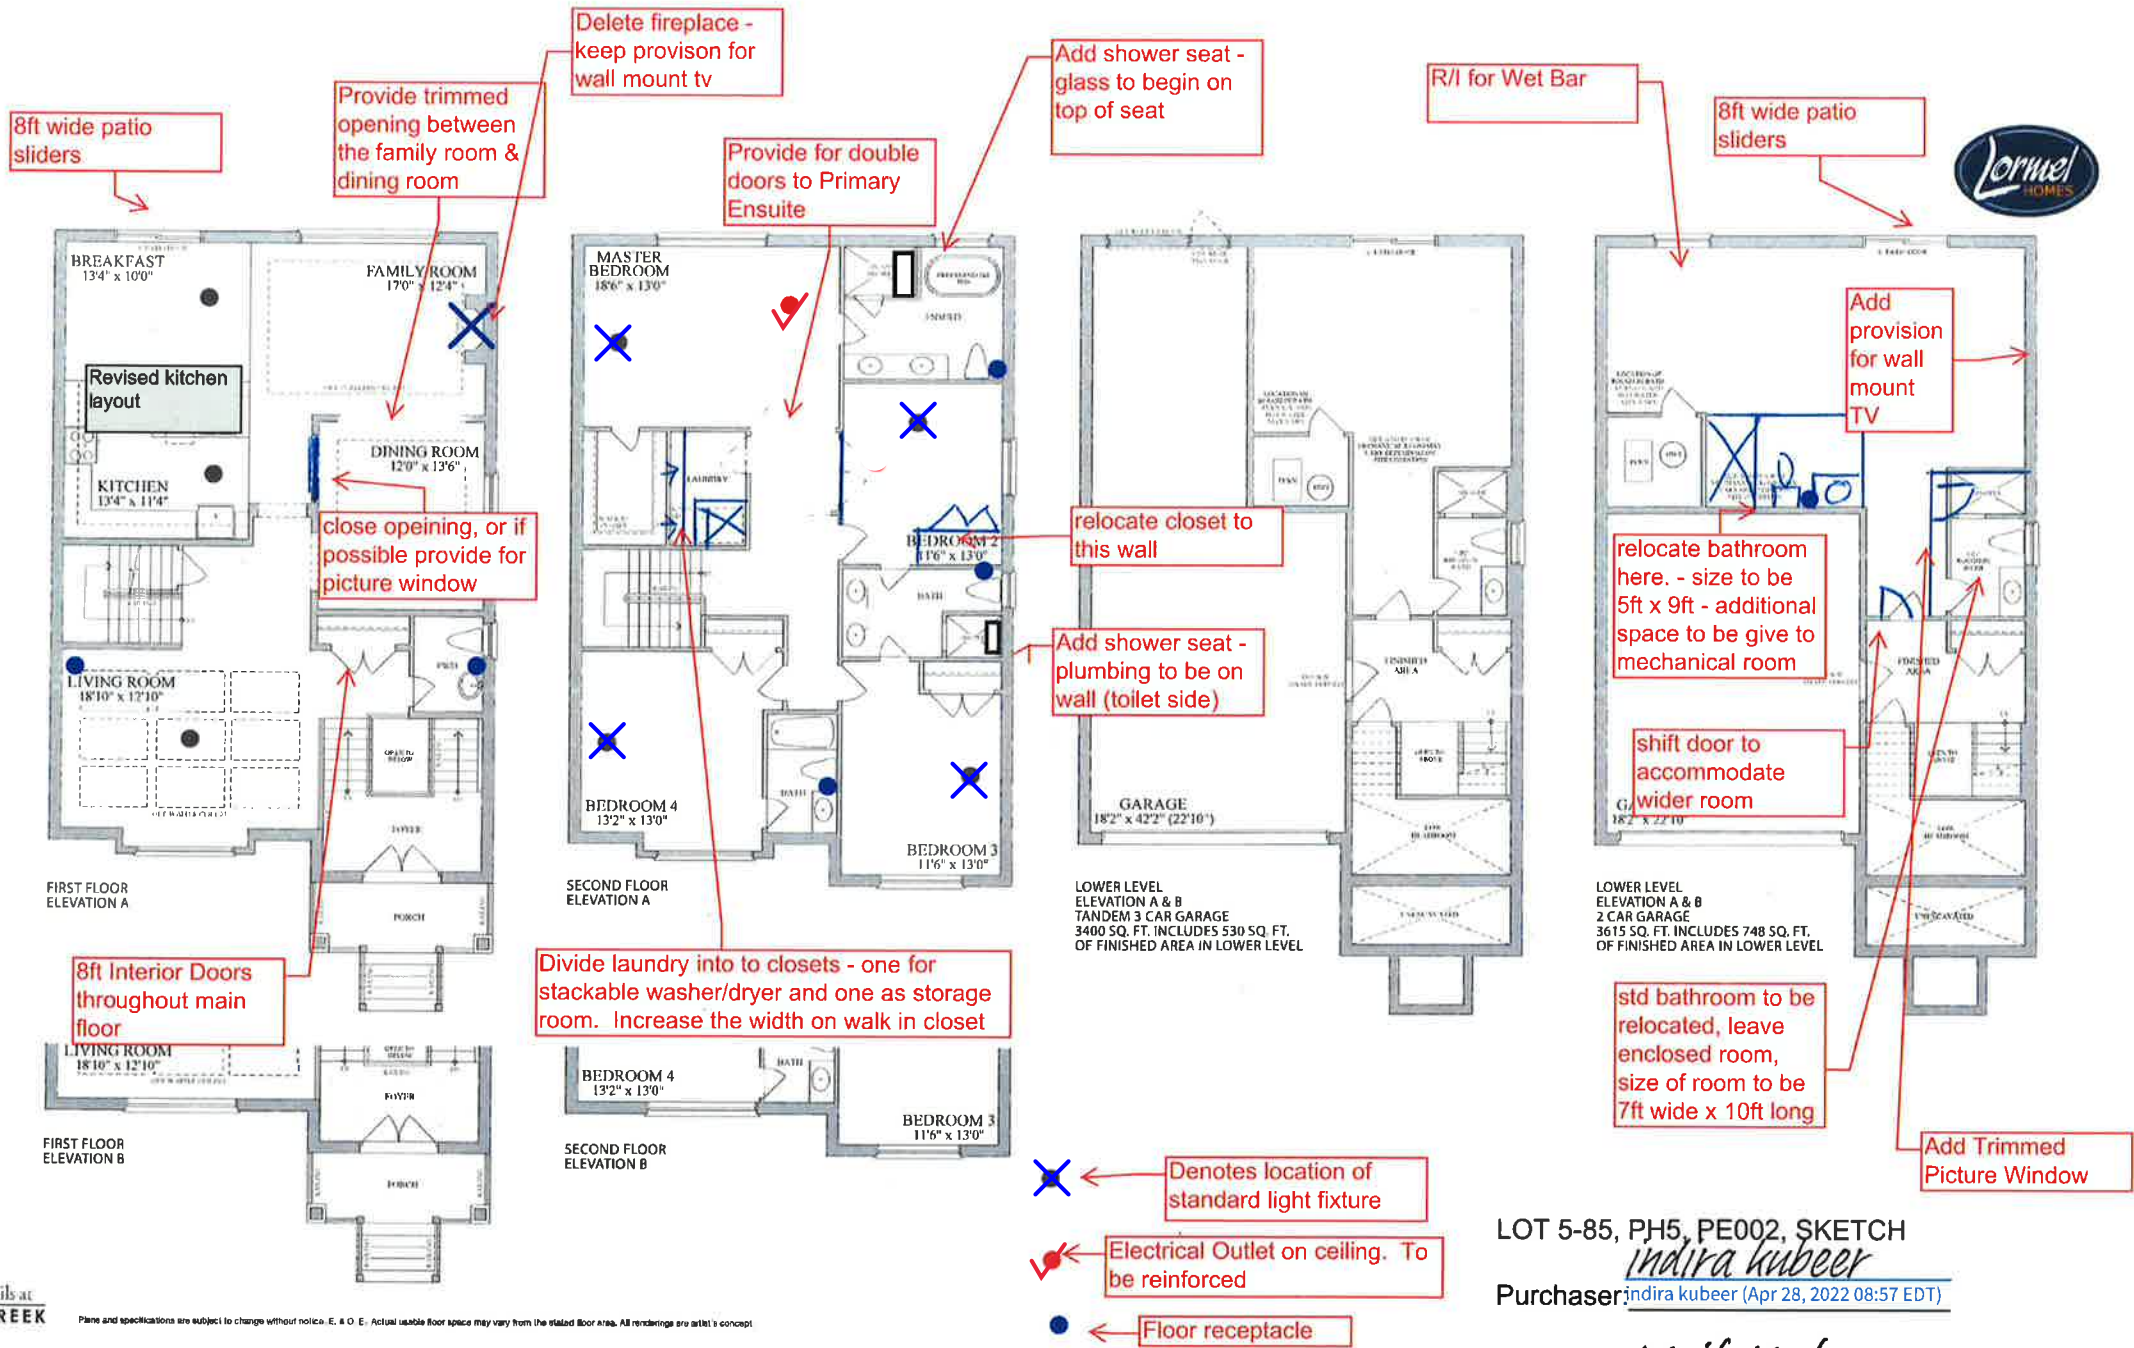

Plans and specifications are subject to change without notice. E, & O E - Actual usable floor space may vary from the stated floor area. All renderings are artist's concept.



LOT 5-85, PH5, PE002, SKETCH

indira kubeer

Purchaser: indira kubeer (Apr 28, 2022 08:57 EDT)

Neil Kubeer

Purchaser: Neil Kubeer (Apr 28, 2022 09:02 EDT)