



## BELLAIRE PROPERTIES INC. (CARSON'S CREEK) PURCHASER EXTRAS

### LOT # 019 P.E #002 - Model - TEMAGAMI - 3350 - PHASE 5

Attention Trades...

The following items below are Purchaser Extras, please make sure that they are done on time and properly complete. Any outstanding items will be Back Charged. If you have any questions please call Roberto Ruiz. Make sure that you review <u>ALL</u> of the items on the Purchaser Extras.

Please be advised that Purchase Orders will come at a later date.

\*\*\*Also, it is very important to speak to Roberto Ruiz before starting on site \*\*

#### TRADE: ITEMS TO BE COMPLETED

Liberty	#1, #2, #5
Internazionale Electric	#1, #5
Kingswood	#1, #5
Advance Marble	#2, #5
Cpl Aluminum	#3
Maple Drywall	#4
Miranda Painting	#4
Pipecon	#5
Allstar Carpentry	#5

Date: Jul.-05-2022 From: Lormel Homes Site Clerk: Jai Fitzgerald Site Tel: 905-775-3633 Site Fax: 905-775-9083

**NOTE:** If more information is needed please call Roberto Ruiz cell-416-688-9324 If more information needed on quotes or changes, please call Zachary 905-832-2023 ext. 224



PURCHASER



#### Schedule B-3 – Purchaser's Extras

forming part of the Agreement of Purchase and Sale

VENDOR: BELLAIRE PROPERTIES INC.

PURCHASER(S): CAN MUI HO LOT NUMBER: 19 PHASE: <u>5</u> MODEL: TEMAGAMI (3350)

P.E.#: 002

It is understood and agreed that no requests for changes, additions or deletions will be accepted by the Vendor for the above extras after the date of acceptance of this order

No.				
1	*Provisions to cabinetry to accommodate future chimney hood fan/exhaust fan above future stove/range in kitchen area.  *Note: Not all models can accommodate this change.  *Builder will try to accommodate centering the vent as best as possible. Purchaser must provide all specifications for future Chimney Style Hood fan/Exhaust Fan as soon as possible. This item must be decided prior to framing stage, otherwise may be considered too late.			
2				
	Free-Standing Range in the kitchen area. Price is based on Vendor's standard countertop.			
	Purchaser must provide model Specifications that show install and cut out instructions for the			
	range must be provided at interior colour selection appointment.			
	*Note: A slide-in range fits flush with the countertop and the cooktop portion slightly protrudes which rests on top of the countertop on either side. An additional piece of countertop behind the range is required, unless otherwise specified by the manufacturer.			
3	Cost to Provide Black Exterior railing at front elevation in lieu of standard.			
	*Based on standard elevation			
	*Note, due to lot grading some elevations may not require any railing at stairs or porch, in the			
4	event that railing is not required purchaser will be credited back amount charged  Cost to provide smooth ceilings in lieu of stippled ceilings - main floor			
5	<ol> <li>Provide and install two pantries – each 2ft deep by 39" wide</li> <li>Fridge opening – 37" wide – to be centered between the two pantries.</li> </ol>			
	3. Extended space between the sink and 1 <sup>st</sup> pantry (approx. 1ft)			
	4. Counter depth fridge enclosure with extended upper cabinet above fridge.			
	<ul><li>5. Kitchen Island (standard is 3ft wide by 6ft long, which includes the overhang for the breakfast bar)</li></ul>			
	a. Extend kitchen island to 3ft (36") x 9ft (with breakfast bar)			
	b. Extend kitchen island granite depth to a total of 44" (36" standard depth with 8" overhang)			
	6. Additional granite for kitchen extension including the island.			
	7. Price is based on standard cabinetry and standard granite.			
	8. All upper cabinetry and pantry to be extended to the bulkhead – standard 9ft ceilings.			
	Extra's Subtotal:			
	H.S.T.			
New Total:				
Less Bonus Package (if Applicable)				
	TOTAL:			
Amount to be Added to the Purchase Price as an Adjustment on Closing:				
	TOTAL			

The above extras and upgrades are to be included during the construction of the above house for the above-named purchaser subject to the following terms and conditions:

•	The Vendor will undertake to install the above extras but will not be liable to the pur In that event, the price of the extra shall be refunded to the purchaser without any ir It is understood and agreed that if the transaction of Purchase and Sale is not comple refundable.	ed for any leas in mats every the tyles of the extra is not to
PAID:		erms: cConstruction
Can Mui He Can Mui ho (Jun 30, 2022 00:01 EDT)  PURCHASER		BELLAIRE PROPERTIES INC.
- UNCHASEN		(original verified at

Car

Garage

**3350** sq.ft.


- includes 760 sq. ft. of finished area in lower


finished area in lower level


# 24 $\bigcirc$ Temagami Elev. $\triangleright$ $\infty$

Car Tandem **3068** sq.ft. - includes 478 sq. ft. of  $\Box$  LOT 5-19, PH5, STRUCTURAL OPTIONS - PE002 PURCHASER: Can Mui Ho (Jun 30, 2022 00:01 EDT)



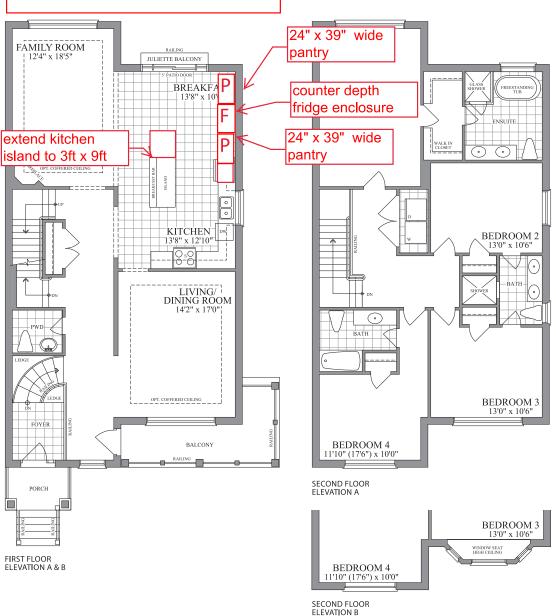

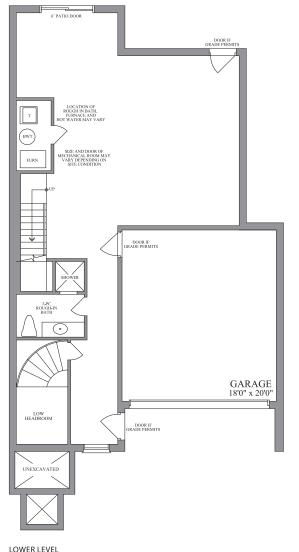

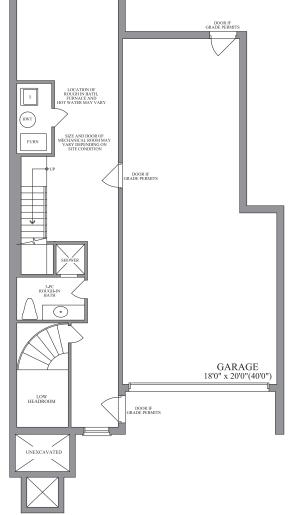

LOWER LEVEL ELEVATION A & B 2 CAR GARAGE 3350 SQ. FT. INCLUDES 760 SQ. FT. OF FINISHED AREA IN LOWER LEVEL

LOWER LEVEL ELEVATION A & B OPT. TANDEM 3 CAR GARAGE 3068 SQ. FT. INCLUDES 478 SQ. FT. OF FINISHED AREA IN LOWER LEVEL

