




The maddawaska / Elev. A & B
3190 sq.ft.

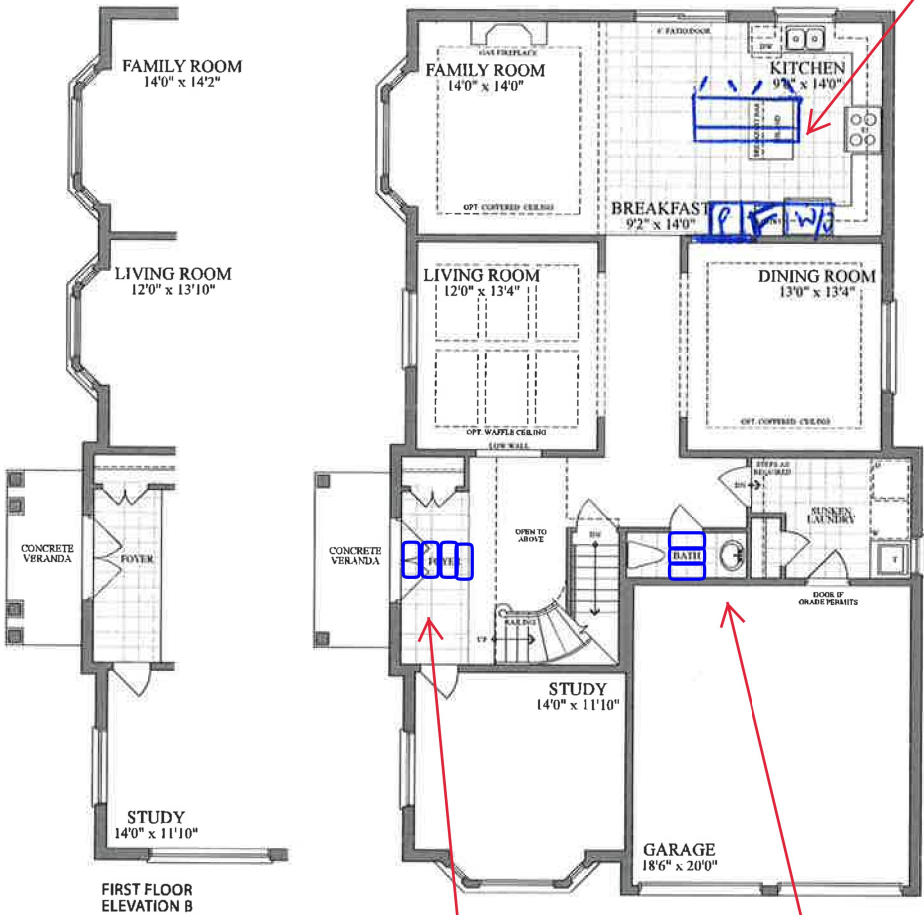

FIRST FLOOR ELEVATION B

FIRST FLOOR ELEVATION A


Foyer: Tiles to be installed stacked horizontally from door

Powder Room: Tiles to be installed stacked horizontally from door


Increase island base cabinet 2'ft by 7'ft plus approx. 1'ft flat breakfast bar (counter)




SECOND FLOOR ELEVATION B

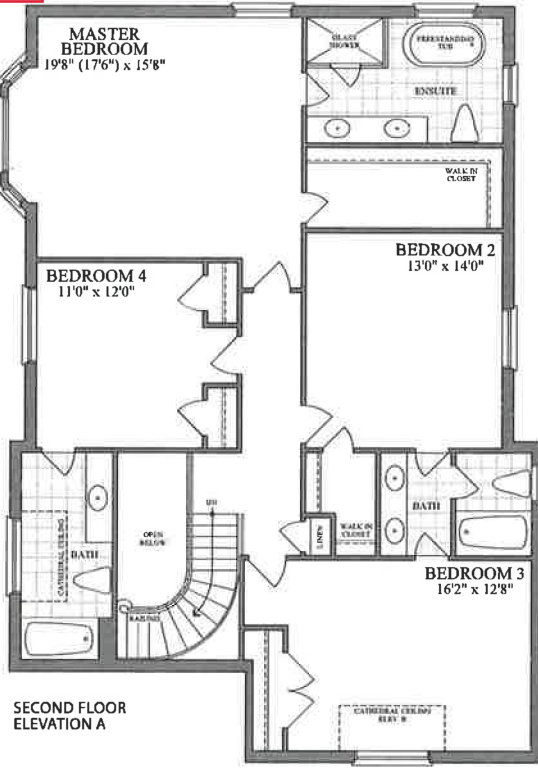

SECOND FLOOR ELEVATION A

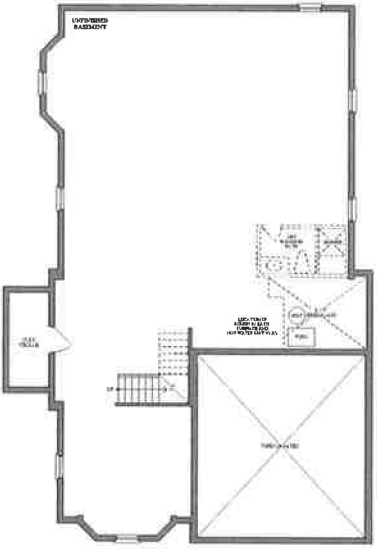

BASEMENT ELEVATION A

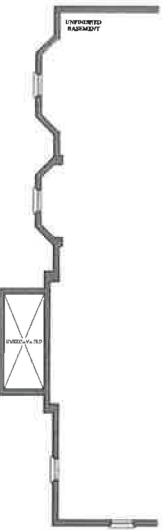

BASEMENT ELEVATION B



Plans and specifications are subject to change without notice, E. & O. E. Actual usable floor space may vary from the stated floor area. All renderings are artist's concept.