SUITE 603

D.S.

KAZ-43

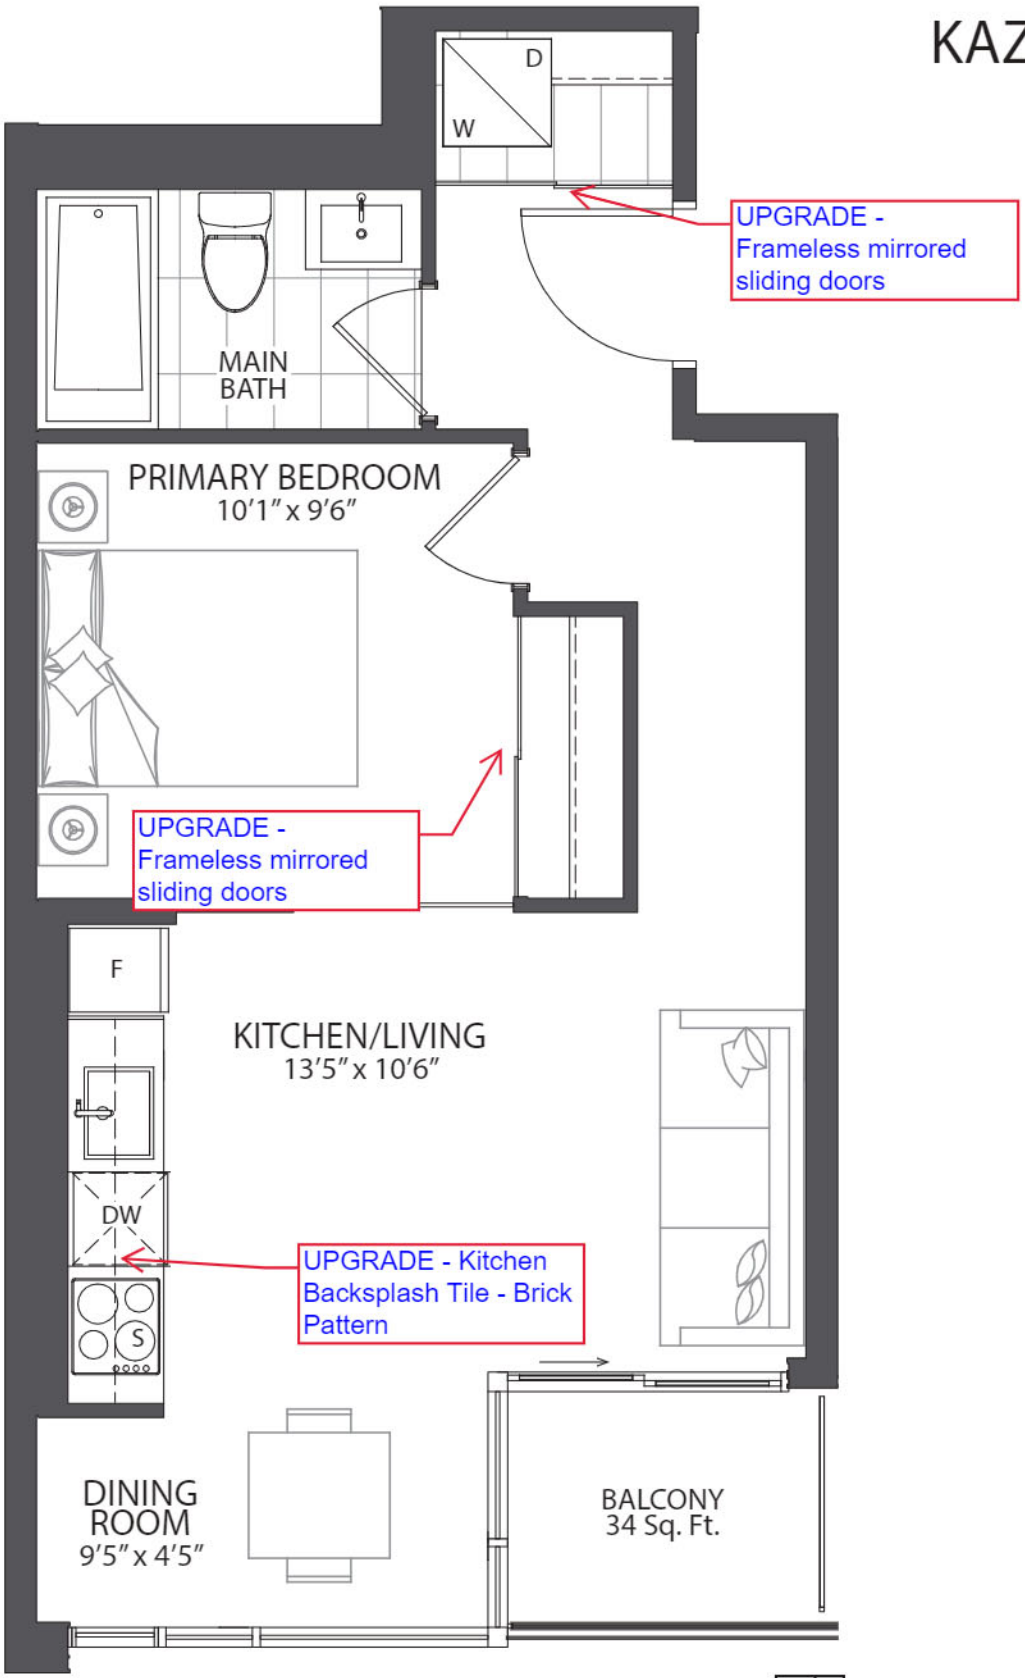
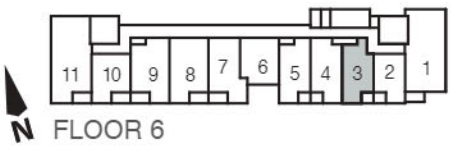
LORMEL
KAZMIR
603 - 1B (497 SF)