
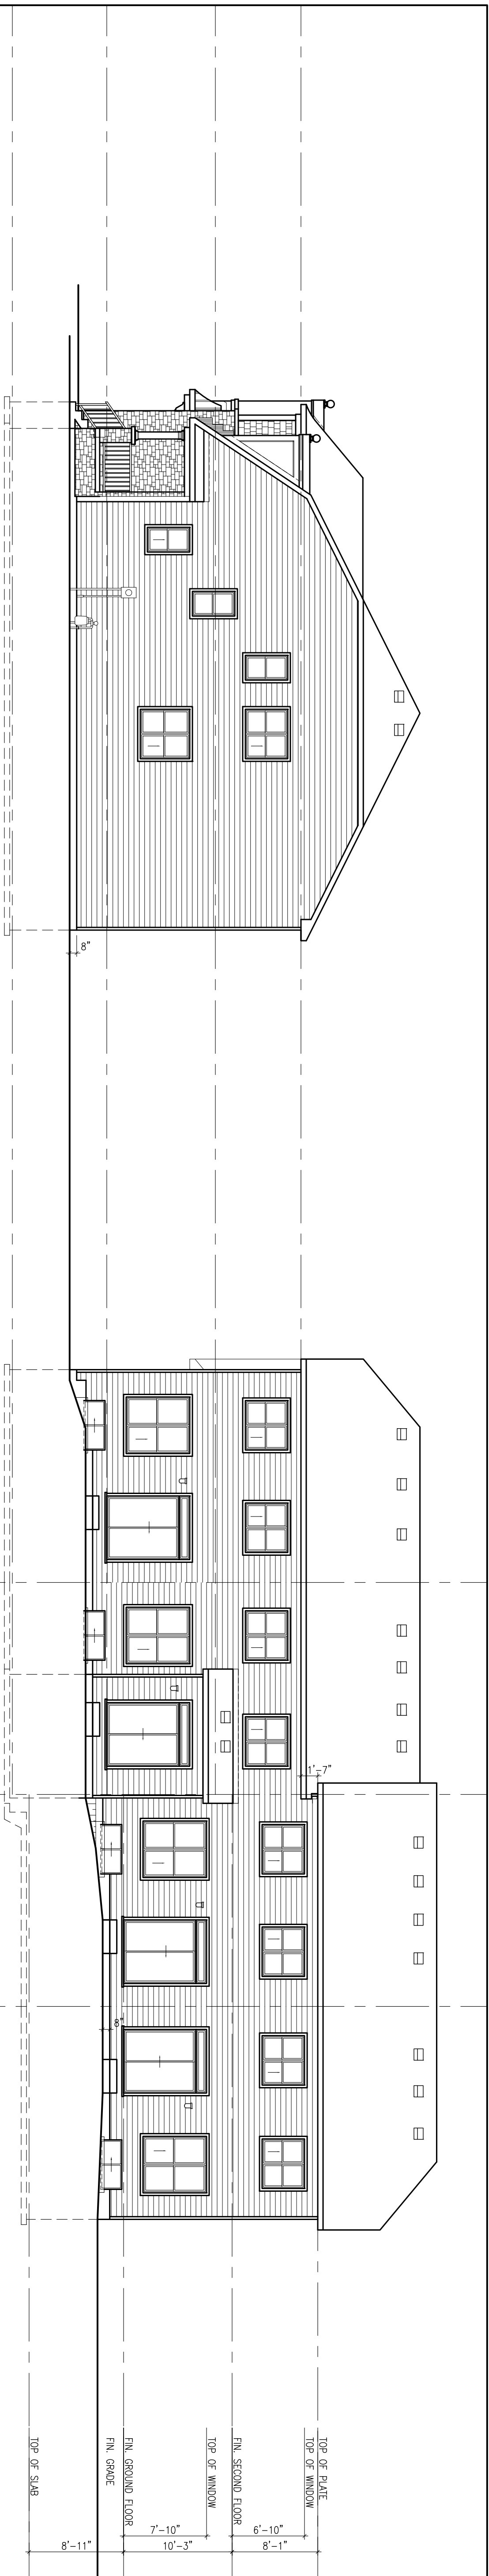


AREA = 336.40 SM
(3621 SF)

[illegible]

UNIT T20-6 (REV.)
1
ELEV. '8'

- 1 UNIT 120-6 (REV.)
ELEV. '8
- 2 UNIT 120-4
ELEV. '8
- 3 UNIT 120-3 (REV.)
ELEV. '8
- 4 UNIT 120-5 END
ELEV. '8

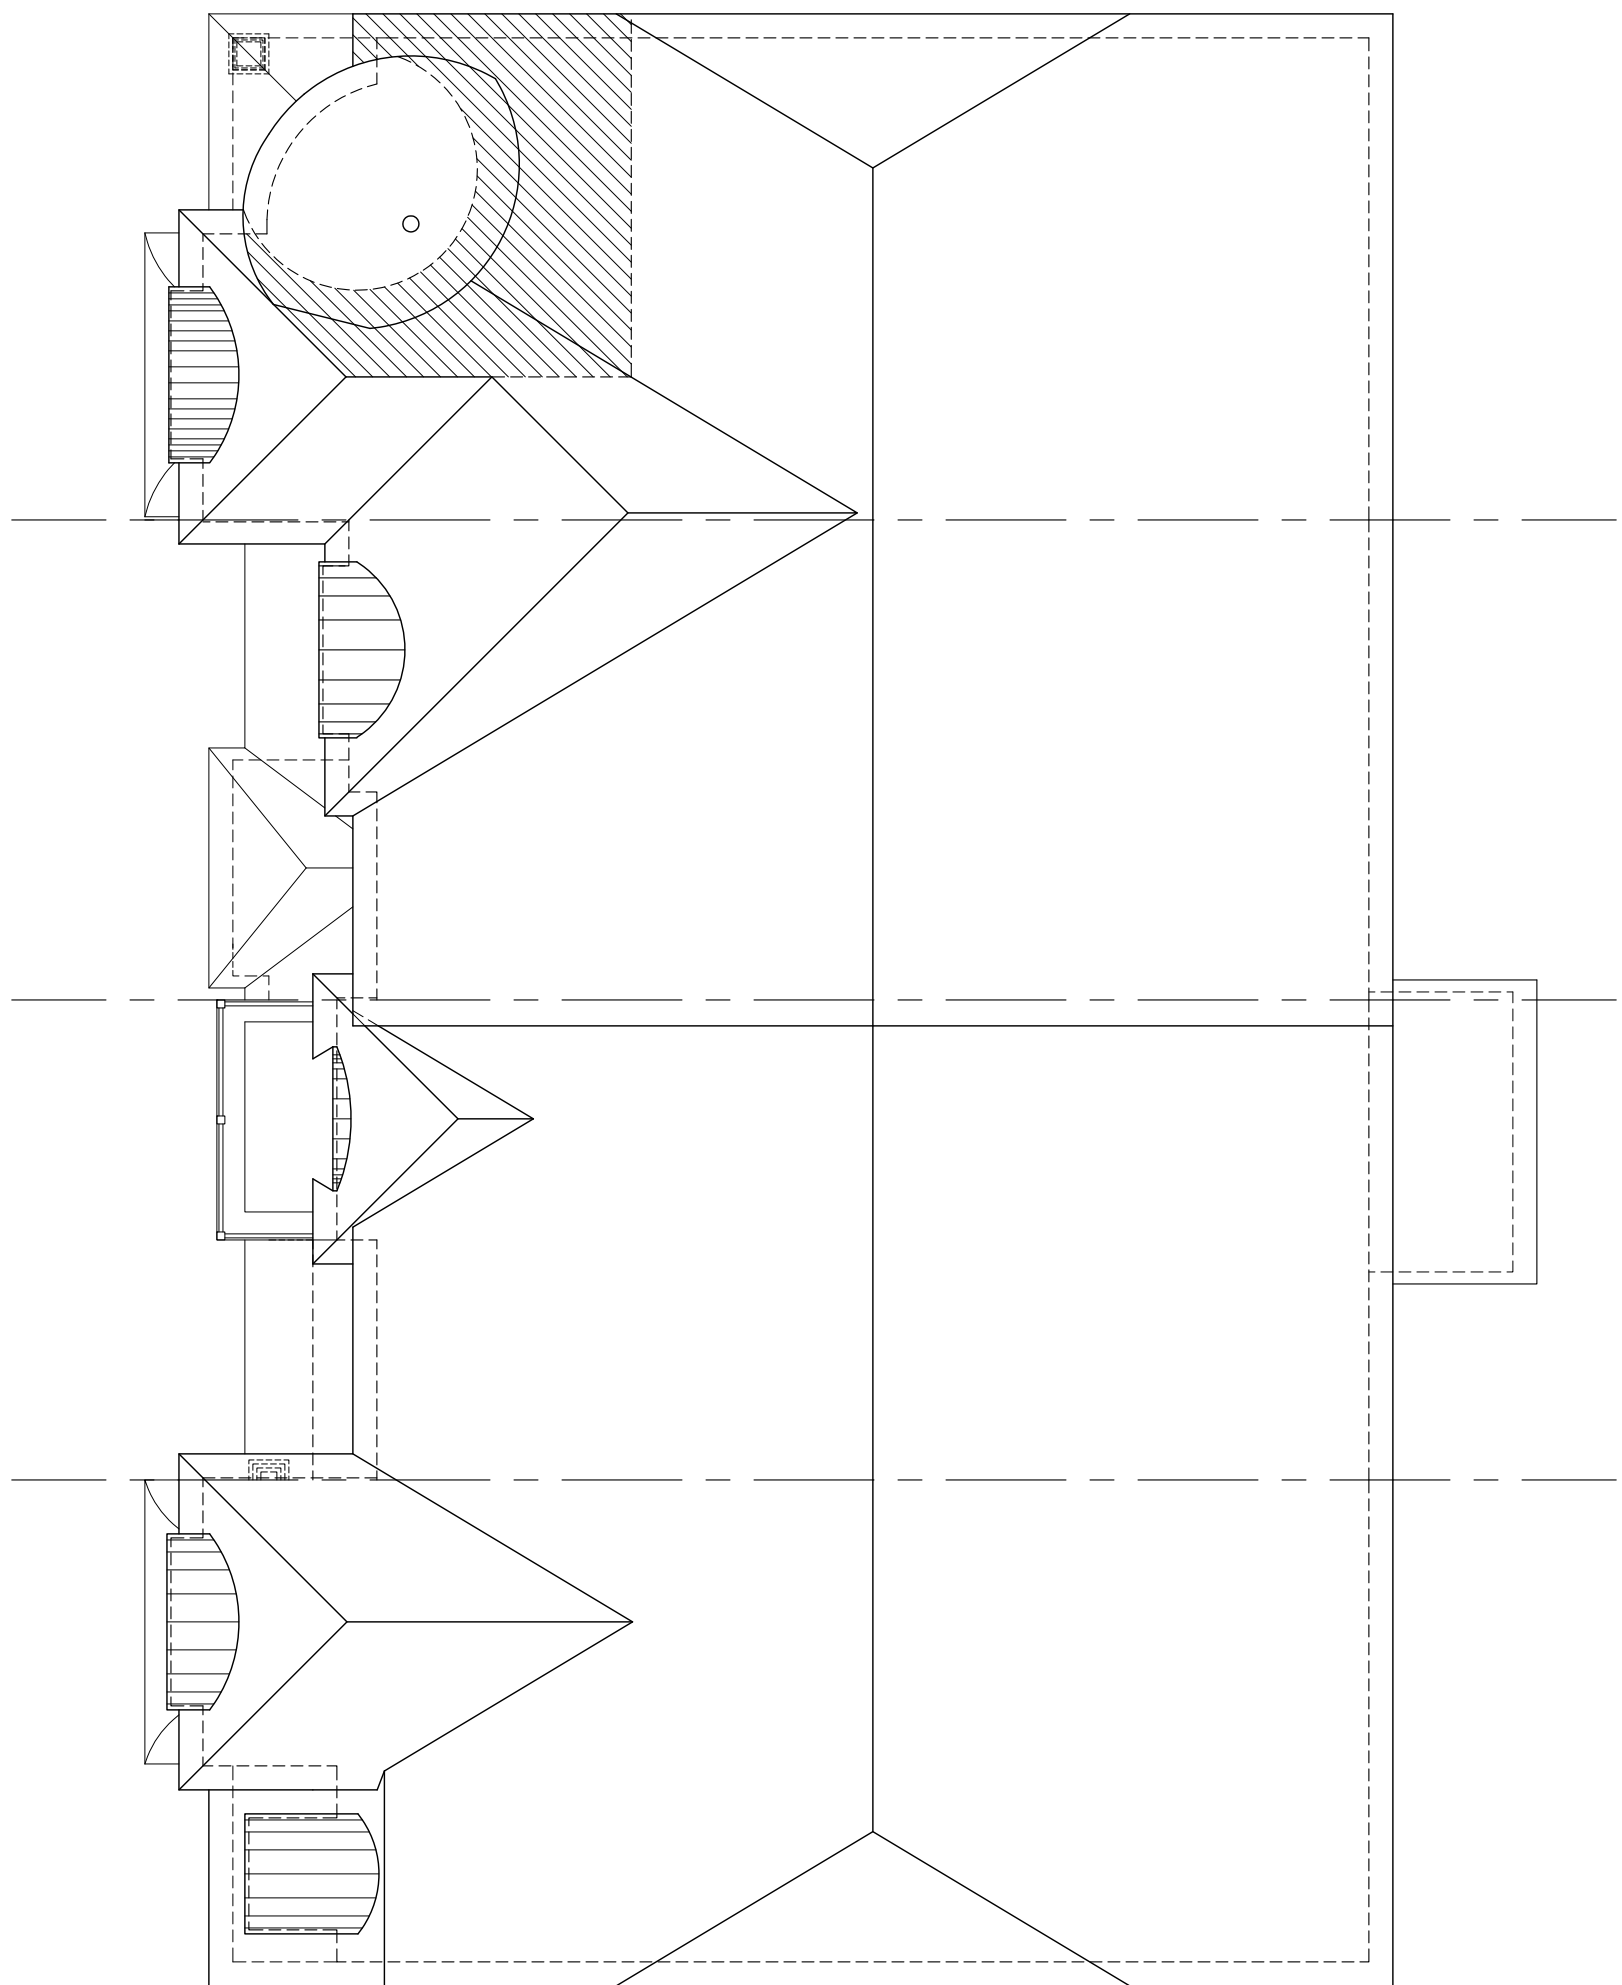


ROOF PLAN

④ UNIT 120-5 END
ELEV. 'B'

③ UNIT 120-3 (REV.)
ELEV. 'B'


② UNIT 120-4
ELEV. 'B'

① UNIT 120-6 (REV.)
ELEV. 'B'

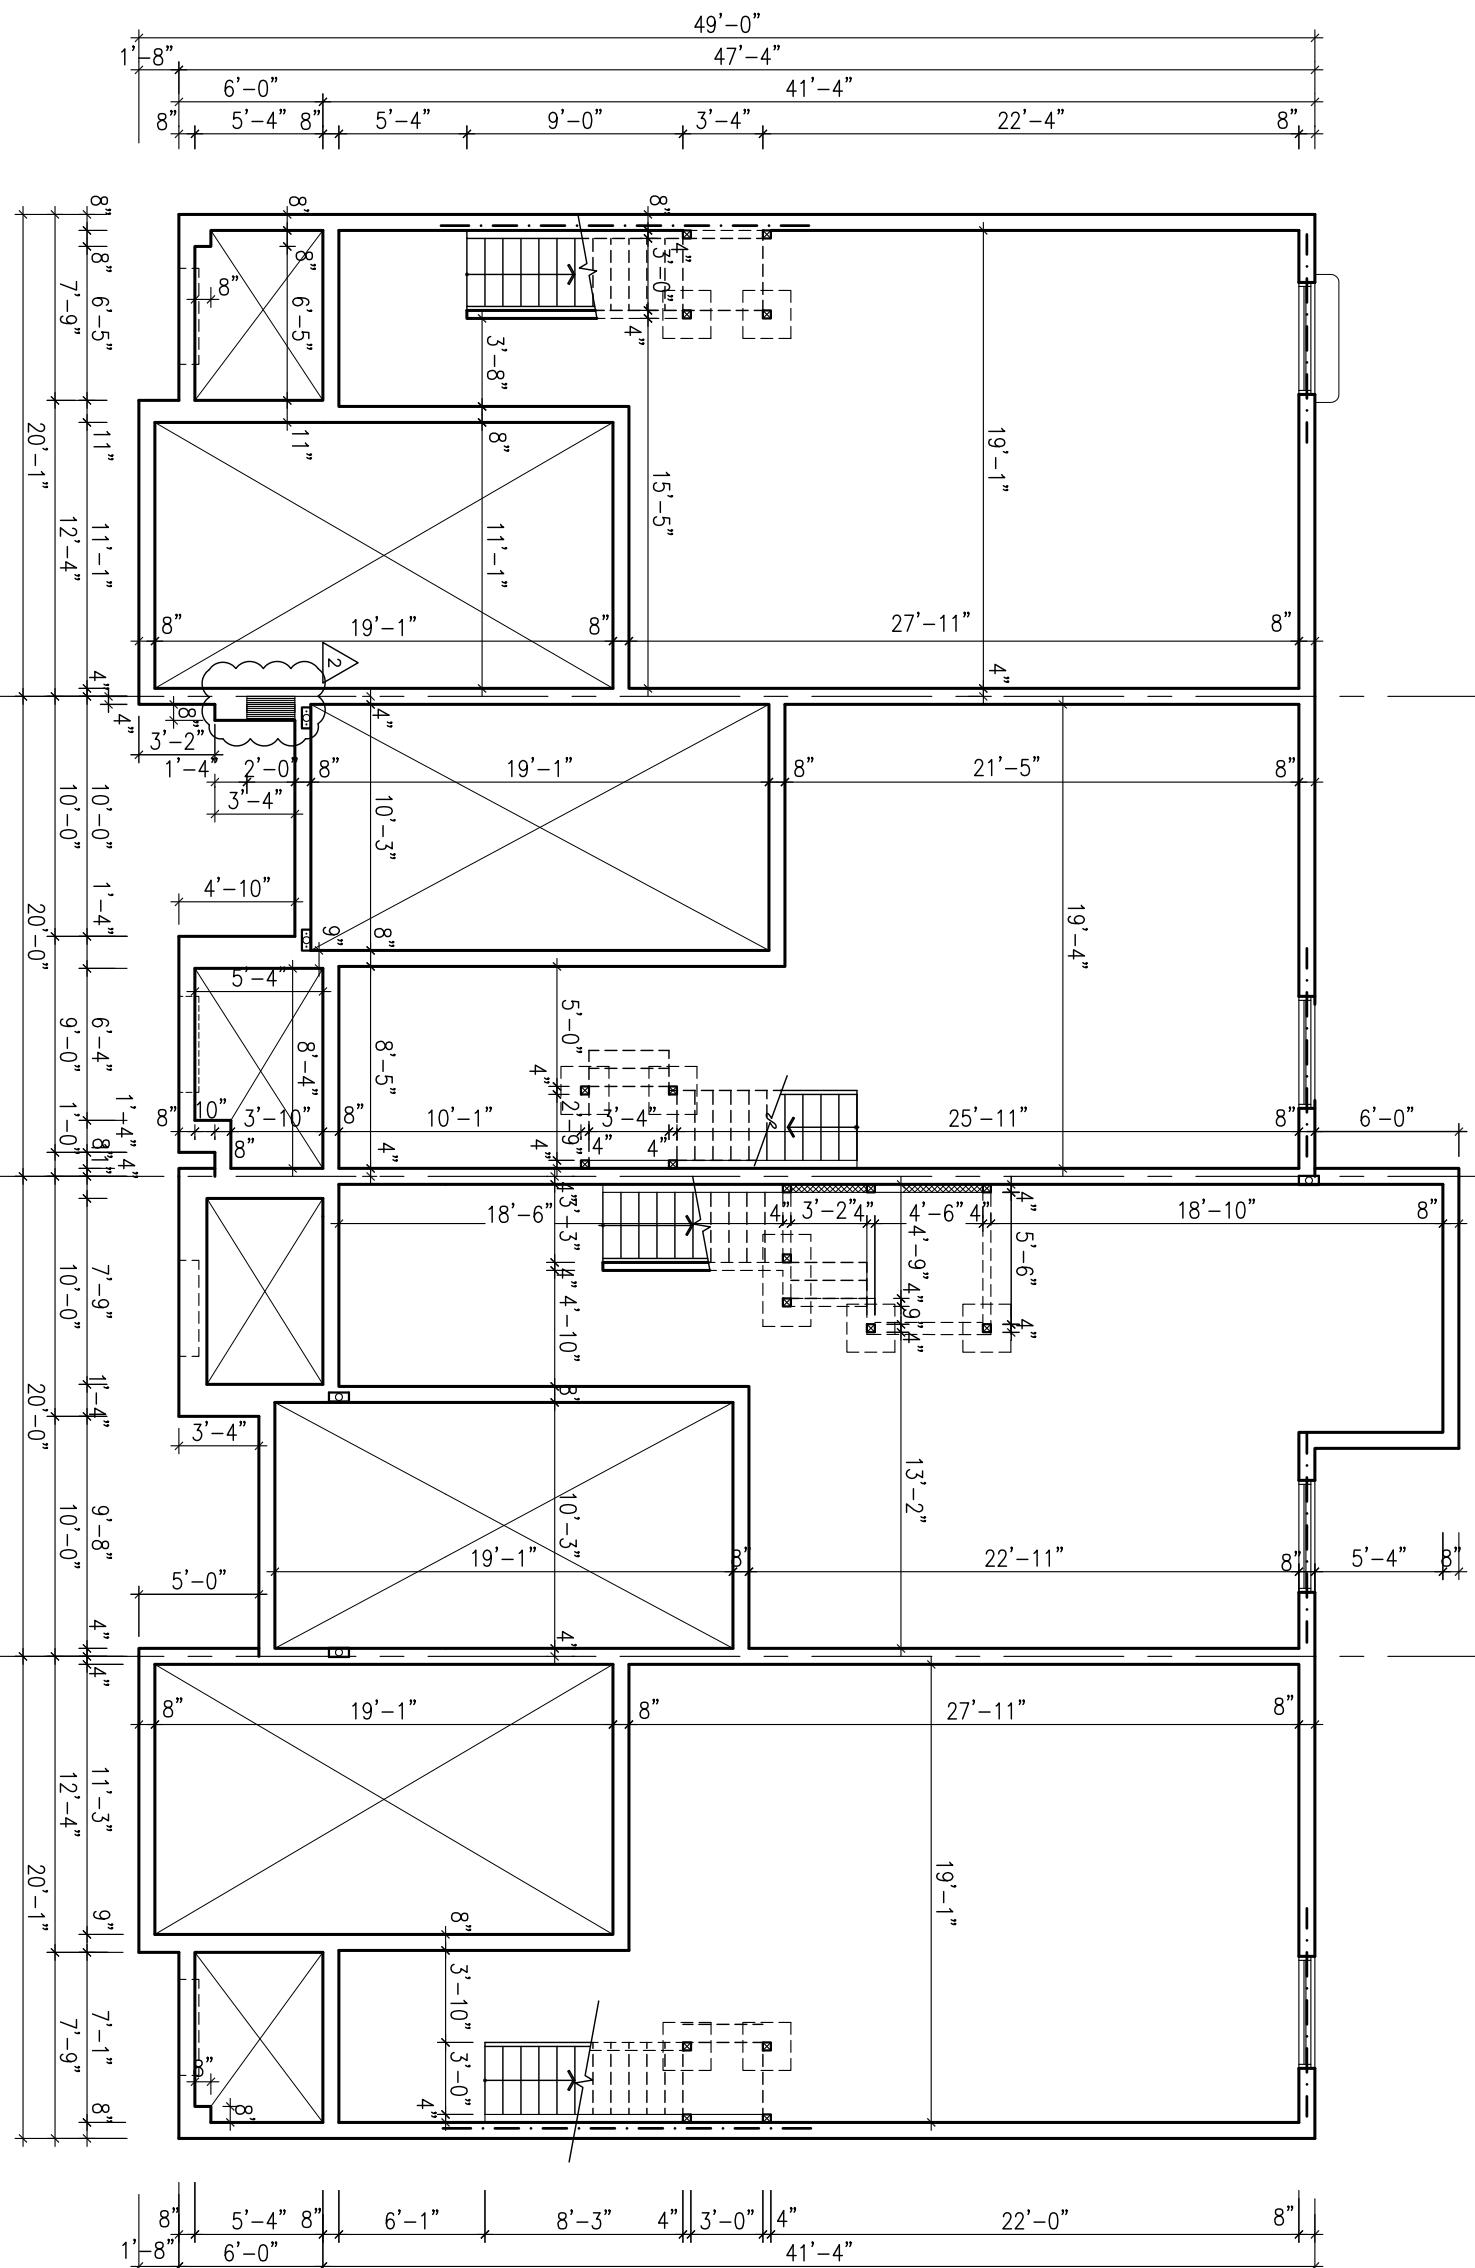


FOUNDATION PLAN

4	UNIT T20-5 END	3	UNIT T20-3 (REV.)	2	UNIT T20-4	1	UNIT T20-6 (REV.)
ELEV. '8"		ELEV. '8"		ELEV. '8"		ELEV. '8"	

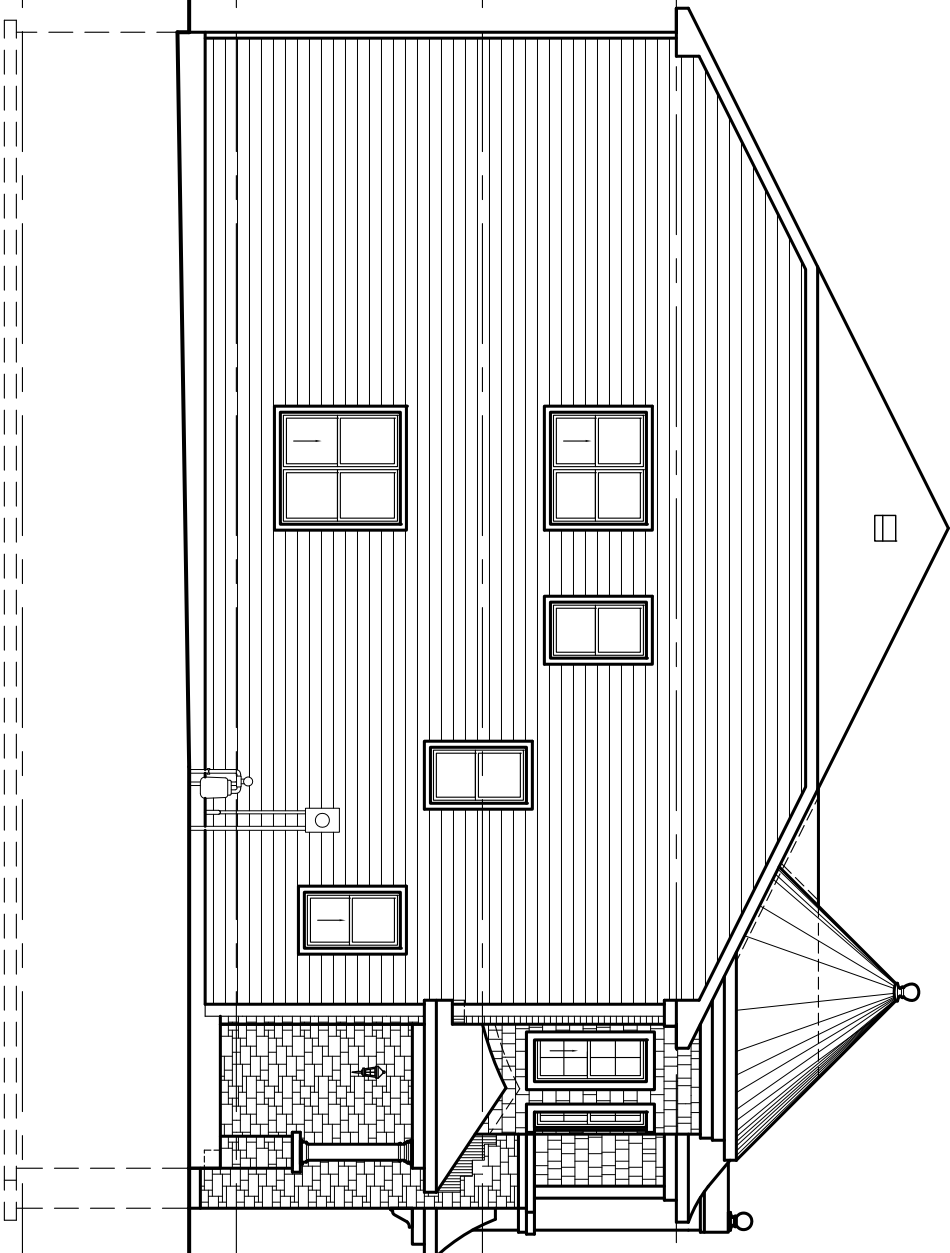

UNIT T20-5 END
4
ELEV. 'B'

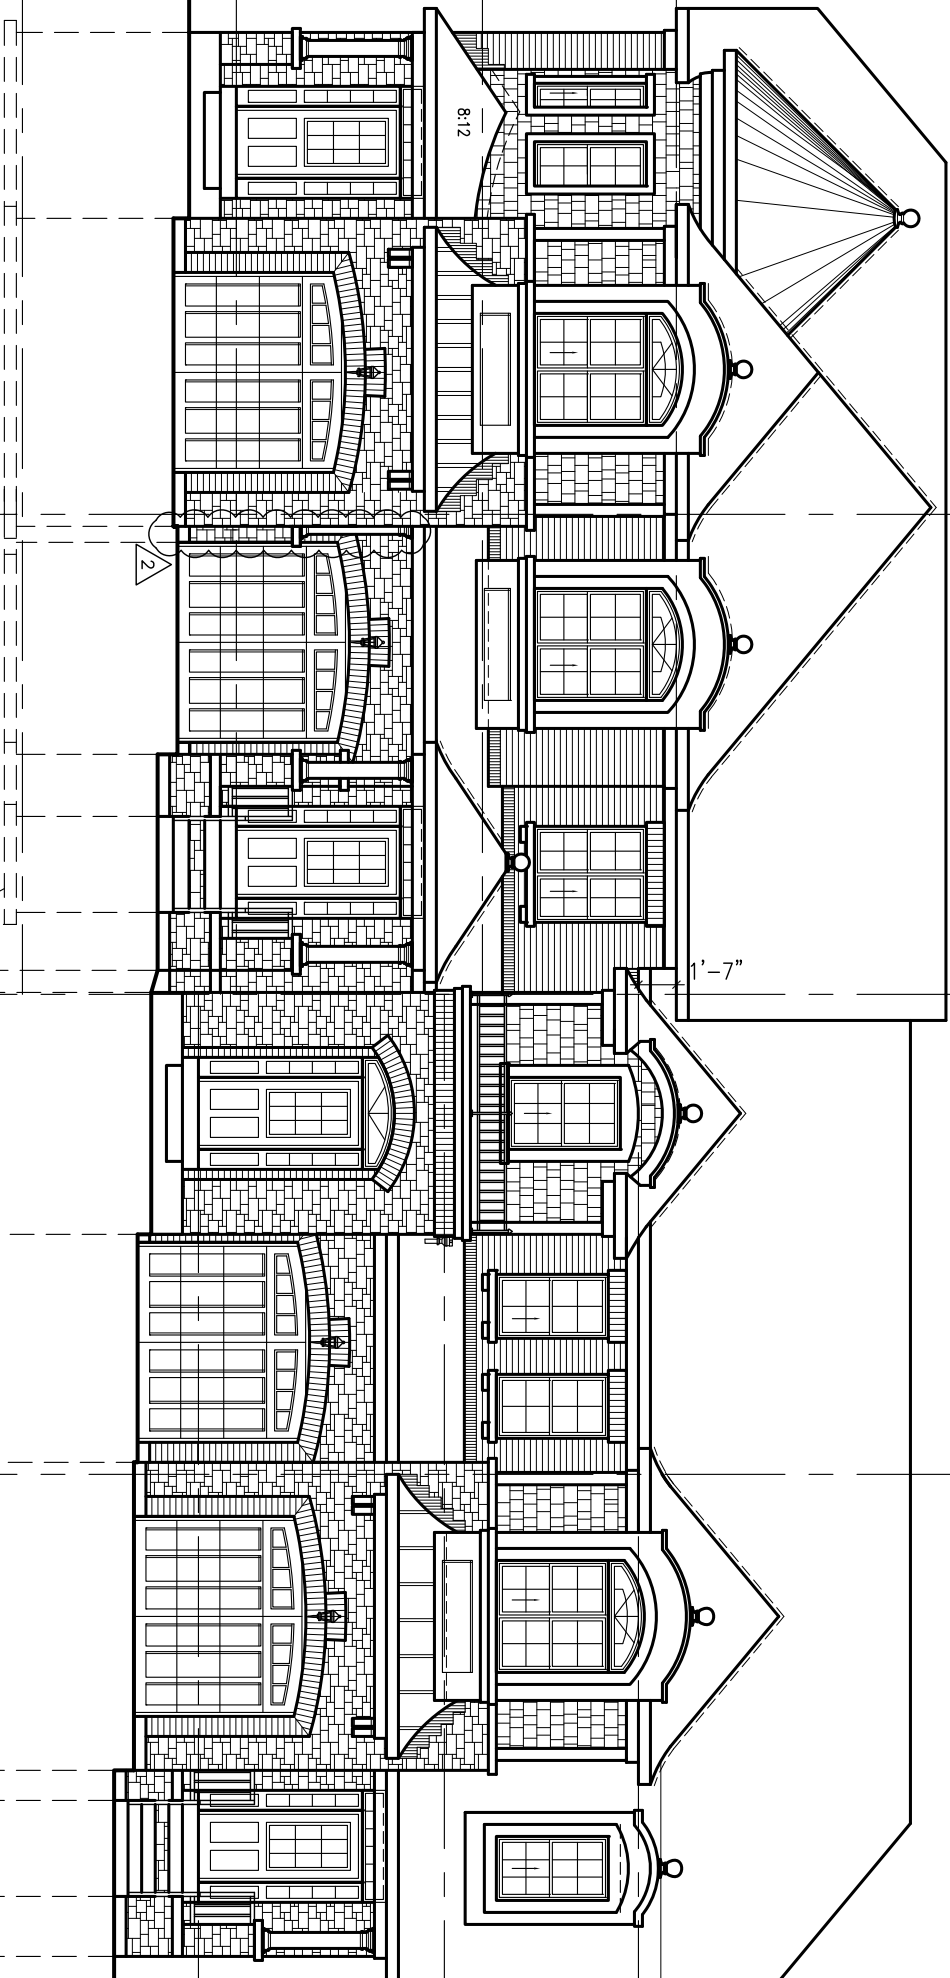

FRONT ELEVATION

4	UNIT T20-5 END
ELEV. '8'	
3	UNIT T20-3 (REV.)
ELEV. '8'	
2	UNIT T20-4
ELEV. '8'	
1	UNIT T20-6 (REV.)
ELEV. '8'	

BLOCK 172

[illegible]