


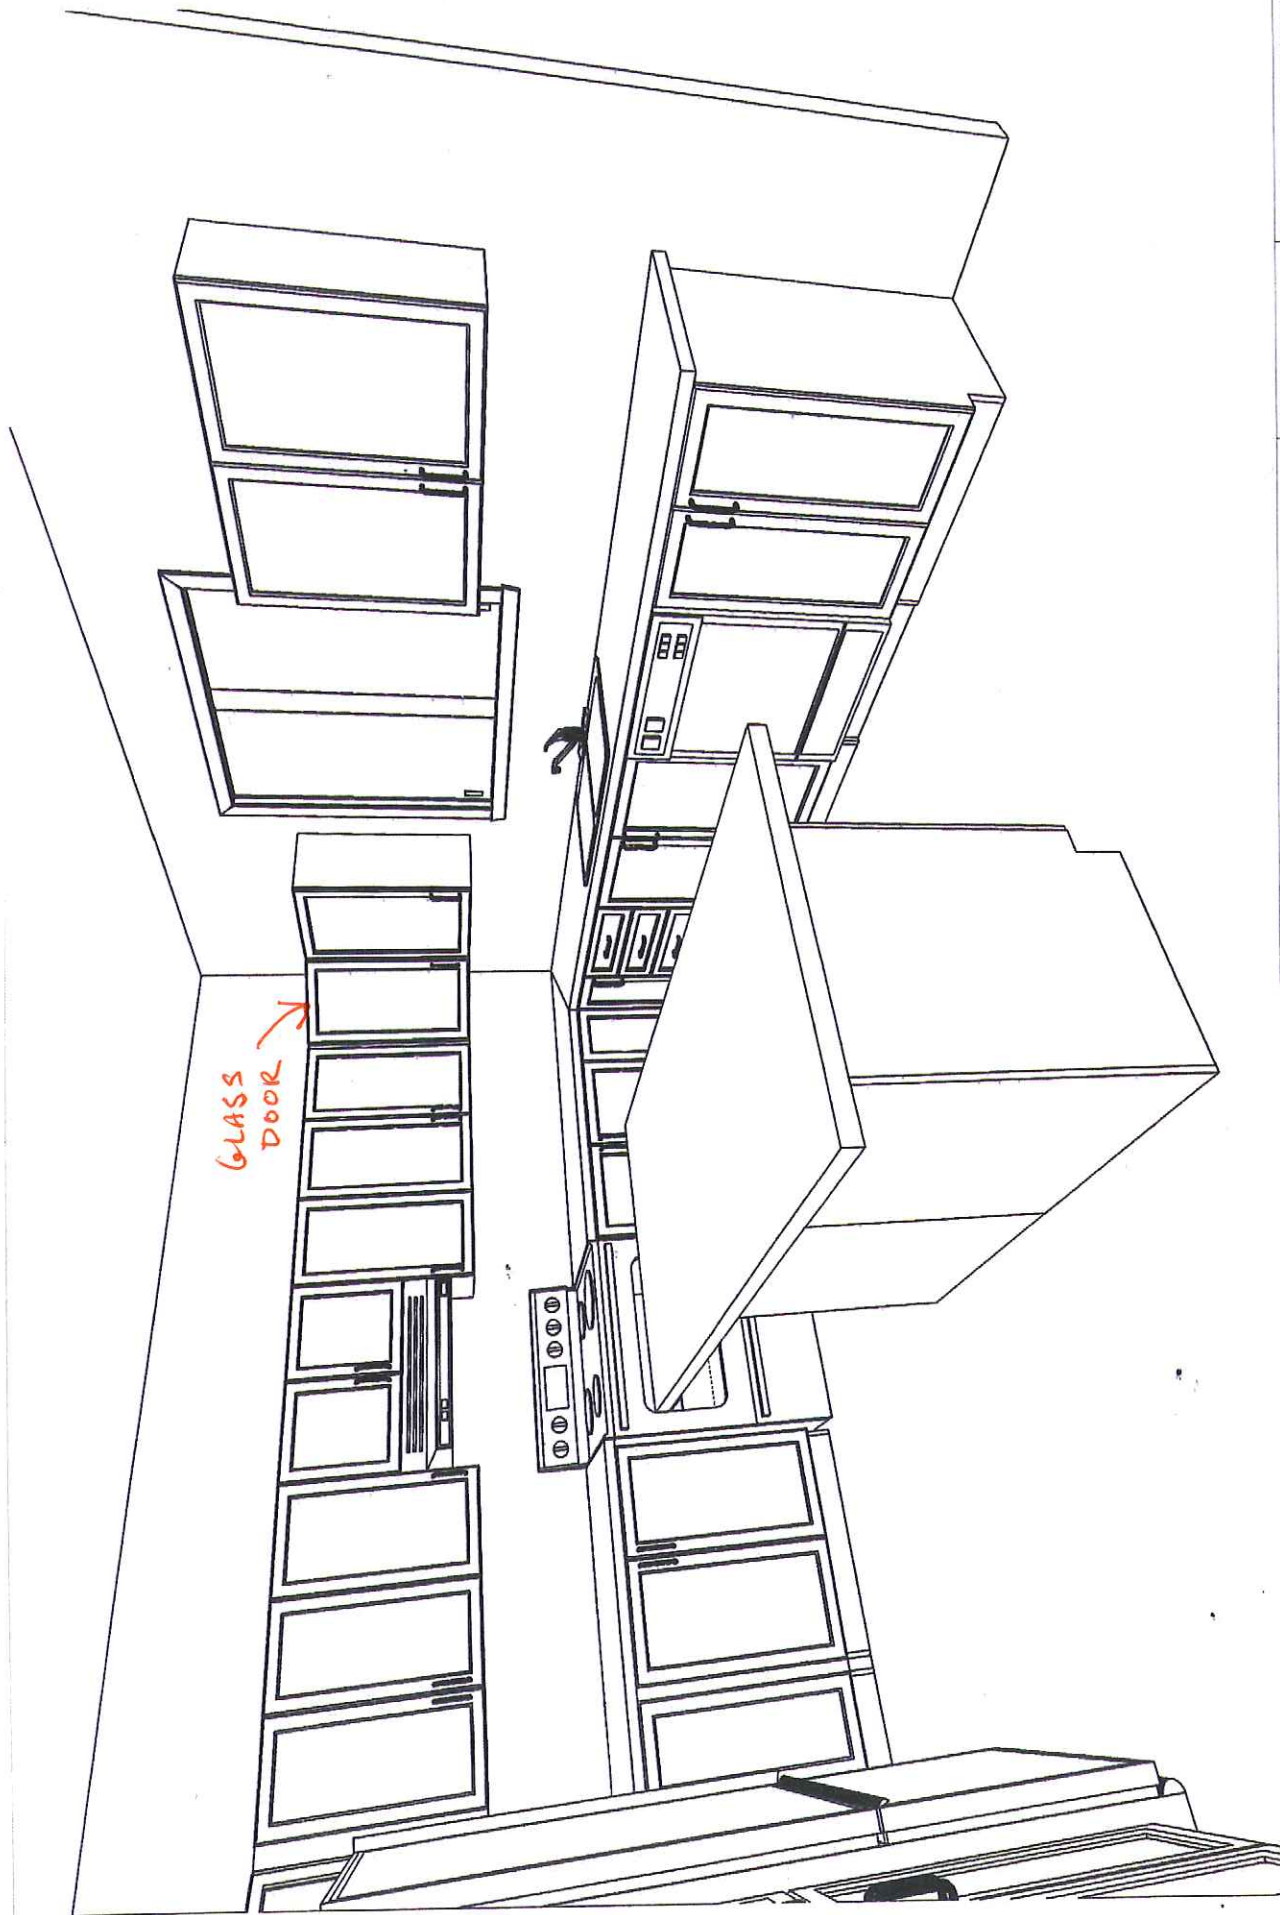

GLASS
DOOR

LOT 45 FC

H.T. NP

Jan. 14/14

Note: This drawing is an artistic interpretation of the general appearance of the design. It is not meant to be an exact rendition.


DRAWN BY: Lori Di Saverio, B.I.D.
CARTIER KITCHENS OTTAWA
DCR - PALTINA (512) - LEFT



Designed: 11/30/2008
Printed: 6/26/2011

All

Drawing #: 1

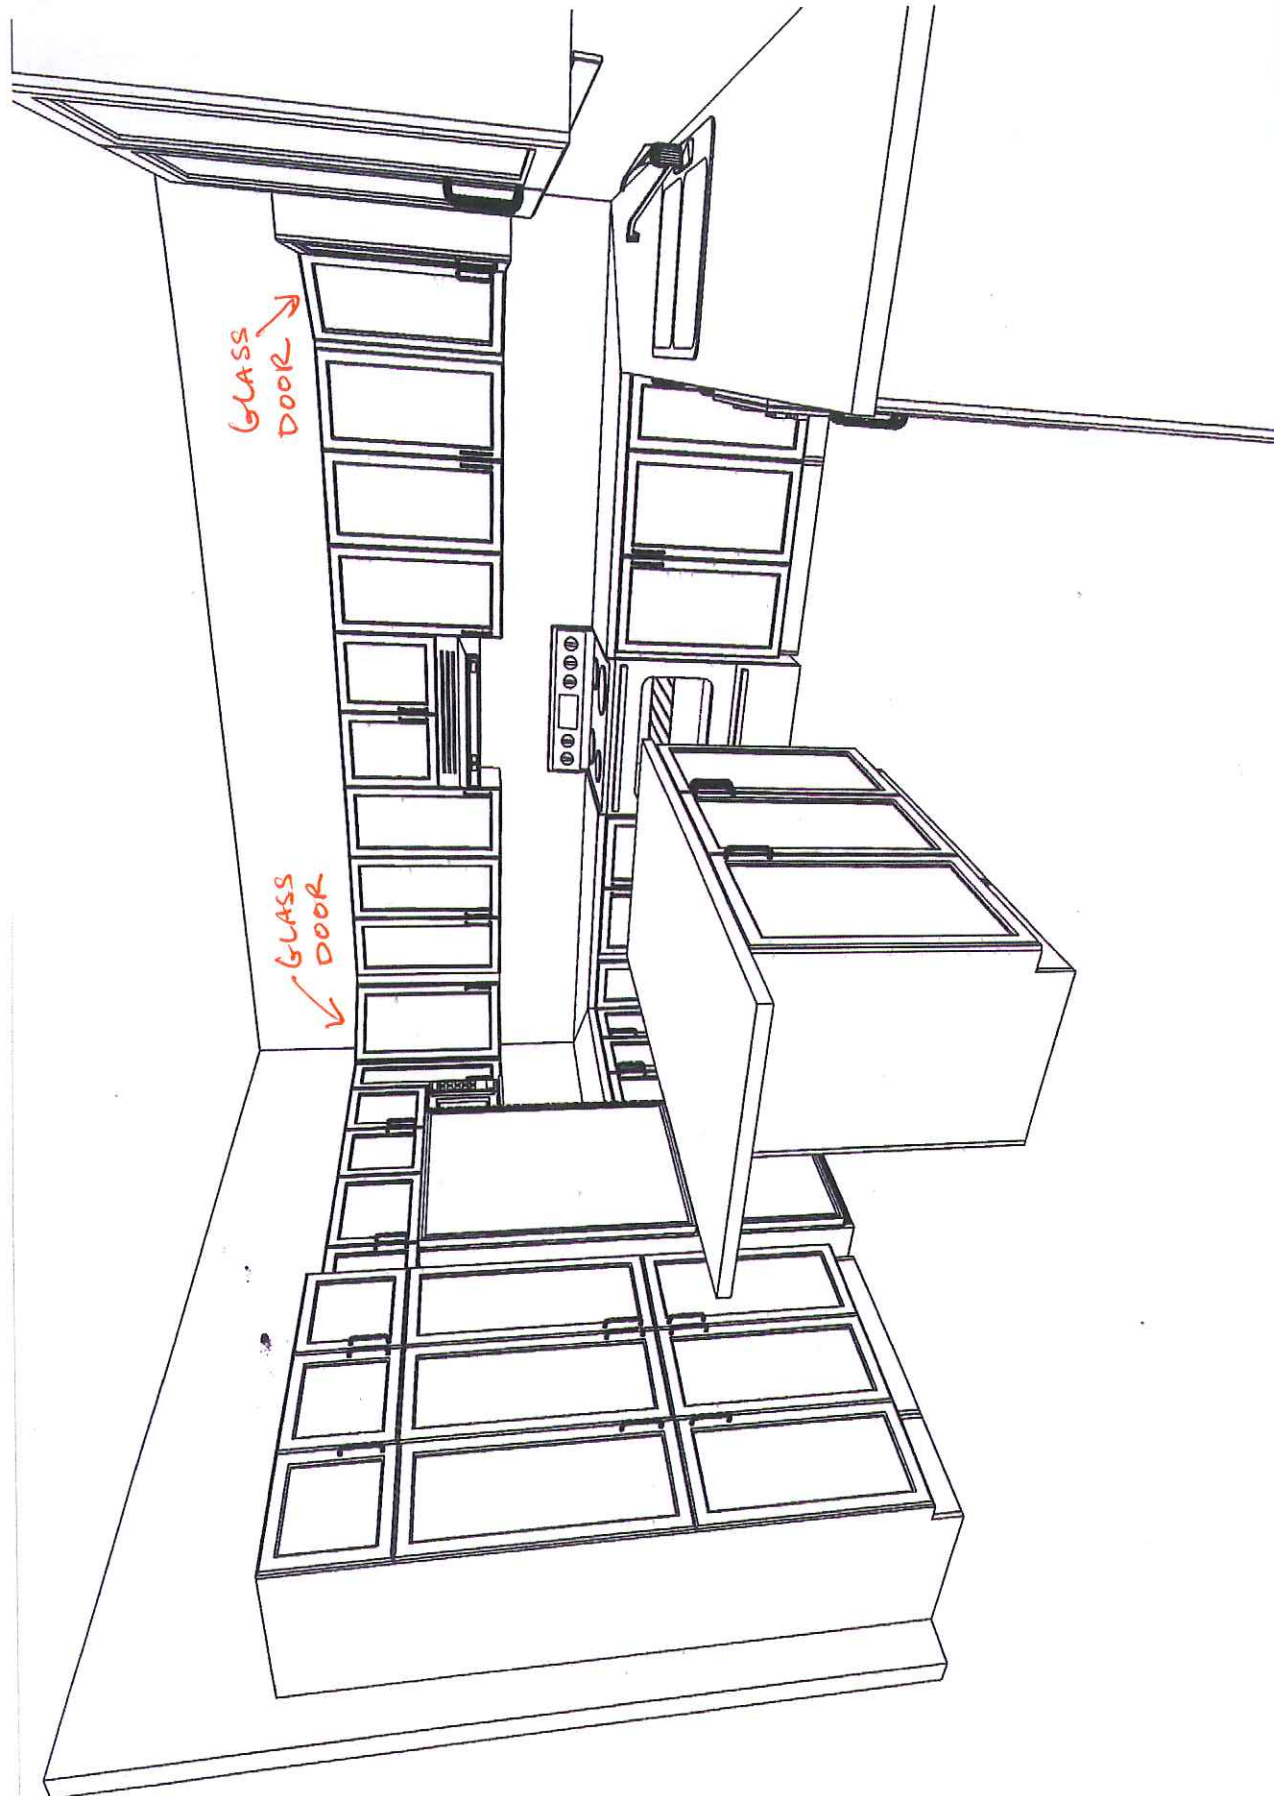

GLASS DOOR

GLASS DOOR

LOT 45 FC

HT NIP

Jan. 14/14

Designed: 11/30/2008 Printed: 6/26/2011		Note: This drawing is an artistic interpretation of the general appearance of the design. It is not meant to be an exact rendition.	2020 TECHNOLOGIES		DRAWN BY: Lori Di Saverio, B.I.D. CARTIER KITCHENS OTTAWA DCR - PALTINA (512) - LEFT	All	Drawing #: 1
--	---	---	----------------------	---	--	-----	--------------


GLASS
DOOR

 2020 TECHNOLOGIES	Designed: 11/30/2008 Printed: 6/26/2011	
	Note: This drawing is an artistic interpretation of the general appearance of the design. It is not meant to be an exact rendition.	
DRAWN BY: Lori Di Saverio, B.I.D. CARTIER KITCHENS OTTAWA		
DCR - PALTINA (512) - LEFT		Drawing #: 1


LOT 45 FC

H.T. NP

Jan. 14/14

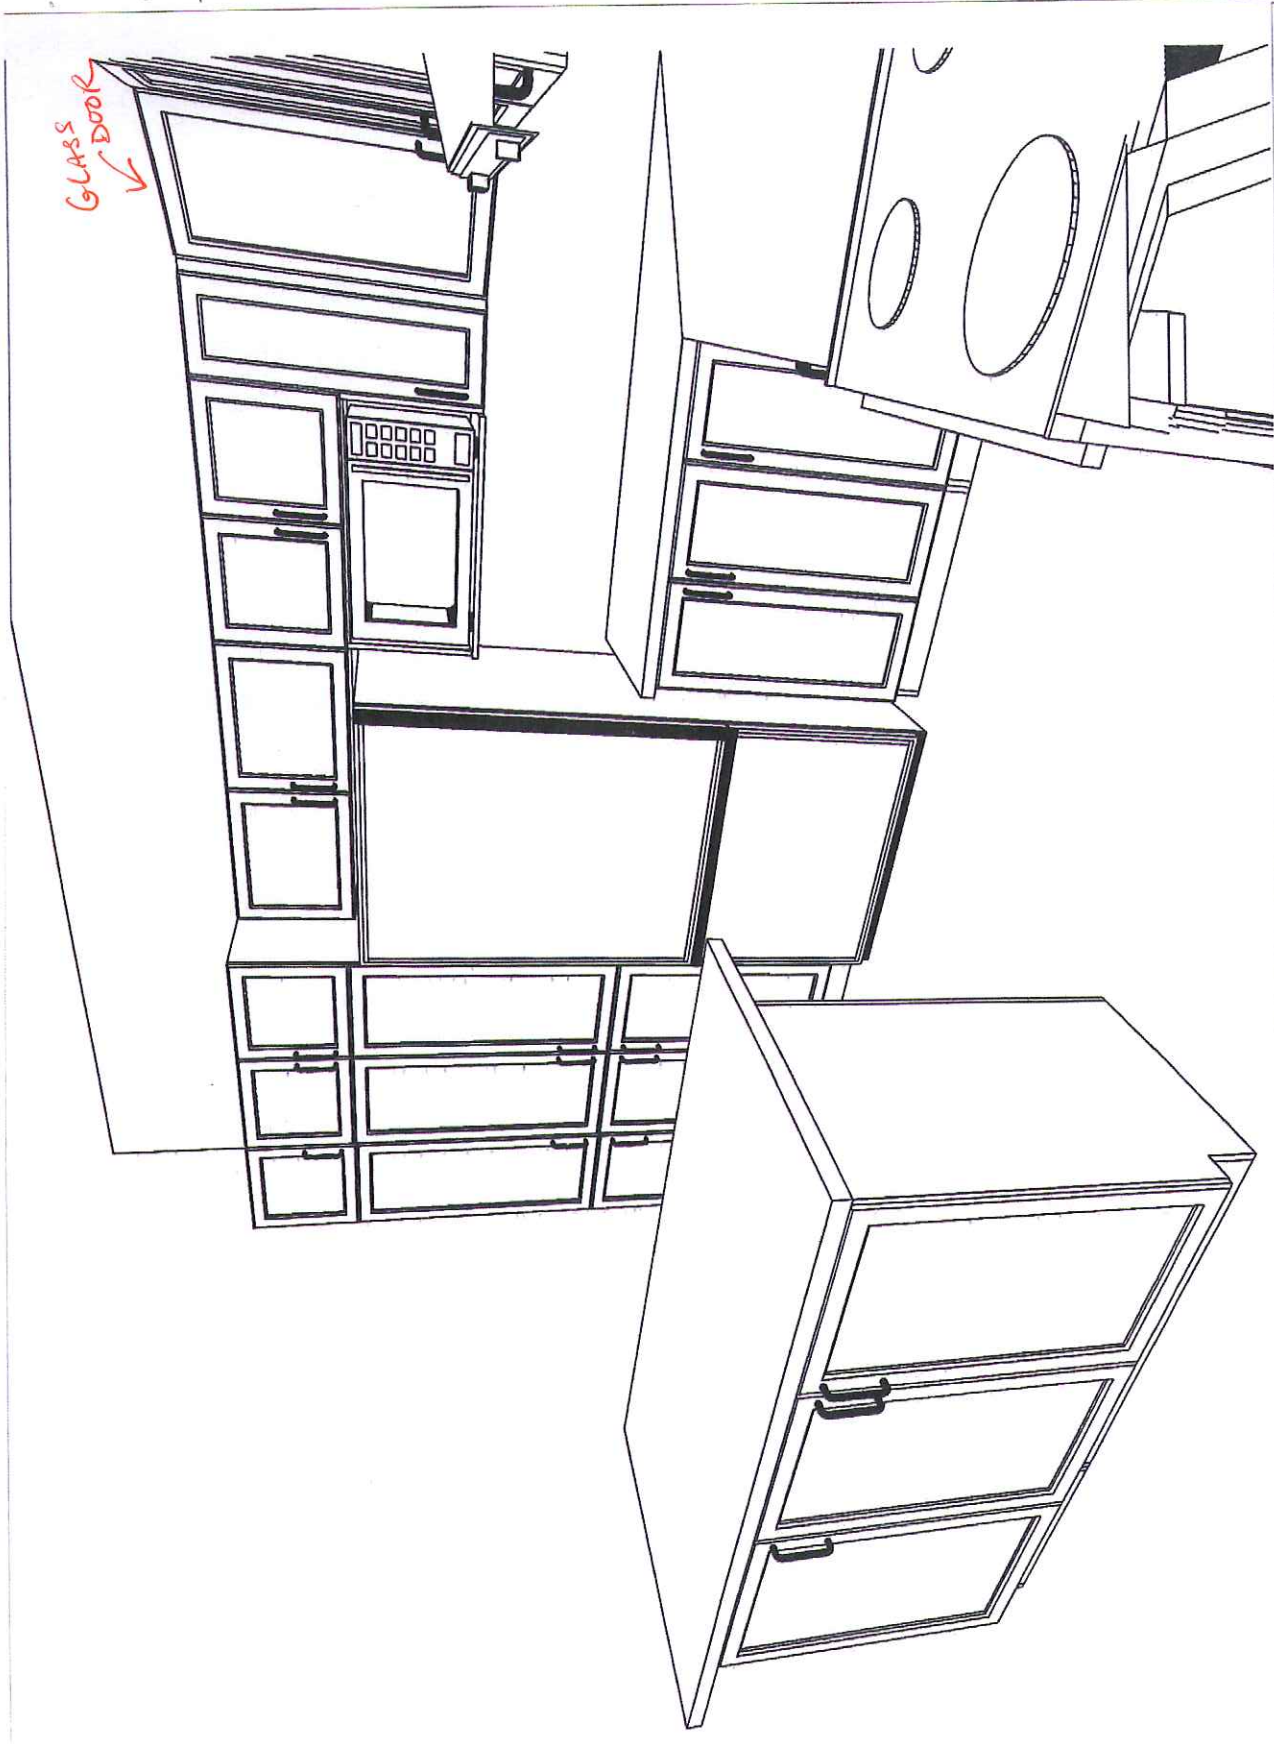

GLASS
✓ DOOR

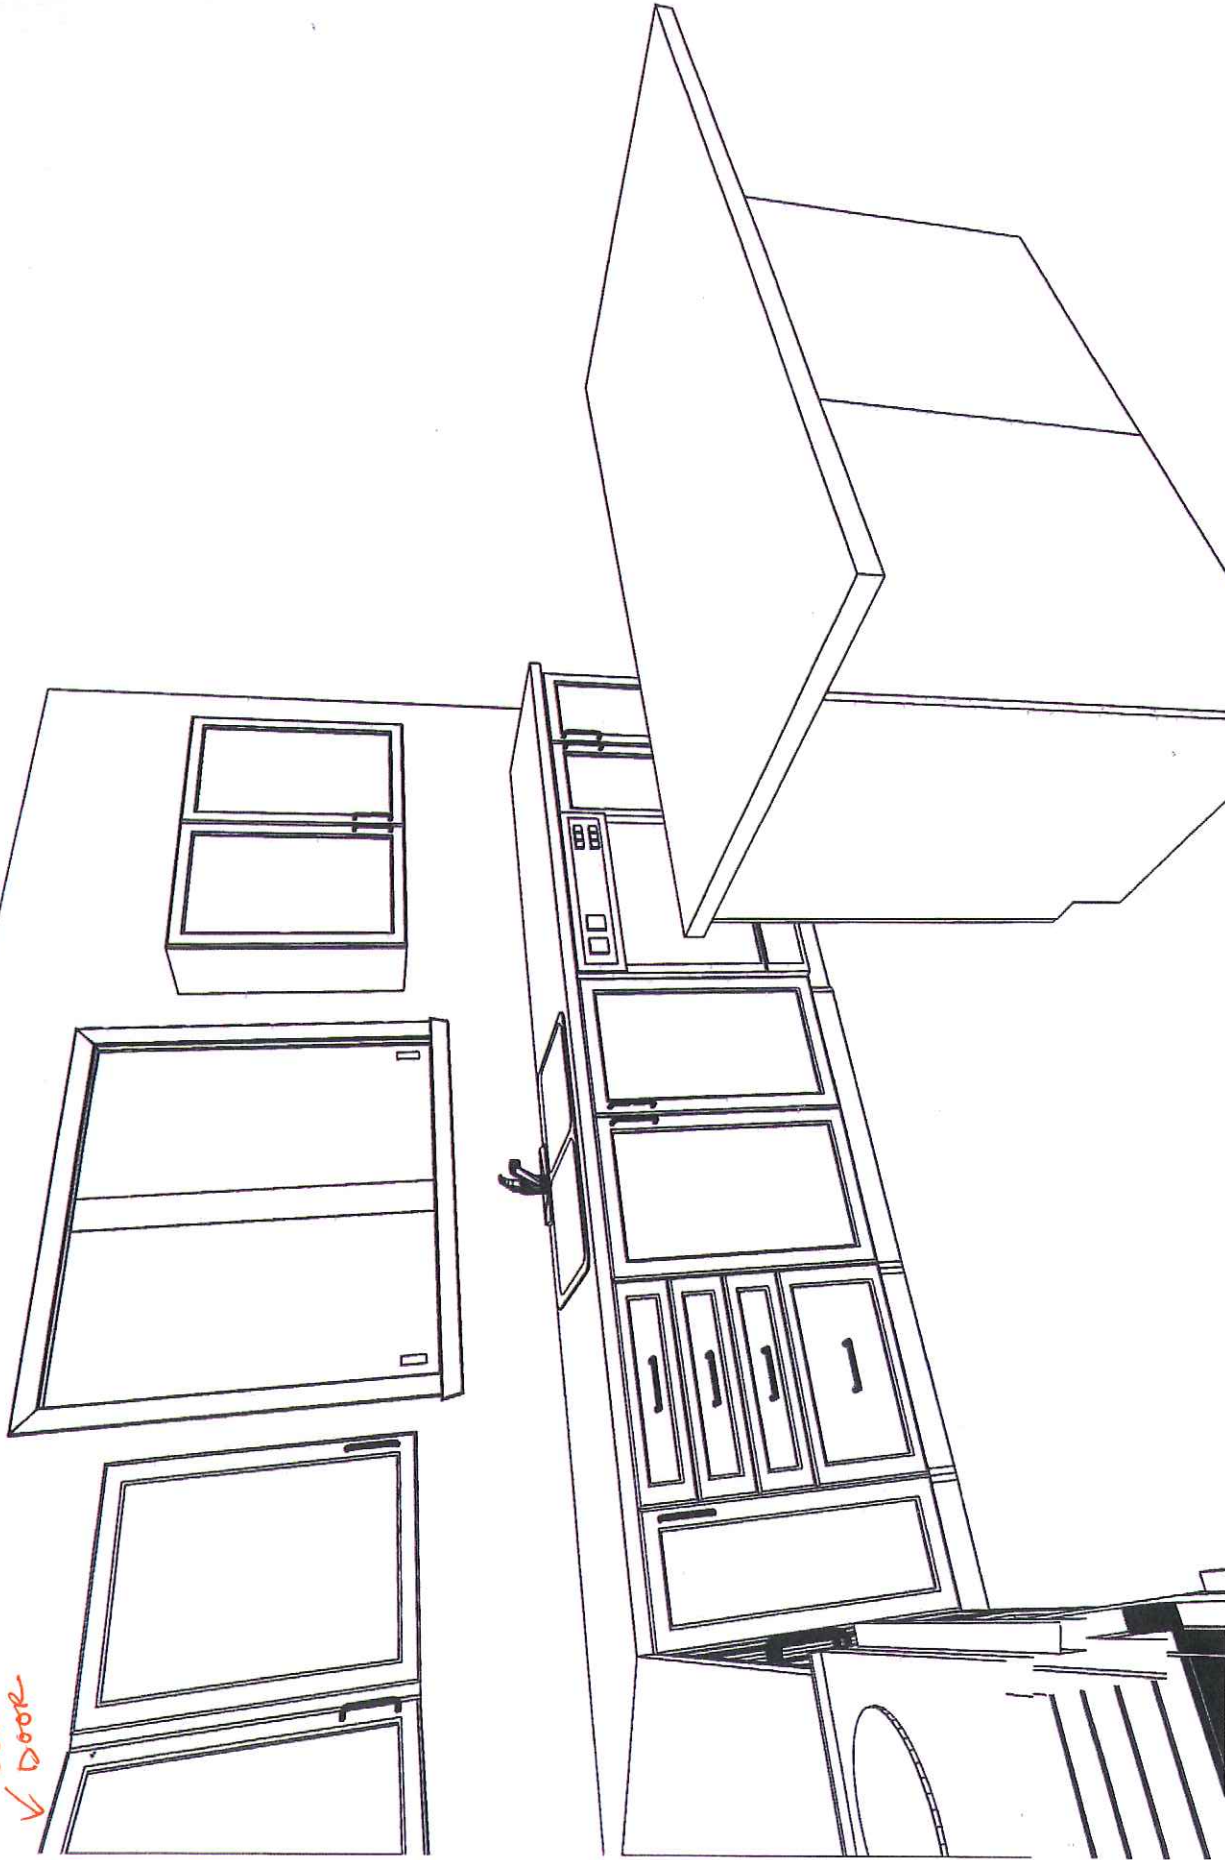

Note: This drawing is an artistic interpretation of the general appearance of the design. It is not meant to be an exact rendition.

DRAWN BY: Lori Di Saverio, B.I.D.
CARTIER KITCHENS OTTAWA
DCR - PALTINA (512) - LEFT



Designed: 11/30/2008
Printed: 6/26/2011

All

Drawing #: 1

LOT 45 FC

H.T. NIP

Jan. 14/14