


3D VIEW #1 - KITCHEN

LOT #22 SM5

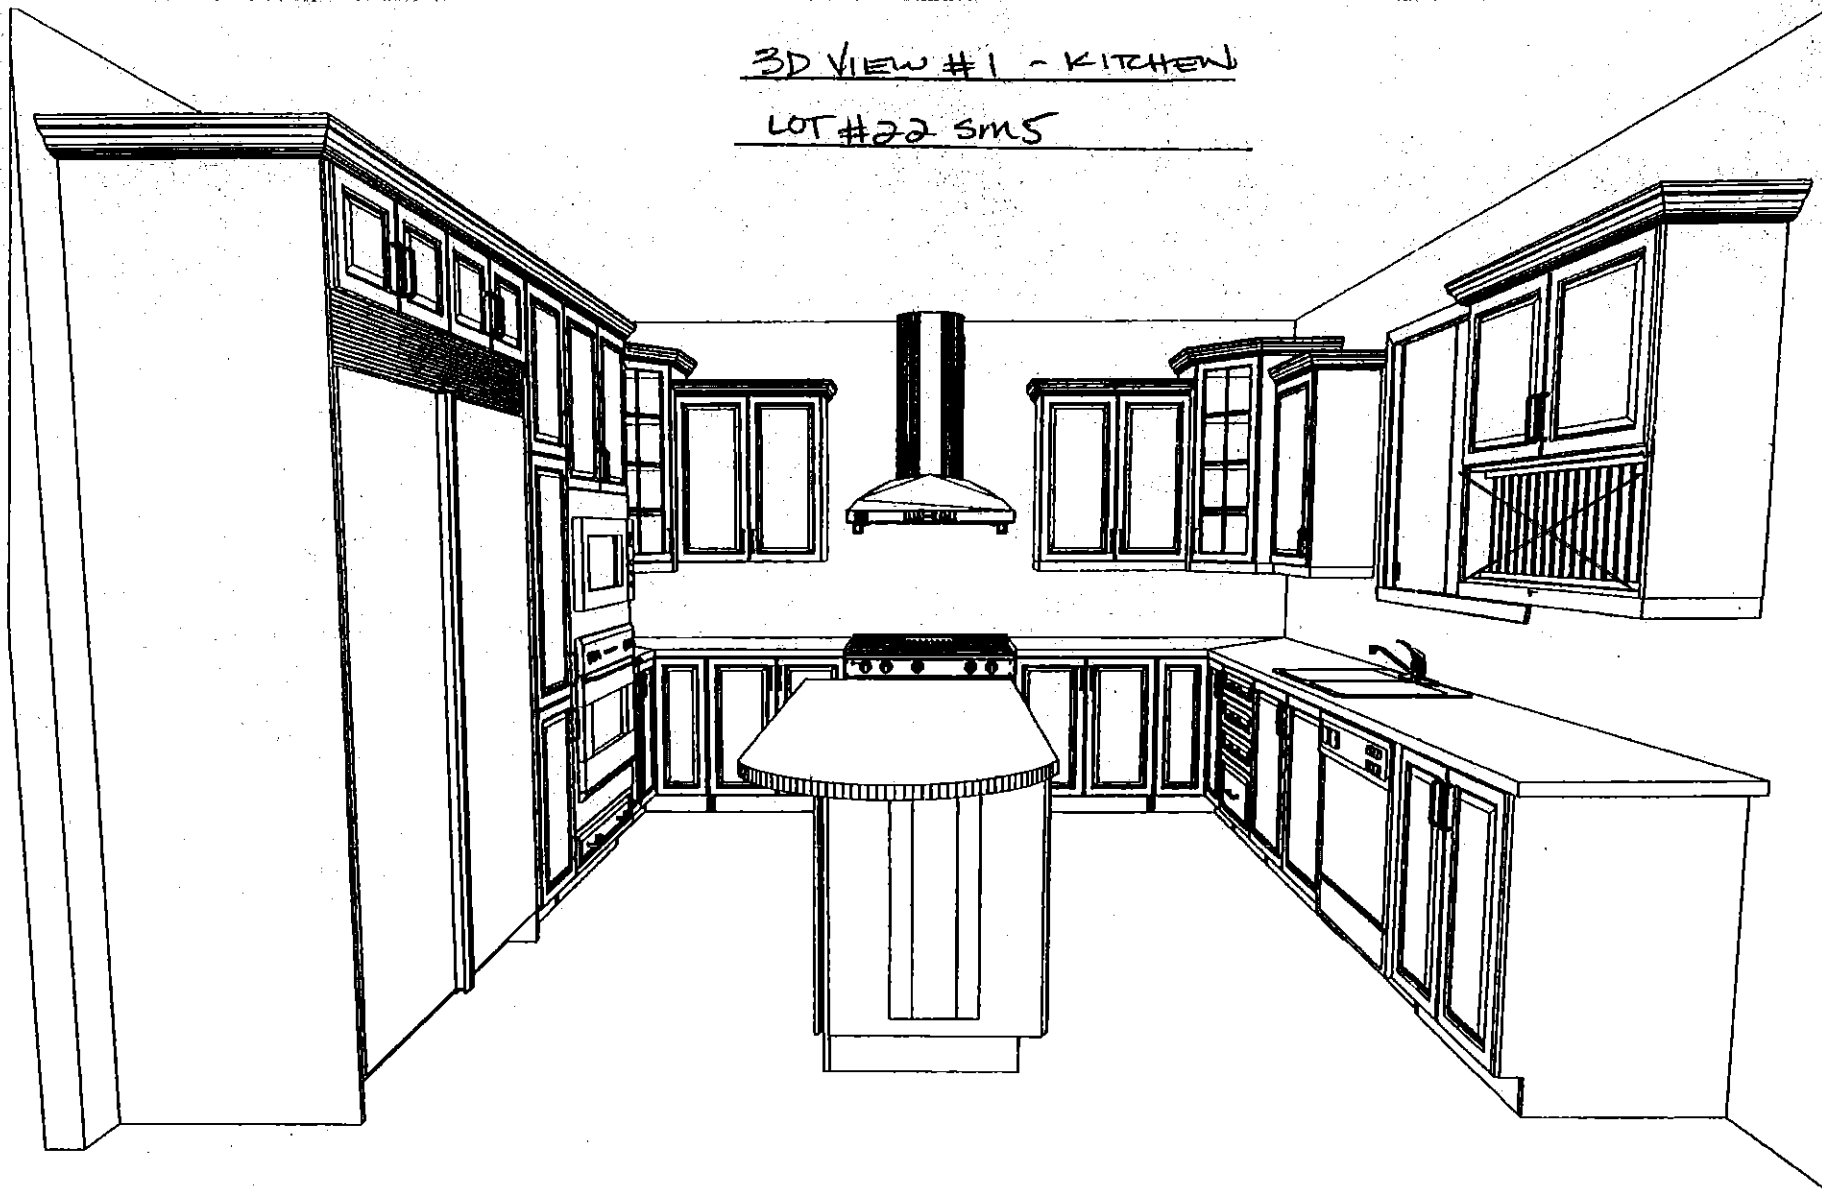

Deleted Plate Rack
& Dummy Doors

CUSTOMER APPROVAL

I have reviewed these drawings and understand the details of the layout and the Cartier Kitchens specifications.

Signature

[Signature]

Date

May 11th/12

Note: This drawing is an artistic interpretation of the general appearance of the design. It is not meant to be an exact rendition.

DRAWN BY: Lori Di Saverio, B.I.D.
CARTIER KITCHENS OTTAWA

DCR #22 SM5 - 512 PLATINA (RIGHT)




Designed: 8/7/2011
Printed: 8/7/2011

All

Drawing #: 1

3D View #2 - Kitchen
 LOT #22 - SMS

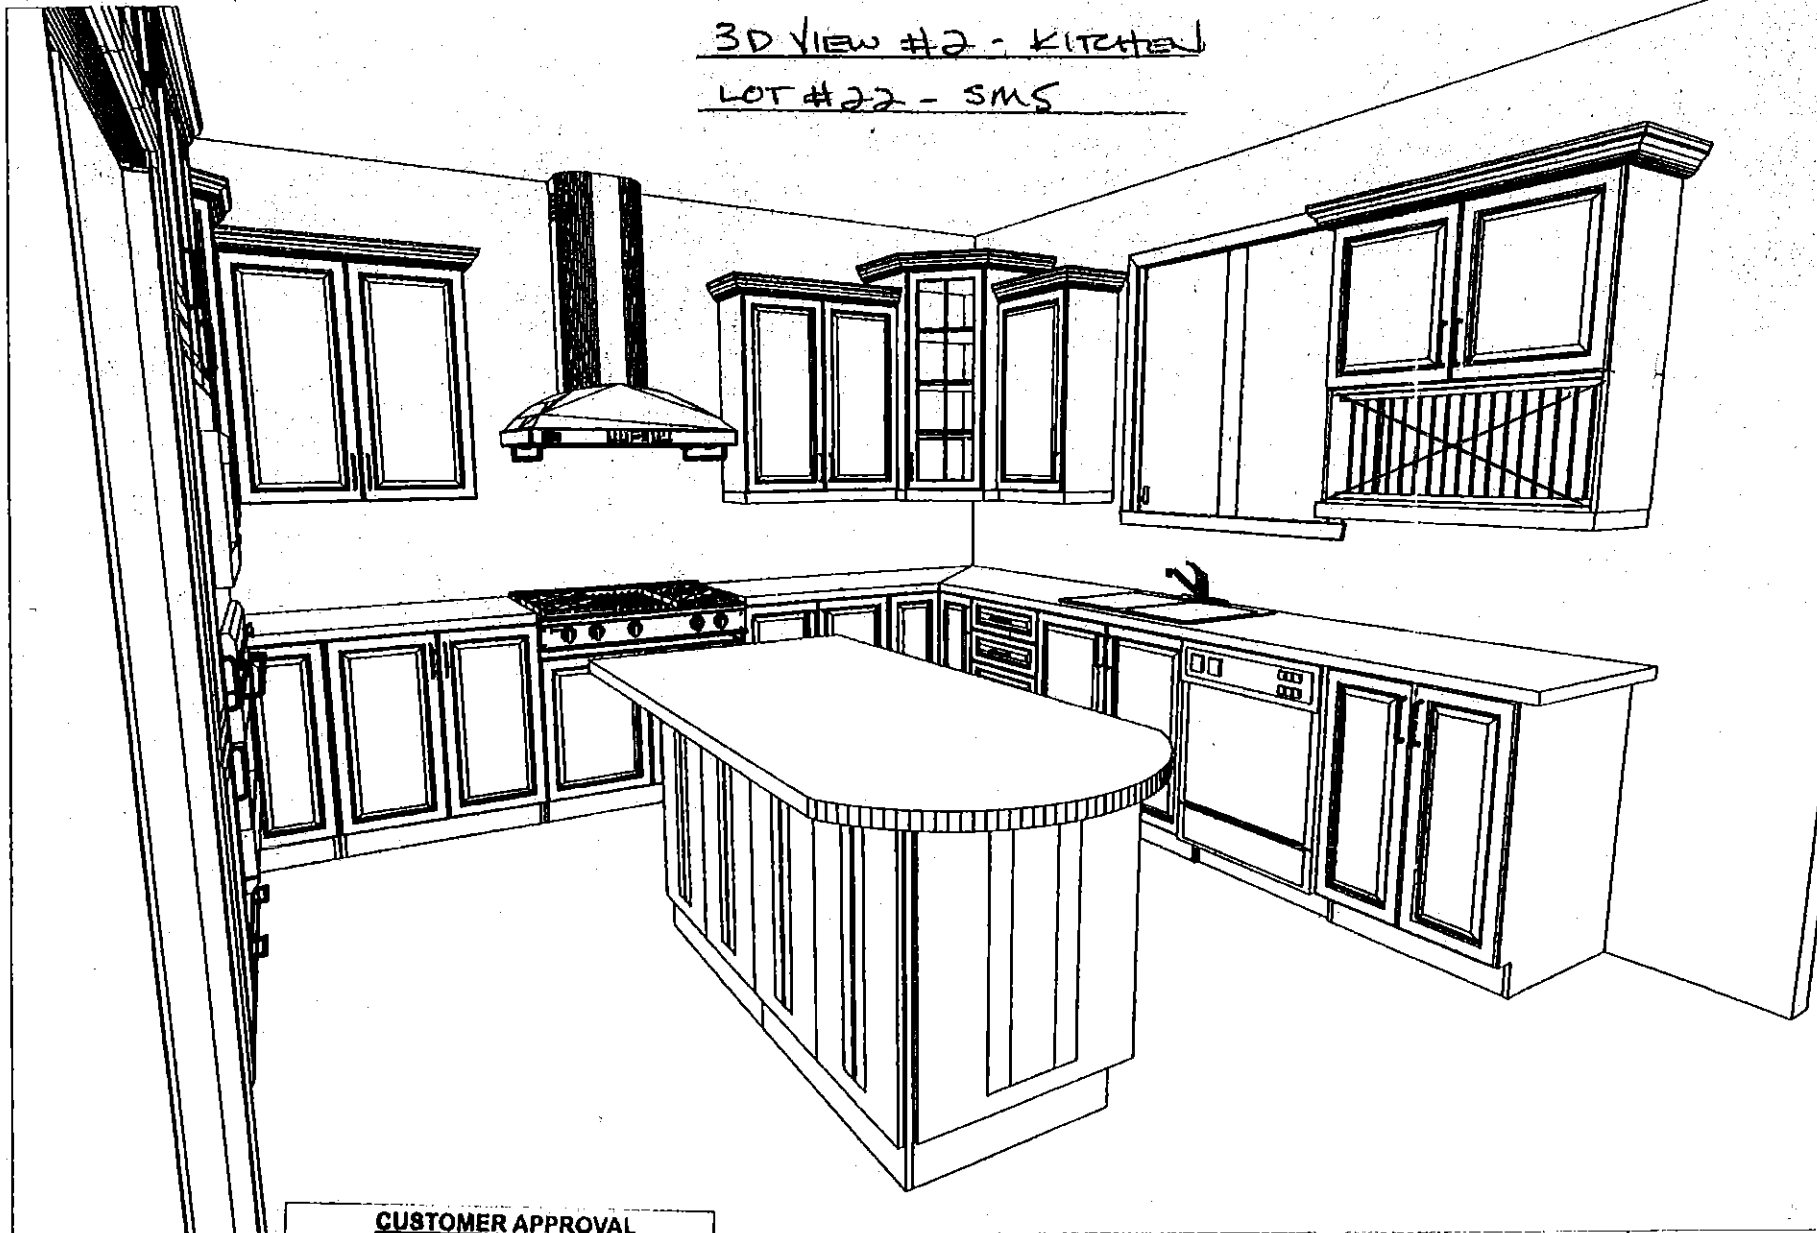

Deleted Plate Rack
 & Dummy Doors

CUSTOMER APPROVAL

I have reviewed these drawings and understand
 the details of the layout and the Cartier Kitchens
 specifications.

Signature *[Signature]*

Date *May 11th/12*

Note: This drawing is an artistic
 interpretation of the general
 appearance of the design. It is
 not meant to be an exact rendition.

DRAWN BY: Lori Di Saverio, B.I.D.
 CARTIER KITCHENS OTTAWA

DCR #22 SM5 - 512 PLATINA (RIGHT)




Designed: 8/7/2011
 Printed: 8/7/2011

All

Drawing #: 1

3D VIEW #3 - KITCHEN

LOT #22 SM5

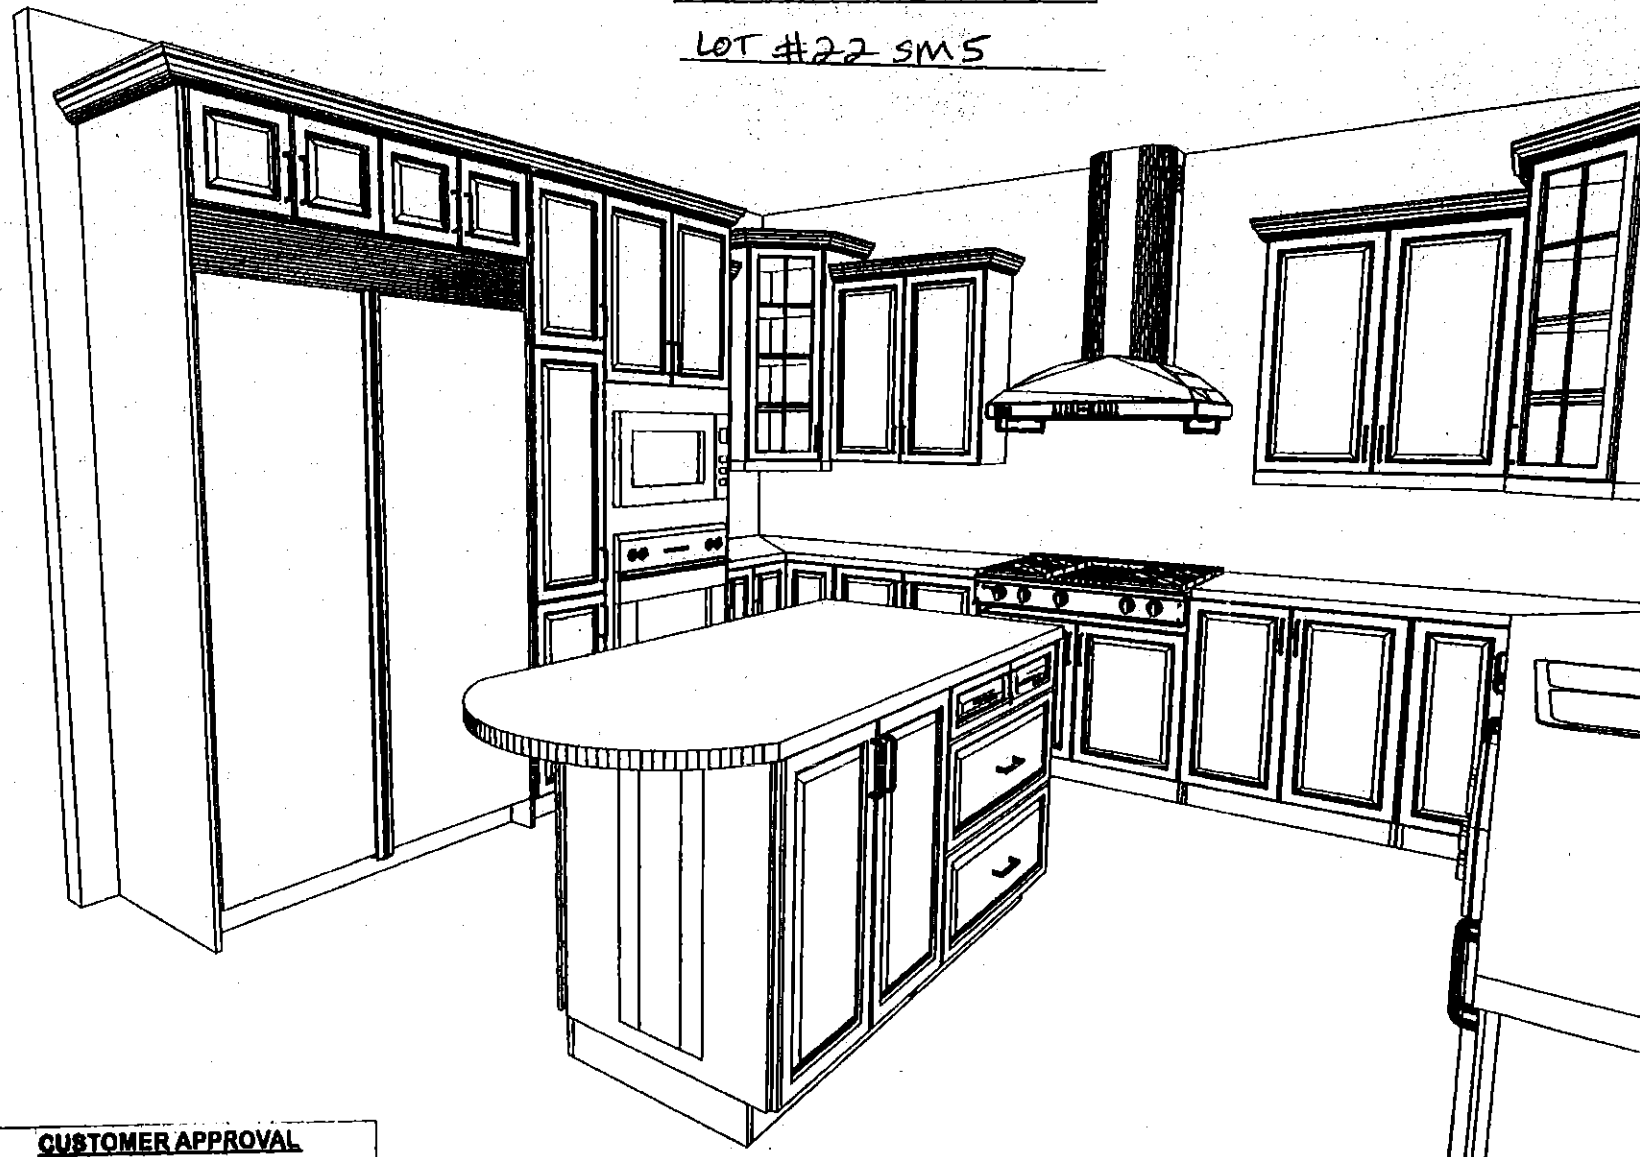

CUSTOMER APPROVAL

I have reviewed these drawings and understand the details of the layout and the Cartier Kitchens specifications.

Signature

Date

[Signature]
May 11th / 12

Note: This drawing is an artistic interpretation of the general appearance of the design. It is not meant to be an exact rendition.

DRAWN BY: Lori Di Saverio, B.I.D.
CARTIER KITCHENS OTTAWA
DCR #22 SM5 - 512 PLATINA (RIGHT)




Designed: 8/7/2011
Printed: 8/7/2011

All

Drawing #: 1

3D VIEW #4 - KITCHEN

LOT #22 SMS

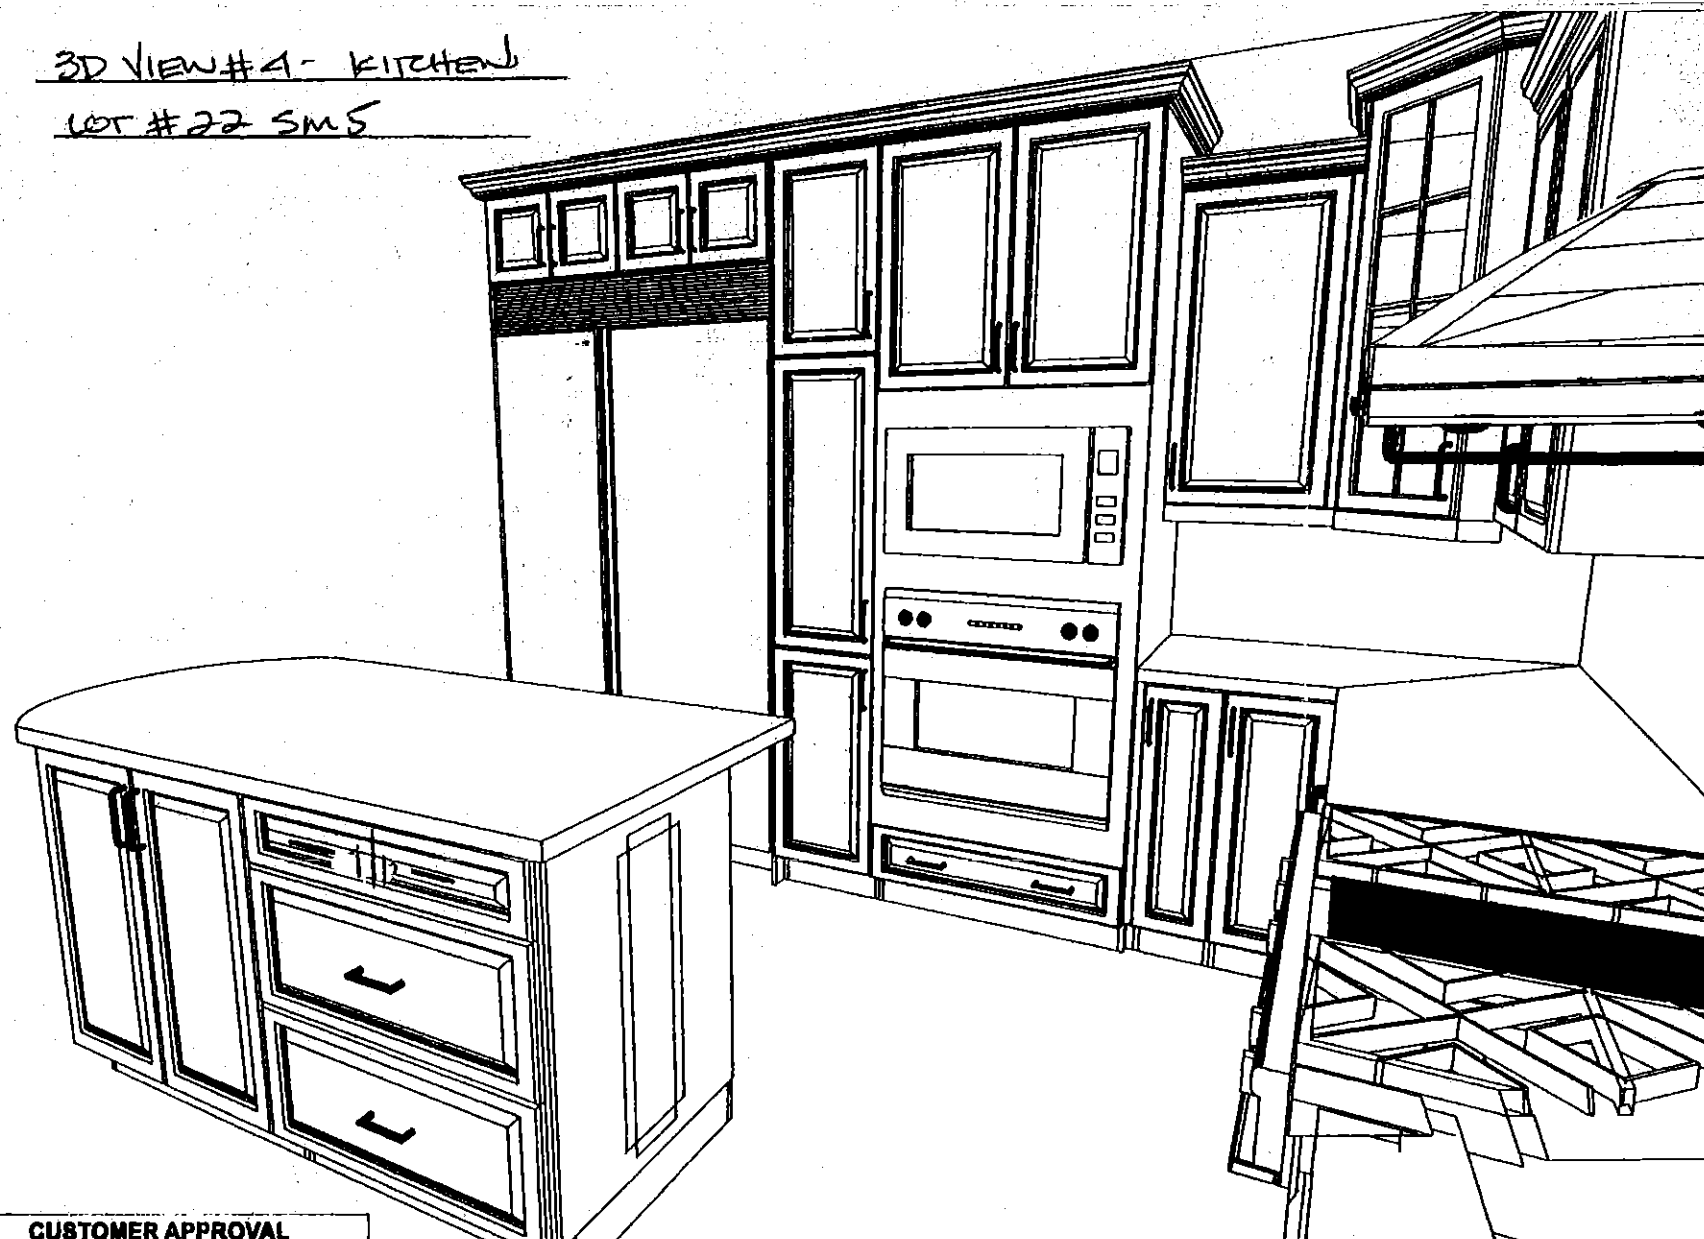

Deleted Dummy Doors
Fridge opening - 36x72

CUSTOMER APPROVAL

I have reviewed these drawings and understand the details of the layout and the Cartier Kitchens specifications.

Signature *[Signature]*

Date *May 1st/12*

Note: This drawing is an artistic interpretation of the general appearance of the design. It is not meant to be an exact rendition.


DRAWN BY: Lori Di Saverio, B.I.D.
CARTIER KITCHENS OTTAWA
DCR #22 SMS - 512 PLATINA (RIGHT)



Designed: 8/7/2011
Printed: 8/7/2011

All

Drawing #: 1

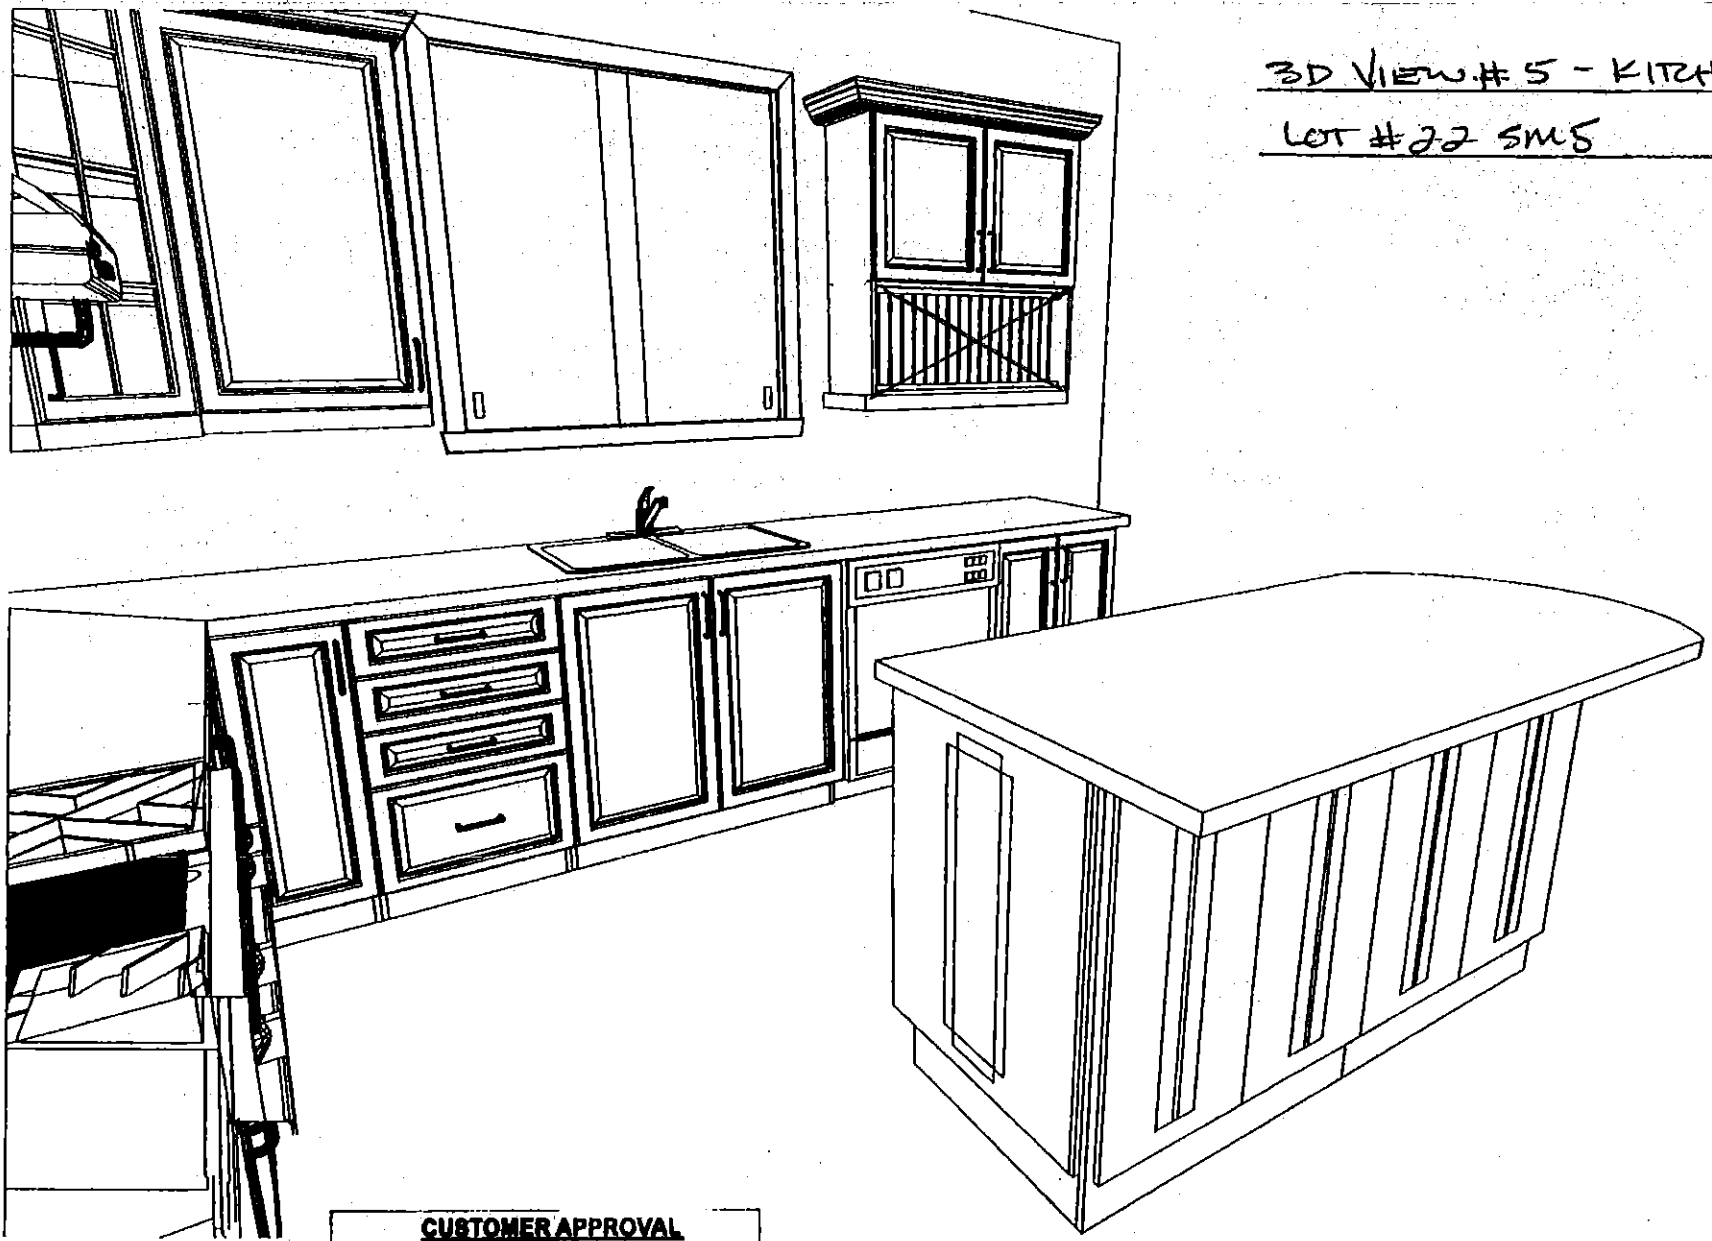

3D VIEW #5 - KITCHEN
LOT #22 SM5

Delete Plate Rack &
Dummy Doors

CUSTOMER APPROVAL

I have reviewed these drawings and understand the details of the layout and the Cartier Kitchens specifications.

Signature _____

Date _____

Note: This drawing is an artistic interpretation of the general appearance of the design. It is not meant to be an exact rendition.

DRAWN BY: Lori Di Saverio, B.I.D.
CARTIER KITCHENS OTTAWA
DCR #22 SM5 - 512 PLATINA (RIGHT)



Designed: 8/7/2011
Printed: 8/7/2011

| All

| Drawing #: 1