

CITY OF-VILLE DE OTTAWA



☐ NEW SUBMISSION ☐ RE-SUBMISSION ☐ MODEL CHANGE ☐ MODEL CHANGE PERMIT #

LEGEND

Finish Fk Provide P ENG soils
Top of F report to inspector
U.S.F. Min. Und confirming assumed
M.U.S.F. Drainage design bearing capacity.
Terracing
Service Location

Proposed Grade
Existing Grade
Driveway & Slope Direction
Grade Percentage
Major Storm Flow Direction
Property Line

Catch Basin
Utility Drop Locations
PROPOSED ROGERS CABLE PEDESTAL
EXISTING ROGERS CABLE PEDESTAL
PROPOSED TRANSFORMER
EXISTING TRANSFORMER
PROPOSED BELL PEDESTAL
EXISTING BELL PEDESTAL
PROPOSED STREETLIGHT C/W
BRACKET AND NUMBER
PROPOSED STREETLIGHT DISCONNECT
SANITARY, STORM AND WATER

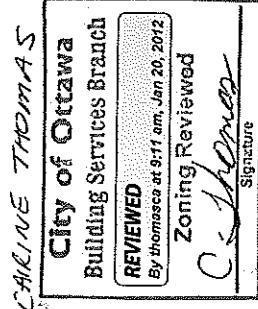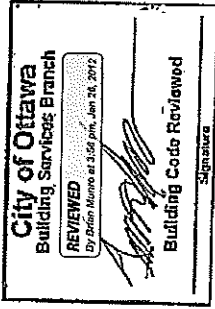

ELEVATIONS SHOWN HEREON ARE FOR SITE GRADING
PLAN SUBMISSION.

Owner/Applicant

DCR/PHOENIX HOMES

Telephone # 723-9227
Plan # 4M-
Lot # 68 STRANDHERD MEADOWS
Block # Unit #
Conc. #
Civic Address: 544 BRETBY CRES.

Bldg. Ht. m
Lot coverage 33.47 %
Scale 1:250

ELEVATIONS

Step footings N/A m
Underside footing SEE ABOVE m
Top of foundation SEE ABOVE m

CHECKED/APPROVED BY: T.L.MAK ENG.
APR.2011 REV.1 APR28-11
REV.2 MAY9-11

LOT 68 SITE/GRADING PLAN STRANDHERD MEADOWS PH5

F.F. = 48.70
T.O.F. = 48.40
U.S.F. = 45.25
LOT COV. 33.47%

PLEASE NOTE: THIS APPLICATION EXPIRES 6(SIX) MONTHS
AFTER DATE RECEIVED

Application No:
Office Use Only: Civic Address:

Circ Date	Circ Date	Circ Date	APPLICATION RECEIVED
Works Division Approval	Zoning Approval Date:	UP0 Approval Date:	

