


CITY OF-VILLE DE OTTAWA

☐ NEW SUBMISSION ☐ RE-SUBMISSION ☐ MODEL CHANGE ☐ MODEL CHANGE PERMIT #

PA11-01334
324 Bamburgh

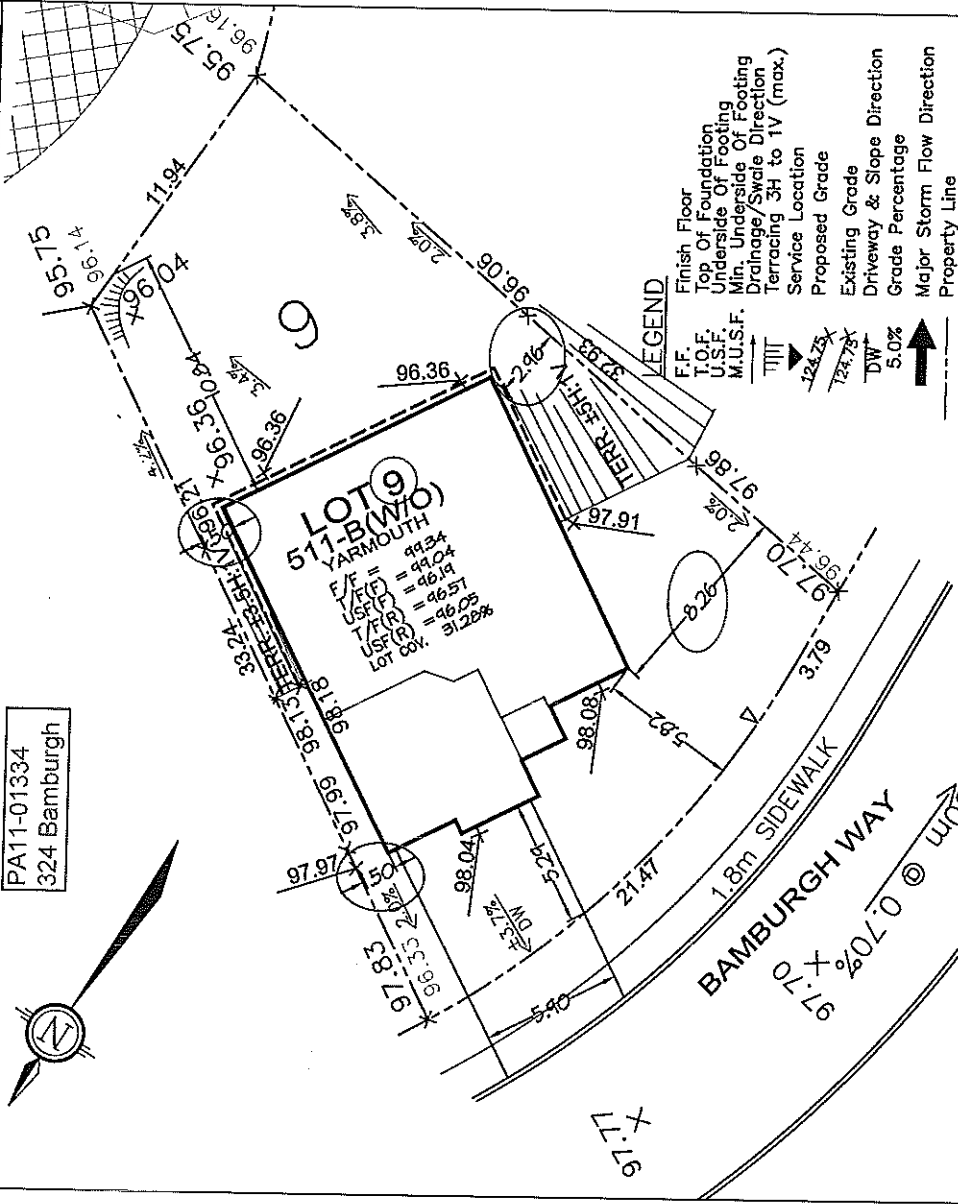

City of Ottawa
Building Services Branch
REVIEWED
By Brian Humes at 2:00 pm, Sep 28, 2011
Building Code Reviewed
Signature

City of Ottawa
Building Services Branch
REVIEWED
By Thomas at 3:07 pm, Sep 28, 2011
Zoning Reviewed
Signature

ELEVATIONS SHOWN HEREON ARE FOR SITE GRADING PLAN SUBMISSION.

Owner/Applicant:

DCR/PHOENIX HOMES

Telephone # 723-9227
Plan # 4M-
Lot # 9 STRANDHERD MEADOWS
Block # Unit #
Conc. #
Civic Address: 324 BAMBURGH WAY

Bldg. Ht. m
Lot coverage 31.28 %
Scale 1:250

ELEVATIONS

Step footings N/A
Underside footing SEE ABOVE
Top of foundation SEE ABOVE
CHECKED/APPROVED BY: T.L.M.A.K. ENG.
AUG. 2011
REV: AUG29-11

LOT 9 SITE/GRADING PLAN
9 STRANDHERD MEADOWS PH5
(9 FT POUR FDN.)

F/F = 99.34
T/F(F) = 99.04
USF(F) = 96.19
T/F(R) = 96.57
USF(R) = 96.05
LOT COV. 31.28%

PLEASE NOTE: THIS APPLICATION EXPIRES 6(SIX) MONTHS
AFTER DATE RECEIVED

Application No:
Office Use Only: Civic Address:

Circ Date	Circ Date	Circ Date	APPLICATION RECEIVED
Works Division Approval	Zoning Approval Date:	UP0 Approval Date:	