

NOTES

1. SEE DWG. A4 FOR WALL & PARTITION ASSEMBLIES.
2. SEE DWG. A5 FOR DOOR AND WINDOW SCHEDULES.
3. SEE DWGS. A6 & A7 FOR SPECIFICATIONS.
4. PROVIDE SLEEVES WHERE FOOTING DRAIN CROSSES FOOTINGS.
5. INTERIOR PARTITION WALLS MAY BE INCREASED TO 2x6 STUDS FOR STRUTURAL AND PLUMBING REQUIREMENTS. ADJUST DIMENSIONS ACCORDINGLY.

STRUCTURAL NOTES

1. SEE PRE-ENG. FLOOR JOIST AND ROOF TRUSS DWGS. FOR FLOOR JOISTS, LVLs AND ROOF TRUSSES. USE 9 1/2" PRE-ENGINEERED JOISTS FOR ALL FLOOR ASSEMBLIES. DOUBLE UP STUDS UNDER ALL LVLs TO FOUNDATION LEVEL. FLOOR JOIST AND ROOF TRUSS DWGS. TO BE REVIEWED AND APPROVED BY STRUCTURAL ENGINEER.

ELEC./MECH. LEGEND

- FD FLOOR DRAIN
- SA SMOKE ALARM (120V)
- CO CARBON MONOXIDE DETECTOR
- CEILING MOUNTED INCAND. LIGHT FIXTURE
- CAPPED CEILING OUTLET
- WALL-MOUNTED INCAND. LIGHT FIXTURE
- WALL-MOUNTED EXTERIOR INCAND. LIGHT FIXTURE

- § LIGHT SWITCH
- § 3-WAY LIGHT SWITCH
- Ⓜ THERMOSTAT
- Ⓜ 120V ELECTRICAL OUTLET
- Ⓜ 120V ELECTRICAL OUTLET
- Ⓜ 220V ELECTRICAL OUTLET
- Ⓜ GFI ELECTRICAL OUTLET
- Ⓜ SWITCH ELECTRICAL OUTLET

- EXHAUST FAN
- TELEPHONE OUTLET
- CABLE TV OUTLET
- WATER HOOKUP
- CENTRAL VACUUM
- ELECTRICAL PANEL

NOTES

- E & D.E.
- DO NOT SCALE DRAWINGS
- ALL DIMENSIONS TO BE VERIFIED ON SITE AND REPORT ANY ERRORS TO BUILDER
- CHECKS IN FOUNDATION TO BE CONVEYED ON SITE BY BUILDER BEFORE POURING OF CONCRETE FOUNDATION WALLS.
- MECHANICAL & ELECTRICAL SHALL CONFORM TO PROVINCIAL & MUNICIPAL CODES & BYLAWS.
- SITE CHECK AND VERIFY CO-ORDINATE WITH SITE FOREMAN
- CHECK WITH MANUFACTURER FOR EXACT ROUGH OPENING REQUIREMENTS FOR ALL SIZES & TYPES
- DIMENSIONS FOR WALLS ARE TAKEN FROM CENTERLINE OF PARTITION WALLS, EXTERIOR FACE OF EX. WALLS, AND/OR FACE OF CONCRETE AND CONCRETE BLOCK WALLS.
- ALL MATERIALS & CONSTRUCTION TO CONFORM TO 2006 O.B.C. CW ALL REVISIONS.
- ALL AREA CALCULATIONS ARE DETERMINED FROM OUTSIDE SURFACE OF EXTERIOR WALLS AND CENTERLINE OF PARTITION WALLS.
- THIS DRAWING SHALL NOT BE USED FOR CONSTRUCTION PURPOSES UNLESS SIGNED AND SEALED BY THE ARCHITECT.

LEGEND

- WALL / PARTITION ASSEMBLY
- DOOR TYPE
- WINDOW TYPE

STRUCTURAL DESIGN BY JOHN STUART HALL, P.ENG. THIS DRAWING SHALL NOT BE USED FOR CONSTRUCTION PURPOSES UNLESS SIGNED AND SEALED BY THE STRUCTURAL ENGINEER OR BY THE ARCHITECT. PROVIDING A LETTER REFERRING THE STRUCTURAL DESIGN AS HAVING BEEN PROVIDED UNDER HIS RESPONSIBILITY.

|   |            |                           |
|---|------------|---------------------------|
| 1 | JAN. 22/13 | RE-ISSUED FOR PERMIT      |
| 2 | JUL. 10/12 | HRV ADDED                 |
| 3 | JUN. 18/12 | ELEC. PANEL REVISED       |
| 4 | APR. 24/12 | REVISED TO MEET OBC SB-12 |
| 5 | DEC. 23/11 | REVISED AS PER STRUCTURAL |
| 6 | DEC. 7/11  | ISSUED FOR PERMIT         |
| 7 | OCT. 1/10  | ISSUED FOR PRELIM. REVIEW |
| 8 | DATE       | REVISION                  |

THIS DRAWING SHALL NOT BE USED FOR CONSTRUCTION PURPOSES UNTIL SIGNED BY THE ARCHITECT

SignedSeal3.jpg



PROJECT  
**SAWGRASS TOWNS**  
JOCKVALE RD.  
OTTAWA, ON

DRAWING NAME  
**"MODEL A REVERSED" BASEMENT FLOOR PLAN**

DRAWN BY RDB  
SCALE 1/4" = 1'  
JOB NO. 967  
DATE OCT. 1, 2010  
DRAWING NO. **A1-1**


MORRIS MELAMED  
architect - ottawa  
(613) 727-7400 FAX (613) 727-7334

NOTE: PROVIDE TANKLESS HW SYSTEM, SEE SUMMARY LOCATION MAY VARY


NOTE: SEE SUMMARY FOR APPLIANCES UPGRADES

NOTE: SEE MANUF. SPECS. FOR ELEC. AND EXHAUST REQUIREMENTS FOR MECHANICAL EQUIPMENT

PROVIDE SLEEVE THROUGH FOOTING 43'-10" (TYPICAL)

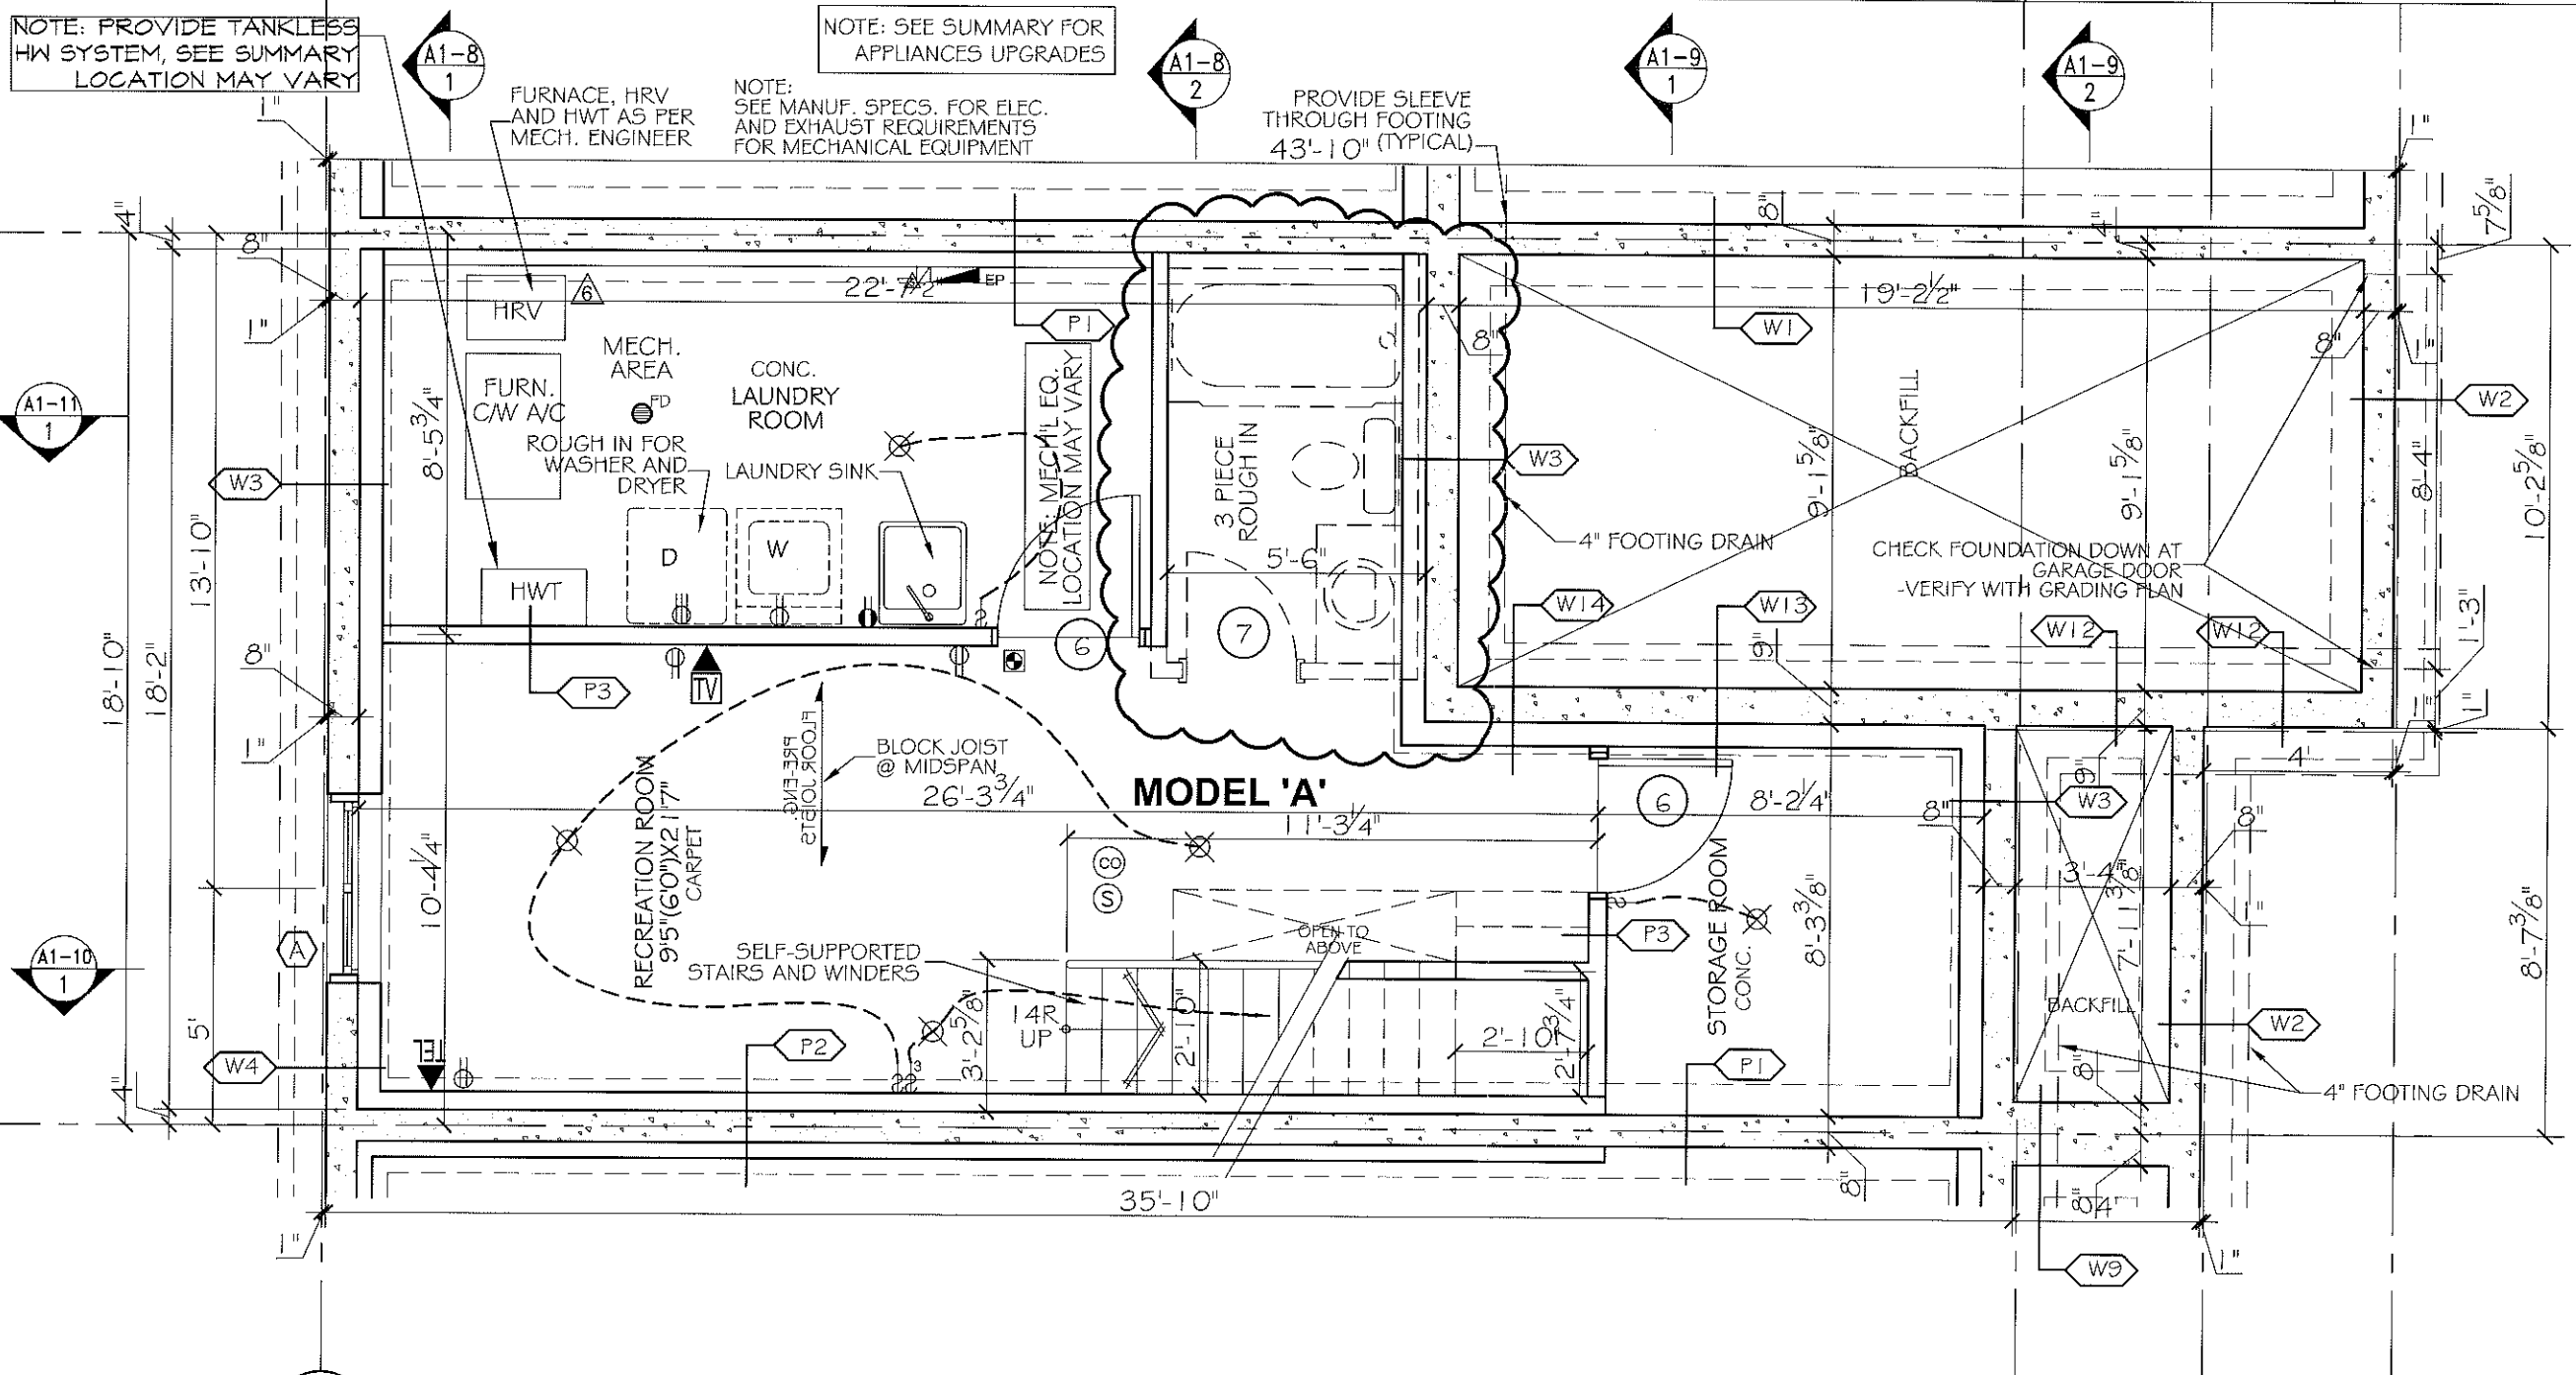

1 "MODEL A" - BASEMENT FLOOR PLAN  
SCALE: 1/4"=1'

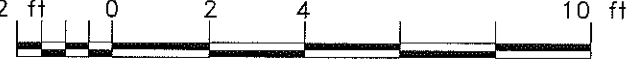

SPECIFIC NOTE:  
SEE SHOP DRAWINGS AND THE REST OF ARCHITECTURAL & STRUCTURAL PLANS FOR COMPLETE WORKING DRAWINGS NOTES, SCHEDULES AND LEGENDS.

**BLOCK-2**  
**UNIT - 13**

NOTES

1. SEE DWG. A4 FOR WALL & PARTITION ASSEMBLIES.
2. SEE DWG. A5 FOR DOOR AND WINDOW SCHEDULES.
3. SEE DWGS. A6 & A7 FOR SPECIFICATIONS.
4. SEE ENG. DWGS FOR FLOOR JOISTS, LVLs AND ROOF TRUSSES. USE 9 1/2" PRE-ENGINEERED JOISTS FOR ALL FLOOR ASSEMBLIES.
5. INTERIOR PARTITION WALLS MAY BE INCREASED TO 2x6 STUDS FOR STRUTURAL AND PLUMBING REQUIREMENTS. ADJUST DIMESNIONS ACCORDINGLY.
6. CONCRETE FRONT PORCH w/ PRE-CAST CONCRETE STEP. SLOPE TOP SURFACES 1/4" IN 12"
7. FIRESTOP ALL PLUMBING AND ELECTRICAL PENETRATIONS AT PARTY WALL.

STRUCTURAL NOTES

1. SEE PRE-ENG. FLOOR JOIST AND ROOF TRUSS DWGS. FOR FLOOR JOISTS, LVLs AND ROOF TRUSSES. USE 9 1/2" PRE-ENGINEERED JOISTS FOR ALL FLOOR ASSEMBLIES. DOUBLE UP STUDS UNDER ALL LVLs TO FOUNDATION LEVEL. FLOOR JOIST AND ROOF TRUSS DWGS. TO BE REVIEWED AND APPROVED BY STRUCTURAL ENGINEER.

ELEC./MECH. LEGEND

- FD FLOOR DRAIN
- SA SMOKE ALARM (120V)
- CO CARBON MONOXIDE DETECTOR
- CEILING MOUNTED INCAND. LIGHT FIXTURE
- CAPPED CEILING OUTLET
- WALL-MOUNTED INCAND. LIGHT FIXTURE
- WALL-MOUNTED EXTERIOR INCAND. LIGHT FIXTURE

- LS LIGHT SWITCH
- 3-WAY LIGHT SWITCH
- T THERMOSTAT
- 120V ELECTRICAL OUTLET
- CEILING MOUNTED 120V ELECTRICAL OUTLET
- 220V ELECTRICAL OUTLET
- GFI ELECTRICAL OUTLET
- SWITCH ELECTRICAL OUTLET

- EXHAUST FAN
- TELEPHONE OUTLET
- CABLE TV OUTLET
- WATER HOOKUP
- CENTRAL VACUUM
- ELECTRICAL PANEL

NOTES

- DO NOT SCALE DRAWINGS
- ALL DIMENSIONS TO BE VERIFIED ON SITE AND REPORT ANY ERRORS TO BUILDER.
- CHECKS IN FOUNDATION TO BE CONFIRMED ON SITE BY BUILDER BEFORE POURING OF CONCRETE FOUNDATION WALLS.
- MECHANICAL & ELECTRICAL SHALL CONFORM TO PROVINCIAL & MUNICIPAL CODES & BY-LAWS
- SITE CHECK AND VERIFY CO ORDNATE WITH SITE FOREMAN.
- CHECK WITH MANUFACTURER FOR EXACT MOUNTING REQUIREMENTS FOR ALL DOORS & WINDOWS.
- DIMENSIONS FOR WALLS ARE TAKEN FROM CENTERLINE OF PARTITION WALLS. EXTERIOR FACE OF EXT. WALLS, SIDING, FACE OF CONCRETE AND CONCRETE BLOCK WALLS.
- ALL MATERIALS & CONSTRUCTION TO CONFORM TO 2006 O.B.C. OR ALL REVISIONS.
- ALL AREA CALCULATIONS ARE DETERMINED FROM OUTSIDE SURFACE OF EXTERIOR WALLS AND CENTERLINE OF PARTITION WALLS.
- THIS DRAWING SHALL NOT BE USED FOR CONSTRUCTION PURPOSES UNLESS SIGNED AND SEALED BY THE ARCHITECT.

LEGEND

- WALL / PARTITION ASSEMBLY
- DOOR TYPE
- WINDOW TYPE
- STRUCTURAL NOTE


STRUCTURAL DESIGN BY JOHN STUART HALL, P.ENG. THIS DRAWING SHALL NOT BE USED FOR CONSTRUCTION PURPOSES UNLESS SIGNED AND SEALED BY THE STRUCTURAL ENGINEER OR BY THE ARCHITECT. PROVIDING A LETTER REFERENCING THE STRUCTURAL DESIGN AS HAVING BEEN PROVIDED UNDER HIS RESPONSIBILITY.

|      |            |                           |
|------|------------|---------------------------|
| 5    | JAN. 22/13 | RE-ISSUED FOR PERMIT      |
| 4    | APR. 24/12 | REVISED TO MEET OBC 08-12 |
| 3    | DEC. 23/11 | REVISED AS PER STRUCTURAL |
| 2    | DEC. 7/11  | ISSUED FOR PERMIT         |
| 1    | OCT. 1/10  | ISSUED FOR PRELIM. REVIEW |
| DATE | REVISION   |                           |

DO NOT SCALE THIS DRAWINGS - READ DIMENSIONS ONLY

THIS DRAWING SHALL NOT BE USED FOR CONSTRUCTION PURPOSES UNTIL SIGNED BY THE ARCHITECT

SignedSeal3.jpg

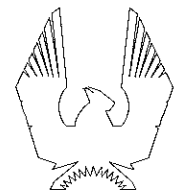


PHOENIX HOMES

PROJECT  
**SAWGRASS TOWNS**  
JOCKVALE RD.  
OTTAWA, ON

DRAWING NAME  
**"MODEL A REVERSED" GROUND FLOOR PLAN**

|          |           |             |              |
|----------|-----------|-------------|--------------|
| DRAWN BY | RDB       | DATE        | OCT. 1, 2010 |
| SCALE    | 1/4" = 1' | DRAWING NO. | A1-2         |
| JOB NO.  | 967       |             |              |

MORRIS MELAMED  
architect - ottawa  
(613) 727-7400 FAX (613) 727-7334

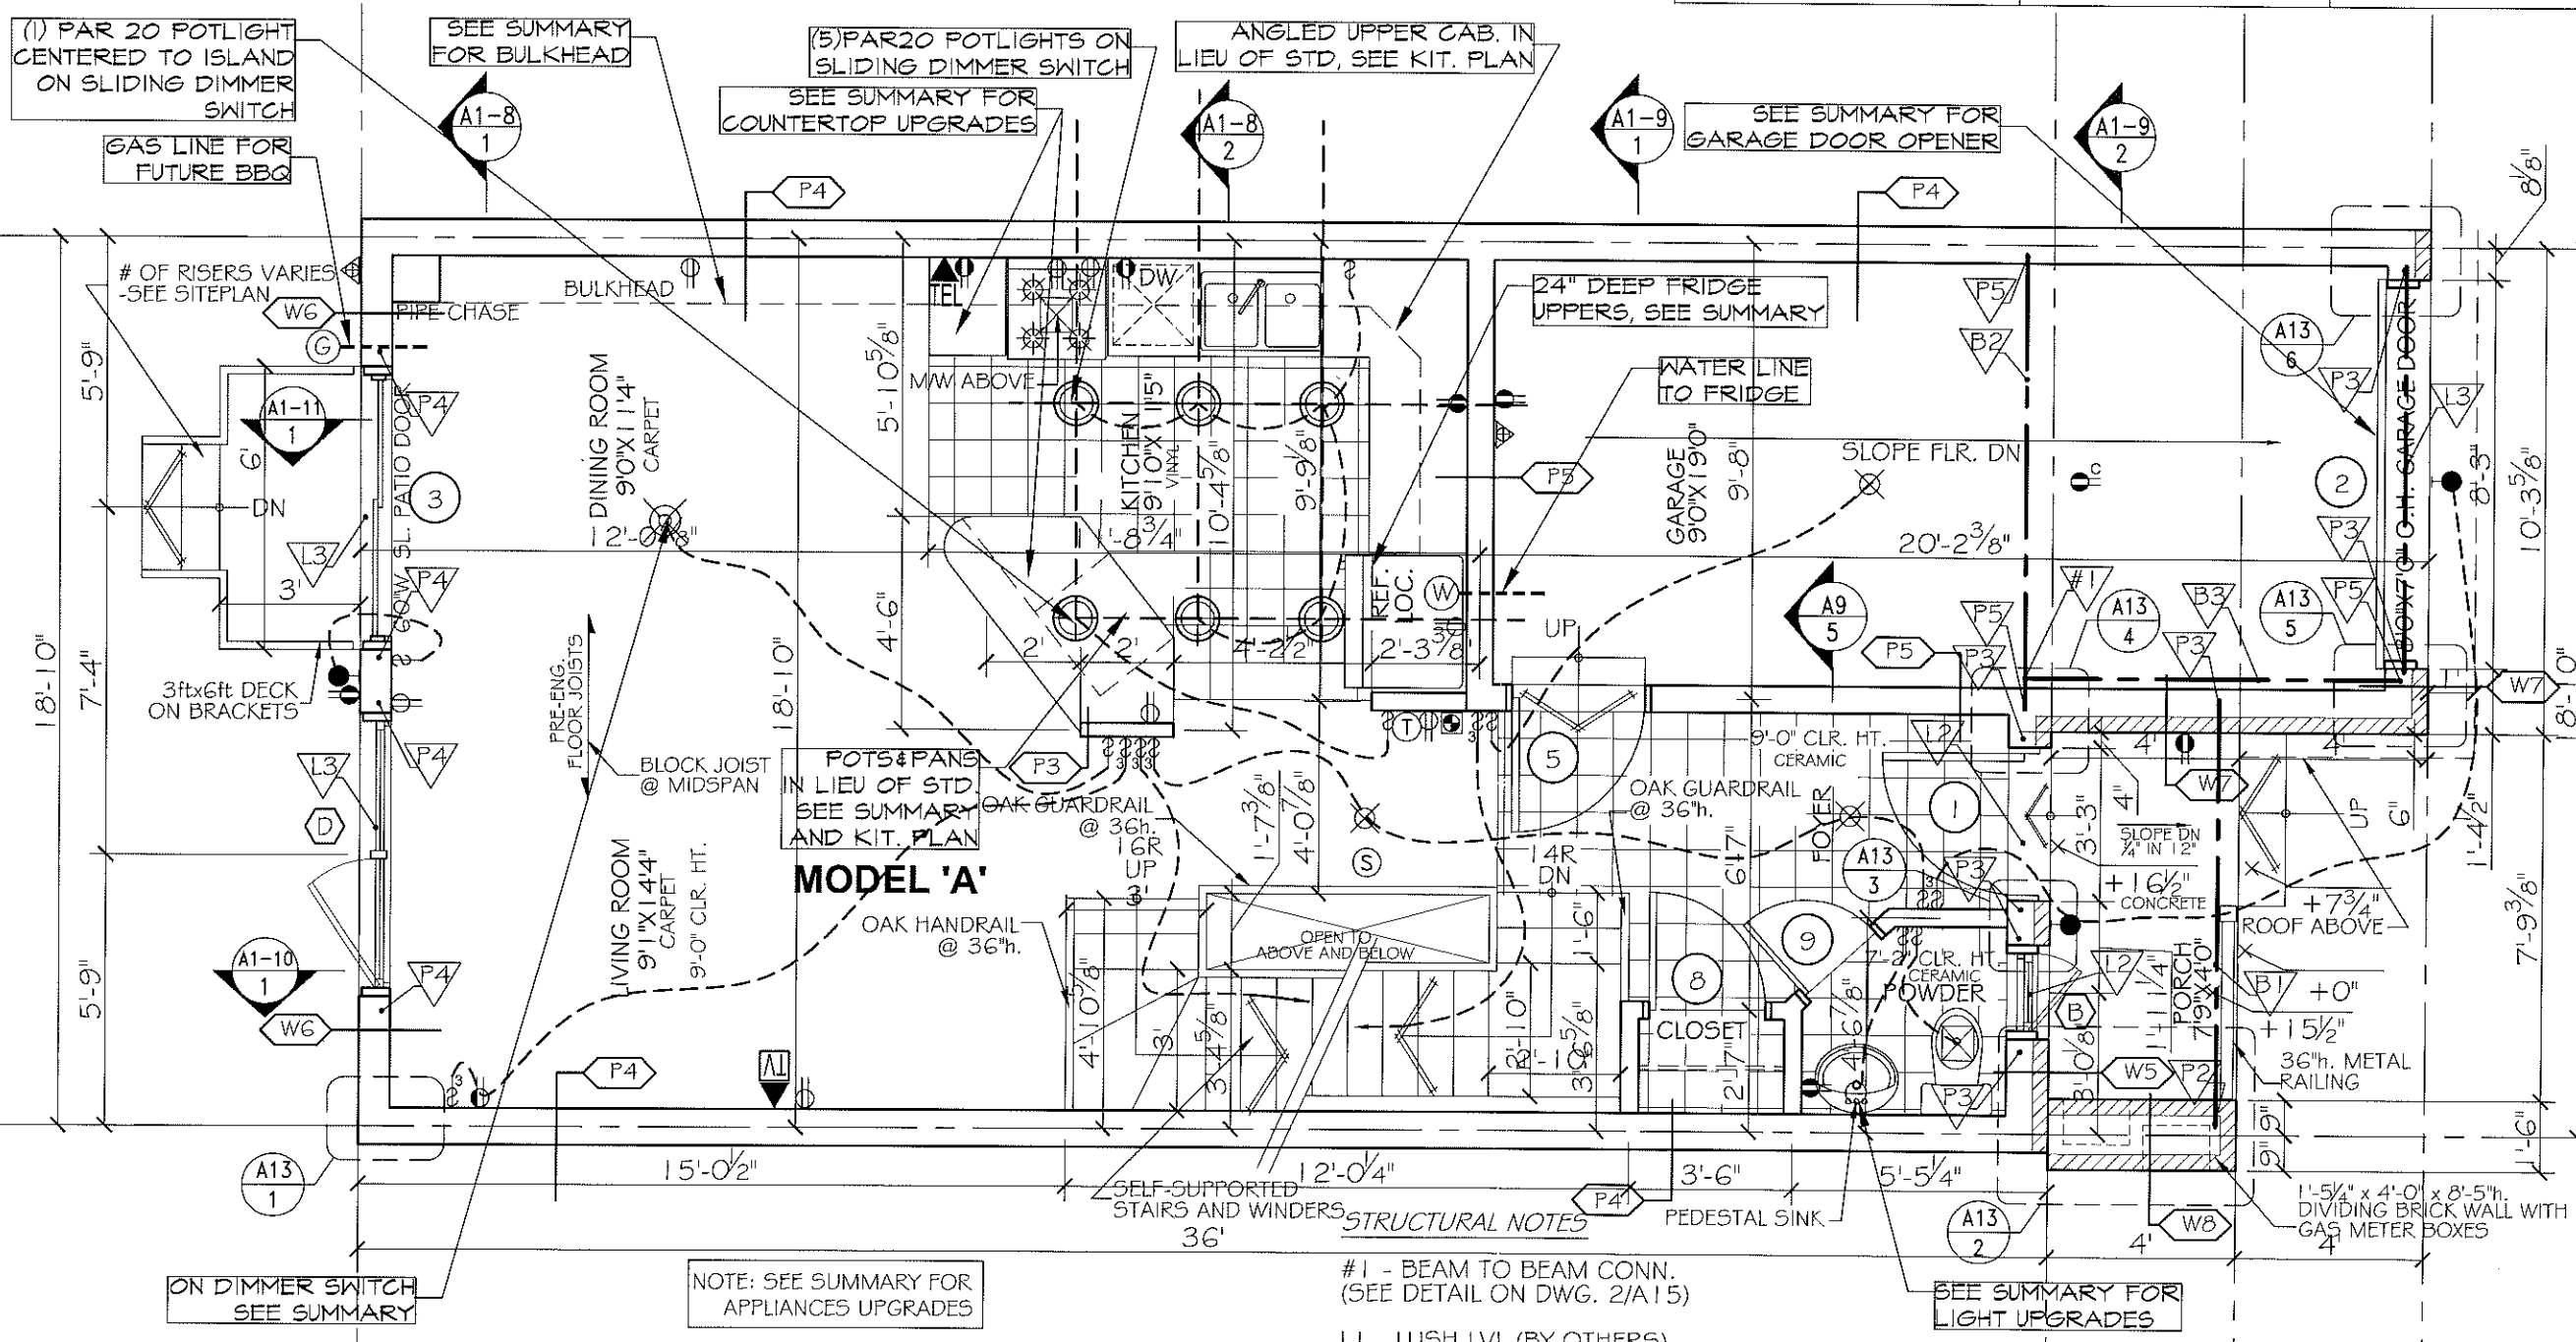

1 "MODEL A" - GROUND FLOOR PLAN  
SCALE: 1/4"=1'



STRUCTURAL NOTES

#1 - BEAM TO BEAM CONN. (SEE DETAIL ON DWG. 2/A15)

- L1 - LUSH LVL (BY OTHERS)
- L2 - 2-2x10
- L3 - 3-2x10

- P1 - 2-2x4
- P2 - 3-2x4
- P3 - 2-2x6
- P4 - 3-2x6
- P5 - 3" TELEPOST

- B1 - FLUSH LVL (BY OTHERS)
- B2 - W200x27 STEEL BEAM WITH 5/8" BRICK PLATE
- B3 - W150x22 STEEL BEAM

SPECIFIC NOTE:

SEE SHOP DRAWINGS AND THE REST OF ARCHITECTURAL & STRUCTURAL PLANS FOR COMPLETE WORKING DRAWINGS NOTES, SCHEDULES AND LEGENDS.

**BLOCK-2**  
**UNIT - 13**

# NOTES

1. SEE DWG. A4 FOR WALL & PARTITION ASSEMBLIES.
2. SEE DWG. A5 FOR DOOR AND WINDOW SCHEDULES.
3. SEE DWGS. A6 & A7 FOR SPECIFICATIONS.
4. SEE ENG. DWGS FOR FLOOR JOISTS, LVLs AND ROOF TRUSSES. USE 9 1/2" PRE-ENGINEERED JOISTS FOR ALL FLOOR ASSEMBLIES.
5. INTERIOR PARTITION WALLS MAY BE INCREASED TO 2x6 STUDS FOR STRUTURAL AND PLUMBING REQUIREMENTS. ADJUST DIMENSIONS ACCORDINGLY.
6. FIRESTOP ALL PLUMBING AND ELECTRICAL PENETRATIONS AT PARTY WALL.
7. STUD WALL REINFORCEMENT FOR FUTURE GRAB BARS IN MAIN BATHROOMS. O.B.C. 9.5.2.3.
8. ATTIC ACCESS HATCH TO BE PROVIDED AS PER NOTE 80 ON DWG. A7.

# STRUCTURAL NOTES

1. SEE PRE-ENG. FLOOR JOIST AND ROOF TRUSS DWGS. FOR FLOOR JOISTS, LVLs AND ROOF TRUSSES. USE 9 1/2" PRE-ENGINEERED JOISTS FOR ALL FLOOR ASSEMBLIES. DOUBLE UP STUDS UNDER ALL LVLs TO FOUNDATION LEVEL. FLOOR JOIST AND ROOF TRUSS DWGS. TO BE REVIEWED AND APPROVED BY STRUCTURAL ENGINEER.

# ELEC./MECH. LEGEND

- |                                               |                                          |                    |
|-----------------------------------------------|------------------------------------------|--------------------|
| ● PD FLOOR DRAIN                              | § 3-WAY LIGHT SWITCH                     | ⊠ EXHAUST FAN      |
| ⊙ SMOKE ALARM (120V)                          | ⊙ THERMOSTAT                             | ⊠ TELEPHONE OUTLET |
| ⊙ CARBON MONOXIDE DETECTOR                    | ⊙ 120V ELECTRICAL OUTLET                 | ⊠ CABLE TV OUTLET  |
| ⊙ CEILING MOUNTED INCAND. LIGHT FIXTURE       | ⊙ CEILING MOUNTED 120V ELECTRICAL OUTLET | ⊠ WATER HOOKUP     |
| ⊙ CAPPED CEILING OUTLET                       | ⊙ 220V ELECTRICAL OUTLET                 | ⊠ CENTRAL VACUUM   |
| ⊙ WALL-MOUNTED INCAND. LIGHT FIXTURE          | ⊙ GFI ELECTRICAL OUTLET                  | ⊠ ELECTRICAL PANEL |
| ⊙ WALL-MOUNTED EXTERIOR INCAND. LIGHT FIXTURE | ⊙ SWITCH ELECTRICAL OUTLET               |                    |

# NOTES

1. SEE DWG. A4 FOR WALL & PARTITION ASSEMBLIES.
2. SEE DWG. A5 FOR DOOR AND WINDOW SCHEDULES.
3. SEE DWGS. A6 & A7 FOR SPECIFICATIONS.
4. SEE ENG. DWGS FOR FLOOR JOISTS, LVLs AND ROOF TRUSSES. USE 9 1/2" PRE-ENGINEERED JOISTS FOR ALL FLOOR ASSEMBLIES.
5. INTERIOR PARTITION WALLS MAY BE INCREASED TO 2x6 STUDS FOR STRUTURAL AND PLUMBING REQUIREMENTS. ADJUST DIMENSIONS ACCORDINGLY.
6. FIRESTOP ALL PLUMBING AND ELECTRICAL PENETRATIONS AT PARTY WALL.
7. STUD WALL REINFORCEMENT FOR FUTURE GRAB BARS IN MAIN BATHROOMS. O.B.C. 9.5.2.3.
8. ATTIC ACCESS HATCH TO BE PROVIDED AS PER NOTE 80 ON DWG. A7.

# LEGEND


- ⊠ WALL / PARTITION ASSEMBLY
- ⊙ DOOR TYPE
- ⊙ WINDOW TYPE
- ⊠ STRUCTURAL NOTE

STRUCTURAL DESIGN BY JOHN STUART HALL, P.ENG. THIS DRAWING SHALL NOT BE USED FOR CONSTRUCTION PURPOSES UNLESS SIGNED AND SEALED BY THE STRUCTURAL ENGINEER OR BY THE ARCHITECT. PROVIDING A LETTER REFERENCING THE STRUCTURAL DESIGN AS HAVING BEEN PROVIDED UNDER HIS RESPONSIBILITY.

|      |            |                                      |
|------|------------|--------------------------------------|
| 7    | JAN. 22/13 | RE-ISSUED FOR PERMIT                 |
| 6    | JUL. 18/12 | SHOWER & VANITY REVISED, WINDOW REV. |
| 5    | JUN. 18/12 | WR SWITCH REVISED                    |
| 4    | APR. 24/12 | REVISED TO MEET OBC 98-12            |
| 3    | DEC. 23/11 | REVISED AS PER STRUCTURAL            |
| 2    | DEC. 7/11  | ISSUED FOR PERMIT                    |
| 1    | OCT. 1/10  | ISSUED FOR PRELIM. REVIEW            |
| DATE | REVISION   |                                      |

THIS DRAWING SHALL NOT BE USED FOR CONSTRUCTION PURPOSES UNTIL SIGNED BY THE ARCHITECT

SignedSeal3.jpg

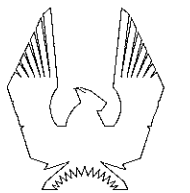


PHOENIX HOMES

PROJECT  
**SAWGRASS TOWNS**  
JOCKVALE RD.  
OTTAWA, ON

DRAWING NAME  
**"MODEL A REVERSED" SECOND FLOOR PLAN**

|          |           |             |              |
|----------|-----------|-------------|--------------|
| DRAWN BY | RDB       | DATE        | OCT. 1, 2010 |
| SCALE    | 1/4" = 1' | DRAWING NO. | A1-3         |
| JOB NO.  | 967       |             |              |

MORRIS MELAMED  
architect - ottawa  
(613) 727-7400 FAX (613) 727-7334

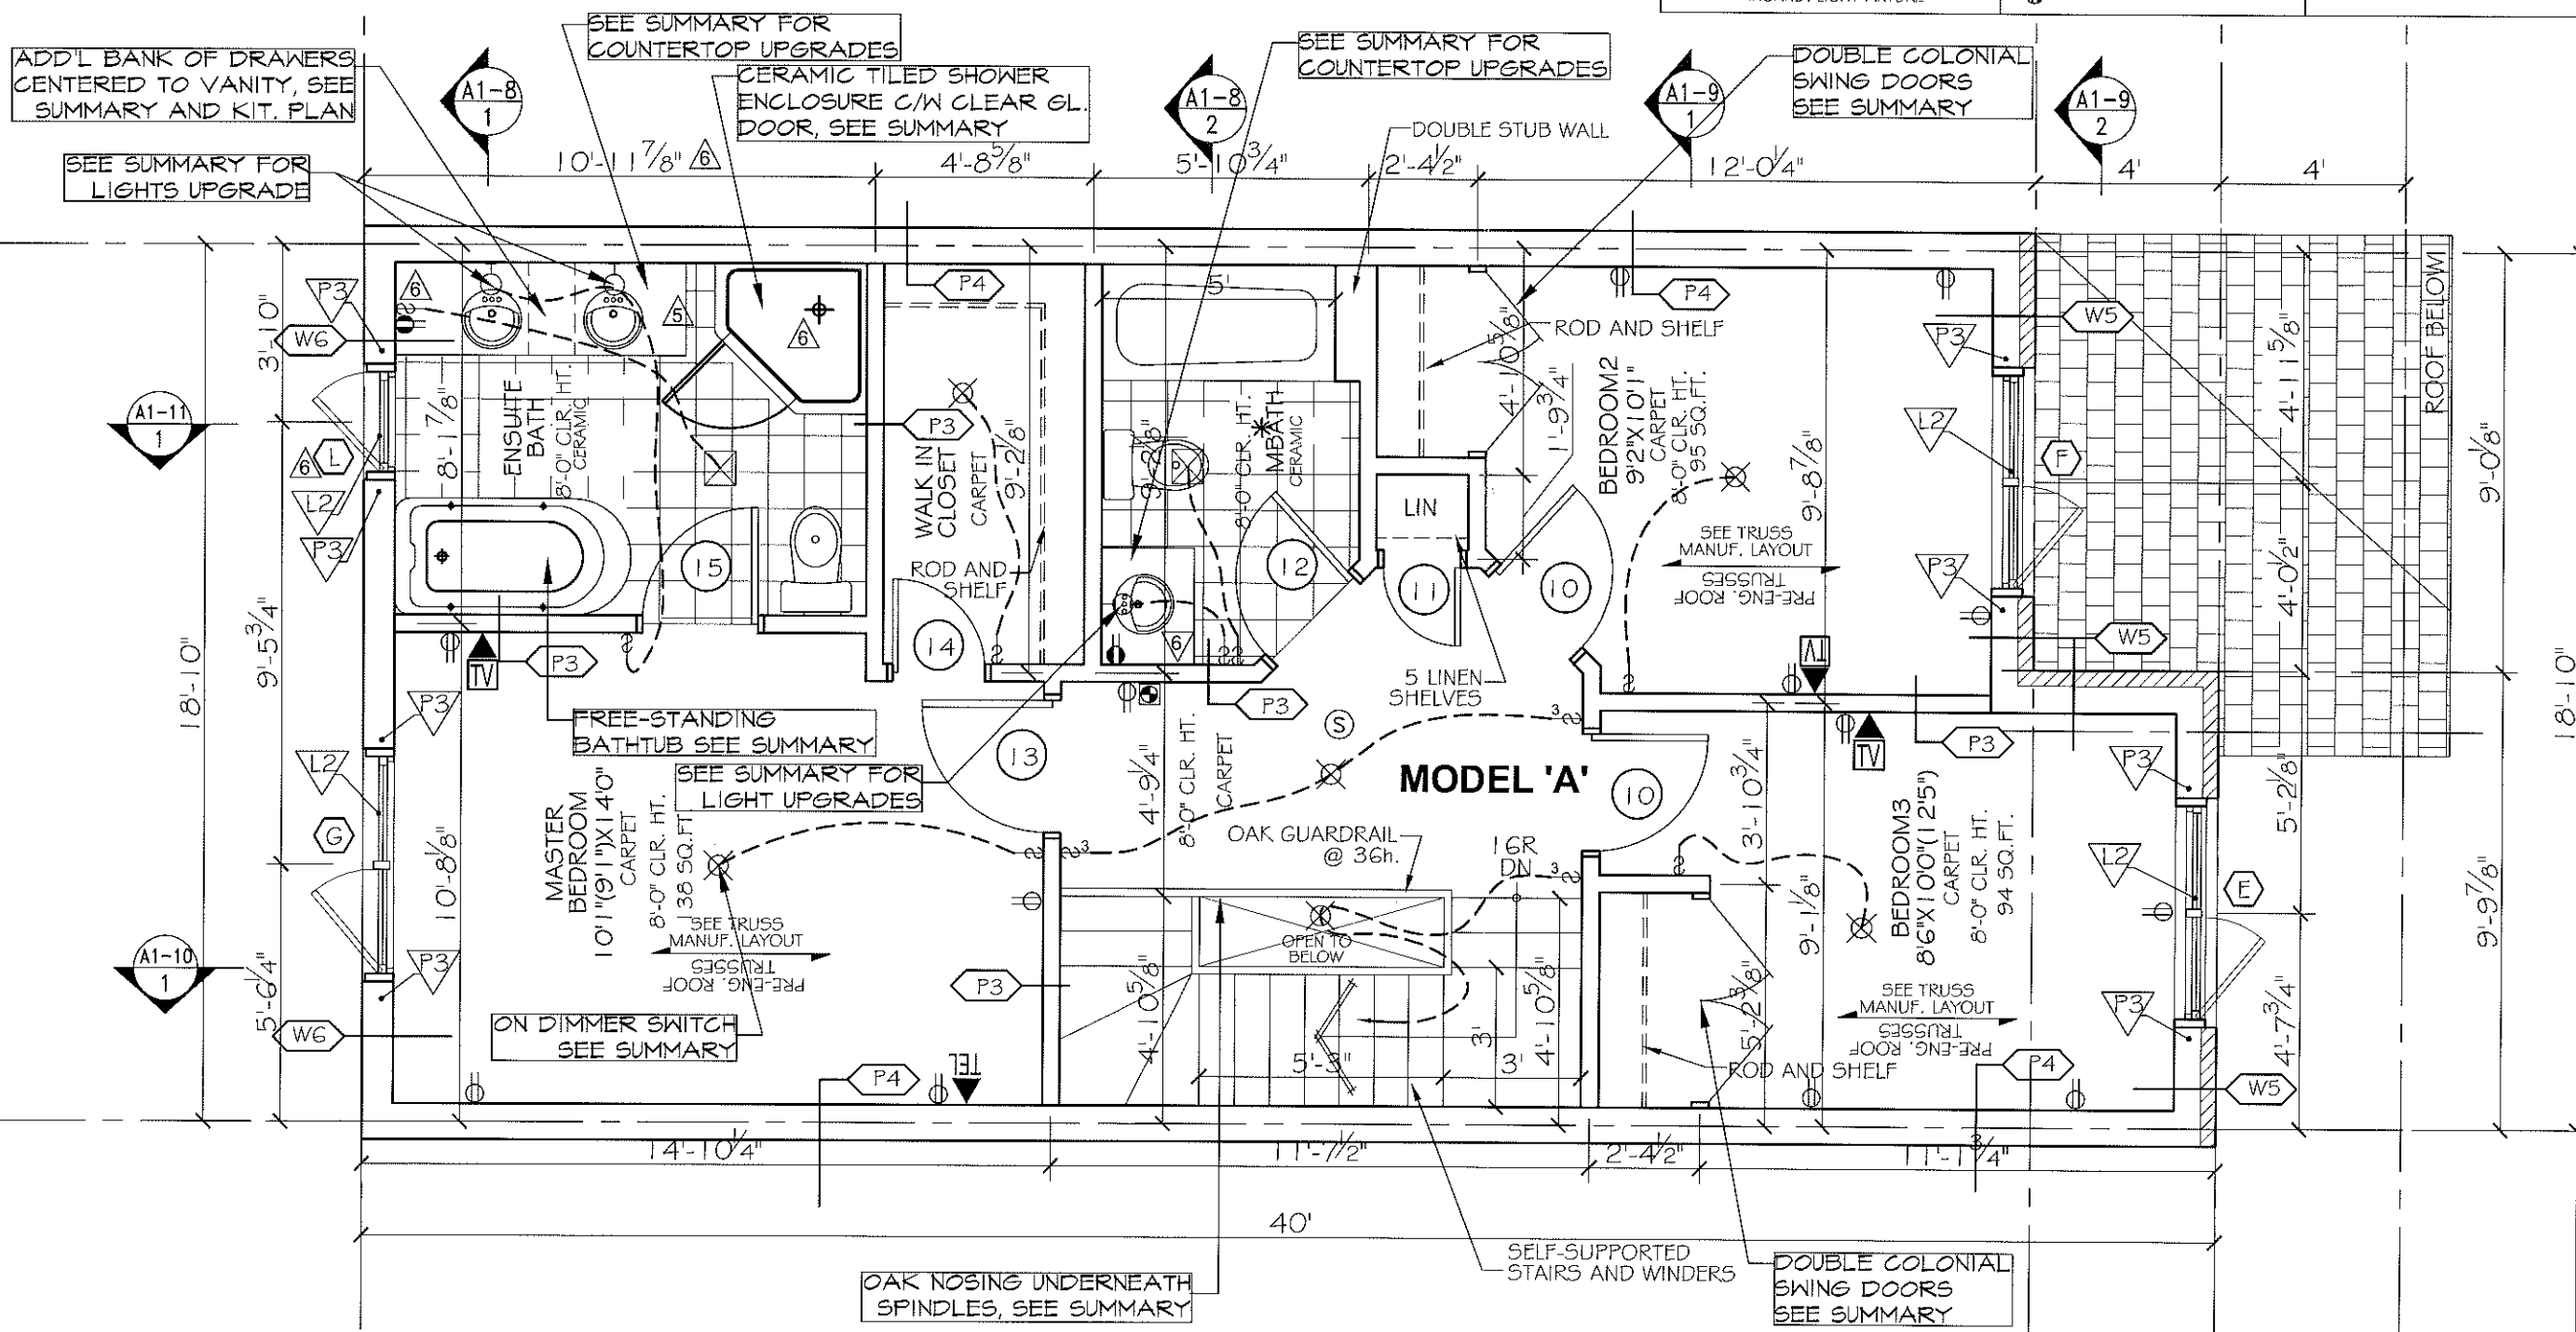

1 "MODEL A" - SECOND FLOOR PLAN  
A1-3 SCALE: 1/4"=1'

# STRUCTURAL NOTES

- L1 - LUSH LVL (BY OTHERS)
- L2 - 2-2x10
- L3 - 3-2x10

P3 - 2-2x6

# SPECIFIC NOTE:

SEE SHOP DRAWINGS AND THE REST OF ARCHITECTURAL & STRUCTURAL PLANS FOR COMPLETE WORKING DRAWINGS NOTES, SCHEDULES AND LEGENDS.

**BLOCK-2**  
**UNIT - 13**



