


DCR PHOENIX HOMES

SHADOW RIDGE TOWNS

MODEL SB6 - ORION


KITCHEN / VANITIES

MOUNTING HT - 84"

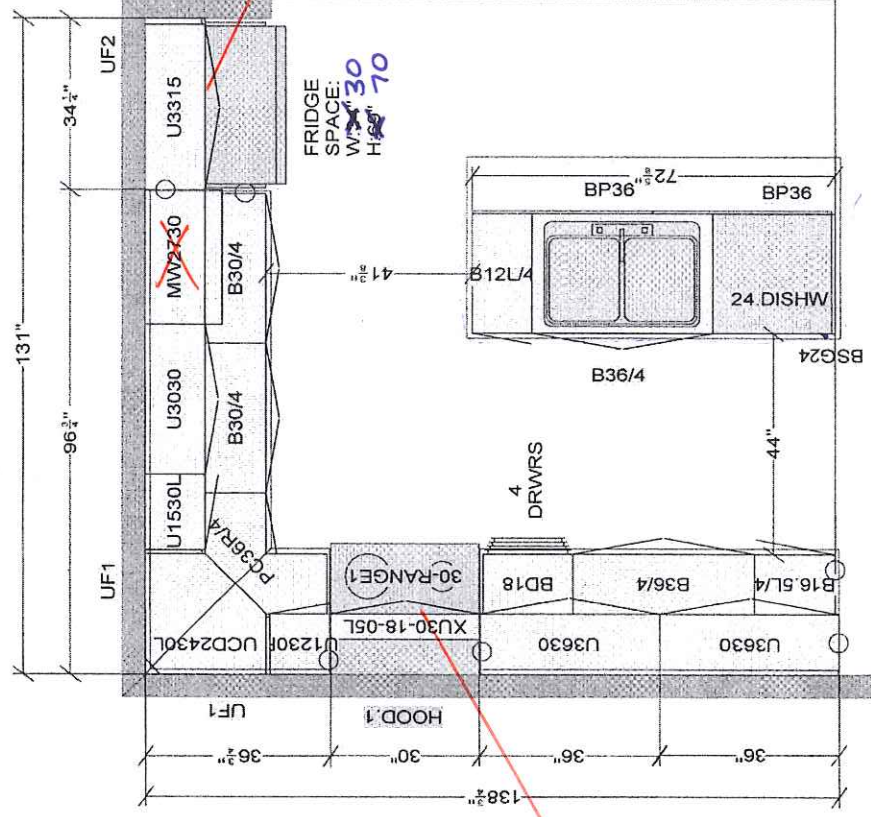

OTR
microfluid

Crown
moulding

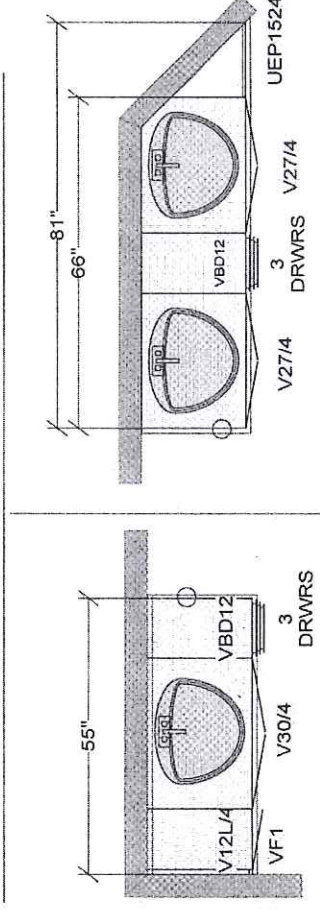

MAIN BATH

ENSUITE

All dimensions, size designations given are subject to verification on job site and adjustment to fit job conditions.

CARTIER KITCHENS OTTAWA

DCR - Shadow Ridge Towns - SB6 - ORION

NO. 15
10/15/15



This is an original design and must not be released or copied unless applicable fee has been paid or job order placed.

DRAWN BY: LD
CARTIER KITCHENS OTTAWA

Designed: 1/18/2013
Printed: 1/18/2013

Drawing #: 1	No Scale.
--------------	-----------