


CONSTRUCTION NOTES

- ALL CONSTRUCTION TO ADHERE TO THESE PLANS AND SPECS AND TO CONFORM TO THE ONTARIO BUILDING CODE AND ALL OTHER APPLICABLE CODES AND AUTHORITIES HAVING JURISDICTION. THESE REQUIREMENTS ARE TO BE TAKEN AS MINIMUM SPECIFICATIONS. ONT. REG. 332/12
1. ROOF CONSTRUCTION
NO.210 (10.25kg/m²) ASPHALT SHINGLES, 11.1mm (7/16") ASPENITE SHEATHING WITH "H" CLIPS, APPROVED WOOD TRUSSES @ 600mm (24") O.C. MAX. APPROVED EAVES PROTECTION TO EXTEND 900mm (3'-0") FROM EDGE OF ROOF AND MIN. 300mm (12") BEYOND INNER FACE OF EXTERIOR WALL (EAVES PROTECTION NOT REQ'D. FOR ROOF 8.12 OR GREATER)
38x89 (2"x4") TRUSS BRACING @ 1830mm (6'-0") O.C. AT BOTTOM CHORD. PREFIN. ALUM. EAVESTROUGH, FASCIA, RVL & VENTED SOFFIT. ATTIC VENTILATION 1:300 OF INSULATED CEILING AREA WITH 25% AT EAVES. AND 25% AT RIDGE (OBC 9.19.1.2)
2. FRAME WALL CONSTRUCTION (2"x6")
SIDING AS PER ELEVATION, APPROVED AIR BARRIER RSI. 0.9 (R5) EXTERIOR RIDG INSULATION BOARD 38x89 (2"x4") STUDS @ 400mm (16") O.C. WITH APPROVED DIAGONAL WALL BRACING, RSI 3.87 (R22) INSULATION AND APPROVED VAPOUR BARRIER AND APPROVED CONT. AIR BARRIER 13mm (1/2") INT. DRYWALL FINISH. SIDING TO BE MIN. 200mm (8") ABOVE FIN. GRADE
3. BRICK VENEER CONSTRUCTION (2"x8")
90mm (4") FACE BRICK 25mm (1") AIR SPACE. 22x180x76mm (7/8"x7"x0.03") GALV. METAL TIES @ 400mm (16") O.C. HORIZONTAL 500mm (24") O.C. VERTICAL. APPROVED AIR BARRIER 11.1mm (7/16") EXTERIOR TYPE SHEATHING, 38x140 (2"x6") STUDS @ 400mm (16") O.C. RSI 3.87 (R22) INSULATION AND APPROVED VAPOUR BARRIER WITH APPROVED CONTIN. AIR BARRIER 13mm (1/2") INT. DRYWALL FINISH. PROVIDE WEEP HOLES @ 800mm (32") O.C. BOTTOM COURSE AND OVER OPENINGS. PROVIDE BASE FLASHING UP MIN. 150mm (6") BEHND BUILDING PAPER. BRICK TO BE MIN. 150mm (6") ABOVE FINISH GRADE.
- 3A. BRICK VENEER CONSTRUCTION (2"x4")
90mm (4") FACE BRICK 25mm (1") AIR SPACE. 22x180x76mm (7/8"x7"x0.03") GALV. METAL TIES @ 400mm (16") O.C. HORIZONTAL 600mm (24") O.C. VERTICAL. APPROVED AIR BARRIER RSI. 0.9 (R5) EXT. RIGD INSUL. 59. 38x89 (2"x4") STUDS @ 400mm (16") O.C. WITH APPROVED DIAGONAL WALL BRACING, RSI 3.35 (R19) INSULATION AND APPROVED VAPOUR BARRIER WITH APPROVED CONT. AIR BARRIER, 13mm (1/2") INT. DRYWALL FINISH. PROVIDE WEEP HOLES @ 800mm (32") O.C. BOTTOM COURSE AND OVER OPENINGS. PROVIDE BASE FLASHING UP MIN. 150mm (6") BEHND BUILDING PAPER. BRICK TO BE MIN. 150MM(6") ABOVE FINISH GRADE.
4. INTERIOR STUD PARTITIONS
FOR BEARING PARTITIONS 38x89 (2"x4") @ 400mm (16") O.C. FOR 2 STOREYS AND 300mm (12") O.C. FOR 3 STOREYS. NON-BEARING PARTITIONS 38x89 (2"x4") @ 600mm (24") O.C. PROVIDE 18.8x69 (3/4"x2") MIN. TRAD. BOTTOM PLATE AND 2/38x89 (2"x4") MIN. TRAD. 13mm (1/2") INT. DRYWALL BOTH SIDES OF STUDS. PROVIDE 38x140 (2"x6") STUDS/PLATES WHERE NOTED.
5. FOUNDATION WALL/FOOTINGS -SEE OBC 9.13.3, 9.13.4
200mm (8") POURED CONC. FDTN. WALL 20MPa (300psi) WITH BITUMENOUS DAMPROOFING AND OPT. DRAINAGE LAYER. BITUMENOUS LAYER REQ. WHEN BASEMENT INSUL. EXTENDS 900 (2'-11") BELOW FIN. GRADE. MAXIMUM POUR HEIGHT 2390 (7'-10") ON 500x155 (20"x6") CONTINUOUS KEYED CONC. FTG. BRACE FDTN. WALL PRIOR TO BACKFILLING. ALL FOOTINGS SHALL REST ON NATURAL UNDISTURBED SOIL OR COMPACTED ENGINEERED FILL, WITH MIN. BEARING CAPACITY OF 75kPa OR GREATER. IF SOIL BEARING DOES NOT MEET MIN. CAPACITY, ENGINEERED FOOTINGS ARE REQUIRED. MAX. FLOOR LIVE LOADOF 2.4kpa(50psf) PER FLOOR, AND MAX. LENGTH OF SUPPORTED JOISTS IS 4.9m (16'-11"). REFER TO SOILS REPORT FOR SOILS CONDITIONS AND BEARING CAPACITY.
6. 100mm (4") DIA. WEEPING TILE 150mm (6") CRUSHED STONE OVER AND AROUND WEEPING TILES.
7. BASEMENT SLAB OBC 9.3.1.5(1)(b) & 9.16.4.5(1) 100mm (3") MIN. 32MPa (4640psi) CONC. SLAB ON (2200psi) CONC. WITH DAMPROOFING BELOW SLAB. PROVIDE RSI 1.76 (R10) INSULATION
8. EXPOSED FLOORS TO EXTERIOR
PROVIDE RSI 5.45 (R31) INSULATION, APPROVED VAPOUR BARRIER AND CONTINUOUS AIR BARRIER, FINISHED SOFFIT.
9. ATTIC INSULATION OBC. 12.3.2.1 & 12.3.3.7
RSI 8.81 (R50) BLOWN IN ROOF INSULATION AND APPROVED VAPOUR BARRIER, 16mm (5/8") INT. DRYWALL FINISH OR APPROVED EQUAL.
10. ALL STAIRS/EXTERIOR STAIRS -OBC 9.8.2 - UNIFORM RISE & RUN IN A GIVEN RUN TO WITHIN 5mm(1/8") MAX. RISE = 200 (7-7/8") MIN. RUN = 210 (8-1/4") MAX. NOSING = 25 (1-1/4") MIN. HEADROOM = 1950 (6'-5") RAIL @ LANDING = 900 (2'-11") MIN. STAIR WIDTH = 800 (2'-8") ICE CURVED STAIRS MIN. RUN = 150 (6") MIN. AVG. RUN = 200 (8") FINISHED RAILING ON PICKETS SPACED MAXIMUM 100mm (4") BETWEEN PICKETS. CLEARANCE SET, HANDRAIL AND SURFACE BEHIND IT TO BE 50mm(2") MIN. HANDRAILS TO BE CONT. EXCEPTING FOR NEWEL POST AT CHANGES OF DIRECTION.
11. GUARDS -OBC 9.8.5.3.2
INTERIOR GUARDS: 900mm (2'-11") MIN. EXTERIOR GUARDS: 1070mm (3'-6") MIN.
12. 38x89 (2"x4") SILL PLATE WITH 13mm (1/2") DIA. ANCHOR BOLTS 200mm (8") LONG, EMBEDDED MIN. 100mm (4") INTO CONC. @ 2400mm(7'-10") O.C. USE NON-SHRINK GROUT TO LEVEL SILL PLATE WHEN REQUIRED. (SEE OBC 9.23.7)
13. RSI 3.52 (R20) INSULATION BLANKET OR BATTS WITH 38x89 (2"x4") STUD WALL, AND APPROVED VAPOUR BARRIER TO 200 (8") BELOW FIN. GRADE. DAMPROOF WITH BUILDING PAPER BETWEEN THE FOUNDATION WALL AND INSULATION UP TO GRADE LEVEL. NOTE: FULL HEIGHT INSULATION AT COLD CELLAR WALLS.

14. BEARING STUD PARTITION
38x89 (2"x4") STUDS @ 400mm (16") O.C. 38x89 (2"x4") SILL PLATE ON DAMPROOFING MATERIAL 15mm (1/2") DIA. ANCHOR BOLTS 200mm (8") LONG, EMBEDDED MIN. 100mm (4") INTO CONC. @ 2400mm (7'-10") O.C. 100mm (4") HIGH CONC. CURB ON 350x155 (14"x6") CONC. FOOTING, ADJ. HORIZ. BRACING AT MID-HEIGHT IF WALL IS UNFINISHED
15. STEEL-BASEMENT COLUMN (SEE O.B.C. 9.17.3.1, 9.17.3.4)
75mm (3") DIA. ADJUSTABLE STL. COL. CONFORMING TO CAN/CSB-7.2M. AND WITH 150x150x8.5 (6"x6"x3/8") STL. PLATE TOP & BOTTOM. 910x910x300 (36"x36"x12") CONC. FOOTING ON UNDISTURBED SOIL OR ENGINEERED FILL CAPABLE OF SUSTAINING A PRESSURE OF 125 Kpa. MINIMUM AND AS PER SOILS REPORT.
- 15A. STEEL-BASEMENT COLUMN (SEE O.B.C. 9.17.3.1, 9.17.3.4)
3"x3"x(18) NON-ADJUSTABLE STL. COL. WITH 150x150x8.5 (6"x6"x3/8") STL. TOP & BOTTOM PLATE ON 910x910x300 (36"x36"x12") CONC. FOOTING ON UNDISTURBED SOIL OR ENGINEERED FILL CAPABLE OF SUSTAINING A PRESSURE OF 125 Kpa. MIN. AND AS PER SOILS REPORT.
- 15B. STEEL COLUMN (SEE 9.17.3.1, 9.17.3.4)
3"x3"x(18) NON-ADJUSTABLE STL. COL. TO BE ON 150x150x9.5 (6"x6"x3/8") STEEL TOP PLATE, & BOTTOM PLATE. 2-12mm (1/2") DIA. x 300mm LONG x50mm HOOK ANCHORS (2-1/2"x12"x2") FIELD WELD COL. TO BASE PLATE. BEAM POCKET OR 300x150 (12"x6") POURED CONC. NIB WALLS. MIN. BEARING 90mm (3'-1/2") 19x64 (1"x3") CONTINUOUS WD. STRAPPING BOTH SIDES OF STEEL BEAM.
16. GARAGE SLAB: 100mm (4") 32MPa (4640psi) CONC. SLAB WITH 5-8% AIR ENTRAINMENT ON OPT. 100 (4") COARSE GRANULAR FILL WITH COMPACTED SUB-BASE OR COMPACTED NATIVE FILL SLOPE TO FRONT AT 1% MIN.
17. 13mm (1/2") GYPSUM BD. ON WALL AND CEILING BETWEEN HOUSE AND GARAGE, RSI 3.35 (R19) IN WALLS, RSI 4.4 (R25) IN CEILING. TAPE AND SEAL ALL JOINTS AIR TIGHT. PER OBC 9.10.9.16
18. DOOR AND FRAME GASPROOFED. DOOR EQUIPPED WITH SELF CLOSING DEVICE AND WEATHERSTRIPPING. PER OBC 9.10.13.15
19. WOOD STEP, C/W HANDRAIL & LANDING IF MORE THAN 3 RISERS, MAX.RISE 200mm (7-7/8") MIN.TREAD 250mm (9-1/2") SEE OBC 9.8.9.2, 9.8.9.3 & 9.8.10
20. CAPPED DRYER EXHAUST VENTED TO EXTERIOR (USE 100mm(4") DIA. SMOOTH WALL VENT PIPE) OBC 9.2.3.8(7)
21. ATTIC ACCESS HATCH 545x810 (21.5"x24") WITH A MIN. AREA OF 3.44 SF WITH WEATHERSTRIPPING RSI 7.0 (R40) RIGD INSUL. BACKING OBC 9.19.2
22. FIREPLACE CHIMNEYS -OBC 9.21-2
TOP OF FIREPLACE CHIMNEY SHALL BE 915mm (3'-0") ABOVE THE HIGHEST POINT AT WHICH IT COMES IN CONTACT WITH THE ROOF AND 610mm (2'-0") ABOVE THE ROOF SURFACE WITHIN A HORIZ. DISTANCE OF 3050mm (10'-0") FROM THE CHIMNEY.
23. LINEN CLOSET, 4 SHELVES MIN. 350mm (14") DEEP. MECHANICAL EXHAUST FAN, VENTED TO EXTERIOR. TO PROVIDE AT LEAST ONE AIR CHANGE PER HOUR.
24. STEEL BEARING PLATE FOR MASONRY WALLS
280x280x16 (11"x11"x5/8") STL. PLATE FOR STL BEAMS AND 280x280x12 (11"x11"x1/2") STL. PLATE FOR WOOD BEAMS BEARING ON CONC. BLOCK PARTYWALL, ANCHORED WITH 2-19mm (3/4") 602mm (8") LONG GALV. ANCHORS WITHIN SLOUT. BLOCK COURSE. LEVEL WITH NON-SHRINK GROUT.
25. SOLID WOOD BEARING FOR WOOD STUD WALLS
SOLID BEARING TO BE AT LEAST AS WIDE AS THE SUPPORTED MEMBER. SOLID WOOD BEARING COMPRISED OF BUILT-UP WOOD STUDS TO BE CONSTRUCTED IN ACCORDANCE WITH OBC 9.17.4.2 (2).
26. U.L.C. RATED CLASS "B" VENT 610mm (2'-0") ABOVE THE POINT IN CONTACT WITH THE ROOF FOR SLOPES UP TO 9/12, REFER TO THE ONTARIO GAS UTILIZATION CODE.
27. 3-38x140 (3-2"x6") BUILD-UP-POST ON METAL BASE SHOE ANCHORED TO CONC. WITH 12.7 DIA. BOLT. 610x610x300 (24"x24"x12") CONC. FTG. OBC 9.17.4
28. STEP FOOTINGS: MIN. HORIZ. STEP = 600mm (23"-5/8") MAX. VERT. STEP = 600mm (23"-5/8") FOR FIRM SOILS.
29. PORCH SLABS:
130 mm (5") MIN. CONC. 32 MPa (4640psi) SLAB AIR ENTRAINMENT MIN. 5 TO 8% AT 28 DAYS. 10 M BARS @ 250 O/C EACH WAY. 10 M BARS @ 400 (16") O.C. 2-15m IN THICKENED AREA FROM WALL TO SLAB ALL SIDES (SEE DETAIL)
30. DIRECT VENT FURNACE TERMINAL MIN. 300mm (12") FROM A GAS REGULATOR, MIN. 900mm (36") FROM ALL OPENINGS, EXHAUST AND INTAKE VENTS. HRV INTAKE TO BE A MIN. OF 1830mm (6'-0") FROM ALL EXHAUST TERMINALS. REFER TO GAS UTILIZATION CODE.
31. DIRECT VENT GAS FIREPLACE VENT TO BE A MINIMUM 300mm (12") FROM ANY OPENING AND ABOVE FIN. GRADE. REFER TO GAS UTILIZATION CODE.
32. SUBFLOOR, JOIST STRAPPING AND BRIDGING
-15mm (5/8") T & G SUBFLOOR ON WOOD FLOOR JOISTS, FOR CERAMIC TILE APPLICATION (* SEE OBC 9.30.6. *) 6mm (1/4") PANEL TYPE UNDERLAY UNDER RESILIENT & PARQUET FLOORING. (-+ SEE OBC 9.30.2 *)
33. ALL JOISTS TO BE BRIDGED WITH 38x38 (2"x2") CROSS BRACING OR SOLID BLOCKING @ 2105mm (6'-11") O.C. MAX. ALL JOISTS TO BE STRAPPED WITH 19x64 (1"x3") @ 2100mm (6'-11") O.C. UNLESS A PANEL TYPE CEILING FINISH IS APPLIED. (SEE OBC 9.23.9.4)
34. EXPOSED BUILDING FACE -OBC 9.10.14.5
EXTERIOR WALLS TO HAVE A FIRE RESISTANCE RATING OF NOT LESS THAN 45 min. WHERE LIMITING DISTANCE IS LESS THAN 1.2M (3'-11"). WHERE THE LIMITING DISTANCE IS LESS THAN 600mm (1'-11") THE EXPOSING FACE SHALL BE CLAD IN NON-COMBUSTIBLE MATERIAL.
35. COLD CELLAR PORCH SLAB (OBC 9.40)
FOR MAX. 2500mm (8'-2") DEPTH. (SHORTEST DIMENSION) 125mm (4 7/8") 32MPa (4640psi) CONC. SLAB WITH 5-8% AIR ENTRAINMENT. REIN. WITH 10M BARS @ 200mm (7 7/8") O.C. EACH WAY IN BOTTOM THIRD OF SLAB. MIN. 30mm(1 1/4") COVER, 600x600mm (23 5/8"x23 5/8") 10M DOWELS @ 600mm (23 5/8") O.C. ANCHORED IN PERIMETER FDTN. WALLS. SLOPE: 1:4 MIN. 1.0% FROM HOUSE WALL. SLAB TO HAVE MIN. 30mm (1") BEARING IN FDN. WALLS. PROVIDE (127) LITELTS OVER CELLAR DOOR & WITH 100mm(4") END BEARINGS.
36. THE FDTN. WALL SHALL NOT BE REDUCED TO LESS THAN 90mm (3-1/2") THICK TO A MAX. DEPTH OF 350mm (13-3/4") AND SHALL BE TIED TO THE FACING MATERIAL WITH METAL TIES SPACED 200mm (8") O.C. VERTICALLY AND 900mm (36") O.C. HORIZONTALLY. FILL SPACE BETWEEN WALL AND FACING SOLID WITH MORTAR. (SEE O.B.C. 9.15.4.7)

38. CONVENTIONAL ROOF FRAMING
38x140 (2"x6") RATTERS @ 400mm (16"O.C.), FOR MAX. (1'-7") SPAN.
40. STRIP FOOTING SUPPORTING EXTERIOR WALLS. -SEE OBC 9.15.3. -ASSUMING MASONRY VENEER CONSTRUCTION, MAX. FLOOR LIVE LOAD OF 2.4Kpa. (50psf) PER FLOOR, AND MAX. LENGTH OF SUPPORTED FLOOR JOISTS IS 4.9m (16'-11").
41. THE STRIP FOOTING SIZE IS AS FOLLOWS:
2 STOREY (STANDARD) 500x155 (20"x6")
2 STOREY (WALK-OUT BASEMENT) 545x175 (22"x7") (UNLESS OTHERWISE NOTED ON PLAN)
42. EXTERIOR WALLS FOR WALK-OUT CONDITIONS
THE EXTERIOR BASEMENT STUD WALL TO BE 38x140 (2"x6") STUDS @ 16" o.c. OR 38x89 (2"x4") STUDS @ 12" o.c.
39. TWO STOREY VOLUME SPACES
FOR HIGH HALL UP TO 18'0", CONSTRUCTION: 2"x6" SPACING AS INDICATED BLOCKING, 910x910x300 (36"x36"x12") ASPENITE SHEATHING, 2" STAPLES BET. 4" AND 6" O/C ALONG STUDS. NAILING: 2" STAPLES PER VARIOUS FINISHES:
1. SIDING-METAL OR VINYL- 2"x6" @16" O/C
2. STUCCO -2"x6" @16" O/C
3. BRICK TO 4'-0" -2"x6" @16" O/C
4. BRICK FULL HEIGHT -2"x6" @12" O/C
- WINDOWS:
1) MINIMUM BEDROOM WINDOW -OBC 9.7.1.3- AT LEAST ONE BEDROOM WINDOW ON A GIVEN FLOOR IS TO HAVE MIN. 0.35m² UNOBSTRUCTED GLAZED OR OPENABLE AREA WITH MIN. CLEAR WIDTH OF 380 mm (1'-3").
2) WINDOW GUARDS -OBC 9.7.1.6- 8.8. A GUARD IS REQUIRED WHERE THE TOP OF THE WINDOW SILL IS LOCATED LESS THAN 480mm (1'-7") ABOVE FIN. FLOOR AND THE DISTANCE FROM THE FIN. FLOOR TO THE ADJACENT GRADE IS GREATER THAN 1800mm (5'-11")
3) ALL WINDOWS TO COMPLY WITH THERMAL RESISTANCE REQUIREMENTS STATED IN OBC 12.3.2.6.
- GENERAL
1) MECHANICAL VENTILATION IS REQUIRED TO PROVIDE 0.3 AIR CHANGES PER HOUR AVERAGED OVER 24 HOURS. SEE MECHANICAL DRAWINGS.
2) ALL DOWNSPOUTS TO DRAIN AWAY FROM THE BUILDINGS PER OBC 9.26.18.2 AND MUN. STANDARDS.
3) ALL WINDOW WELLS TO DRAIN TO FOOTING LEVEL PER OBC 9.14.6.3 CHECK WITH LOCAL AUTHORITY.
4) PROVIDE STUD WALL REINFORCEMENT FOR FUTURE GRAB BARS IN BATHROOMS. REINF. OF STUD WALLS SHALL BE INSTALLED ACCORDING TO WATER CLOSETS AND SHOWER OR BATHTUB IN MAIN BATHROOM, SEE OBC 9.5.2.3, 3.8.3.8(1)(d) & 3.8.3.13(1)(f).
- LUMBER:
1) ALL LUMBER SHALL BE SPRUCE NO.2 GRADE, UNLESS NOTED OTHERWISE.
2) STUDS SHALL BE STUD GRADE SPRUCE, UNLESS NOTED OTHERWISE.
3) LUMBER EXPOSED TO THE EXTERIOR TO BE SPRUCE NO.2 GRADE PRESSURE TREATED OR CEDAR, UNLESS NOTED OTHERWISE.
4) ALL LAMINATED VENEER LUMBER (L.V.L.) BEAMS, GIRDER TRUSSES, AND METAL HANGER CONNECTIONS SUPPORTING ROOF FRAMING TO BE DESIGNED & CERTIFIED BY TRUSS MANUF.
5) LVL BEAMS SHALL BE 2.0E WS MICRO-LAM LVL (Fb=2800psi MIN.) OR EQUIVALENT. NAIL EACH PLY OF LVL WITH 89mm (3 1/2") LONG COMMON WIRE NAILS @ 300mm (12") O.C. STAGGERED IN 2 ROWS FOR 184, 240 & 300mm (7 1/4", 9 1/2", 11 7/8") DEPTHS AND STAGGERED IN 3 ROWS FOR GREATER DEPTHS AND FOR 4 PLY MEMBERS ADD 13mm (1/2") DIA. GALVANIZED BOLTS BOLTED AT MID-DEPTH OF BEAM @ 915mm (3'-0") O.C.
6) PROVIDE TOP MOUNT BEAM HANGERS TYPE "SCL" MANUFACTURED BY MCA CONNECTOR LTD. Tel. (905) 642-3175 OR EQUAL FOR ALL LVL BEAM TO BEAM CONNECTIONS UNLESS OTHERWISE NOTED.
- 7) JOIST HANGERS: PROVIDE METAL HANGERS FOR ALL JOISTS AND BUILT-UP WOOD MEMBERS INTERSECTING FLUSH BUILT-UP WOOD MEMBERS.
8) WOOD FRAMING NOT TREATED WITH A WOOD PRESERVATIVE, IN CONTACT WITH CONCRETE, SHALL BE SEPARATED FROM THE CONCRETE BY AT LEAST 2 mil. POLYETHYLENE FILM, NO. 50 (45lbs.) ROLL ROOFING OR OTHER DAMPROOFING MATERIAL, EXCEPT WHERE THE WOOD MEMBER IS AT LEAST 150mm (6") ABOVE THE GROUND.
- STEEL:
1) STRUCTURAL STEEL SHALL CONFORM TO CAN/CSA-G40-21 GRADE 300W. HOLLOW STRUCTURAL SECTIONS SHALL CONFORM TO CAN/CSA-G40-21 GRADE 350W CLASS "H".
2) REINFORCING STEEL SHALL CONFORM TO CSA-G30-18M GRADE 400R.

- WOOD LINTELS AND BUILT-UP WOOD BEAMS
- | L1 | 2/38 x 184 (2/2" x 8") SPR.#2 | | | | |
|----|--------------------------------|--|--|--|--|
| B1 | 3/38 x 184 (3/2" x 8") SPR.#2 | | | | |
| B2 | 4/38 x 184 (4/2" x 8") SPR.#2 | | | | |
| L3 | 2/38 x 235 (2/2" x 10") SPR.#2 | | | | |
| B3 | 3/38 x 235 (3/2" x 10") SPR.#2 | | | | |
| B4 | 4/38 x 235 (4/2" x 10") SPR.#2 | | | | |
| L5 | 2/38 x 286 (2/2" x 12") SPR.#2 | | | | |
| B5 | 3/38 x 286 (3/2" x 12") SPR.#2 | | | | |
| B6 | 4/38 x 286 (4/2" x 12") SPR.#2 | | | | |
- LAMINATED VENEER LUMBER (LVL) BEAMS
- | LVL1 | 2-1 3/4"x7 1/4" (3-45x184) | | | | |
|------|-----------------------------|--|--|--|--|
| LVL2 | 3-1 3/4"x7 1/4" (3-45x184) | | | | |
| LVL3 | 4-1 3/4"x7 1/4" (4-45x184) | | | | |
| LVL4 | 2-1 3/4"x9 1/2" (2-45x240) | | | | |
| LVL5 | 3-1 3/4"x9 1/2" (3-45x240) | | | | |
| LVL6 | 2-1 3/4"x11 7/8" (2-45x300) | | | | |
| LVL7 | 3-1 3/4"x11 7/8" (3-45x300) | | | | |
- STEEL COLUMNS (UNLESS NOTED OTHERWISE)
TP = (1) 3" DIA. ADJ. ST. POST
3TP = (2) 3" DIA. ADJ. ST. POSTS
2TP = (3) 3" DIA. ADJ. ST. POSTS
- LEGEND
- | ○ | CLASS 'B' VENT | M.C. | MEDICINE CABINET | — | SOLID WOOD BEARING |
|------|--------------------------------------|--------|--------------------|----|------------------------|
| ○ | EXHAUST VENT | /// | CONC. BLOCK WALL | P2 | 2 MEMBER BUILT-UP STUD |
| ○ | DUPLEX OUTLET (12" HIGH) | XXXXXX | DOUBLE VOLUME WALL | P3 | 3 MEMBER BUILT-UP STUD |
| ○ | DUPLEX OUTLET (HEIGHT AS NOTED AT F) | — | SEE NOTE (39) | P4 | 4 MEMBER BUILT-UP STUD |
| ○ | WEATHERPROOF DUPLEX OUTLET | — | | P5 | 5 MEMBER BUILT-UP STUD |
| ○ | HEAVY DUTY OUTLET | — | | | |
| ○ | POT LIGHT | — | | | |
| ○ | LIGHT FIXTURE (CEILING MOUNTED) | — | | | |
| ○ | LIGHT FIXTURE (PULL CHAIN) | — | | | |
| ○ | LIGHT FIXTURE (WALL MOUNTED) | — | | | |
| ○ | SWITCH | — | | | |
| ○ | FLOOR DRAIN | — | | | |
| ○ | HOSE BIB | — | | | |
| DJ | DOUBLE JOIST | — | | | |
| TJ | TRIPLE JOIST | — | | | |
| LVL | LAMINATED VENEER LUMBER | — | | | |
| X | POINT LOAD FROM ABOVE | — | | | |
| P.T. | PRESSURE TREATED LUMBER | — | | | |
| G.T. | GIRDER TRUSS BY ROOF TRUSS MANUF. | — | | | |
| F.A. | FLAT ARCH | — | | | |
| I | CURVED ARCH | — | | | |
- NOTE: SOLID BEARING TO BE AS WIDE AS SUPPORTED MEMBER. (SOLID BEARING TO BE A MINIMUM OF 2"ONE CONTINUOUS STUD AND ONE JACK STUD, UNLESS OTHERWISE NOTED ON PLAN.)
SMOKE ALARM (REFER TO OBC 9.10.19)
PROVIDE 1 PER FLOOR, NEAR THE STAIRS CONNECTING THE FLOOR LEVEL. ALARMS TO BE CONNECTED TO AN ELECTRICAL CIRCUIT AND INTERCONNECTED TO ACTIVATE ALL ALARMS IF 1 SOUNDS.
CARBON MONOXIDE DETECTOR (OBC 9.33.4)
WHERE A FUEL-BURNING APPLIANCE IS INSTALLED IN A DWELLING UNIT, A CARBON MONOXIDE DETECTOR CONFORMING TO CAN/CSA 6.19, CSA 6.19 OR UL2034 SHALL BE INSTALLED ADJACENT TO EACH SLEEPING AREA. CARBON MONOXIDE DETECTOR(S) SHALL BE PERMANENTLY WIRED SO THAT ITS ACTIVATION SHALL ACTIVATE ALL CARBON MONOXIDE DETECTORS AND BE EQUIPPED WITH AN ALARM THAT IS AUDIBLE WITHIN BEDROOMS WHEN THE INTERVENING DOORS ARE CLOSED.
SOIL GAS CONTROL (OBC 9.13.4, 9.13.4.1 & 9.13.4.2)
PROVIDE CONSTRUCTION TO PREVENT LEAKAGE OF SOIL GAS INTO THE BUILDING IF REQUIRED.
- CONTRACTOR MUST VERIFY ALL DIMENSIONS ON THE JOB AND REPORT ANY DISCREPANCY TO THE ARCHITECT BEFORE PROCEEDING WITH THE WORK.
ALL DRAWINGS AND SPECIFICATIONS ARE INSTRUMENTS OF SERVICE AND THE PROPERTY OF THE ARCHITECT WHICH MUST BE RETURNED AT THE COMPLETION OF THE WORK.
ALL DRAWINGS TO BE USED FOR CONSTRUCTION ONLY AFTER BUILDING PERMIT HAS BEEN ISSUED.
- PRESCRIPTIVE COMPLIANCE PACKAGE (OBC 2012 SUPPLEMENTARY STANDARD 5B-12)
O.B.C. TABLE 2.11.2.A COMPLIANCE PACKAGE "1"
1. CEILING WITH ATTIC SPACE - MIN. (RSI 8.81) R50
2. CEILING WITHOUT ATTIC SPACE - MIN. (RSI 5.46) R31
3. EXPOSED FLOOR - MIN. (RSI 5.46) R31
4. WALLS ABOVE GRADE - MIN. (RSI 5.46) R31
5. BASEMENT WALLS - MIN. (RSI 3.52) R20
6. EDGE OF BELOW GRADE SLAB (LESS THAN OR EQUAL TO 24" B6.) - MIN. (RSI 1.76) R10
7. HEATED SLAB (OR SLAB LESS THAN OR EQUAL TO 24" B6.) - MIN.(RSI 1.76) R10
8. WINDOWS & SLIDING GLASS DOORS - MAX. U VALUE OF 1.8
9. SKYLIGHTS MAX. U VALUE OF 2.8
10. SPACE HEATING EQUIPMENT - MIN. ARE OF 92%
11. HRV - MIN. EFFICIENCY OF 55%
12. DOMESTIC HOT WATER HEATER, MIN. EF OF 0.628

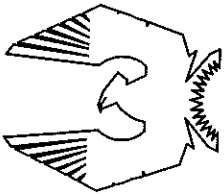

PHOENIX HOMES

SITE: SHADOW RIDGE 2

LOT NUMBER: 69


CIVIC ADDRESS: 6545 WATERDOWN ST.

CHEASAPEAKE-2007

REV.	AS PER CONST. SUMMARY	NOV6-13	SD
3	REV. AS PER CONST. SUMMARY	NOV6-13	SD
2	REV. AS PER CONST. SUMMARY	AUG16-13	SD
1	REV. AS PER CONST. SUMMARY	JUL11-13	SD
No.	Description	Date	By
REVISIONS			

file number:	508
drawn by:	A. FRANCOEUR
date:	OCT. 2003
scale:	3/16"=1'
sheet no:	9

GRAB BARS IN MAIN BATHROOM
REINFORCEMENT OF STUD WALLS SHALL BE INSTALLED
ADJACENT TO WATER CLOSETS AND SHOWER OR
BATHTUB IN MAIN BATHROOM. REFER TO OBC. 9.5.2.3.
3.8.3.8.(1)(d) & 3.8.3.13.(1)(f).

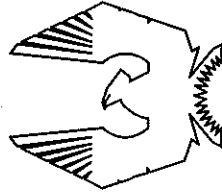

CHEASPEAKE-2007-A

SITE: SHADON RIDGE 25E

LOT NUMBER:

CIVIC ADDRESS:
6545 WATERDOWN ST.



No.	Description	Date	By
REVISIONS			

file number: 508


drawn by: A. FRANCOEUR

date: OCT. 2003

scale: 3/16"=1'

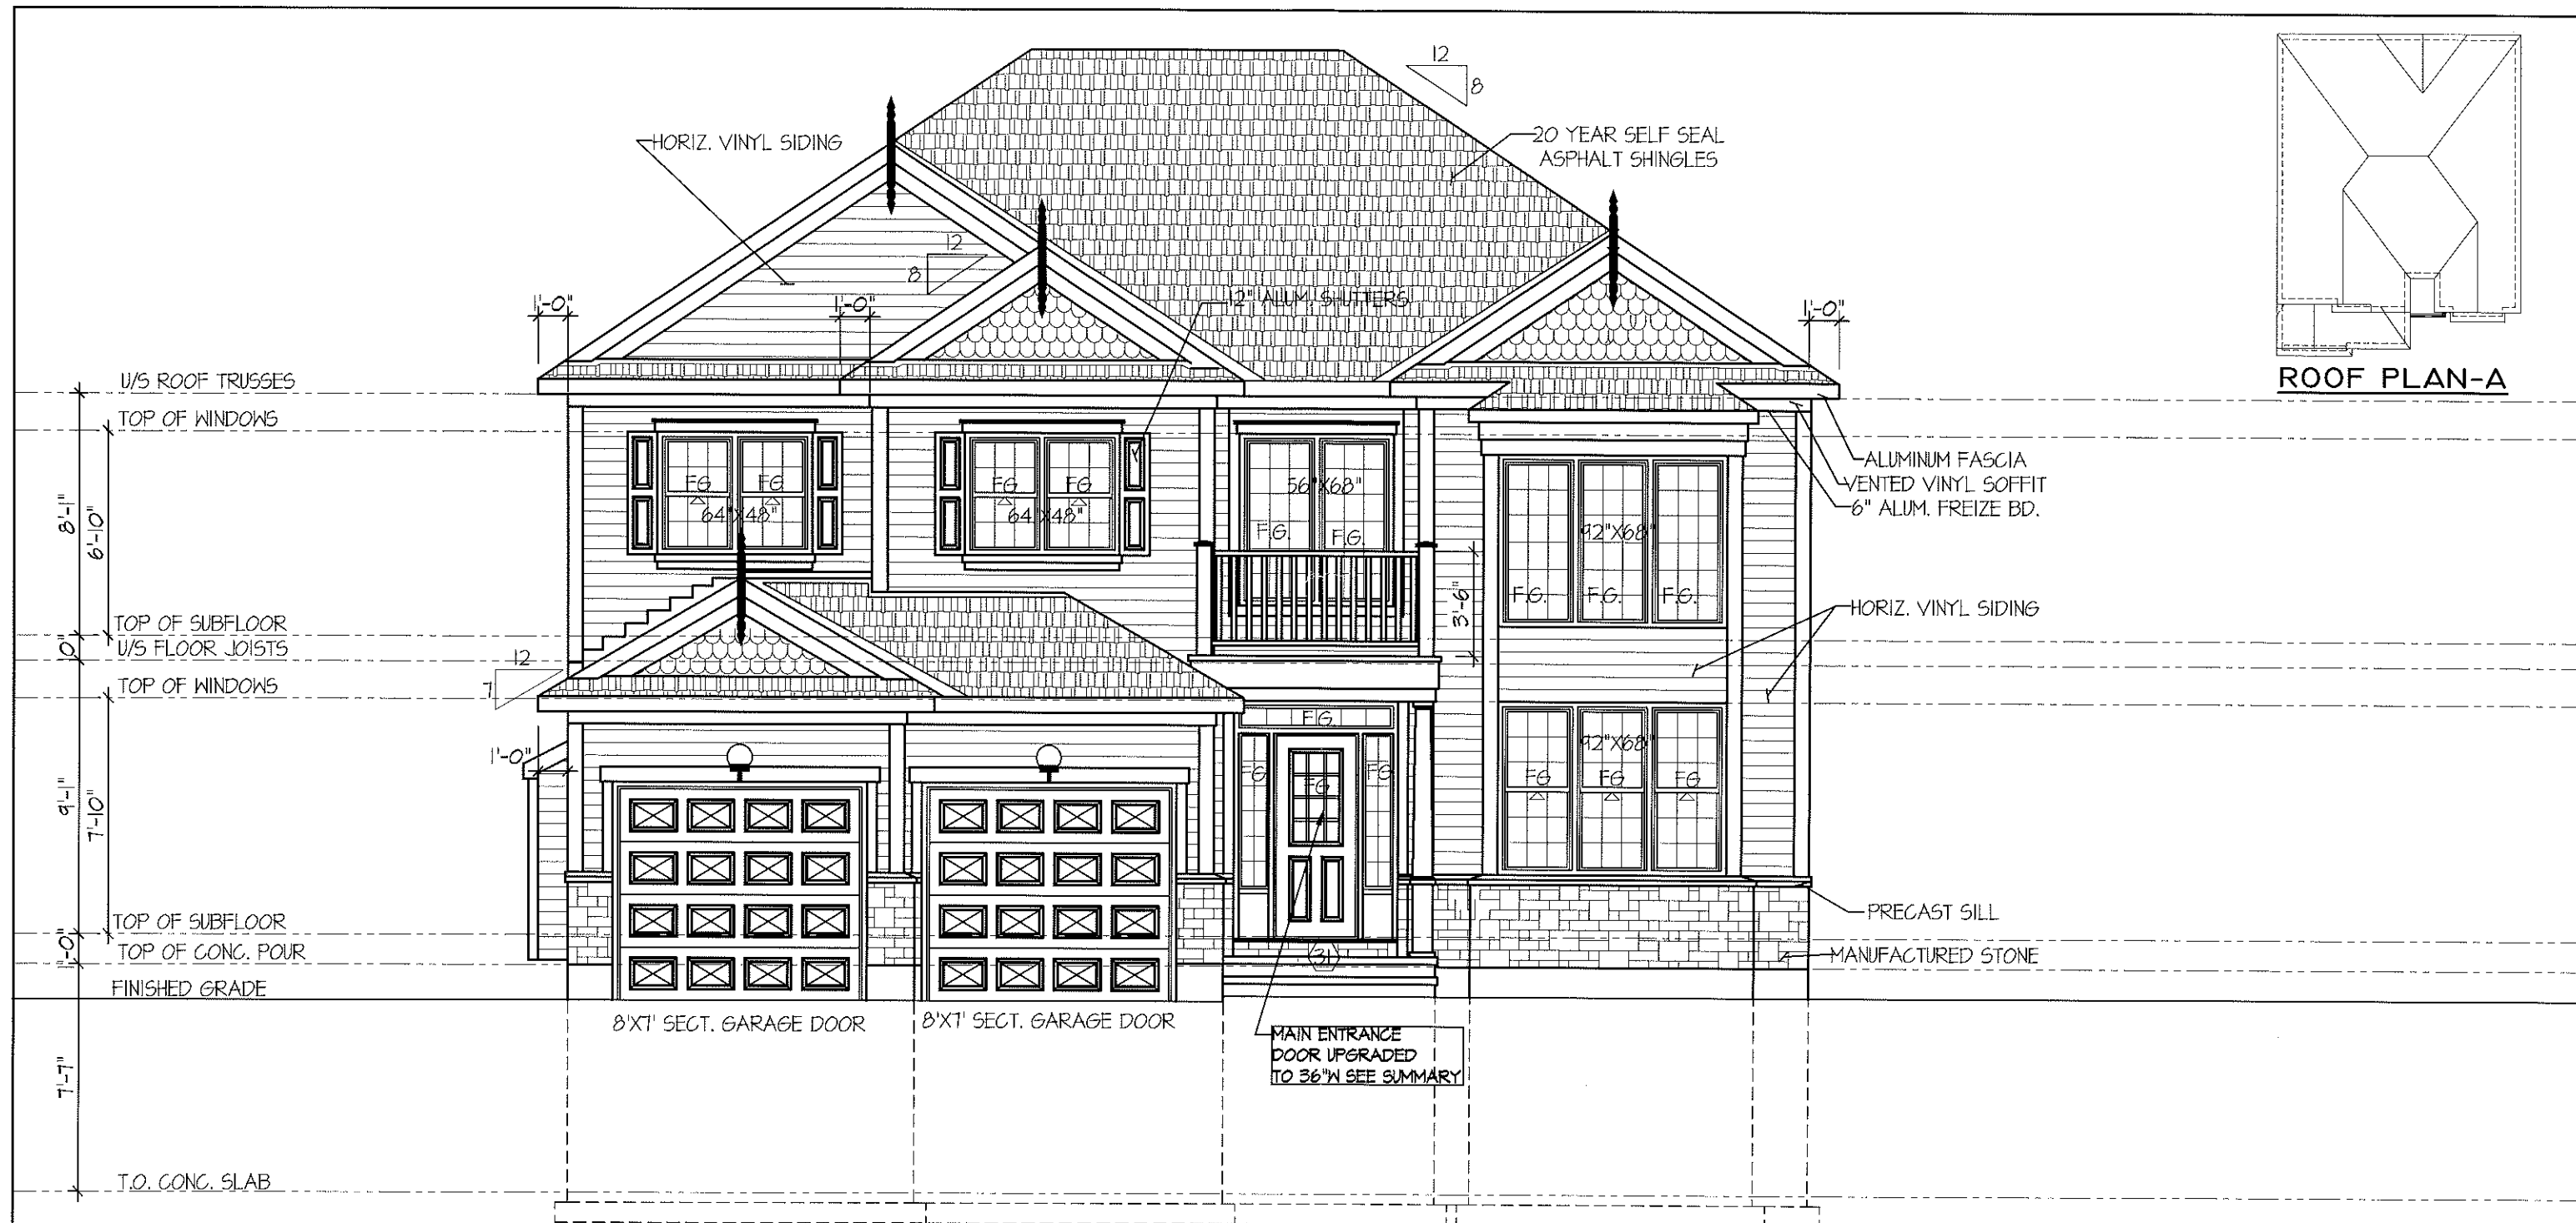

FRONT ELEVATION 'A'

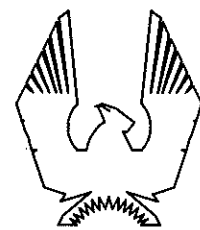

PHOENIX HOMES

CHEASAPEAKE-2007-A

SITE: SHADOW RIDGE2

LOT NUMBER:

69

CIVIC ADDRESS:
6545 WATERDOWN ST.

No.	Description	Date	By
3	REV. AS PER CONST. SUMMARY	NOV6-13	SD
2	REV. AS PER CONST. SUMMARY	AUG16-13	SD
1	REV. AS PER CONST. SUMMARY	JUL11-13	SD
REVISIONS			

file number: 508

drawn by: A. FRANCOEUR

date: OCT. 2003

scale: 3/16"=1'

sheet no:

5A

9