

DCR PHOENIX HOMES

WHITE TAIL RIDGE
LOT #83
PLATINA (512)
KITCHEN
MOUNTING HT: 84

LINE 2 - COMO MELAMINE - MOIRE

HARDWARE - HU 80

STD WHITE INTERIORS


METAL DRAWER BOX

4 PCS - 5/8" KICK

2 PCS - LOOSE FILLER - 6 x 96

2 PCS - C MOULD

2 PC - T MOULD

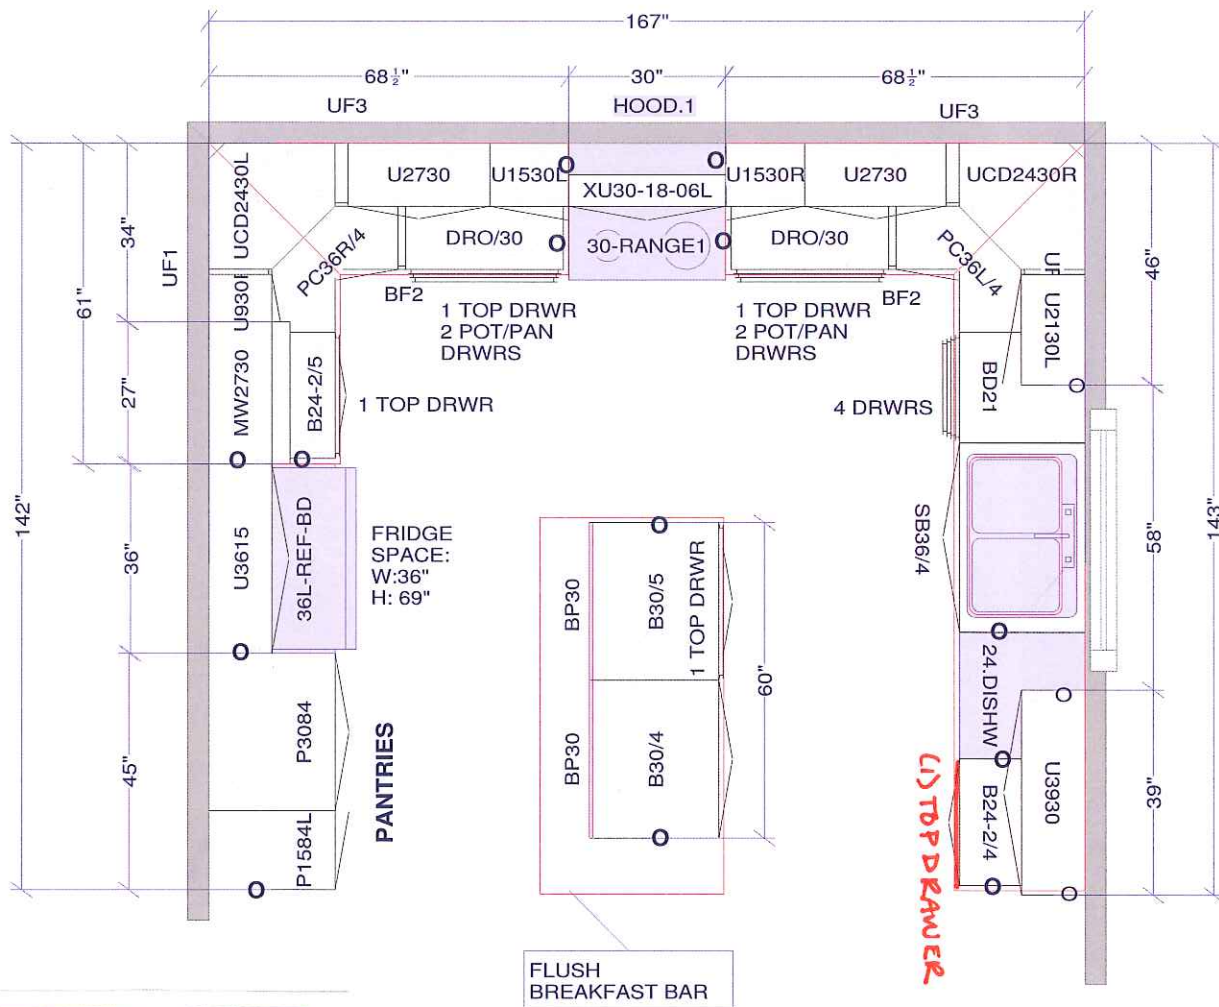

CUSTOMER APPROVAL

I have reviewed these drawings and understand the details of the layout and the Cartier Kitchens specifications.

Signature: *[Signature]*

Date: Sep. 5/14

All dimensions _size designations given are subject to verification on job site and adjustment to fit job conditions.

Cartier Kitchens Ottawa



This is an original design and must not be released or copied unless applicable fee has been paid or job order placed.


Drawn by: Lori Di Saverio, B.I.D.
Cartier Kitchens Ottawa

Designed: 04/08/201
Printed: 04/08/2014

DCR - #83 WTR - PLATINA (512) - KITCHEN.kit

All

Drawing #: 1 No Scale

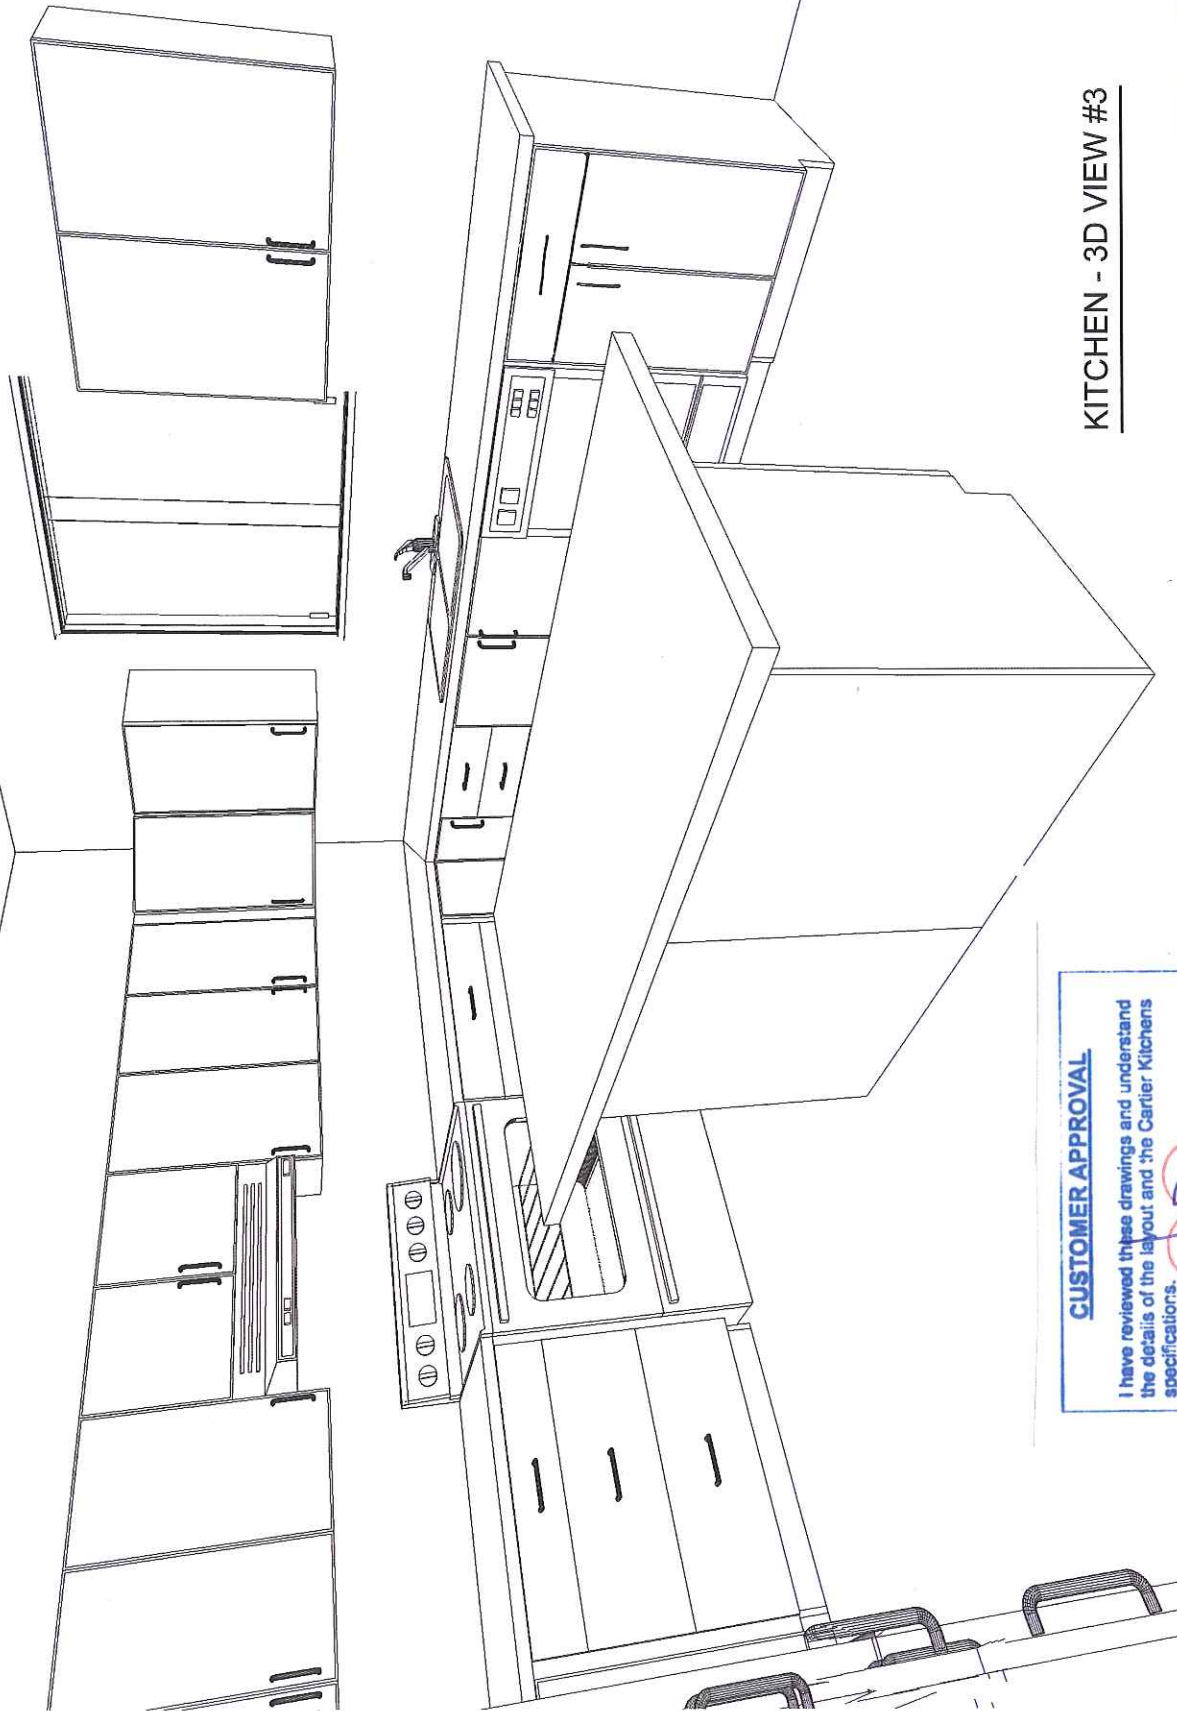

KITCHEN - 3D VIEW #3

CUSTOMER APPROVAL

I have reviewed these drawings and understand the details of the layout and the Cartier Kitchens specifications.

Signature _____

Date _____

[Handwritten Signature]


[Handwritten Date: Sep. 5/14]

Note: This drawing is an artistic interpretation of the general appearance of the design. It is not meant to be an exact rendition.

Drawn By: Lori D Saverio, B.I.D.
Cartier Kitchens Ottawa



Designed: 04/08/2014
Printed: 04/08/2014

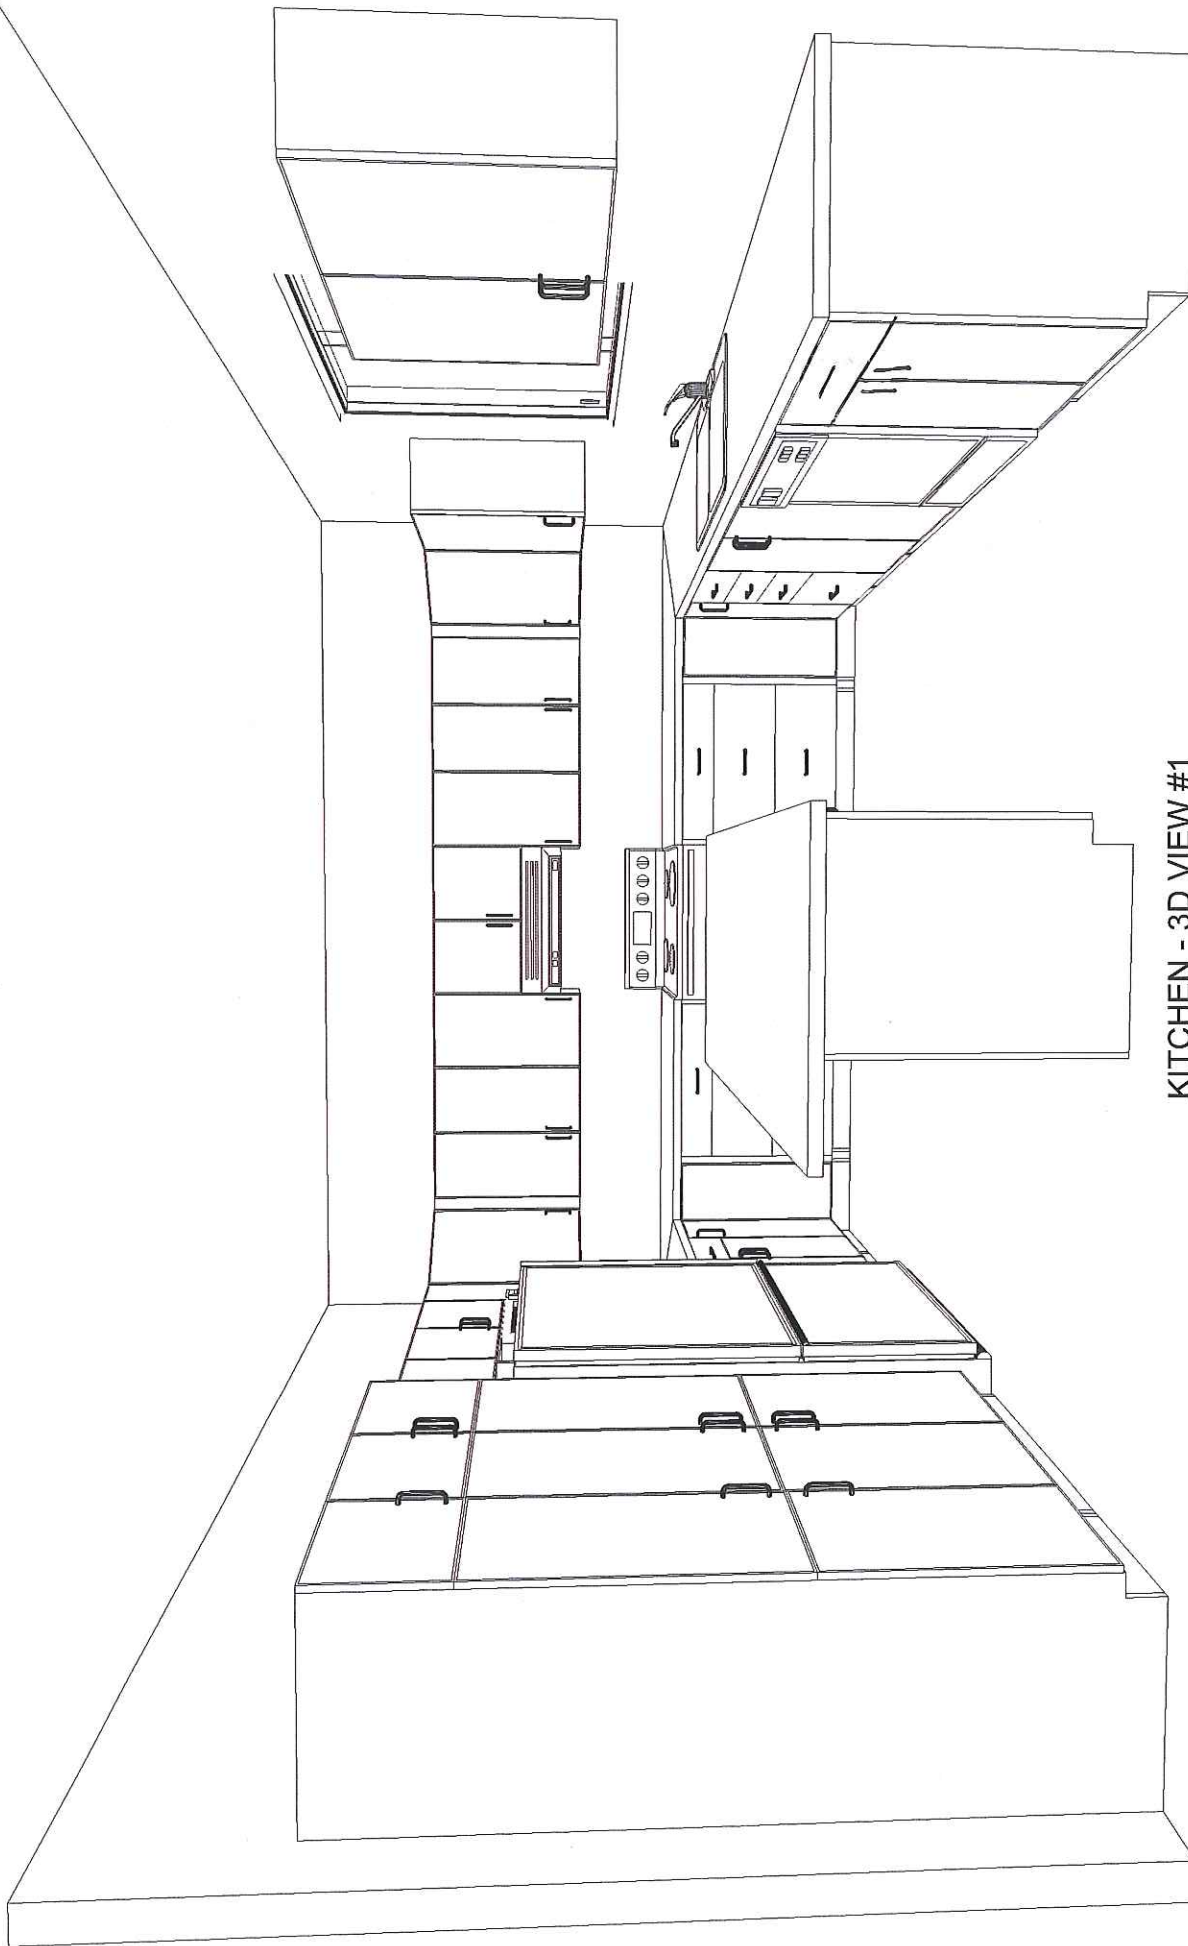

KITCHEN - 3D VIEW #1

CUSTOMER APPROVAL

I have reviewed these drawings and understand the details of the layout and the Cartier Kitchens specifications.

Signature ASW


Date Sep. 5/14



Note: This drawing is an artistic interpretation of the general appearance of the design. It is not meant to be an exact rendition.

Drawn By: Lori D Saverio, B.I.D.
Cartier Kitchens Ottawa

Designed: 04/08/2014
Printed: 04/08/2014

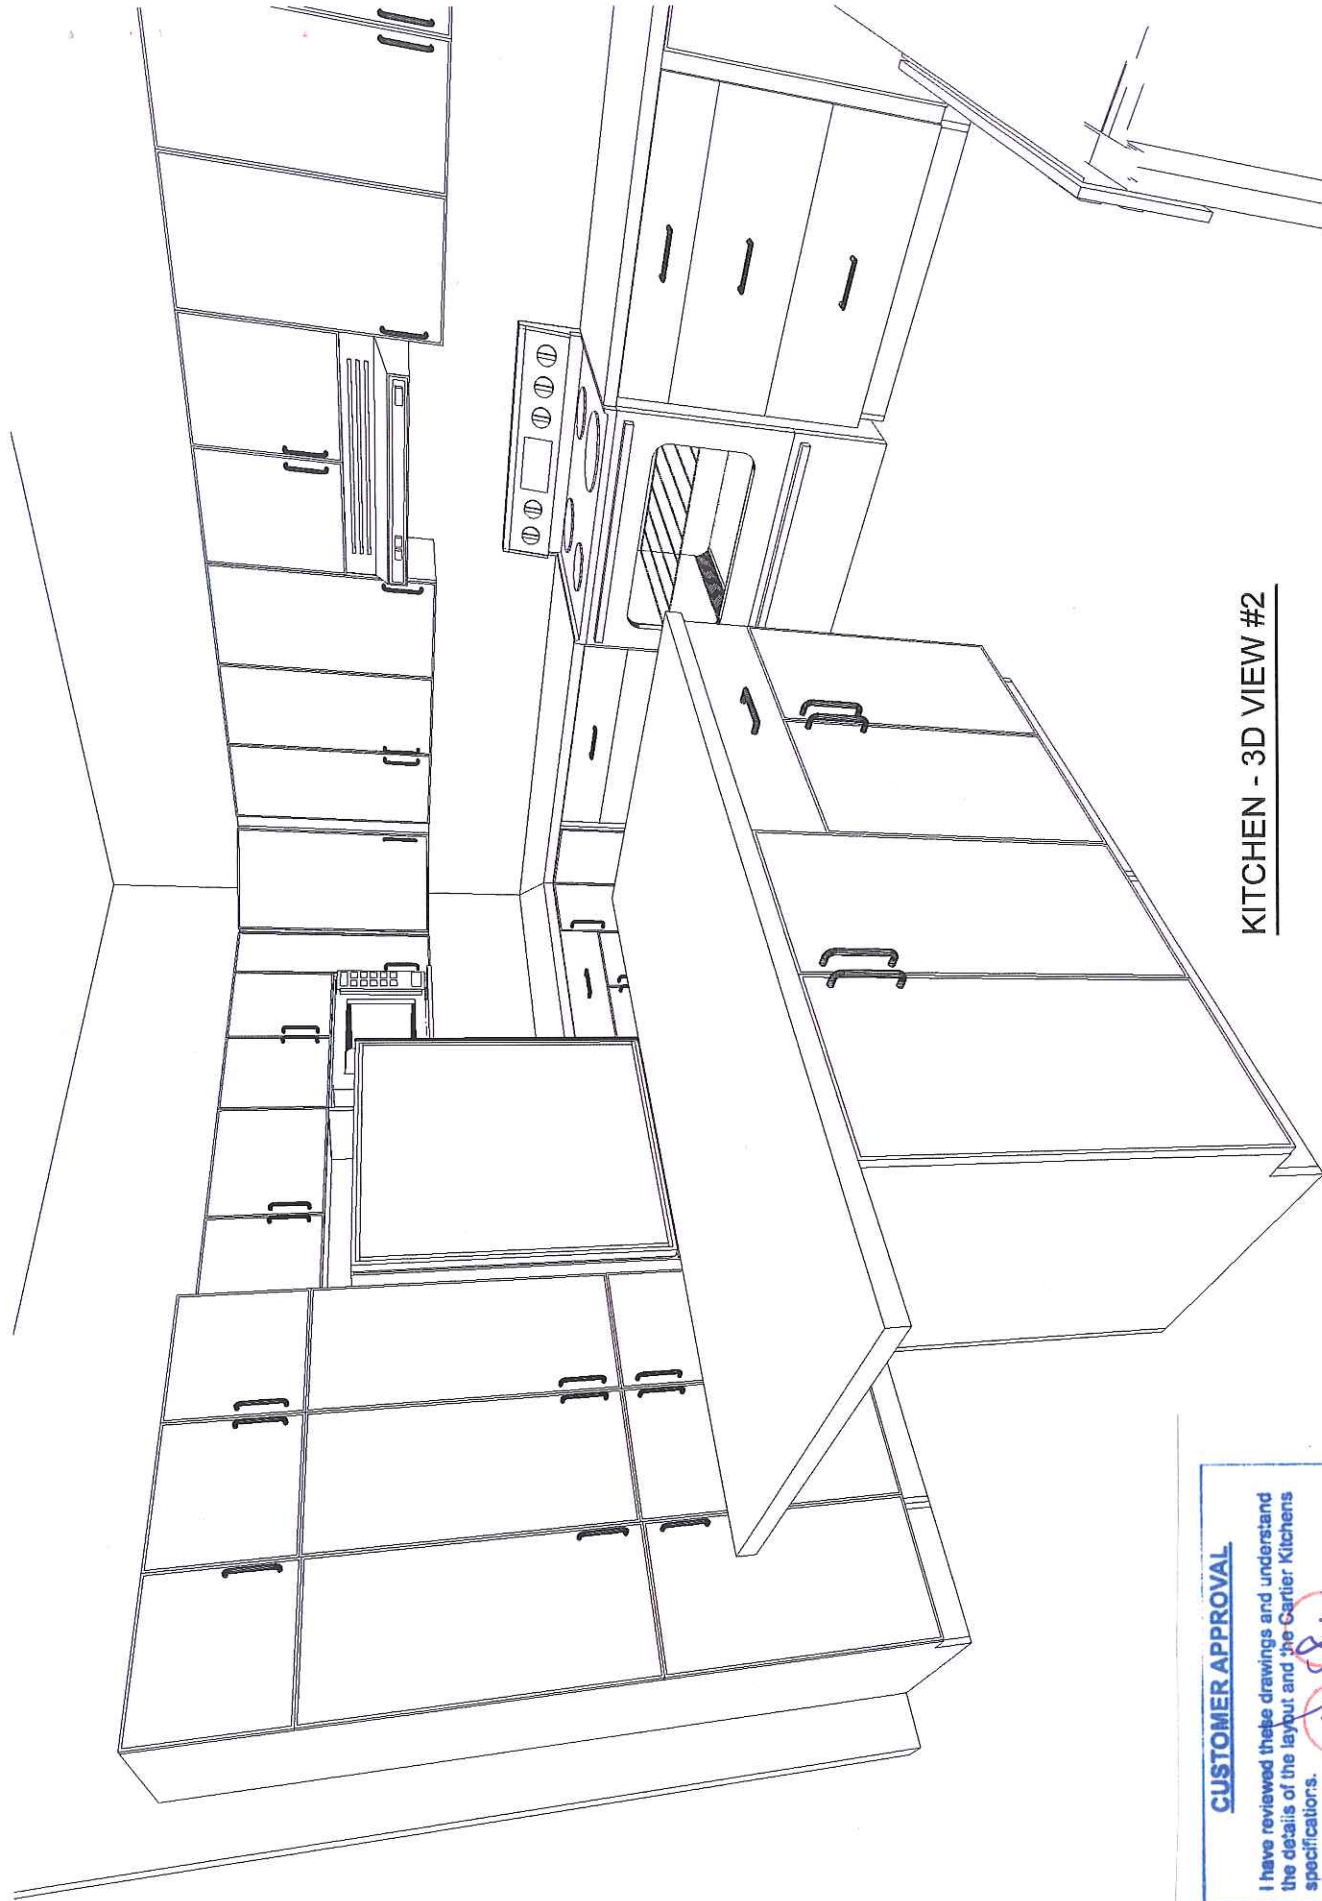

KITCHEN - 3D VIEW #2

CUSTOMER APPROVAL

I have reviewed these drawings and understand the details of the layout and the Cartier Kitchens specifications.

Signature [Signature]

Date Sep. 5/14

Note: This drawing is an artistic interpretation of the general appearance of the design. It is not meant to be an exact rendition.	2020 TECHNOLOGIES	Designed: 04/08/2014
		Printed: 04/08/2014
Drawn By: Lori D Saverio, B.I.D. Cartier Kitchens Ottawa		Revision #. 1