

DCR PHOENIX HOMES

TOWNHOUSE 20-24 - STANWICK - END UNIT

3 BEDROOM & MASTER RETREAT

KITCHEN / VANITIES

MOUNTING HEIGHT: 84" 96

LINE 1

HARDWARE - STD & 1st UPGRADE

STANDARD WHITE INTERIOR

METAL DRAWER BOX


6 PCS - 5/8" KICK - FIN. BOTH ENDS

2 PCS - LOOSE FILLER - 6 x 96


2 PCS - 90 DEG. CORNER MOULD

1 PCS - T-MOULD


7 PCS - FLAT MOULDING

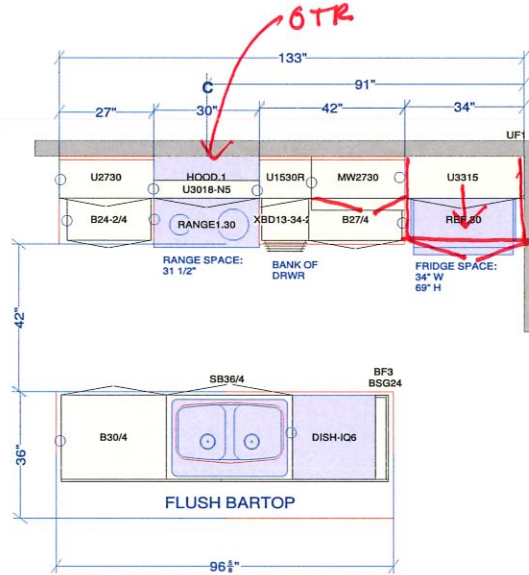


POWDER

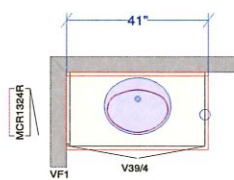

MAIN

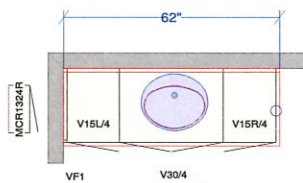

ENSUITE

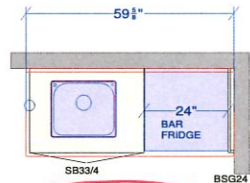

MASTER BDRM RETREAT



OPTIONAL REC ROOM VANITY

- EXTENDED APPROX. 36"
- ADD 2nd SINK

- MOVED TO BASEMENT
- DELETE SINK (KEEP BASE CABINET)

All dimensions size designations given are subject to verification on job site and adjustment to fit job conditions.

SPECTRUM KITCHEN and BATH DESIGN

This is an original design and must not be released or copied unless applicable fee has been paid or job order placed.

DRAWN BY: LORI DISAVERIO, B.I.D


Designed: 2018-02-28
Printed: 2018-03-01

TH 20 - 24 END STANWICK - 3 BDRM + MASTER RETREAT-

All

Drawing #: 1 No Scale.

WMH31017H OVER-THE-RANGE MICROWAVE

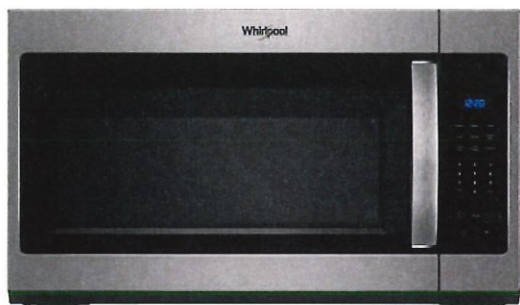

DISHWASHER-SAFE TURNTABLE PLATE



Clean up spills on the turntable by simply putting it in the dishwasher.

2-SPEED, 300 CFM MOTOR CLASS*



Match the right amount of ventilation to the dish being prepared and quickly get rid of cooking odors with two different fan speed settings.


MICROWAVE PRESETS



Get just the right amount of heat and time, whether you're cooking or defrosting, with specific preset options.

OTHER FEATURES

- Add 30 seconds option
- Electronic touch controls
- Adjustable cooktop lighting

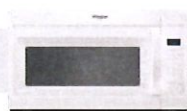

White
(W)



Black
(B)



Fingerprint Resistant
Stainless Steel (Z)



Silver
(S)

MODEL	WMH31017HW	WMH31017HB	WMH31017HZ	WMH31017HS
Max height (in)	17-1/8"	17-1/8"	17-1/8"	17-1/8"
Width (in)	29-15/16"	29-15/16"	29-15/16"	29-15/16"
Depth (in)	15-9/16"	15-9/16"	15-9/16"	15-9/16"

LOT 21 FB Towns

Whirlpool®

*Performance varies based on installation.

©/™ ©2018 Whirlpool. All rights reserved. 1/18. WC170107A



DELTA Raincan Single-Setting Shower Head

LOT 21 FB TOWN S

ENSURE



[Pin it](#)

[+ Share](#)

Model #: 52283

What does this model number mean?

Finish Shown: Chrome

Own this product?

Registering it helps us
provide the best service.

Want to save this
product so you can
quickly find it later?

Need help with your product?

Product Features and Benefits

- Soft, rubber Touch-Clean spray holes allow you to easily wipe away calcium and lime build-up from the spray face of your shower head and hand shower with the touch of a finger
- Installs in minutes
- Spray settings include: Soft Rain spray
- WaterSense labeled showers use at 1 water than the industry standard@sav without compromising performance
- Lifetime Faucet and Finish Warranty





DELTA

Ceiling Mount Shower Arm & Flange

LOT 21 FBTOWNS
ENSUITE



Pin it

Share

Model #: U4996

What does this model number mean?

Finish Shown: Chrome

Own this product?

Registering it helps us
provide the best service.

Want to save this
product so you can
quickly find it later?

Need help with your product?

Product Features and Benefits

- Extends 3" down from ceiling
- Includes flange
- Shower head sold separately
- 2-1/2" outside diameter
- Durable brass construction for years
- 1/2" (12.7 mm) IPS male threads
- Lifetime Faucet and Finish Warranty





DELTA

Premium 3-Setting Slide Bar Hand Shower

LOT 21 FB TOWNS
ENSUITE



[Pin it](#)

[+ Share](#)

Model #: 57014

What does this model number mean?

Finish Shown: Chrome

Own this product?

Registering it helps us
provide the best service.

Want to save this
product so you can
quickly find it later?

Need help with your product?

Product Features and Benefits

- 69" long hose for a long reach within the shower.
- Includes wall bar with adjustable slide for tall or short bathers
- Dual check valves
- Spray settings include: Full Body spray, Drenching spray
- Includes 70 in. hose
- Lifetime Faucet and Finish Warranty



DELTA 3-Setting 2-Port Diverter Trim

LOT 21 FB TOWNS
ENSUITE



Pin it

+ Share

Model #: T11800
What does this model number mean?

Finish Shown: Chrome

Own this product?

Registering it helps us
provide the best service.

Want to save this
product so you can
quickly find it later?

Need help with your product?

Product Features and Benefits

- Trim kit only, must purchase rough-in kit separately
- Must purchase rough-in kit R11000 sold separately
- 2 individual positions, 1 shared position
- Single lever handle for ease of operation
- 1/2 in. rough-in
- Includes valve cartridge
- Lifetime Faucet and Finish Warranty





DELTA Soap / Lotion Dispenser

LOT 21 FB TOWNS
KITCHEN.

INSTALLED LEFT CORNER K



[Pin it](#)

[+ Share](#)

Model #: RP1001AR
What does this model number mean?

Finish Shown: Arctic Stainless

Own this product?

Registering it helps us
provide the best service.

Want to save this
product so you can
quickly find it later?

Need help with your product?

Product Features and Benefits

- For use as soap or lotion dispenser
- Large capacity 13-ounce bottle
- Refillable from above the deck
- Includes refill funnel
- Lifetime Faucet and Finish Warranty

